

OPERATION & MAINTENANCE MANUAL

Water Quality Biofiltration Swale

Manual prepared: **March 2019**

DFI No. **D00645**



Figure 1: DFI No. D00645, looking South

Identification

Drainage Facility ID (DFI):	D00645
Facility Type:	Water Quality Biofiltration Swale
Construction Drawings:	(V-File Numbers) 45V-157
Location:	District: 4
	Highway No.: 001
	Mile Post: 233.22 to 233.26, Left

1. Manual Purpose

The purpose of this manual is to outline inspection needs and summarize maintenance actions.

2. Facility Location

The location map below details the facility location. The highway, mile posts, side streets, access location, and stormwater flow directions are noted on the map.

Facility location type: Off ramp

Flow direction: North

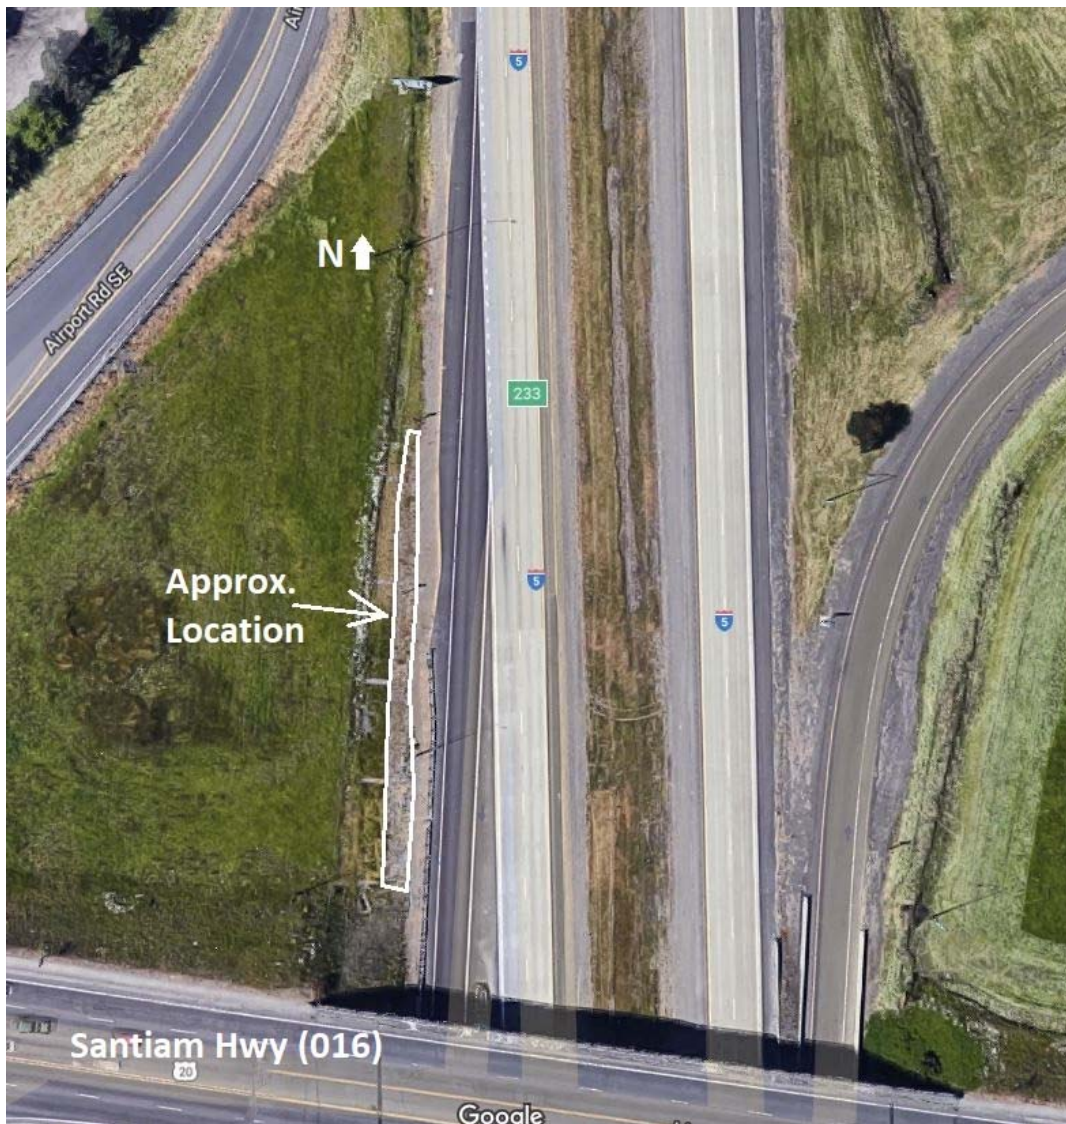



Figure 2: Facility location map

3. Facility Summary

The length and width of a swale is based on the bottom dimensions.

The bottom length and bottom width of the swale is:


Bottom Length (feet)	Bottom Width (feet)
211	2-12

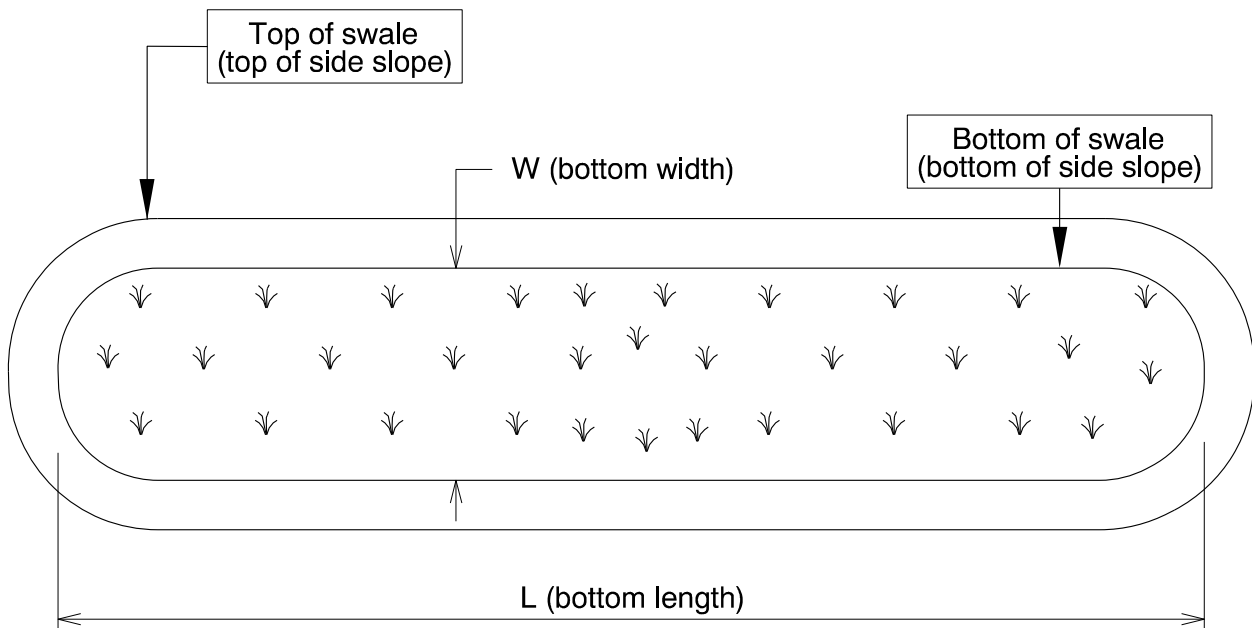

The depth of the swale is the vertical distance measured from the bottom of the swale to the top. The slope of the swale sides is presented by a vertical distance (rise) followed by the horizontal distance (run).

Depth and side slopes:

Depth (feet)	Rise (feet)	Run (feet)
Varies	1	3

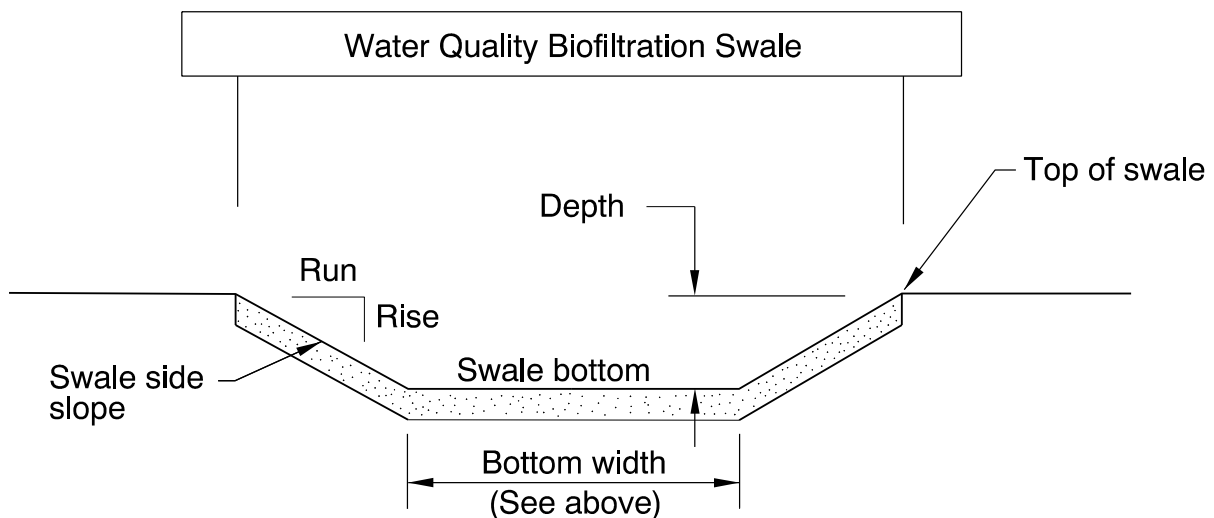

Site Specific Information: Stormwater enters the swale via two storm sewer pipes and then flows north before exiting into an open ditch. Maintenance access is via the roadside shoulder.

4. Facility Access

Maintenance access to the facility:

<input type="checkbox"/> Roadside pad	<input checked="" type="checkbox"/> Roadside shoulder
<input type="checkbox"/> Access road with Gate	<input type="checkbox"/> Access road without Gate



Figure 3: Access via roadside shoulder

5. Operational Components / Maintenance Items

Classification

This facility is classified as an:

<input checked="" type="checkbox"/> On-line Swale	<input type="checkbox"/> Off-line Swale
A swale that does not include a high flow bypass component; flow drains into and through the facility	A swale that treats low/small flows and diverts high flows using a bypass component

Bypass Component

This facility includes a high flow bypass component:

<input checked="" type="checkbox"/> No	<input type="checkbox"/> Yes
There is no bypass component. High flows drain into and through the facility	There is a bypass component. Only low/small flows drain into the swale. High flows are diverted around the swale using a bypass component

Operational Components

A swale has many components that assist with treatment, conveyance, and reducing flow velocity to minimize erosion. The components in use can vary depending if the facility was designed to operate on-line or off-line. The facility components table (**Table 1**) has been provided to highlight the applicable components for this facility. The component is in use when the box contains an “x” (e.g.).

The Standard Operation Manual for Water Quality Biofiltration Swales (implemented March 2017) outlines facility operation, typical footprint configuration, and component definitions and details. A link to the manual is attached to the feature marker in TransGIS.

<https://gis.odot.state.or.us/TransGIS/>

Operational Plan

The applicable standard operational plan for this facility is:

<input type="checkbox"/> Operational Plan A <input checked="" type="checkbox"/> Operational Plan B <input type="checkbox"/> Operational Plan C
A standard operational plan illustrates the general facility footprint configuration and explains the purpose of each facility component. Operational plans (A, B, C) are provided in the Standard Operation Manual.

See Appendix A for the site specific operational plan.

Maintenance Items

Operational components marked in **Table 1** should be inspected and maintained according to Section 7. Each facility component is defined and detailed in the Standard Operation Manual using the associated ID number indicated below.

Table 1: Swale Components		ID #
Manholes/Structures		
Pre-treatment manhole	<input type="checkbox"/>	S1
Weir type flow splitter/flow splitter manhole	<input type="checkbox"/>	S2
Orifice type flow splitter/flow splitter manhole	<input type="checkbox"/>	S3
Standard manhole	<input checked="" type="checkbox"/>	S4
Swale Inlet		
Pavement sheet flow	<input checked="" type="checkbox"/>	S5
Inlet Pipe (s)	<input checked="" type="checkbox"/>	S6
Open channel inlet	<input type="checkbox"/>	S7
Riprap pad	<input type="checkbox"/>	S8
Ground Cover		
Grass bottom	<input checked="" type="checkbox"/>	S9
Grass side slopes	<input checked="" type="checkbox"/>	S10
Granular drain rock	<input type="checkbox"/>	S11
Plantings	<input type="checkbox"/>	S12
Underground Components		
Geotextile fabric	<input type="checkbox"/>	S13
Water quality mix	<input checked="" type="checkbox"/>	S14
Perforated pipe	<input type="checkbox"/>	S15
Porous pavers (access grid)	<input type="checkbox"/>	S16
Flow Spreader		
Rock basin (used at inlet)	<input type="checkbox"/>	S17
Anchored board (midpoint of swale or every 50 feet along swale bottom)	<input type="checkbox"/>	S18
Other: describe type	<input type="checkbox"/>	S19
Swale Outlet		
Catch basin with grate	<input type="checkbox"/>	S20
Outlet Pipe (s)	<input type="checkbox"/>	S21
Open channel outlet	<input checked="" type="checkbox"/>	S22
Auxiliary Outlet: describe type	<input type="checkbox"/>	S23
Outfall Type		
Waterbody (Creek/Lake/Ocean)	<input type="checkbox"/> C	S24
	<input type="checkbox"/> L	
	<input type="checkbox"/> O	
Ditch	<input checked="" type="checkbox"/>	S25
Storm drain system	<input type="checkbox"/>	S26
Outfall Components		
Riprap pad	<input type="checkbox"/>	S27
Riprap bank protection	<input type="checkbox"/>	S28

6. Maintenance

Maintenance Frequency/Maintain Records

- a. Inspect annually. Preferably prior to the rainy season.
- b. Clean and maintain as necessary. Refer to Activity 125 for conditions when maintenance is needed.
- c. Keep a record of inspections, maintenance, and repairs.

Maintenance Guide/Maintenance Actions

The ODOT Routine Road Maintenance Water Quality and Habitat Guide (the *Blue Book*) outlines the standard maintenance actions for water quality facilities under Activity 125.

There are standard maintenance tables for standard ODOT designs. The maintenance tables describe the maintenance component, the defect or problem, the condition when maintenance is needed, and the recommended maintenance to correct the problem. Use the following tables to maintain ODOT swales:

- Table 1 (General Maintenance): Contains general maintenance and inspection guidelines that are applicable to all ODOT water quality facilities
- Table 3 (Maintenance of Water Quality or Biofiltration Swales): Contains maintenance information for swales

The *Blue Book* can be viewed at the following website:

http://www.oregon.gov/ODOT/Maintenance/Documents/blue_book.pdf

7. Limitations

Access grid installed:

<input checked="" type="checkbox"/> No	<input type="checkbox"/> Yes
There are no porous pavers installed in this swale	

Swales are designed to allow equipment access along the bottom. If an access grid is **NOT** installed, vehicles entering the swale can create depressions (tire ruts), damage vegetation, and damage structural components (e.g. flow spreaders). These conditions may result in poor treatment and drainage performance.

Equipment wheels should be kept on the tops and side slopes. Mower arms may be run along the swale bottom.

8. Waste Material Handling

Material removed from the facility is defined as waste by the Department of Environmental Quality (DEQ). Refer to the roadwaste section of the ODOT Maintenance Yard Environmental Management System (EMS) Policy and Procedures Manual for disposal options:

http://www.oregon.gov/ODOT/Maintenance/Documents/ems_manual.pdf


Contact any of the following for more detailed information about management of waste materials found on site:

ODOT Clean Water Unit	(503) 986-3008
ODOT Statewide Hazmat Coordinator	(503) 667-7442
ODOT Region 1 Hazmat Coordinator	(503) 731-8290
ODOT Region 2 Hazmat Coordinator	(503) 986-2647
ODOT Region 3 Hazmat Coordinator	(541) 957-3594
ODOT Region 4 Hazmat Coordinator	(541) 388-6186
ODOT Region 5 Hazmat Coordinator	(541) 963-1590
ODEQ Northwest Region Office	(503) 229-5263




A Appendix A – Site Specific Operational Plan

Contents:

Operational Plan: DFI D00645

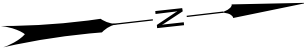

- LEGEND:**
- Photo Location / Direction
 - Facility Component (see table 1 in O&M Manual)
 - Cleanout
 - and Inlet
 - Storm Pipe (Facility)
 - Storm Pipe (Facility)
 - Conveyance Direction
 - Pavement / Facility Flow Path

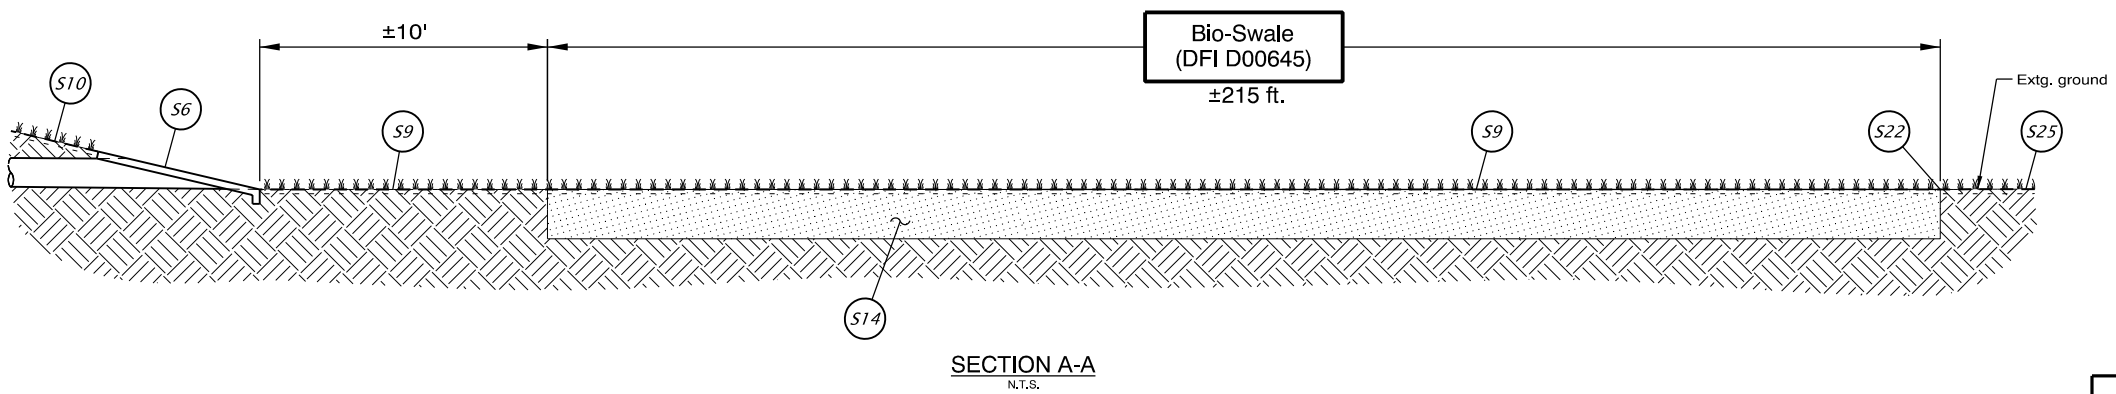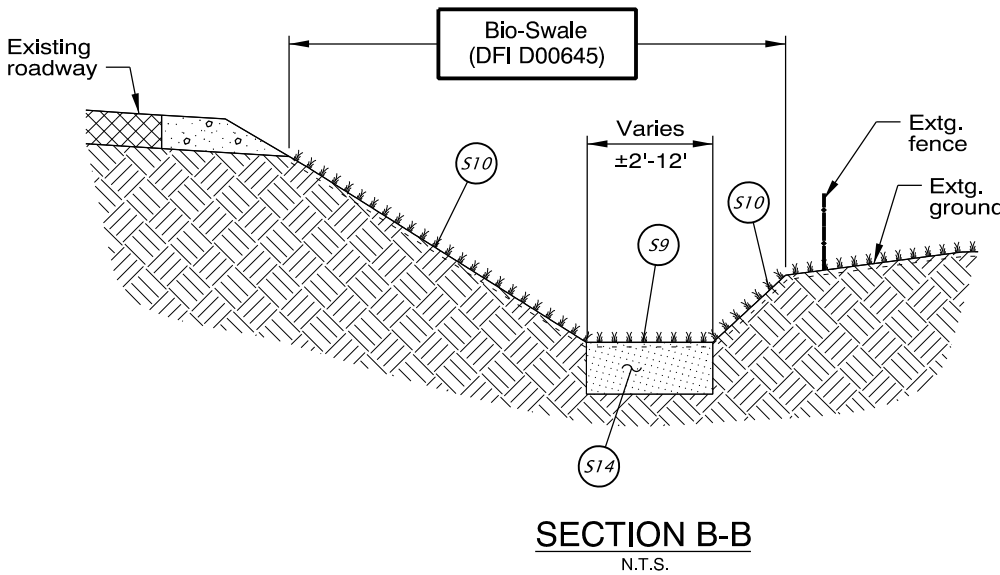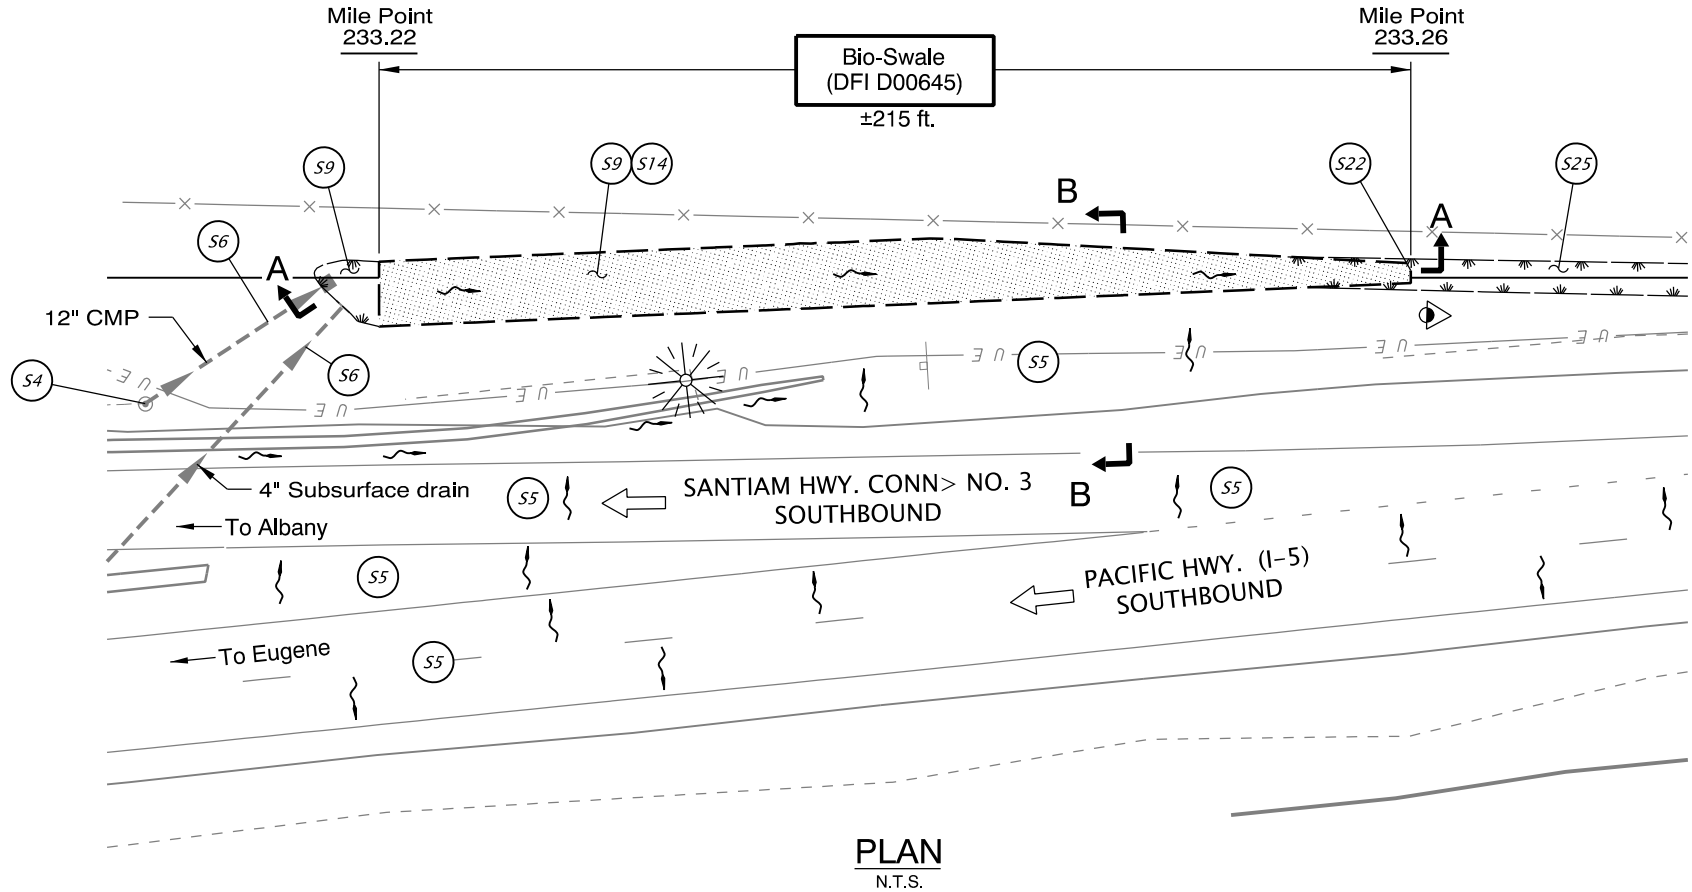

Prepared By:
Jason Stroud

Drafted By:
Michael Skelton

DFI D00645
MAINTENANCE DISTRICT 4 I-5
WATER QUALITY BIOFILTRATION SWALE
PACIFIC HIGHWAY MP 233.22 LT.
LINN COUNTY

B Appendix B – Project Contract Plans

Contents:

Site Specific Subset of Project Contract Plan 45V-157

INDEX OF SHEETS	
SHEET NO.	DESCRIPTION
1	Title Sheet
1A	Index Of Sheets Cont'd. & Std. Drg. Nos.

STATE OF OREGON
DEPARTMENT OF TRANSPORTATION

PLANS FOR PROPOSED PROJECT
GRADING, DRAINAGE, & PAVING

**I-5: SANTIAM HWY. O'XING, SB LANES (ALBANY) SECTION
PACIFIC HIGHWAY**


LINN COUNTY
OCTOBER 2012

REVISED AS CONSTRUCTED

Gene Wilborn

Jim Wilborn

DATE *7/19/13*

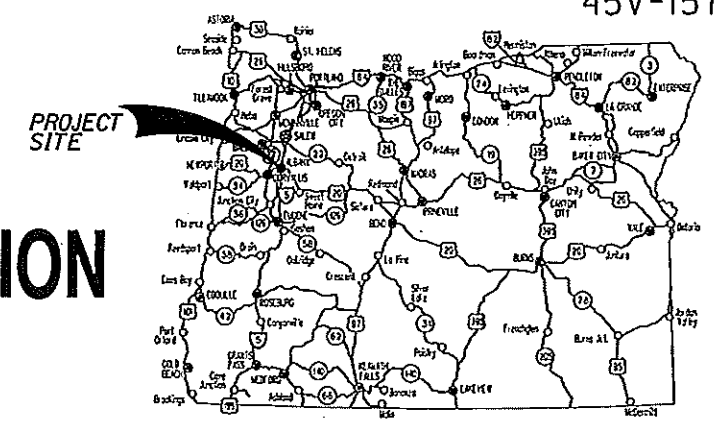


Overall Length Of Project - 0.43 Miles

ATTENTION:
Oregon Law Requires You To Follow Rules Adopted By The Oregon Utility Notification Center. Those Rules Are Set Forth In OAR 952-001-0010 Through OAR 952-001-0090. You May Obtain Copies Of The Rules By Calling The Center. (Note: The Telephone Number For The Oregon Utility Center Is (503) 232-1987.)



ORIGINAL

**HPP-S001(418)
BEGINNING OF PROJECT
STA. "SB" 1096+10 (M.P. 233.46)**

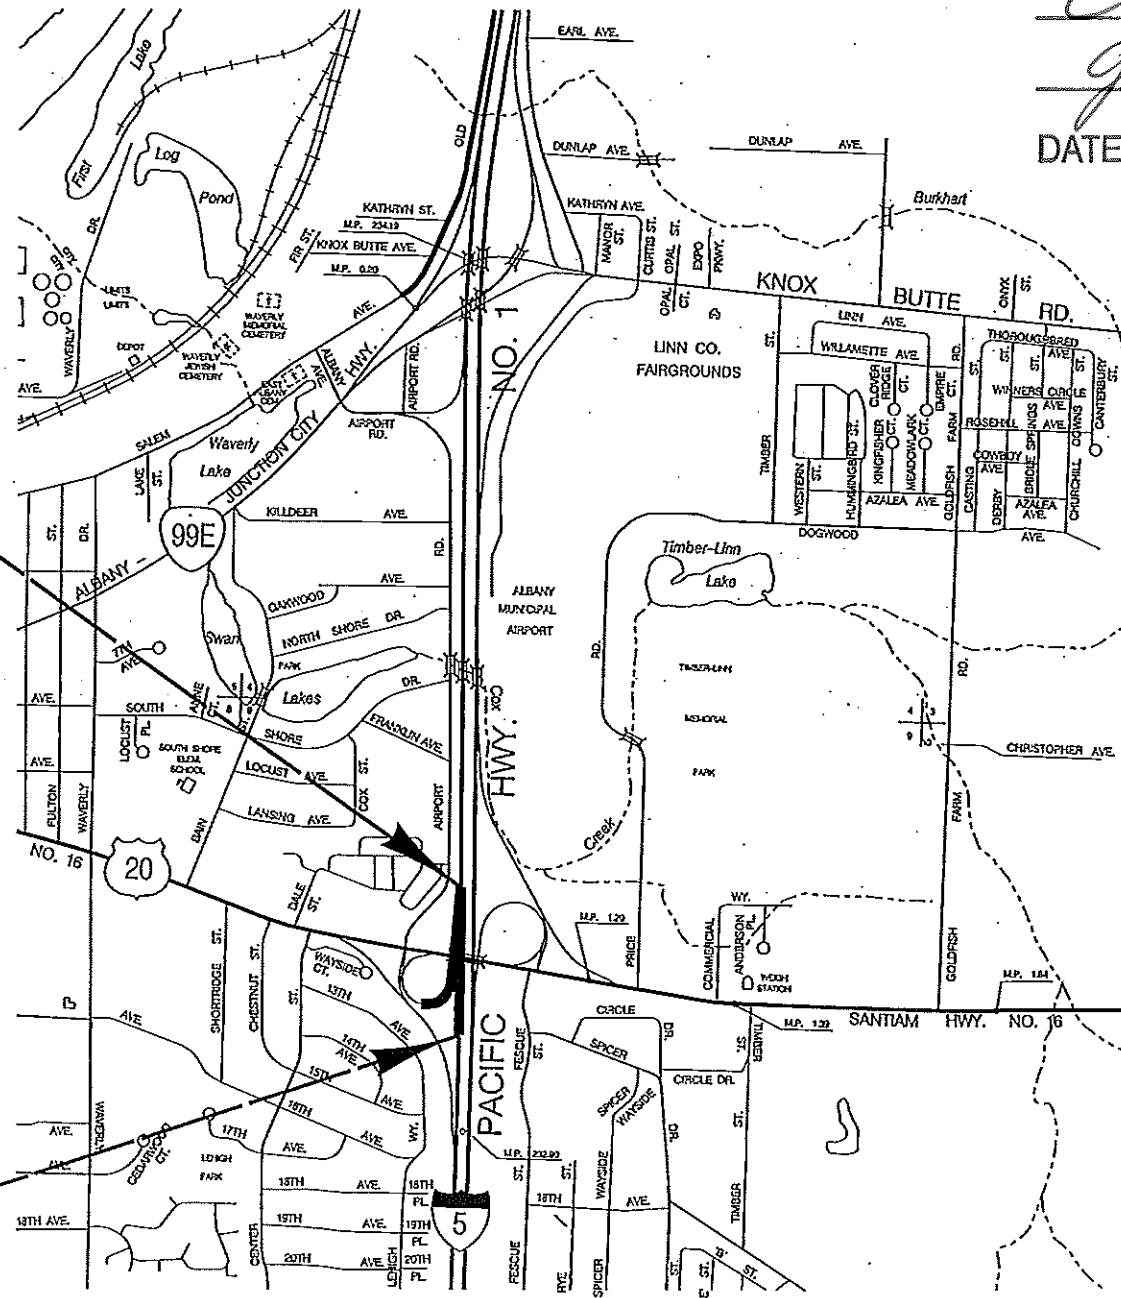

**HPP-S001(418)
END OF PROJECT
STA. "SB" 1118+90 (M.P. 233.03)**

T. IIS., R. 3W., W.M.

OREGON TRANSPORTATION COMMISSION	
Pat Egan	CHAIR
David Lohman	COMMISSIONER
Mary Olson	COMMISSIONER
Mark Frohnmayer	COMMISSIONER
Tammy Boney	COMMISSIONER
Matthew L. Garrett	DIRECTOR OF TRANSPORTATION

PLANS PREPARED FOR
ODOT
BY:
QUINCY ENGINEERING, INC.

These plans were developed using ODOT design standards. Exceptions to these standards, if any, have been submitted and approved by the ODOT Chief Engineer or their delegated authority.

Approving Authority: *Jeff W. Olson* 9/12/12
Signature & date

Jeff W. Olson, Principal
Print name and title
J.M.N.
Concurrence by ODOT Chief Engineer

**I-5: SANTIAM HWY. O'XING,
SB LANES (ALBANY) SECTION
PACIFIC HIGHWAY
LINN COUNTY**

FEDERAL HIGHWAY ADMINISTRATION	PROJECT NUMBER	SHEET NO.
OREGON DIVISION	HPP-S001(418)	1



INDEX OF SHEETS, CONT'D.	
SHEET NO.	DESCRIPTION
2 Thru 2A-3 Incl.	Typical Sections
2B Thru 2B-4 Incl.	Details
2C, 2C-2	Traffic Control Details
2C-3	Detour Plan
2C-4 Thru 2C-18 Incl.	Traffic Control Plan
2D	Pipe Data Sheet
3, 4	Alignment
4A	General Construction
4B	Notes
4C	Profile
5	Alignment
GEO/HYDRO	
GA Thru GA-3, Incl.	Erosion Control Plan
GN	Planting Plan
GN-2	Planting Details
PERMANENT PAVEMENT MARKINGS	
ST	Striping Details
ST-2 Thru ST-4 Incl.	Striping Plan
PERMANENT SIGNING	
S-13212	Sign & Post Data Table, Sign Details, and Permanent Signing Plan
ILLUMINATION	
I-01943	Illumination Legend
I-01944	Illumination Plan


Standard Drg. Nos.

- RD140 - Roadway Cross Slopes Superelevated Sections
- RD300 - Trench Backfill, Bedding, Pipe Zone And Mult. Installations
- RD312 - Subsurface Drain
- RD364, RD368 - Concrete Inlets
- RD376 - Misc. Drainage Structures
- RD386 - Fill Height Tables
- RD399 - Stormwater Treatment and Storage Facility Field Markers
- RD400, RD405, RD410, RD415, RD420 - Guardrail
- RD500 - Precast Concrete Barrier Pin and Loop Assy.
- RD505 - Concrete Barrier Cast-in-Place
- RD515 - Median Barrier Anchoring Details
- RD516 - Securing Concrete Barrier to Roadway
- RD545 - Precast Tall (42") Concrete Barrier
- RD570 - Guardrail Transition to Tall Concrete Barrier
- RD610 - Asphalt Pavement Details
- RD700 - Curbs
- RD1005 - Check Dams
- RD1010 - Inlet Protection
- RD1040 - Sediment Fence (Supported and Unsupported)
- RD1055 - Matting
- TM200 - Sign Installation Details
- TM211 - Signing Details US and Interstate Route Shields
- TM225 - Exit Number and Gore Signing Details
- TM472 - Traffic Signal Junction Box
- TM500, TM502 - Pavement Markings
- TM517 - Recessed Pavement Markers
- TM520, TM521 - Durable Pavement Markings
- TM551 - Freeway Exit Ramp Pavement Markings
- TM560 - Alignment Layout: General
- TM570, TM571, TM575 - Traffic Delineators
- TM670 - Wood Post Sign Supports
- TM671 - 3 Second Wind Gust Speed Isotach
- TM676 - Sign Attachments
- TM681, TM687, TM688 - Square Tube Sign Supports
- TM800 - Tables, Abrupt Edge, and PCMS Details
- TM810 - Temporary Reflective Pavement Markers
- TM820 - Temporary Barricades
- TM821 - Temporary Sign Supports
- TM830 - Temporary Concrete Barrier and Rumble Strips
- TM832 - Temporary Impact Attenuators
- TM850 - 2-Lane, 2-Way Roadways
- TM860 - Freeway Sections



No R/W Map

NOT REVISED AS CONSTRUCTED

Gene Wilborn
Jim Wit
 DATE 7/19/13

 QUINCY ENGINEERING, INC.		
I-5: SANTIAM HWY. O'XING, SB LANES (ALBANY) SECTION PACIFIC HIGHWAY LINN COUNTY		
FEDERAL HIGHWAY ADMINISTRATION	PROJECT NUMBER	SHEET NO.
OREGON DIVISION	HPP-S00K(418)	1A




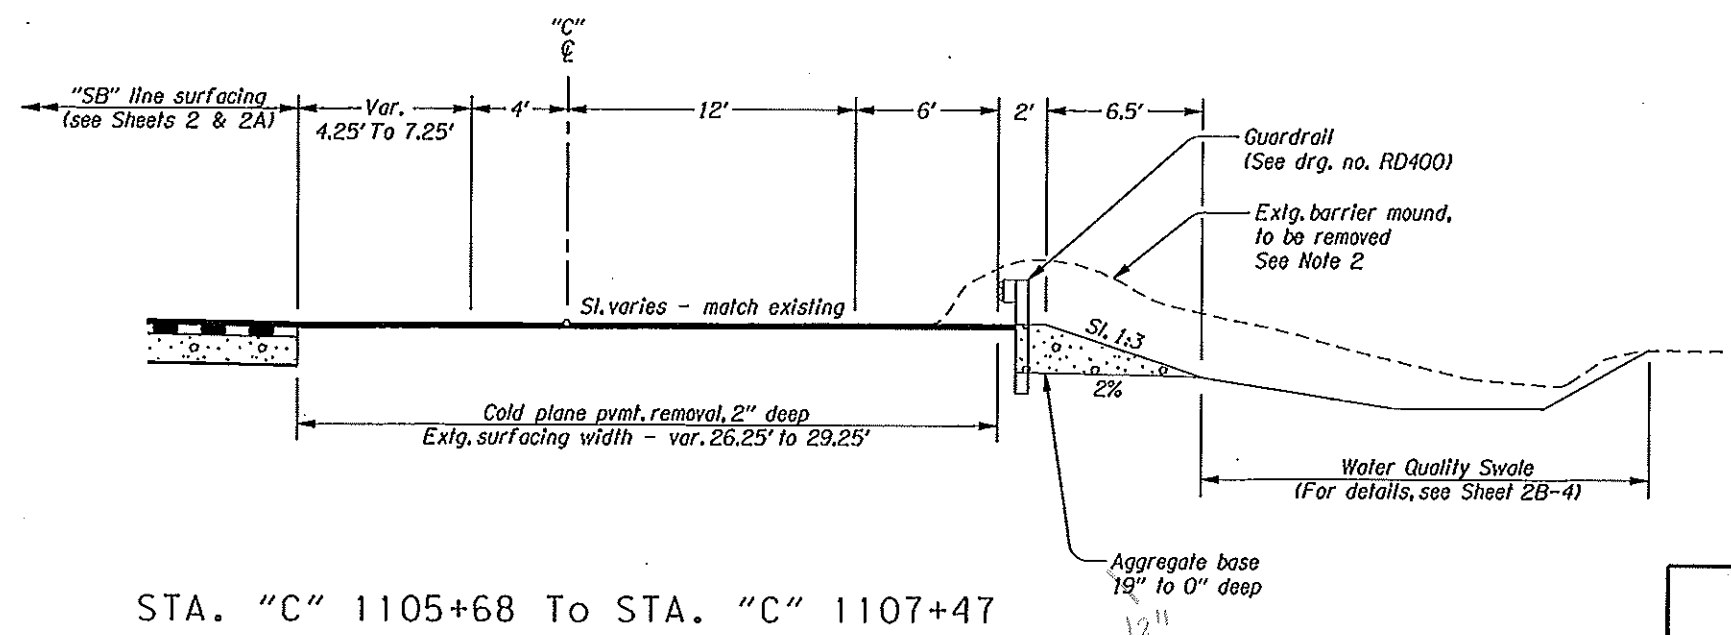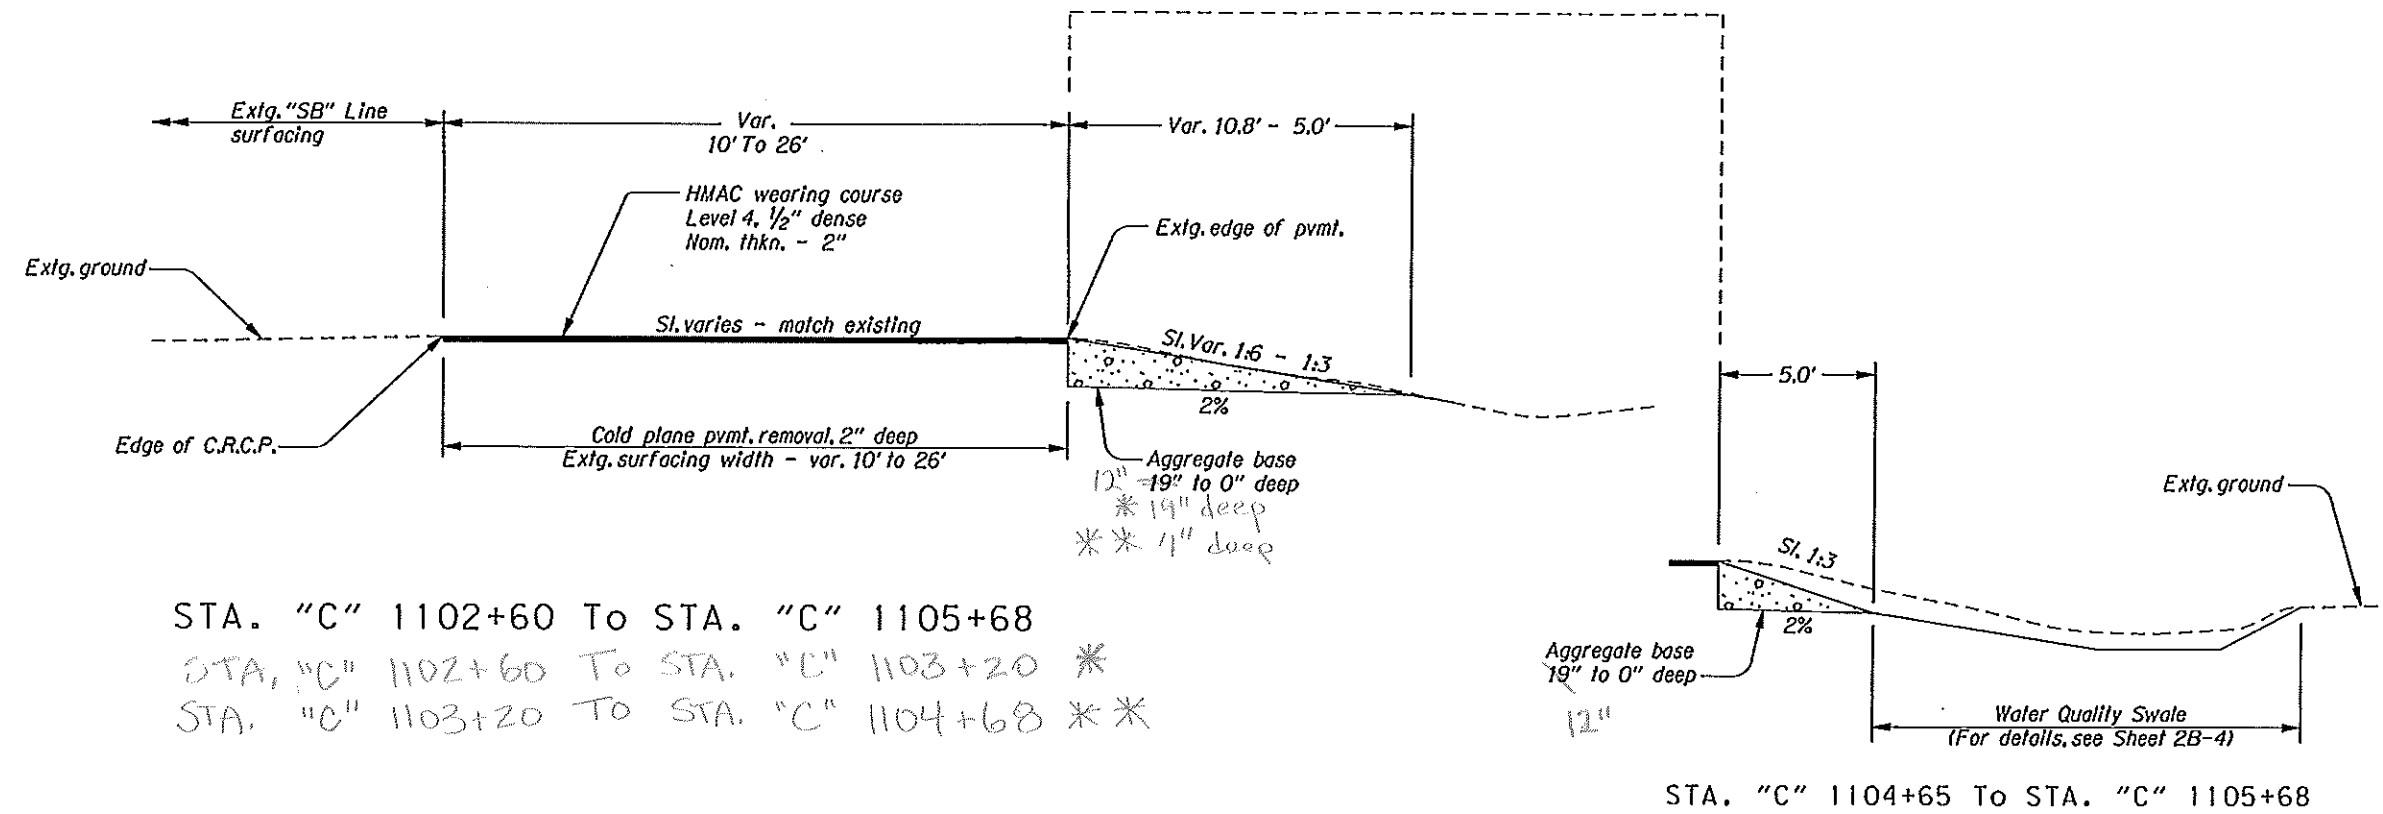



- Notes:
1. Side-slopes are shown as vert. to horiz.
 2. Extg. pavement limits under barrier mound unknown - see Sheet 2A for any necessary full-depth shoulder widening.


Gene Wilborn


 DATE 7/19/13

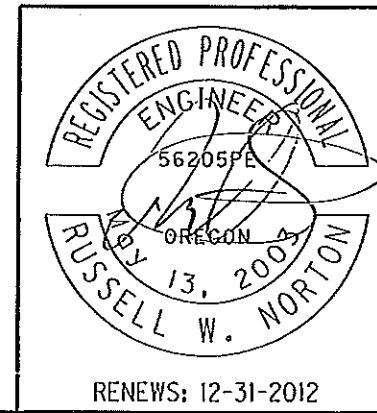


1-51 SANTIAM HWY. O'XING. SB LANES (ALBANY) SECTION PACIFIC HIGHWAY LINN COUNTY	
Design Team Leader - Russell W. Horton Designed By - Jeremy Mikkelsen Drafted By - Jeremy Mikkelsen	
TYPICAL SECTIONS	SHEET NO. 2A-2

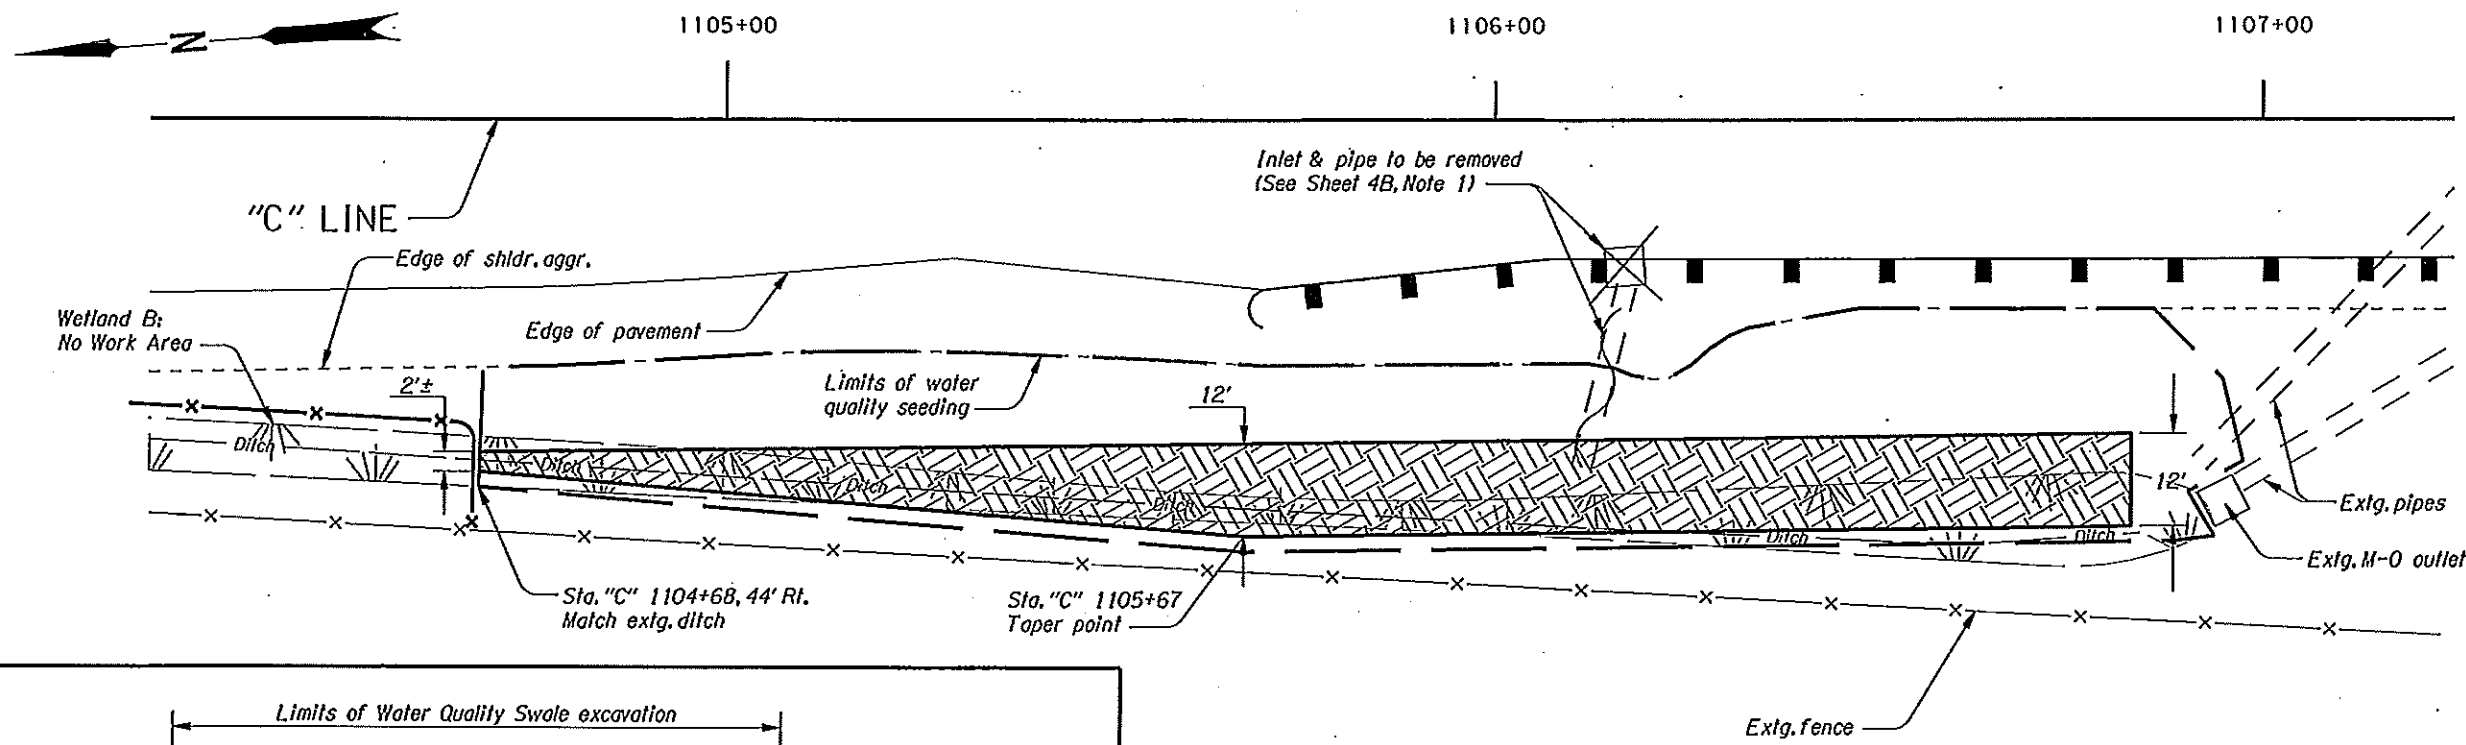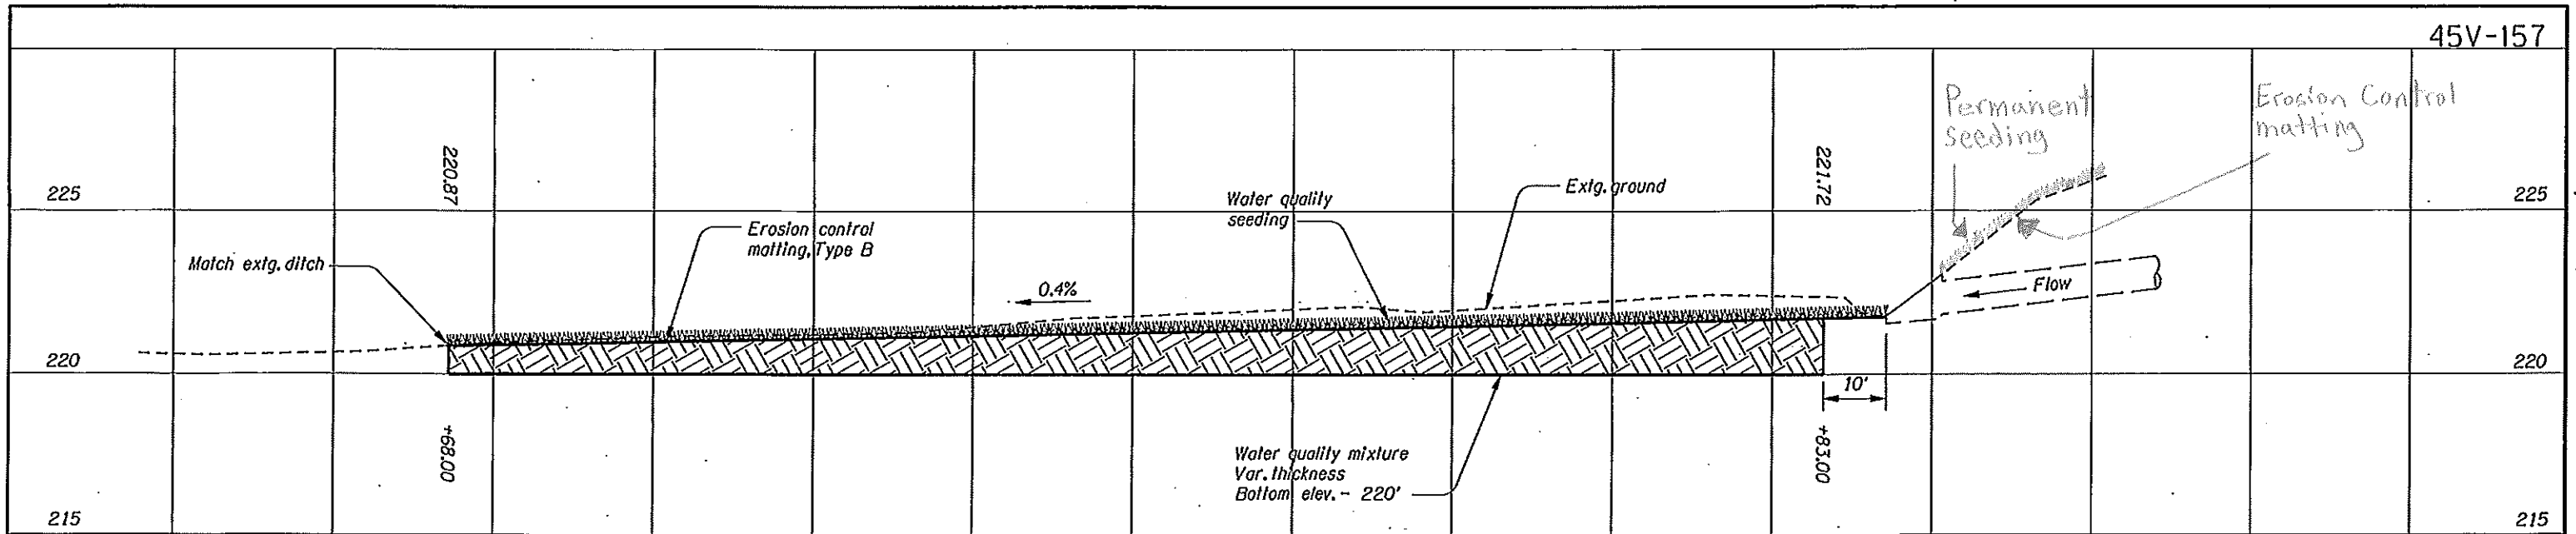

- Notes:
1. Water quality mixture shall be a blend of soil and medium compost mulch. Limits of mixture shown thus:  See Section 01012 for details.
 2. Elevations shown are at swale flow line (top of water quality mixture).
 3. Grade swale to match existing ditch beyond treatment length.
 4. See drg. no RD399 for Stormwater Treatment and Storage Facility Field Marker placement details.
 5. Retain and protect extg. fence.

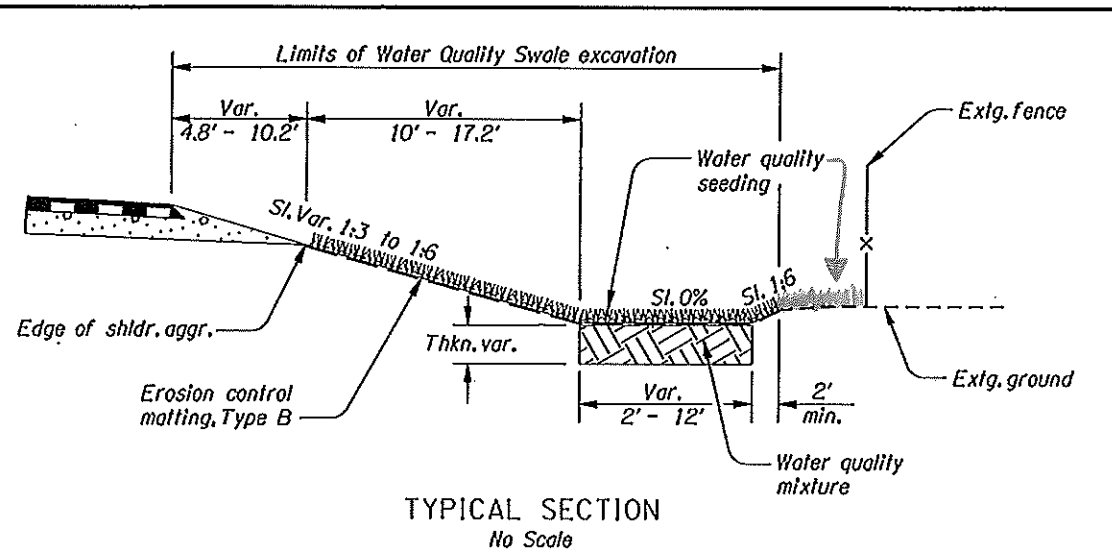


REVISED AS CONSTRUCTED
Gene Wilborn
GwW
 DATE 7/19/13
WATER QUALITY SWALE
 Scale: 1" = 25' Horz.
 1" = 5' Vert.
 (See Sheet 4B, Note 12)

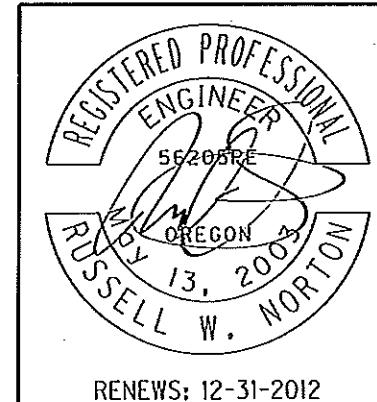

OREGON DEPARTMENT OF TRANSPORTATION	
QUINCY ENGINEERING, INC.	
1-5: SANTIAM HWY. O'XING SB LANES (ALBANY) SECTION PACIFIC HIGHWAY LINN COUNTY	
Design Team Leader - Russell W. Norton Designed By - Jeremy Mikkelsen Drafted By - Jeremy Mikkelsen	
DETAILS	SHEET NO. 2B-4


Sec. 9, T. 11 S., R. 3 W., W.M.
SANTIAM HIGHWAY INTERCHANGE

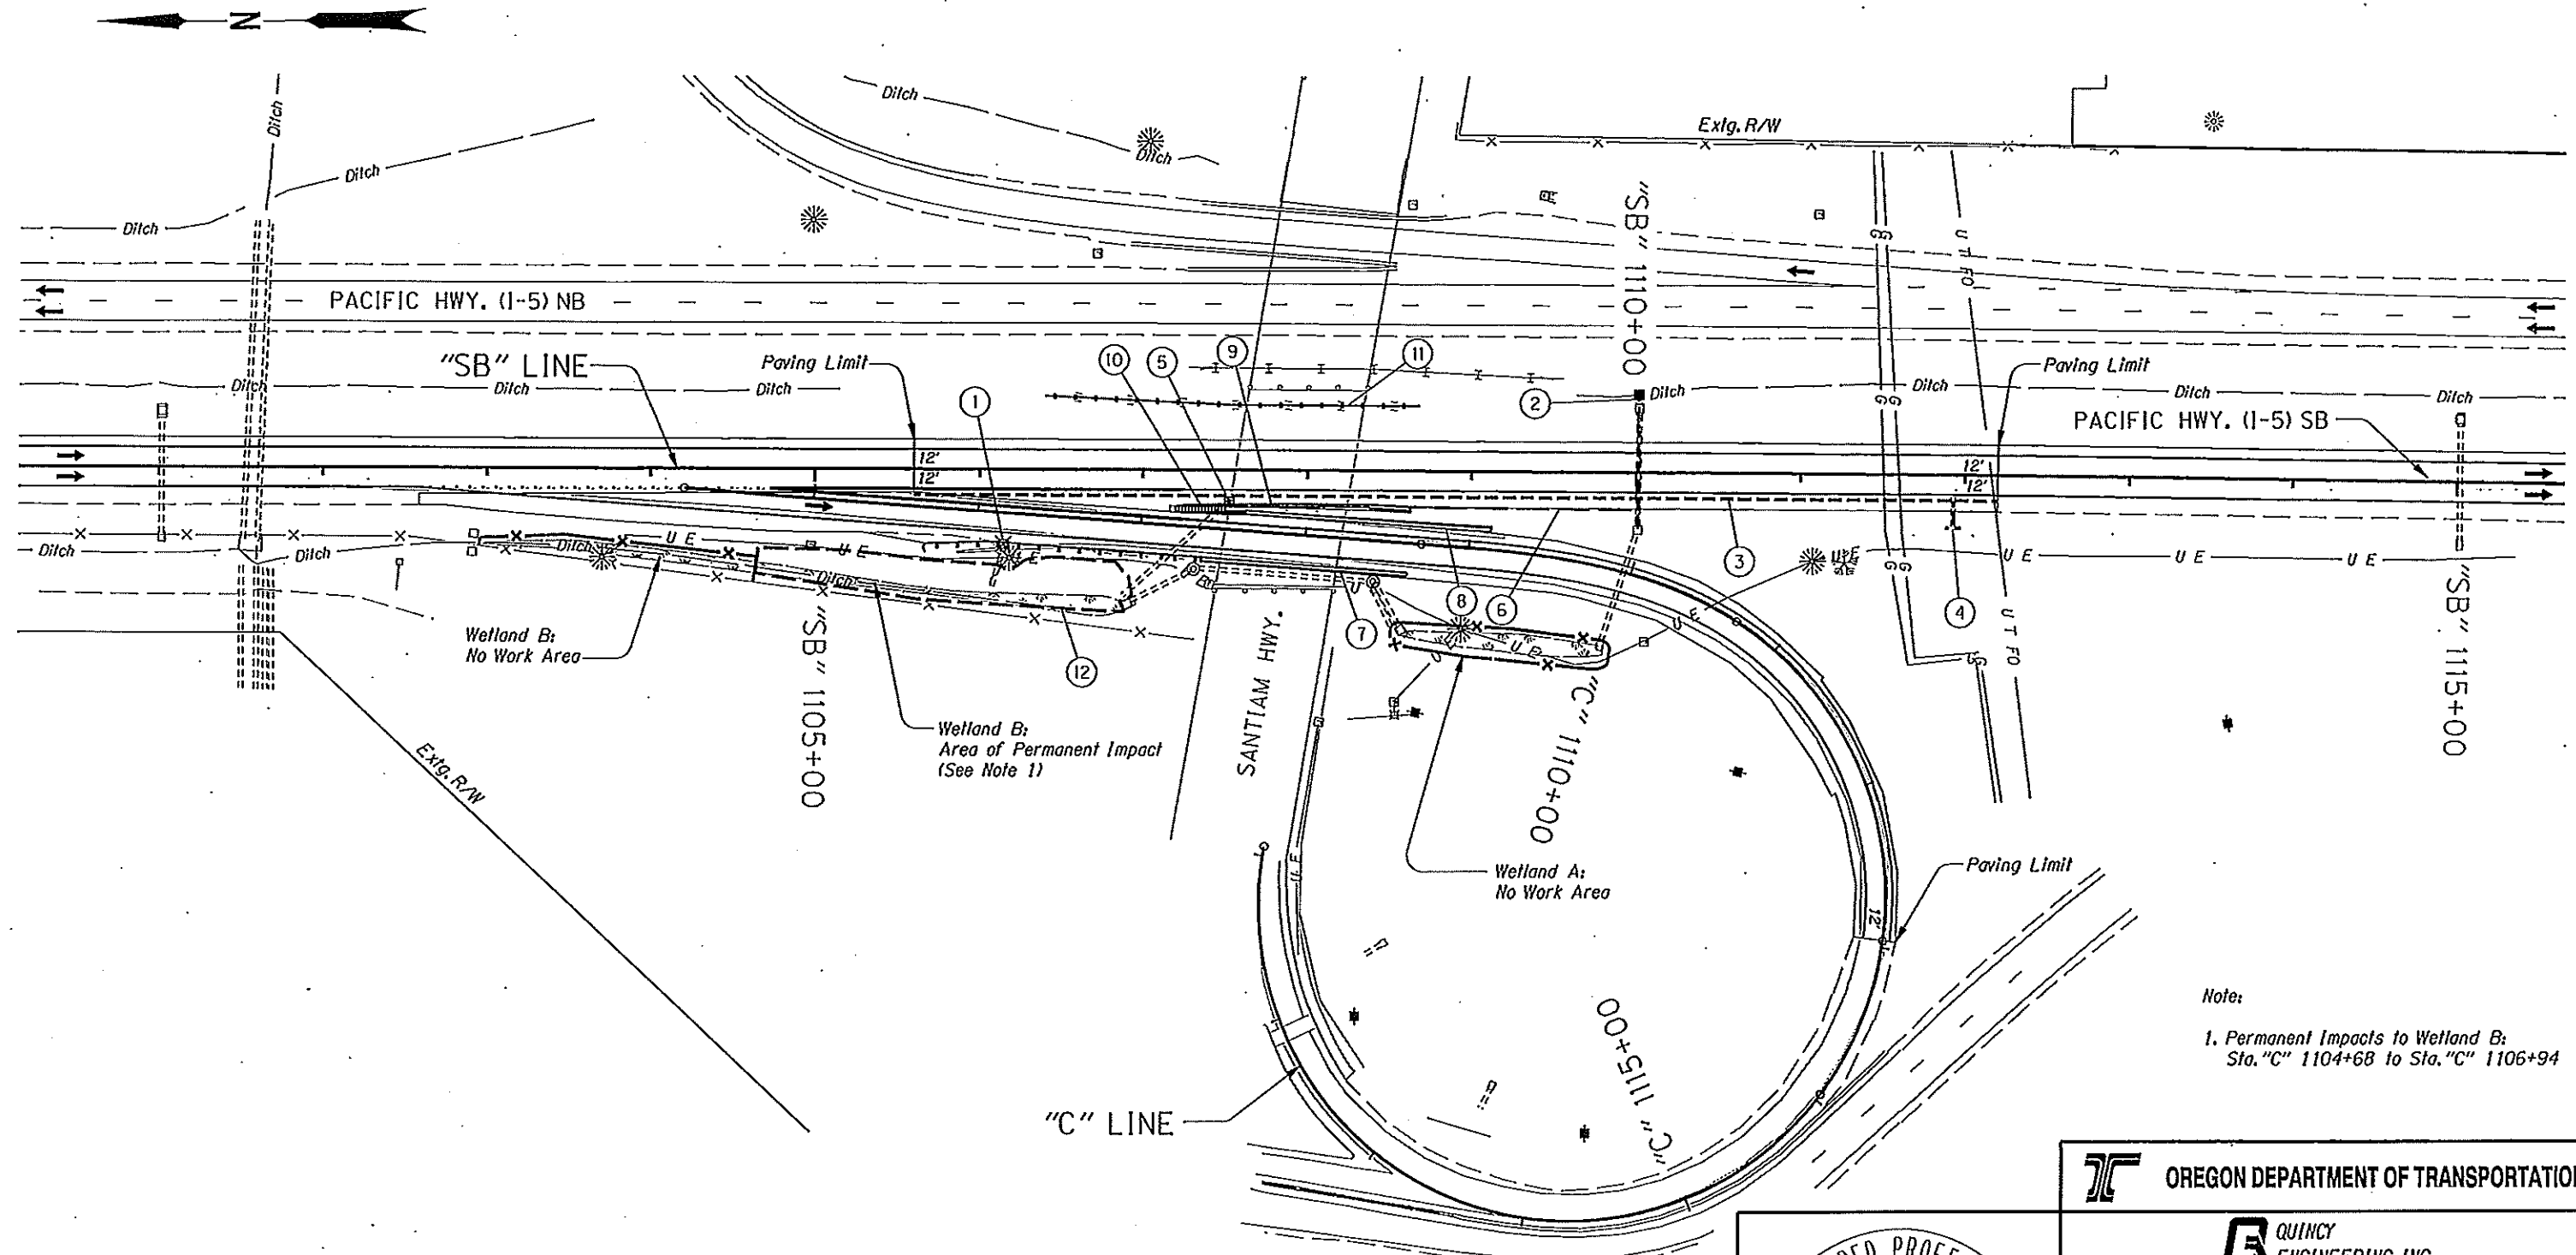

Note:
 1. Permanent Impacts to Wetland B:
 Sta. "C" 1104+68 to Sta. "C" 1106+94

NOT REVISED AS CONSTRUCTED

Gene Wilborn
JKW
 DATE 7/19/13

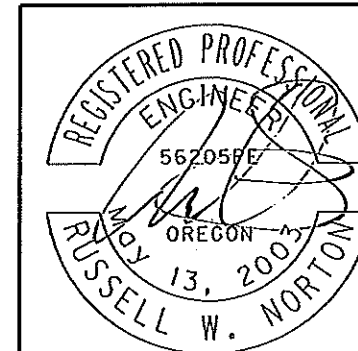

RENEWS: 12-31-2012

OREGON DEPARTMENT OF TRANSPORTATION

QUINCY ENGINEERING, INC.

**1-5: SANTIAM HWY. O'XING
 SB LANES (ALBANY) SECTION
 PACIFIC HIGHWAY
 LINN COUNTY**

Design Team Leader - Russell W. Norton
 Designed By - Jeremy Mikkelsen
 Drafted By - Jeremy Mikkelsen

GENERAL CONSTRUCTION

SHEET
NO.
4A


Sec. 9, T. 11 S., R. 3 W., W.M.
SANTIAM HIGHWAY INTERCHANGE

- ① Sta. "SB" 1106+15, Rt.
Remove inlet
Remove 12" CMP - 24'
- ② Sta. "SB" 1110+01, 47' Lt.
Remove Inlet
Remove 15" conc. pipe - 70'
Const. Type M-E inlet
Inst. 12" storm sewer pipe - 82'
5' depth
S = 0.005 f1/f1
IE (12" out) = 224.14'±
Connect to extg. inlet
IE (12" in) = 223.9'±
(See drg. nos. RD300, RD368, & RD386)
- ③ Sta. "SB" 1105+60 to Sta. "SB" 1112+20, Rt.
Inst. 4" subsurface drain pipe - 660'
(Connect to extg. pipe at ends of project)
Drainage geotextile, Type 1 - 318 sq. yd.
Granular drain material - 15 cu. yd.
(For details, see Sheet 2B)
- ④ Sta. "SB" 1111+93, Rt.
Const. subsurface drain outlet
(See drg. no. RD312)
- ⑤ Sta. "SB" 1107+52.50, Rt.
Adjust inlet
(See drg. nos. RD364 & RD376)
Connect 4" subsurface drain pipe to existing inlet
- ⑥ Sta. "SB" 1108+62 to Sta. "SB" 1110+02, Rt.
Const. low profile mountable curb
(See drg. no. RD700)
- ⑦ Sta. "C" 1108+88 to Sta. "C" 1110+13, Rt.
Remove extg. conc. shldr. barrier - 275'
~~Salvage and deliver to Agency~~
~~(See Section 00310.45 for details)~~
Remove earth mound
Const. tall conc. barrier - 125'
Const. guardrail - 100' (Type 2A)
Const. guardrail - 12.5' (Type 3)
Const. guardrail transition
Const. guardrail terminal, flared
Test Level 4
Flare rate=9.375:1, W=4', E=0'
(See drg. nos. RD400, RD405, RD410, RD415, RD420, & RD570)
- ⑧ Sta. "C" 1109+00 to Sta. "C" 1110+63, Lt.
Remove extg. conc. shldr. barrier - 172'
~~Salvage and deliver to Agency~~
~~(See Section 00310.45 for details)~~
Const. tall conc. barrier, narrow base - 12.5'
Const. tall conc. barrier - 150'
Flare rate=0, E=2'
Backfill between barriers with aggregate base - 120 tons
(See drg. no. RD545 & Sheet 2B-3 for details)
- ⑨ Sta. "SB" 1107+50 to Sta. "SB" 1108+63, Rt.
Remove extg. conc. shldr. barrier - 75'
~~Salvage and deliver to Agency~~
~~(See Section 00310.45 for details)~~
Const. tall conc. barrier, narrow base - 87.5'
Const. tall conc. barrier - 25'
Flare rate=0, E=0'
(See drg. no. RD545)
- ⑩ Sta. "SB" 1107+50, Rt.
Remove extg. impact attenuator and backup wall
Inst. impact attenuator, Type K
Const. conc. base and backup wall
(For details, see Sheet 2B-3)
- ⑪ Sta. "SB" 1106+60 to Sta. "SB" 1108+50, Lt.
Remove cable barrier system
Const. TL-3 cable barrier system - 225'
- ⑫ Sta. "SB" 1104+68 to Sta. "SB" 1106+94, Rt.
Const. water quality swale
w/ 12' flat bottom, 1:6 slopes
Type B erosion control matting - 673' sq. yd.
(For details, see Sheet 2B-4 & drg. no. RD1055)

REVISED AS CONSTRUCTED

Gene Wilborn

Gene Wilborn
DATE 7/19/13

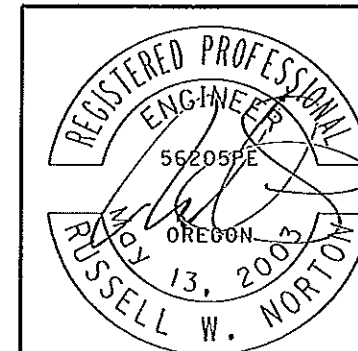

RENEWS: 12-31-2012

OREGON DEPARTMENT OF TRANSPORTATION

QUINCY ENGINEERING, INC.

**I-5: SANTIAM HWY. O'XING
SB LANES (ALBANY) SECTION
PACIFIC HIGHWAY
LINN COUNTY**

Design Team Leader - Russell W. Norton
Designed By - Jeremy Mikkelsen
Drafted By - Jeremy Mikkelsen

NOTES

SHEET NO.
4B