

OPERATION & MAINTENANCE MANUAL

DFI No. : D00646

Facility Type: Water Quality Porous
Pavement



December, 2018

1. Identification

Drainage Facility ID (DFI): **D00646**
Facility Type: Water Quality Porous Pavement
Construction Drawings: 43V-178
Location: District: 08
Highway No.: 025
Mile Post: 2.07; 2.55 (beg./end); Right
Description: This facility is located along the north side of westbound US 199. It can be identified as the multi-use path adjacent to the highway.

2. Facility Contact Information

Contact the Engineer of Record, Region Technical Center, or Geo-Environmental's Senior Hydraulics Engineer for:

- Operational clarification
- Maintenance clarification
- Repair or restoration assistance

Engineering Contacts:

Region Technical Center Hydro Unit Manager

Or

Geo-Environmental Senior Hydraulics Engineer (503) 986-3365.

3. Construction

Engineer of Record: Jason Sheadel – Region 3 Tech Center

Facility construction: 2013

Contractor: N/A

4. Storm Drain System and Facility Overview

Water quality treatment will be accomplished through the underlying water quality amended soils. A perforated drainpipe, installed in a subsurface drain below the water quality amended soils, will convey the treated stormwater from the water quality amended soils. The entire cross-section will be lined in an impermeable geotextile fabric. A permeable geotextile fabric will be installed between the subbase and amended soils as well as between the water quality amended soils and the subsurface drain to promote flow of water through the system without transporting materials between layers.

A. Maintenance equipment access:

This facility can be accessed from the north should of westbound US 199.

B. Heavy equipment access into facility:

- Allowed (no limitations)
- Allowed (with limitations)
- Not allowed

C. Special Features:

- Amended Soils
- Porous Pavers
- Liners
- Underdrains

5. Facility Haz Mat Spill Feature(s)

There are no Haz Mat spill featured designed into this facility.

6. Auxiliary Outlet (High Flow Bypass)

Auxiliary Outlets are provided if the primary outlet control structure can not safely pass the projected high flows. Broad-crested spillway weirs and over flow risers are the two most common auxiliary outlets used in stormwater treatment facility design. The auxiliary outlet feature is either a part of the facility or an additional storm drain feature/structure.

The auxiliary outlet feature for this facility is:

- Designed into facility
- Other

There are no auxiliary outlets built into this facility. In the event that flows exceed design flows the water will flow down the multi-use path surface and/or overtop the mountable curb and flow into the area behind the path..

7. Maintenance Requirements

Routine maintenance table for non-proprietary stormwater treatment and storage/detention facilities have been incorporated into ODOT's Maintenance Guide. These tables summarize the maintenance requirements for ponds, swales, filter strips, bioslopes, and detention tanks and vaults. Special maintenance requirements in addition to the routine requirements are noted below when applicable.

The ODOT Maintenance Guide can be viewed at the following website:

<http://www.oregon.gov/ODOT/HWY/OOM/MGuide.shtml>

Maintenance requirements for proprietary structures, such as underground water quality manholes and/or vaults with filter media are noted in Appendix C when applicable.

The following stormwater facility maintenance table (See ODOT Maintenance Guide) should be used to maintain the facility outlined in this Operation and Maintenance Manual or follow the Maintenance requirements outlined in Appendix C when proprietary structure is selected below:

- Table 1 (general maintenance)
- Table 2 (stormwater ponds)
- Table 3 (water quality biofiltration swales)
- Table 4 (water quality filter strips)
- Table 5 (water quality bioslopes)
- Table 6 (detention tank)
- Table 7 (detention vault)
- Appendix C (proprietary structure)
- Special Maintenance requirements: See following table.

Maintenance Component	Defect or Problem	Condition When Maintenance is Needed	Results Expected When Maintenance is Performed
General	Sediment accumulation	Collection of sediment is too coarse to pass through pavement.	Remove sediment deposits with high-pressure vacuum sweeper.
	Accumulation of leaves, needles, and other foliage	Accumulation on top of pavement is observed.	Remove with a leaf blower or high-pressure vacuum sweeper.
	Trash and debris	Trash and debris have accumulated on the pavement.	Remove by hand or with a high-pressure vacuum sweeper.
	Oil accumulation	Oil collection is observed on top of pavement.	Immediately remove with a vacuum sweeper and follow up by a pressure wash or other appropriate rinse procedure.
Visual Facility Identification	Not aware of permeable pavement location	Facility markers are missing or not readable.	Replace facility identification where needed.
Annual Minimum Maintenance			Remove potential void-clogging debris with a biannual or annual high-pressure vacuum sweeping.

Note: Special maintenance Requirements Require Concurrence from ODOT SR Hydraulics Engineer.

8. Waste Material Handling

9. Material removed from the facility is defined as waste by the Department of Environment Quality (DEQ). Refer to the roadwaste section of the ODOT Maintenance Yard Environmental Management System (EMS) Policy and Procedures Manual for disposal options:

http://www.oregon.gov/ODOT/Maintenance/Documents/ems_manual.pdf


Contact any of the following for more detailed information about management of waste materials found on site:

ODOT Clean Water Unit	(503) 986-3008
ODOT Statewide Hazmat Coordinator	(503) 667-7442
ODOT Region 1 Hazmat Coordinator	(503) 731-8290
ODOT Region 2 Hazmat Coordinator	(503) 986-2647
ODOT Region 3 Hazmat Coordinator	(541) 957-3594
ODOT Region 4 Hazmat Coordinator	(541) 388-6186
ODOT Region 5 Hazmat Coordinator	(541) 963-1590
ODEQ Northwest Region Office	(503) 229-5263

Appendix A

Content:

- **Operational Plan and Profile Drawing(s)**

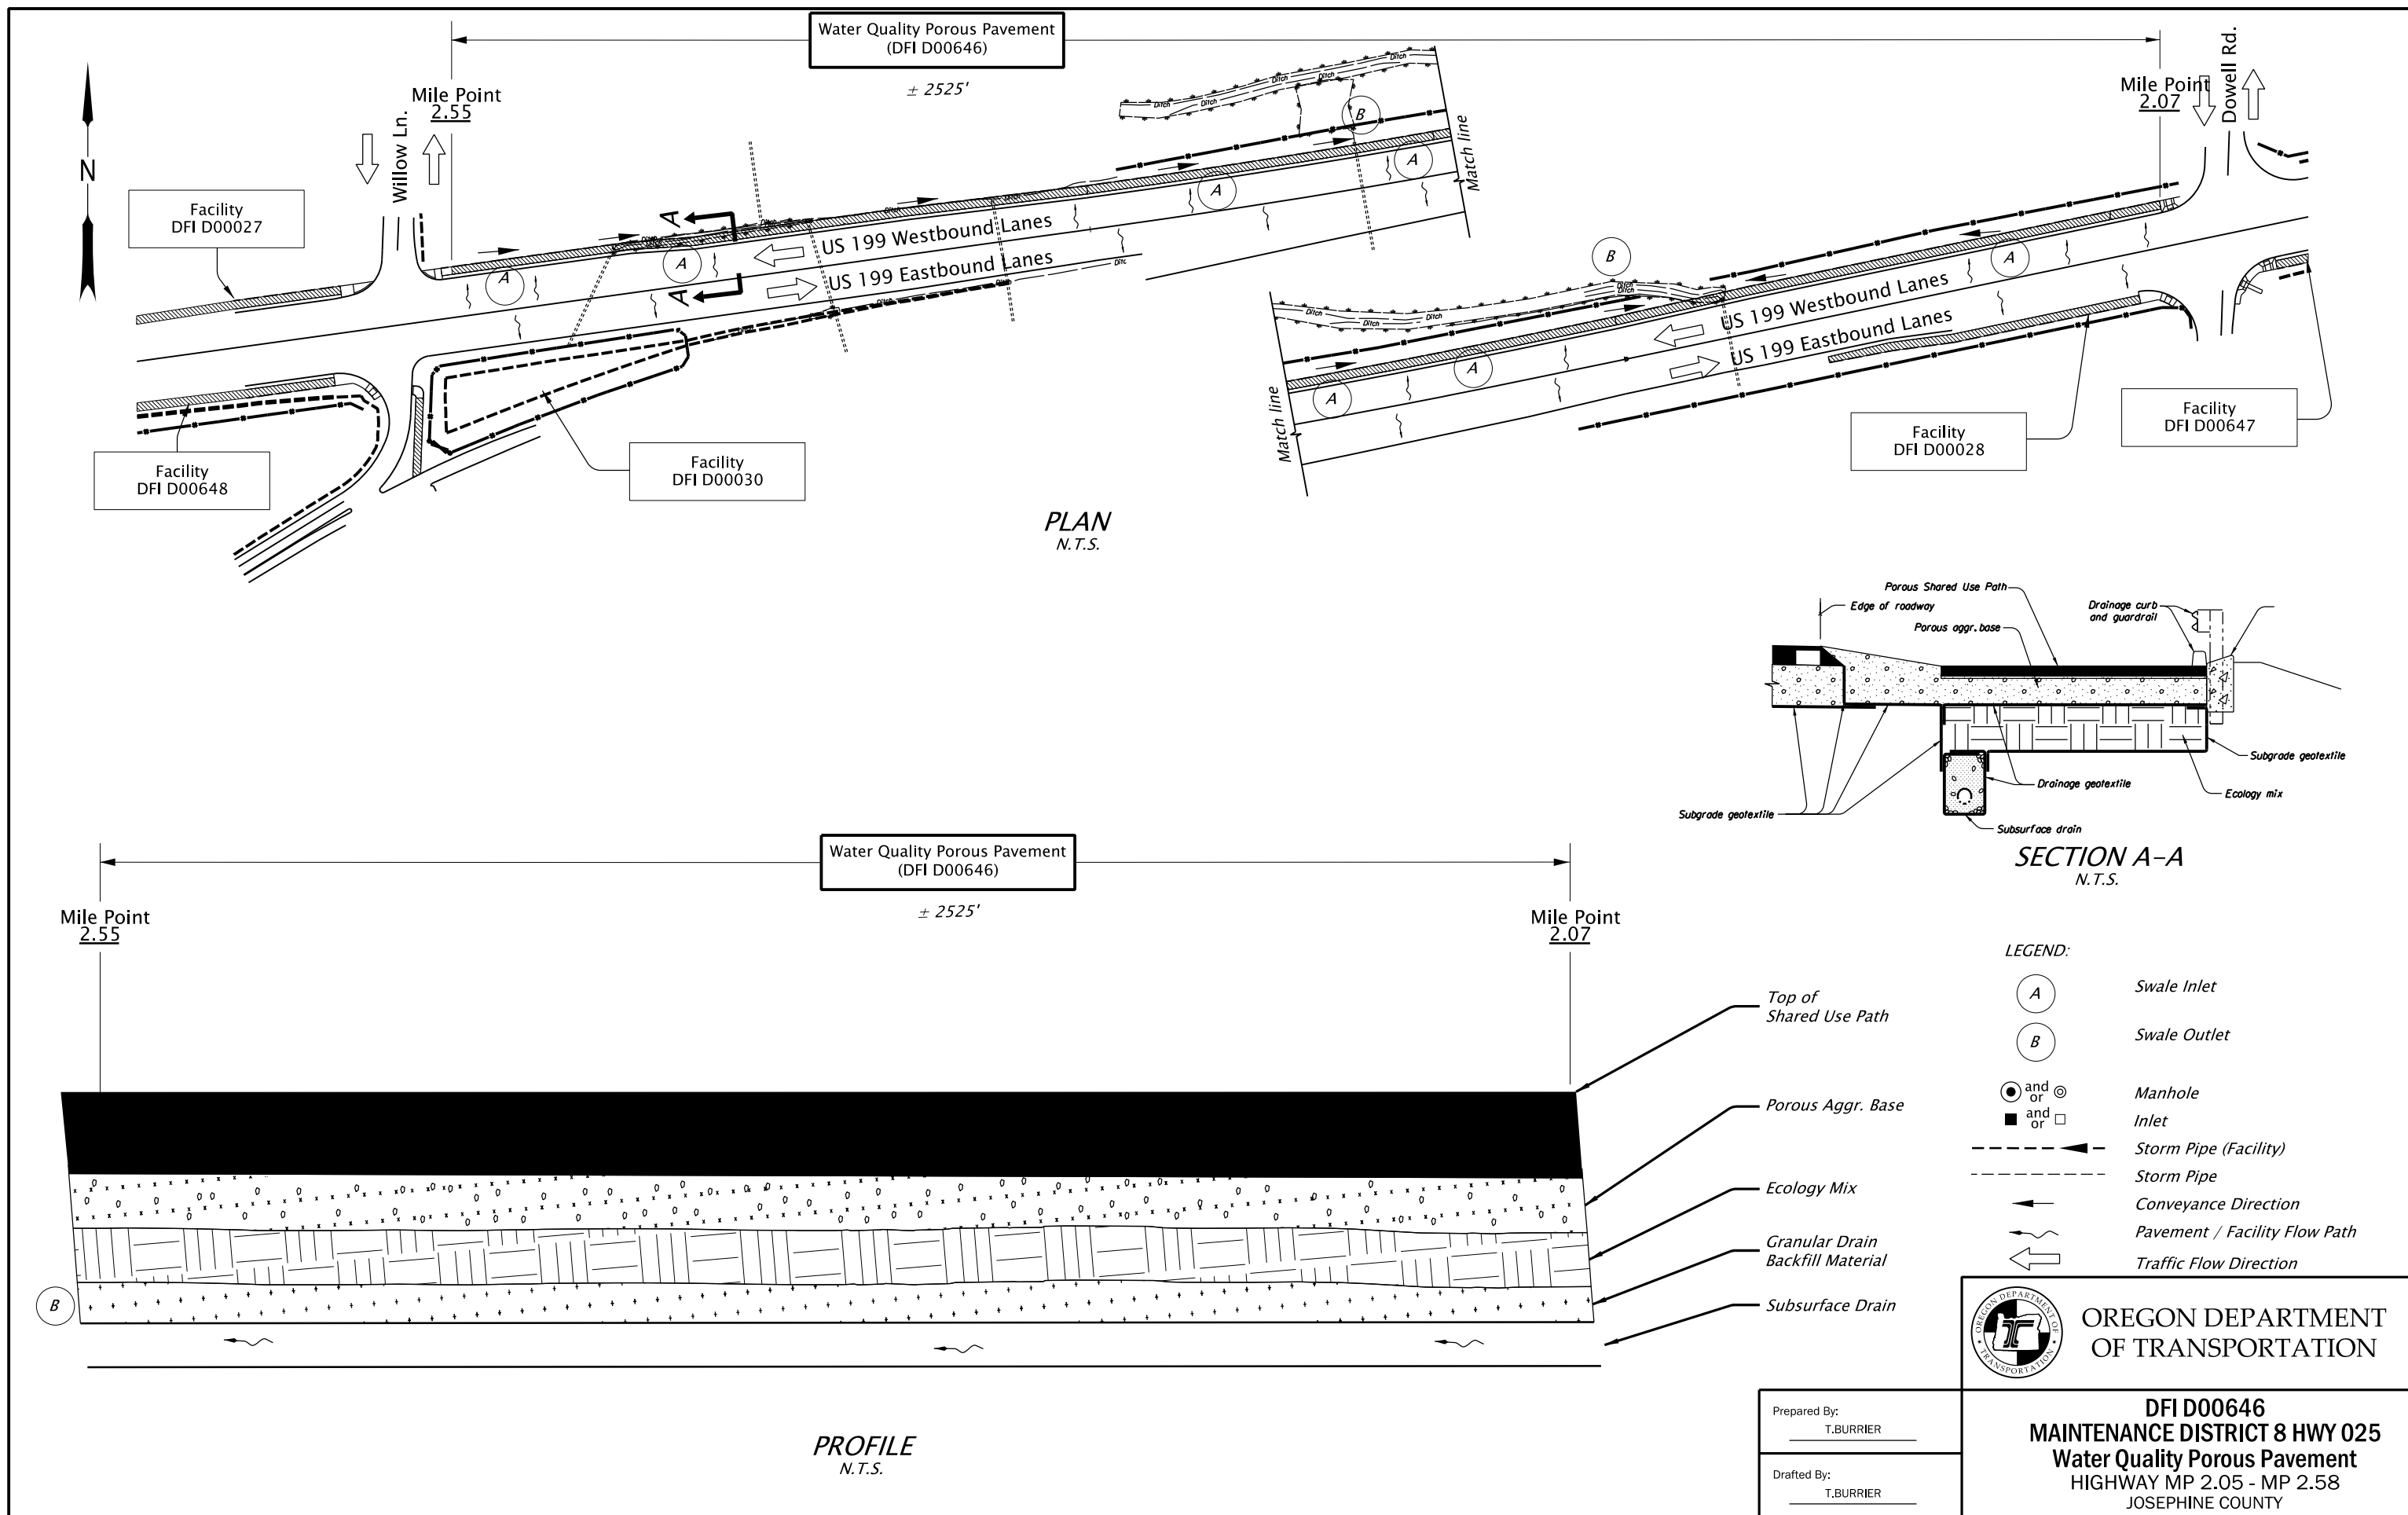

PLAN
N.T.S.

SECTION A-A
N.T.S.

PROFILE
N.T.S.

- LEGEND:
- (A) Swale Inlet
 - (B) Swale Outlet
 - and ○ Manhole
 - and □ Inlet
 - Storm Pipe (Facility)
 - Storm Pipe
 - ← Conveyance Direction
 - ↔ Pavement / Facility Flow Path
 - ↔ Traffic Flow Direction



Prepared By: T.BURRIER

Drafted By: T.BURRIER

DFI D00646
MAINTENANCE DISTRICT 8 HWY 025
Water Quality Porous Pavement
 HIGHWAY MP 2.05 - MP 2.58
 JOSEPHINE COUNTY

Appendix B

Content:

- **ODOT Project Plan Sheets**
 - *Cover/Title Sheet*
 - *Water Quality/Detention Plan Sheets*
 - *Other Details*

STATE OF OREGON
DEPARTMENT OF TRANSPORTATION

PLANS FOR PROPOSED PROJECT
GRADING, PAVING, DRAINAGE,
SIGNALS AND STRUCTURE

**US 199: DOWELL RD TO ROGUE
COMMUNITY COLLEGE**

REDWOOD HIGHWAY

JOSEPHINE COUNTY
DECEMBER 2010

**END OF PROJECT
STP-OTIA-S025(044)**

**BEGINNING OF PROJECT
STP-OTIA-S025(044)**

STA. "RW" 679+89.72 (M.P. 3.25) =
STA. "RH" 679+89.72 (M.P. 3.25). OFFSET 0

STA. "RW" 751+76.16 (M.P. 1.89) =
STA. "RH" 41+71.13, OFFSET 30.07' Lt.

EQUA. STA. "RH" 10+00.00 AH.
STA. "RH" 720+00.00 BK.


T.36S, R.06W, Sect. 24, W.M.
T.36S, R.06W, Sect. 25, W.M.
T.36S, R.06W, Sect. 26, W.M.
T.36S, R.06W, Sect. 27, W.M.

INDEX OF SHEETS	
SHEET NO.	DESCRIPTION
	Title Sheet
1A	Index Of Sheets Cont'd. & Std. Dwg. Nos.


AS CONSTRUCTED

Shywood 07/20/12
PROJECT INSPECTOR DATE

Don S. Don 7/20/02 #41759
890-7015

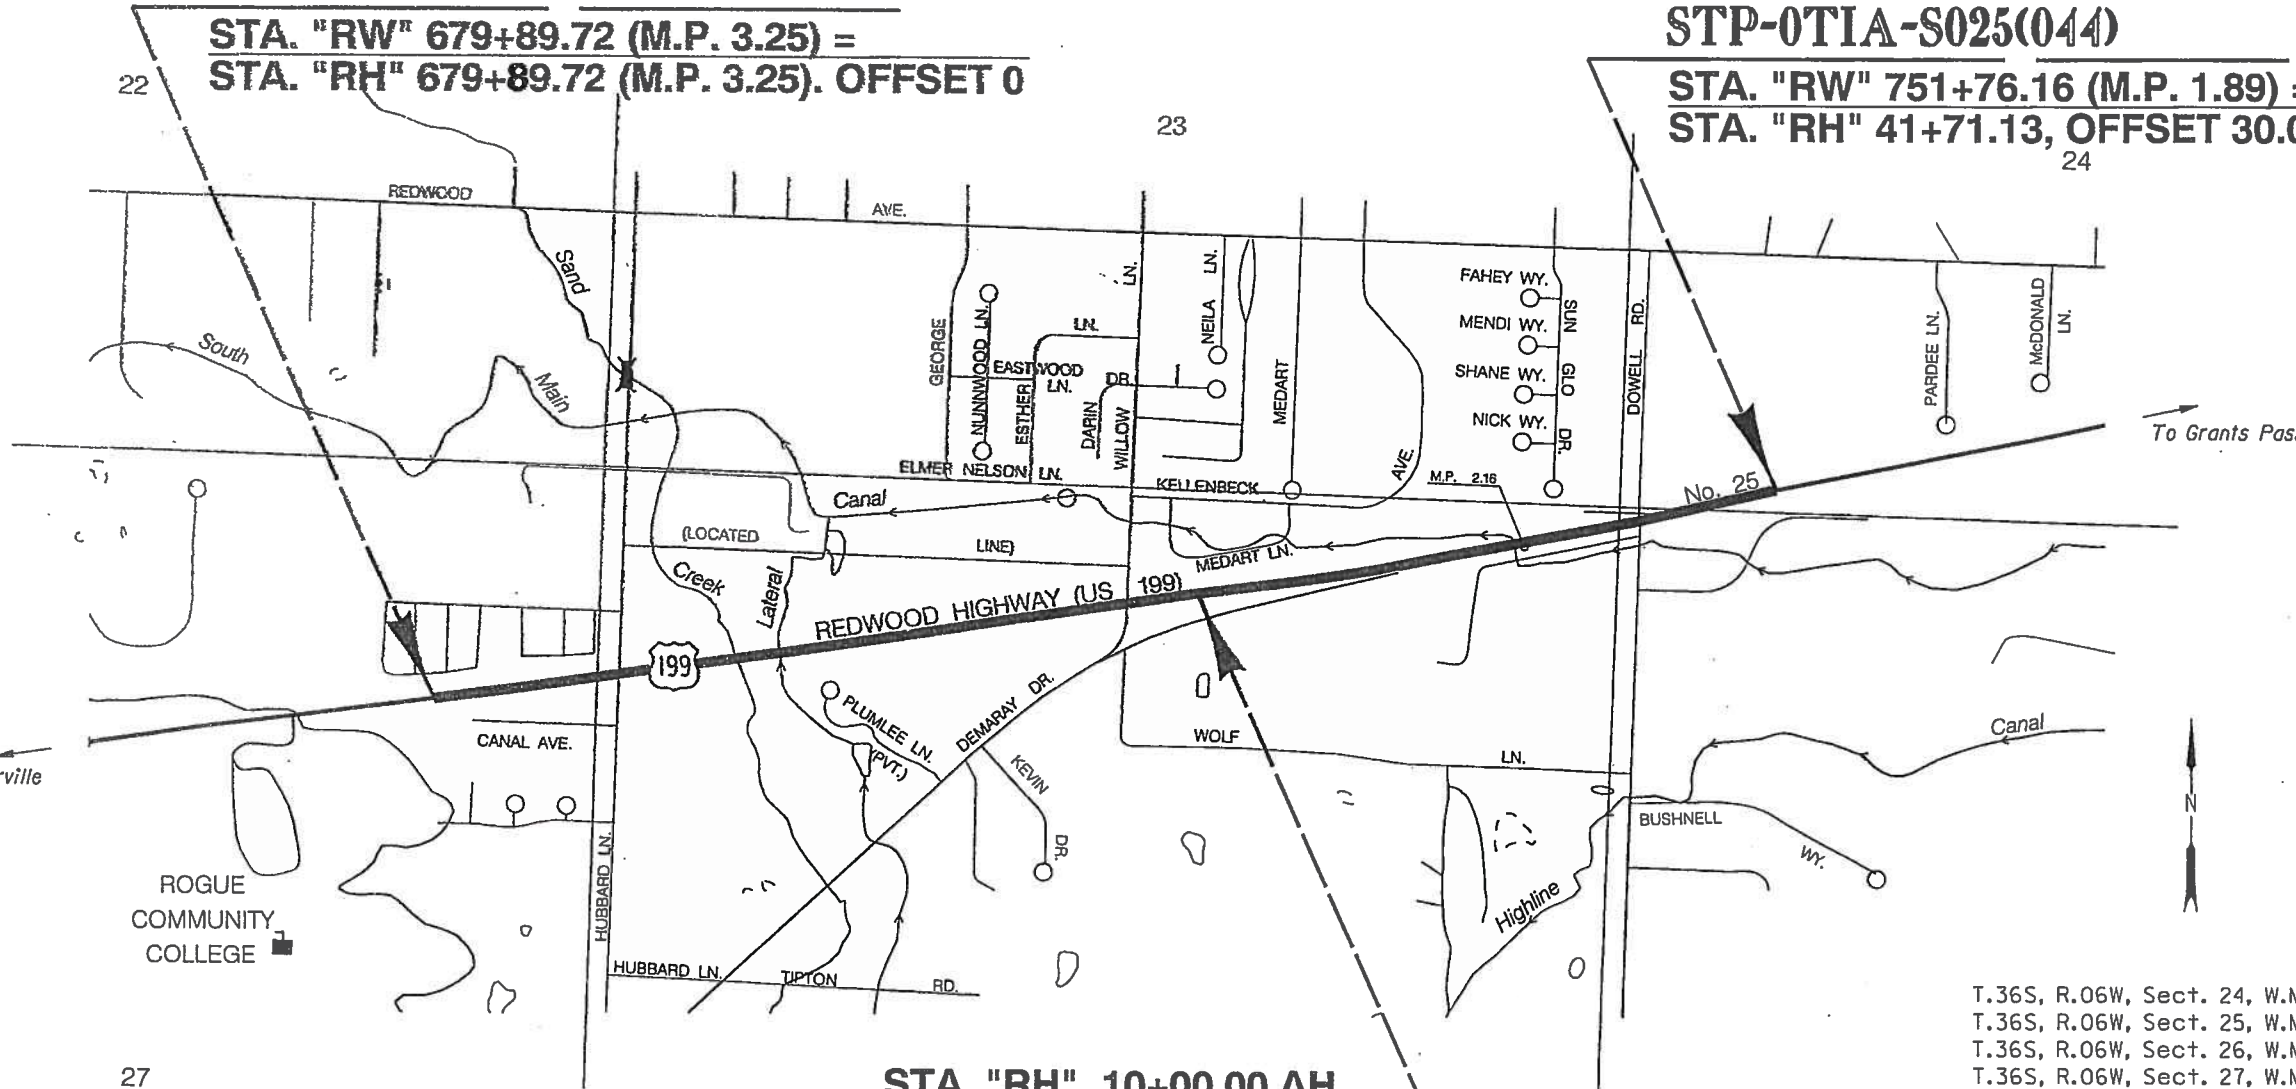

CC!
DISTRIBUTION
7/23/12 - GRID
7/28/12 - C.O.G.P.

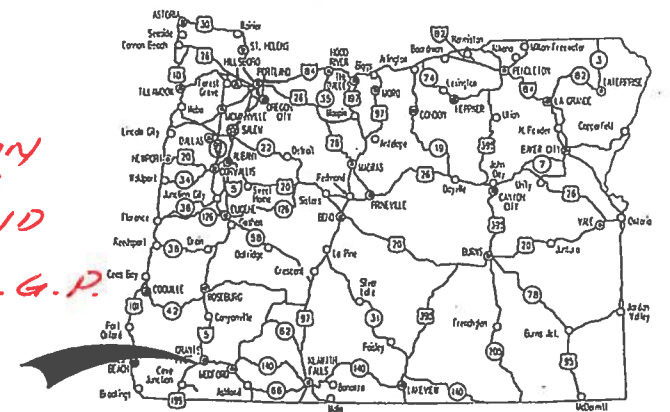

Overall Length Of Project - 1.36 Miles

ATTENTION:
Oregon Law Requires You To Follow Rules Adopted By The Oregon Utility Notification Center. Those Rules Are Set Forth In OAR 952-001-0010 Through OAR 952-001-0090. You May Obtain Copies Of The Rules By Calling The Center. (Note: The Telephone Number For The Oregon Utility Center Is (503) 232-1987.)

LET'S ALL
WORK TOGETHER
TO MAKE THIS
JOB SAFE

OREGON TRANSPORTATION COMMISSION
Gail Achterman CHAIR
Michael Nelson VICE-CHAIR
Mary F. Olson COMMISSIONER
Alan Brown COMMISSIONER
David Lohman COMMISSIONER
Matthew L. Garrett. DIRECTOR OF TRANSPORTATION

These plans were developed using ODOT design standards. Exceptions to these standards, if any, have been submitted and approved by the ODOT Chief Engineer or their delegated authority.

Approving Authority: *M. Thompson*
Signature & date 9-14-10
MARK THOMPSON, TECH CENTER MGR
Print name and title
Tom Trudell
Concurrence by ODOT Chief Engineer

US 199: DOWELL RD TO ROGUE COMMUNITY COLLEGE REDWOOD HIGHWAY JOSEPHINE COUNTY		
FEDERAL HIGHWAY ADMINISTRATION	PROJECT NUMBER	SHEET NO.
OREGON DIVISION	STP-OTIA-S025(044)	1

INDEX OF SHEETS, CONT'D.	
SHEET NO.	DESCRIPTION
3RW thru 7RW	Right of Way
2 thru 2A-16	Typical Sections
2B thru 2B-6	Details
2C	Traffic Control Plan
2D, 2D-1	Pipe Data Sheet
3 thru 10D	Alignment & General Const., Profiles, Drainage
GEO/HYDRO	
GA thru GA-8	Erosion Control
GC-1, GC-2	Retaining Wall Plan & Elevation
GE thru GE-4	Sand Creek Box Culvert Extension
GG	Temporary Water Management
GJ thru GJ-9	Detention Pond & Drainage Details
GN-1 thru GN-6	Roadside Development
PERMANENT PAVEMENT MARKINGS	
ST1 thru ST8	Striping Plan
PERMANENT SIGNING	
S-12160 thru S-12169	Signing Plans
TRAFFIC SIGNALS	
15673 thru 15684	Signal Plans

Standard Dwg. Nos.

- RD100
- RD101
- RD230
- RD300
- RD302
- RD312
- RD314
- RD317
- RD318
- RD336, RD340, RD344, RD346
- RD348
- RD356
- RD360
- RD364, RD370, RD372
- RD374
- RD376
- RD386, RD388, RD390
- RD400, RD405, RD410, RD415, RD420, RD450, RD470
- RD500
- RD510
- RD515
- RD516
- RD530

RD
 342 Shallow manholes
 362 Sawtooth
 Clearout

- RD610
- RD700, RD701
- RD705
- RD706
- RD715
- RD720
- RD750
- RD755
- RD757
- RD759
- RD810
- RD815
- RD1000
- RD1005
- RD1010, RD1015
- RD1025
- RD1040
- RD1055
- BR720
- BR800
- BR805
- BR840, BR841
- TM200
- TM201
- TM204
- TM206
- TM211
- TM221, TM222
- TM223, TM224
- TM230, TM231, TM233
- TM450
- TM457
- TM458
- TM460
- TM462
- TM465
- TM467
- TM470
- TM472
- TM482
- TM485
- TM488

- Asphalt Pavement Details
- Curbs
- Islands
- Traffic Separators And Transitions
- Approaches And Non-Sidewalk Driveways
- Sidewalks
- Curb Line Sidewalk Driveways - Local Jurisdictions
- Sidewalk Ramp Details
- Sidewalk Ramp Placement
- Truncated Dome Detectable Warning Surface Details And Locations
- Barbed and Woven Wire Fences
- Chain Link Fence
- Construction Entrances
- Check Dams
- Inlet Protection
- Sediment Barrier (Type 1)
- Sediment Fence
- Matting
- Standard Gravity Retaining Wall Details
- Box Culvert Wingwalls Details
- Box Culvert Extensions Details
- Standard Double Box Culvert Details
- Sign Installation Details
- Miscellaneous Sign Placement Details
- Flag Board Mounting Details
- Sign Bracing Detail
- Signing Details
- Milepost Marker Details
- Directional Sign Layout
- Mounting Details For Removable Legend
- Mast Arm Pole Details
- Vehicle, Ped. Signal & Push Button Mounting Details
- Pedestrian Ramp Placement Details
- Vehicle Signal Details
- Adjustable Signal Head Mounting Details
- Overhead Sign, Fire Preemption & Photoelectronic Details
- Ped. Signal And Ped. Push Button Details
- Color Code Charts
- Traffic Signal Junction Boxes
- Controller Cabinet And Foundation Details
- Service Cabinets And Service Cabinet Wiring Details
- Terminal Cabinet Detail


- TM500, TM501, TM502, TM503
- TM515
- TM517
- TM521
- TM525
- TM530
- TM539
- TM570
- TM571
- TM576
- TM602
- TM629, TM630
- TM635
- TM650, TM651, TM652, TM653
- TM670
- TM671
- TM675
- TM676
- TM677
- TM678
- TM679
- TM680
- TM681, TM687, TM688
- TM800
- TM820
- TM821
- TM830
- TM831
- TM841
- TM842
- TM843
- TM850
- TM851, TM852

- Pavement Marking Standard Details
- Raised Pavement Markers
- Recessed Pavement Markers
- Durable Pavement Markings Method "B" Extruded & Method "F" Spray
- Turn Arrow Marking Details
- Intersection Pavement Markings
- Median And Left Turn Channelization Details
- Traffic Delineators
- Traffic Delineators Steel Post Details
- Traffic Delineator Installation
- Triangular Base Breakaway Multi-Direction Slip Base
- Slip Base & Fixed Base Luminaire Supports
- Breakaway Sign & Luminaire Supports
- Traffic Signal Supports
- Perm. Signing Wood Post Supports Sizing Charts
- 3 Second Gust Wind Speed Isotach
- Extruded Aluminum Panels
- Sign Attachments
- Sign Mounts
- Secondary Sign Mounting Details
- Signal Mast Arm Street Name Sign Mounts
- Signal Pole Mounts
- Square Tube Sign Supports
- Tables, Abrupt Edge And PCMS Details
- Temporary Barricades
- Temporary Sign Supports
- Temporary Concrete Barrier And Rumble Strips
- Temporary Impact Attenuators
- Intersection Work Zone Details
- Signalized Intersection Details
- Multi-Lane Signalized Intersection Details
- 2-Lane, 2 Way Roadways
- Non-Freeway Multi-Lane Sections


R/W Map No. 11B-04-04

US 199 DOWELL RD TO ROGUE COMMUNITY COLLEGE REDWOOD HIGHWAY JOSEPHINE COUNTY		
FEDERAL HIGHWAY ADMINISTRATION	PROJECT NUMBER	SHEET NO.
OREGON DIVISION	STP-0TIA-S025(044)	1A

Standard Drawings located on the web at:
http://www.oregon.gov/ODOT/HWY/ENGSERVICES/standard_drawings_home.shtml

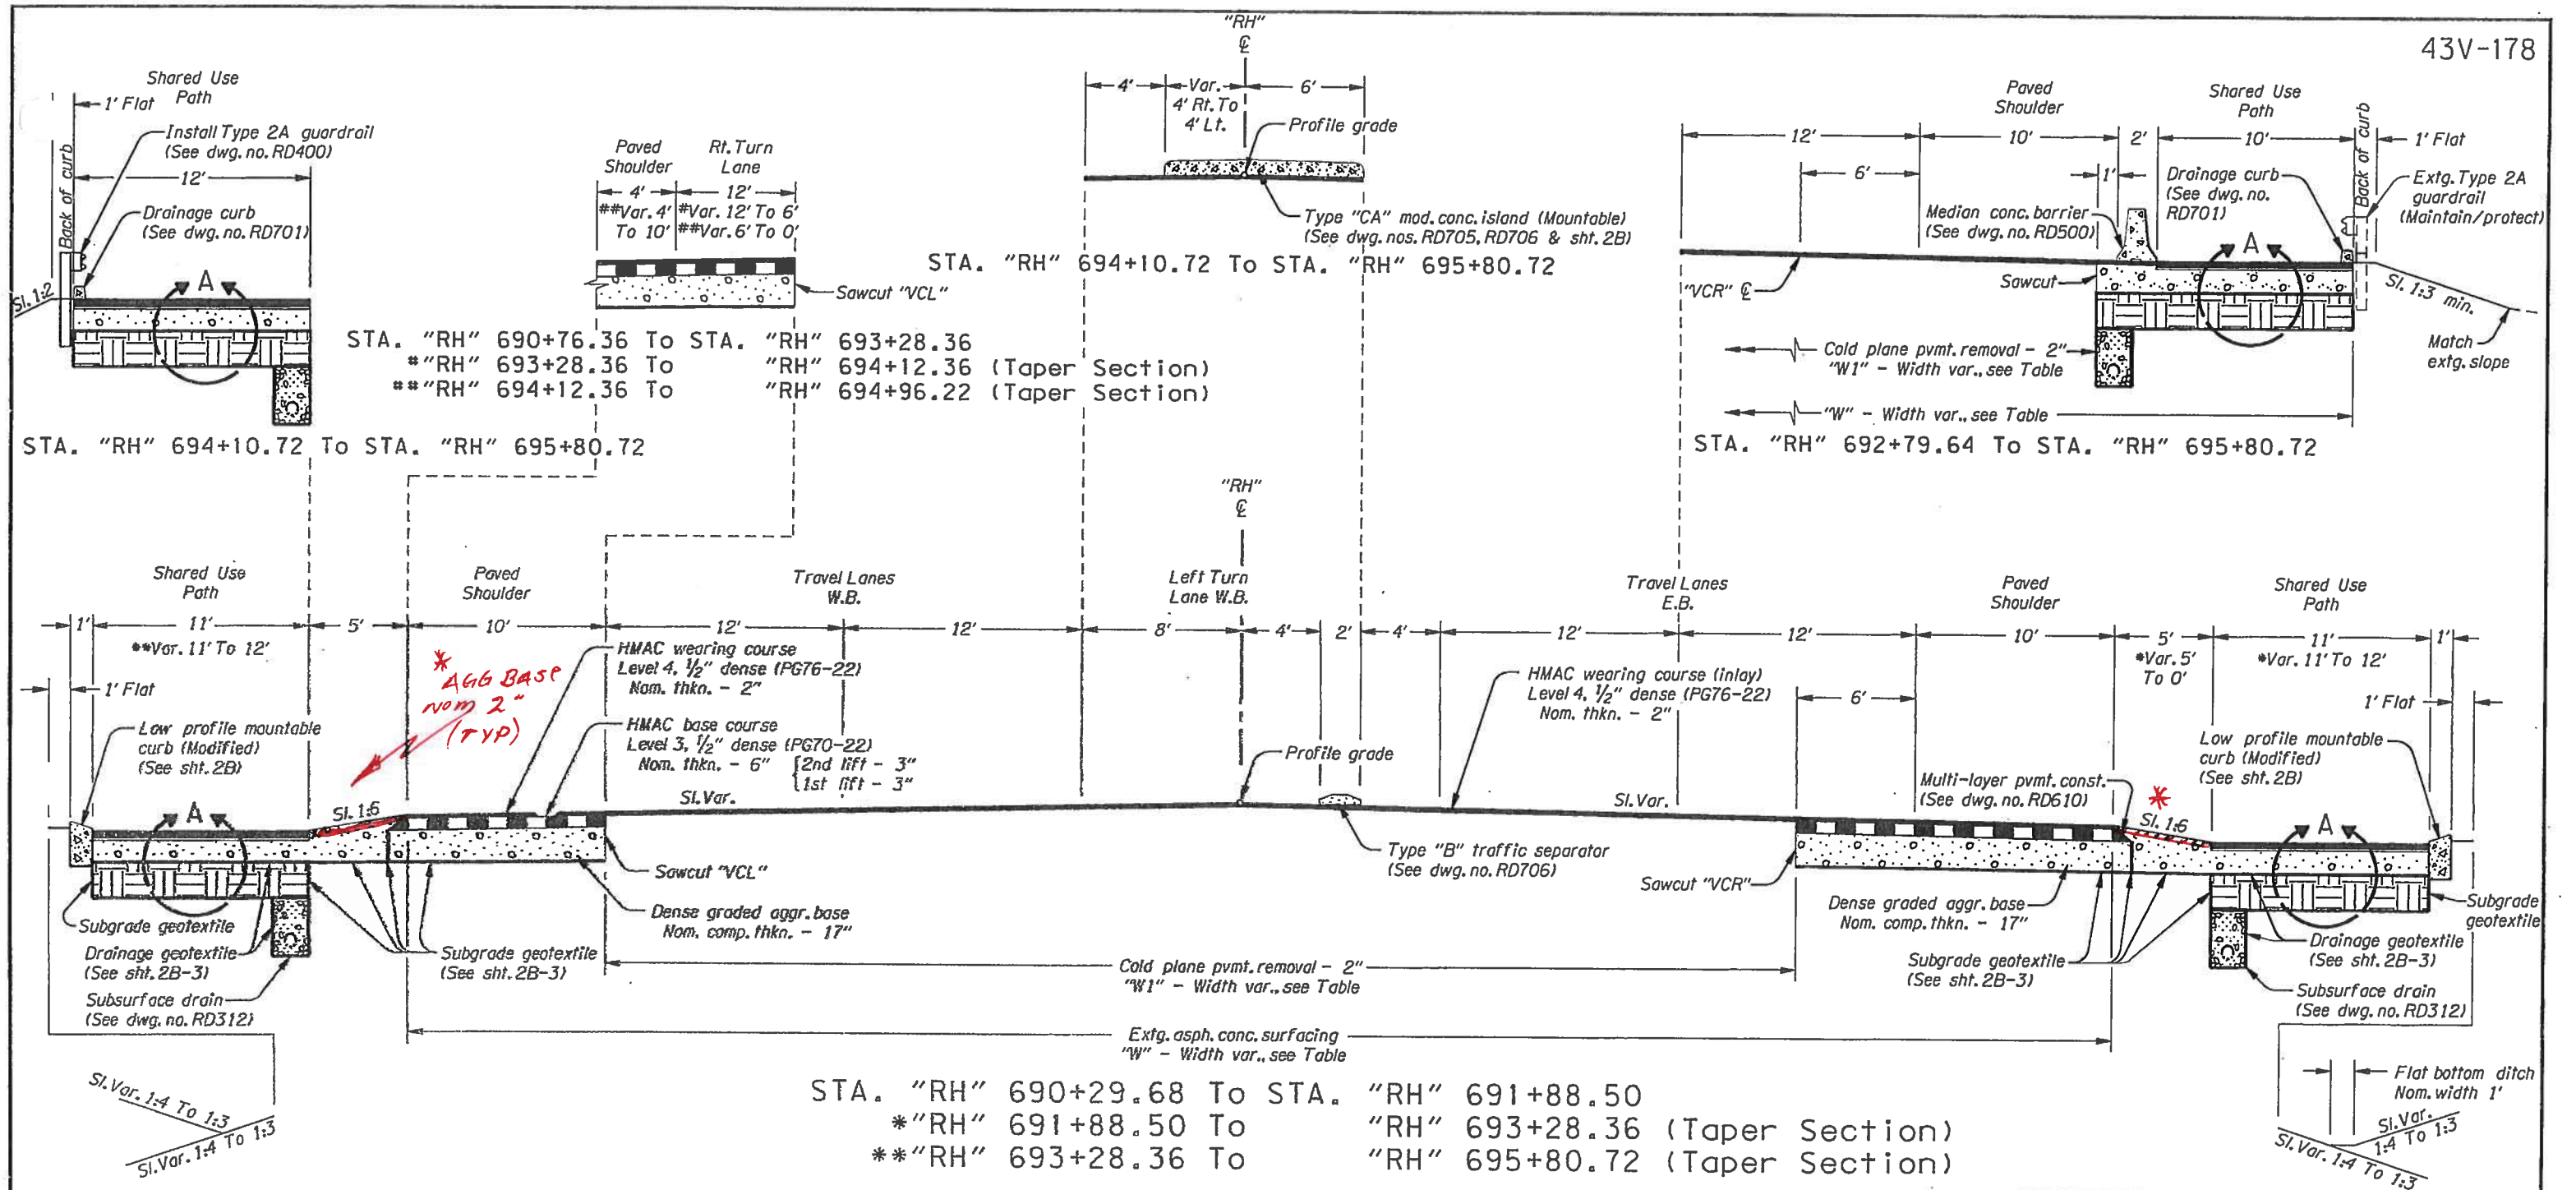


STA. To	STA.	"W"	"W1"
690+29.68	691+88.50	96.31' To 85.13'	60'
691+88.50	692+79.64	85.13' To 81.7'	60'
692+79.64	693+28.36	97.4' To 96.0'	75'
693+28.36	694+10.72	96.0' To 96.5'	75'
694+10.72	695+80.72	96.0' To 98.0'	75'

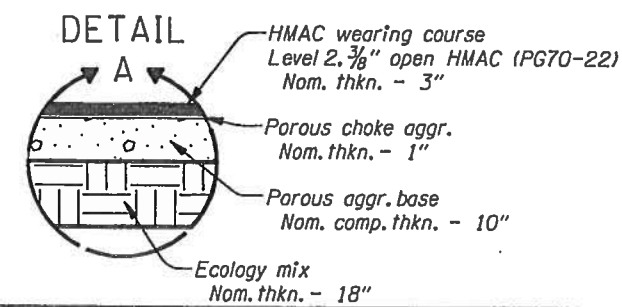


REGISTERED PROFESSIONAL ENGINEER
 56199PE
 J. M. Sheadel
 OREGON
 JAN. 8, 2009
 JASON N. SHEADEL
 EXPIRES: JUNE 30, 2012

OREGON DEPARTMENT OF TRANSPORTATION
 REGION 3 - TECHNICAL CENTER
 US 199-DOWELL RD TO ROGUE COMMUNITY COLLEGE
 REDWOOD HIGHWAY JOSEPHINE COUNTY
 Design Team Leader - James Burford
 Designed By - Jason Sheadel
 Drafted By - Judy Hardin
TYPICAL SECTIONS
 SHEET NO. 2A

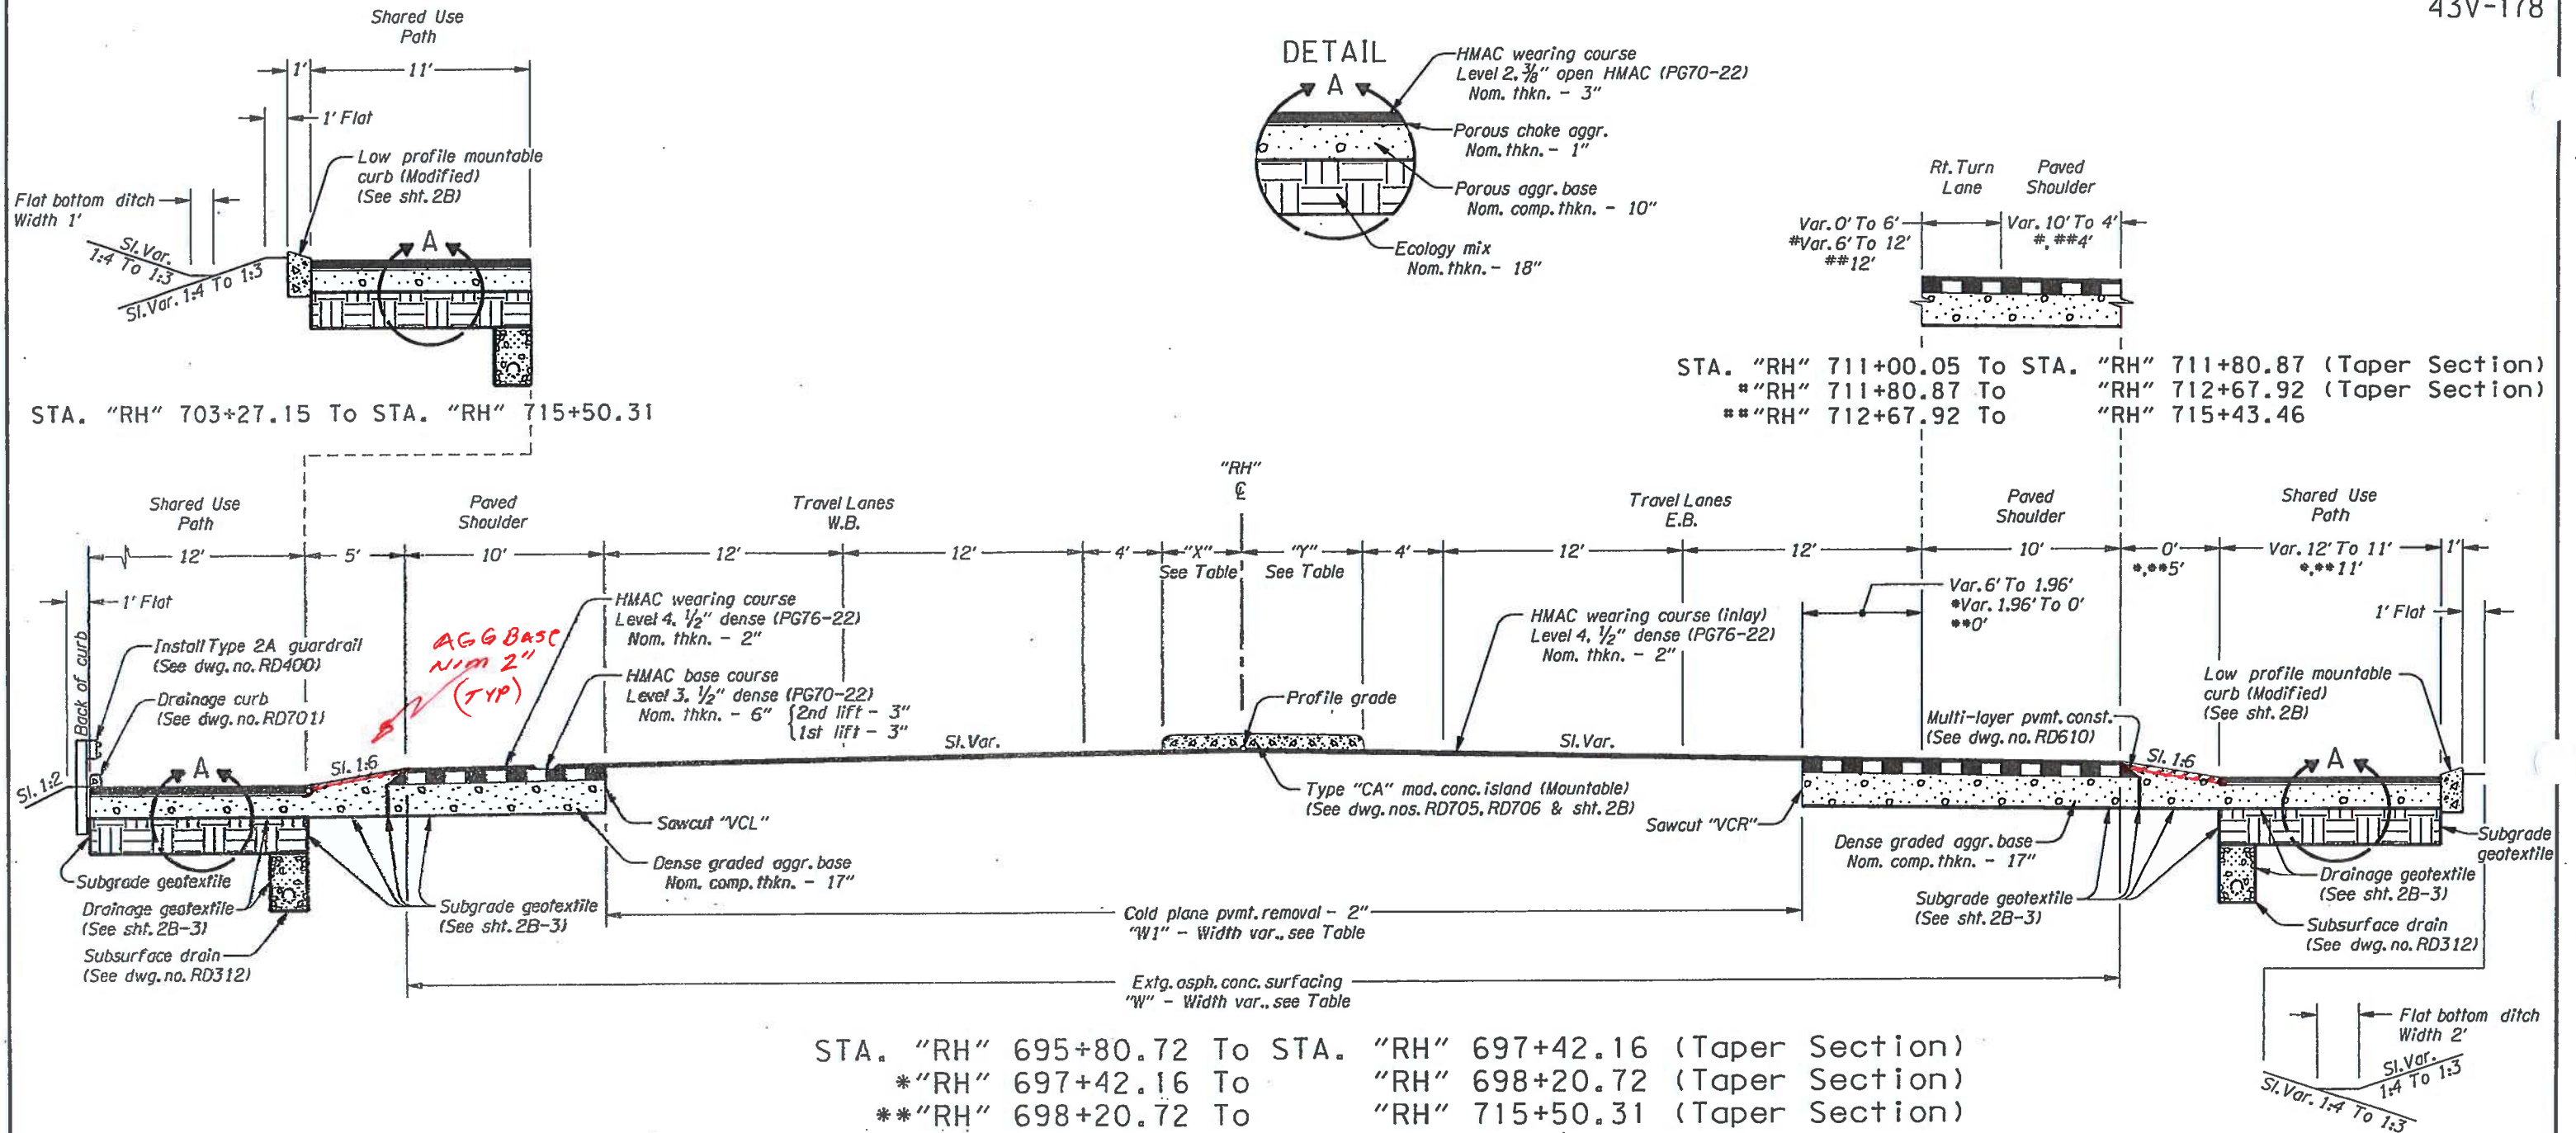

STA. To	STA.	"W"	"W1"	"X"	"Y"
695+80.72	697+42.16	98.0' To 97.6'	60.0' To 61.6'	4' To 3.61'	6' To 3.98'
697+42.16	698+20.72	81.3' To 80.9'	61.6' To 62.4'	3.61' To 3.43'	3.98' To 3'
698+20.72	700+00.72	80.9' To 80.1'	62.4' To 62.0'	3.43' To 3'	3'
700+00.72	703+27.15	80.1' To 80.6'	62'	3'	3'
703+27.15	711+25.21	80.6' To 80.4'	62'	3'	3'
711+25.21	714+25.21	80.4' To 92.3'	62.0' To 72.0'	3' To 8'	3' To 8'
714+25.21	715+50.31	92.3' To 94.0'	72'	8'	8'

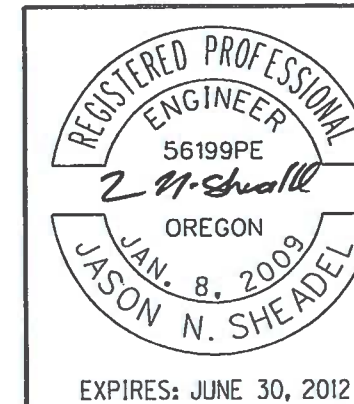

OREGON DEPARTMENT OF TRANSPORTATION


REGION 3 - TECHNICAL CENTER

US 199 DOWELL RD TO
ROGUE COMMUNITY COLLEGE
REDWOOD HIGHWAY
JOSEPHINE COUNTY

Design Team Leader - James Burford
Designed By - Jason Sheadel
Drafted By - Judy Hardin


TYPICAL SECTIONS

SHEET NO. 2A-2

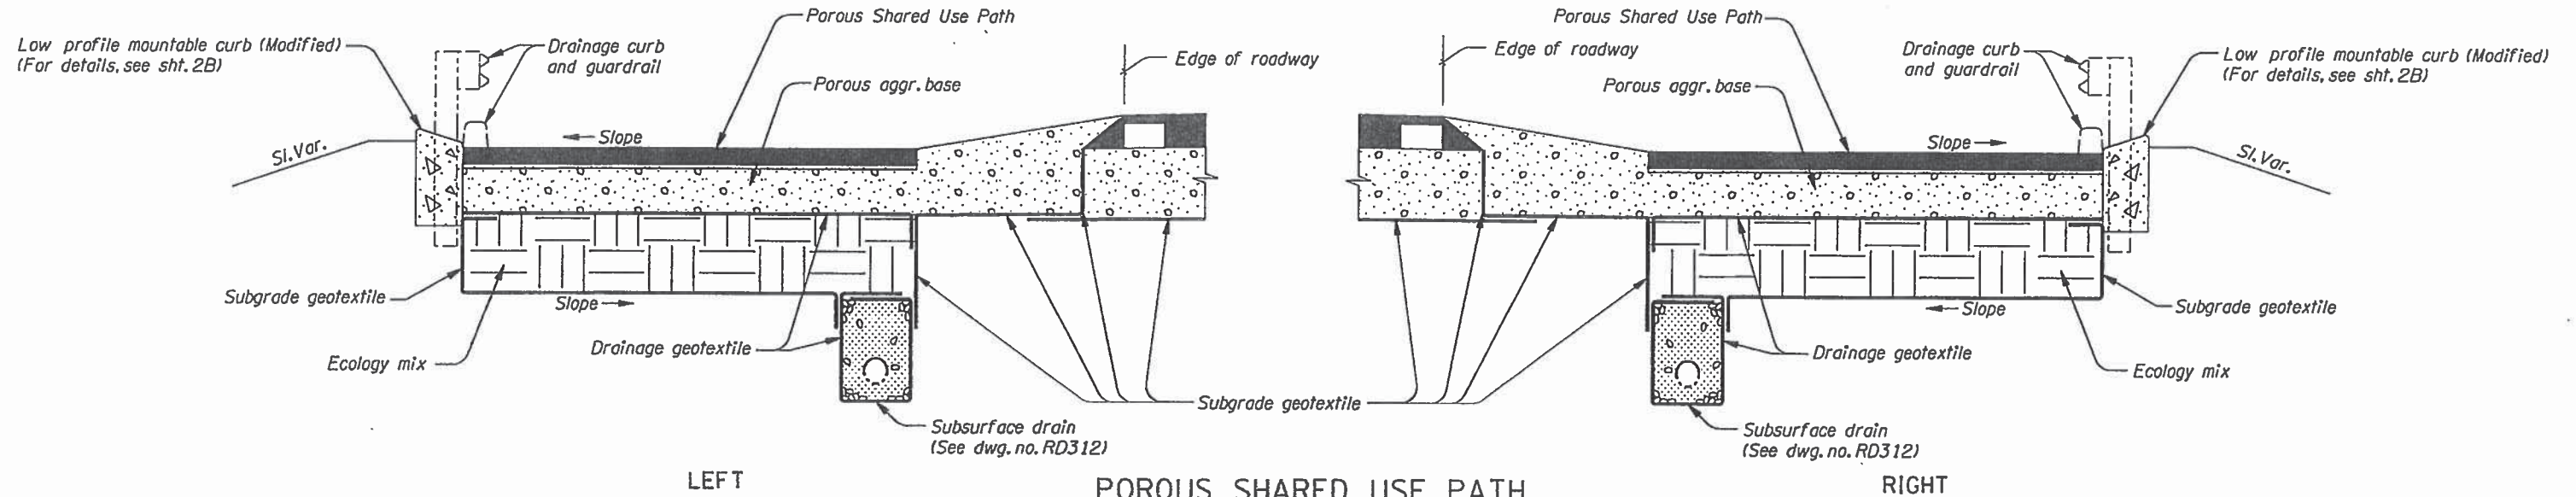


**POROUS SHARED USE PATH
(GEOTEXTILE OVERLAP DETAIL)**

For additional details, see typical sections
Provide geotextile overlap per 00350.41 (a)(2)
(Not to scale)

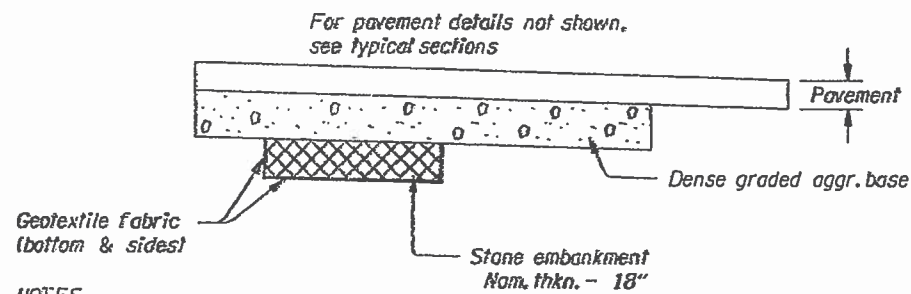


- NOTES:**
1. Excavate to a depth of 18" below subgrade
 2. Replace with 18" of stone embankment prior to placement of aggr. base.


**18" SUBGRADE STABILIZATION
(Location As Directed)**

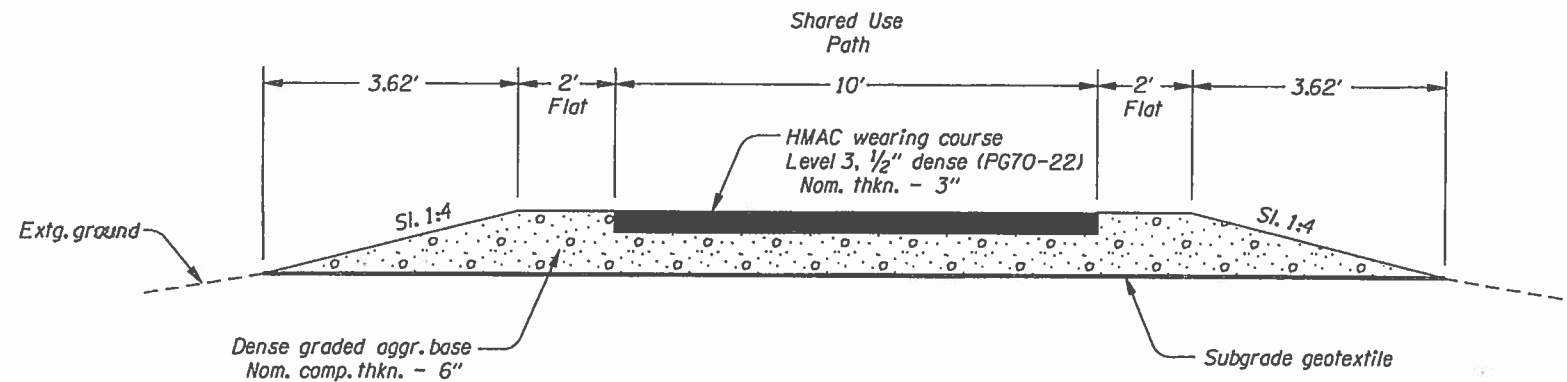


**STA. "WS" 30+95.87 To STA. "WS" 31+80.12 Lt.
NONPOROUS SHARED USE PATH**

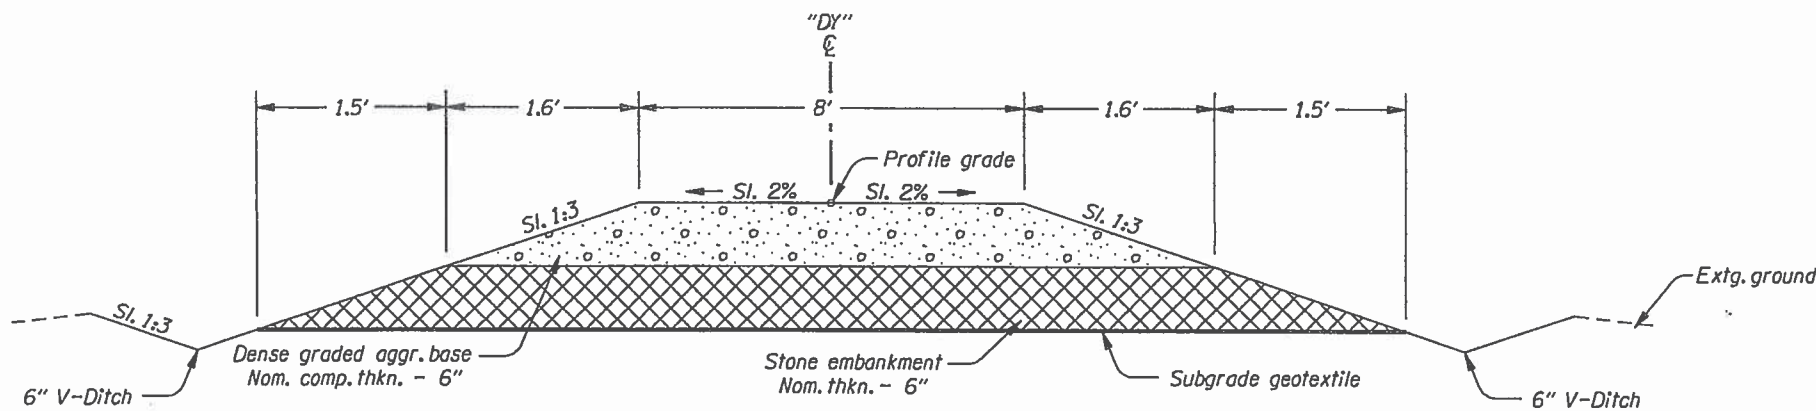

**STA. "DY" 0+00.00 To STA. "DY" 1+07.48
GRAVEL DRIVEWAY
For Profile, see sht. 4B-2**

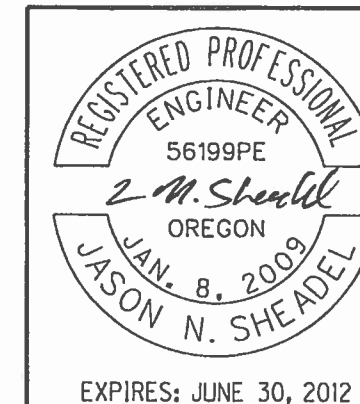

<p>OREGON DEPARTMENT OF TRANSPORTATION</p>	
<p>REGION 3 - TECHNICAL CENTER</p>	
<p>US 199 DOWELL RD TO ROGUE COMMUNITY COLLEGE REDWOOD HIGHWAY JOSEPHINE COUNTY</p>	
<p>Design Team Leader - James Burford Designed By - Jason Sheadel Drafted By - Judy Hardin</p>	
<p>DETAILS</p>	<p>SHEET NO. 2B-3</p>

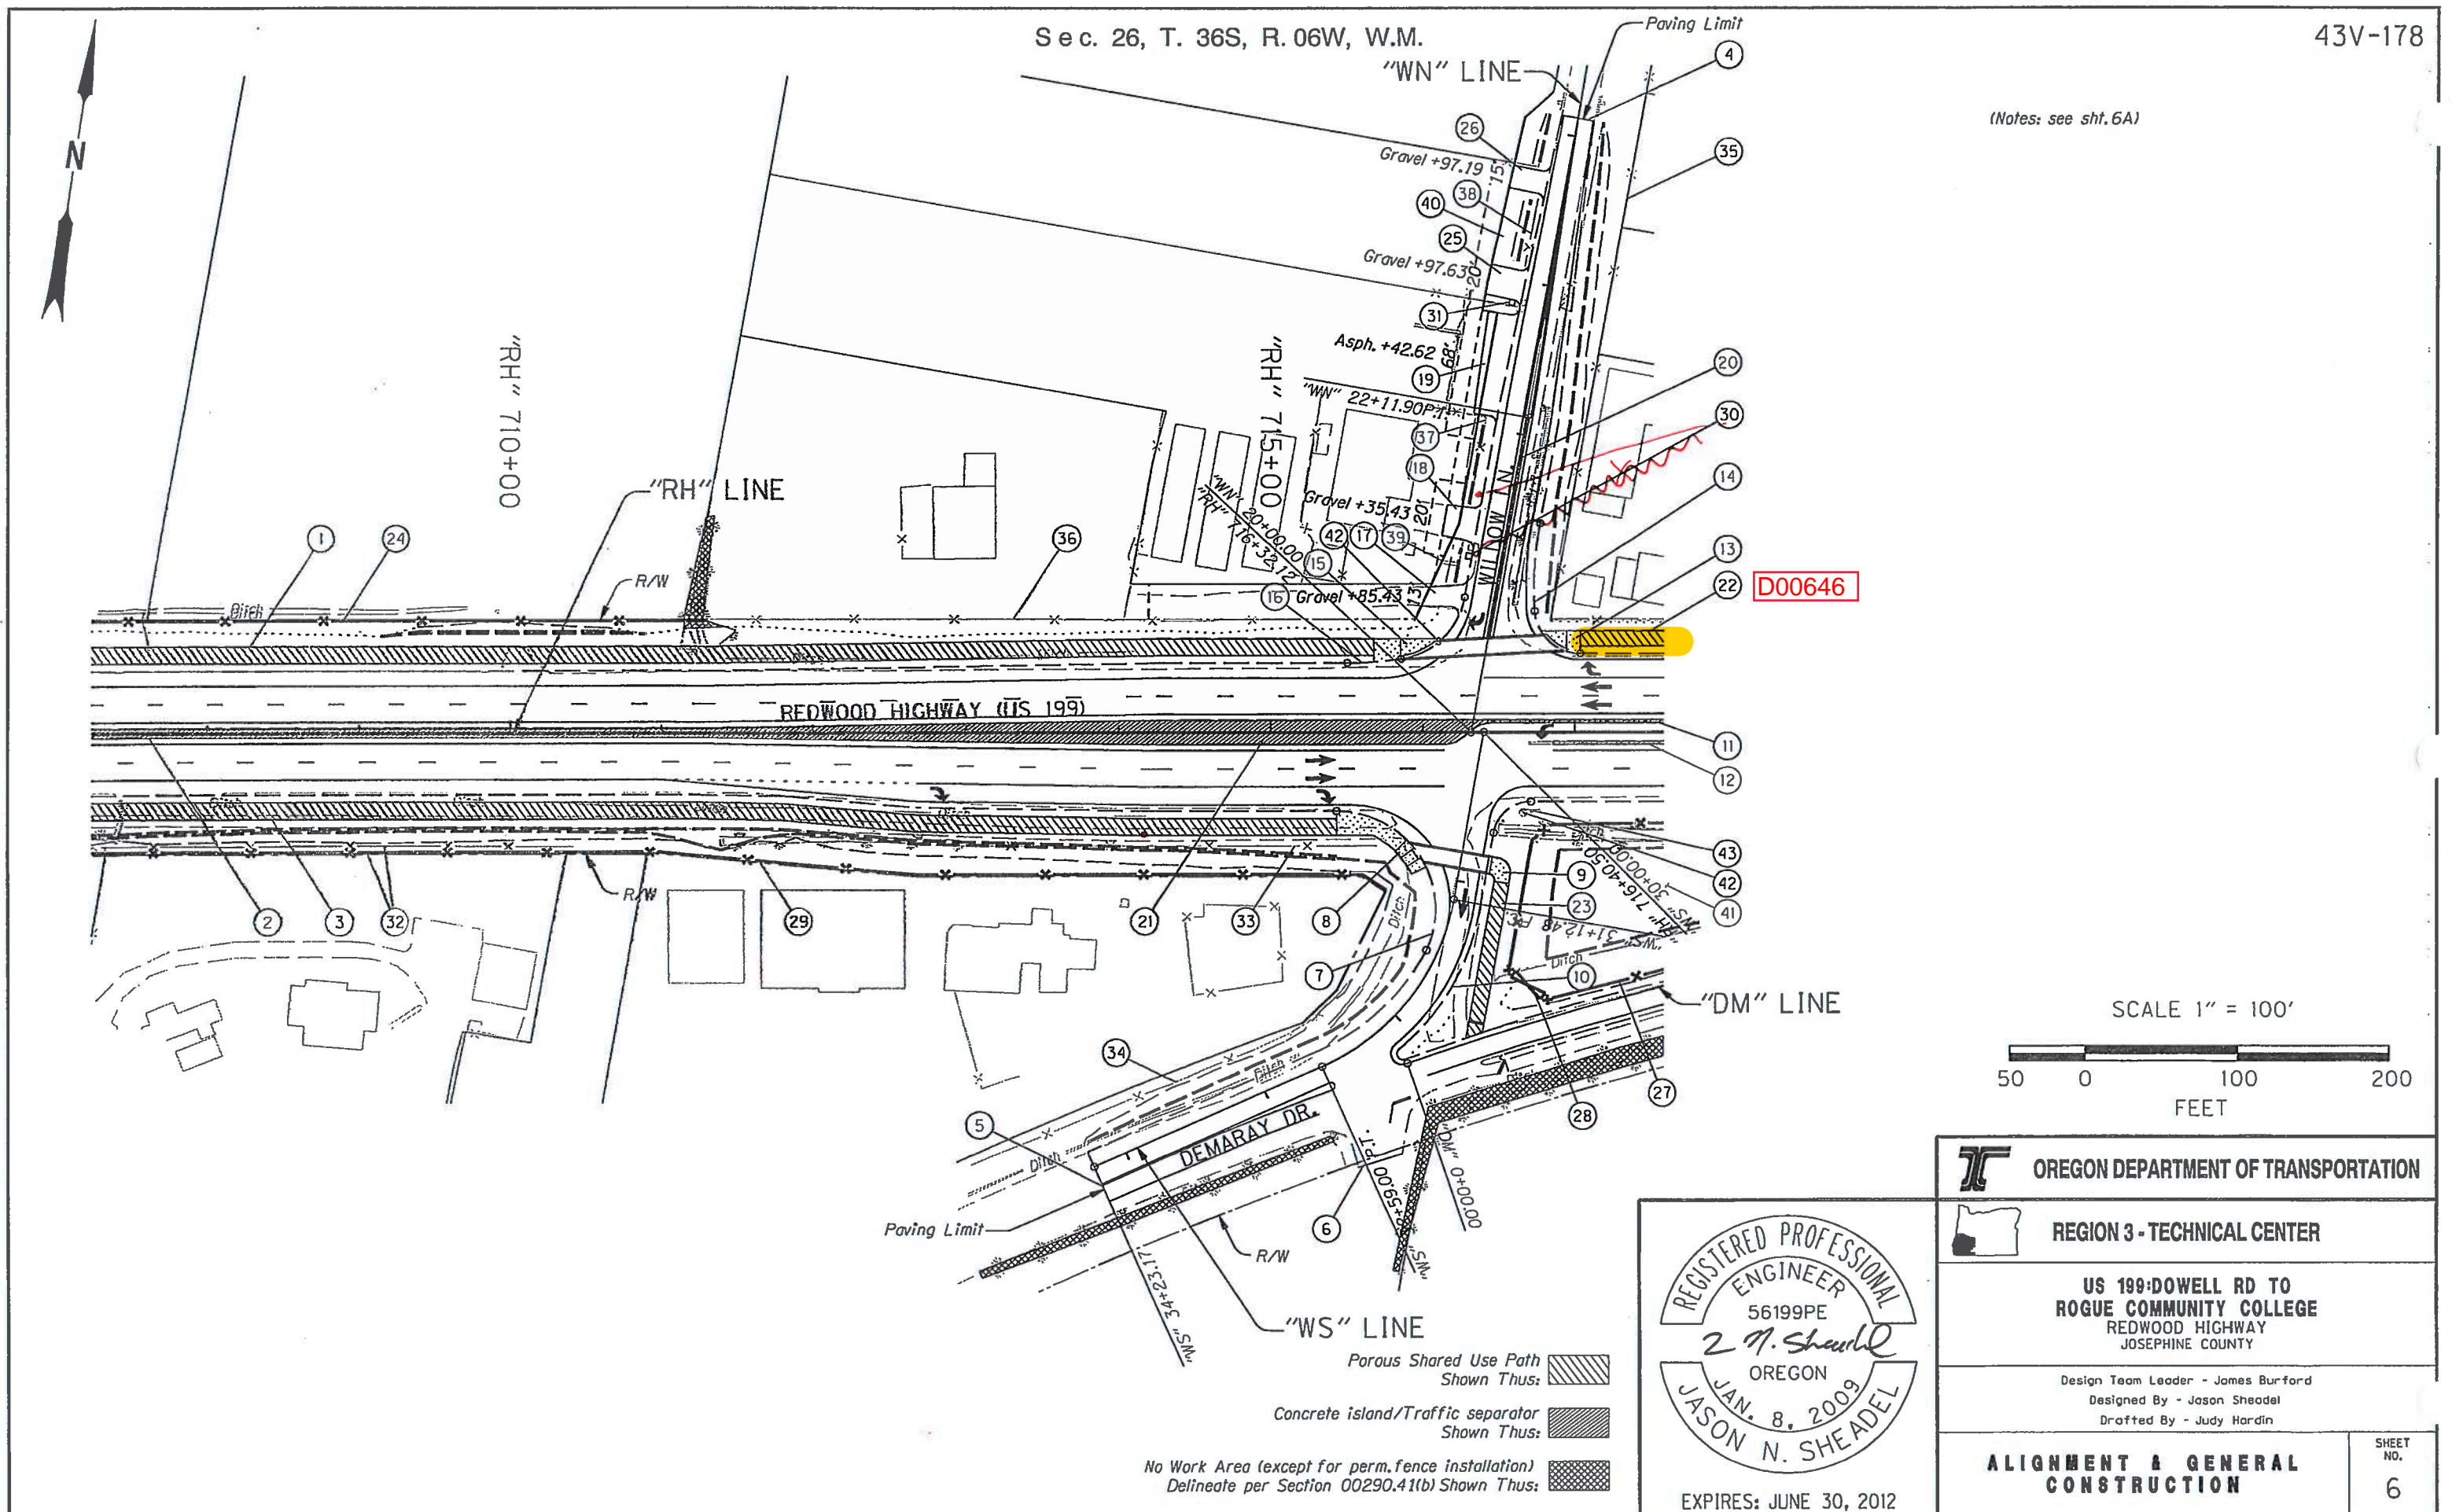

(Notes: see sht. 6A)

D00646

SCALE 1" = 100'



OREGON DEPARTMENT OF TRANSPORTATION


REGION 3 - TECHNICAL CENTER

**US 199: DOWELL RD TO
ROGUE COMMUNITY COLLEGE**
REDWOOD HIGHWAY
JOSEPHINE COUNTY

Design Team Leader - James Burford
Designed By - Jason Sheadel
Drafted By - Judy Hardin

**ALIGNMENT & GENERAL
CONSTRUCTION**

SHEET
NO.
6

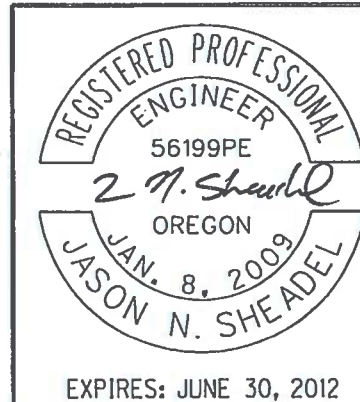

Porous Shared Use Path
Shown Thus: [diagonal hatching]

Concrete island/Traffic separator
Shown Thus: [cross-hatching]

No Work Area (except for perm. fence installation)
Delineate per Section 00290.41(b) Shown Thus: [stippled pattern]

- ① See sht. 5, note 5
Const. low profile mountable curb, modified
- ② See sht. 4A, note 20
Const. type "CA" mountable conc. island, modified
Const. mountable curb, modified
- ③ See sht. 4A, note 23
Const. low profile mountable curb, modified
- ④ Sta. "WN" 24+11.76
Const. asph. conc. pvmt. match
- ⑤ Sta. "WS" 34+23.17
Const. asph. conc. pvmt. match
- ⑥ Sta. "WS" 32+52.54, Lt.
Const. asph. conc. street connection
- ⑦ Sta. "RH" 715+43.46, Rt. To Sta. "WS" 31+51.22, Rt.
Const. standard conc. curb (E=7") - 131'
- ⑧ Sta. "RH" 715+43.46, Rt. To Sta. "WS" 30+97.64, Rt.
Const. P.C. conc. sidewalk - 76B sq.ft.
Const. sidewalk ramp
(Parallel Ramp)
- ⑨ Sta. "WS" 30+86.07, Lt
Const. P.C. conc. sidewalk - 206 sq.ft.
Const. sidewalk ramp
(Perpendicular Sidewalk Ramp thru Buffer Strip)
(See dwg. no. RD755)
- ⑩ Sta. "RH" 716+71.50, Rt. To Sta. "WS" 31+72.55, Lt.
(on Demaray Dr.)
Const. standard conc. curb (E=7") - 268'
- ⑪ Sta. "RH" 716+45.41 To Sta. "RH" 718+91.56, Lt.
Const. type "B" traffic separator - 567 sq.ft.
- ⑫ Sta. "RH" 716+85.70 To Sta. "RH" 11+30.69, Rt.
Const. type "B" traffic separator - 1,025 sq.ft.
- ⑬ Sta. "RH" 716+87.23, Lt
Const. P.C. conc. sidewalk - 261 sq.ft.
Const. sidewalk ramp
(Mod. ramp for sidewalks that do not
continue around radius. 30' curb radius)
(For details, see sht. 2B-2)
- ⑭ Sta. "RH" 717+03.66, Lt. To Sta. "WN" 21+44.33, Rt.
Const. standard conc. curb (E=7") - 104'

- ⑮ Sta. "RH" 715+97.19, Lt
Const. P.C. conc. sidewalk - 467 sq.ft.
Const. sidewalk ramp
(Mod. ramp for sidewalks that do not
continue around radius. 50' curb radius)
(For details, see sht. 2B-2)
- ⑯ Sta. "WN" 20+99.66, Lt. To Sta. "RH" 715+50.31, Lt.
Const. standard conc. curb (E=7") - 111'
- ⑰ Sta. "WN" 20+85.43, Lt.
Const. asph. conc. road approach
- ⑱ Sta. "WN" 21+35.43, Lt.
Const. asph. conc. road approach
- ⑲ Sta. "WN" 22+42.62, Lt.
Const. asph. conc. road approach
- ⑳ Sta. "WN" 20+64.33 To Sta. "WN" 22+11.90
Const. type "B" traffic separator - 324 sq.ft.
- ㉑ Sta. "RH" 714+25.37 To Sta. "RH" 718+91.56
Remove extg. conc. island - 3,407 sq.ft.
- ㉒ Sta. "RH" 717+03.66 To Sta. "RH" 32+40.41, Lt.
Const. low profile mountable curb, modified - 2,533'
- ㉓ Sta. "WS" 30+95.87 To Sta. "WS" 31+80.12, Lt.
Const. nonporous shared-use path. **CONCRETE SIDEWALK**
(For details, see sht. 2B-3) **(CHANGE)**
- ㉔ See sht. 4A, note 40
Inst. type 2 fence, modified
- ㉕ Sta. "WN" 22+97.63, Lt.
Const. asph. conc. road approach
- ㉖ Sta. "WN" 23+66.90, Lt.
Const. asph. conc. road approach
- ㉗ Sta. "RH" 716+72.5 To Sta. "RH" 10+12.6, Rt.
Inst. Type CL-4 (black vinyl coated) chain link fence - 805'
(See dwg. no. RD815)
- ㉘ Sta. "WS" 31+45.2, Lt.
Inst. type CL-4 (black vinyl coated) 16' chain link double gate
(See dwg. no. RD815)
- ㉙ Sta. "RH" 710+37 To Sta. "RH" 715+76, Rt.
Inst. type 2 fence, modified - 542'
Connect to extg. cross fences

- ⑳ ²¹⁺⁶⁰ Sta. "WN" 21+14.7, Lt.
Inst. multiple mailbox support
(1834 & 1840 Willow)
Const. conc. collar
Remove extg. mailbox support
- ㉑ Sta. "WN" 22+85.2, Lt.
Inst. single mailbox support
(1802 Willow)
Const. conc. collar
Remove extg. single mailbox support
- ㉒ Sta. "RH" 707+32 To Sta. "RH" 710+37, Rt.
Remove extg. fence - 305'
Inst. type 2 fence, modified - 305'
- ㉓ Sta. "RH" 712+97 To Sta. "RH" 715+70, Rt.
Remove extg. fence - 273'
- ㉔ Sta. "WS" 32+03 To Sta. "WS" 34+24, Rt.
Maintain/protect extg. fence
- ㉕ Sta. "WN" 25+06, Rt. To Sta. "RH" 16+08, Lt.
Maintain/protect extg. fence
- ㉖ Sta. "RH" 711+28 To Sta. "RH" 715+21, Lt.
Maintain/protect extg. fence
- ㉗ Sta. "WN" 21+47 To Sta. "WN" 22+07, Lt.
Extg. fence to be removed by others
- ㉘ Sta. "WN" 23+09 To Sta. "WN" 23+56, Lt.
Extg. fence to be removed by others
- ㉙ Sta. "WN" 21+07.80, Lt.
Remove extg. conc. barrier - 12.5'
- ㉚ Sta. "WN" 23+21, Lt. & Sta. "WN" 23+43, Lt
Protect extg. trees at back of R/W
- ㉛ Sta. "RH" 716+66, 10+13 Rt.
For detention pond plan, see sht. GJ
For planting plan, see sht. GN-5

- ㉜ Sta. "RH" 716+10, 60' Lt.
Sta. "RH" 716+67, 53' Rt.
Remove extg. flashing beacon footing - 2
- ㉝ Sta. "RH" 716+72.19, Rt.
Sta. "RH" 14+47.49, Rt.
Inst. Type S2 marker post - 2
(For details, see sht. 2B-6)


No.	DATE	REVISIONS	BY
①	04-05-2011	Revised quantities	J.A.H.



OREGON DEPARTMENT OF TRANSPORTATION	
REGION 3 - TECHNICAL CENTER	
US 199 DOWELL RD TO ROGUE COMMUNITY COLLEGE REDWOOD HIGHWAY JOSEPHINE COUNTY	
Design Team Leader - James Burford Designed By - Jason Sheadel Drafted By - Judy Hardin	
ALIGNMENT & GENERAL CONSTRUCTION	SHEET NO. 6A

Sec. 26, T. 36S, R. 06W, W.M.

(Notes: see shl. 6D)

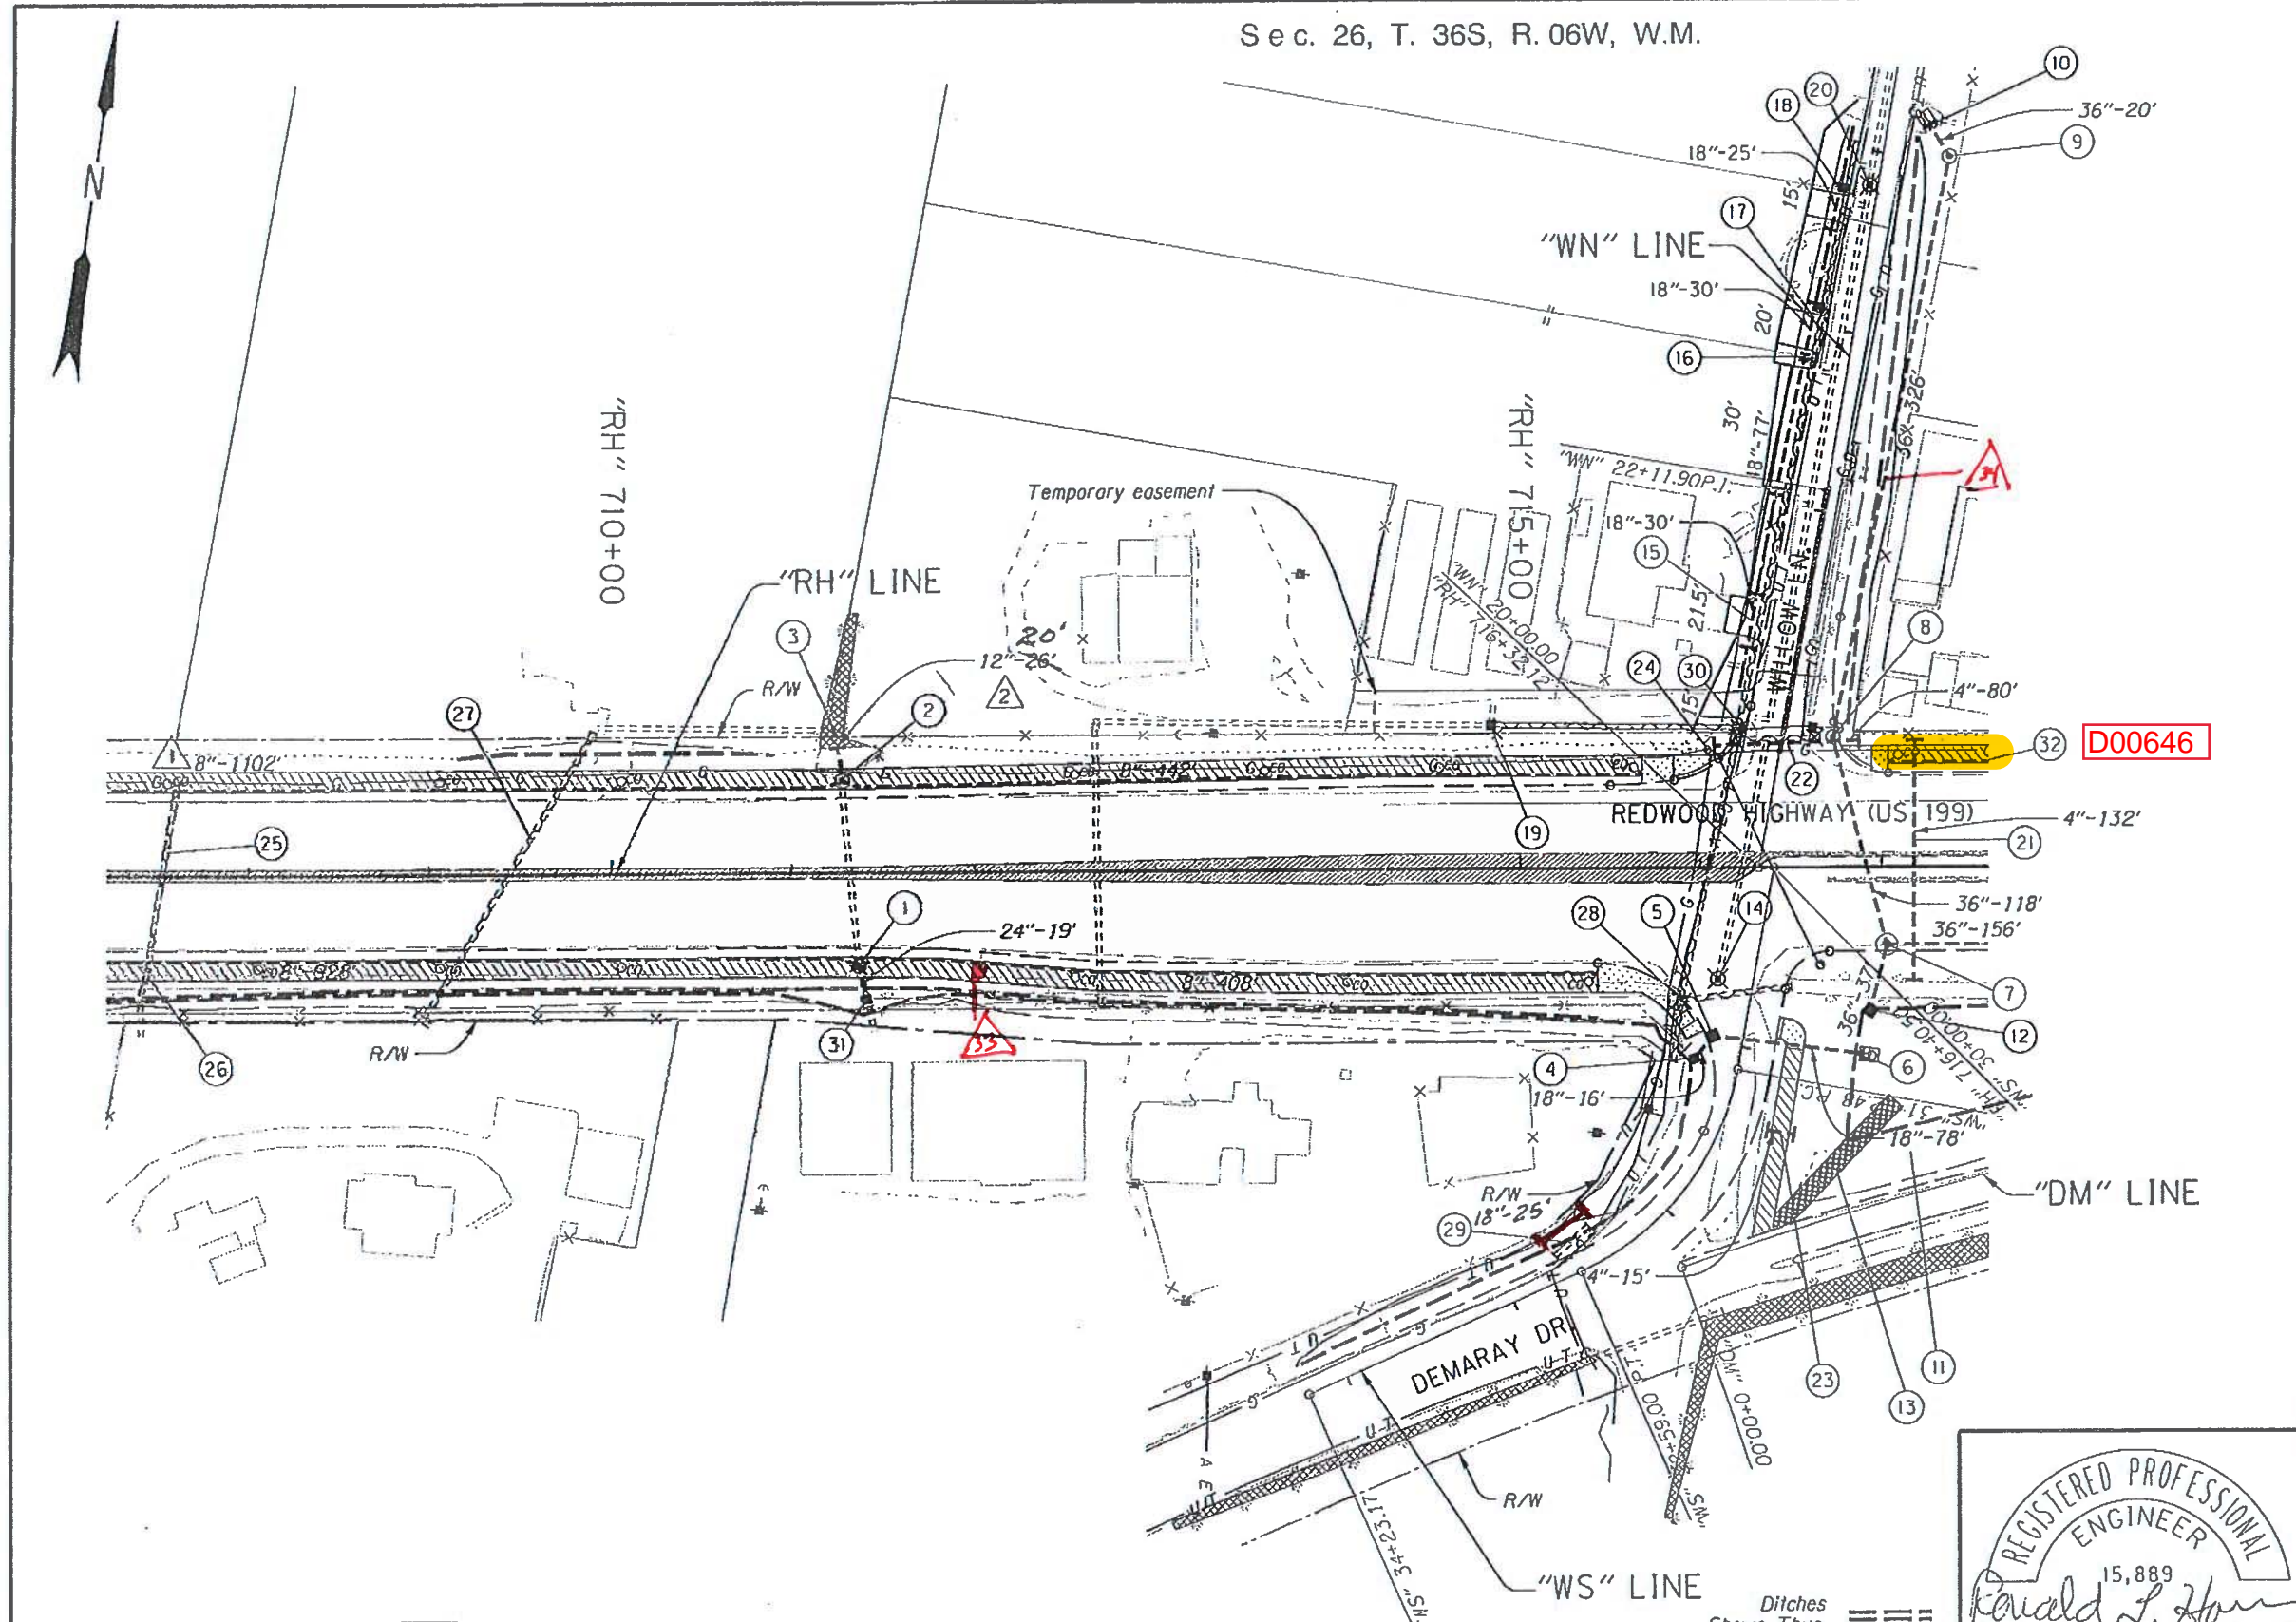

REVISIONS	
①	Revised 11-19-2010 Revised underdrain length
②	Revised 11-19-2010 Revised pipe size

Ditches Shown Thus:

Biofiltration Swales Shown Thus:

No Work Area (except for perm. fence installation) Delineate Per Section 00290.41(b) Shown Thus:

REGISTERED PROFESSIONAL ENGINEER
15,889
Ronald L. Horres
OREGON
MAY 19, 1992
RONALD L. HORRES

RENEWS: 06-30-2011

OREGON DEPARTMENT OF TRANSPORTATION

PARSONS BRINCKERHOFF
400 S.W. Sixth Ave., Portland, OR 97204

US199:DOWELL RD
TO ROGUE COMMUNITY COLLEGE
REDWOOD HIGHWAY
JOSEPHINE COUNTY

Design Team Leader - James Burford
Designed By - Ronald Horres
Drafted By - Anthony O'Donnell

DRAINAGE & UTILITIES

NO. 6C


- ① Sta. "RH" 711+36.00, 50.73' Rt.
Remove extg. inlet
Remove extg. culv. pipe - 18'
Const. storm sew. manhole
Rim - 949.64
F.L.(S) - 945.43
F.L.(N) - 945.43
F.L.(W) - 945.43
F.L.(E) - 945.43
Connect to extg. 24" culv. pipe (N)
Inst. 24" storm sew. pipe - 19' S.
5' depth
F.L.(S) - 946.30
Inst. 8" drain pipe - 928' W
Const. 7 cleanouts
Sta. "RH" 702+08.95, 47.10' Rt.
Sta. 703+50.00, 47.06' Rt.
Sta. 705+00.00, 47.01' Rt.
Sta. 706+50.00, 46.95' Rt.
Sta. 708+00.00, 46.93' Rt.
Sta. 709+00.00, 46.90' Rt.
Sta. 710+00.00, 46.87' Rt.
Inst. 8" drain pipe - 408' E
Const. 3 cleanouts
Sta. "RH" 715+43.46, 57.83' Rt.
Sta. 714+00.00, 57.42' Rt.
Sta. 712+50.00, 53.71' Rt.
- ② Sta. "RH" 711+26.77, 50.57' Lt.
Const. 60" storm sew. manhole
(See Dwg. No. RD346)
Rim - 949.71
F.L.(N) - 945.11 **944.95**
F.L.(S) - 944.95
F.L.(W) - 945.25
F.L.(E) - 945.11 **INSTALL 24" STORM SEWER**
Remove extg. 24" storm sew. pipe - 7' N + CONC. COLLAR
Connect to 24" storm sew. pipe (N)
Connect to extg. 24" storm sew. pipe (S)
Inst. 8" drain pipe - 1102' W
Const. 8 cleanouts
Sta. "RH" 700+25.00, 46.83' Lt.
Sta. 701+50.00, 46.83' Lt.
Sta. 703+00.00, 46.83' Lt.
Sta. 704+50.00, 46.83' Lt.
Sta. 706+00.00, 46.83' Lt.
Sta. 707+50.00, 46.83' Lt.
Sta. 709+00.00, 46.83' Lt.
Sta. 710+00.00, 46.83' Lt.
Inst. 8" drain pipe - 442' E
Const. 4 cleanouts
Sta. "RH" 715+67.98, 51.83' Lt.
Sta. 714+50.00, 51.83' Lt.
Sta. 713+50.00, 50.65' Lt.
Sta. 712+50.00, 48.92' Lt.
- ③ Sta. "RH" 711+26.77, 50.57' Lt.
To Sta. 711+24.67, 69.00' Lt.
Inst. 12" storm sew. pipe - **26' 20"**
5' depth
F.L.(N) - 944.82
F.L.(S) - 944.95
- ④ Sta. "WS" 31+10.51, 24.28' Rt.
Const. type "D" inlet
Rim - 946.80
F.L.(E) - 945.00
- ⑤ Sta. "WS" 30+96.53, 16.63' Rt.
Const. type "G-2" inlet
Rim - 948.50
F.L.(E) - 944.87
F.L.(W) - 944.87
Inst. 18" storm sew. pipe - 18' W
5' depth **14'**

- ⑥ Sta. "WS" 30+96.53, 16.63' Rt. To Sta. 30+92.26, 61.40' Lt.
Inst. 18" storm sew. pipe - **78' 74'**
5' depth
F.L.(W) - 944.87
F.L.(E) - 944.50
Const. 18" Paved Culvert End Slope - 35 sq.ft.
(See Dwg. No. RD320)
Const. loose riprap (Class 50) - 4.1 cu.yd.
Riprap Geotextile Type 2 - 10.0 sq.yd.
(For detail, see sht. GJ-6)
- ⑦ Sta. "RH" 717+03.10, 42.23' Rt.
Const. 72" storm sew. manhole
Rim - 949.62
F.L.(N) - 939.93
F.L.(S) - 939.93
F.L.(E) - 942.23
Connect to 36" storm sew. pipe (N)
Inst. 36" storm sew. pipe - **37' S 40'**
10' depth
Inst. 36" storm sew. pipe - 156' E.
10' depth
- ⑧ Sta. "WN" 20+78.14, 27.64 Rt.
Remove extg. siphon box
Const. 60" storm sew. manhole w/ inlet
Rim - 948.90
F.L.(S) - 939.56
F.L.(N) - 939.56
Inst. 36" storm sew. pipe - 118' S.
10' depth
Connect to 36" storm sew. pipe (N)
- ⑨ Sta. "WN" 24+03.84, 35.55' Rt.
Const. 72" storm sew. manhole
Rim - 944.25
F.L.(S) - 938.56
F.L.(N) - 938.56
Inst. 36" storm sew. pipe - **327'**
10' depth **ADD 7.5' PIPE AND SLOPE END SECTION - 2 EA**
Connect to 36" storm sew. pipe (N)
- ⑩ Sta. "WN" 24+03.84, 35.55' Rt. To Sta. 24+18.94, 22.40' Rt.
Inst. 36" storm sew. pipe - 20'
F.L.(S) - 938.56
F.L.(N) - 938.50
10' depth
Outfall to irrigation canal
Const. loose riprap (Class 100) - 27 cu.yd.
Riprap Geotextile Type 2 - 46.0 sq.yd.
(For detail, see sht. GJ-6)
- ⑪ Detention Facility
(For details, see sht. GJ)
- ⑫ See Sht. GJ, Note 4
- ⑬ See Sht. GJ, Note 7
- ⑭ Sta. "WS" 30+65.23, 19.49' Rt.
Adjust sanitary sew. manhole - minor
Method B Circular Cut
- ⑮ Sta. "WN" 21+18.69, 27.90' Lt. To Sta. 21+48.69, 27.90' Lt.
Inst. 18" culv. pipe - **30' 45'**
5' depth
F.L.(S) - 946.01
F.L.(N) - 945.46
Const. 18" sloped end - **2**

- ⑯ Sta. "WN" 22+82.82, 24.68' Lt.
Const. type "Field" inlet **G2-MA**
Rim - 944.50
F.L.(S) - 943.07
F.L.(N) - 943.07
(See Dwg. No. RD374)
Inst. 12" storm sew. pipe - 77' S. **ADD 13'**
5' depth
F.L.(S) - 944.50
Connect to 12" storm sew. pipe (N)
- ⑰ Sta. "WN" 23+12.51, 26.04' Lt. To Sta. 22+82.82, 27.13' Lt.
Inst. 12" storm sew. pipe - **30' 35'** - SALVAGE & REINSTALL CULVERT PIPE - MAINTAIN UTILITY ACCESS DRIVEWAY
5' depth
F.L.(S) - 943.07
F.L.(N) - 942.95
Const. 12" sloped end
- ⑱ Sta. "WN" 23+54.00, 23.46' Lt. To Sta. 23+78.97, 20.29' Lt.
Inst. 18" culv. pipe - **25' 30'** PER EOR
5' depth
F.L.(S) - 942.66
F.L.(N) - 942.04
Const. 18" sloped end - **2 EA**
- ⑲ Sta. "RH" 714+83.95, 79.38' Lt.
Const. siphon box and cover **TRAFFIC RATED LID**
(See Sht. GJ-6 for details - Siphon Box E)
F.L.(W) - 945.0±
Connect to extg. irrigation pipe (N)
RELOCATE 4' OF 10" PIPE FROM E. TO N.
- ⑳ Sta. "WN" 23+81.34, 23.46' Lt.
Adjust sanitary sew. manhole - minor
Method B Circular Cut
- ㉑ Sta. "RH" 717+17.72, 70.06' Lt. To Sta. 717+17.72, 61.94' Rt.
Inst. 4" irrigation sleeve - 132'
5' depth
F.L.(N) - 945.00
F.L.(S) - 945.00
Inst. irrigation sleeve end - 2
(For details, see sht. GN-1)
- ㉒ Sta. "RH" 716+07.55, 67.46' Lt. To Sta. 716+87.50, 70.19' Lt.
Inst. 4" irrigation sleeve - 80'
5' depth
F.L.(W) - 946.00
F.L.(E) - 945.00
Inst. irrigation sleeve end - 2
(For details, see sht. GN-1)
- ㉓ Sta. "WS" 31+38.44, 24.38' Lt. To Sta. 31+36.39, 39.18' Lt.
Inst. 4" irrigation sleeve - 15'
5' depth
F.L.(W) - 947.75
F.L.(E) - 947.00
Inst. irrigation sleeve end - 2
(For details, see sht. GN-1)
- ㉔ Sta. "RH" 716+04.02, 65.35' Lt.
Adjust natural gas valves
(By Others)

- ㉕ See sht. 5B, note 7
- ㉖ See sht. 5B, note 8
- ㉗ Sta. "RH" 708+97.11, 78.24' Rt. To Sta. 709+88.92, 75.69' Lt.
Abandon 12" irrigation pipe - Rt. side - 1
- ㉘ Sta. "RH" 715+88.93, 72.56' Rt.
Remove extg. inlet
Abandon 12" storm sew. pipe - Rt. side - 1
Abandon 18" storm sew. pipe - Lt. side - 1
Remove extg. 18" storm sew. pipe - **33' S 25'**
REPLACED (ADS)
- ㉙ Sta. "WS" 32+42.80, 20.86' Rt. To Sta. 32+68.77, 13.74' Rt.
Remove extg. 18" culv. pipe - 25'
REINSTALL 18" culv. PIPE 25'
- ㉚ Sta. "WN" 20+73.77, 25.27' Lt.
Remove extg. siphon boxes - 2
Abandon 12" irrigation pipe - Rt. side - 1
Abandon 8" irrigation pipe - Rt. side - 1
Abandon 10" irrigation pipe - Lt. side - 1
RELOCATE 4' OF 10" PIPE TO NEW Siphon Box E (N) SEE ⑲
- ㉛ Sta. "RH" 711+40.22, 50.73' Lt. RT
Const. type "Field" inlet **G2-MA**
Rim - 948.40
F.L.(S) - 945.90
F.L.(N) - 945.90
Connect to extg. 24" storm sew. pipe (S)
Connect to 24" storm sew. pipe (N)
- ㉜ See Sht. 7B, Note 4
- ㉝ **ADJUST EXT. SIPHON BOX + INSTALL LID (G)**
RH 712+75 RT
- ㉞ **INSTALL SUBSURFACE DRAINS - 8 EA**
WN 21+40 TO 23+85 RT

REVISIONS	
①	Revised 11-19-2010 Revised underdrain length and cleanouts
②	Revised 11-19-2010 Revised pipe size

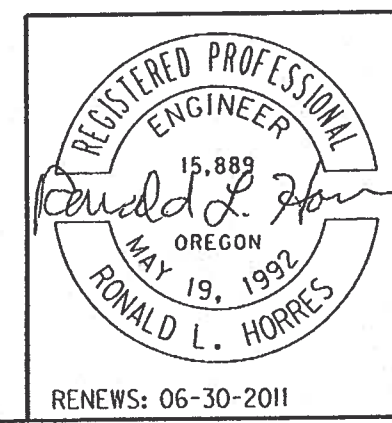

OREGON DEPARTMENT OF TRANSPORTATION

PARSONS BRINCKERHOFF
122 400 S.W. Sixth Ave. Portland, OR 97204

**US199-DOWELL RD
TO ROQUE COMMUNITY COLLEGE**
REDWOOD HIGHWAY
JOSEPHINE COUNTY


Design Team Leader - James Burford
Designed By - Ronald Horres
Drafted By - Anthony O'Donnell

DRAINAGE & UTILITIES

SHEET NO. **6D**

REVISIONS
 ③ ADJUSTED SLOPED END QTY 9-14-11 KCT
 ④ REVISED NOTE 9-14-11 KCT

Sec. 26, T. 36S, R. 06W, W.M.

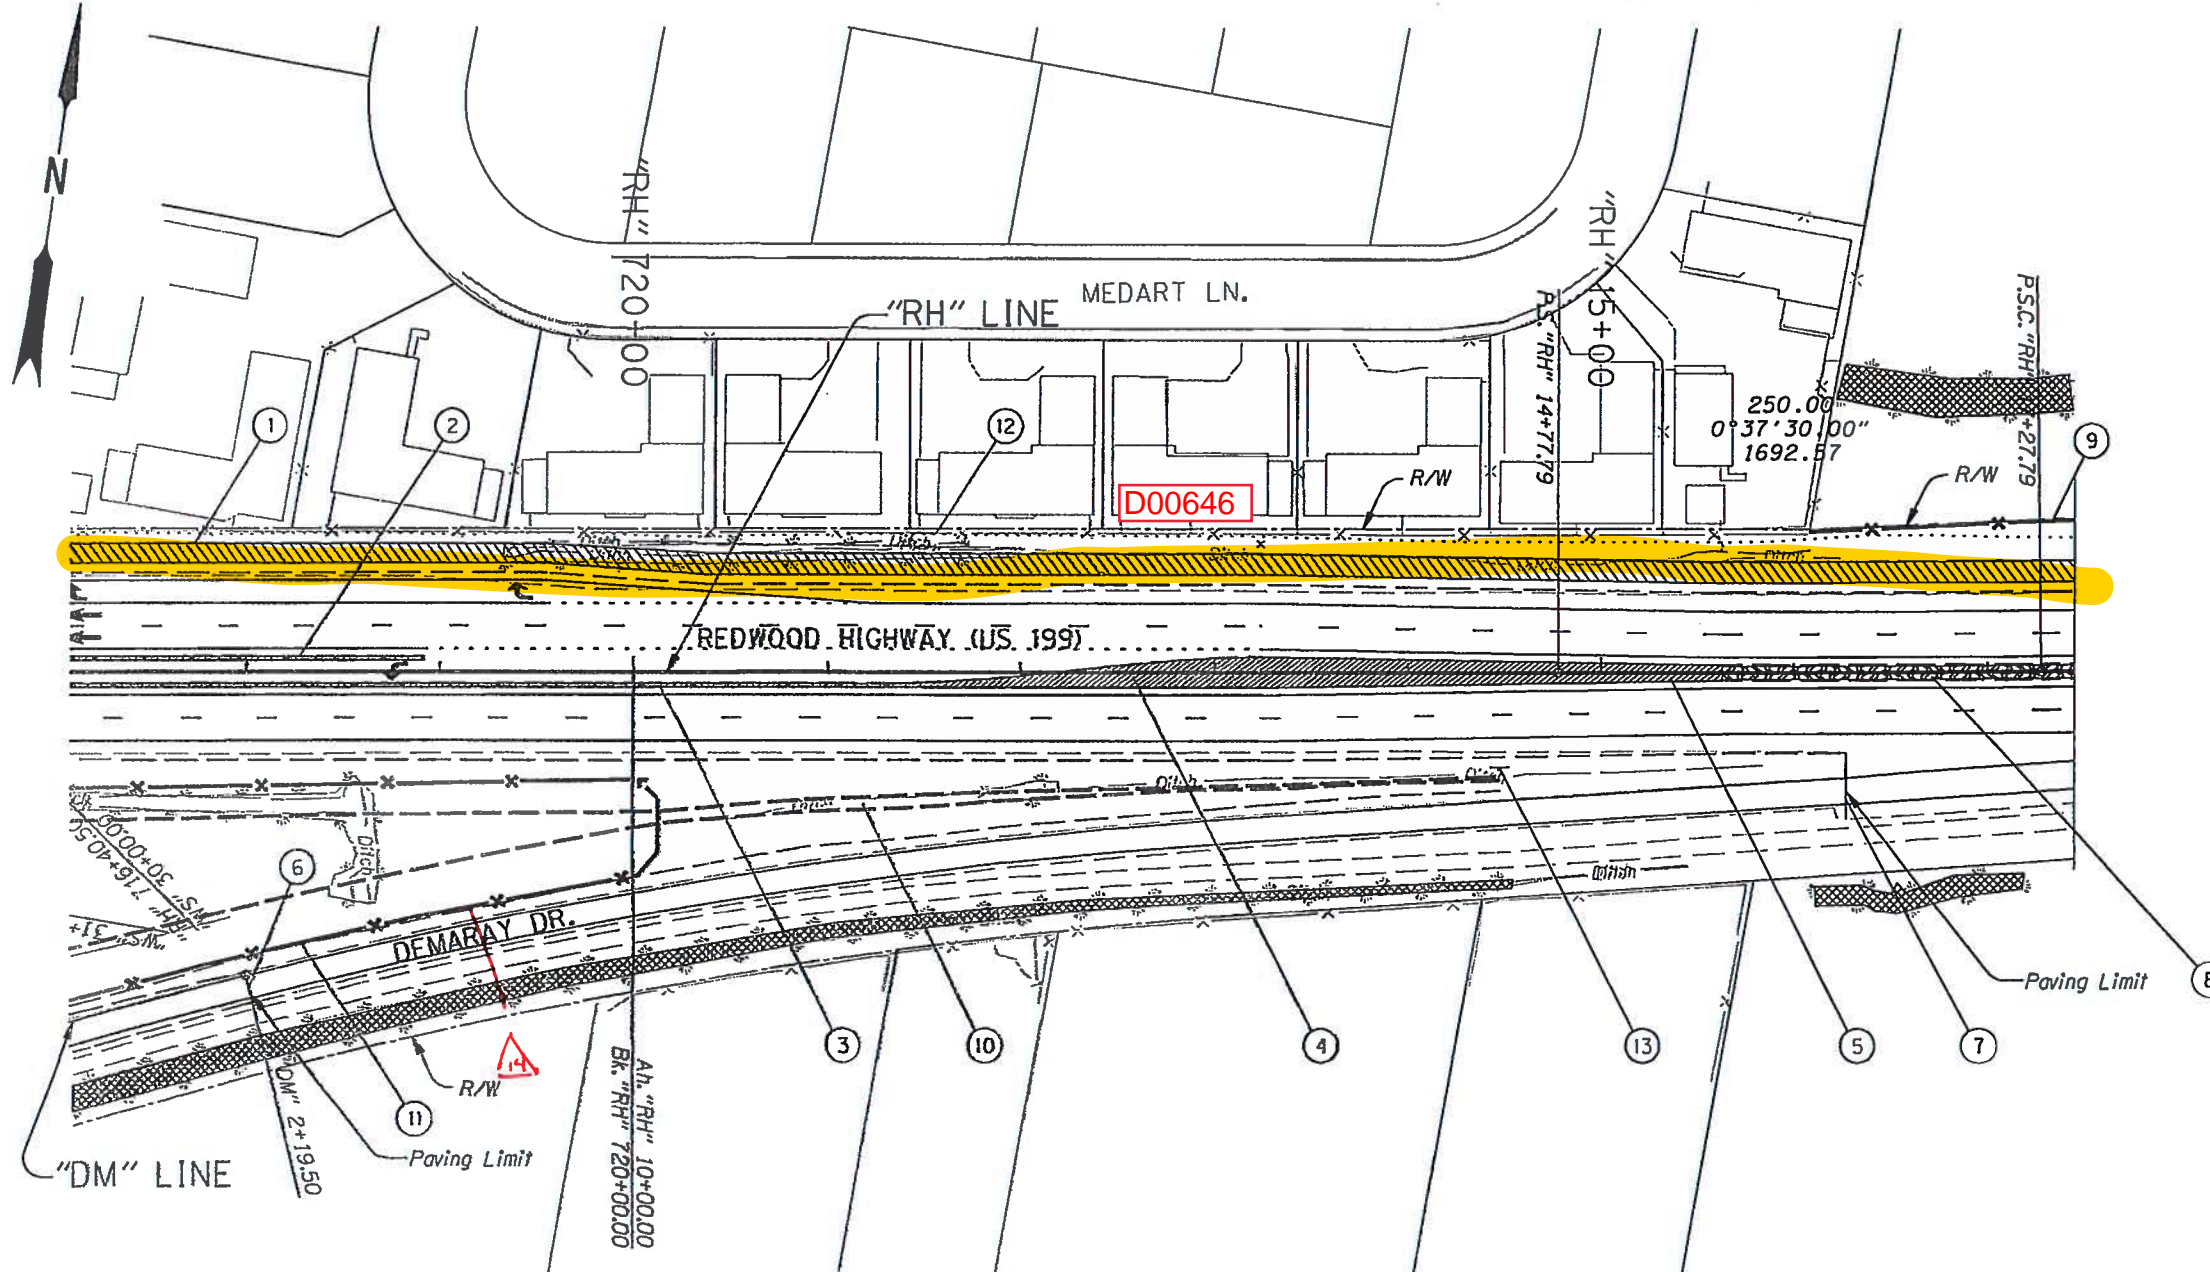

- ① See sht. 6A, note 22
Const. low profile mountable curb, modified
- ② See sht. 6A, note 11
Const. type "B" traffic separator
- ③ See sht. 6A, note 12
Const. type "B" traffic separator
- ④ Sta. "RH" 716+70.33 To Sta. "RH" 13+23.48
Remove extg. conc. island - 2,665 sq. ft.
- ⑤ Sta. "RH" 11+30.69 To Sta. "RH" 15+63.56
Const. type "CA" mountable conc. island, modified - 4,031 sq. ft.
Const. mountable curb, modified - 877'
- ⑥ Sta. "DM" 2+19.50
Const. asph. conc. pvmf. match
- ⑦ Sta. "RH" 16+26.36, Rt.
Const. asph. conc. street connection
- ⑧ Sta. "RH" 15+63.56 To Sta. "RH" 18+23.56
Const. type "CA" mountable porous rock island, modified - 1,734 sq. ft.
Const. mountable curb, modified - 520'
Remove extg. asph. conc. surfacing - 1468 sq. ft.
(For details, see sht. 2B)
- ⑨ Sta. "RH" 16+08.62 To Sta. "RH" 25+45.82, Lt.
Inst. type 2 fence, modified - 932'
- ⑩ Sta. "RH" 10+14.6, Rt. To Sta. "RH" 14+47.5, Rt.
Const. biofiltration swale #2
Biofiltration mix - 90 cu. yd.
Matting, jute - 585 sq. yd.
(For details, see sht. GJ-7)
(For planting plan, see sht. GN-6)
- ⑪ See sht. 6A, note 27
Inst. Type CL-4 (black vinyl coated) chain link fence

- ⑫ See sht. 6A, note 35
Maintain/protect extg. fence
- ⑬ See sht. 6A, note 43
Inst. Type S2 marker post

⑭ om 2+82
INSTALL 69' OF 24" STORM PIPE
10' DEEP - N.

SCALE 1" = 100'




- Porous Rock Island
Shown Thus: [hatched pattern]
- Porous Shared Use Path
Shown Thus: [diagonal hatched pattern]
- Concrete island/Traffic separator
Shown Thus: [solid hatched pattern]
- No Work Area (except for perm. fence installation)
Delineate per Section 00290.41(b) Shown Thus: [dotted pattern]



OREGON DEPARTMENT OF TRANSPORTATION	
REGION 3 - TECHNICAL CENTER	
US 199: DOWELL RD TO ROGUE COMMUNITY COLLEGE REDWOOD HIGHWAY JOSEPHINE COUNTY	
Design Team Leader - James Burford Designed By - Jason Sheadel Drafted By - Judy Hardin	
ALIGNMENT & GENERAL CONSTRUCTION	SHEET NO. 7

Sec. 26, T. 36S, R. 06W, W.M.

43V-178

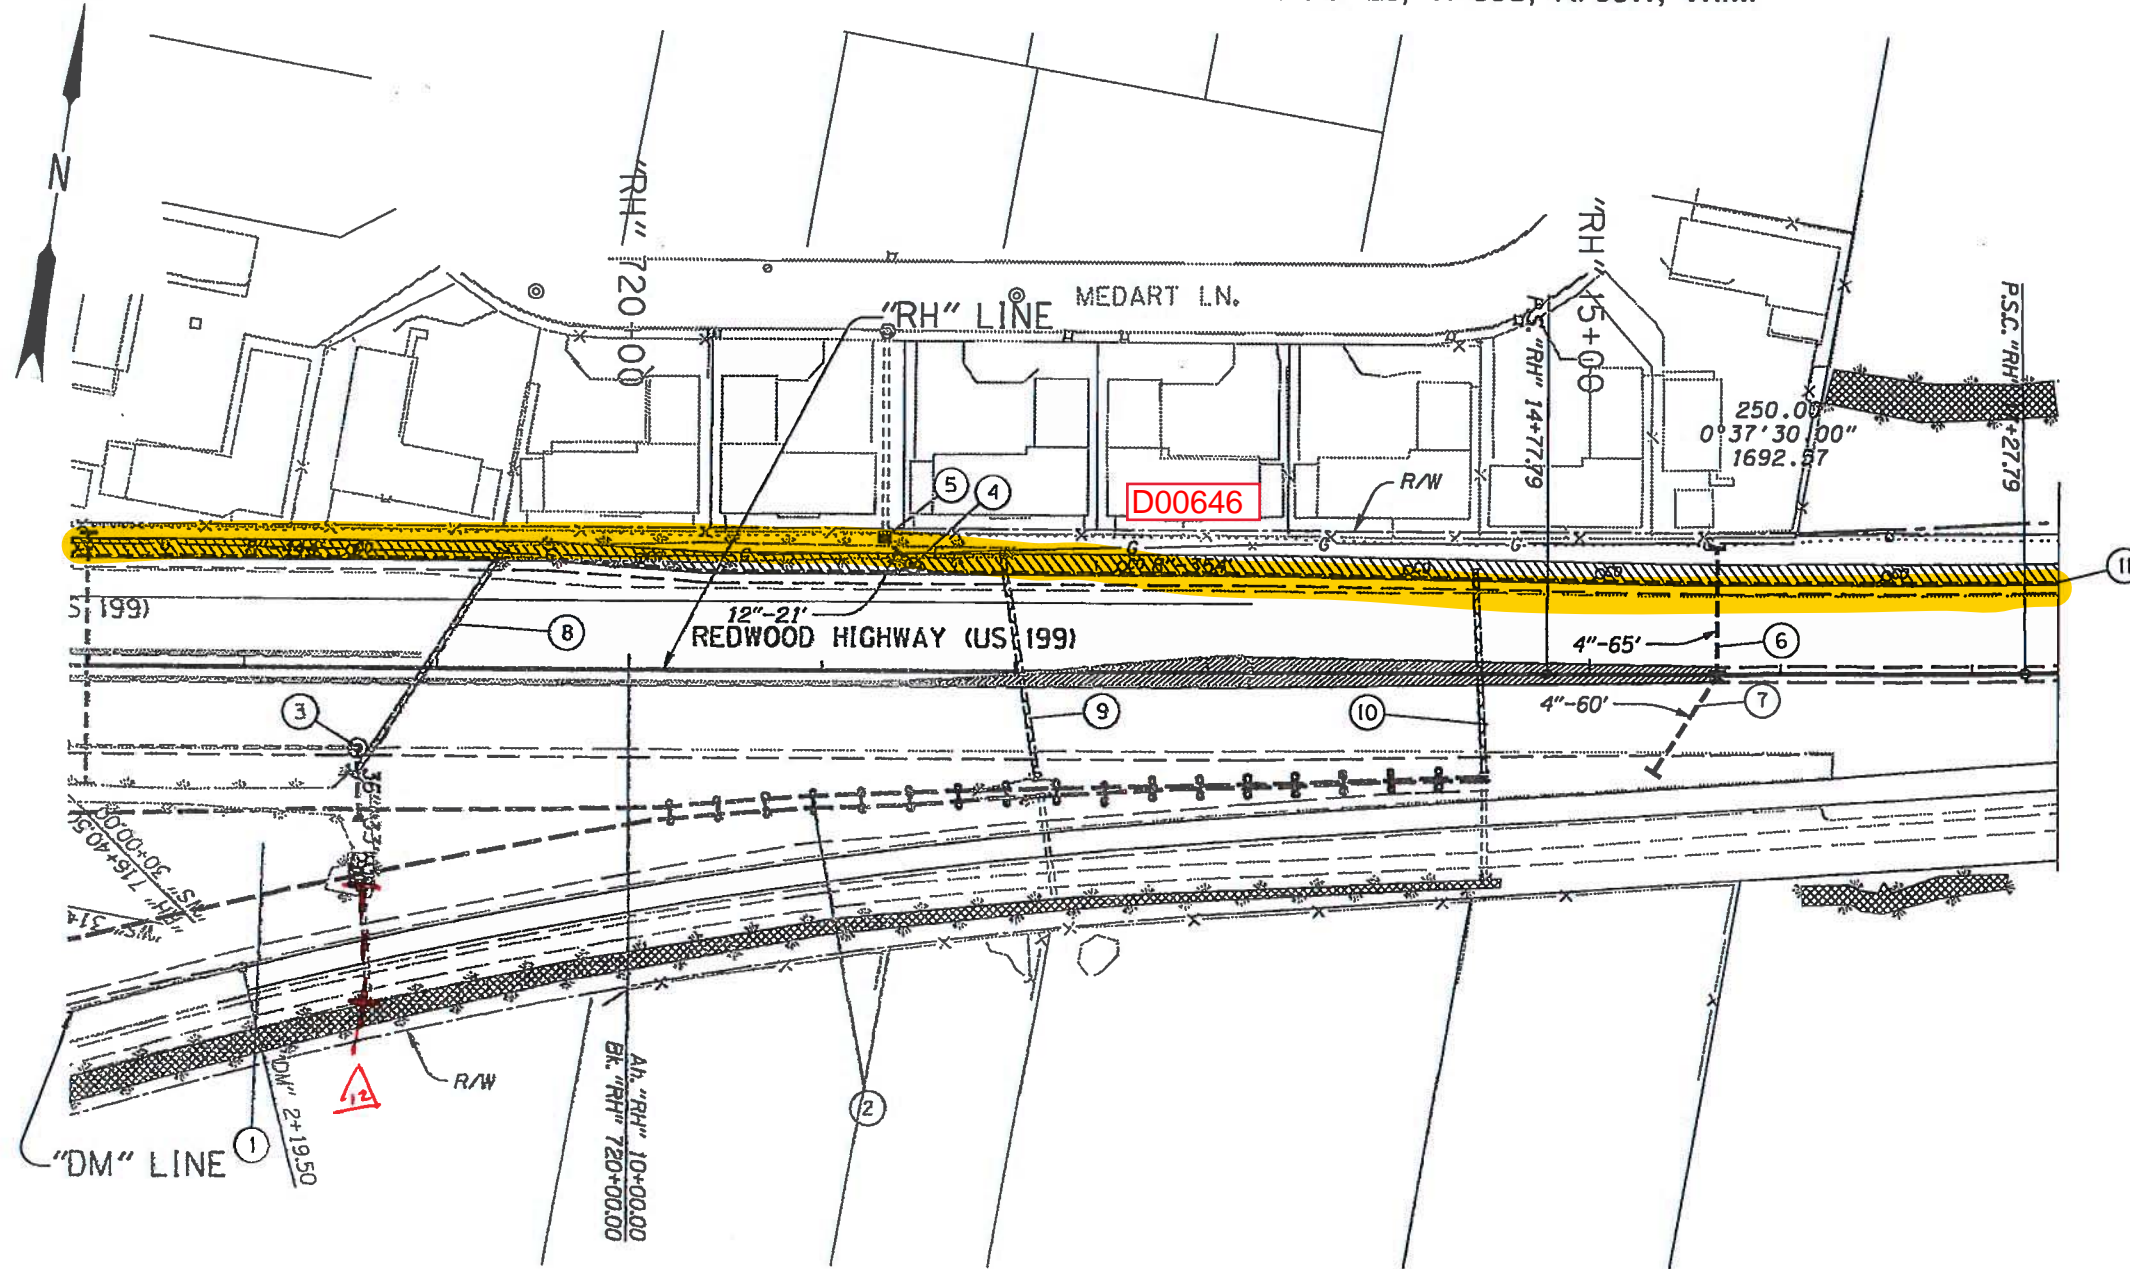

- ① See Sht. 6D, Note 11
- ② Const. Biofiltration Swale No. 2:
(For details, see sht. 6J-7)
Const. Biofiltration Check Dams - 17
- ③ See Sht. 6J, Note 3
- ④ Sta. "RH" 11+46.72, 55.54' Lt.
Const. storm sew. manhole
Rim - 947.87
F.L.(N) - 942.13
F.L.(E) - 943.42
F.L.(W) - 943.42
Connect to 12" storm sew. pipe (N)
Inst. 8" Drain Pipe - 354' E
Const. 3 cleanouts
Sta. "RH" 15+00.00, 49.04' Lt.
Sta. 14+00.00, 50.58' Lt.
Sta. 12+50.00, 51.83' Lt.
Inst. 8" Drain Pipe - 444' W
Const. 3 cleanouts
Sta. "RH" 717+03.66, 57.83' Lt.
Sta. 718+50.00, 57.83' Lt.
Sta. 10+00.00, 54.69' Lt.
- ⑤ Sta. "RH" 11+32.28, 70.32' Lt.
Remove extg. inlet
Const. type "D" inlet
Rim - 946.00
F.L.(N) - 940.13
F.L.(S) - 942.13
Connect to extg. 30" storm sew. pipe (N)
Inst. 12" storm sew. pipe - 2' S
10' depth
- ⑥ Sta. "RH" 15+66.91, 66.63' Lt. To
Sta. 15+66.90, 1.63' Lt.
Inst. 4" irrigation sleeve - 65'
5' depth
F.L.(N) - 942.00
F.L.(S) - 945.00
Inst. irrigation sleeve end - 2
(For details, see sht. GN-1)
- ⑦ Sta. "RH" 15+66.57, 1.50' Rt. To
Sta. 15+33.73, 51.70' Rt.
Inst. 4" irrigation sleeve - 60'
5' depth
F.L.(N) - 945.00
F.L.(S) - 946.00
Inst. irrigation sleeve end - 2
(For details, see sht. GN-1)

- ⑧ Sta. "RH" 718+57.38, 57.42' Rt. To Sta. 719+34.04, 61.96' Lt.
Abandon 36" culv. pipe - Rt. side - 1
- ⑨ Sta. "RH" 12+11.95', 57.06' Rt. To Sta. 11+93.21, 63.92' Lt.
Abandon 30" culv. pipe - Rt. side - 1
- ⑩ Sta. "RH" 14+45.37, 52.15' Rt. To Sta. 14+40.26, 55.04' Rt.
Abandon 24" culv. pipe - Rt. side - 1
- ⑪ See Sht. 8B, Note 1

Remove and Replace 24" storm sewer pipe, 10' DEEP - 69' Dm 2+82

Ditches Shown Thus: ====
Biofiltration Swales Shown Thus: +==+

No Work Area (except for perm. fence installation) Delineate Per Section 00290.41(b) Shown Thus: [hatched box]



RENEWS: 06-30-2011

OREGON DEPARTMENT OF TRANSPORTATION

PARSONS BRINCKERHOFF
129 400 S.W. Sixth Ave., Portland, OR 97204


US199: DOWELL RD
TO ROGUE COMMUNITY COLLEGE
REDWOOD HIGHWAY
JOSEPHINE COUNTY

Design Team Leader - James Burford
Designed By - Ronald Horres
Drafted By - Anthony O'Donnell

DRAINAGE & UTILITIES

SHEET NO. 7B

(Notes: see sht. 9D)

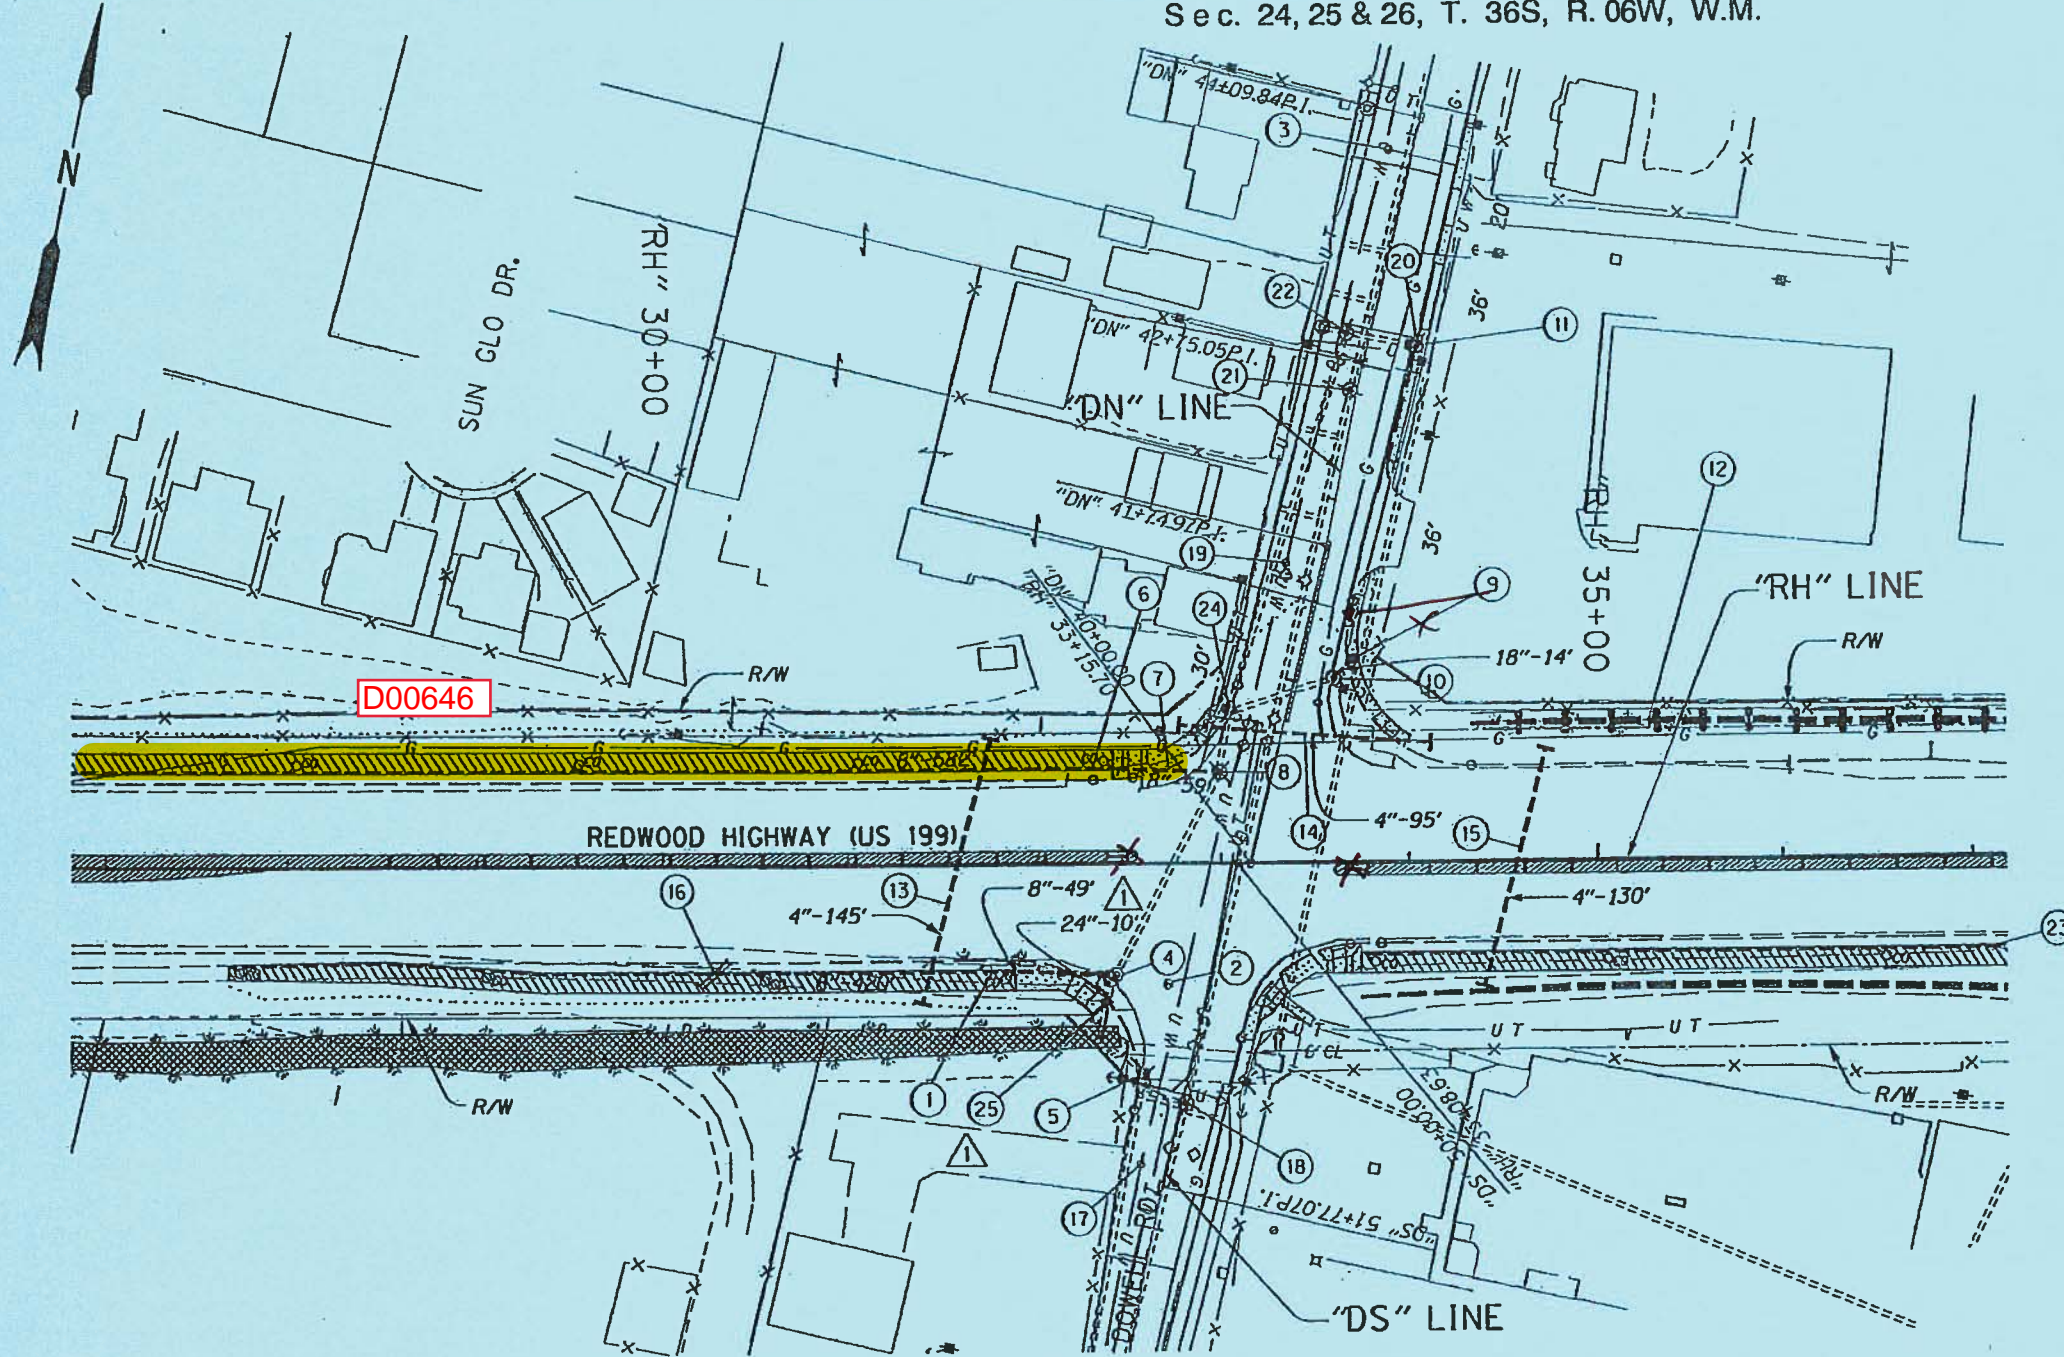

D00646

REDWOOD HIGHWAY (US 199)

"DS" LINE

"RH" LINE


"DN" LINE

REVISIONS	
1	Revised 10-24-2011 Added inlet and storm sew. pipe

Ditches Shown Thus:

Biofiltration Swales Shown Thus:

No Work Area (except for perm. fence installation) Delineate Per Section 00290.41(b) Shown Thus:

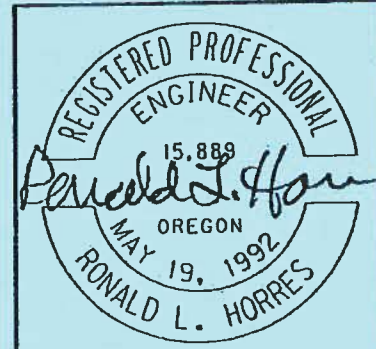

OREGON DEPARTMENT OF TRANSPORTATION	
PARSONS BRINCKERHOFF 400 S.W. Sixth Ave. Portland, OR 97204	
US199-DOWELL RD TO ROGUE COMMUNITY COLLEGE REDWOOD HIGHWAY JOSEPHINE COUNTY	
Design Team Leader - James Burford Designed By - Ronald Horres Drafted By - Anthony O'Donnell	
DRAINAGE & UTILITIES	SHEET NO. 9C

- ① Sta. "RH" 27+68.49, 52.49' Rt. To Sta. 31+88.57, 56.83' Rt.
Inst. 8" drain pipe - 420'
Const. 4 cleanouts
Sta. "RH" 27+68.49, 52.49' Rt.
Sta. 29+00.00, 54.24' Rt.
Sta. 30+50.00, 56.83' Rt.
Sta. 31+88.57, 56.83' Rt.
Connect to 8" storm sew. pipe (E)
- ② Sta. "DS" 50.71.23, 21.47" Lt.
Adjust box - survey monument
- ③ Sta. "DN" 43+89.42, 12.70' Lt.
Adjust box - water valve
- ④ Sta. "RH" 32+38.84, 61.32' Rt.
Remove extg. manhole
Remove extg. 12" storm sew. pipe - 26' W
Const. 96" storm sew. manhole
Rim - 943.85
F.L. (W) - 939.65, CL offset 2.50' N
F.L. (NE) - 939.19, CL offset 1.75' E
F.L. (S) - 940.03, CL offset 1.50' W
Inst. 8" storm sew. pipe - 49' W
5' depth
Connect to 8" drain pipe (W)
Connect to extg. 24" storm sew. pipe (NE)
Connect to 24" storm sew. pipe (S)
- ⚠ ⑤ Sta. "DS" 51+21.95, 25.20' Rt.
Remove extg. inlet
Const. type "G-2" inlet
Rim - 945.58
F.L. (NW) - 942.44
F.L. (S) - 942.44
Connect to 24" extg. storm sew. pipe (NW)
Connect to 24" extg. storm sew. pipe (S)
- ⑥ Sta. "RH" 26+56.23, 50.35' Lt. To Sta. 32+40.41, 50.81' Lt.
Inst. 8" drain pipe - 582'
Const. 5 cleanouts
Sta. "RH" 26+56.23, 50.35' Lt.
Sta. 28+00.00, 50.83' Lt.
Sta. 29+50.00, 50.83' Lt.
Sta. 31+00.00, 50.83' Lt.
Sta. 32+40.41, 50.81' Lt.
Connect to 8" storm sew. pipe
- ⑦ Sta. "RH" 32+40.41, 50.81' Lt. To Sta. "RH" 32+99.19, 48.69' Lt.
Inst. 8" storm sew. pipe - 59' 43'
5' depth
Connect to 8" drain pipe (W)
Connect to extg. storm sew. manhole (E)
F.L. (E) - 939.87.
- ⑧ Sta. "RH" 32+99.19, 48.69' Lt.
Adjust storm sew. manhole - minor
Method B Circular Cut
- ⑨ Sta. "DN" ⁴¹⁺³³ ~~41+18.53~~ 27.98' Rt.
Const. type "CG-3" inlet
Rim - 940.42
F.L. (SW) - 936.61
(See Dwg. No. RD371 And RD372)
Connect to ^{18"} storm sew. pipe (SW)
^{12" INSTALL 28'}
- ⑩ Sta. "DN" 41+06.34, 20.41 Rt.
Remove extg. inlet
Const. storm sew. manhole
Rim - 941.25
F.L. (SW) - 936.47
F.L. (NE) - 936.50
Connect to extg. 18" storm sew. pipe (SW)
Inst. 18" storm sew. pipe - 14' NE
^{12" 5' depth 28'}
- ⑪ Sta. "DN" 42+90.06, 22.14' Rt.
Remove extg. inlet
Const. type "G-2" inlet
Rim - 937.50
F.L. (W) - 934.13
Connect to extg. 12" storm sew. pipe (W)
- ⑫ See sht. 10B, note 3
- ⑬ Sta. "RH" 31+75.66, 67.20' Lt. To Sta. 31+39.84, 73.31' Rt.
Inst. 4" irrigation sleeve - 145'
5' depth
F.L. (N) - 938.00
F.L. (S) - 938.50
Inst. irrigation sleeve end - 2
(For details, see sht. GN-1)
- ⑭ Sta. "RH" 32+76.68, 73.88' Lt. To Sta. 34+11.28, 63.43' Lt.
Inst. 4" irrigation sleeve - 95'
5' depth
F.L. (W) - 939.00
F.L. (E) - 939.00
Inst. irrigation sleeve end - 2
(For details, see sht. GN-1)
- ⑮ Sta. "RH" 34+71.92, 59.78' Lt. To Sta. 34+39.81, 66.19' Rt.
Inst. 4" irrigation sleeve - 130'
5' depth
F.L. (N) - 938.00
F.L. (S) - 937.00
Inst. irrigation sleeve end - 2
(For details, see sht. GN-1)
- ⑯ Sta. "RH" 30+20.56, 64.20' Rt. To Sta. 30+35.65, 50.64' Rt.
Remove exst. 12" culv. pipe - 20'
- ⑰ Sta. "DS" 51+68.15, 13.97' Rt.
Adjust box - water valve
- ⑱ Sta. "DS" 51+30.69, 2.42' Lt.
Adjust san. sew. manhole - minor
Method B Circular Cut
- ⑲ Sta. "DN" 41+60.71, 19.25' Lt.
Adjust box - water valve
- ⑳ Sta. "DN" 42+93.98, 24.25' Rt.
Adjust box - water meter
- ㉑ Sta. "DN" 42+59.35, 3.77' Lt.
Adjust san. sew. manhole - minor
Method B Circular Cut
- ㉒ Sta. "DS" 42+93.68, 15.26' Lt.
Adjust san. sew. manhole - minor
Method B Circular Cut
- ㉓ See Sht. 10B, Note 1
- ㉔ Sta. "DN" 40+77.38, 30.43' Lt.
Remove extg. inlet
Const. type ~~"CG-3"~~ inlet ^{G2}
F.L. (S) - 937.06
F.L. (N) - 937.02
F.L. (E) - 936.45
Connect to extg. 18" storm sew. pipe (S)
Connect to extg. 18" storm sew. pipe (N)
Connect to extg. 18" storm sew. pipe (E)
- ⚠ ㉕ Sta. "DS" 50+88.36, 52.74' Rt.
Remove extg. 24" storm sew. pipe - 12' N
Const. type "CG-3" inlet
Rim - 944.27
F.L. (N) - 940.60
F.L. (S) - 940.60
Connect to extg. 24" storm sew. pipe (S)
Inst. 24" storm sew. pipe (N) - 10'.

REVISIONS	
⚠	Revised 10-24-2011 Added inlet, revised manhole and inlet location/inverts and pipe length.



RENEWS: 06-30-2013

OREGON DEPARTMENT OF TRANSPORTATION	
PB PARSONS BRINCKERHOFF <small>125 400 S.W. Sixth Ave., Portland, OR 97204</small>	
US199-DOWELL RD TO ROGUE COMMUNITY COLLEGE REDWOOD HIGHWAY JOSEPHINE COUNTY	
Design Team Leader - James Burford Designed By - Ronald Horres Drafted By - Anthony O'Donnell	
DRAINAGE & UTILITIES	SHEET NO. 9D