

OPERATION & MAINTENANCE MANUAL

Detention Tank

Manual prepared: July 2019

DFI No. D00726



Figure 1: DFI No. D00726, Access to the detention tank flow control manhole at the outlet

1. Identification

Drainage Facility ID (DFI): D00726
Facility Type: Detention Tank
Construction Drawings: (V-File Numbers) 46V-51
Location: District: 3
Highway No.: 140
Mile Post: 36.29 to 36.34, Right

2. Manual Purpose

The purpose of this manual is to outline inspection needs and summarize maintenance actions.

3. Facility Location

The location map below details the facility location. The highway, mile posts, side streets, access location, and stormwater flow directions are noted on the map.

Facility location type: Roadway shoulder

Flow direction: East to West



Figure 2: Hillsboro – Silverton Hwy.

4. Facility Summary1

The length, width, and depth of the detention tank is based on the dimensions referenced in Figure 3. The depth is the vertical distance measured from the bottom of the detention facility to the rim of the access opening.

The dimensions of the detention facility are:

Facility Type	Length (feet)	Depth (feet)	Number of tanks/pipes	Tank/Pipe Diameter (inches)
Detention Tank	250	20	1	48

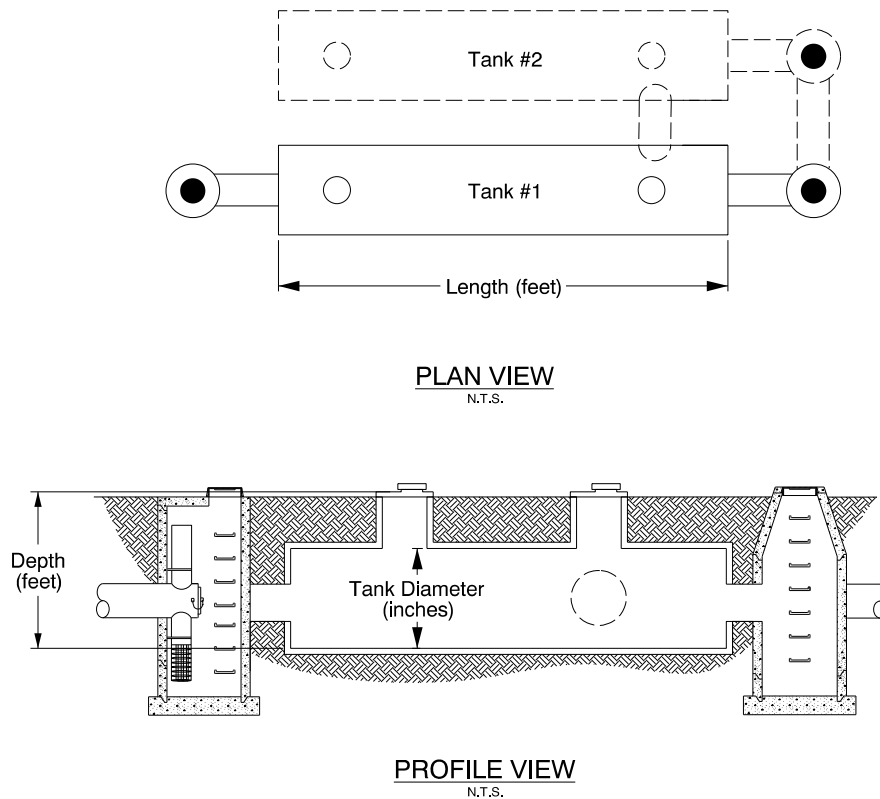


Figure 3: Reference dimensions for a detention tank

Site Specific Information: Stormwater entering the detention tank is being pre-treated by DFI D00692 a Filtterra planter boxe along the Hillsboro-Silverton Hwy.

5. Facility Access

Maintenance access to the facility:

<input type="checkbox"/> Roadside pad	<input checked="" type="checkbox"/> Roadside shoulder
<input type="checkbox"/> Access road with Gate	<input type="checkbox"/> Access road without Gate
<input type="checkbox"/> Confined Space Entry	<input type="checkbox"/> Lane Closure needed



Figure 4: Roadside shoulder on Hillsboro-Silverton Hwy.

6. Operational Components / Maintenance Items

Classification and Standard Operational (Op) Plan:

This facility is classified as a:

<input checked="" type="checkbox"/> Operational Plan A Detention Tank	<input type="checkbox"/> Operational Plan B Detention Vault	<input type="checkbox"/> Operational Plan C Manifold Detention System
<p>A standard operational plan illustrates the general facility footprint configuration and explains the purpose of each facility component. Operational plans (A, B, C) are provided in the Standard Operation Manual.</p>		

See Appendix A for the site specific operational plan.

Key Features/Items:

This facility has a bypass component (T2). T2 is a(n):

<input type="checkbox"/> Weir type flow splitter	<input type="checkbox"/> Orifice type flow splitter	<input type="checkbox"/> Other: Describe type
---	--	--

This facility has a Pre-treatment Manhole (T1). T1 is a(n):

<input type="checkbox"/> ODOT Pollution control manhole
<input type="checkbox"/> CDS (Continuous Deflective Separator)
<input type="checkbox"/> Downstream Defender
<input checked="" type="checkbox"/> Filtterra(s)
<input type="checkbox"/> Bayfilter

Include manufacturer’s Operaion and Maintenance manual as part of this document. Attach as Appendix C.

Operational Components

The facility components table (**Table 1**) has been provided to highlight the applicable components for this facility. The component is in use when the box contains an “x” (e.g.).

The Standard Operation Manual for detention tanks/vaults, implemented October 2018, outlines facility operation, typical footprint configuration, and component definitions and details. A link to the manual is attached to the feature marker in TransGIS.

<https://gis.odot.state.or.us/TransGIS/>

Maintenance Items

Operational components marked in **Table 1** should be inspected and maintained according to Section 7. Each facility component is defined and detailed in the Standard Operation Manual using the associated ID number indicated below.

Table 1: Detention Tank/Vault Components		ID #
Manholes		
Pre-Treatment Manhole/Inlets	<input checked="" type="checkbox"/>	T 1
Flow Splitter Manhole	<input type="checkbox"/>	T 2
Flow Control Manhole	<input checked="" type="checkbox"/>	T 3
Standard Manhole	<input checked="" type="checkbox"/>	T 4
Sump	<input checked="" type="checkbox"/>	T 5
Facility Inlet		
Inlet Pipe: 2-12" & 18"	<input checked="" type="checkbox"/>	T 6
Facility Structures		
Main Tank/Vault	<input checked="" type="checkbox"/>	T 7
Additional Back-Up Tank	<input type="checkbox"/>	T 8
Manifold Pipe	<input type="checkbox"/>	T 9
Connecting Pipe	<input checked="" type="checkbox"/>	T 10
Access Opening	<input checked="" type="checkbox"/>	T 11
Facility Outlet		
Outlet Flow Control	<input checked="" type="checkbox"/>	T 12
Drainage Mechanism	<input checked="" type="checkbox"/>	T 13
Outlet Pipe: 18"	<input checked="" type="checkbox"/>	T 14
Outfall Type		
Outfall (Waterbody, Creek/Lake/Ocean)	<input type="checkbox"/> C	T 15
	<input type="checkbox"/> L	
	<input type="checkbox"/> O	
Ditch	<input type="checkbox"/>	T 16
Storm Drain System	<input checked="" type="checkbox"/>	T 17
Outfall Components		
Riprap Bank Protection	<input type="checkbox"/>	T 18

7. Maintenance

Maintenance Frequency/Maintain Records

- a. Inspect annually. Preferably prior to the rainy season.
- b. Clean and maintain as necessary. Refer to Activity 125 in the Maintenance Guide for conditions when maintenance is needed.
- c. Keep a record of inspections, maintenance, and repairs.

Maintenance Guide/Maintenance Actions

The Maintenance Guide outlines the standard maintenance actions for water quality facilities under Activity 125.

There are standard maintenance tables for standard ODOT designs. The maintenance tables describe the maintenance component, the defect or problem, the condition when maintenance is needed, and the recommended maintenance to correct the problem. Use the following tables to maintain ODOT detention tanks or vaults:

- Table 1 (General Maintenance): Contains general maintenance and inspection guidelines that are applicable to all ODOT water quality and detention facilities
- Table 6 (Detention Vaults): Contains maintenance information for detention vaults
- Table 7 (Detention Tanks): Contains maintenance information for detention tanks and large diameter pipe

For this facility,

<input checked="" type="checkbox"/> Jet Rodding is allowed	<input type="checkbox"/> Jet rodding in <u>NOT</u> allowed
---	---

The ODOT Maintenance Guide can be viewed at the following website:

<http://www.oregon.gov/ODOT/HWY/OOM/pages/mguide.aspx>

The Blue Book can be viewed at the following website:

http://www.oregon.gov/ODOT/Maintenance/Documents/blue_book.pdf

8. Limitations

Care should be taken when vehicles enter the facility to prevent the creation of depressions (tire ruts) and limit damage to vegetation and structural components. Maintenance vehicles should remain upon provided access areas.

9. Waste Material Handling

Material removed from the facility is defined as waste by the Department of Environmental Quality (DEQ). Refer to the road waste section of the ODOT Maintenance Yard Environmental Management System (EMS) Policy and Procedures Manual for disposal options:

<http://www.oregon.gov/ODOT/HWY/OOM/pages/ems.aspx>

Contact any of the following for more detailed information about management of waste materials found on site:

ODOT Clean Water Unit	(503) 986-3008
ODOT Statewide Hazmat Coordinator	(503) 667-7442
ODOT Region 1 Hazmat Coordinator	(503) 731-8290
ODOT Region 2 Hazmat Coordinator	(503) 986-2647
ODOT Region 3 Hazmat Coordinator	(541) 957-3594
ODOT Region 4 Hazmat Coordinator	(541) 388-6186
ODOT Region 5 Hazmat Coordinator	(541) 963-1590
ODEQ Northwest Region Office	(503) 229-5263

A Appendix A – Site Specific Operational Plan

Contents:

Operational Plan: DFI D00726

B Appendix B – Project Contract Plans

Contents:

Site Specific Subset of Project Contract Plan 46V-51




Willow Ave.


Mile Point 36.29

Mile Point 36.34

Detention Tank (DFI D00726)

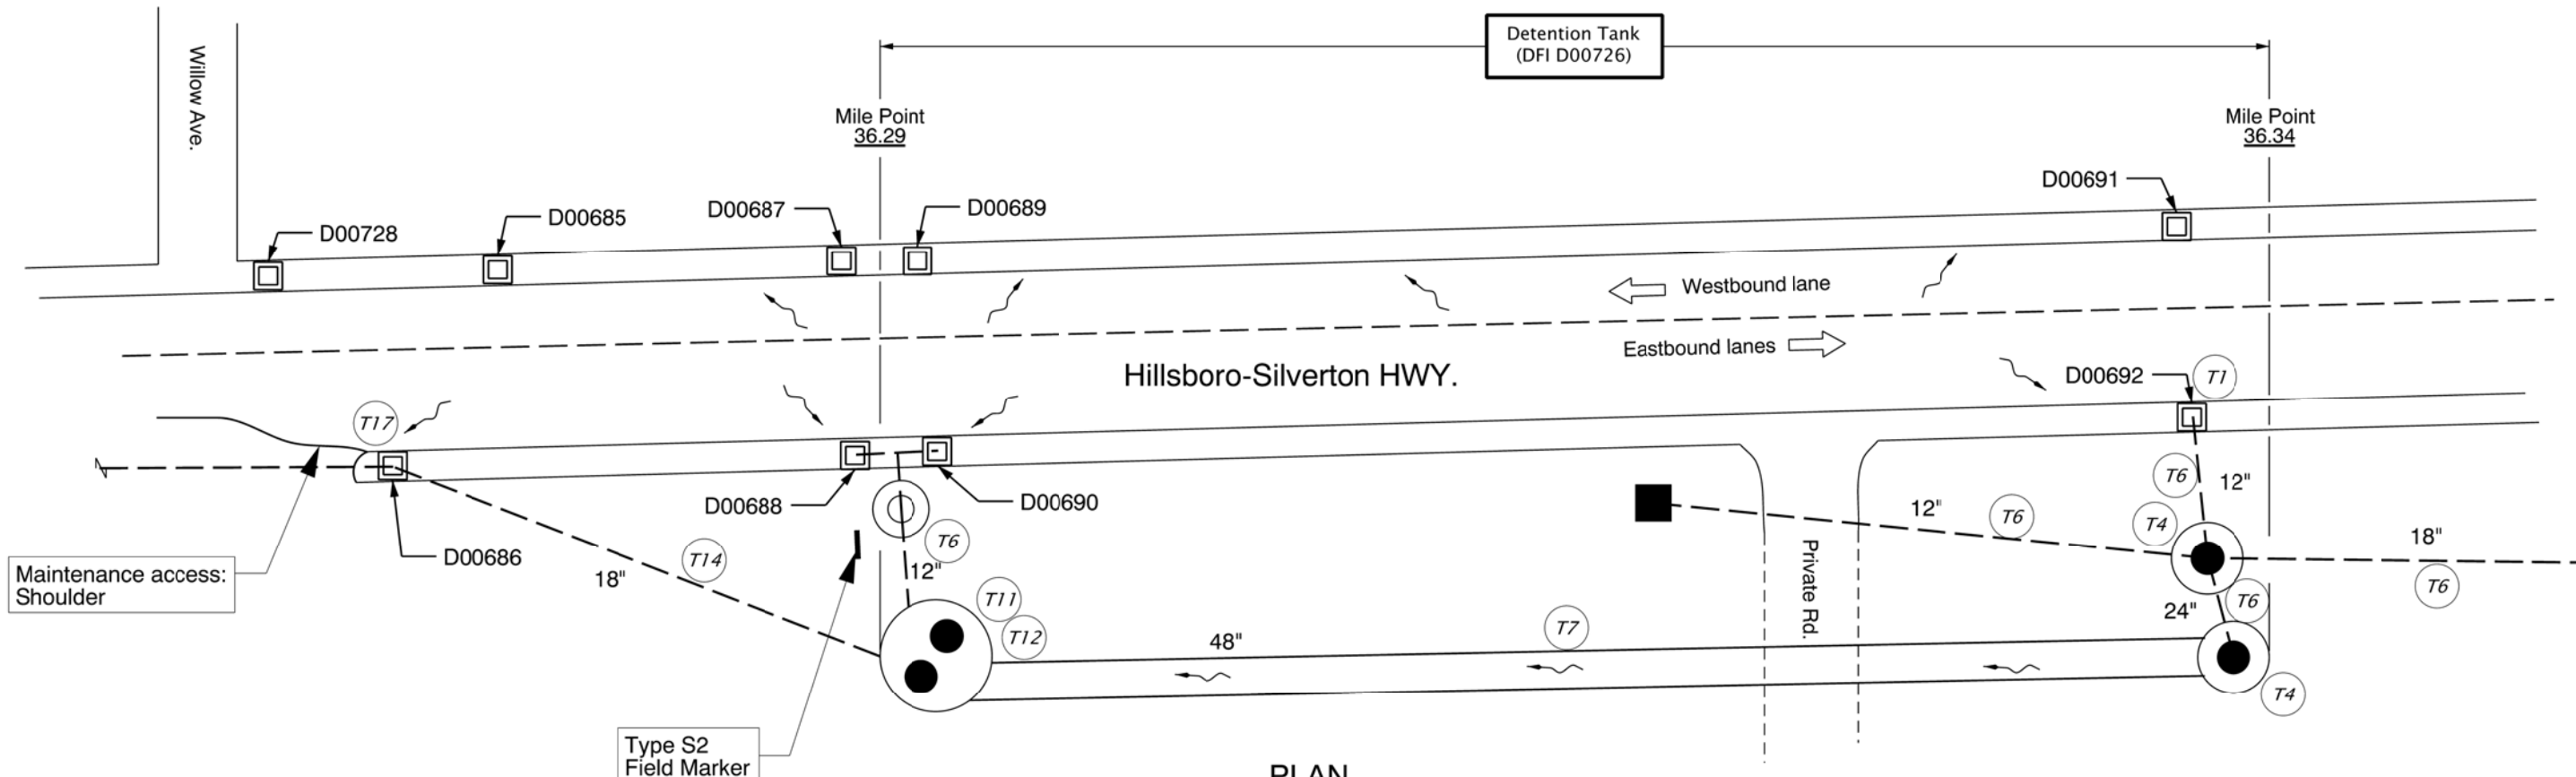


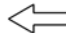
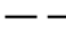


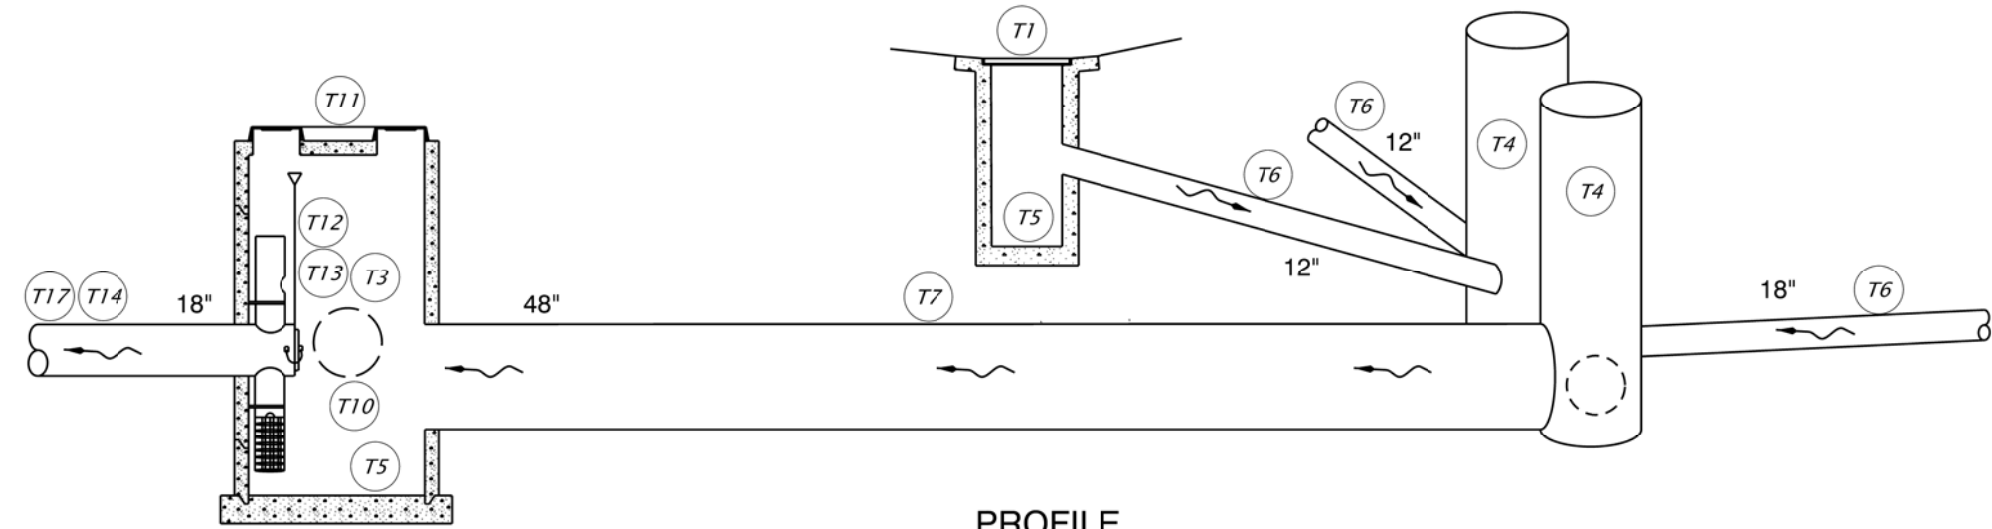PLAN
N.T.S.



PROFILE
N.T.S.

LEGEND

-  Stormwater Flow Path
-  Manhole
-  Filtera
-  Traffic Flow Direction
-  Storm Pipe Flow Direction

Prepared By:
Ramiro Perez

Drafted By:
Serge Chernishoff

OREGON DEPARTMENT OF TRANSPORTATION

DFI D00726
MAINTENANCE DISTRICT 3 HWY 140
DETENTION TANK
 HIGHWAY MP 36.29-36.34
 Marion County

C Appendix C – Proprietary Manufacturer’s O&M Manual

Contents:

Manufacturer’s Operation & Maintenance Manual

46V-51

INDEX OF SHEETS	
SHEET NO.	DESCRIPTION
1	Title Sheet
1A	Index Of Sheets Contd.
1A-2	Index Of Sheets Contd.
1A-3	Standard Drg. Nos.

STATE OF OREGON
 DEPARTMENT OF TRANSPORTATION
 PLANS FOR PROPOSED PROJECT

GRADING, DRAINAGE, STRUCTURES, PAVING, SIGNING,
 ILLUMINATION, SIGNAL & ROADSIDE DEVELOPMENT


**FFO - I-5 @ OR214 INTERCHANGE
 (WOODBURN) DEVELOPMENT SEC.**

HILLSBORO - SILVERTON HIGHWAY

MARION COUNTY

Ⓐ JUNE 2013

**BEGINNING OF
 CONTRACT PROJECT**
STP-S140(045)
 STA. "L"952+05 (M.P. 276.01)

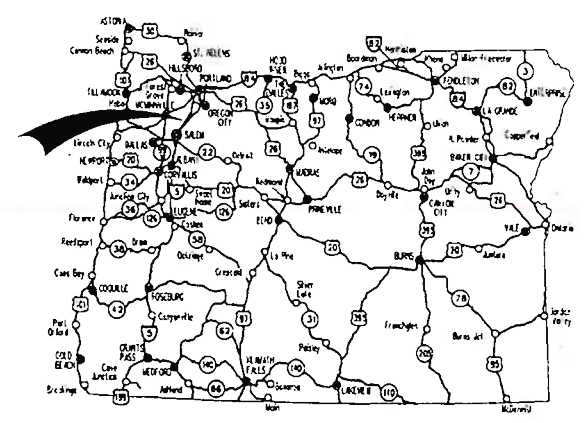

Overall Length Of Project - 2.76 Miles


ATTENTION:
 Oregon Law Requires You To Follow Rules
 Adopted By The Oregon Utility Notification
 Center. Those Rules Are Set Forth In
 OAR 952-001-0010 Through OAR 952-001-0090.
 You May Obtain Copies Of The Rules By Calling
 The Center. (Note: The Telephone Number For
 The Oregon Utility Center Is (503) 232-1987.)



REVISED AS CONSTRUCTED
 CONTRACT

John [Signature] 10/26/17
 PROJECT MGR

No.	DATE	REVISIONS	BY
Ⓐ	4-18-13	Edited station & MP for the end of contract	J.O.L.
Ⓑ	5-16-13	Changed date	C.A.C.

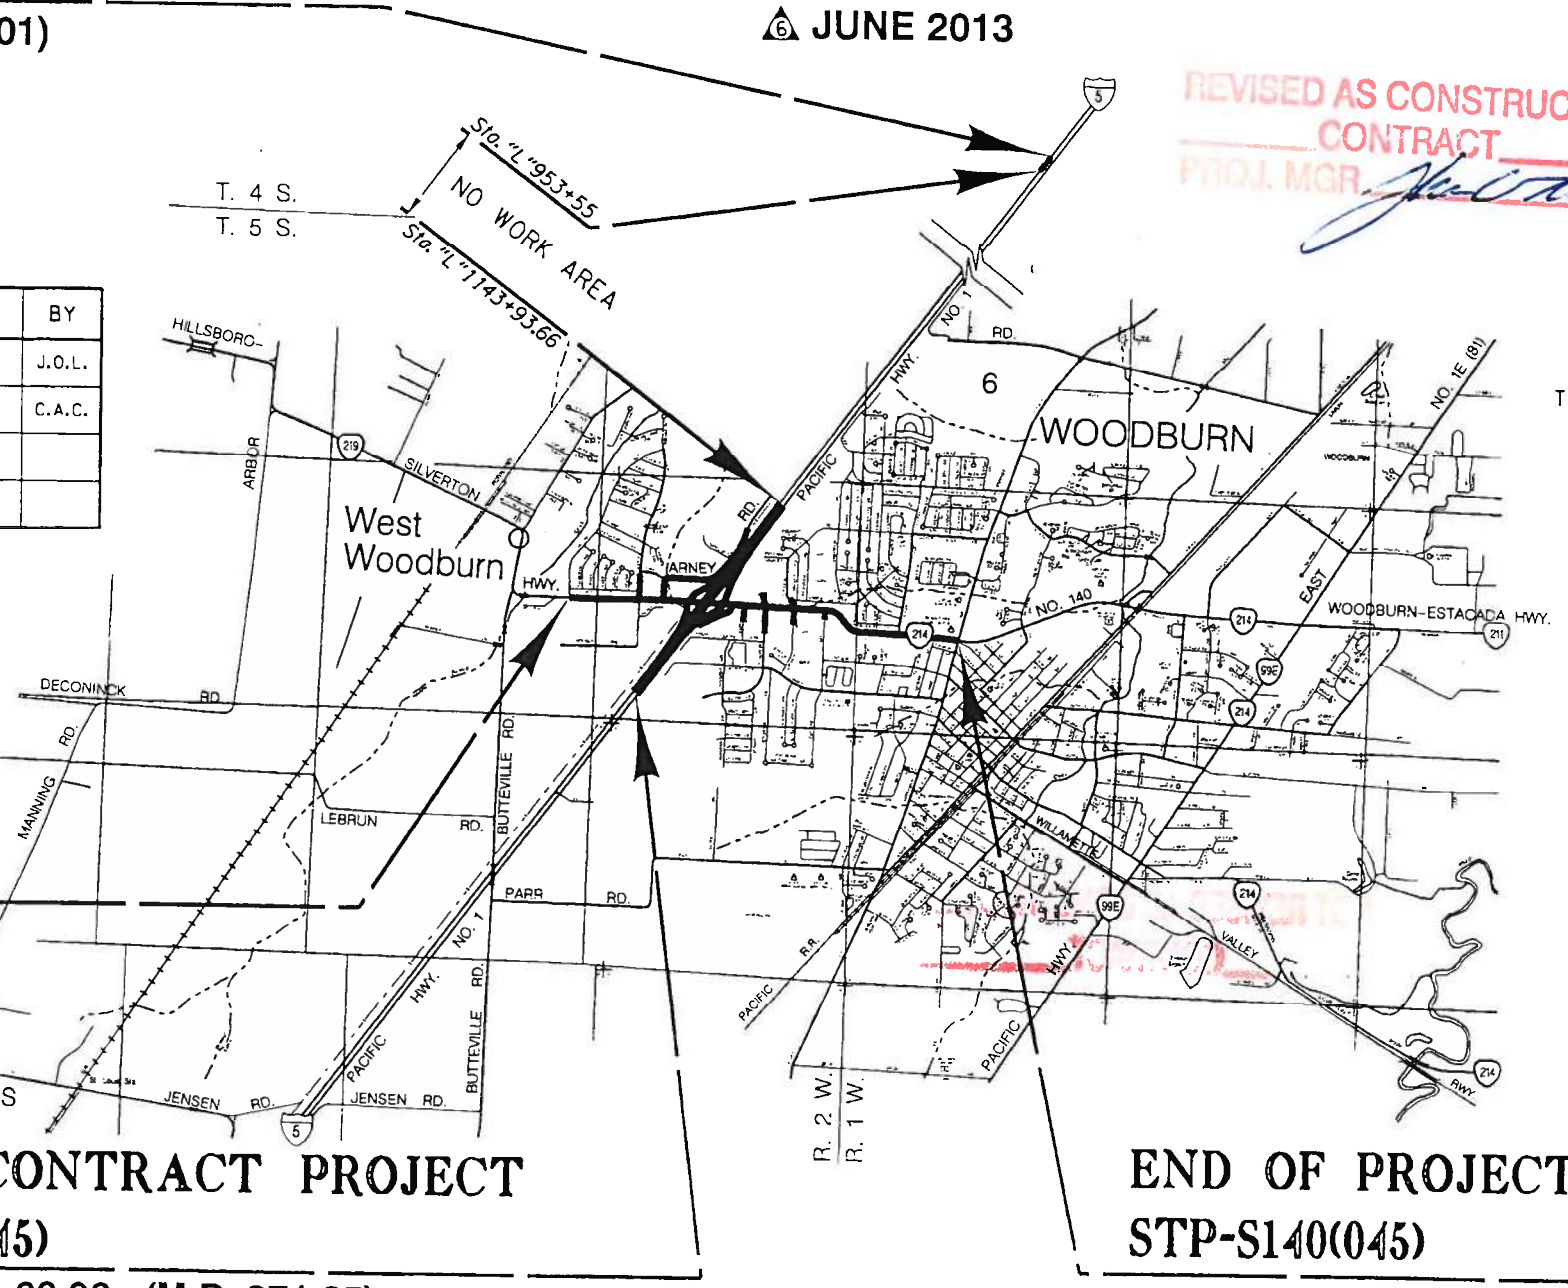

T. 5 S., R. 1 & 2 W., W.M.



**BEGINNING OF
 PROJECT**
STP-S140(045)
 STA. "HSc"477+21
 (M.P. 36.24)

END OF CONTRACT PROJECT
STP-S140(045)
 Ⓐ STA. "L"1199+66.06 (M.P. 271.35)

END OF PROJECT
STP-S140(045)
 STA. "HSc"562+67.5 (M.P. 37.87)

- OREGON TRANSPORTATION COMMISSION
- Pat Egan CHAIR
 - David Lohman COMMISSIONER
 - Mary F. Olson COMMISSIONER
 - Mark Frohnmayer COMMISSIONER
 - Tommy Baney COMMISSIONER
 - Matthew L. Garrett DIRECTOR OF TRANSPORTATION

These plans were developed using ODOT design standards. Exceptions to these standards, if any, have been submitted and approved by the ODOT Chief Engineer or their delegated authority.

By: *Michael T. Long* 5-20-13
 Signature & date
 Michael T. Long - R2 Tech Center Manager
 Print name and title

 Concurrence by ODOT Chief Engineer

FFO - I-5 @ OR214 INTERCHANGE
 (WOODBURN) DEVELOPMENT SEC.
 HILLSBORO - SILVERTON HIGHWAY
 MARION COUNTY

FEDERAL HIGHWAY ADMINISTRATION	PROJECT NUMBER	SHEET NO.
OREGON DIVISION	STP-S140(045)	1

PE00 0559 040

INDEX OF SHEETS, CONTO.	
SHEET NO.	DESCRIPTION
① 2, 2A Thru 2A-25 Incl.	Typical Sections
① 2B Thru 2B-25 Incl.	Details
2C Thru 2C-3 Incl.	Traffic Control Details
2C-4 Thru 2C-18 Incl.	Traffic Control Plans
③ 2C-18A Thru 2C-20 Incl.	Shts. Removed
2C-21 Thru 2C-30 Incl.	Traffic Control Plans
③ 2C-31 Thru 2C-34 Incl.	Shts. Removed
2C-35 Thru 2C-67 Incl.	Traffic Control Plans
2D Thru 2D-9 Incl.	Pipe Data Sheet
3	General Construction
3A	Drainage & Utilities
3A-2	Drainage Notes
3B & 3C	"HSc" Profile
4	Alignment
4A	General Construction
4A-2	Construction Notes
4B	Drainage & Utilities
4B-2	Drainage Notes
4C, 4D & 4E	"HSc" & "WD" Profiles
5	Alignment
5A	General Construction
5A-2	Construction Notes
5B	Drainage & Utilities
5B-2	Drainage Notes
5C, 5D & 5E	"HSc" & "AR" Profiles
6	Alignment
6A	General Construction
6A-2	Construction Notes
6B	Drainage & Utilities
6B-2	Drainage Notes
6C, 6D, 6E, 6F, 6G, 6H, 6J, 6K, 6L, 6M, 6N, 6P & 6Q	"HSc", "A2", "B2", "C2", "D2", "G2", "J2", "NB", "SB", "BT", "CT" & "DT" Profiles
7	Alignment
7A	General Construction
7A-2	Construction Notes
7B	Drainage & Utilities
7B-2 & 7B-3	Drainage Notes
7C, 7D, 7E & 7F	"HSc", "LA" & "ER" Profiles

INDEX OF SHEETS, CONTO.	
SHEET NO.	DESCRIPTION
8	Alignment
8A	General Construction
8A-2	Construction Notes
8B	Drainage & Utilities
8B-2 & 8B-3	Drainage Notes
8C, 8D, 8E & 8F	"HSc", "OW", "T" & "CD" Profiles
9	Alignment
9A	General Construction
9B	Drainage & Utilities
9B-2	Drainage Notes
9C & 9D	"HSc" Profiles
10	General Construction
10A	"HSc" Profile
11	General Construction
12	General Construction
13	General Construction
13A	Drainage & Utilities
13B	"NB" Profile
14	Alignment
14A	General Construction
14B	Drainage & Utilities
14B-2	Drainage Notes
14C, 14D & 14E	"AR", "NB" & "SB" Profiles
15	Alignment
15A	General Construction
15B	Drainage & Utilities
15B-2	Drainage Notes
15C & 15D	"NB" & "SB" Profiles
16	General Construction
16A	Drainage & Utilities
16A-2	Drainage Notes
16B	"SB" Profile
① 16C	Sht. Removed
17	General Construction


NOT REVISED AS CONSTRUCTED
CONTRACT 14581

INDEX OF SHEETS, CONTO.	
SHEET NO.	DESCRIPTION
GEO/HYDRO	
① GA Thru ① GA-3 Incl.	Erosion Control Details
① GA-4 Thru ① GA-13 Incl.	Erosion Control Plans
GB	Geotechnical Data Layout
GB-2 Thru ① GB-13 Incl.	Geotechnical Data
GC	Retaining wall no. 1 plan and elevation
GC-2	Retaining wall no. 1 details
GC-3	Retaining wall no. 2 plan and elevation
GC-4 & GC-5	Retaining wall no. 2 details
GC-6 & GC-7	Retaining wall no. 3 plan and elevation
GC-8	Retaining wall no. 3 details
OTAK INC.	
GC-9 & GC-10	Retaining wall 4 plan
GC-11	Retaining wall 4 details
GD	Sound Wall Layout & Index
GD-2 Thru ① GD-7 Incl.	Sound Wall Plan & Elevation
GD-8	Sound Wall Details
GD-9 Thru ① GD-17 Incl.	Sound Wall Plan & Elevation
GD-18 Thru ① GD-20 Incl.	Sound Wall Details
OTAK INC.	
② GD-21	Block Pattern Details
GD-22	Soundwall details
GJ Thru ① GJ-4 Incl.	Stormwater Plan
GJ-5 Thru ① GJ-11 Incl.	Stormwater Details
OTAK INC.	
GN Thru ① GN-86 Incl.	Roadside Development

INDEX OF SHEETS, CONTO.	
SHEET NO.	DESCRIPTION
STRUCTURE NO. 07802A	
91378	Plan & Elevation
91379	General Notes & Permit Loading
91380	Construction Sequence & Misc. Details
91381	Foundation Data
91382	Staging
91383	Temporary Concrete Barrier Details
91384	End Panel Replacement Staging
91385	Footing Plan
91386	Spiral Splice & Pile Splice Details
91387	Deck Plan - Spans 1 & 2
91388	Deck Plan - Spans 3 & 4
91389	Typical Deck Section
91390	Deck Reinforcement Over Interior Bents
91391	Girder Schedule & Details
91392	Girder Details
91393	Bent 1 Plan & Elevation (Bent 5 Similar)
91394	Bent 1 Details (Bent 5 Similar)
91395	Bent 1 Section (Bent 5 Similar)
91396	Bent 2 Plan & Elevation (Bent 4 Similar)
91397	Bent 2 Details (Bent 4 Similar)
91398	Bent 2 Section (Bent 4 Similar)
91399	Bent 3 Plan & Elevation
91400	Bent 3 Details
91401	Bent 3 Section
91402	Column Footing Details
91403	Wingwall & Slope Paving Retaining Wall Details
91404	Luminaire Base Details
91405	Sidewalk South Side Detail
OTAK INC.	
91406	Bridge Rail Typical Panel Elevation
91407	Bridge Rail Panel Details
91408	Bridge Rail Post And Panel Details
91409	Bridge Rail Typical Arch Elevation
91410	Bridge Rail Arches Details
91411	Bridge Rail Misc. Details
91412	Bridge Rail South Side Plan & Elevation
91413	Bridge Rail South Side Plan & Elevation
91414	Bridge Rail South Side Plan & Elevation
91415	Bridge Rail North Side Plan & Elevation
91416	Bridge Rail North Side Plan & Elevation
91417	Bridge Rail North Side Plan & Elevation

No.	DATE	REVISIONS	BY
①	4-18-13	Removed shts. 2A-26 & 16C Added sht. 2B-25	J.O.L.
②	4-23-13	Sheet added	C.A.C.
③	5-3-13	Removed shts.	D.R.M.
④	5-21-13	Removed 2 shts. & renumbered the GA series	D.R.M.

FFO-1-5 @ OR214 INTERCHANGE (WOODBURN) DEVELOPMENT SEC. HILLSBORO - SILVERTON HIGHWAY MARION COUNTY		
FEDERAL HIGHWAY ADMINISTRATION	PROJECT NUMBER	SHEET NO.
OREGON DIVISION		1A

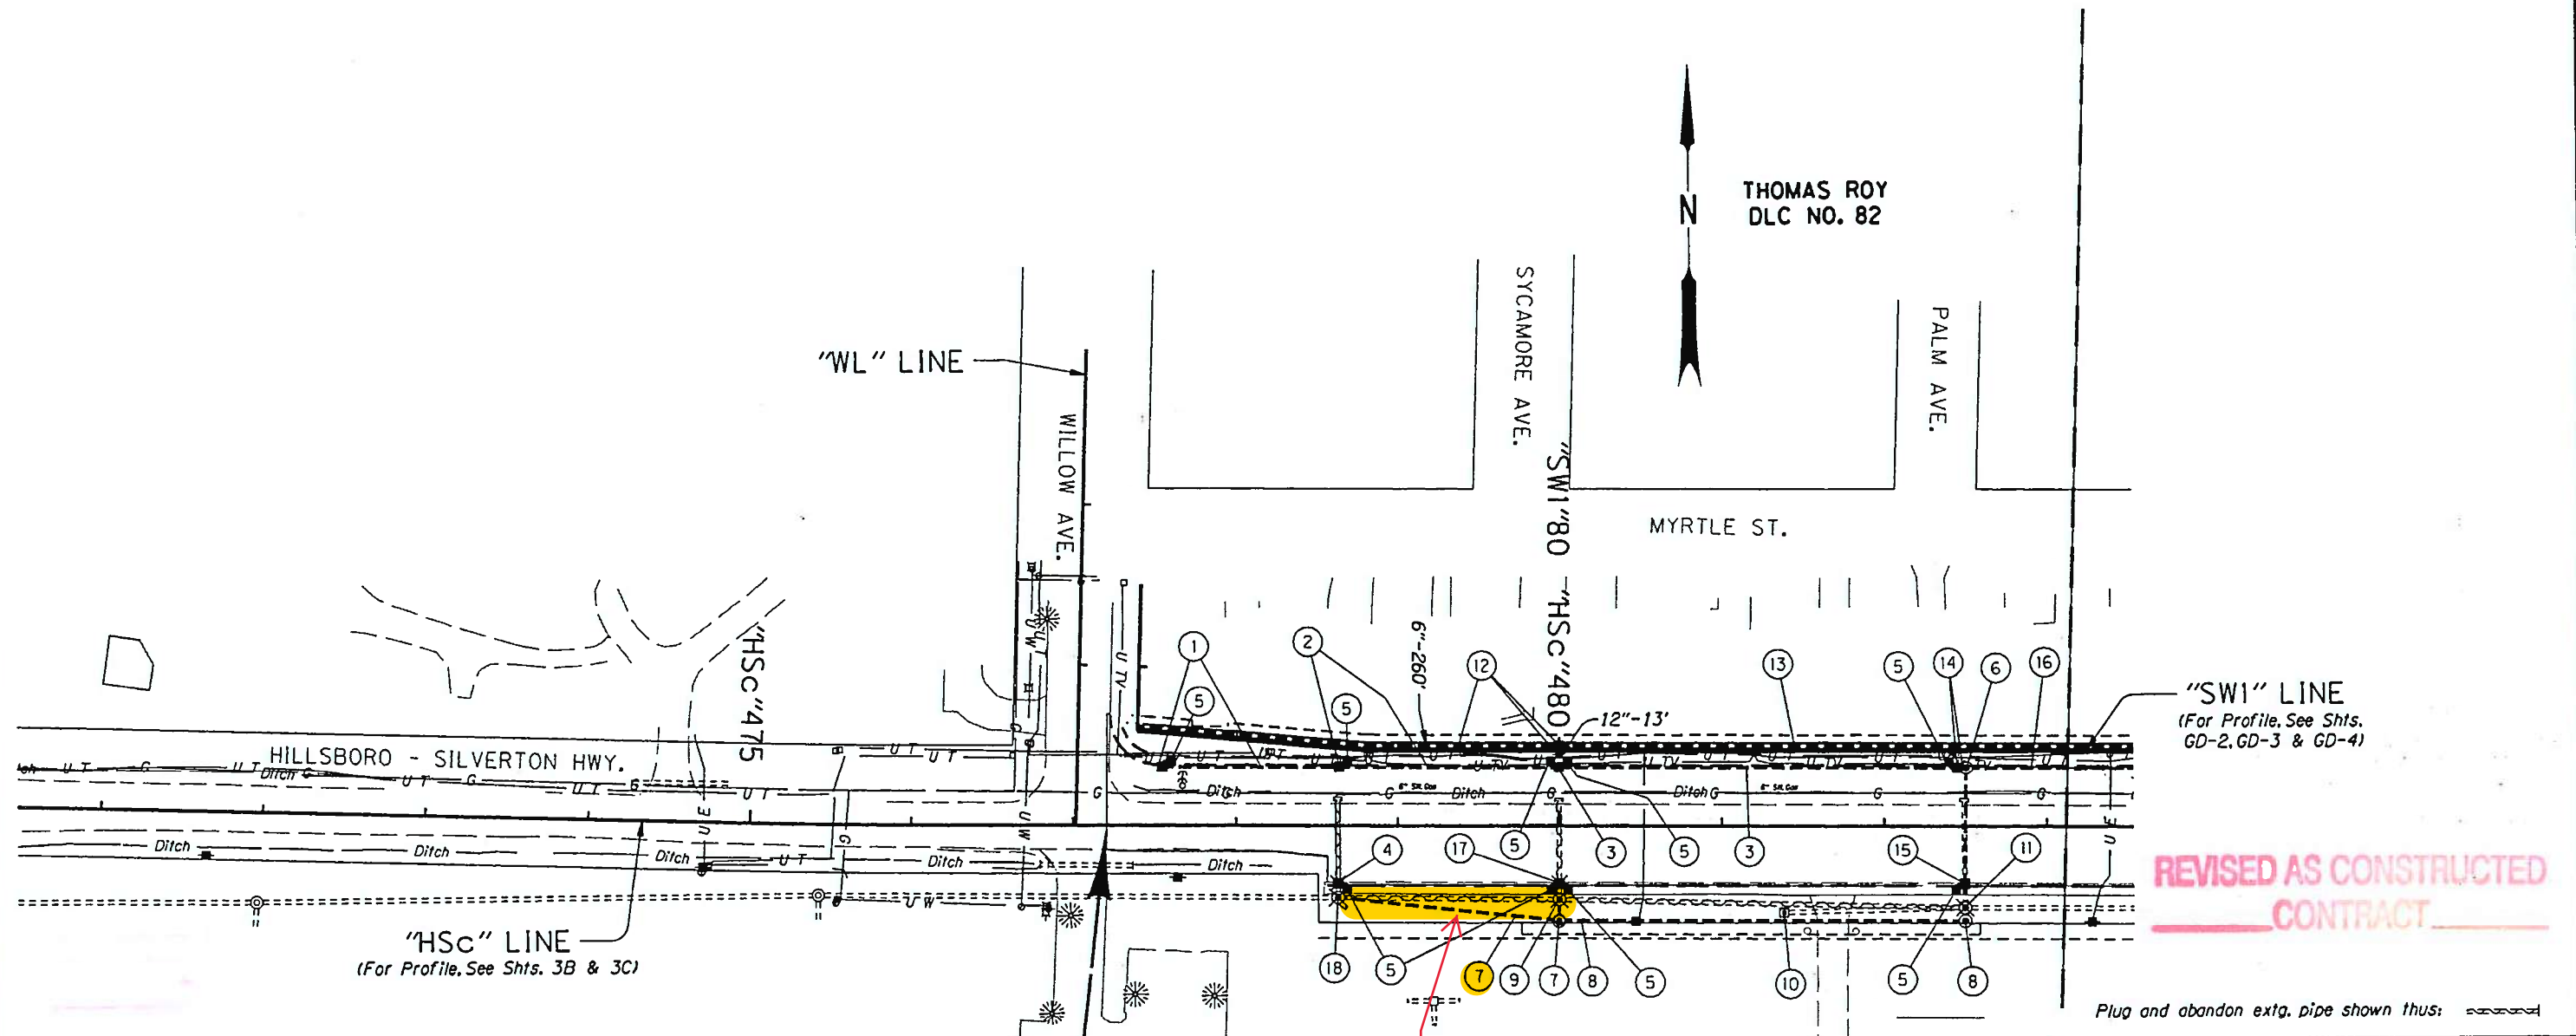


"HSc" LINE
(For Profile, See Shts. 3B & 3C)

"SWI" LINE
(For Profile, See Shts. GD-2, GD-3 & GD-4)

REVISED AS CONSTRUCTED
CONTRACT

Plug and abandon extg. pipe shown thus:

BEGINNING OF PROJECT
STP-S140(045)
STA. "HSc" 477+21 (M.P. 36.24)

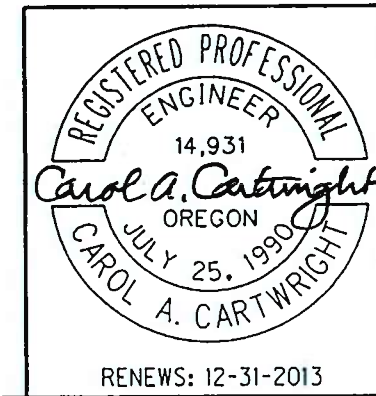

OREGON DEPARTMENT OF TRANSPORTATION	
REGION 2 TECH CENTER	
FFO-15 @ OR214 INTERCHANGE (WOODBURN) DEVELOPMENT SEC. HILLSBORO - SILVERTON HIGHWAY MARION COUNTY	
Design Team Leader - Carol Cartwright Designed By - John Lucas Drafted By - Charlotte Gerken	
DRAINAGE & UTILITIES	SHEET NO. 3A

1 Sta. "HSc"477+55 to Sta. "HSc"478+63.8 Lt.
Const. type "CG-2" Mod. inlet
Adjust inlet
Inst. 12" storm sew. pipe - 109'
5' depth
(For details, see sht. 2B-15)
(See drg. nos. RD300, RD326, RD366,
RD376, RD380, RD384, RD386, RD388,
RD390, RD391 & RD393)

2 Sta. "HSc"478+63.8 to Sta. "HSc"480+00. Lt.
Const. type "CG-2" Mod. inlet
Adjust inlet
Inst. 12" storm sew. pipe - 136'
5' depth
(For details, see sht. 2B-15)

3 Sta. "HSc"480+00 to Sta. "HSc"482+50.3 Lt.
Const. type "CG-2" Mod. inlet
Adjust inlet
Inst. 12" storm sew. pipe - 250'
5' depth
(For details, see sht. 2B-15)

4 Sta. "HSc"478+68.8
Remove extg. inlet
Const. type "CG-2" Mod. inlet
Adjust inlet
(For details, see sht. 2B-15)

5 Const. water quality structure - 9
Connect to inlet
(For details, see shts. GJ-10 & GJ-11)

6 Sta. "HSc"482+50. Lt.
Remove extg. pipe - 74'
Const. manhole
Step orientation - 312°
Minor adjust manhole
Inst. 18" storm sew. pipe - 87'
10' depth
Connect to extg. manhole
(See drg. nos. RD335, RD336, RD344,
RD356 & RD360)

D00726

7 Sta. "HSc"478+63.5 to Sta. "HSc"480+00.3, Rt.
Const. flow control manhole 84" dia.
Connect to extg. manhole
Inst. 18" storm sew. pipe - 138'
20' depth
(For details, see shts. GJ-7 & GJ-8)
(See drg. nos. RD340 & RD346)

8 Sta. "HSc"480+00.3 to Sta. "HSc"482+50, Rt.
Const. manhole, 84" dia.
Step orientation - 180°
Inst. 48" storm sew. pipe - 250'
20' depth
(For details, see sht. GJ-7)

9 Sta. "HSc"480+00, Rt.
Minor adjust manhole
Inst. 12" storm sew. pipe - 12'
5' depth
(For details, see sht. GJ-7)

10 Sta. "HSc"481+38.5, Rt.
Adjust inlet
(See drg. no. RD376)
INST. 6" STORM SEW. PIPE - 10'

11 Sta. "HSc"482+50, Rt.
Major adjust manhole
Inst. 24" storm sew. pipe - 7'
5' depth

12 Sta. "HSc"477+40 to Sta. "HSc"479+99.8, Lt.
Const. 24" area drainage basin, without apron
Inst. 6" subsurface drain pipe - 260' 263'
5' depth
Inst. 12" storm sew. pipe - 13'
5' depth
Drainage geotextile type "1" - 240 sq. yd.
(See drg. nos. RD312 & RD374)

13 Sta. "HSc"480+03 to Sta. "HSc"484+00, Lt.
Inst. 6" subsurface drain pipe - 400' 397'
5' depth
Drainage geotextile type "1" - 370 sq. yd.

14 Sta. "HSc"482+45 to Sta. "HSc"482+50.3, Lt.
Const. type "CG-2" Mod. inlet
Adjust inlet
Inst. 12" storm sew. pipe - 5'
5' depth
(For details, see sht. 2B-15)

15 Sta. "HSc"482+50, Rt.
Remove extg. inlet
Const. type "CG-2" Mod. inlet
Adjust inlet
Inst. 12" storm sew. pipe - 15'
5' depth
(For details, see sht. 2B-15)


16 Sta. "HSc"482+50.3 to Sta. "HSc"484+05.7, Lt.
Inst. 12" storm sew. pipe - 155'
10' depth

17 Sta. "HSc"480+05.6
Remove extg. inlet
Const. type "CG-2" Mod. inlet
Adjust inlet
(For details, see sht. 2B-15)

18 Sta. "HSc"478+63.5, Rt.
Major adjust manhole


REVISED AS CONSTRUCTED
CONTRACT

No.	DATE	REVISIONS	BY
1	4-18-13	Edited text	J.O.L.
2	5-21-13	Edited text	C.A.C.

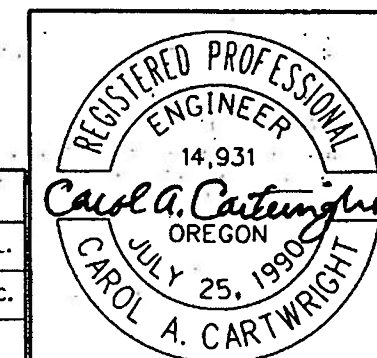


RENEWS: 12-31-2013

OREGON DEPARTMENT OF TRANSPORTATION	
REGION 2 TECH CENTER	
FFO-1-5 @ OR214 INTERCHANGE (WOODBURN) DEVELOPMENT SEC. HILLSBORO - SILVERTON HIGHWAY MARION COUNTY	
Design Team Leader - Carol Cartwright Designed By - John Lucas Drafted By - Charlotte Gerken	
SHEET NO.	3A-2

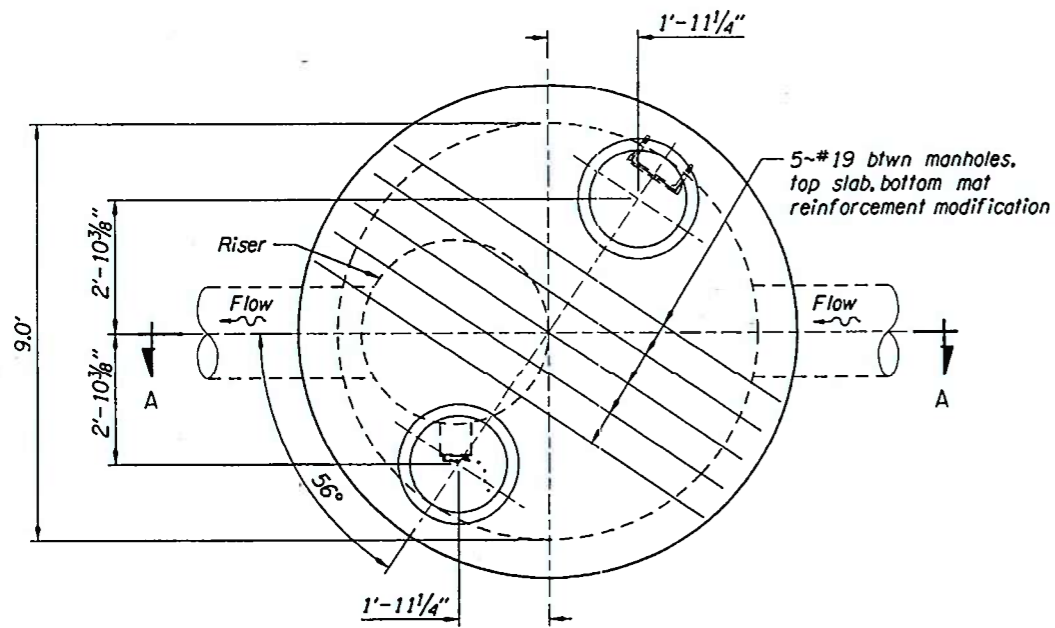


PLAN
STA. "D2"67+46.00

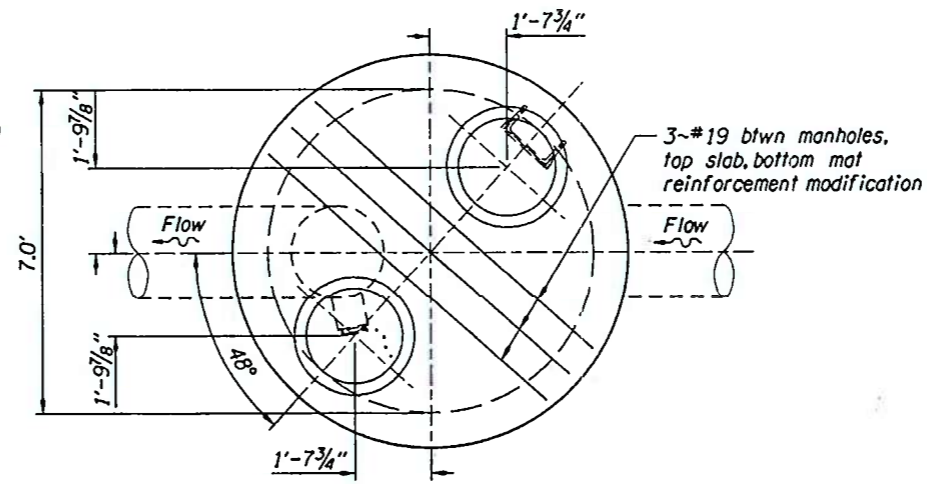

PLAN
STA. "HSc"479+85.98
Storage pond No. 00726

MANHOLE INLET AND OUTLET TABLE

STATION	OFFSET (Ft.)	INVERT EL. (A) (Ft.)	UPPER ORIFICE CTR. EL. (B) (Ft.)	RISER RIM EL. (C) (Ft.)	INVERT EL. (D) (Ft.)	TOP OF MANHOLE COVER EL. (E) (Ft.)	RISER DIA. (F) (In.)	UPPER ORIFICE DIA. (G) (In.)
"D2"67+46.00	33.22 ll.	175.15	177.32	179.65	175.15	190.80	48	16.0
"HSc"479+85.98	58.63 rl.	173.56	180.61	182.08	173.49	185.70	24	4.5

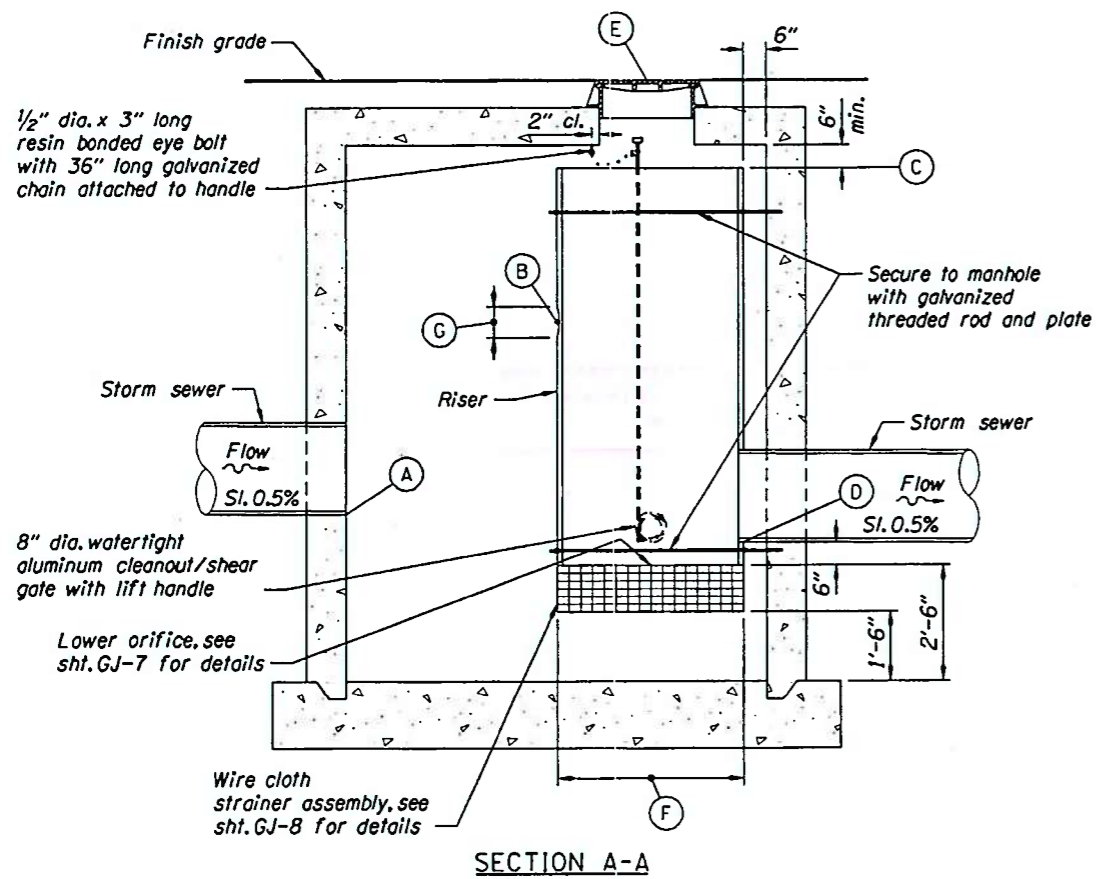


SECTION A-A

NOT REVISED AS CONSTRUCTED
CONTRACT


NOTES:
For manhole details not shown, see dwgs. RD336, RD344, RD346 & RD356.

Riser and outlet pipe identical materials.

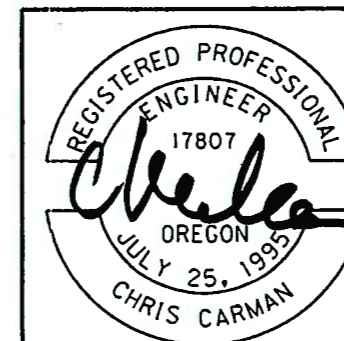


RENEWS: 12-31-2013

OREGON DEPARTMENT OF TRANSPORTATION	
REGION 2 TECH CENTER	
FFO-1-5 @ OR214 INTERCHANGE (WOODBURN) DEVELOPMENT SEC. HILLSBORO - SILVERTON HIGHWAY MARION COUNTY	
Reviewed By - Bruce Carmichael Designed By - Chris Carman Drafted By - Sandra Gish	SHEET NO. GJ-7
STORMWATER STORAGE POND DETAILS	

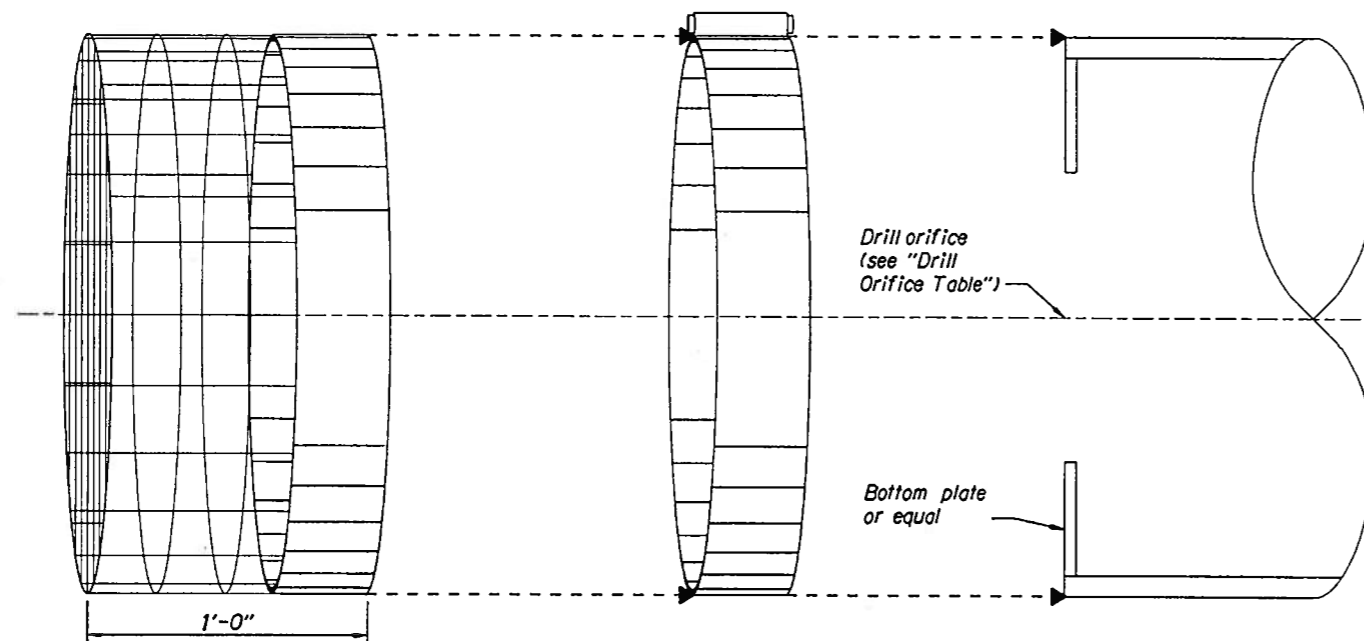


FLOW CONTROL MANHOLE WIRE STRAINER ASSEMBLY

FLOW CONTROL MANHOLE WIRE STRAINER ASSEMBLY

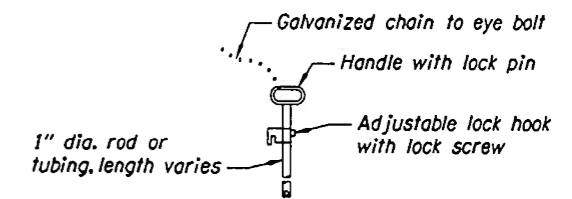

LIFT HANDLE

6 holes, evenly spaced on 10 7/8" bolt circle for bolting to flange connection

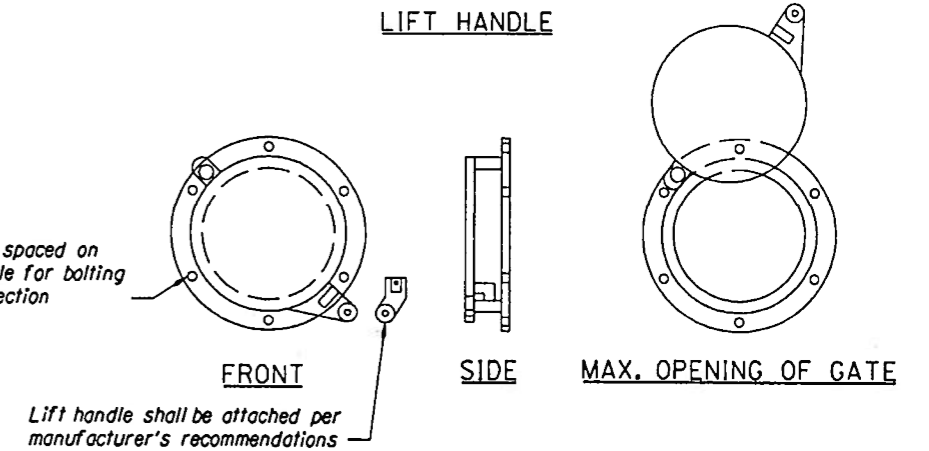

CLEANOUT/SHEAR GATE DETAILS

DRILL ORIFICE TABLE

STATION	OFFSET (ft.)	DIAMETER (in.)
"D2"67+46.00	33.22 ft.	10 1/2
"HSc"479+85.98	58.63 ft.	3 1/2

CLEANOUT/SHEAR GATE NOTES:
Cleanout/shear gate shall be aluminum alloy per ASTM B-26-2C-32.

Lift handle either solid or tubing with adjustable hook as required.

Neoprene rubber gasket required between riser mounting flange and gate flange.

Mating surfaces of lid and body to be machined for proper fit.

Flange mounting bolts shall be 3/8" diameter stainless steel.

Gate shall not open beyond the clear opening by limited hinge movement, stop pad, or some other device.



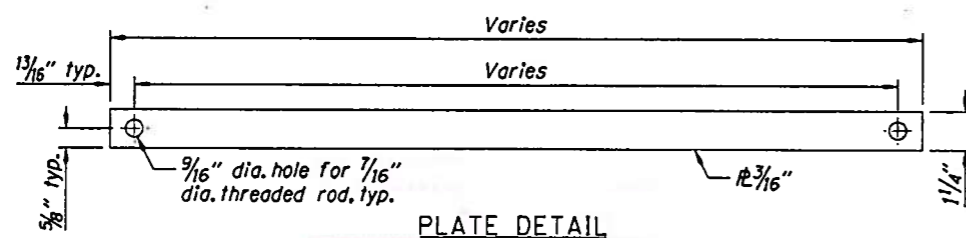


PLATE DETAIL

NOT REVISED AS CONSTRUCTED CONTRACT

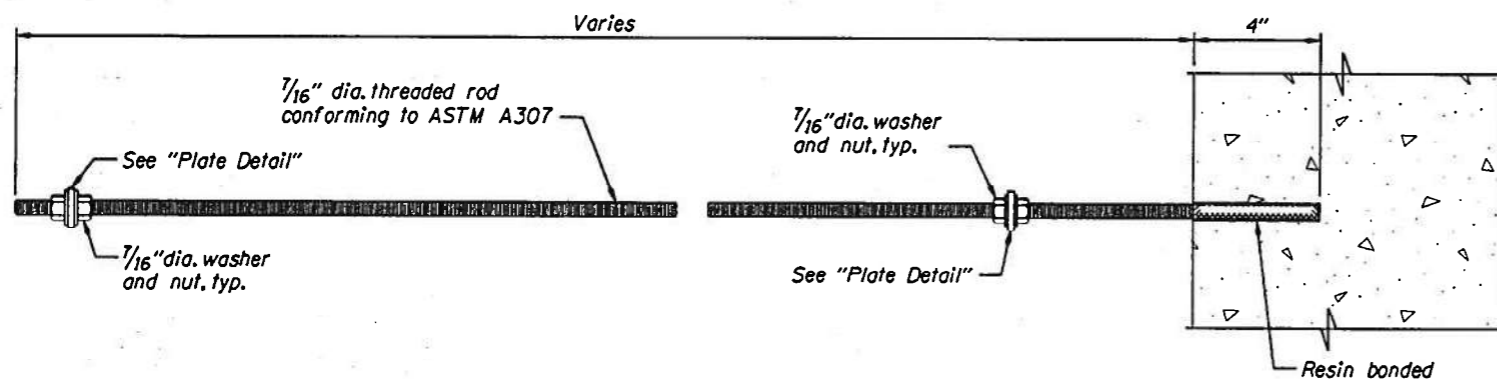

THREADED ROD AND PLATE DETAILS

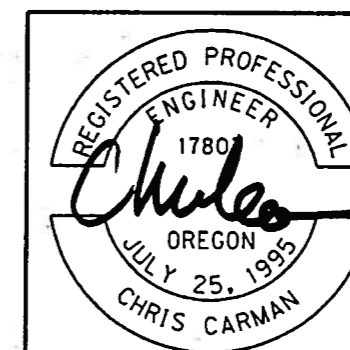

RENEWS: 12-31-2013

OREGON DEPARTMENT OF TRANSPORTATION	
REGION 2 TECH CENTER	
FFO-15 @ OR214 INTERCHANGE (WOODBURN) DEVELOPMENT SEC. HILLSBORO - SILVERTON HIGHWAY MARION COUNTY	
Reviewed By - Bruce Carmichael Designed By - Chris Carman Drafted By - Sandra Gish	
STORMWATER STORAGE POND DETAILS	SHEET NO. GJ-8