

# OPERATION & MAINTENANCE MANUAL

## Water Quality Infiltration Basin

Manual prepared: January 2018

DFI No. D00746



Figure 1: DFI No. D00746, looking North

## Identification

Drainage Facility ID (DFI): D00746  
Facility Type: Water Quality Infiltration Basin  
Construction Drawings: (V-File Numbers) 46V-040  
Location: District: 10  
Highway No.: 004  
Mile Post: 140.87 to 140.9, [RT]

### 1. Manual Purpose

The purpose of this manual is to outline inspection needs and summarize maintenance actions.

### 2. Facility Location

The location map below details the facility location. The highway, mile posts, side streets, access location, and stormwater flow directions are noted on the map.

Facility location type: Off ramp

Flow direction: [North ]

Latitude: 44deg. 06' 59.30" N

Longitude: 121deg. 19' 05.97" W




Figure 2: Facility location map

### 3. Facility Summary

The length and width of a pond is based on the bottom dimensions.

The bottom length and bottom width of the basin is:


Bottom Length (feet)	Bottom Width (feet)
155	17

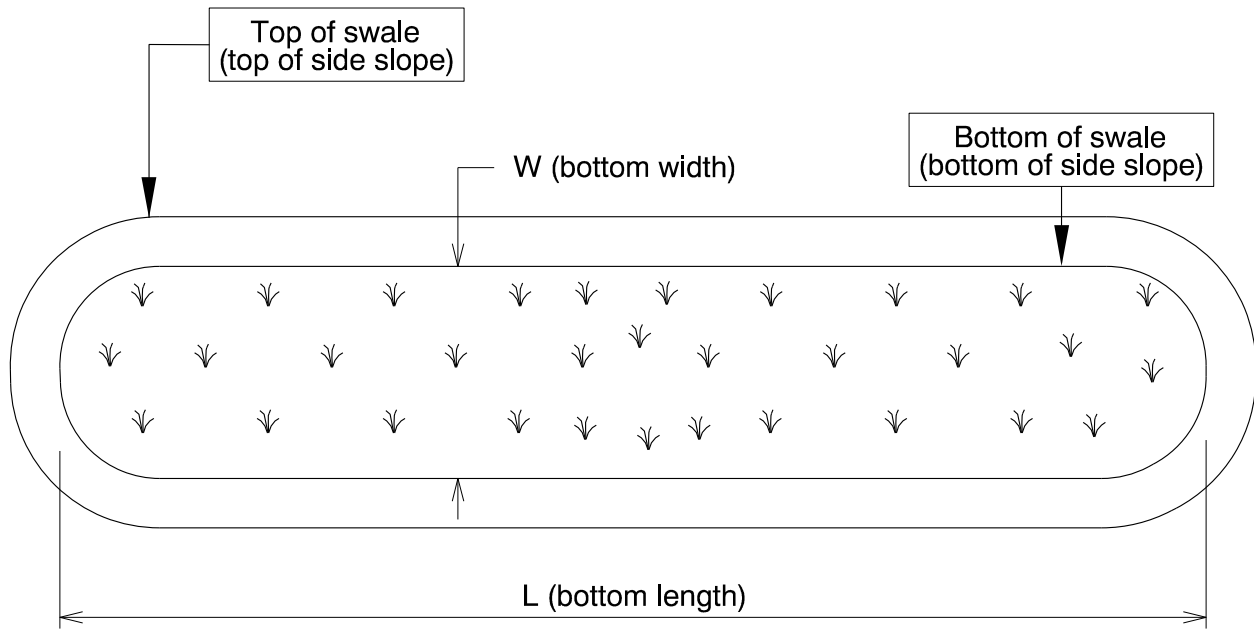

The depth of the pond is the vertical distance measured from the bottom of the pond to the top. The slope of the pond sides is presented by a vertical distance (rise) followed by the horizontal distance (run).

Depth and side slopes:

Depth (feet)	Rise (feet)	Run (feet)
2.75	1	3

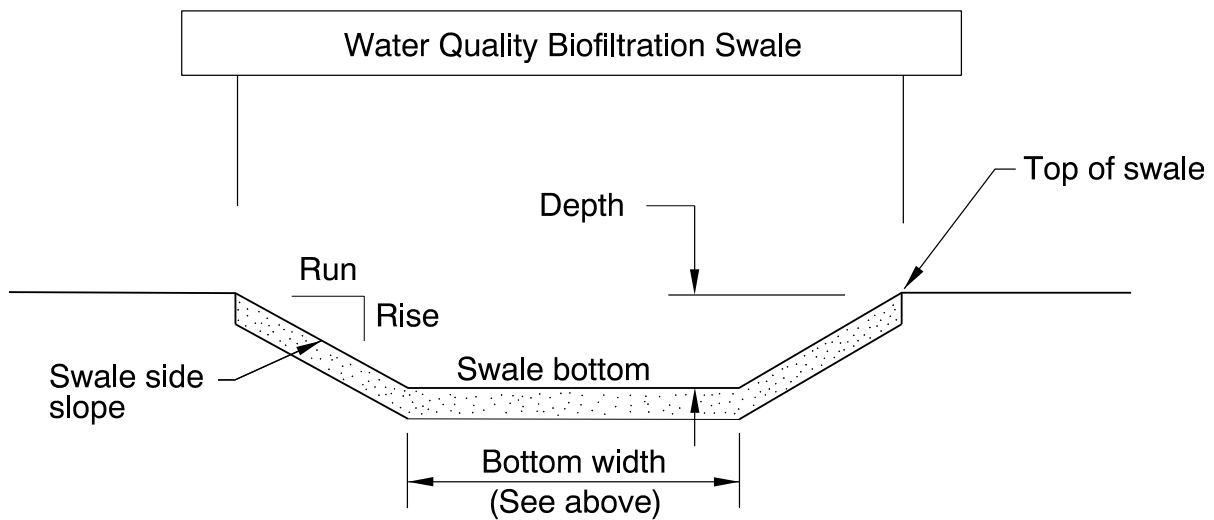

**Site Specific Information:** The primary outlet for this facility is infiltration into the native soils.

#### 4. Facility Access

Maintenance access to the facility:

<input type="checkbox"/> Roadside pad	<input type="checkbox"/> Roadside shoulder
<input type="checkbox"/> Access road with Gate	<input checked="" type="checkbox"/> Access road without Gate



Figure 3: Facility Access

#### 5. Operational Components / Maintenance Items

##### Classification

This facility is classified as an:

<input checked="" type="checkbox"/> <b>On-line Basin</b>	<input type="checkbox"/> <b>Off-line Basin</b>
A basin that does not include a high flow bypass component; flow drains into and through the facility	A basin that treats low/small flows and diverts high flows using a bypass component

##### Bypass Component

This facility includes a high flow bypass component:

<input checked="" type="checkbox"/> <b>No</b>	<input type="checkbox"/> <b>Yes</b>
<b>There is no bypass component. High flows drain into and through the facility</b>	<b>There is a bypass component. Only low/small flows drain into the swale. High flows are diverted around the swale using a bypass component</b>

### Operational Components

A pond has many components that assist with treatment and reducing flow velocity to minimize erosion. The components in use can vary depending if the facility was designed to operate on-line or off-line. The facility components table (**Table 1**) has been provided to highlight the applicable components for this facility. The component is in use when the box contains an “x” (e.g.  ).

The Standard Operation Manual for Water Quality Biofiltration Ponds (implemented March 2017) outlines facility operation, typical footprint configuration, and component definitions and details. A link to the manual is attached to the feature marker in TransGIS.

<https://gis.odot.state.or.us/TransGIS/>

### Operational Plan

The applicable standard operational plan for this facility is:

<input checked="" type="checkbox"/> <b>Operational Plan A</b> <input type="checkbox"/> <b>Operational Plan B</b> <input type="checkbox"/> <b>Operational Plan C</b>
<b>A standard operational plan illustrates the general facility footprint configuration and explains the purpose of each facility component. Operational plans (A, B, C) are provided in the Standard Operation Manual.</b>

See Appendix A for the site specific operational plan.

### Maintenance Items

Operational components marked in **Table 1** should be inspected and maintained according to Section 7. Each facility component is defined and detailed in the Standard Operation Manual using the associated ID number indicated below.

<b>Table 1: Swale Components</b>		<b>ID #</b>
<b>Manholes/Structures</b>		
Pre-treatment manhole	<input type="checkbox"/>	<b>S1</b>
Weir type flow splitter/flow splitter manhole	<input type="checkbox"/>	<b>S2</b>
Orifice type flow splitter/flow splitter manhole	<input type="checkbox"/>	<b>S3</b>
Standard manhole	<input checked="" type="checkbox"/>	<b>S4</b>
<b>Pond Inlet</b>		
Pavement sheet flow	<input type="checkbox"/>	<b>S5</b>
Inlet Pipe (s)	<input checked="" type="checkbox"/>	<b>S6</b>
Open channel inlet	<input type="checkbox"/>	<b>S7</b>
Riprap pad	<input checked="" type="checkbox"/>	<b>S8</b>
<b>Ground Cover</b>		
Grass bottom	<input checked="" type="checkbox"/>	<b>S9</b>
Grass side slopes	<input checked="" type="checkbox"/>	<b>S10</b>
Granular drain rock	<input type="checkbox"/>	<b>S11</b>
Plantings	<input type="checkbox"/>	<b>S12</b>
<b>Underground Components</b>		
Geotextile fabric	<input type="checkbox"/>	<b>S13</b>
Water quality mix	<input checked="" type="checkbox"/>	<b>S14</b>
Perforated pipe	<input type="checkbox"/>	<b>S15</b>
Porous pavers (access grid)	<input type="checkbox"/>	<b>S16</b>
<b>Flow Spreader</b>		
Rock basin (used at inlet)	<input type="checkbox"/>	<b>S17</b>
Anchored board (midpoint of swale or every 50 feet along swale bottom)	<input type="checkbox"/>	<b>S18</b>
Other: describe type	<input type="checkbox"/>	<b>S19</b>
<b>Pond Outlet</b>		
Catch basin with grate	<input type="checkbox"/>	<b>S20</b>
Outlet Pipe (s)	<input type="checkbox"/>	<b>S21</b>
Open channel outlet	<input type="checkbox"/>	<b>S22</b>
Auxiliary Outlet: Infiltration	<input checked="" type="checkbox"/>	<b>S23</b>
<b>Outfall Type</b>		
Waterbody (Creek/Lake/Ocean)	<input type="checkbox"/> C	<b>S24</b>
	<input type="checkbox"/> L	
	<input type="checkbox"/> O	
Ditch	<input type="checkbox"/>	<b>S25</b>
Storm drain system	<input type="checkbox"/>	<b>S26</b>
<b>Outfall Components</b>		
Riprap pad	<input type="checkbox"/>	<b>S27</b>
Riprap bank protection	<input type="checkbox"/>	<b>S28</b>



## 6. Maintenance

### Maintenance Frequency/Maintain Records

- a. Inspect annually. Preferably prior to the rainy season.
- b. Clean and maintain as necessary. Refer to Activity 125 for conditions when maintenance is needed.
- c. Keep a record of inspections, maintenance, and repairs.

### Maintenance Guide/Maintenance Actions

The ODOT Routine Road Maintenance Water Quality and Habitat Guide (the *Blue Book*) outlines the standard maintenance actions for water quality facilities under Activity 125.

There are standard maintenance tables for standard ODOT designs. The maintenance tables describe the maintenance component, the defect or problem, the condition when maintenance is needed, and the recommended maintenance to correct the problem. Use the following tables to maintain ODOT swales:

- Table 1 (General Maintenance): Contains general maintenance and inspection guidelines that are applicable to all ODOT water quality facilities
- Table 3 (Maintenance of Water Quality or Biofiltration Swales): Contains maintenance information for swales

The *Blue Book* can be viewed at the following website:

[http://www.oregon.gov/ODOT/Maintenance/Documents/blue\\_book.pdf](http://www.oregon.gov/ODOT/Maintenance/Documents/blue_book.pdf)

## 7. Limitations

Access grid installed:

<input checked="" type="checkbox"/> No	<input type="checkbox"/> Yes
There are ( <b>Choose applicable weight: no, light, med., heavy</b> ) duty porous pavers installed in this swale	

Ponds are designed to allow equipment access along the bottom. If an access grid is **NOT** installed, vehicles entering the pond can create depressions (tire ruts), damage vegetation, and damage structural components. These conditions may result in poor treatment and drainage performance.

Equipment wheels should be kept on the tops and side slopes. Mower arms may be run along the pond bottom.

## 8. Waste Material Handling

Material removed from the facility is defined as waste by the Department of Environmental Quality (DEQ). Refer to the roadwaste section of the ODOT Maintenance Yard Environmental Management System (EMS) Policy and Procedures Manual for disposal options:

[http://www.oregon.gov/ODOT/Maintenance/Documents/ems\\_manual.pdf](http://www.oregon.gov/ODOT/Maintenance/Documents/ems_manual.pdf)


Contact any of the following for more detailed information about management of waste materials found on site:

ODOT Clean Water Unit	(503) 986-3008
ODOT Statewide Hazmat Coordinator	(503) 667-7442
ODOT Region 1 Hazmat Coordinator	(503) 731-8290
ODOT Region 2 Hazmat Coordinator	(503) 986-2647
ODOT Region 3 Hazmat Coordinator	(541) 957-3594
ODOT Region 4 Hazmat Coordinator	(541) 388-6186
ODOT Region 5 Hazmat Coordinator	(541) 963-1590
ODEQ Northwest Region Office	(503) 229-5263

## **A Appendix A – Site Specific Operational Plan**


### **Contents:**

**Operational Plan: DFI D00746**

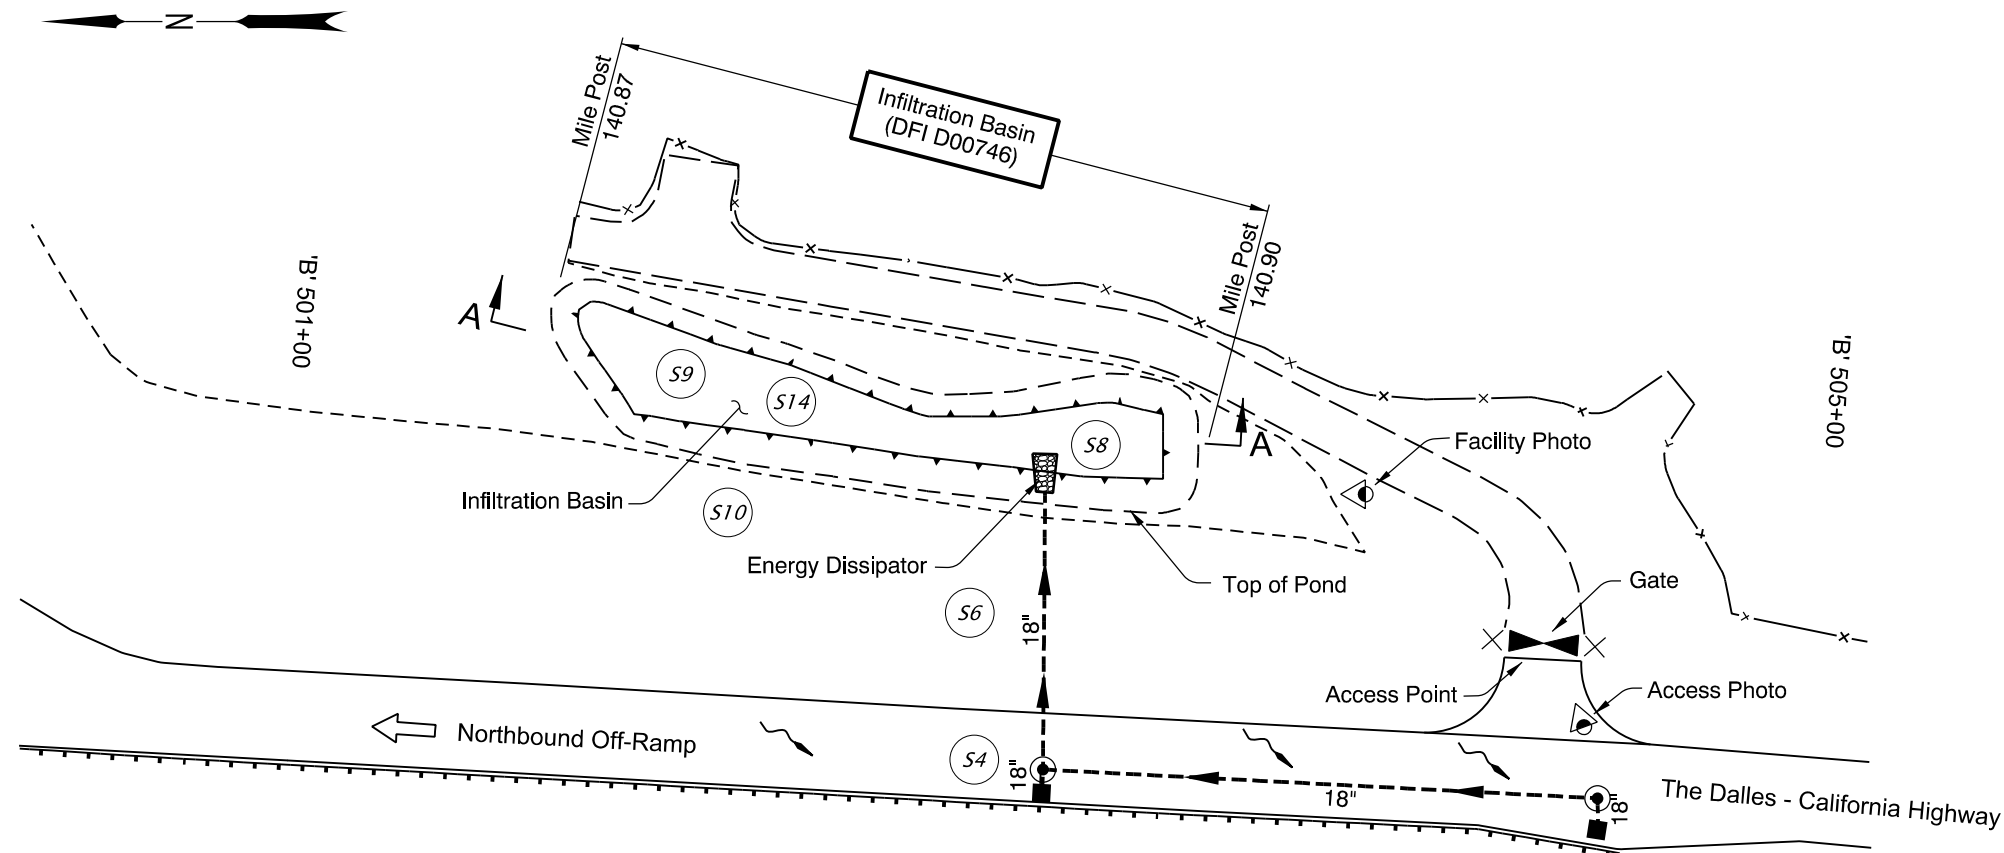

- LEGEND**
- Storm Sewer Manhole
  - Inlet Type "G-2"
  - 18" Storm Pipe (Dia.)
  - ▶ Conveyance Direction
  - ~ Pavement / Facility Flow Path
  - ◁ Photo Location/Direction

**PLAN**  
N.T.S.

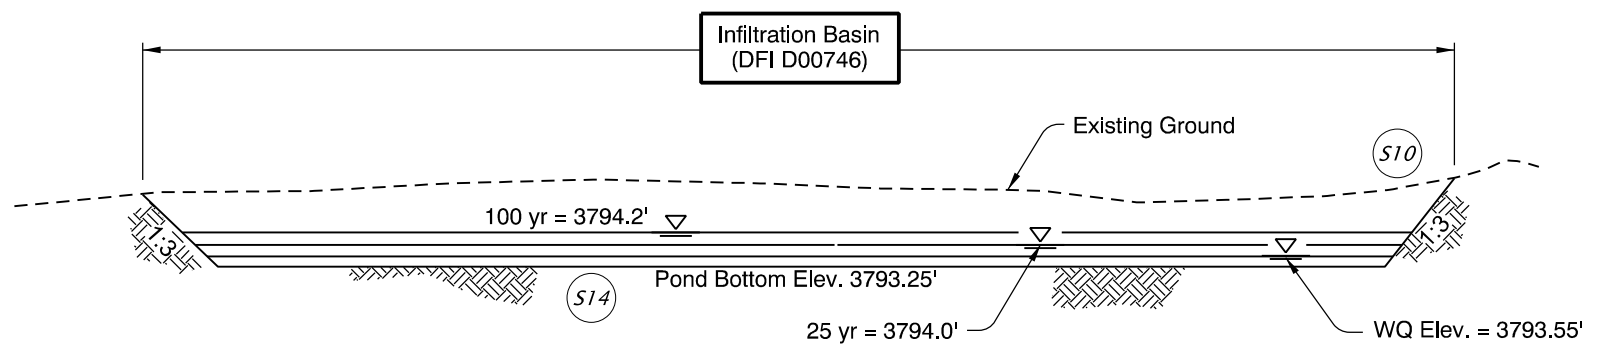

**SECTION A-A**  
N.T.S.

OREGON DEPARTMENT OF TRANSPORTATION

Prepared By:  
Michael W. Ogden

Drafted By:  
Michael L. Graves

**DFI D00746**  
**MAINTENANCE DISTRICT 10 HWY 004**  
**INFILTRATION BASIN**  
THE DALLES-CALIFORNIA HIGHWAY MP 140.87  
DESCHUTES COUNTY

## **B Appendix B – Project Contract Plans**

### **Contents:**

**SiteSpecificSubsetofProjectContractPlan46V-040**

46V-040

INDEX OF SHEETS	
SHEET NO.	DESCRIPTION
1	Title Sheet
1A Thru 1A-2	Index Of Sheets Cont'd.
1A-3	Standard Drg. Nos.
1B	Keymap
1C	Control Data Sheet


STATE OF OREGON  
 DEPARTMENT OF TRANSPORTATION  
 PLANS FOR PROPOSED PROJECT

GRADING, DRAINAGE, STRUCTURES, PAVING, SIGNING, ILLUMINATION,  
 SIGNALS & ROADSIDE DEVELOPMENT

**US97/MURPHY RD:  
 BROOKSWOOD-PARRELL (BEND) PHASE 1**

**THE DALLES-CALIFORNIA HIGHWAY  
 DESCHUTES COUNTY**

MAY 2013

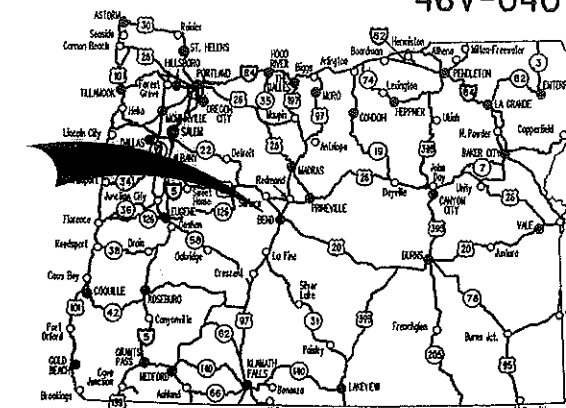

Overall Length Of Project - 2.50 Miles

NOT REVISAS AS CONSTRUCTED  
*[Signature]*  
 Project Manager  
 1/16/15  
 Date

**ATTENTION!**  
 Oregon Law Requires You To Follow Rules Adopted By The Oregon Utility Notification Center. Those Rules Are Set Forth In OAR 952-001-0010 Through OAR 952-001-0090. You May Obtain Copies Of The Rules By Calling The Center. (Notes The Telephone Number For The Oregon Utility Center Is (503) 232-1987.)




**BEGINNING OF PROJECT  
 STA. 'US97' 408+00.00 (M.P. 140.44)**

**BEGINNING OF PROJECT  
 STA. '3RD' 177+00.00**

**BEGINNING OF PROJECT  
 STA. 'MR' 733+00.00**

**END OF PROJECT  
 STA. 'MR' 755+00.00**

**END OF PROJECT  
 STA. 'US97' 454+00.00 (M.P. 142.03)**

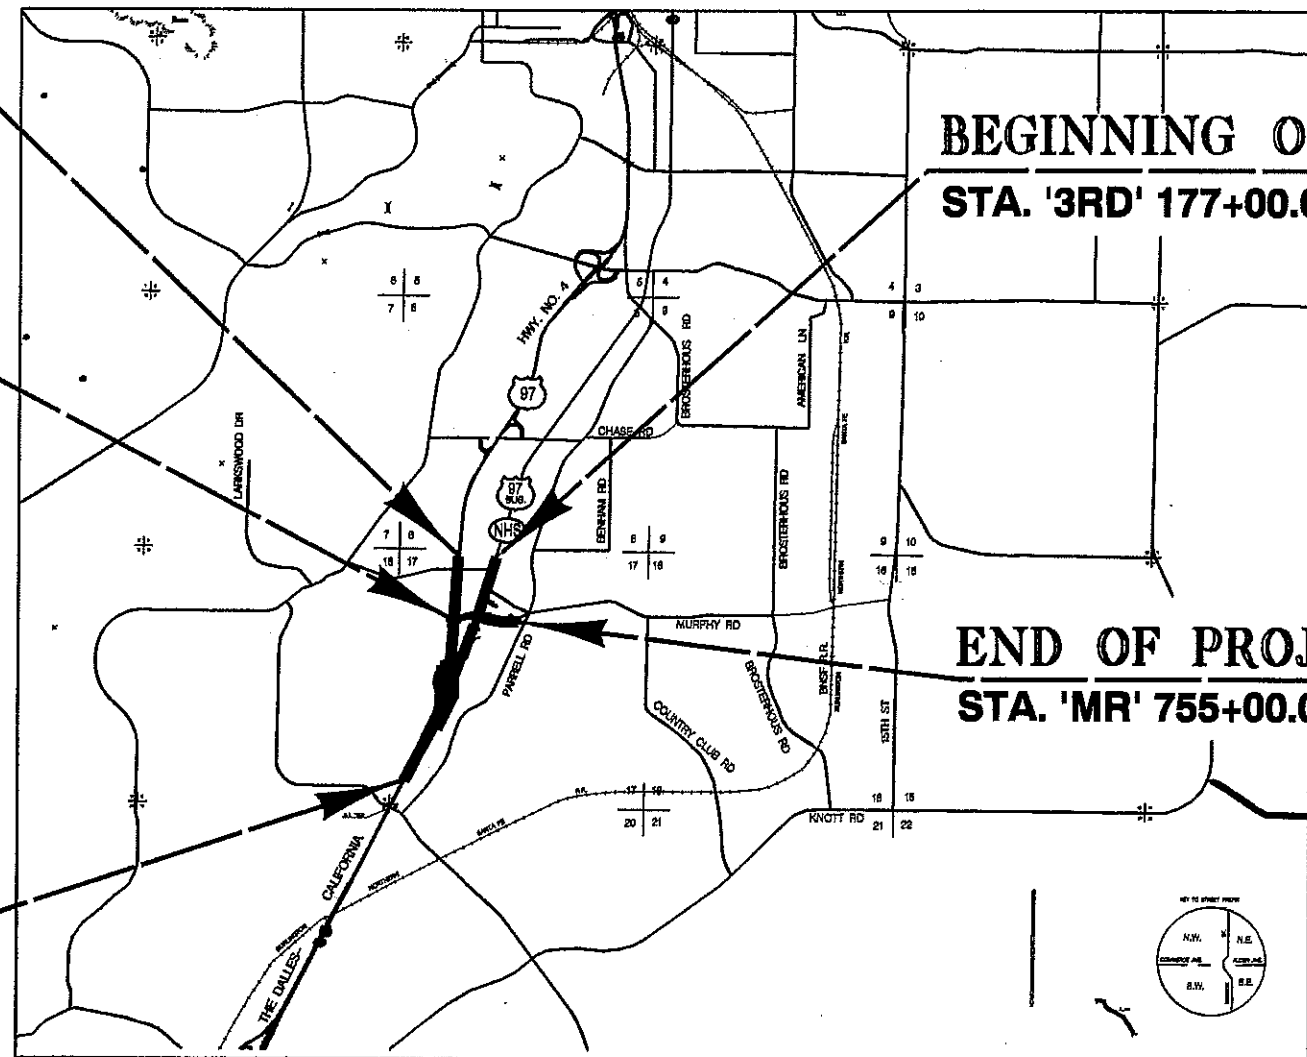

**OREGON TRANSPORTATION COMMISSION**  
 Pat Egan CHAIR  
 David Lohman COMMISSIONER  
 Mary F. Olson COMMISSIONER  
 Mark Frohnmayer COMMISSIONER  
 Tammy Boney COMMISSIONER  
 Matthew L. Garrett DIRECTOR OF TRANSPORTATION


These plans were developed using ODOT design standards. Exceptions to these standards, if any, have been submitted and approved by the ODOT Chief Engineer or their delegated authority.

Approving Authority *[Signature]* 3-19-13  
 Signature & date  
 William Adams III - DM  
 Print name and title  
*[Signature]*  
 Concurrence By ODOT Chief Engineer

<b>US97/MURPHY RD:          BROOKSWOOD-PARRELL (BEND) PHASE 1          THE DALLES-CALIFORNIA HIGHWAY          DESCHUTES COUNTY</b>		
FEDERAL HIGHWAY ADMINISTRATION	PROJECT NUMBER	SHEET NO.
OREGON DIVISION	SO-S004(169)	1

T. 18 S., R. 12 E., W.M.

Sec. 17, T. 18 S., R 12 E., W.M.

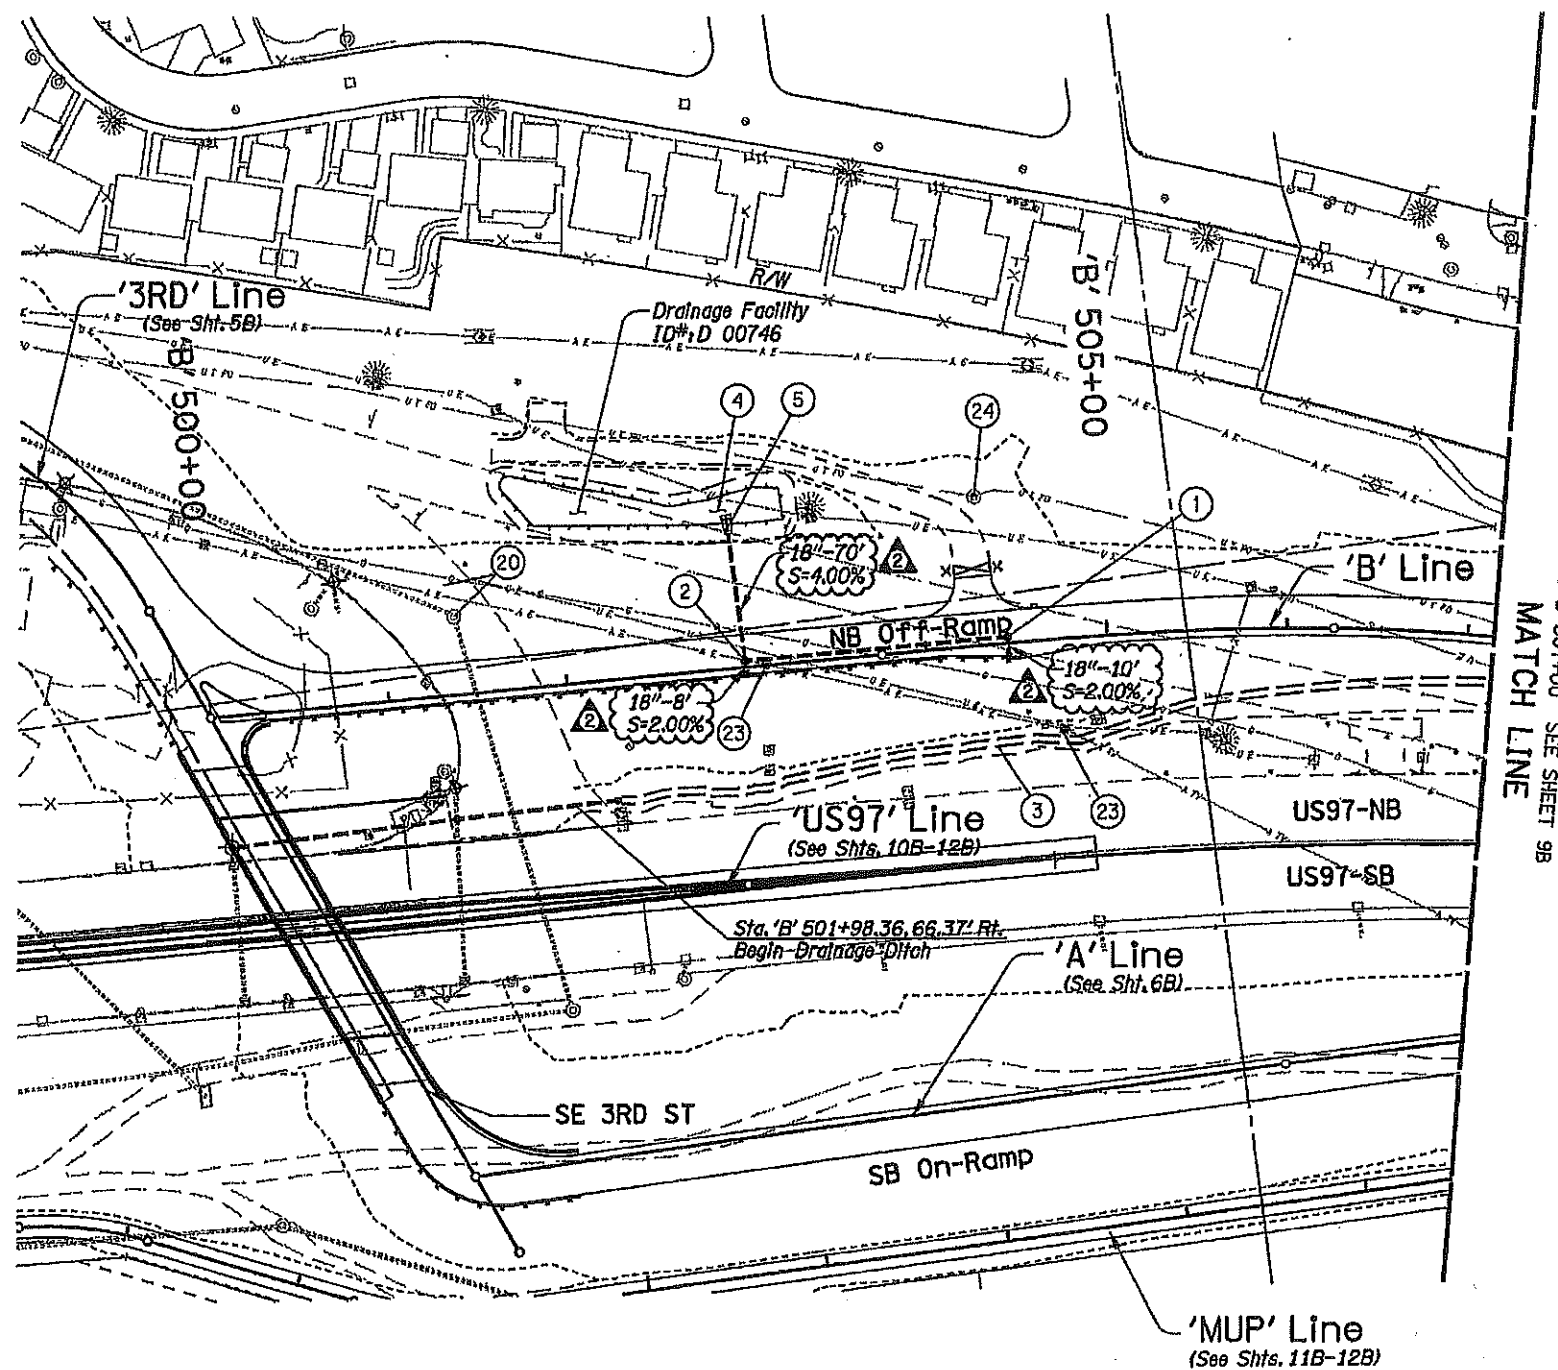

- ① Sta. 'B' 504+45.00, 3.5' Lt.  
Const. Storm Sewer Manhole  
  
Inst. 18" Sew. Pipe - 10'  
5' Depth  
(See Drg. Nos. RD335 & RD356)  
Const. Type "G-2" Inlet W/Sump  
  
F.L. (18" Out) 3805.18 E  
(See Drg. No. RD364)
- ② Sta. 'B' 503+00.00, 3.5' Lt.  
Const. Storm Sewer Manhole  
  
Inst. 18" Sew. Pipe - 145'  
20' Depth  
Inst. 18" Sew. Pipe - 8'  
5' Depth  
(See Drg. Nos. RD335 & RD356)  
Const. Type "G-2" Inlet W/Sump  
  
F.L. (18" Out) 3808.66 E  
(See Drg. No. RD364)
- ③ Const. Ditch (See Typical Sections & Sht. BC For Elevations)
- ④ Const. Infiltration Basin (For Details, See Sht 6J-10)
- ⑤ Sta. 'B' 502+96.54, 73.56' Lt.  
Const. Riprap Basin  
Inst. 18" Sew. Pipe - 70'  
20' Depth  
F.L. 18" 3795.07  
(For Details, See Sht. 2B-10)
- ②① Inst. San. Sewer Pipe (For Details, See SS Shts.)
- ②③ Relocate Power Pole (By Others)
- ②④ Adjust Utility Manhole (By Others)

STA. 'B' 507+00 SEE SHEET 9B  
MATCH LINE

**OREGON DEPARTMENT OF TRANSPORTATION**

**CH2MHILL** 2020 SW 4TH AVE. - 3RD FLOOR  
PORTLAND, OR 97201-4953  
TEL. 503.235.5000

**US97/MURPHY RD: BROOKSWOOD-PARRELL (BEND) PHASE 1**  
THE DALLES-CALIFORNIA HIGHWAY  
DESCHUTES COUNTY


Reviewed By - R. Attanasio  
Designed By - J. Stallard  
Drafted By - S. Atwood

**DRAINAGE & UTILITIES** SHEET NO. **8B**

REGISTERED PROFESSIONAL ENGINEER  
82930PE  
JEFFERY SHAWN STALLARD  
MAY 12, 2009  
OREGON  
EXPIRES: 6/30/2014  
2-3-14


REVISED AS CONSTRUCTED

*[Signature]*  
Project Manager Date

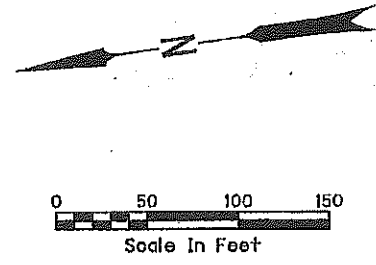

Rev. No.	Date	Revision
①	5-2-13	Std. Drg. References, Corrections
②	2-3-14	Revised Drainage Design

Bid Package 1

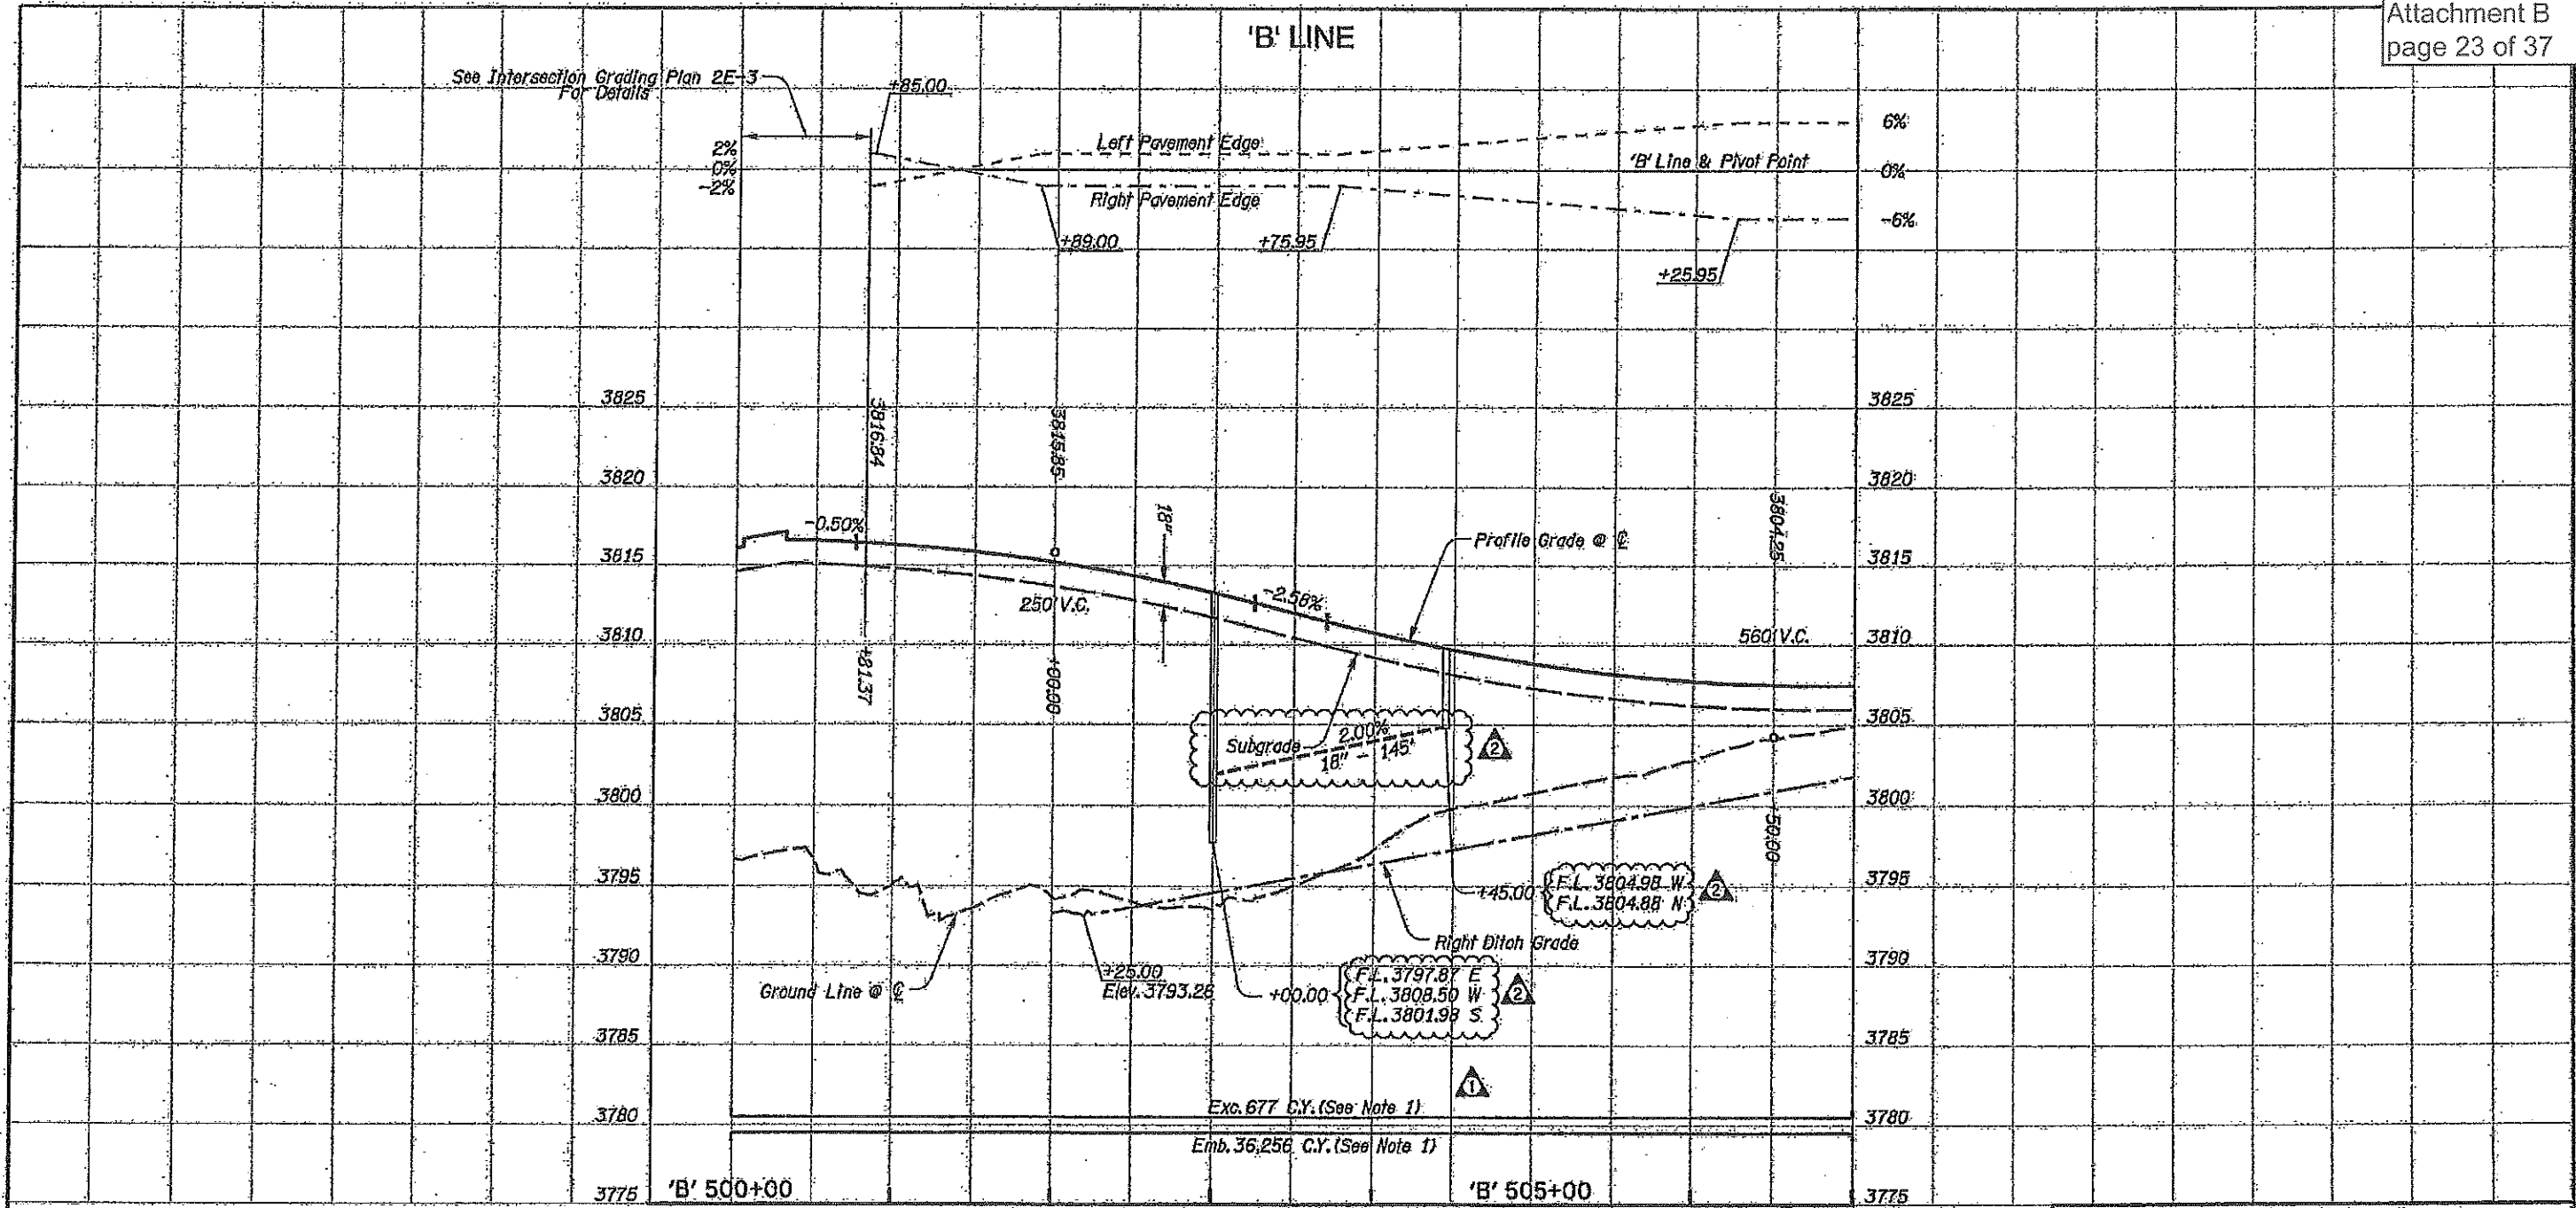


Notes

1. Volumes Shown This Sheet Include All Earthwork Within The Limits Of The Intersection Of 3rd Street And The Northbound Off-Ramp ('B' Line). Limits Defined Per Intersection Grading Plan 2E-3.

REVISED AS CONSTRUCTED

*[Signature]*  
Project Manager Date

Rev. No.	Date	Revision
1	1-10-14	Updated Earthwork
2	2-3-14	Revised Drainage Design

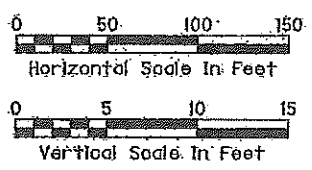

DRAINAGE

REGISTERED PROFESSIONAL ENGINEER  
82930PE  
OREGON  
MAY 12, 2009  
JEFFERY SHAWN STALLARD  
EXPIRES: 6/30/2014  
2-3-14

ROADWAY

REGISTERED PROFESSIONAL ENGINEER  
79261PE  
OREGON 2-3-2014  
JUNE 14, 2007  
RYAN J. BROWN  
EXPIRES: 12/31/2016

OREGON DEPARTMENT OF TRANSPORTATION

**CH2MHILL**  
2020 SW 4TH AVE. - 3RD FLOOR  
PORTLAND, OR 97201-4953  
TEL. 503.235.5000


**US97/MURPHY RD  
BROOKSWOOD-PARRELL (BEND) PHASE 1  
THE DALLES-CALIFORNIA HIGHWAY  
DESCHUTES COUNTY**

Reviewed By - S. Daleo  
Designed By - R. Brown/J. Stallard  
Drafted By - J. Tyler

**PROFILE**  
SHEET NO. **8C**

Bid Package 1



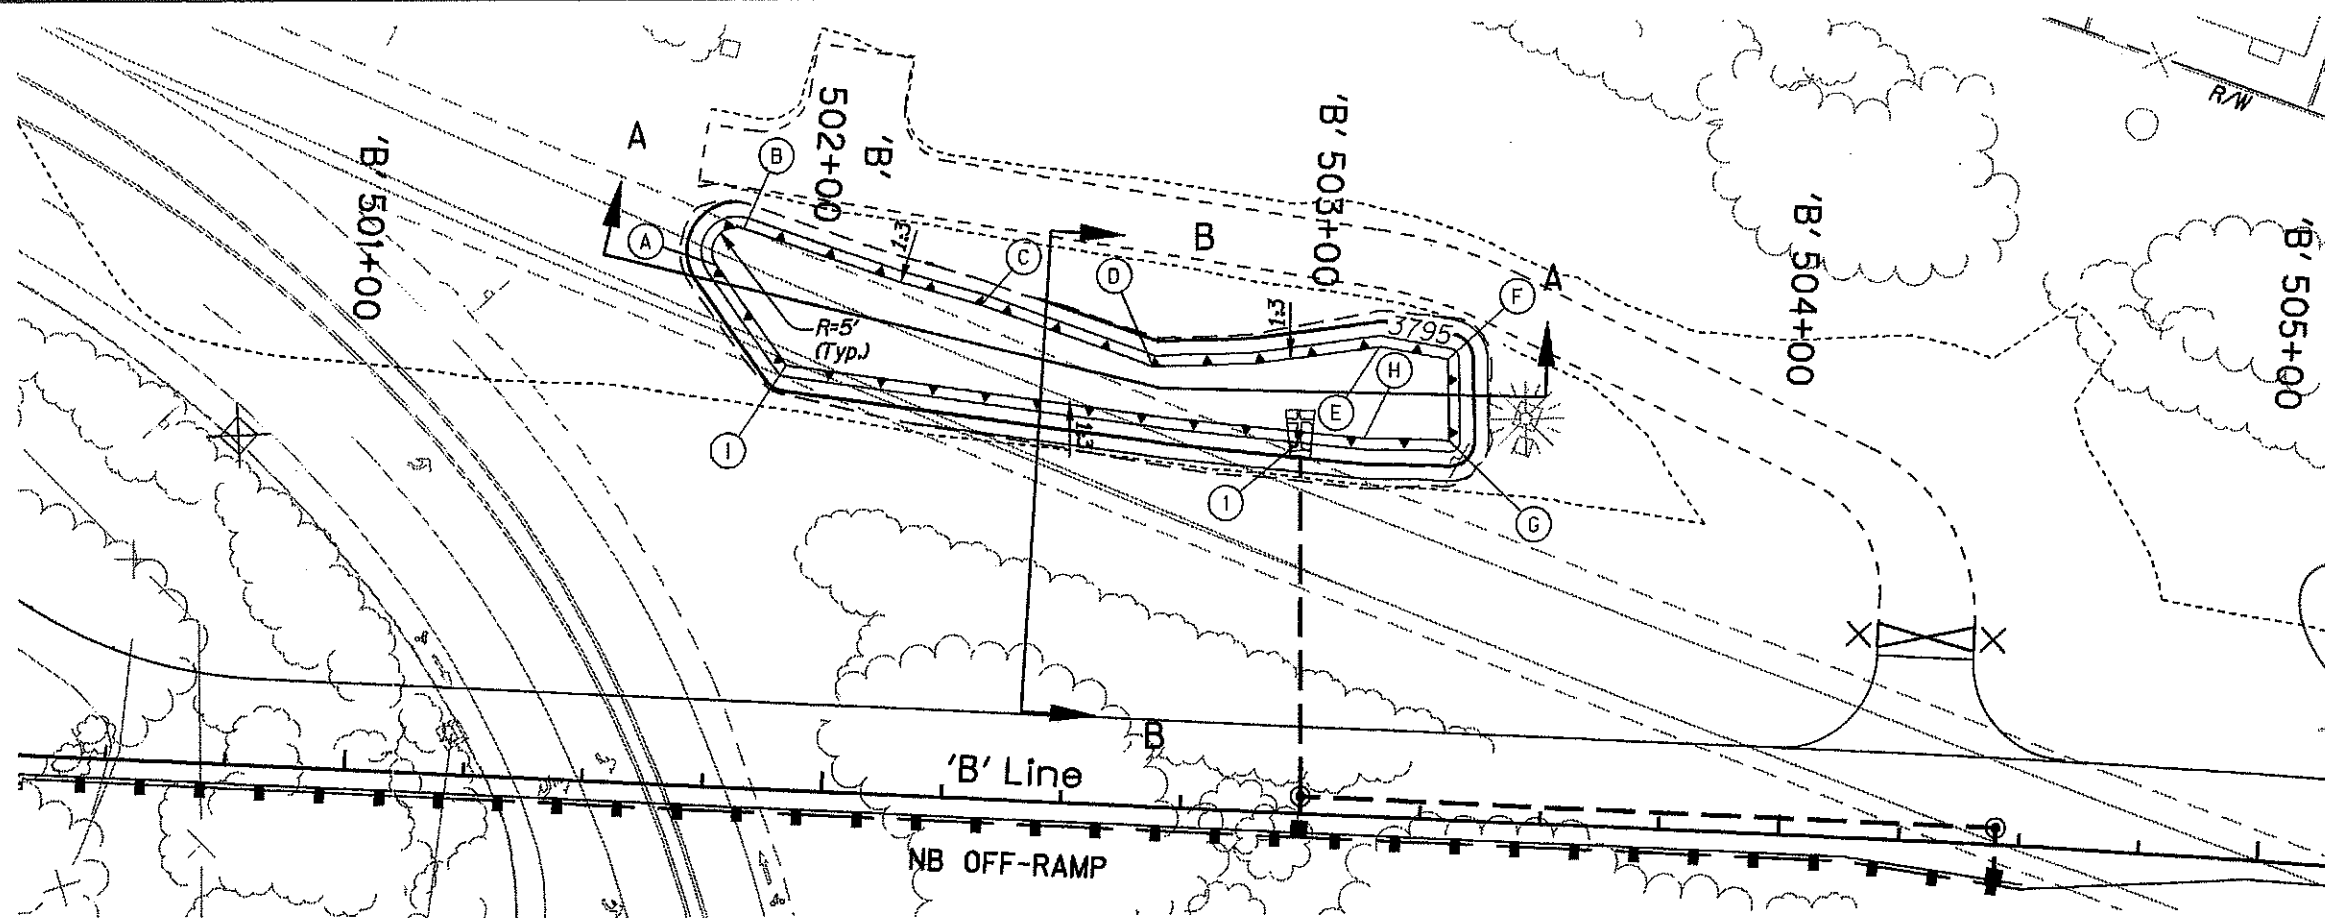


REUSED AS CONSTRUCTED  
 [Signature]  
 Project Manager Date


POINT CONTROL				
Pt.	Station	Offset	Elev.	Pt. Description
(A)	Sta. 'B' 501+72.72	108.21' Lt.	3793.25	Toe of Slope
(B)	Sta. 'B' 501+78.08	116.06' Lt.	3793.25	Toe of Slope
(C)	Sta. 'B' 502+28.39	102.43' Lt.	3793.25	Toe of Slope
(D)	Sta. 'B' 502+84.93	91.23' Lt.	3793.25	Toe of Slope
(E)	Sta. 'B' 503+12.20	97.49' Lt.	3793.25	Toe of Slope
(F)	Sta. 'B' 503+26.24	95.52' Lt.	3793.25	Toe of Slope
(G)	Sta. 'B' 503+27.32	78.53' Lt.	3793.25	Toe of Slope
(H)	Sta. 'B' 503+09.65	78.31' Lt.	3793.25	Toe of Slope
(I)	Sta. 'B' 501+88.27	87.99' Lt.	3793.25	Toe of Slope

PLAN

Proposed Northbound Off-Ramp

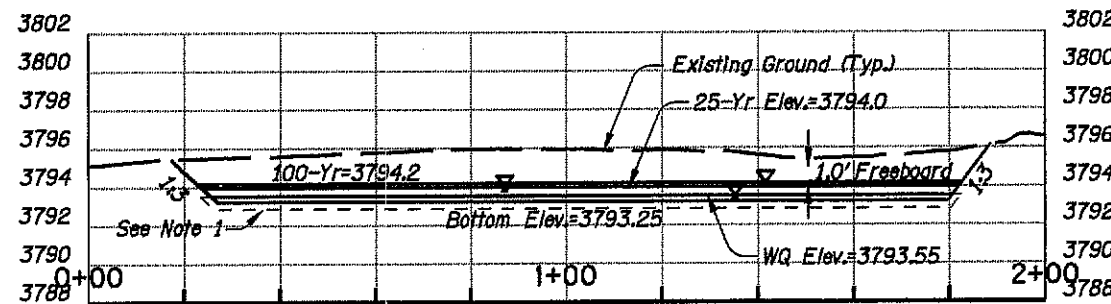

SECTION A-A


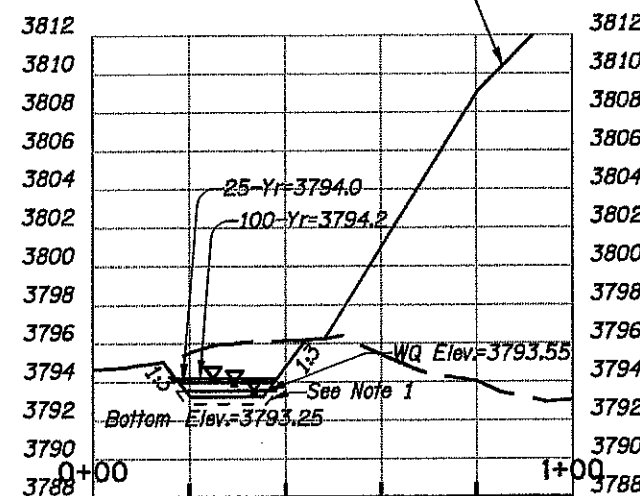


SECTION B-B

Notes:

- Over Excavate For Placement Of 18" Of Compast Amended Soil.
- Side Slopes Are Shown As Vert. To Horiz.

INFILTRATION BASIN D 00746

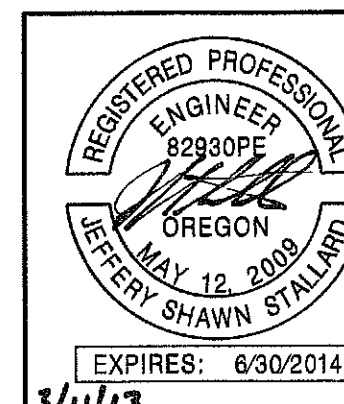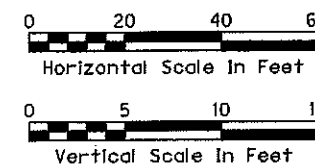

**OREGON DEPARTMENT OF TRANSPORTATION**


**CH2MHILL** 2020 SW 4TH AVE. - 3RD FLOOR  
 PORTLAND, OR 97201-4953  
 TEL. 503.235.5000

**US97/MURPHY RD:  
 BROOKSWOOD-PARRELL (BEND) PHASE 1**  
 THE DALLES-CALIFORNIA HIGHWAY  
 DESCHUTES COUNTY

Reviewed By - R. Attanasio  
 Designed By - J. Stallard  
 Drafted By - S. Atwood


**STORMWATER DETAILS** SHEET NO. GJ-10

Rev. No.	Date	Revision

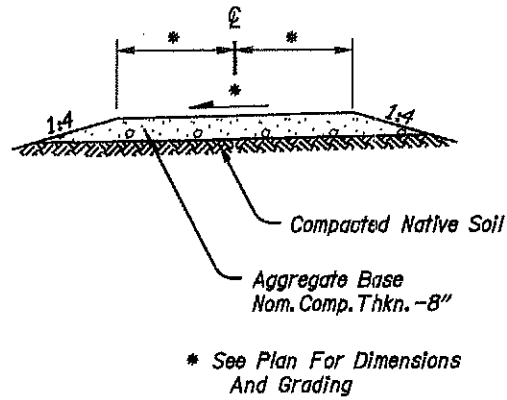


SECTION A-A

Pt.	Station	Offset	Elev.
(A)	Sta. 4+24.27	6.00' Rt.	3794.48
(B)	Sta. 4+14.27	16.00' Rt.	3794.32
(C)	Sta. 4+14.27	26.00' Rt.	3793.63
(D)	Sta. 3+94.27	26.00' Rt.	3794.06
(E)	Sta. 3+94.27	16.00' Rt.	3794.26
(F)	Sta. 3+84.27	6.00' Rt.	3794.67
(G)	Sta. 1+82.30	6.04' Rt.	3804.88
(H)	Sta. 1+44.66	10.00' Rt.	3809.73
(I)	Sta. 1+38.09	10.00' Rt.	3810.15
(J)	Sta. 1+18.09	30.00' Rt.	3810.11
(K)	Sta. 1+18.09	30.00' Lt.	3811.18
(L)	Sta. 1+38.09	10.00' Lt.	3810.26
(M)	Sta. 1+50.68	9.97' Lt.	3809.28
(N)	Sta. 1+88.78	6.00' Lt.	3803.67

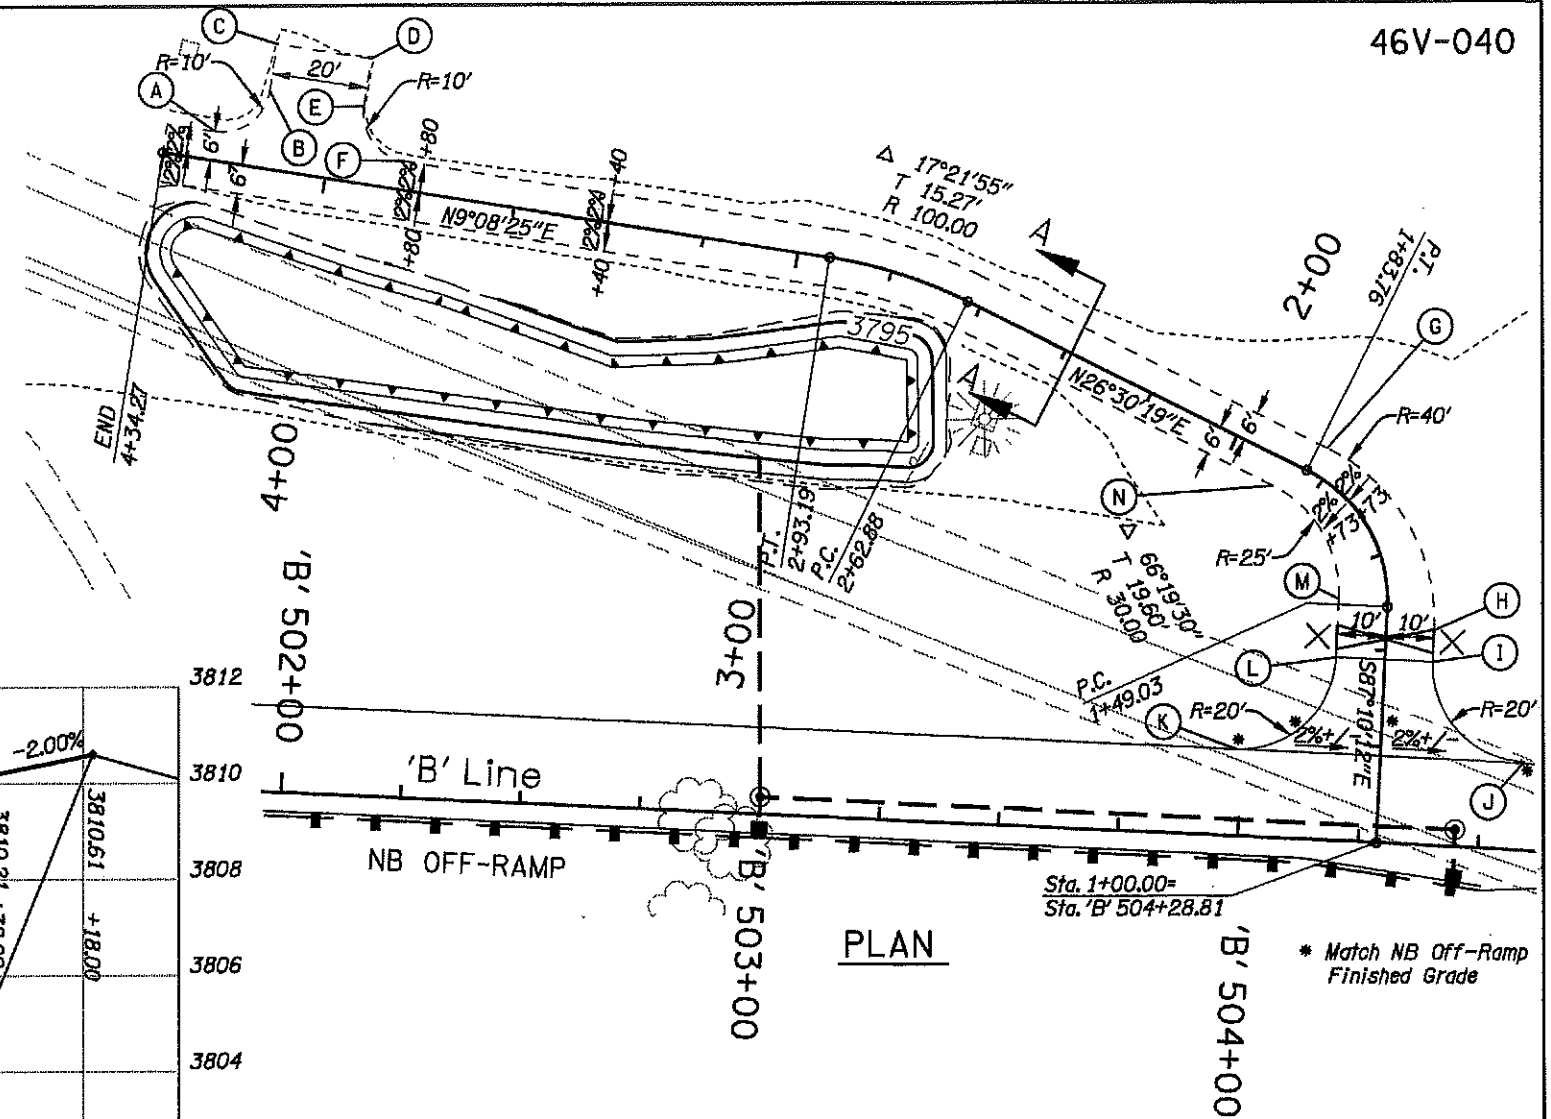

PLAN

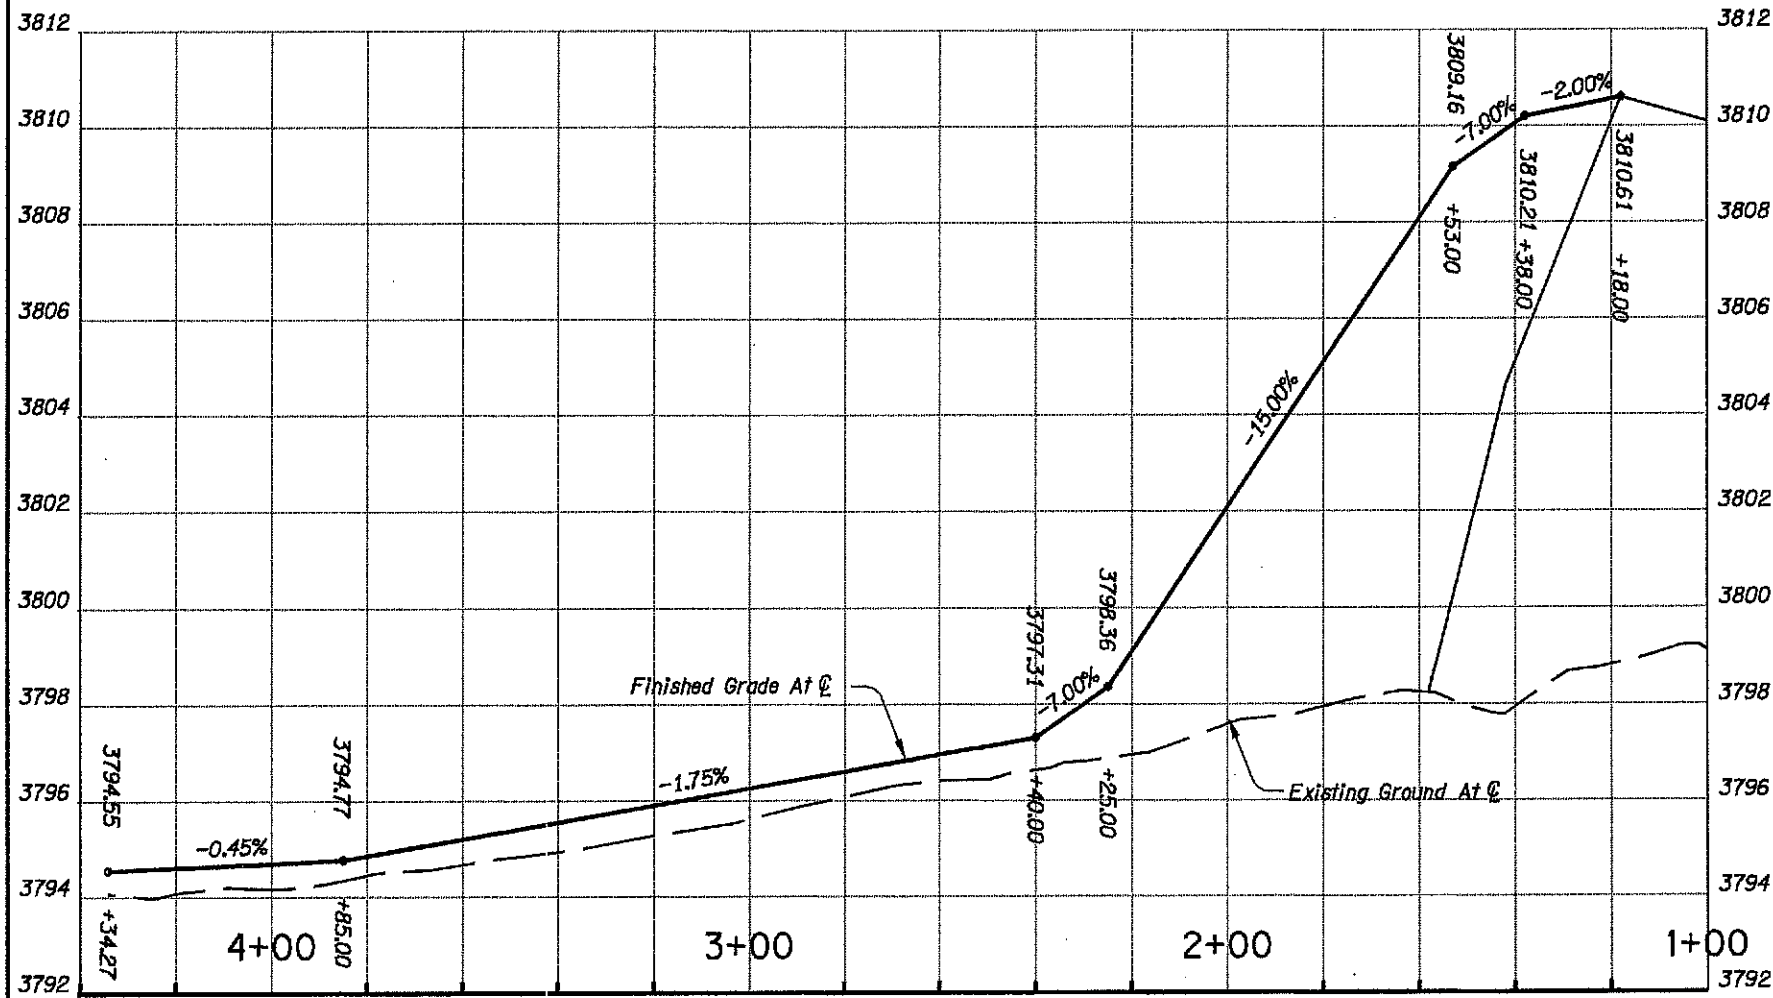

PROFILE

INFILTRATION BASIN D 00746

Rev. No.	Date	Revision


REvised AS CONSTRUCTED

*[Signature]*  
Project Manager

*[Signature]*  
Date

0 20 40 60  
Horizontal Scale In Feet

0 2 4 6  
Vertical Scale In Feet

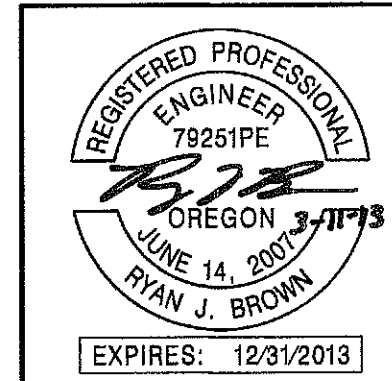

**OREGON DEPARTMENT OF TRANSPORTATION**

**CH2MHILL** 2020 SW 4TH AVE. - 3RD FLOOR  
PORTLAND, OR 97201-4953  
TEL. 503.235.5000

**US97/MURPHY RD:  
BROOKWOOD-PARRELL (BEND) PHASE 1**  
THE DALLES-CALIFORNIA HIGHWAY  
DESCHUTES COUNTY


Reviewed By - S. Daleo  
Designed By - S. Christopherson  
Drafted By - S. Atwood

**STORMWATER  
ACCESS DETAILS**


SHEET NO.  
**GJ-11**

T. 18S, R. 12E, W.M.  
INFILTRATION BASIN #D 00746

46V-040

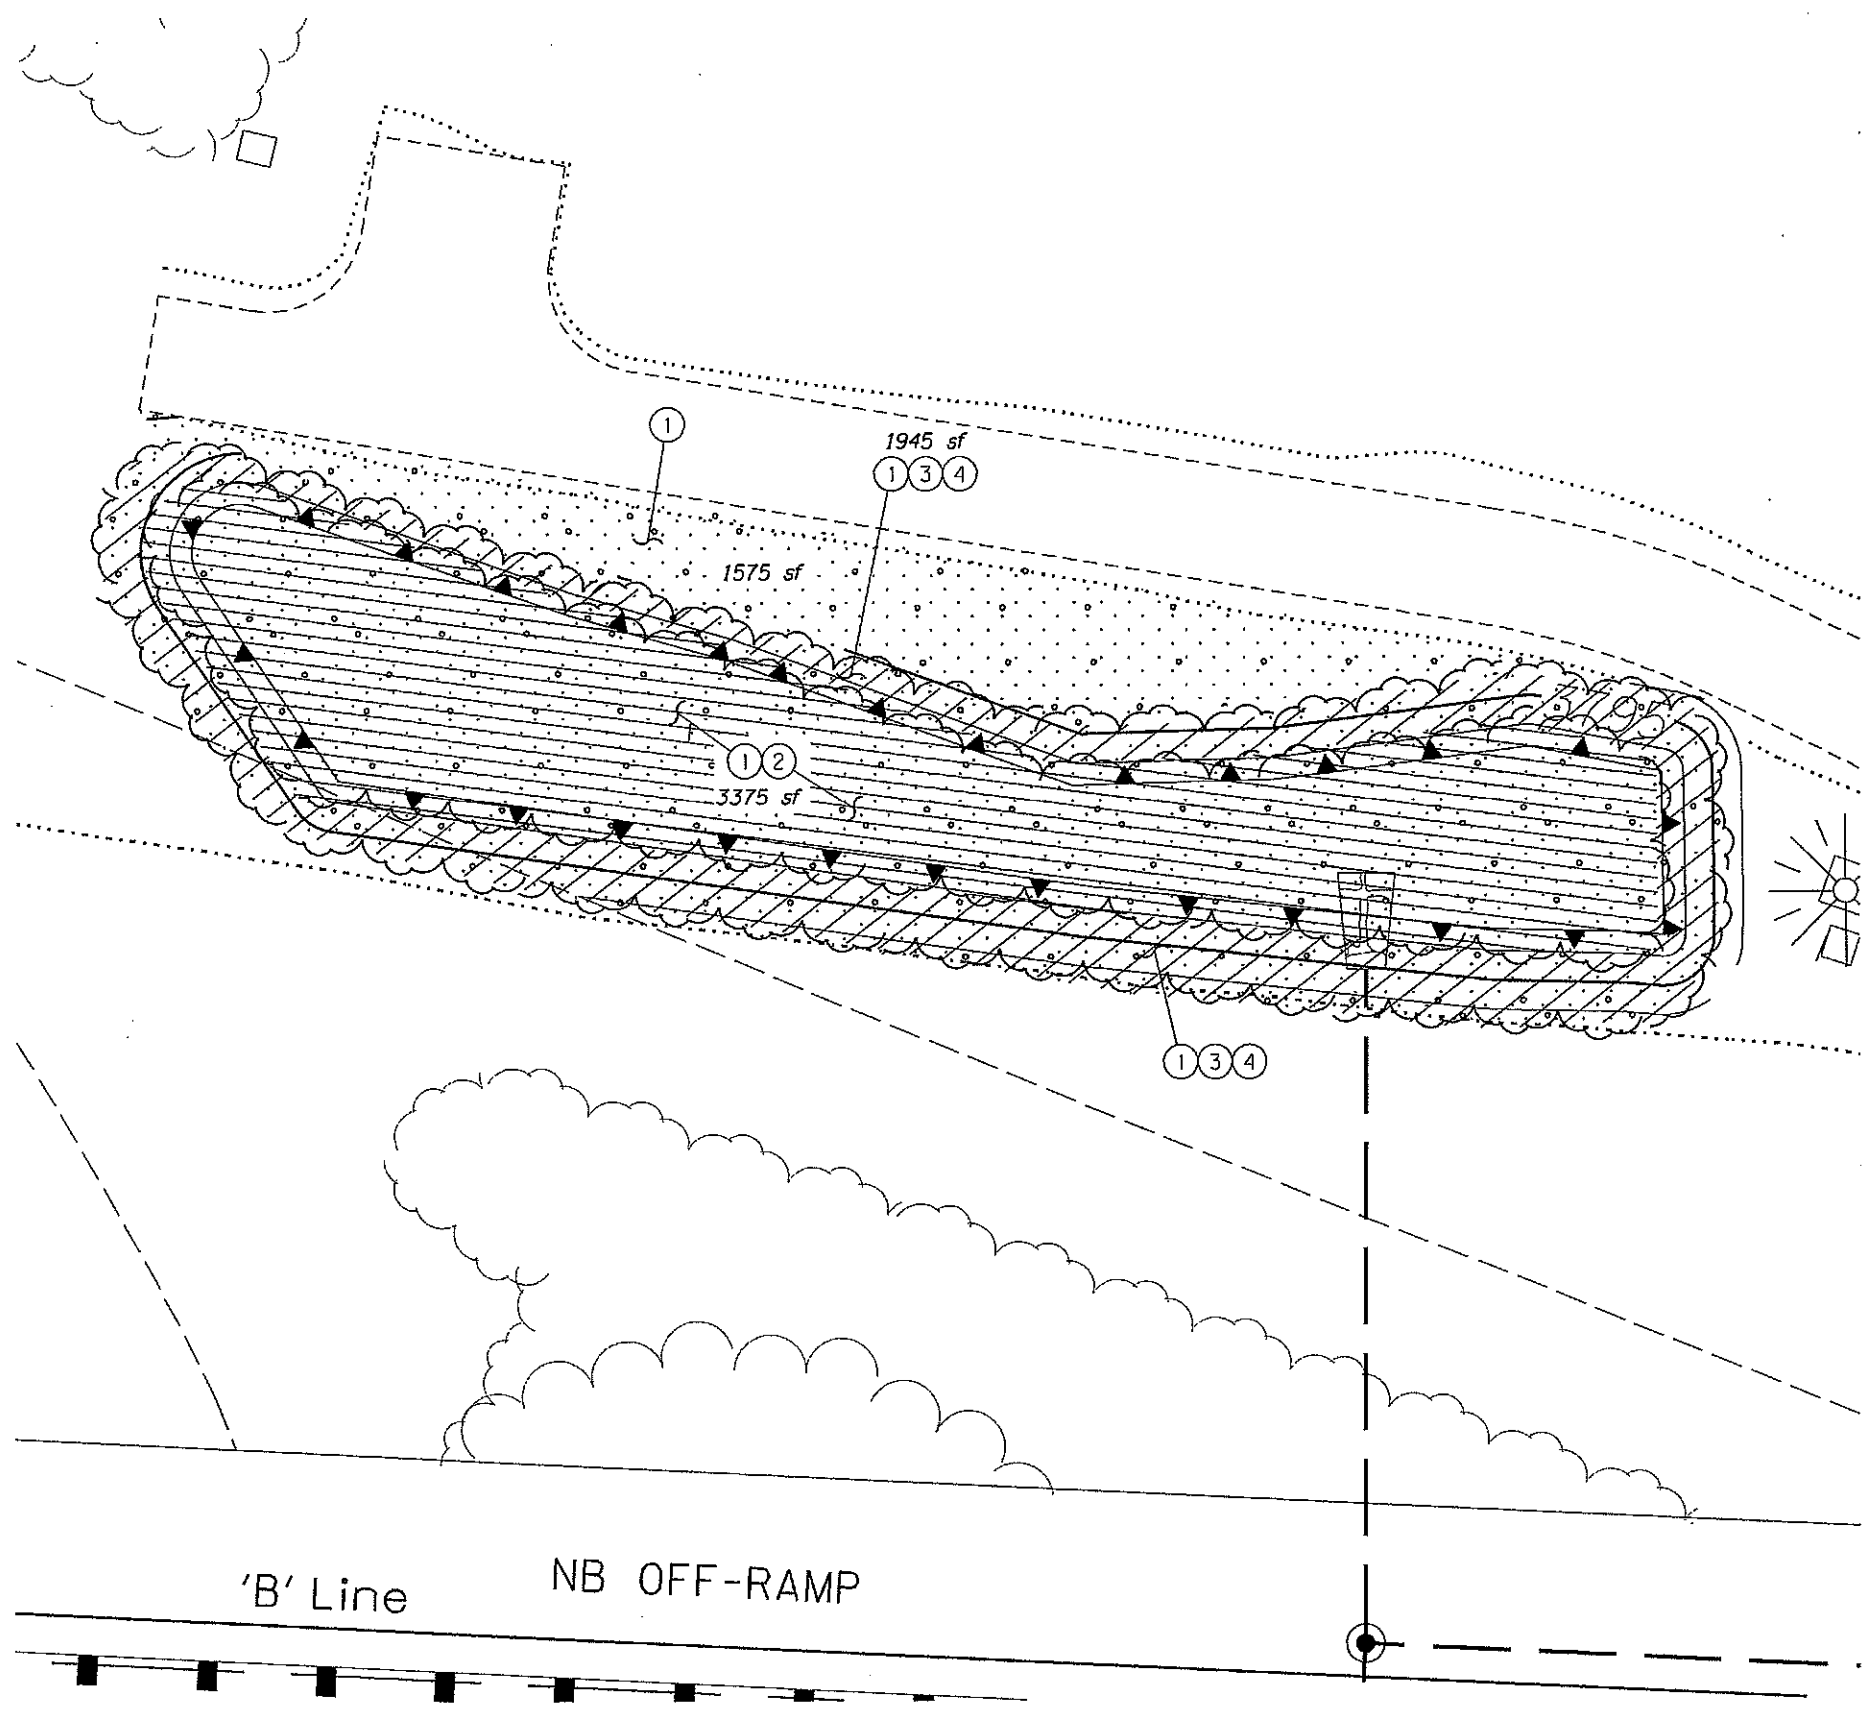


① Seed and mulch area, but excluding access road (Approx. 6895 sq.ft.);  
Permanent Seeding, Mix No. 1 - 0.16 ac.

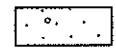


NOT PLANTED


② Plant the following 4" pot groundcover at 30" o.c. (Approx. 3375 sq.ft.);  
Lupinus lepidus - 540  
Groundcover, 4" pot - 540

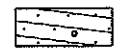


③ Plant the following No. 1 Container shrubs in uniform spacing at 6' o.c. (Approx. 1945 sq.ft.)  
Ribes cereum - 54  
Shrubs, No. 1 Container - 54

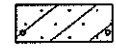

④ Plant with the following herbaceous material (Size as noted) at 2' o.c. (Approx. 1945 sq.ft.)  
Achillea millefolium (Tubelings) - 240  
Eriophyllum lanatum (Bulb) - 240  
Bulbs - 240  
Tubelings - 240

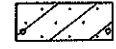

REVISED AS CONSTRUCTED  
*[Signature]*  
Project Manager Date

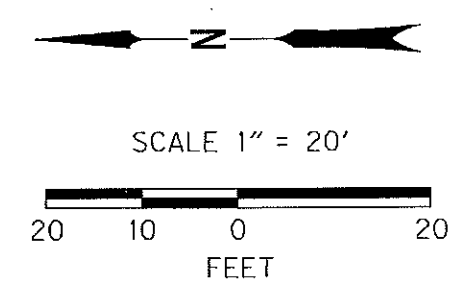


REGISTERED  
317  
*[Signature]*  
MICHAEL D. SMYTH  
OREGON  
04/04/94  
LANDSCAPE ARCHITECT  
04/30/2013

OREGON DEPARTMENT OF TRANSPORTATION	
<b>WHPacific</b>	9755 SW Barnes Rd Ste 300 Portland, OR 97225 t: 503.626.0455 f: 503.526.0775
US97/MURPHY ROAD: BROOKSWOOD - PARRELL (BEND) PHASE 1 THE DALLES-CALIFORNIA HIGHWAY DESCHUTES COUNTY	
Reviewed By - Barry Johnson Designed By - Mike Smyth Drafted By - Tammy Taggart	
STORMWATER FACILITY PLANTING	SHEET NO. GJ-12

**BIOFILTRATION PLANT MATERIAL SCHEDULE**


SCIENTIFIC NAME	COMMON NAME	SIZE (CLASS)	ROOT TYPE	PLANT DESCRIPTION	A.S.N.S.	SPACING	LAYOUT	PERCENT OF AREA	QUANTITIES BY SHEET				TOTAL
									GJ-3	GJ-6	GJ-9	GJ-12	
<b>SHRUBS, No. 1 Container</b>													
<i>Ribes cereum</i>	Wax Currant	#1	Cont.	Multi-stem, 12" ht.	2.1.3.3, Type 2	6' o.c.	Random		42	137	267	54	500
<b>TOTAL</b>									<b>42</b>	<b>137</b>	<b>267</b>	<b>54</b>	<b>500</b>
<b>GROUNDCOVER, 4" Pot</b>													
<i>Lupinus lepidus</i>	Prairie Lupine	4"	Pot	Full in container	12.1.3	30" o.c.	Random		480	1110	555	540	2685
<b>TOTAL</b>									<b>480</b>	<b>1110</b>	<b>555</b>	<b>540</b>	<b>2685</b>
<b>HERBACEOUS, BULBS, BARERoot, TUBELINGS, PROPAGULE</b>													
<i>Achillea millefolium</i>	Common Yarrow		Tubeling	Full in container	6.1.2	24" o.c.	Uniform		190	615	1205	240	2250
<i>Eriophyllum lanatum</i>	Oregon Sunshine		Bulb		11.1	24" o.c.	Uniform		190	615	1205	240	2250
<b>TOTAL</b>									<b>380</b>	<b>1230</b>	<b>2410</b>	<b>480</b>	<b>4500</b>
<b>PERMANENT SEEDING, Ac.</b>													
Permanent Seeding, Mix No. 1				See Spec's					0.18	0.35	0.41	0.16	1.10
<b>TOTAL</b>									<b>0.18</b>	<b>0.35</b>	<b>0.41</b>	<b>0.16</b>	<b>1.10</b>

NOT PLANTED ⓐ

REVISED AS CONSTRUCTED  
  
 Project Manager \_\_\_\_\_ Date \_\_\_\_\_

ABBREVIATION TABLE

A.S.N.S.	American Standard For Nursery Stock
B&B	Balled & Burlap
B.R.	Bare Root
Cal.	Caliper
Cont.	Container
L.C.	Live Cutting
O.C.	On Center
W.S.	Where Staked

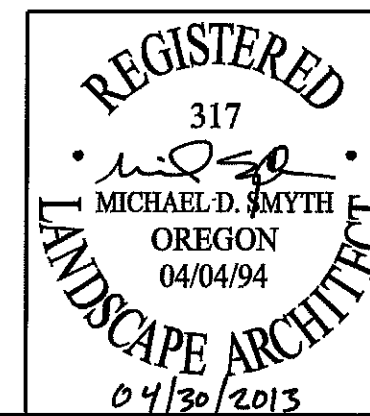

**OREGON DEPARTMENT OF TRANSPORTATION**  
**WHPacific** 9755 SW Barnes Rd Ste 300  
 Portland, OR 97225  
 t: 503.626.0455 f: 503.526.0775

**US97/MURPHY ROAD:  
 BROOKSWOOD - PARRELL (BEND) PHASE 1  
 THE DALLES-CALIFORNIA HIGHWAY  
 DESCHUTES COUNTY**

Reviewed By - Barry Johnson  
 Designed By - Mike Smyth  
 Drafted By - Tommy Taggart

**STORMWATER FACILITY  
 PLANT LIST**

SHEET NO.  
**GJ-13**