

# OPERATION & MAINTENANCE MANUAL

## Water Quality Biofiltration Swale

Manual prepared: December 2018



**DFI No. D00771**

**Figure 1: DFI No. D00771, looking southwest**



## Identification

Drainage Facility ID (DFI): D00771  
Facility Type: Water Quality Biofiltration Swale  
Construction Drawings: (V-File Numbers) 46V-060  
Location: District: 2B  
Highway No.: 047  
Mile Post: 61.05-61.10 (Left Side)

### 1. Manual Purpose

The purpose of this manual is to outline inspection needs and summarize maintenance actions.

### 2. Facility Location

The location map below details the facility location. The highway, mile posts, side streets, access location, and stormwater flow directions are noted on the map.

Facility location type: Off ramp

Flow direction: West

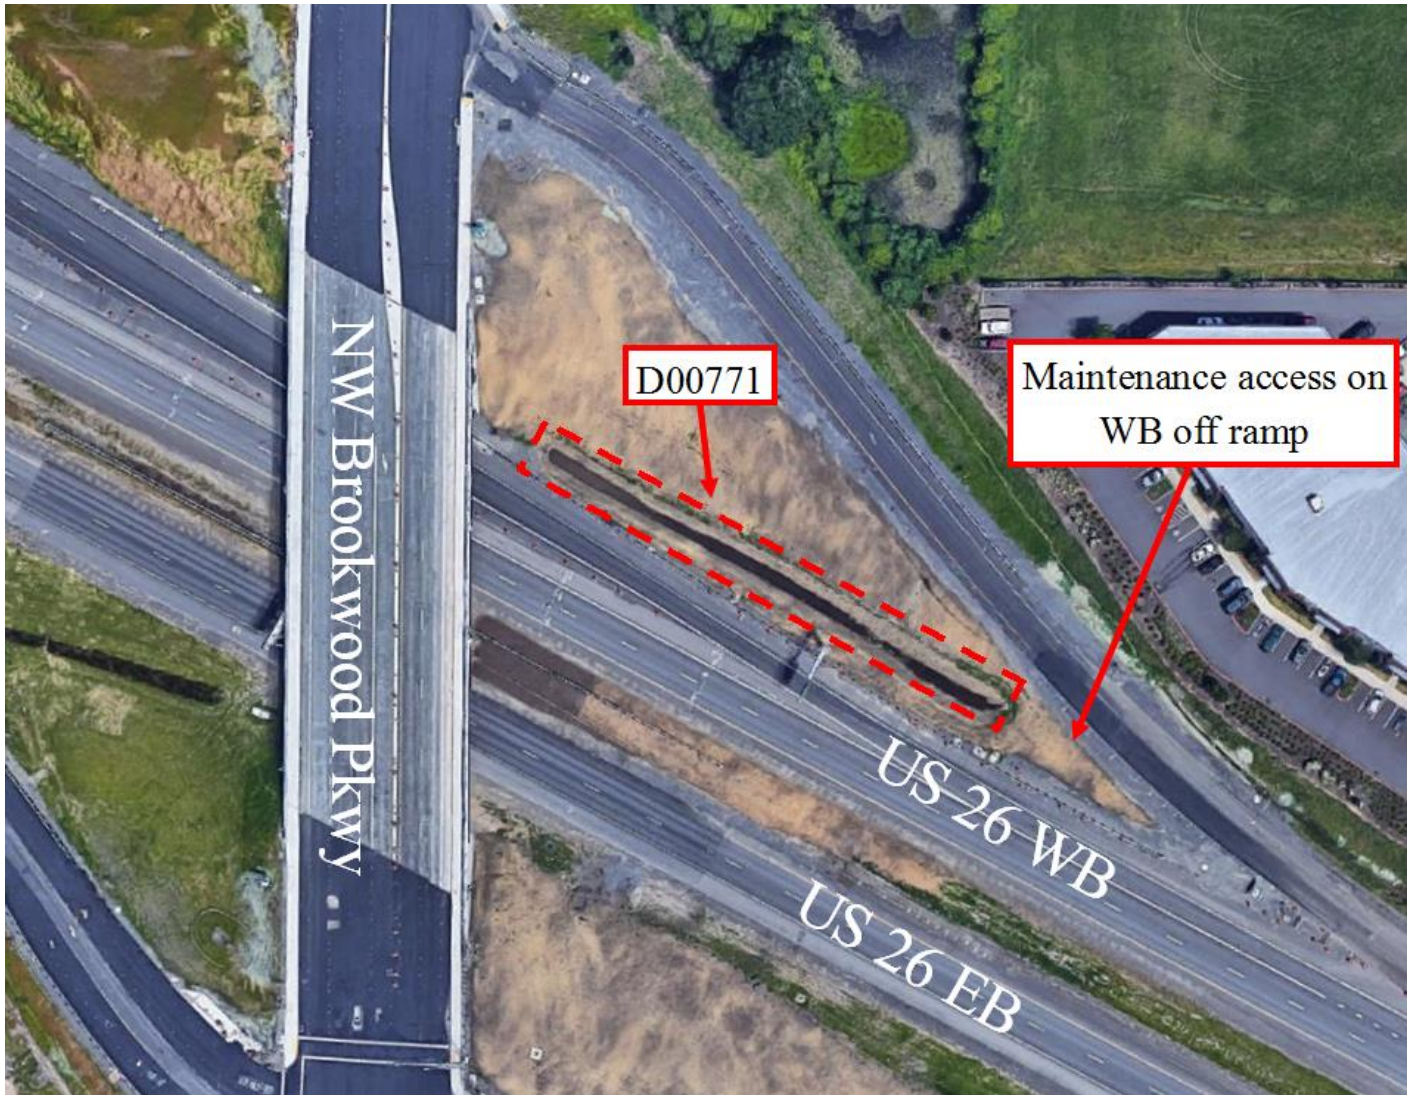



Figure 2: Facility location map

### 3. Facility Summary

The length and width of a swale are based on the bottom dimensions.

The bottom length and bottom width of the swale is:


Bottom Length (feet)	Bottom Width (feet)
317	4

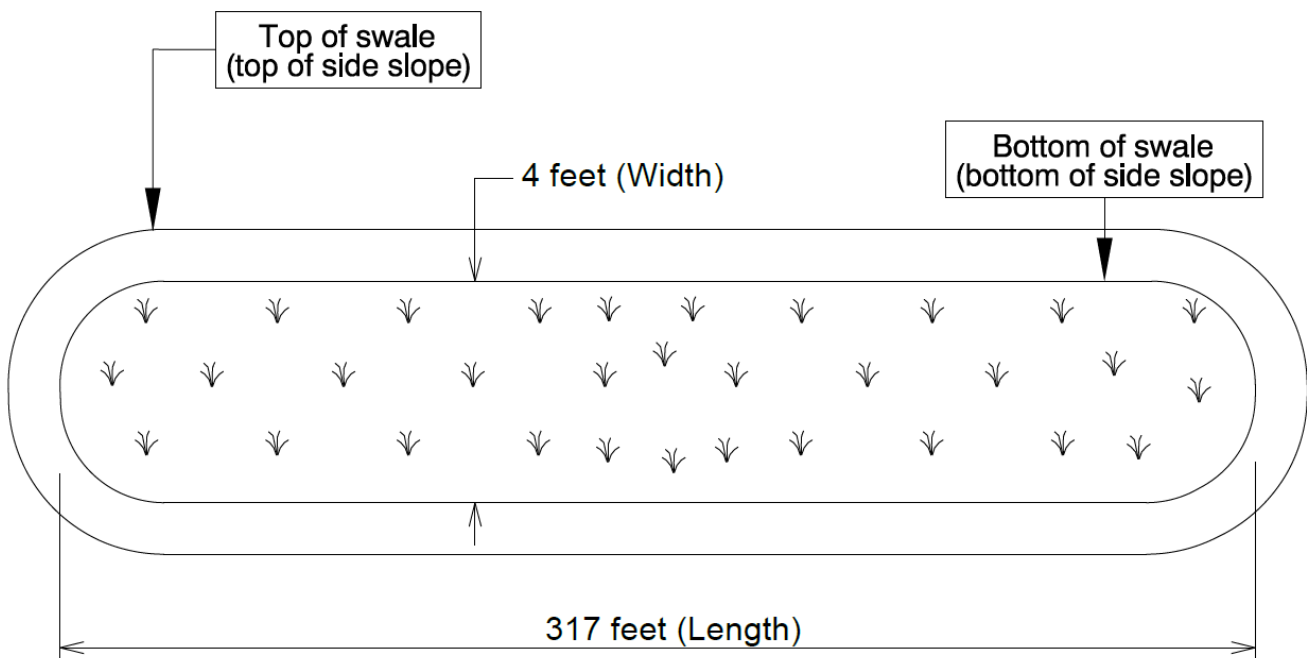

The depth of the swale is the vertical distance measured from the bottom of the swale to the top. The slope of the swale sides is presented by a vertical distance (rise) followed by the horizontal distance (run).

Depth and side slopes:

Depth (feet)	Rise (feet)	Run (feet)
1	1	3

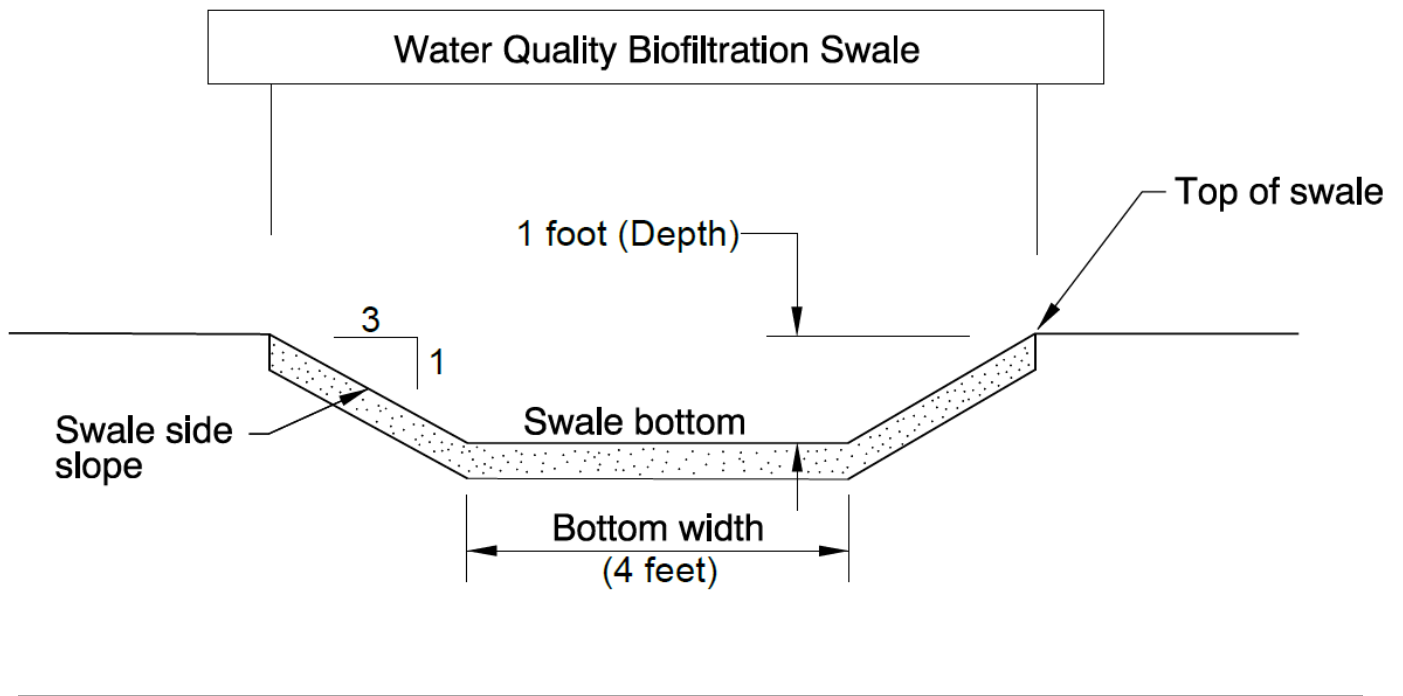

#### 4. Facility Access

Maintenance access to the facility:

<input type="checkbox"/> Roadside pad	<input checked="" type="checkbox"/> Roadside shoulder
<input type="checkbox"/> Access road with Gate	<input type="checkbox"/> Access road without Gate



Figure 3: Maintenance access

#### 5. Operational Components / Maintenance Items

##### Classification

This facility is classified as an:

<input checked="" type="checkbox"/> <b>On-line Swale</b>	<input type="checkbox"/> <b>Off-line Swale</b>
A swale that does not include a high flow bypass component; flow drains into and through the facility	A swale that treats low/small flows and diverts high flows using a bypass component

## Bypass Component

This facility includes a high flow bypass component:

<input checked="" type="checkbox"/> No	<input type="checkbox"/> Yes
There is no bypass component. High flows drain into and through the facility	There is a bypass component. Only low/small flows drain into the swale. High flows are diverted around the swale using a bypass component

## Operational Components

A swale has many components that assist with treatment, conveyance, and reducing flow velocity to minimize erosion. The components in use can vary depending if the facility was designed to operate on-line or off-line. The facility components table (**Table 1**) has been provided to highlight the applicable components for this facility. The component is in use when the box contains an “x” (e.g. ).

The Standard Operation Manual for Water Quality Biofiltration Swales (implemented March 2017) outlines facility operation, typical footprint configuration, and component definitions and details. A link to the manual is attached to the feature marker in TransGIS.

<https://gis.odot.state.or.us/TransGIS/>

## Operational Plan

The applicable standard operational plan for this facility is:

<input type="checkbox"/> Operational Plan A	<input checked="" type="checkbox"/> Operational Plan B	<input type="checkbox"/> Operational Plan C
An on-line swale with roadside ditches	An on-line swale with piped inlets and outlets	An off-line swale with a piped high flow bypass
A standard operational plan illustrates the general facility footprint configuration and explains the purpose of each facility component. Operational plans (A, B, C) are provided in the Standard Operation Manual.		

See Appendix A for the site specific operational plan.

## Maintenance Items

Operational components marked in **Table 1** should be inspected and maintained according to Section 7. Each facility component is defined and detailed in the Standard Operation Manual using the associated ID number indicated below.



<b>Table 1: Swale Components</b>		<b>ID #</b>
<b>Manholes/Structures</b>		
Pre-treatment manhole	<input type="checkbox"/>	<b>S1</b>
Weir type flow splitter/flow splitter manhole	<input type="checkbox"/>	<b>S2</b>
Orifice type flow splitter/flow splitter manhole	<input type="checkbox"/>	<b>S3</b>
Standard manhole	<input type="checkbox"/>	<b>S4</b>
<b>Swale Inlet</b>		
Pavement sheet flow	<input type="checkbox"/>	<b>S5</b>
Inlet Pipe (s)	<input checked="" type="checkbox"/>	<b>S6</b>
Open channel inlet	<input type="checkbox"/>	<b>S7</b>
Riprap pad	<input type="checkbox"/>	<b>S8</b>
<b>Ground Cover</b>		
Grass bottom	<input checked="" type="checkbox"/>	<b>S9</b>
Grass side slopes	<input checked="" type="checkbox"/>	<b>S10</b>
Granular drain rock	<input type="checkbox"/>	<b>S11</b>
Plantings	<input type="checkbox"/>	<b>S12</b>
<b>Underground Components</b>		
Geotextile fabric	<input type="checkbox"/>	<b>S13</b>
Water quality mix	<input checked="" type="checkbox"/>	<b>S14</b>
Perforated pipe	<input type="checkbox"/>	<b>S15</b>
Porous pavers (access grid)	<input type="checkbox"/>	<b>S16</b>
<b>Flow Spreader</b>		
Rock basin (used at inlet)	<input checked="" type="checkbox"/>	<b>S17</b>
Anchored board (midpoint of swale or every 50 feet along swale bottom)	<input type="checkbox"/>	<b>S18</b>
Other: Flow Spreading Check Dam	<input checked="" type="checkbox"/>	<b>S19</b>
<b>Swale Outlet</b>		
Catch basin with grate	<input type="checkbox"/>	<b>S20</b>
Outlet Pipe (s)	<input checked="" type="checkbox"/>	<b>S21</b>
Open channel outlet	<input type="checkbox"/>	<b>S22</b>
Auxiliary Outlet:	<input type="checkbox"/>	<b>S23</b>
<b>Outfall Type</b>		
Waterbody (Creek/Lake/Ocean)	<input type="checkbox"/> <b>C</b>	<b>S24</b>
	<input type="checkbox"/> <b>L</b>	
	<input type="checkbox"/> <b>O</b>	
Ditch	<input type="checkbox"/>	<b>S25</b>
Storm drain system	<input checked="" type="checkbox"/>	<b>S26</b>
<b>Outfall Components</b>		
Riprap pad	<input type="checkbox"/>	<b>S27</b>
Riprap bank protection	<input type="checkbox"/>	<b>S28</b>

## 6. Maintenance

### Maintenance Frequency/Maintain Records

- a. Inspect annually. Preferably prior to the rainy season.
- b. Clean and maintain as necessary. Refer to Activity 125 for conditions when maintenance is needed.
- c. Keep a record of inspections, maintenance, and repairs.

### Maintenance Guide/Maintenance Actions

The ODOT Routine Road Maintenance Water Quality and Habitat Guide (the *Blue Book*) outlines the standard maintenance actions for water quality facilities under Activity 125.

There are standard maintenance tables for standard ODOT designs. The maintenance tables describe the maintenance component, the defect or problem, the condition when maintenance is needed, and the recommended maintenance to correct the problem. Use the following tables to maintain ODOT swales:

- Table 1 (General Maintenance): Contains general maintenance and inspection guidelines that are applicable to all ODOT water quality facilities
- Table 3 (Maintenance of Water Quality or Biofiltration Swales): Contains maintenance information for swales

The *Blue Book* can be viewed at the following website:

[http://www.oregon.gov/ODOT/Maintenance/Documents/blue\\_book.pdf](http://www.oregon.gov/ODOT/Maintenance/Documents/blue_book.pdf)

## 7. Limitations

Access grid installed:

<input checked="" type="checkbox"/> <b>No</b>	<input type="checkbox"/> <b>Yes</b>
<b>There are no duty porous pavers installed in this swale</b>	

Swales are designed to allow equipment access along the bottom. If an access grid is **NOT** installed, vehicles entering the swale can create depressions (tire ruts), damage vegetation, and damage structural components (e.g. flow spreaders). These conditions may result in poor treatment and drainage performance.

Equipment wheels should be kept on the tops and side slopes. Mower arms may be run along the swale bottom.

## 8. Waste Material Handling

Material removed from the facility is defined as waste by the Department of Environmental Quality (DEQ). Refer to the roadwaste section of the ODOT Maintenance Yard Environmental Management System (EMS) Policy and Procedures Manual for disposal options:

[http://www.oregon.gov/ODOT/Maintenance/Documents/ems\\_manual.pdf](http://www.oregon.gov/ODOT/Maintenance/Documents/ems_manual.pdf)


Contact any of the following for more detailed information about management of waste materials found on site:

ODOT Clean Water Unit	(503) 986-3008
ODOT Statewide Hazmat Coordinator	(503) 667-7442
ODOT Region 1 Hazmat Coordinator	(503) 731-8290
ODOT Region 2 Hazmat Coordinator	(503) 986-2647
ODOT Region 3 Hazmat Coordinator	(541) 957-3594
ODOT Region 4 Hazmat Coordinator	(541) 388-6186
ODOT Region 5 Hazmat Coordinator	(541) 963-1590
ODEQ Northwest Region Office	(503) 229-5263


## **A Appendix A – Site Specific Operational Plan**

### **Contents:**


**Operational Plan: DFI D00771**

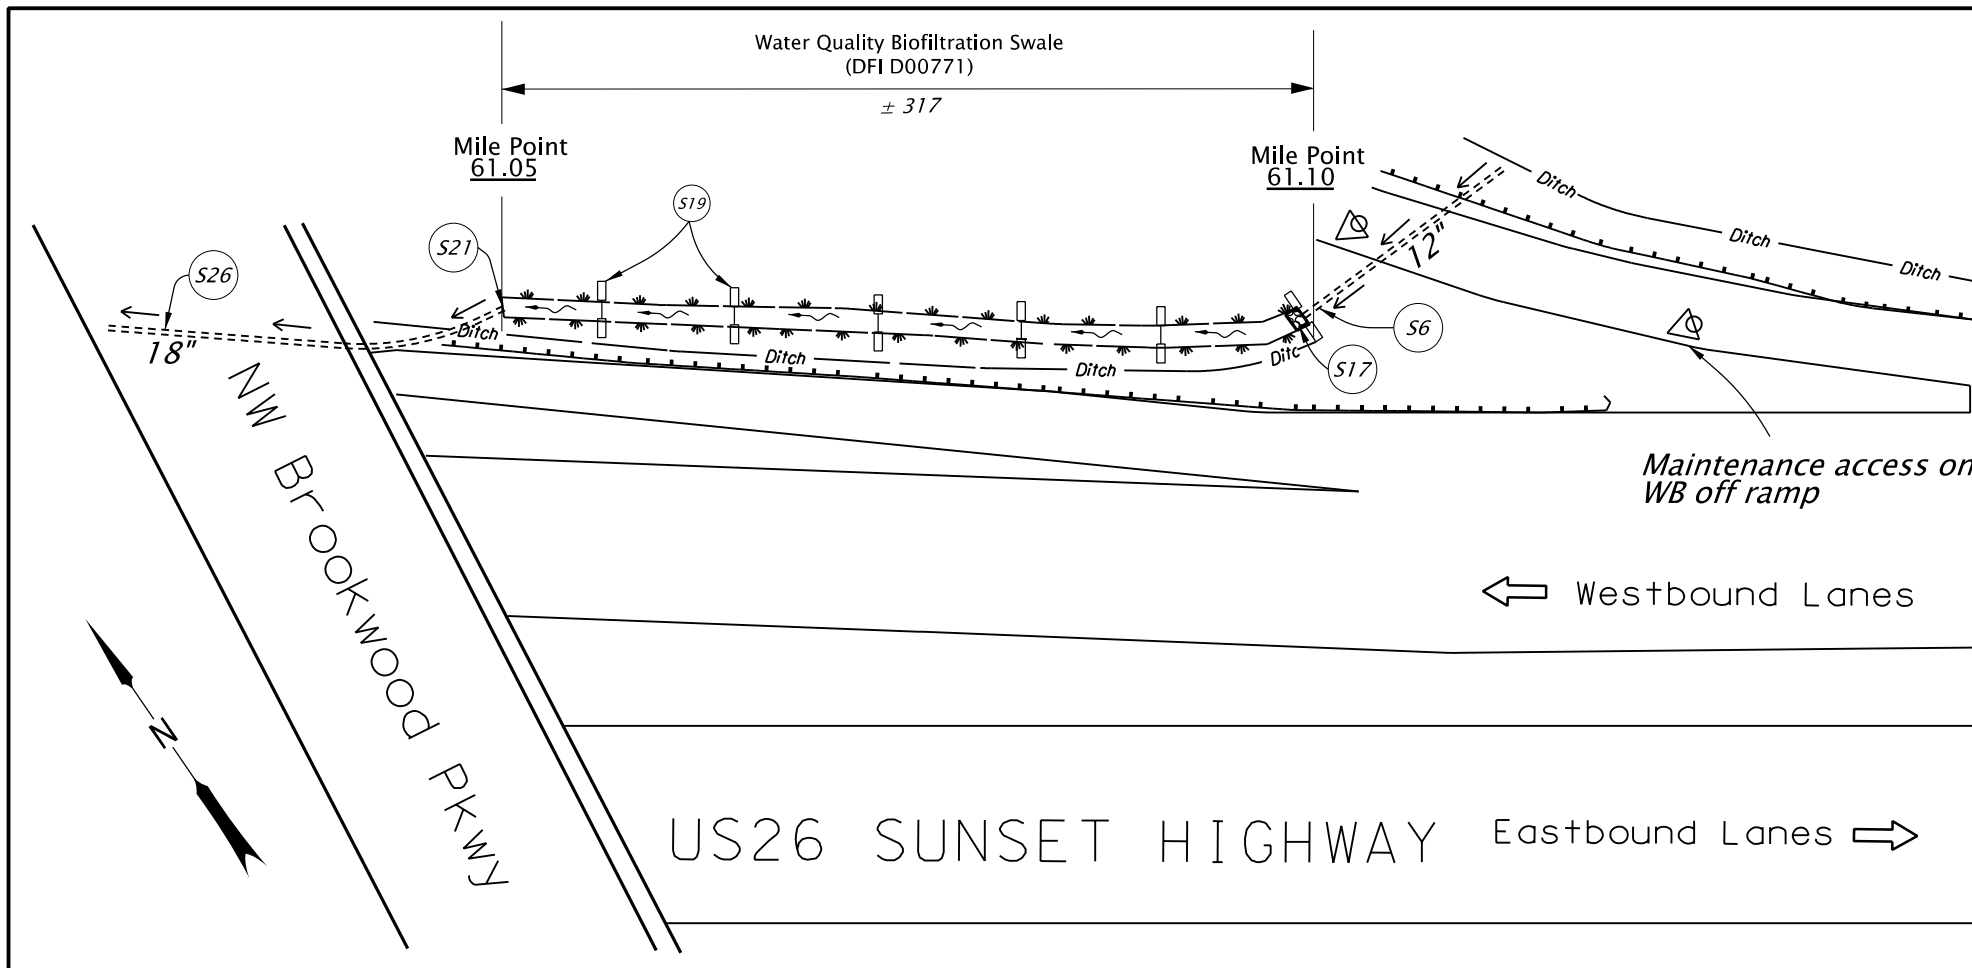

Plan  
N.T.S.

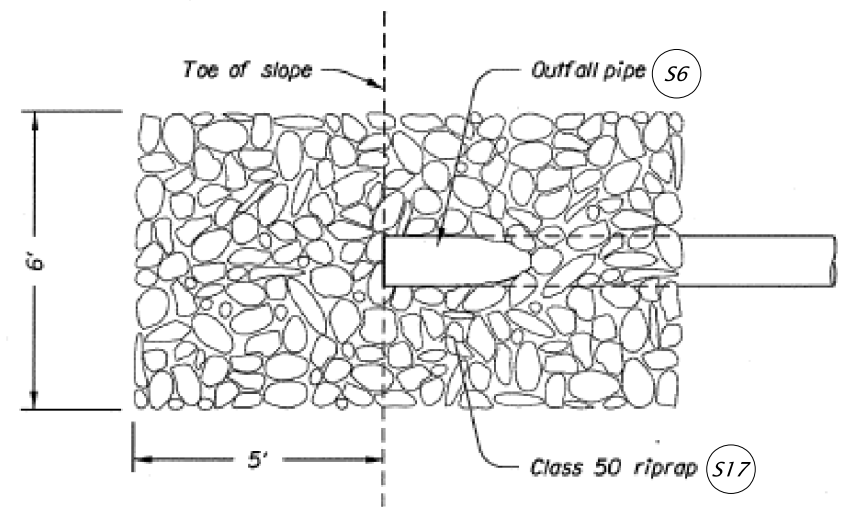


PLAN

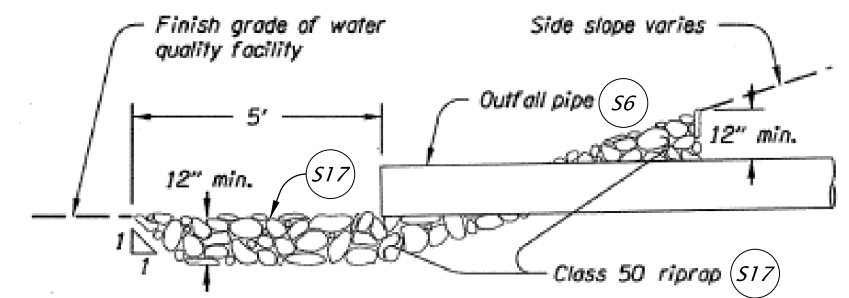

ELEVATION

**INLET ENERGY DISSIPATOR**

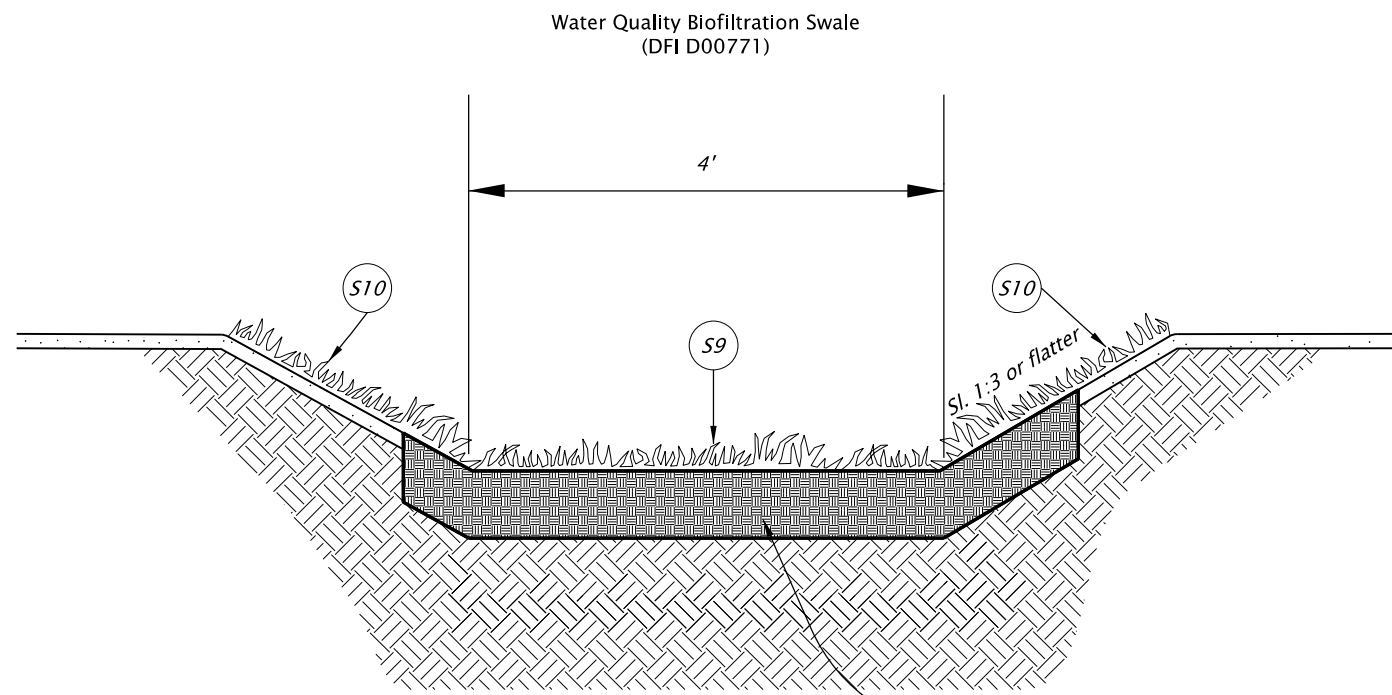

SECTION A-A  
N.T.S.

**Legend**

- Photo Location/Direction
- Storm Pipe (Facility)
- Conveyence Direction
- Water Flow Direction
- Traffic Flow Direction
- Check dam




OREGON DEPARTMENT OF TRANSPORTATION

Sht. 01 of 02


Prepared By:  
Katrina Sepulveda

Drafted By:  
Katrina Sepulveda

**DFI D00771**  
**MAINTENANCE DISTRICT 2B HWY 047**  
**Water Quality Biofiltration Swale**  
SUNSET HIGHWAY MP 61.05-61.10  
Washington County

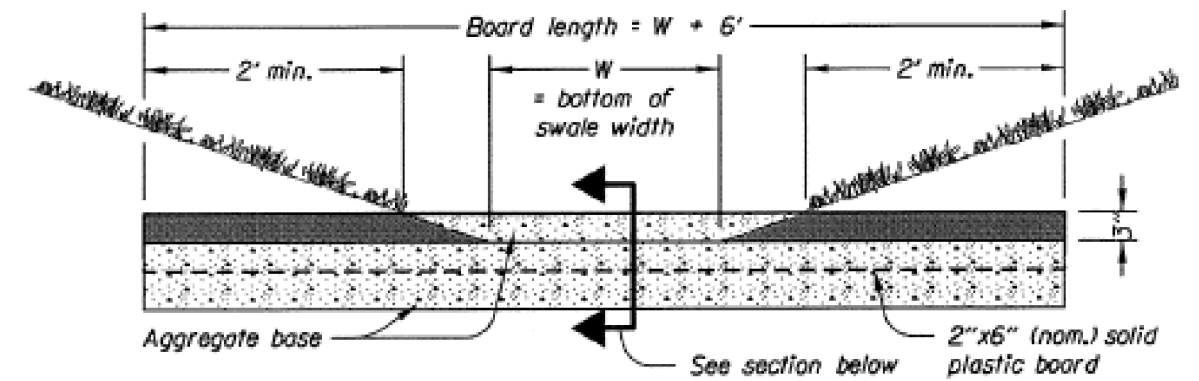

ELEVATION

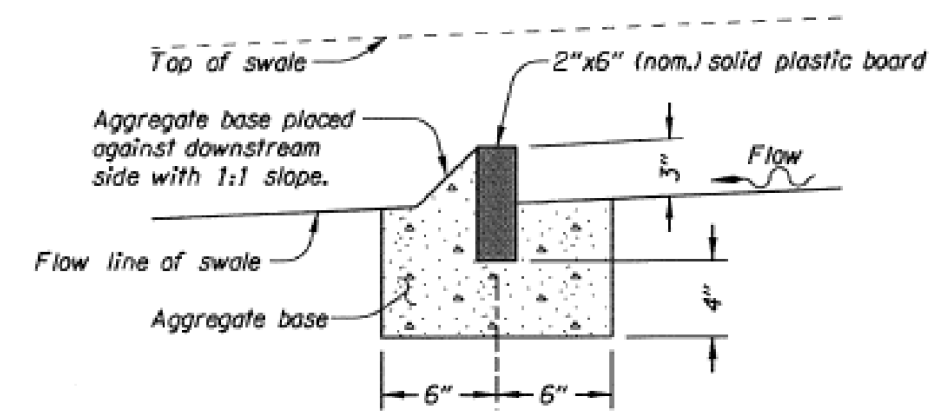

SECTION

**S19 FLOW SPREADING CHECK DAM**  
*Space approx. every 50' or as directed.*



Sht. 02 of 02

Prepared By:  
 Katrina Sepulveda  
 Drafted By:  
 Katrina Sepulveda

**DFI D00771**  
**MAINTENANCE DISTRICT 2B HWY 047**  
**Water Quality Biofiltration Swale**  
 SUNSET HIGHWAY MP 61.05-61.10  
 Washington County

## **B Appendix B – Project Contract Plans**

### **Contents:**

**Site Specific Subset of Project Contract Plan 46V-060**

INDEX OF SHEETS	
SHEET NO.	DESCRIPTION
1	Title Sheet
1A	Index of Sheets Cont'd.
1A-2	Std. Drg. Nos.
1B	Sheet Layout


## STATE OF OREGON DEPARTMENT OF TRANSPORTATION

PLANS FOR PROPOSED PROJECT

**GRADING, DRAINAGE, STRUCTURES, PAVING,  
SIGNING, ILLUMINATION AND SIGNALS**


# US26 @ BROOKWOOD / HELVETIA (SHUTE RD) PROJECT

**SUNSET HIGHWAY  
WASHINGTON COUNTY  
JULY 2013**

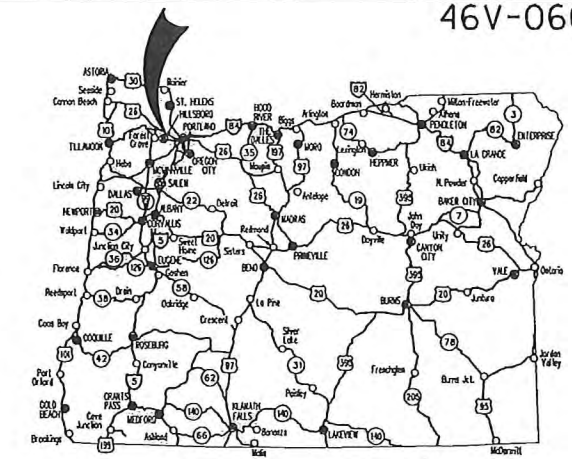

Overall length of project: 1.1 miles

**ATTENTION:**  
Oregon Law Requires You To Follow Rules Adopted By The Oregon Utility Notification Center. Those Rules Are Set Forth in OAR 952-001-0010 Through OAR 952-001-0090. You May Obtain Copies Of The Rules By Calling The Center. (Note: The Telephone Number For The Oregon Utility Center Is (503) 232-1987.)

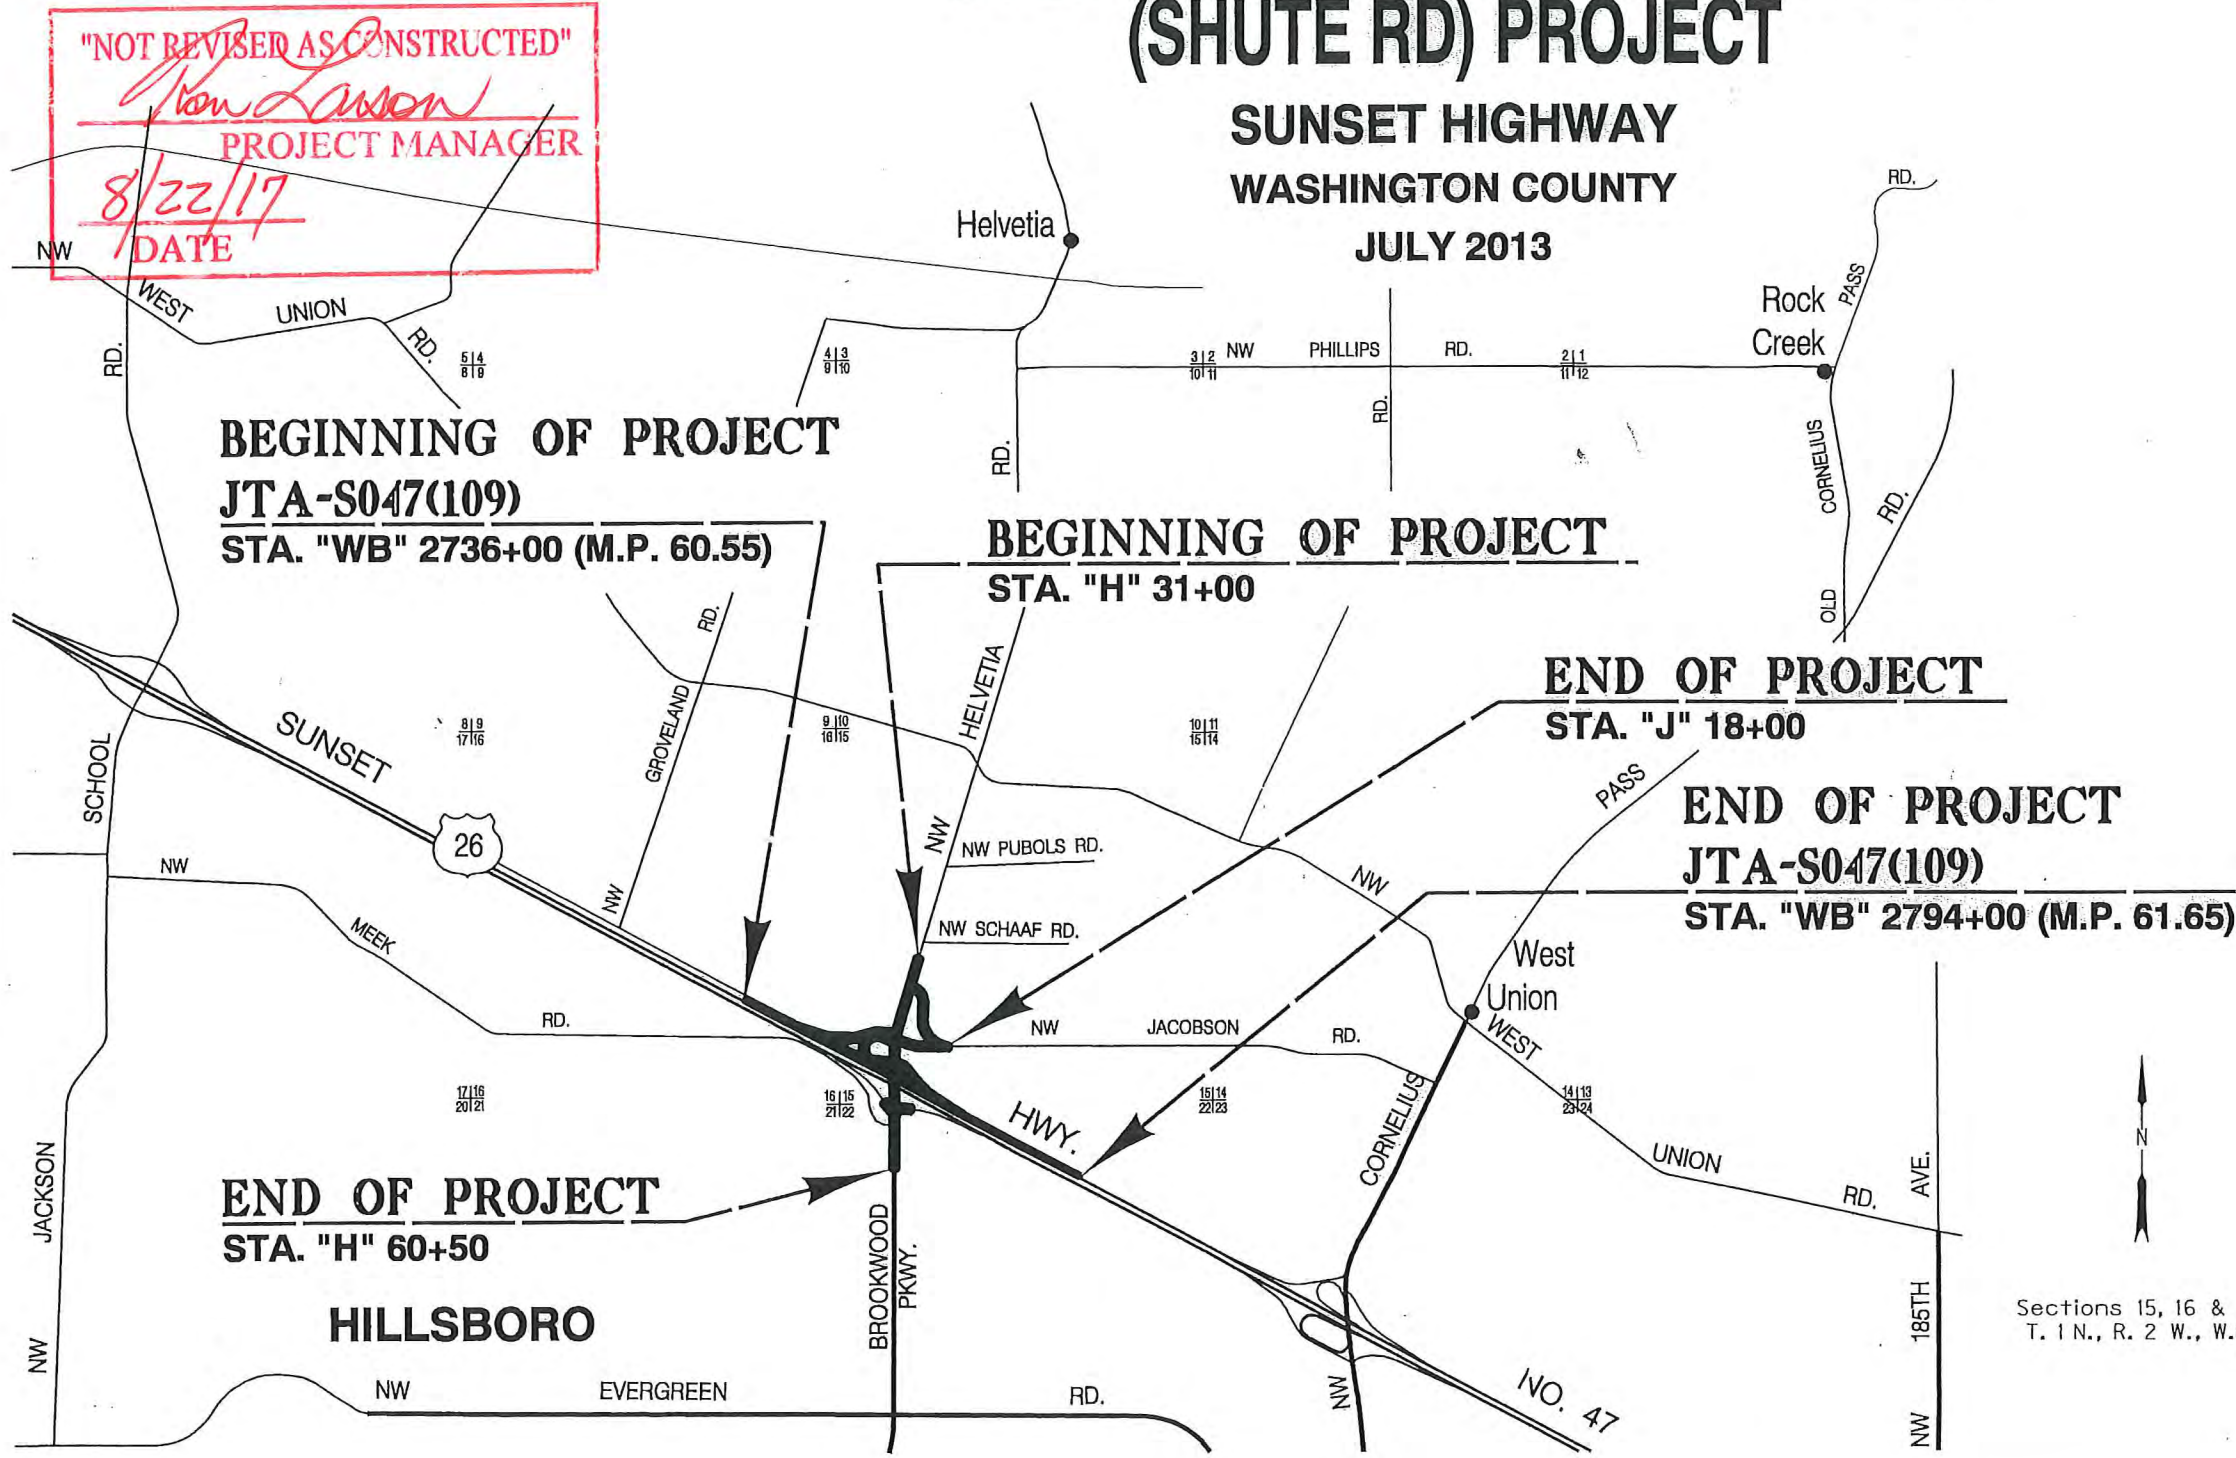

**OREGON TRANSPORTATION COMMISSION**

Pat Egan	CHAIR
David Lohman	COMMISSIONER
Mary F. Olson	COMMISSIONER
Mark Frohnmayer	COMMISSIONER
Tommy Boney	COMMISSIONER
Matthew L. Garrett	DIRECTOR OF TRANSPORTATION

These plans were developed using ODOT design standards. Exceptions to these standards, if any, have been submitted and approved by the ODOT Chief Engineer or their delegated authority.

Approving Authority: *Naveen G. Chandra*  
Naveen G. Chandra, Reg. 1 Project Delivery Mgr.  
6/11/13

*[Signature]*  
Concurrence by ODOT Chief Engineer

<b>US26 @ BROOKWOOD / HELVETIA (SHUTE RD) PROJECT</b>		
SUNSET HIGHWAY WASHINGTON COUNTY		
FEDERAL HIGHWAY ADMINISTRATION	PROJECT NUMBER	SHEET NO.
OREGON DIVISION	STATE	1

Sections 15, 16 & 22  
T. 1 N., R. 2 W., W.M.



PE001829



INDEX OF SHEETS, CONT'D.	
SHEET NO.	DESCRIPTION
<b>ROADWAY</b>	
2, 2A Thru 2A-14 Incl.	Typical Sections
2B Thru 2B-7 Incl.	Details
2C Thru 2C-57 Incl.	Traffic Control Plans
2D & 2D-2	Pipe Data Sheet
3	General Construction
4	General Construction
5	Alignment & R/W
5A	General Construction
5B	Drainage & Utilities
5B-2	Drainage & Utilities Notes
5C	Profile
6	Alignment & R/W
6A	General Construction
6A-2	Construction Notes
6B	Drainage & Utilities
6B-2	Drainage & Utilities Notes
6C	Profile
7	General Construction
8	Alignment & R/W
8A	General Construction
8A-2	Construction Notes
9	Alignment & R/W
9A	General Construction
9A-2	Construction Notes
9B	Drainage & Utilities
9B-2	Drainage & Utilities Notes
9C	Profile
10	Alignment & R/W
10A	General Construction
10A-2	Construction Notes
10B	Drainage & Utilities
10B-2	Drainage & Utilities Notes
10C	Profile
11	Alignment & R/W
11A	General Construction
11A-2	Construction Notes
11B	Drainage & Utilities
11B-2	Drainage & Utilities Notes
11C	Profile
11D	Profile
11E	Pedestrian Pathway Details
12	Alignment & R/W
12A	General Construction
12B	Drainage & Utilities
12C	Profile
13	Alignment & R/W
13A	General Construction

INDEX OF SHEETS, CONT'D.	
SHEET NO.	DESCRIPTION
<b>GEO/HYDRO</b>	
GA	Erosion & Sediment Notes
GA-2 Thru GA-43 Incl.	Erosion & Sediment Control Plan
GA-44	Erosion & Sediment Control Details
GB Thru GB-3 Incl.	Drill Hole Locations
GB-4	Wall 1 Subsurface Data
GB-5	Wall 2 Subsurface Data
GB-6 Thru GB-9 Incl.	Subsurface Data
GC	Wall 1 (Structure No. 22103)
GC-2 & GC-3	Wall 2 (Structure No. 22104)
GC-4	Wall 2 Sections (Structure No. 22104)
GC-5	Wall 2 Stages (Structure No. 22104)
GC-6	General Notes & Design Requirements (Structure No. 22103 & 22104)
GE	Culvert & Temporary Water Management Plan
GJ Thru GJ-3 Incl.	Water Quality Facility Details
GJ-4	Water Quality Facility No. 1
GJ-5 Thru GJ-7 Incl.	Water Quality Facility No. 2
GJ-8	Water Quality Facility No. 3
GL Thru GL-2 Incl.	Prospective Disposal Site
GN Thru GN-2 Incl.	Contour Grading Plan
GR	Weed Control Work Plan

INDEX OF SHEETS, CONT'D.	
DRAWING NO.	DESCRIPTION
91879	General Layout & Index
<b>BRIDGE NO. 09722</b>	
<b>NW HELVETIA RD CONN OVER HWY 47</b>	
91880	Plan & Elevation
91881	General Notes
91882	Foundation Data
91883	Staging
91884	Footing Plan
91885	Construction & Concrete Pour Sequence
91886	Deck Plan Span 1
91887	Deck Plan Span 2
91888	Deck Section
91889	Partial Framing Layout
91890	Steel Girder Details - Span 1
91891	Steel Girder Details - Span 2
91892	Girder Camber Details
91893	Field Splice Details
91894	Cross Beam (Bent 2) Details
91895	Cross Beam (Bent 2) Connection
91896	Misc. Welding Details
91897	Intermediate Cross Frame Details
91898	Cross Frames (Bents 1 & 3) Details
91899	Bent 3 (Bent 1 similar)
91900	Misc. (Bents 1 & 3) Details
91901	Bearing Details (Bents 1 & 3)
91902	Wingwalls
91903	Bent 2
91904	Bent 2 - Details
91905	Bearing Details (Bent 2)
91906	Ornamental Protective Fencing 1
91907	Ornamental Protective Fencing 2
91908	Ornamental Protective Fencing 3
91909	Temporary Barrier - Plan & Elevation
91910	Temporary Barrier Details

INDEX OF SHEETS, CONT'D.	
SHEET NO.	DESCRIPTION
<b>STRUCTURE No. 22068 (SIGN BRIDGE)</b>	
S-14078	Plan & Elevation
S-14079	Subsurface Data

STRUCTURE No. 22038	
S-14080	Canilever Sign Support
S-14081	Subsurface Data

ILLUMINATION	
I-02155	Illumination Legend
I-02156 Thru I-02163 Incl.	Illumination Plan
I-02164	Temporary Illumination Legend & Pole Table
I-02165 Thru I-02168 Incl.	Temporary Illumination Plan
I-02169	Temporary Illumination Details

TRAFFIC SIGNALS	
17329	Signal Legend
17330	Signal Plan
17331	Detector Plan
17332	Existing Utility Plan
17333	Signal Removal Plan
17334	Signal Plan
17335	Detector Plan
17336	Existing Utility Plan
17337	Signal Removal Plan
17338	Interconnect Plan
17339	Details
17340	Pump Meter Legend
17341	Pump Meter Plan
17342	Temporary Signal Legend
17343 Thru 17347 Incl.	Temporary Signal & Detector Plan
17348	Existing Utilities
17349 Thru 17351 Incl.	Temporary Signal & Detector Plan
17352	Existing Utilities
17353 Thru 17355 Incl.	Details
17360	Signal Pole Footing - Detail 1 Bridge Dwg. No. 91717
17361	Signal Pole Footing - Detail 2 Bridge Dwg. No. 91718

PERMANENT PAVEMENT MARKINGS	
ST Thru ST-11 Incl.	Striping Plan

DRAWING NO.	DESCRIPTION
<b>PERMANENT SIGNING</b>	
S-14052 Thru S-14075 Incl.	Permanent Signing
S-14076	Rice Museum Signing Plan
<b>STRUCTURE No. 22039</b>	
S-14076	Canilever Sign Support
S-14077	Subsurface Data

ITS	
ITS-1521	ITS Legend
ITS-1522 Thru ITS-1525 Incl.	ITS Plan
ITS-1526 Thru ITS-1527 Incl.	Details

**"REVISED AS CONSTRUCTED"**  
  
**PROJECT MANAGER**  
8/28/17  
**DATE**


Added new Plan Sheets 2A-13, 2A-14, 2B-8 and 11E - Pedestrian Pathway Details, S-14076 - Rice Museum Signing Plan, ITS-1528 - Details

<b>US26 @ BROOKWOOD / HELVETIA (SHUTE RD) PROJECT</b>		
SUNSET HIGHWAY WASHINGTON COUNTY		
FEDERAL HIGHWAY ADMINISTRATION	PROJECT NUMBER	SHEET NO.
OREGON DIVISION	STATE	1A

Standard Drawings located on the web at:  
[http://www.oregon.gov/ODOT/HWY/ENG/SERVICES/standard\\_drawings\\_home.shtml](http://www.oregon.gov/ODOT/HWY/ENG/SERVICES/standard_drawings_home.shtml)

Sec. 15 & 22, T. 1 N., R. 2 W., W.M.  
 BROOKWOOD PKWY. / HELVETIA RD. INTERCHANGE

SCALE: 1"=100'

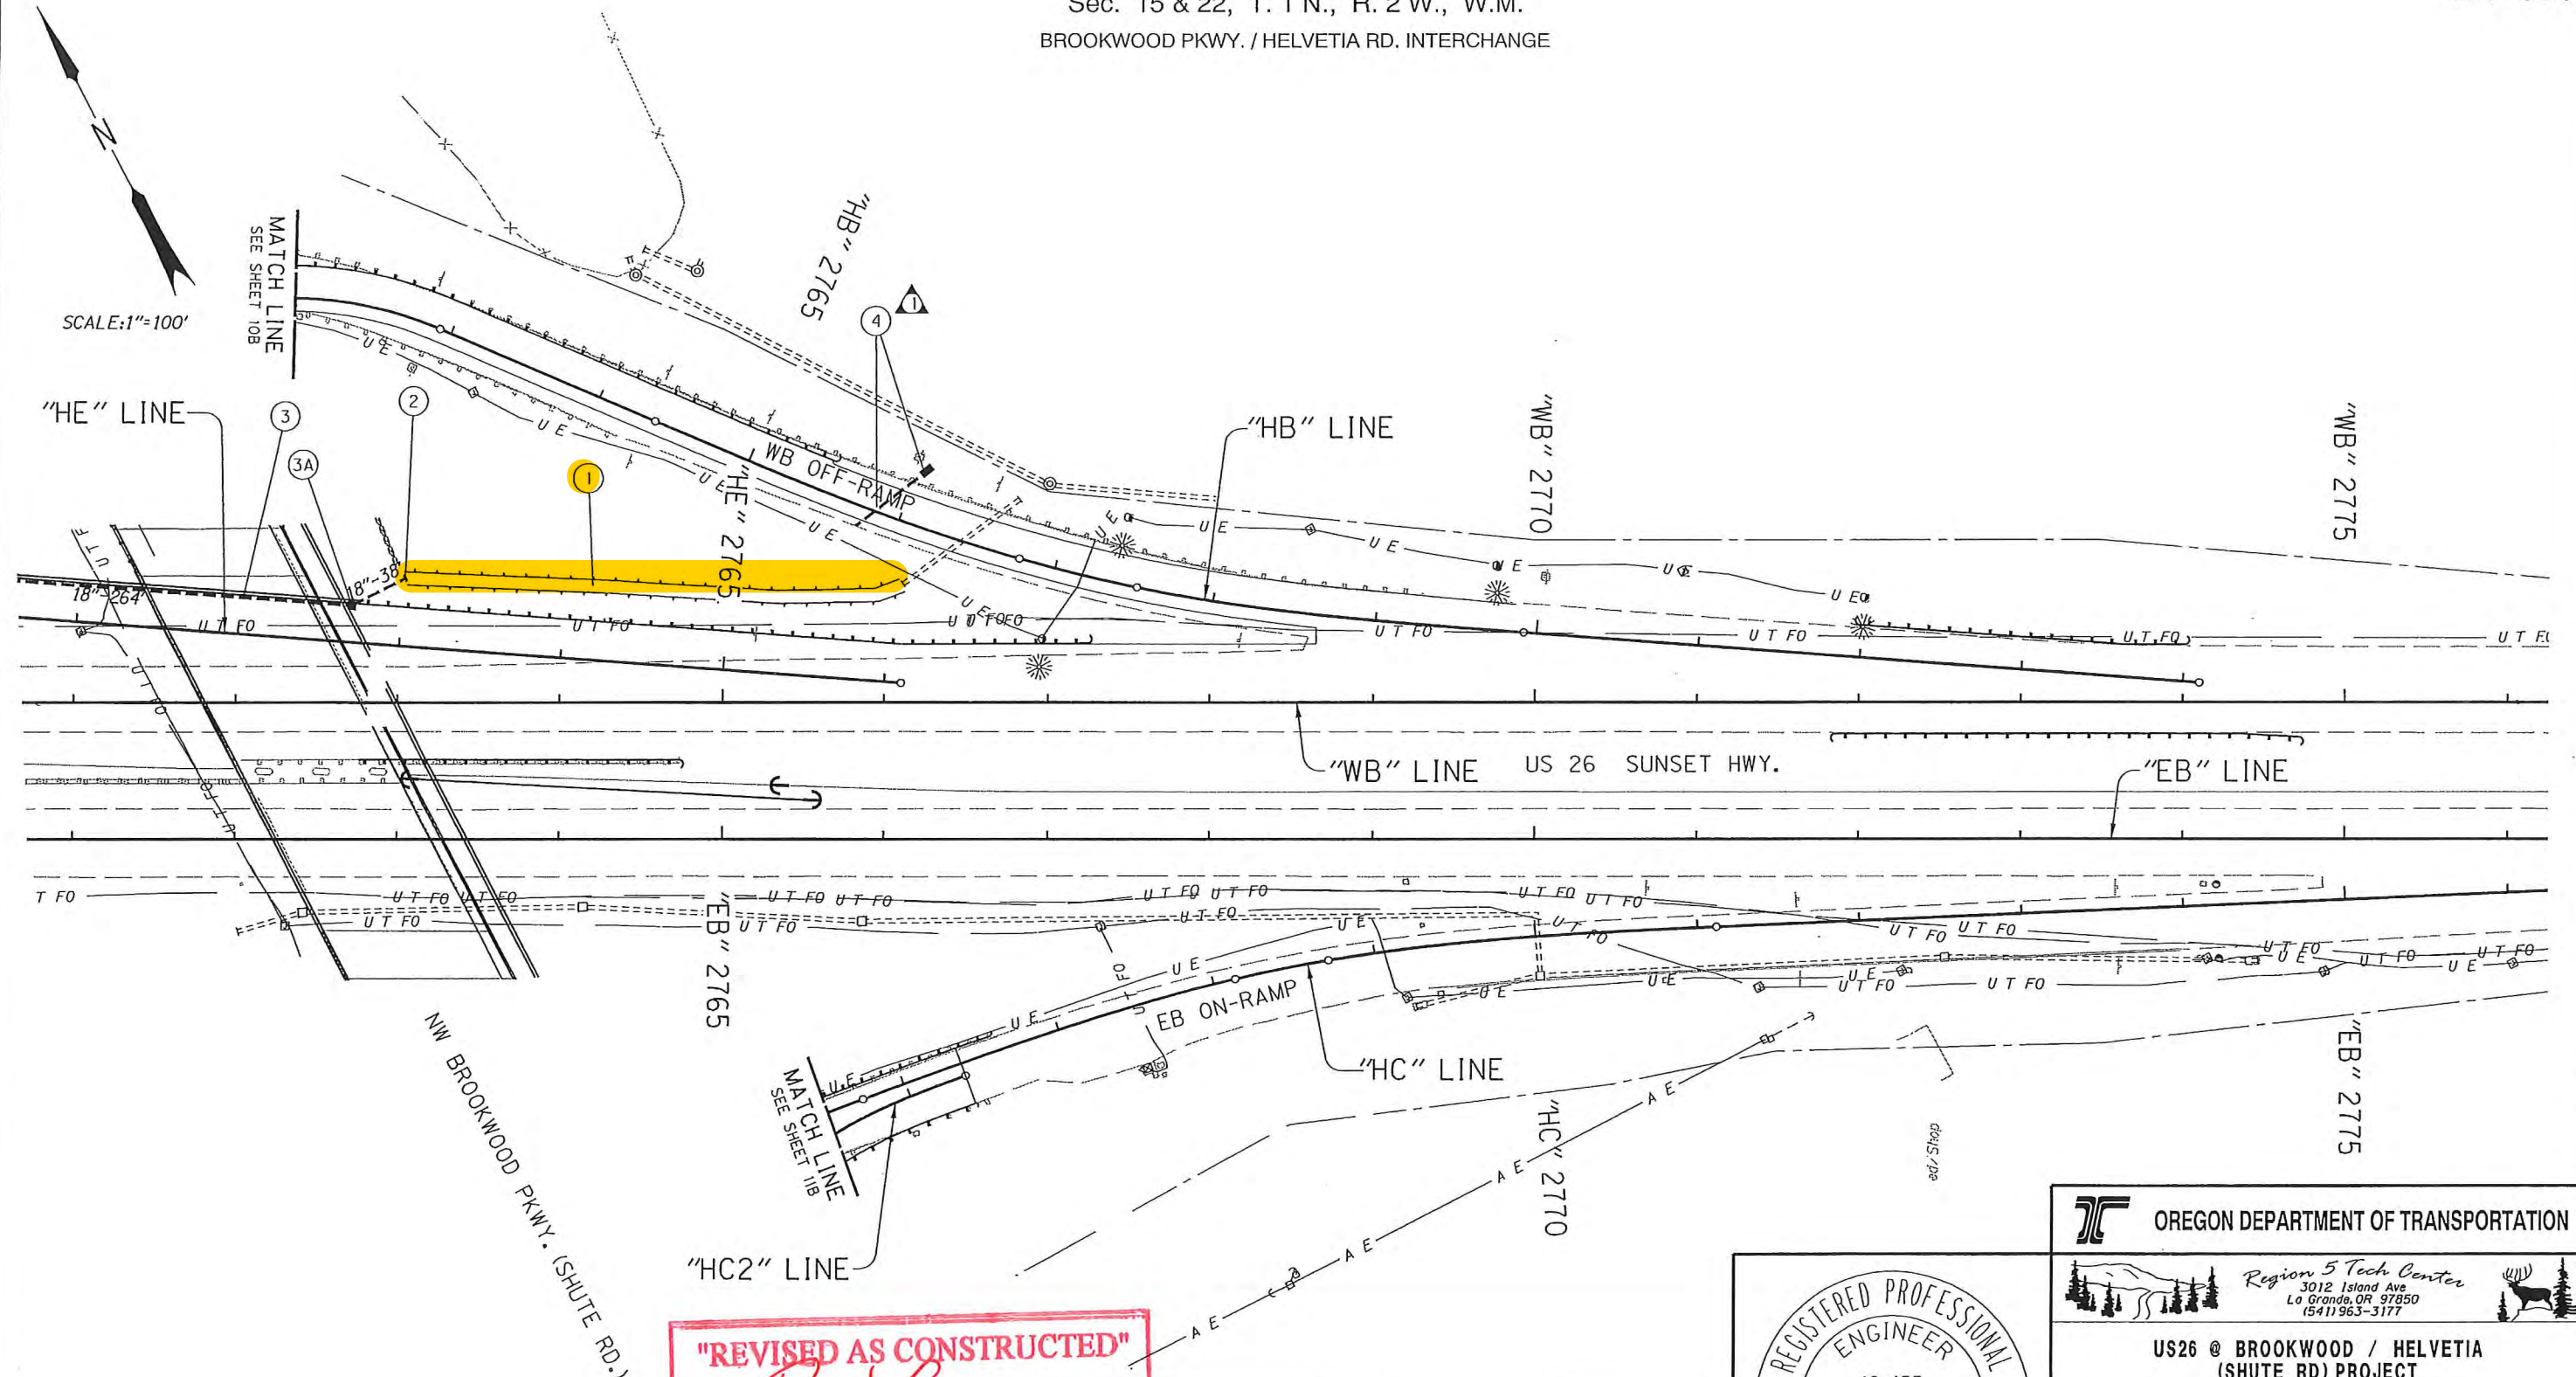

**"REVISED AS CONSTRUCTED"**  
*Van Laxson*  
**PROJECT MANAGER**  
8/22/17  
**DATE**

Removal of pipes, shown thus:

No.	DATE	REVISIONS	BY
4	1-30-2015	Added note 4.	M.J.K.

REGISTERED PROFESSIONAL ENGINEER  
 19,455  
 OREGON  
 SEPT 16, 1997  
 MARK J. KIGHTLINGER  
 RENEWS: 06-30-2015

**OREGON DEPARTMENT OF TRANSPORTATION**

Region 5 Tech Center  
 3012 Island Ave  
 La Grande, OR 97850  
 (541) 963-3177

**US26 @ BROOKWOOD / HELVETIA (SHUTE RD) PROJECT**  
 SUNSET HIGHWAY  
 WASHINGTON COUNTY

Design Team Leader - Thomas Glen Wallace  
 Designed By - Mark J. Kightlinger  
 Drafted By - Mark J. Kightlinger

**DRAINAGE & UTILITIES**

SHEET NO. 6B

\* 18" storm sewer pipe must be ductile iron due to shallow depth as directed by EOR on 8/5/15 via e-mail.

- ① Const. water quality facility no. 1  
(For drg. nos. see sht. 1A)
- ② Sta. "HE" 2763+00, Lt. \* Install 18" Ductile Iron Pipe - 38'  
~~Inst. 18" storm sewer pipe - 38'~~  
5' depth
- ③ (See sht. 5B-2, note 10) \* Install 18" Ductile Iron Pipe  
~~Inst. 18" storm sewer pipe~~  
3A Sta. "HE" 2762+69, Lt. Offset 22.50' Left  
Const. Type "G-2" Inlet
- ⚠ ④ Sta. "HB" 2765+85±  
Inst. 4" Subsurface drain pipe  
(Perforated) - 56'  
Inst. outlet protection block  
(See drg. no. RD312)

**"REVISED AS CONSTRUCTED"**  
*Ken Larson*  
 PROJECT MANAGER  
 8/22/17  
 DATE

No.	DATE	REVISIONS	BY
⚠	1-30-2015	Added note 4.	M.J.K.

REGISTERED PROFESSIONAL ENGINEER  
 19,455  
*Mark J. Kightlinger*  
 OREGON  
 SEPT 16, 1997  
 MARK J. KIGHTLINGER  
 1/30/2015  
 RENEWS: 06-30-2015

**OREGON DEPARTMENT OF TRANSPORTATION**


*Region 5 Tech Center*  
 3012 Island Ave  
 La Grande, OR 97850  
 (541) 963-3177

**US26 @ BROOKWOOD / HELVETIA (SHUTE RD) PROJECT**  
 SUNSET HIGHWAY  
 WASHINGTON COUNTY

Design Team Leader - Thomas Glen Wallace  
 Designed By - Mark J. Kightlinger  
 Drafted By - Mark J. Kightlinger

**DRAINAGE & UTILITIES NOTES**

SHEET NO. 6B-2

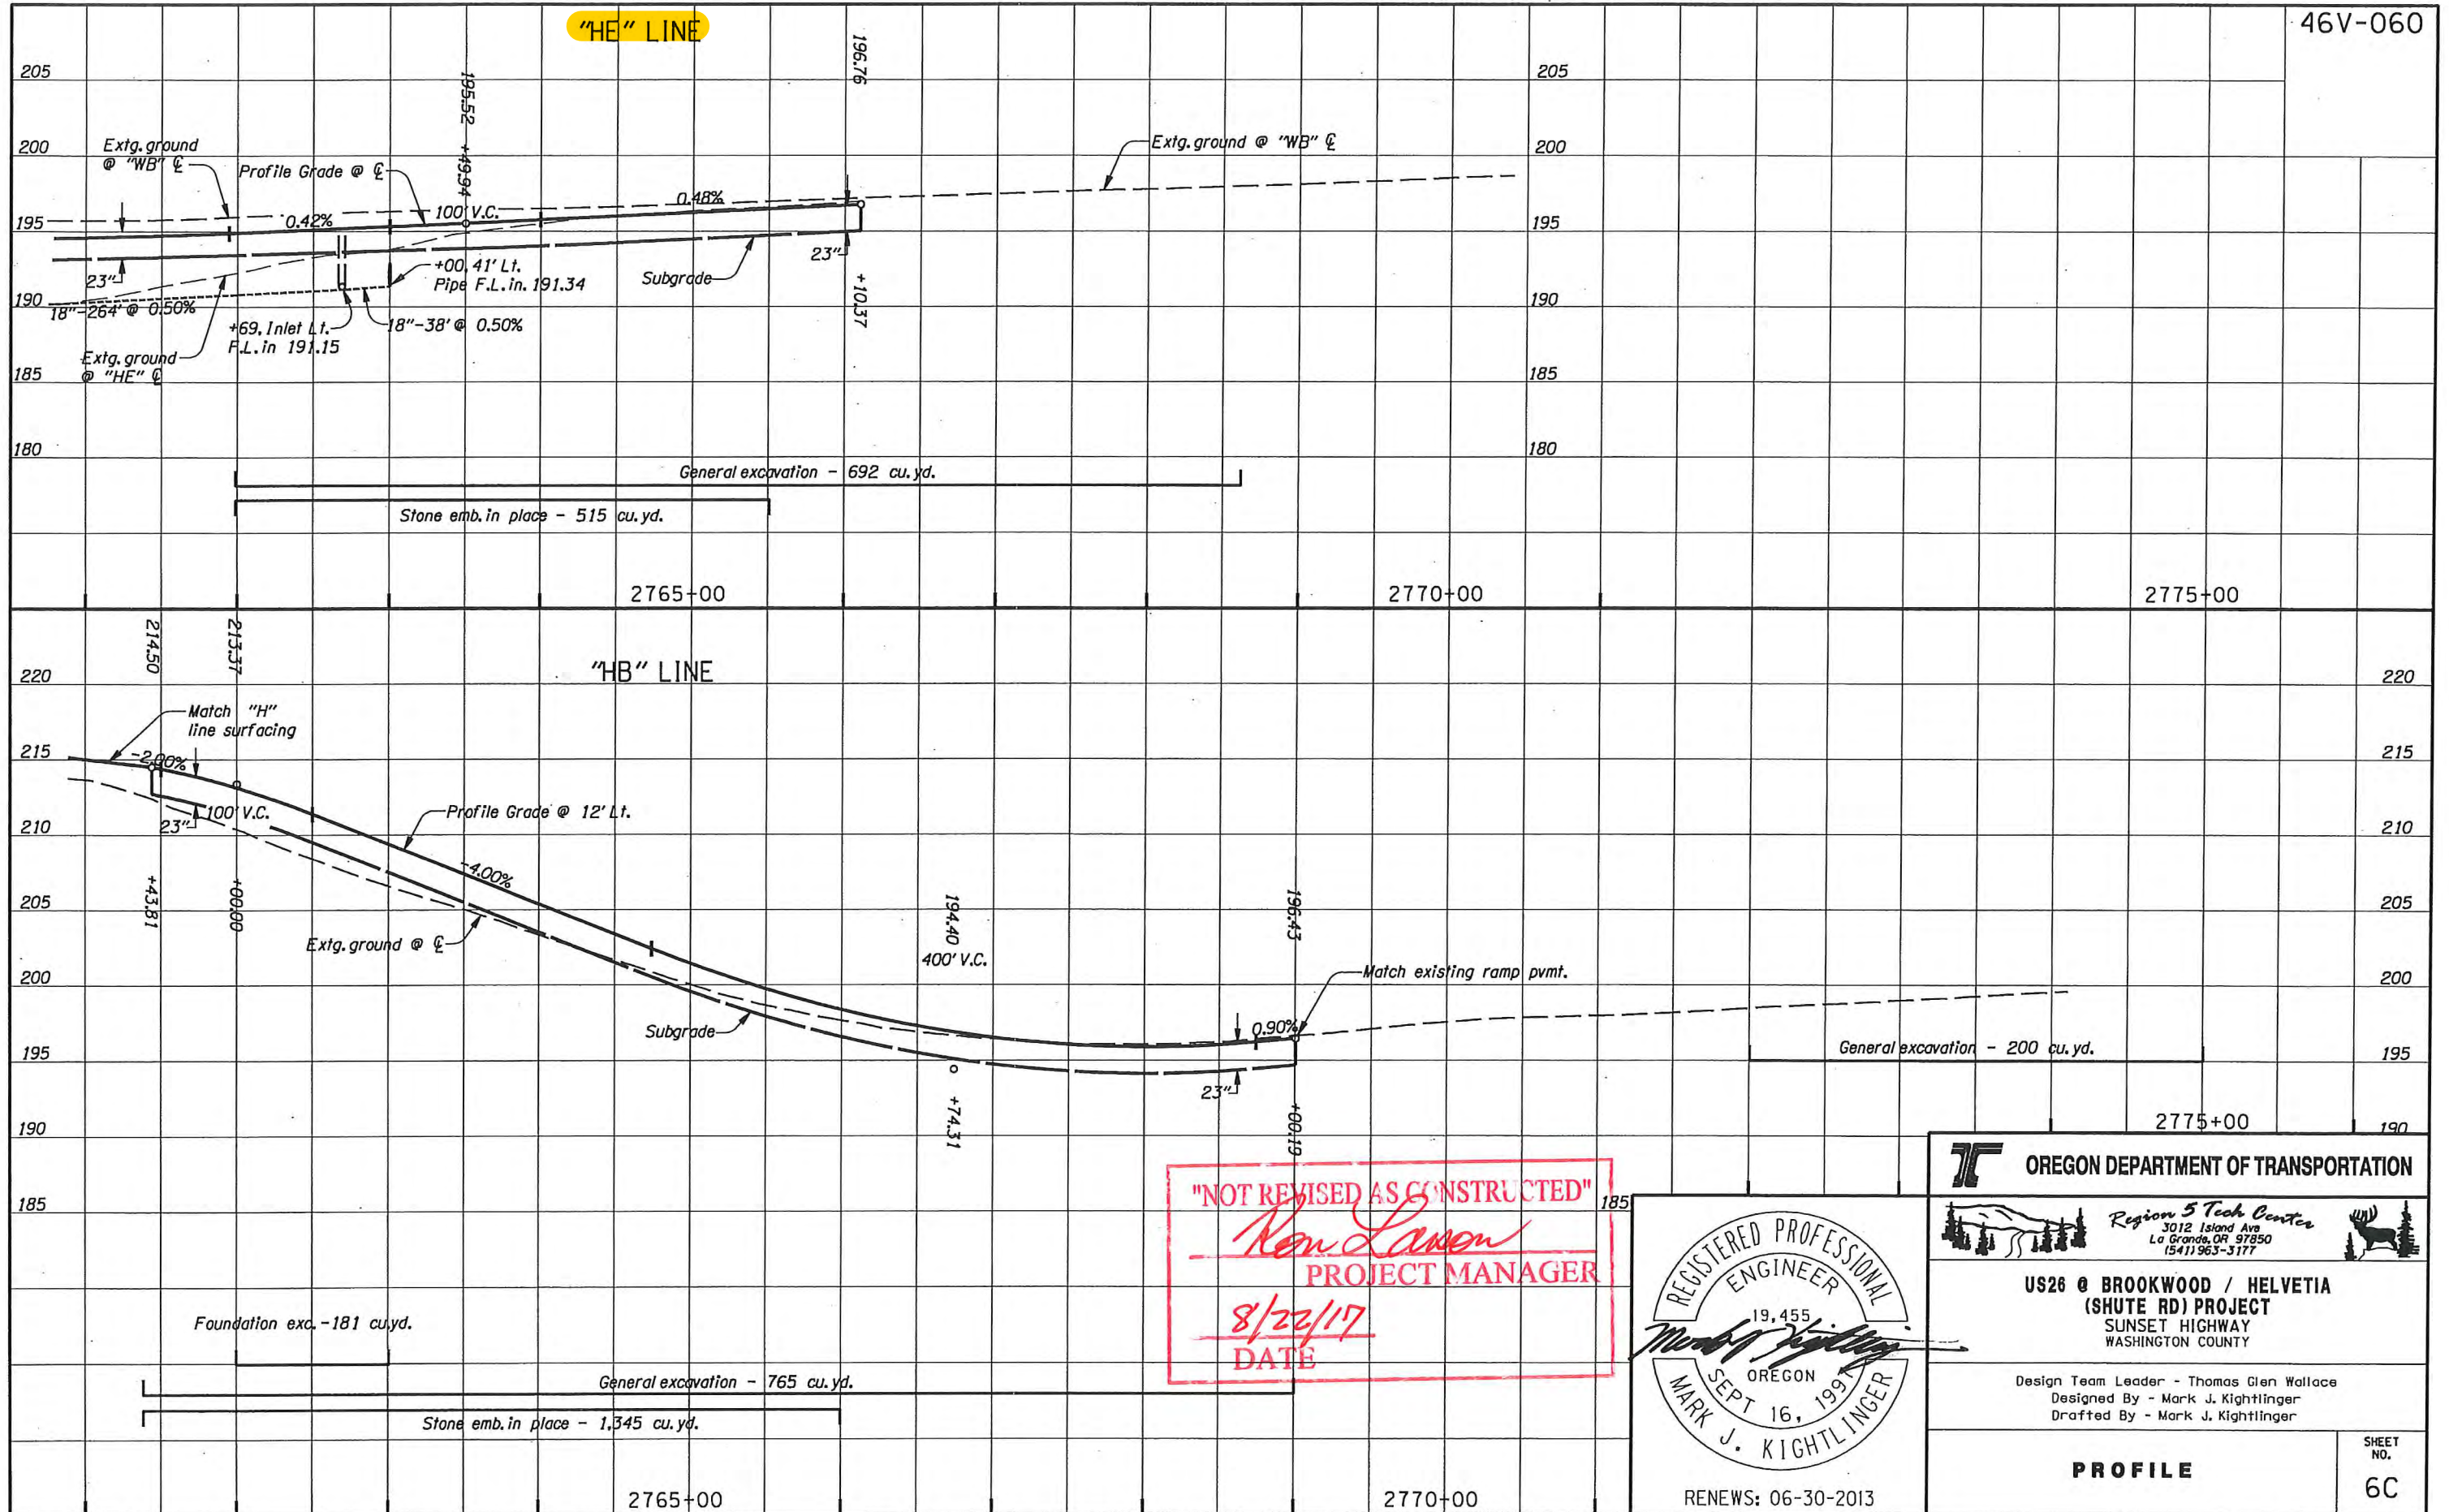

"NOT REVISED AS CONSTRUCTED"  
*Ken Lanon*  
 PROJECT MANAGER  
 8/22/17  
 DATE

REGISTERED PROFESSIONAL  
 ENGINEER  
 19,455  
*Mark J. Kightlinger*  
 OREGON  
 SEPT 16, 1991  
 MARK J. KIGHTLINGER  
 RENEWS: 06-30-2013

**OREGON DEPARTMENT OF TRANSPORTATION**


*Region 5 Tech Center*  
 3012 Island Ave  
 La Grange, OR 97850  
 15411963-3177

**US26 @ BROOKWOOD / HELVETIA  
 (SHUTE RD) PROJECT**  
 SUNSET HIGHWAY  
 WASHINGTON COUNTY


Design Team Leader - Thomas Glen Wallace  
 Designed By - Mark J. Kightlinger  
 Drafted By - Mark J. Kightlinger

**PROFILE**


SHEET NO.  
**6C**

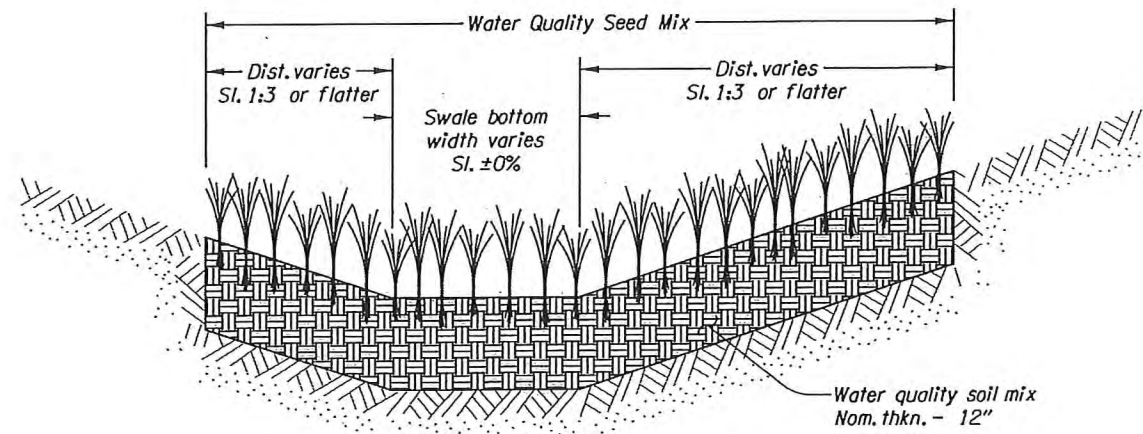


**WATER QUALITY SWALE SECTION**

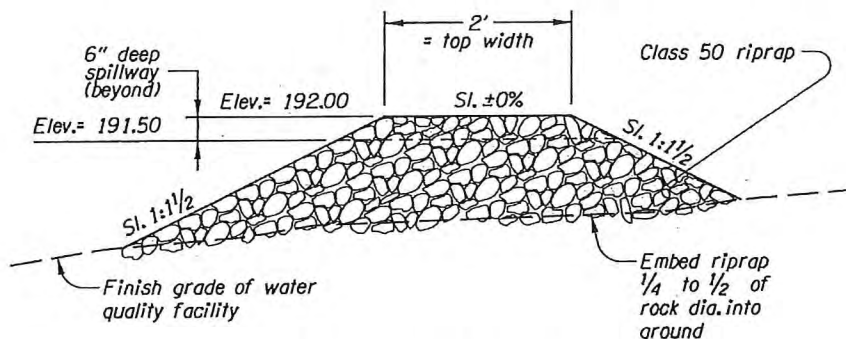


**FOREBAY BERM**

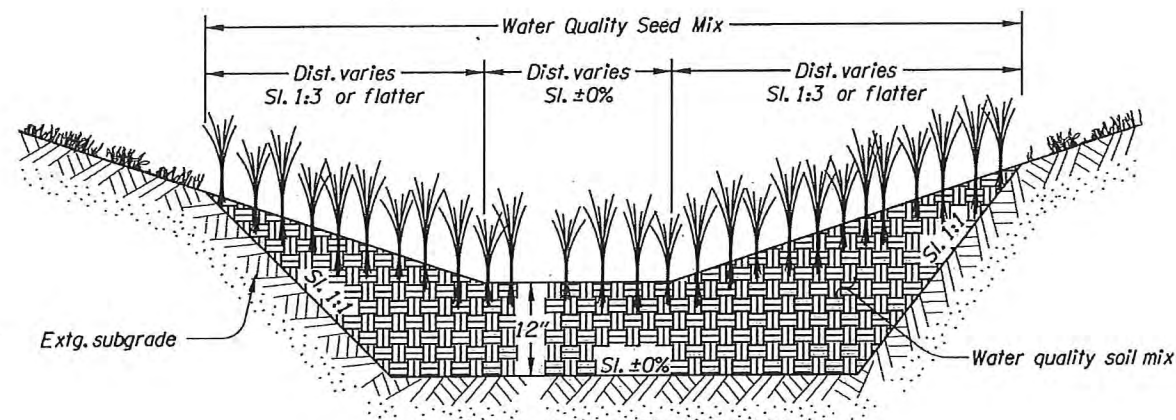

**TYPICAL DRY POND SECTION**

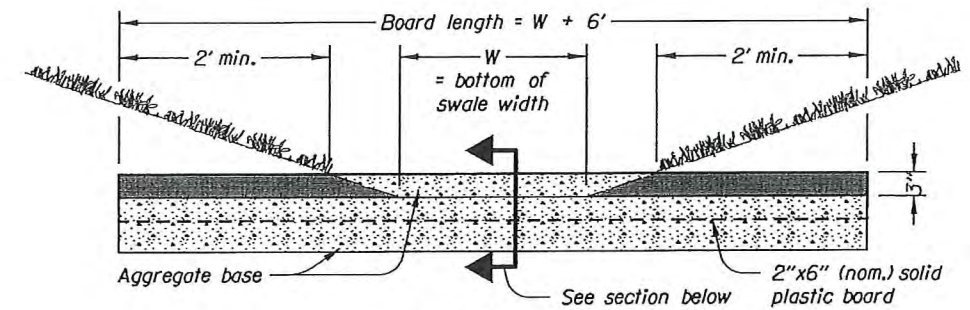

**ELEVATION**

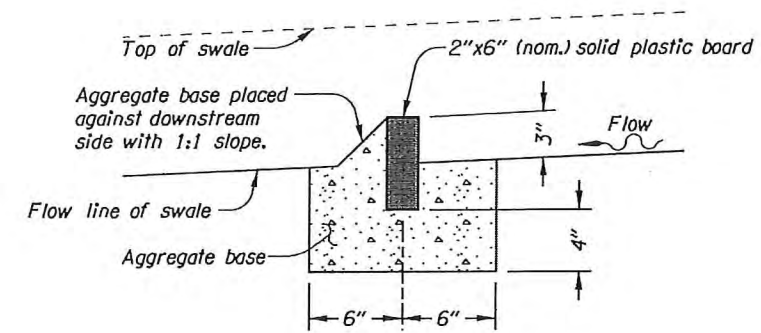

**SECTION**

**FLOW SPREADING CHECK DAM**

Space approx. every 50' or as directed.

**"NOT REVISED AS CONSTRUCTED"**  
*Ron Larson*  
**PROJECT MANAGER**  
**8/22/17**  
**DATE**

NOTES FOR ALL DETAILS:  
 1. Side-slopes are shown as vert. to horiz.

**OREGON DEPARTMENT OF TRANSPORTATION**

Region 5 Tech Center  
 3012 Island Ave  
 La Grande, OR 97850  
 (541) 963-3177


**US26 @ BROOKWOOD / HELVETIA  
 (SHUTE RD) PROJECT  
 SUNSET HIGHWAY  
 WASHINGTON COUNTY**

Design Team Leader - Thomas Glen Wallace  
 Designed By - Caroline L. Barnes  
 Drafted By - F. Jeremy Schad


**WATER QUALITY  
 FACILITY DETAILS**

SHEET  
 NO.  
**GJ-2**


**REGISTERED PROFESSIONAL  
 ENGINEER**  
 60,795  
*Caroline L. Barnes*  
 OREGON  
 05, 1999  
**CAROLINE L. BARNES**  
 RENEWS: 12-31-2013

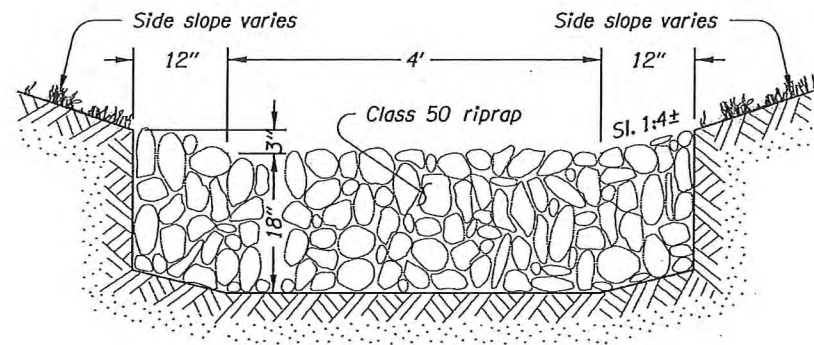

CHANNEL PROTECTION

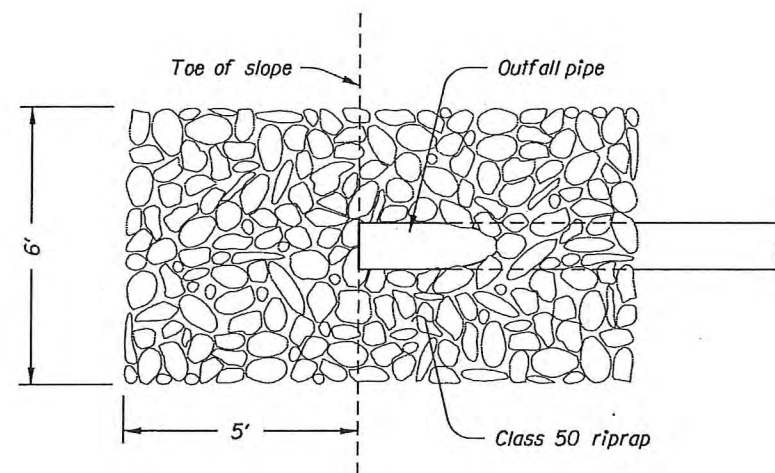

PLAN

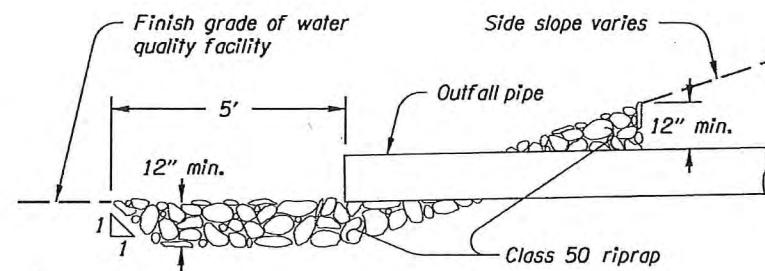


ELEVATION


**INLET ENERGY DISSIPATOR**

"NOT REVISED AS CONSTRUCTED"  
*Ken Larson*  
 PROJECT MANAGER  
 8/22/17  
 DATE


NOTES FOR ALL DETAILS:  
 1. Side-slopes are shown as vert. to horiz.

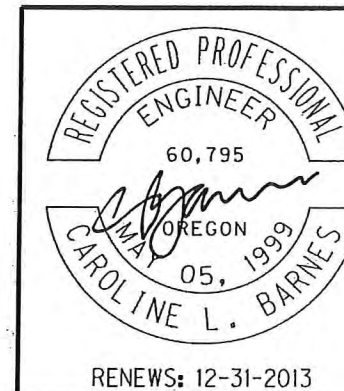

<b>OREGON DEPARTMENT OF TRANSPORTATION</b>	
Region 5 Tech Center 3012 Island Ave La Grande, OR 97850 (541) 963-3177	
<b>US26 @ BROOKWOOD / HELVETIA (SHUTE RD) PROJECT</b> SUNSET HIGHWAY WASHINGTON COUNTY	
Design Team Leader - Thomas Glen Wallace Designed By - Caroline L. Barnes Drafted By - F. Jeremy Schod	
<b>WATER QUALITY FACILITY DETAILS</b>	SHEET NO. <b>GJ-3</b>

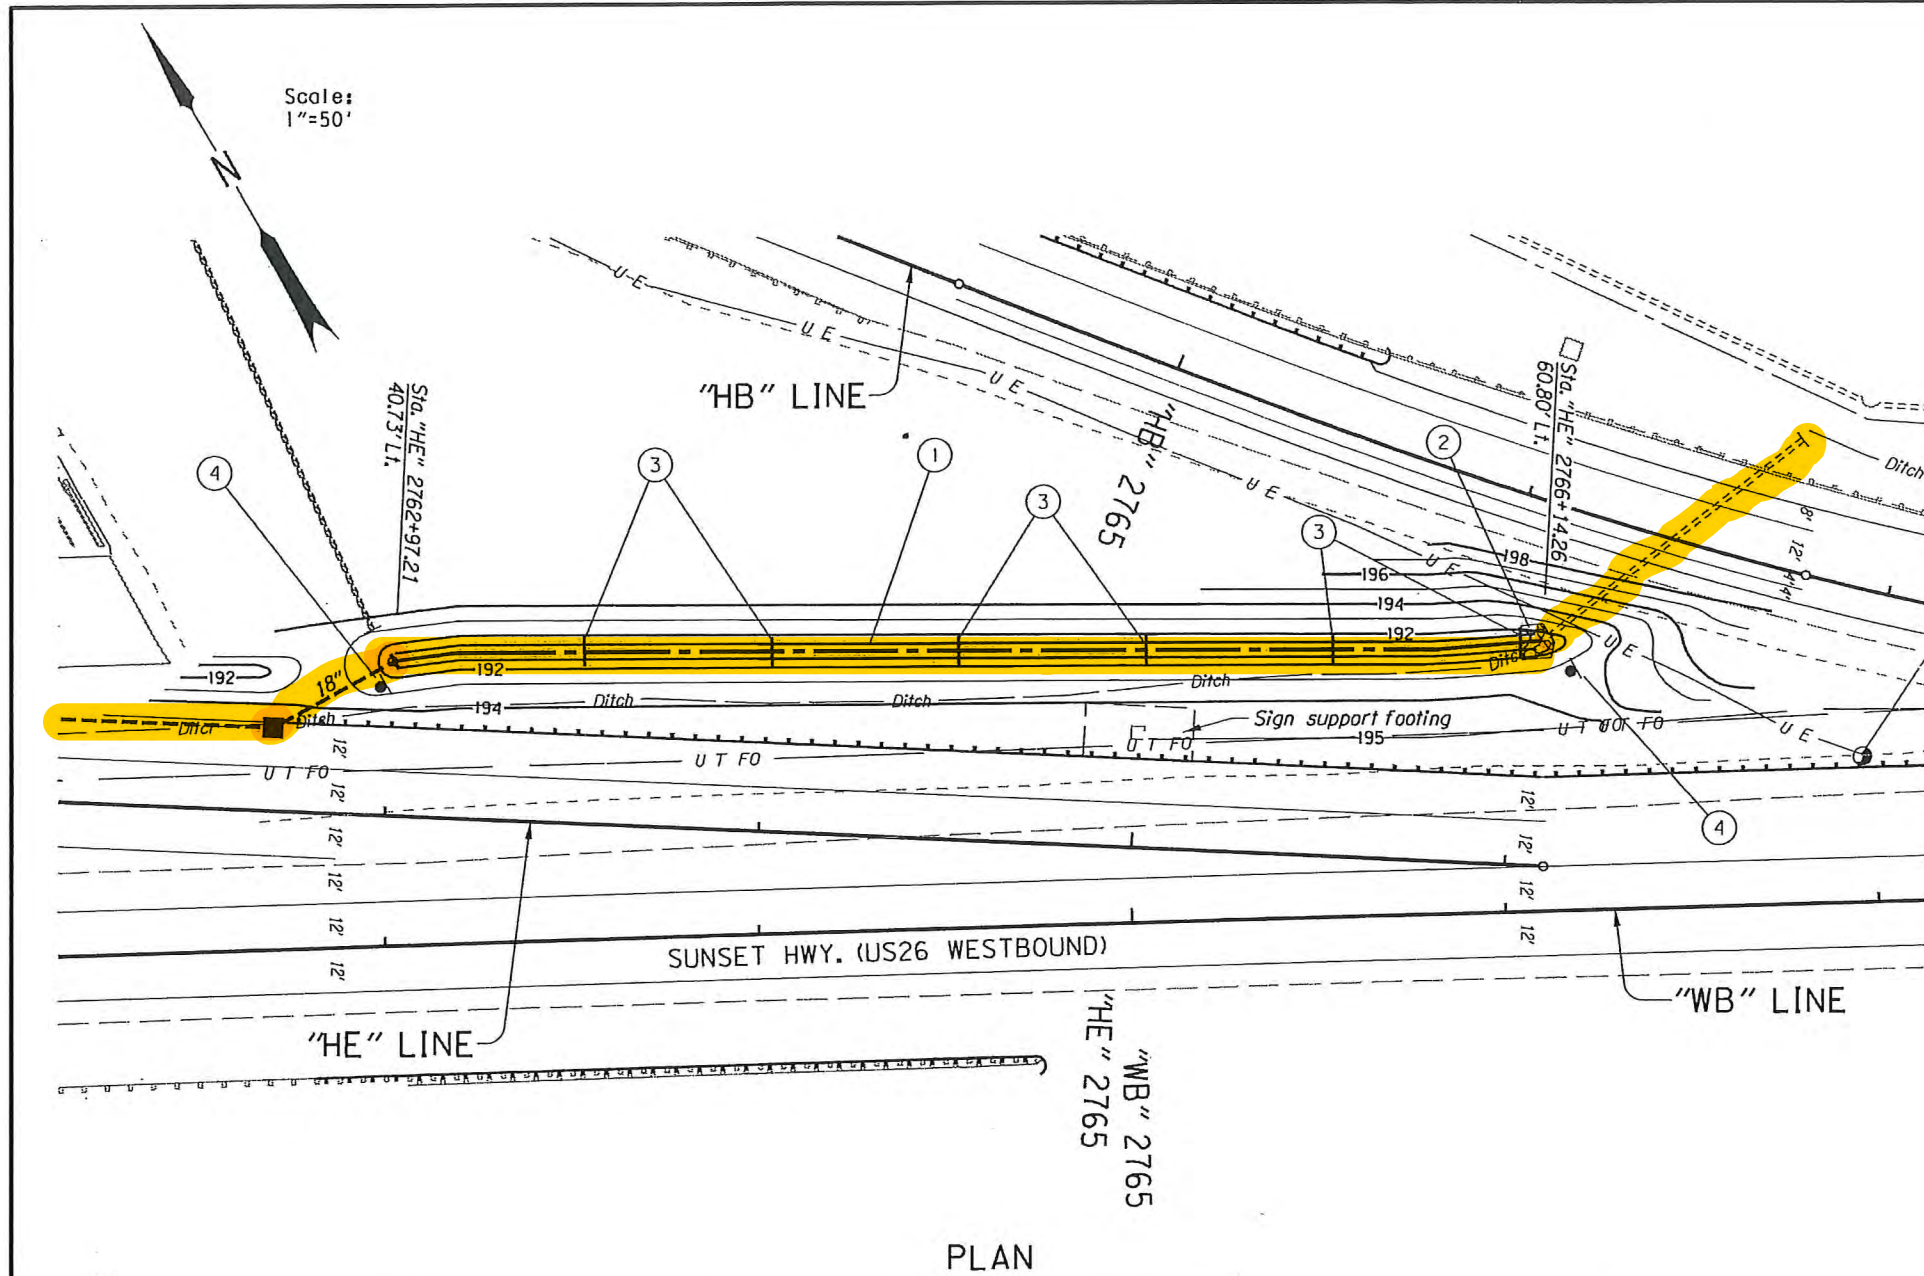

PLAN

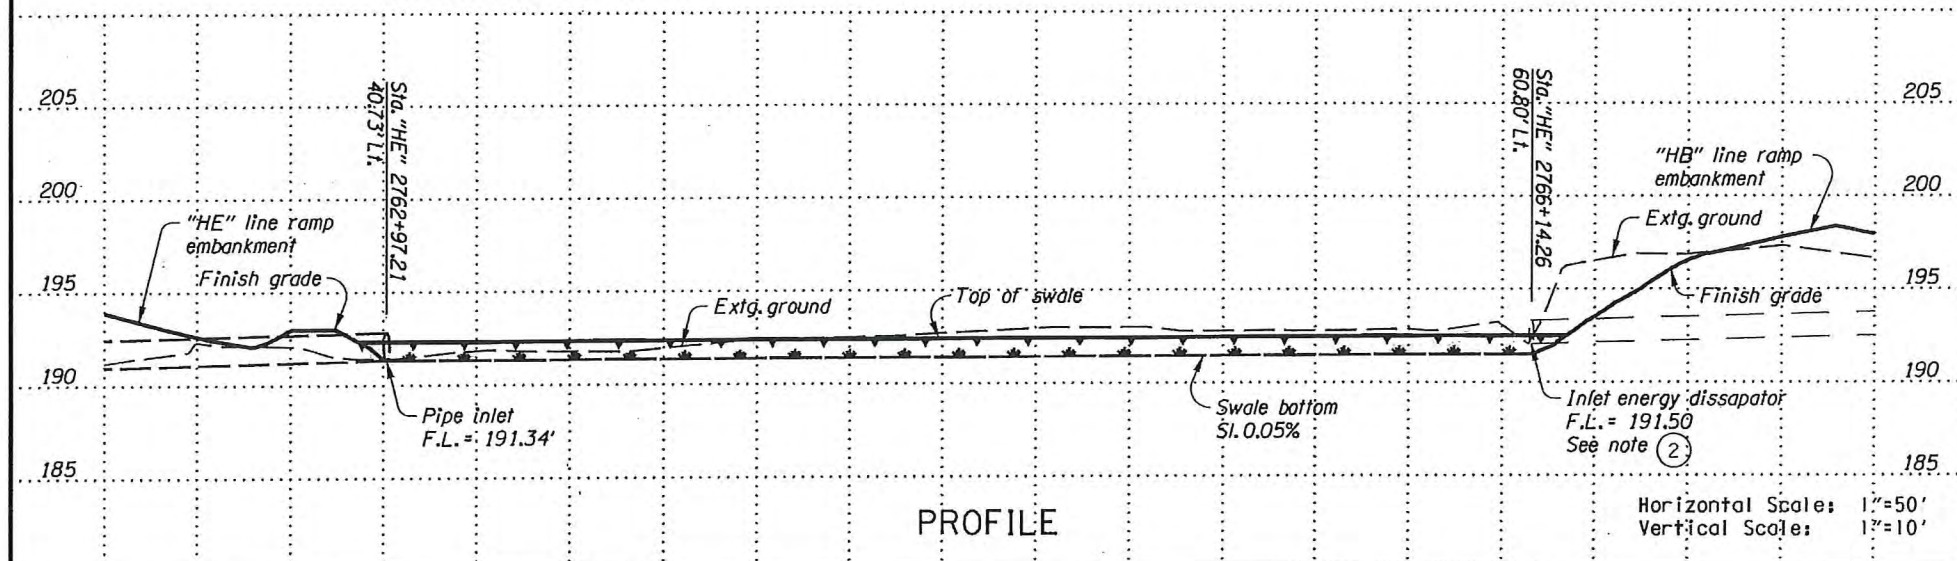

PROFILE

- ① Sta. "HE" 2762+97.21, 40.73' Lt. to Sta. "HE" 2766+14.26, 60.80' Lt. Const. 4' wide water quality swale (For details see sht. GJ-2)
- ② Const. inlet energy dissipator onto existing outfall (for details see sht. GJ-3)
- ③ Const. flow spreading check dam (For details see sht. GJ-2)
- ④ Install stormwater treatment field marker (See drg. no. RD399)

**"REVISED AS CONSTRUCTED"**  
*Don Larson*  
**PROJECT MANAGER**  
8/22/17  
**DATE**


Storm Facility No. D00771

**OREGON DEPARTMENT OF TRANSPORTATION**

Region 5 Tech Center  
 3012 Island Ave  
 La Grande, OR 97850  
 (541) 963-3177

**US26 @ BROOKWOOD / HELVETIA**  
**(SHUTE RD) PROJECT**  
 SUNSET HIGHWAY  
 WASHINGTON COUNTY

Design Team Leader - Thomas Glen Wallace  
 Designed By - Caroline L. Barnes  
 Drafted By - F. Jeremy Schod

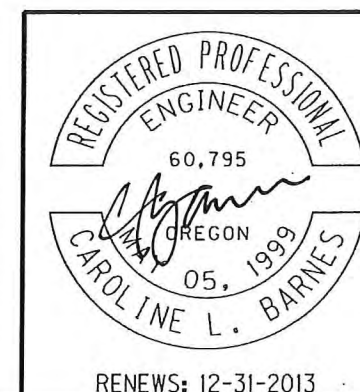

**WATER QUALITY FACILITY NO. 1**

SHEET NO.  
**GJ-4**