

OPERATION & MAINTENANCE MANUAL

Water Quality Extended Detention Dry Pond

Manual prepared: December 2018

DFI No. D00772



Figure 1: DFI No. D00772, looking

1. Identification

Drainage Facility ID (DFI): D00772
Facility Type: Water Quality Extended Detention Dry Pond
Construction Drawings: (V-File Numbers) 46V-060
Location: District: 2B
Highway No.: 047
Mile Post: 61.01-61.08 (Left Side)

2. Manual Purpose

The purpose of this manual is to outline inspection needs and summarize maintenance actions for stormwater ponds.

3. Facility Location

The location map below details the facility location. The highway, mile posts, side streets, access location, and stormwater flow directions are noted on the map.

Facility location type: Off ramp

Flow direction: West



Figure 2: Facility location map

4. Facility Summary

The pond size is based on storage volume, the bottom and top surface areas and the depth are used for this measurement.

The pond for this water quality facility is not uniformly shaped and the sides vary, as shown below.

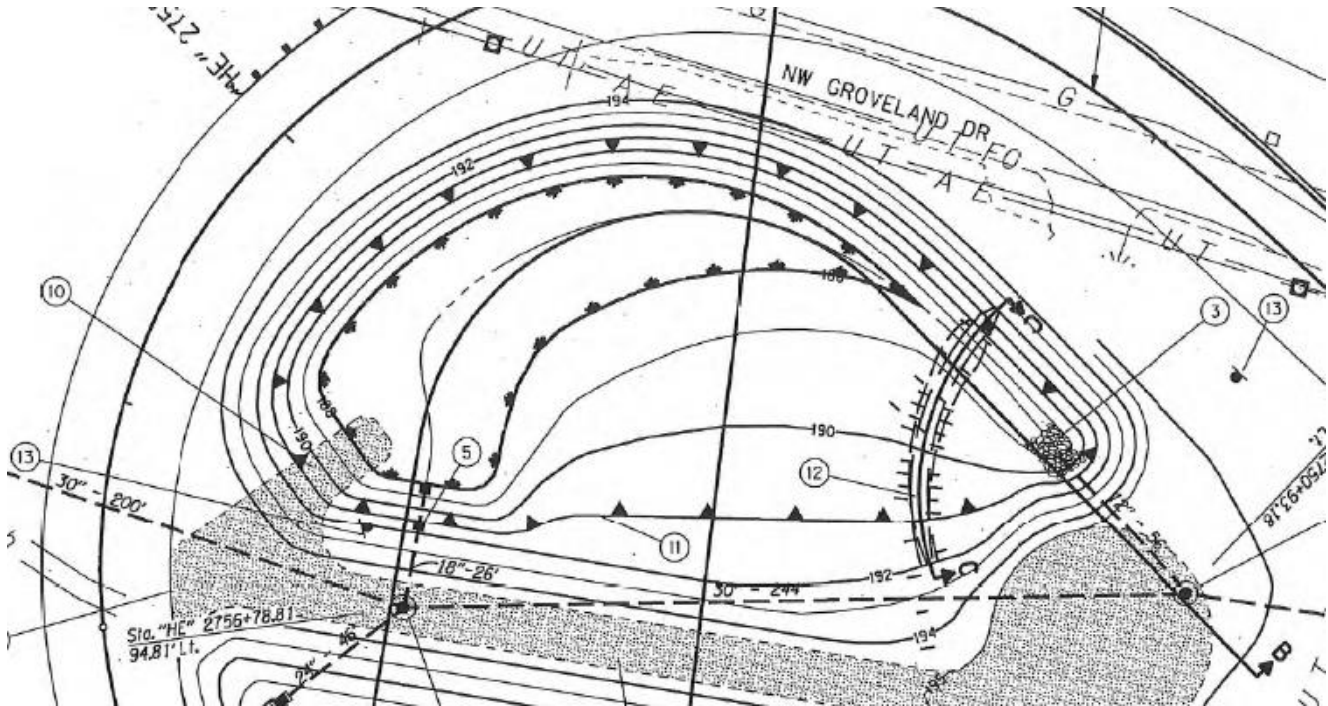



Figure 3: Site plan of detention pond

The depth of the pond is the vertical distance measured from the bottom of the pond to the top. The slope of the pond sides is presented by a vertical distance (rise) followed by the horizontal distance (run).

Depth and side slopes:

Depth (feet)	Side slope*	
	Rise (feet)	Run (feet)
1	1	3

*The side slope varies (shown below) between 1:3 or flatter

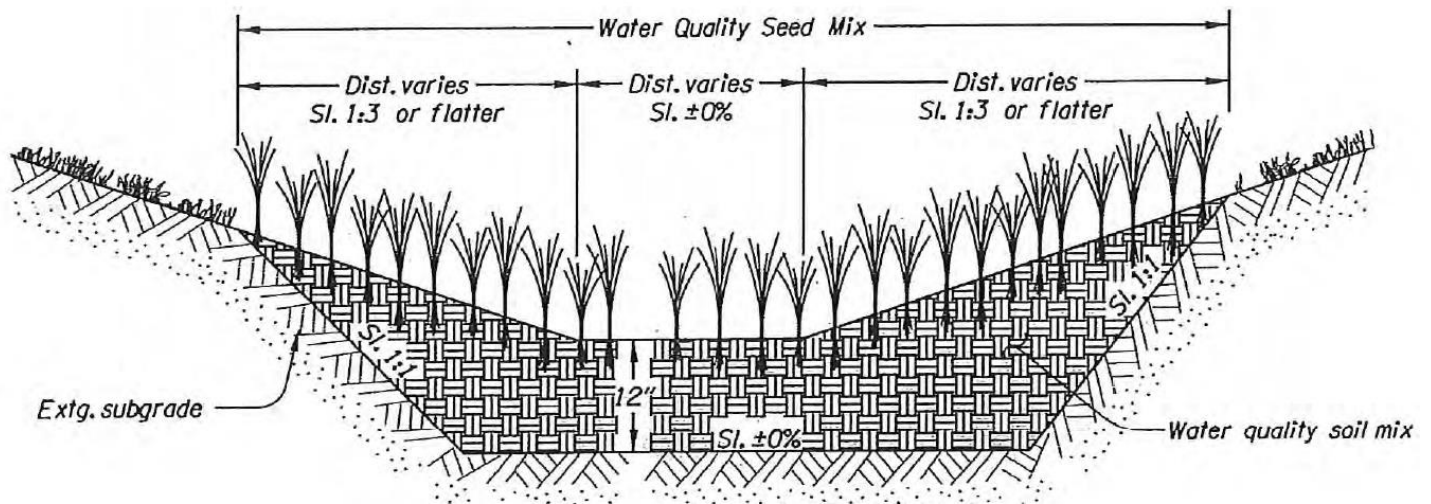

Site Specific Information: Stormwater enters this facility through a piped inlet with a flow splitter manhole. This manhole (Appendix A, page 2) allows low flows through the detention pond. There is a high flow bypass in the manhole that diverts the stormwater into a stormwater sewer system. The water exits the detention pond through an outlet control system (Appendix A, page 2) with 2 “D” type inlets. The water then flows through a storm sewer system. This sewer system exits into a nearby ditch.

5. Facility Access

Maintenance access to the facility:

<input type="checkbox"/> Roadside pad	<input type="checkbox"/> Roadside shoulder
<input checked="" type="checkbox"/> Access road with Gate	<input type="checkbox"/> Access road without Gate

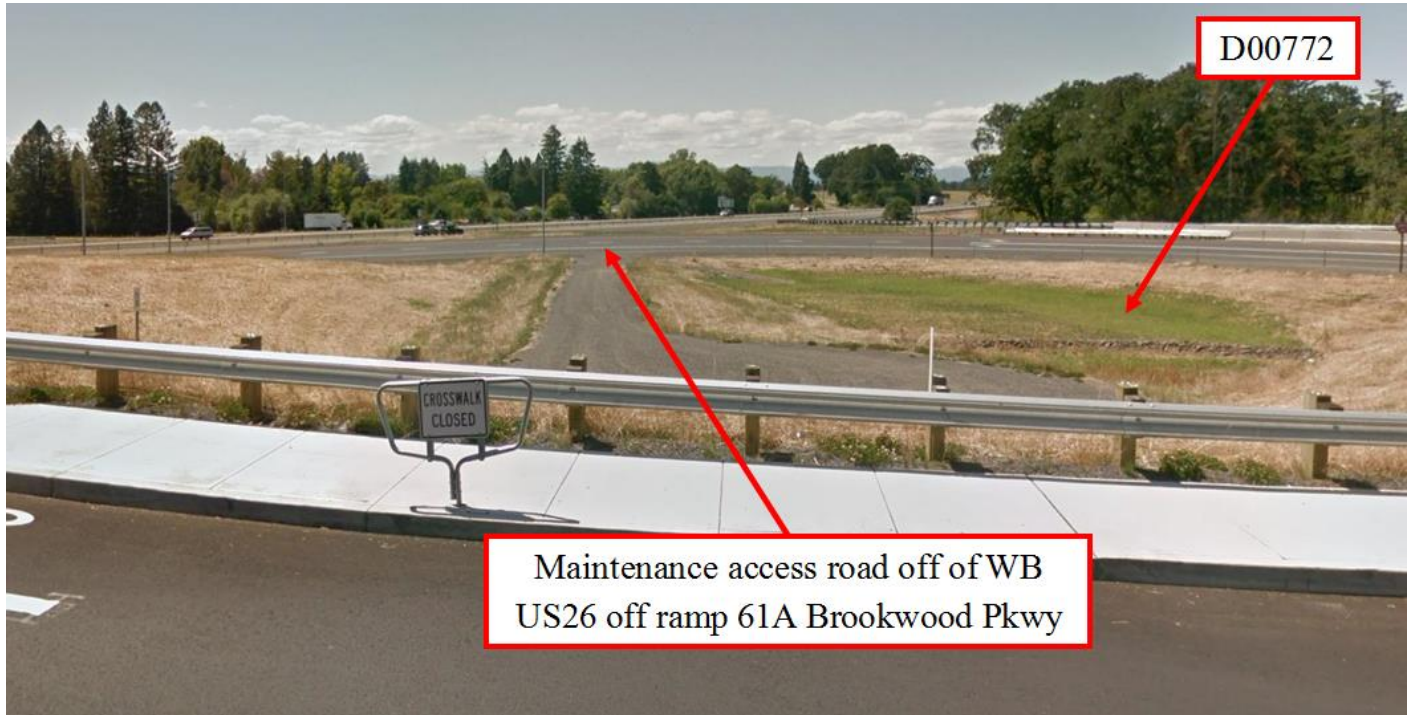


Figure 3: Maintenance Access

Operational Components / Maintenance Items

Classification and Standard Operational (Op) Plan:

This facility is classified as a:

<input type="checkbox"/> Detention Pond (Op Plan A)	<input type="checkbox"/> WQ Bioretention Pond (Op Plan B)	<input checked="" type="checkbox"/> WQ Extended Detention Dry Pond (Op Plan C)	<input type="checkbox"/> WQ Detention Pond/Biofiltration Swale Combo (Op Plan D)
--	--	---	---

A standard operational plan illustrates the general facility footprint configuration and explains the purpose of each facility component. Operational plans (A,B,C,D) are provided in the Standard Operation Manual.

See Appendix A for the site specific operational plan.

Key Features/Items:

This facility is classified as a:

<input checked="" type="checkbox"/> Dry Pond	<input type="checkbox"/> Wet Pond
The pond is wet during storm events and dries during periods of no precipitation.	The pond has constant presence of water year round. A portion of the pond dries during periods of no precipitation.

This facility includes a **high flow bypass component:**

<input type="checkbox"/> No	<input checked="" type="checkbox"/> Yes
There is no bypass component. High flows drains into and through the facility	There is a bypass component. Only low/small flows drain into the pond. High flows are diverted around the pond using a bypass component

This facility includes a **proprietary structure(s):**

<input checked="" type="checkbox"/> No	<input type="checkbox"/> Yes (DXXXXX)
There are no proprietary structures associated with this facility.	A proprietary structure is used in the operation of this facility. The proprietary structure is a/an: describe

Operational Components

The facility components table (**Table 1**) has been provided to highlight the applicable components for this facility. The component is in use when the box contains an “x” (e.g.).

The Standard Operation Manual for Ponds outlines facility operation, typical footprint configuration, and component definitions and details. A link to the manual is attached to the feature marker in TransGIS.

<https://gis.odot.state.or.us/TransGIS/>

Maintenance Items

Operational components marked in **Table 1** should be inspected and maintained according to Section 7. Each facility component is defined and detailed in the Standard Operation Manual using the associated ID number indicated in the table below.

Table 1: Stormwater Pond Components		ID #
Upstream Manholes/Structures		
Pre-treatment Manhole Type: describe	<input type="checkbox"/>	P1
Water Quality Manhole Type: describe	<input type="checkbox"/>	P2
Flow Splitter Manhole (Weir/Orifice)	<input checked="" type="checkbox"/>	P3
Standard Manhole	<input type="checkbox"/>	P4
Sediment Basin/Forebay	<input type="checkbox"/>	P5
Forebay Dewatering Riser Pipe (outlet)	<input type="checkbox"/>	P6
Facility Inlet		
Pavement Sheet Flow	<input type="checkbox"/>	P7
Inlet Pipe(s)	<input checked="" type="checkbox"/>	P8
Open Channel Inlet	<input type="checkbox"/>	P9
Riprap Pad (Energy Dissipater)	<input checked="" type="checkbox"/>	P10
Ground Cover		
Grass Bottom	<input checked="" type="checkbox"/>	P11
Grass Side Slopes	<input checked="" type="checkbox"/>	P12
Granular Drain Rock	<input type="checkbox"/>	P13
Plantings	<input type="checkbox"/>	P14
Underground Components		
Geotextile Fabric: Specify Type	<input type="checkbox"/>	P15
Impermeable Liner	<input type="checkbox"/>	P16
Water Quality Mix	<input checked="" type="checkbox"/>	P17
Perforated Pipe	<input type="checkbox"/>	P18
Bottom Marker (ex. Porous Pavers)	<input type="checkbox"/>	P19

Flow Spreader		
Anchored Board (midpoint of pond or every 50 feet along pond bottom)	<input type="checkbox"/>	P20
Other: describe	<input type="checkbox"/>	P21
Facility Outlet		
Catch Basin with Grate	<input type="checkbox"/>	P22
Outlet Pipe(s)	<input type="checkbox"/>	P23
Outlet/Flow Control Structure	<input checked="" type="checkbox"/>	P24
Auxiliary Outlet	<input type="checkbox"/>	P25
Hazmat Control Valve: Specify make/model	<input type="checkbox"/>	P26
Outfall Type		
Waterbody (Creek/Lake/Ocean)	<input type="checkbox"/> C	P27
	<input type="checkbox"/> L	
	<input type="checkbox"/> O	
Ditch	<input checked="" type="checkbox"/>	P28
Storm Drain System	<input type="checkbox"/>	P29
Outfall Components		
Riprap Pad	<input type="checkbox"/>	P30
Riprap Bank Protection	<input type="checkbox"/>	P31

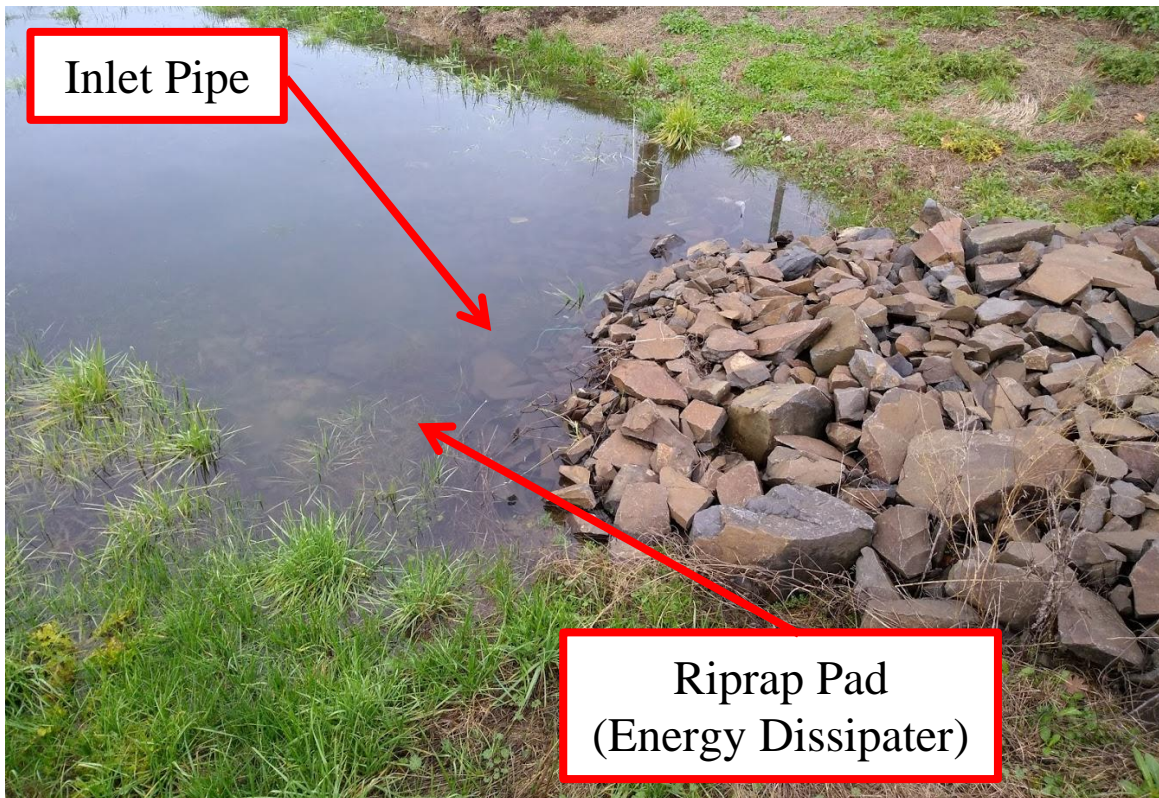


Figure 4: Piped Inlet and Energy Dissipater



Figure 5: Components of detention pond

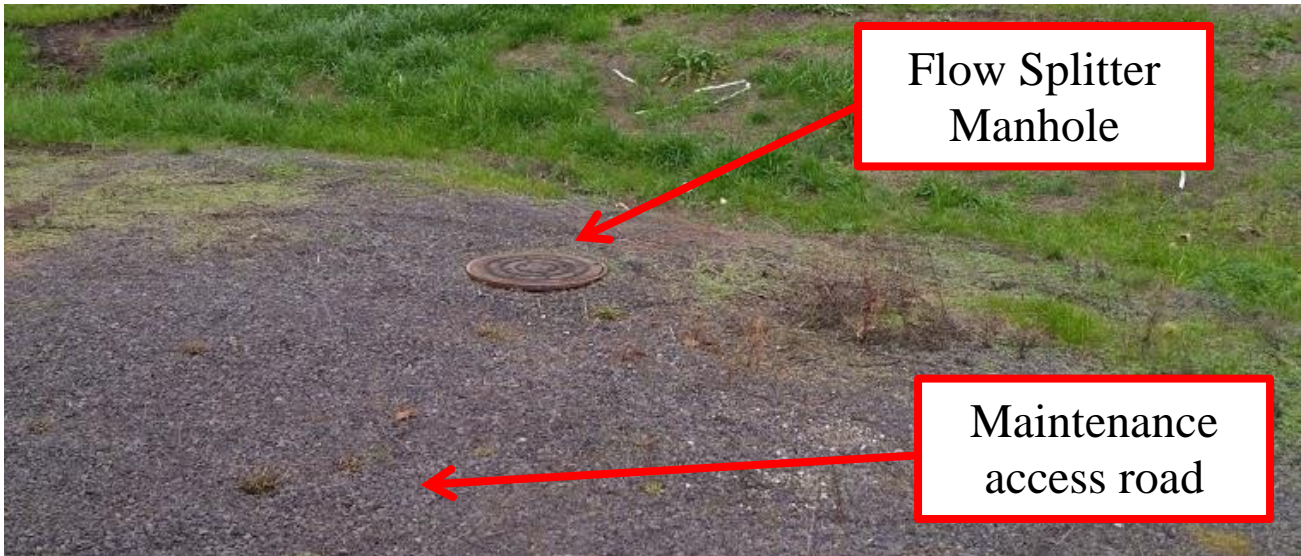


Figure 6: Flow Splitter Manhole on Maintenance Access Road

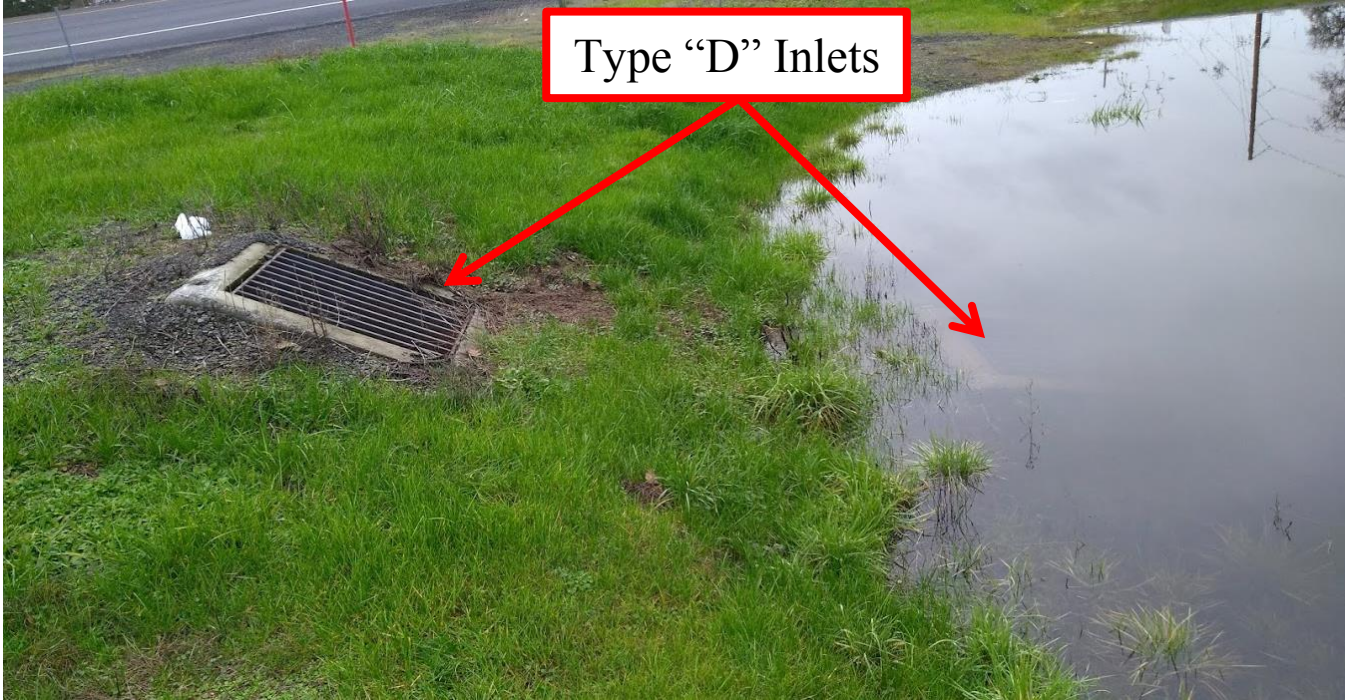


Figure 7: Outlet Control System

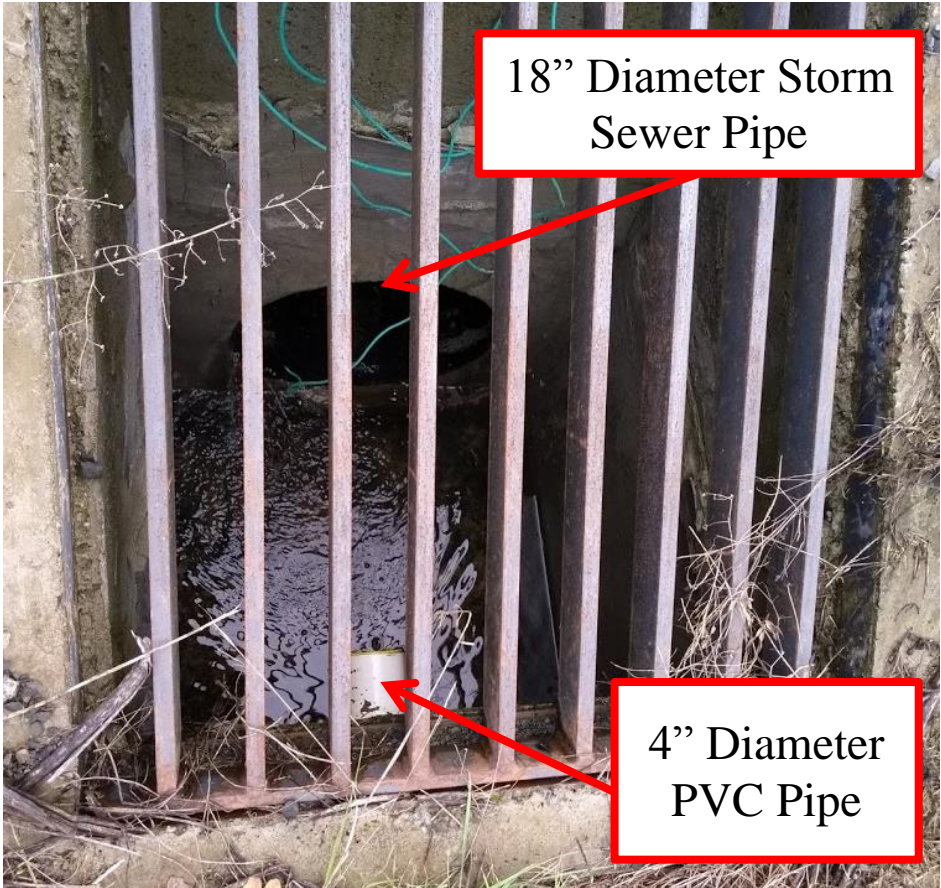


Figure 8: Inside Type "D" Inlet

6. Maintenance

Maintenance Frequency/Maintain Records

- a. Inspect annually. Preferably prior to the rainy season.
- b. Clean and maintain as necessary. Refer to Activity 125 in the Maintenance Guide for conditions when maintenance is needed.
- c. Keep a record of inspections, maintenance, and repairs.

Maintenance Guide/Maintenance Actions

The Maintenance Guide outlines the standard maintenance actions for water quality facilities under Activity 125.

There are standard maintenance tables for standard ODOT designs. The maintenance tables describe the maintenance component, the defect or problem, the condition when maintenance is needed, and the recommended maintenance to correct the problem. Use the following tables to maintain ODOT Ponds:

- Table 1 (General Maintenance): Contains general maintenance and inspection guidelines that are applicable to all ODOT water quality facilities
- Table 2 (Maintenance of Stormwater Ponds): Contains maintenance information for ponds

The ODOT Maintenance Guide can be viewed at the following website:
<http://www.oregon.gov/ODOT/HWY/OOM/pages/mguide.aspx>

The Blue Book can be viewed at the following website:
http://www.oregon.gov/ODOT/Maintenance/Documents/blue_book.pdf

7. Limitations

There are access limitations for this facility:

<input type="checkbox"/> No	<input checked="" type="checkbox"/> Yes
There are no duty porous pavers installed in this pond.	

Ponds are designed to allow equipment access along the bottom if an access grid is installed. If an access grid is NOT installed, vehicles entering the pond can create depressions (tire ruts), damage vegetation, or damage structural components (e.g. flow spreaders). These conditions may result in poor treatment and drainage performance.

If no access grid then: Equipment wheels should be kept on the tops and side slopes. Mower arms may be run along the pond bottom.

8. Waste Material Handling

Material removed from the facility is defined as waste by the Department of Environmental Quality (DEQ). Refer to the road waste section of the ODOT Maintenance Yard Environmental Management System (EMS) Policy and Procedures Manual for disposal options:

<http://www.oregon.gov/ODOT/HWY/OOM/pages/ems.aspx>


Contact any of the following for more detailed information about management of waste materials found on site:

ODOT Clean Water Unit	(503) 986-3008
ODOT Statewide Hazmat Coordinator	(503) 667-7442
ODOT Region 1 Hazmat Coordinator	(503) 731-8290
ODOT Region 2 Hazmat Coordinator	(503) 986-2647
ODOT Region 3 Hazmat Coordinator	(541) 957-3594
ODOT Region 4 Hazmat Coordinator	(541) 388-6186
ODOT Region 5 Hazmat Coordinator	(541) 963-1590
ODEQ Northwest Region Office	(503) 229-5263

A Appendix A – Site Specific Operational Plan

Contents:

Operational Plan: DFI D00772

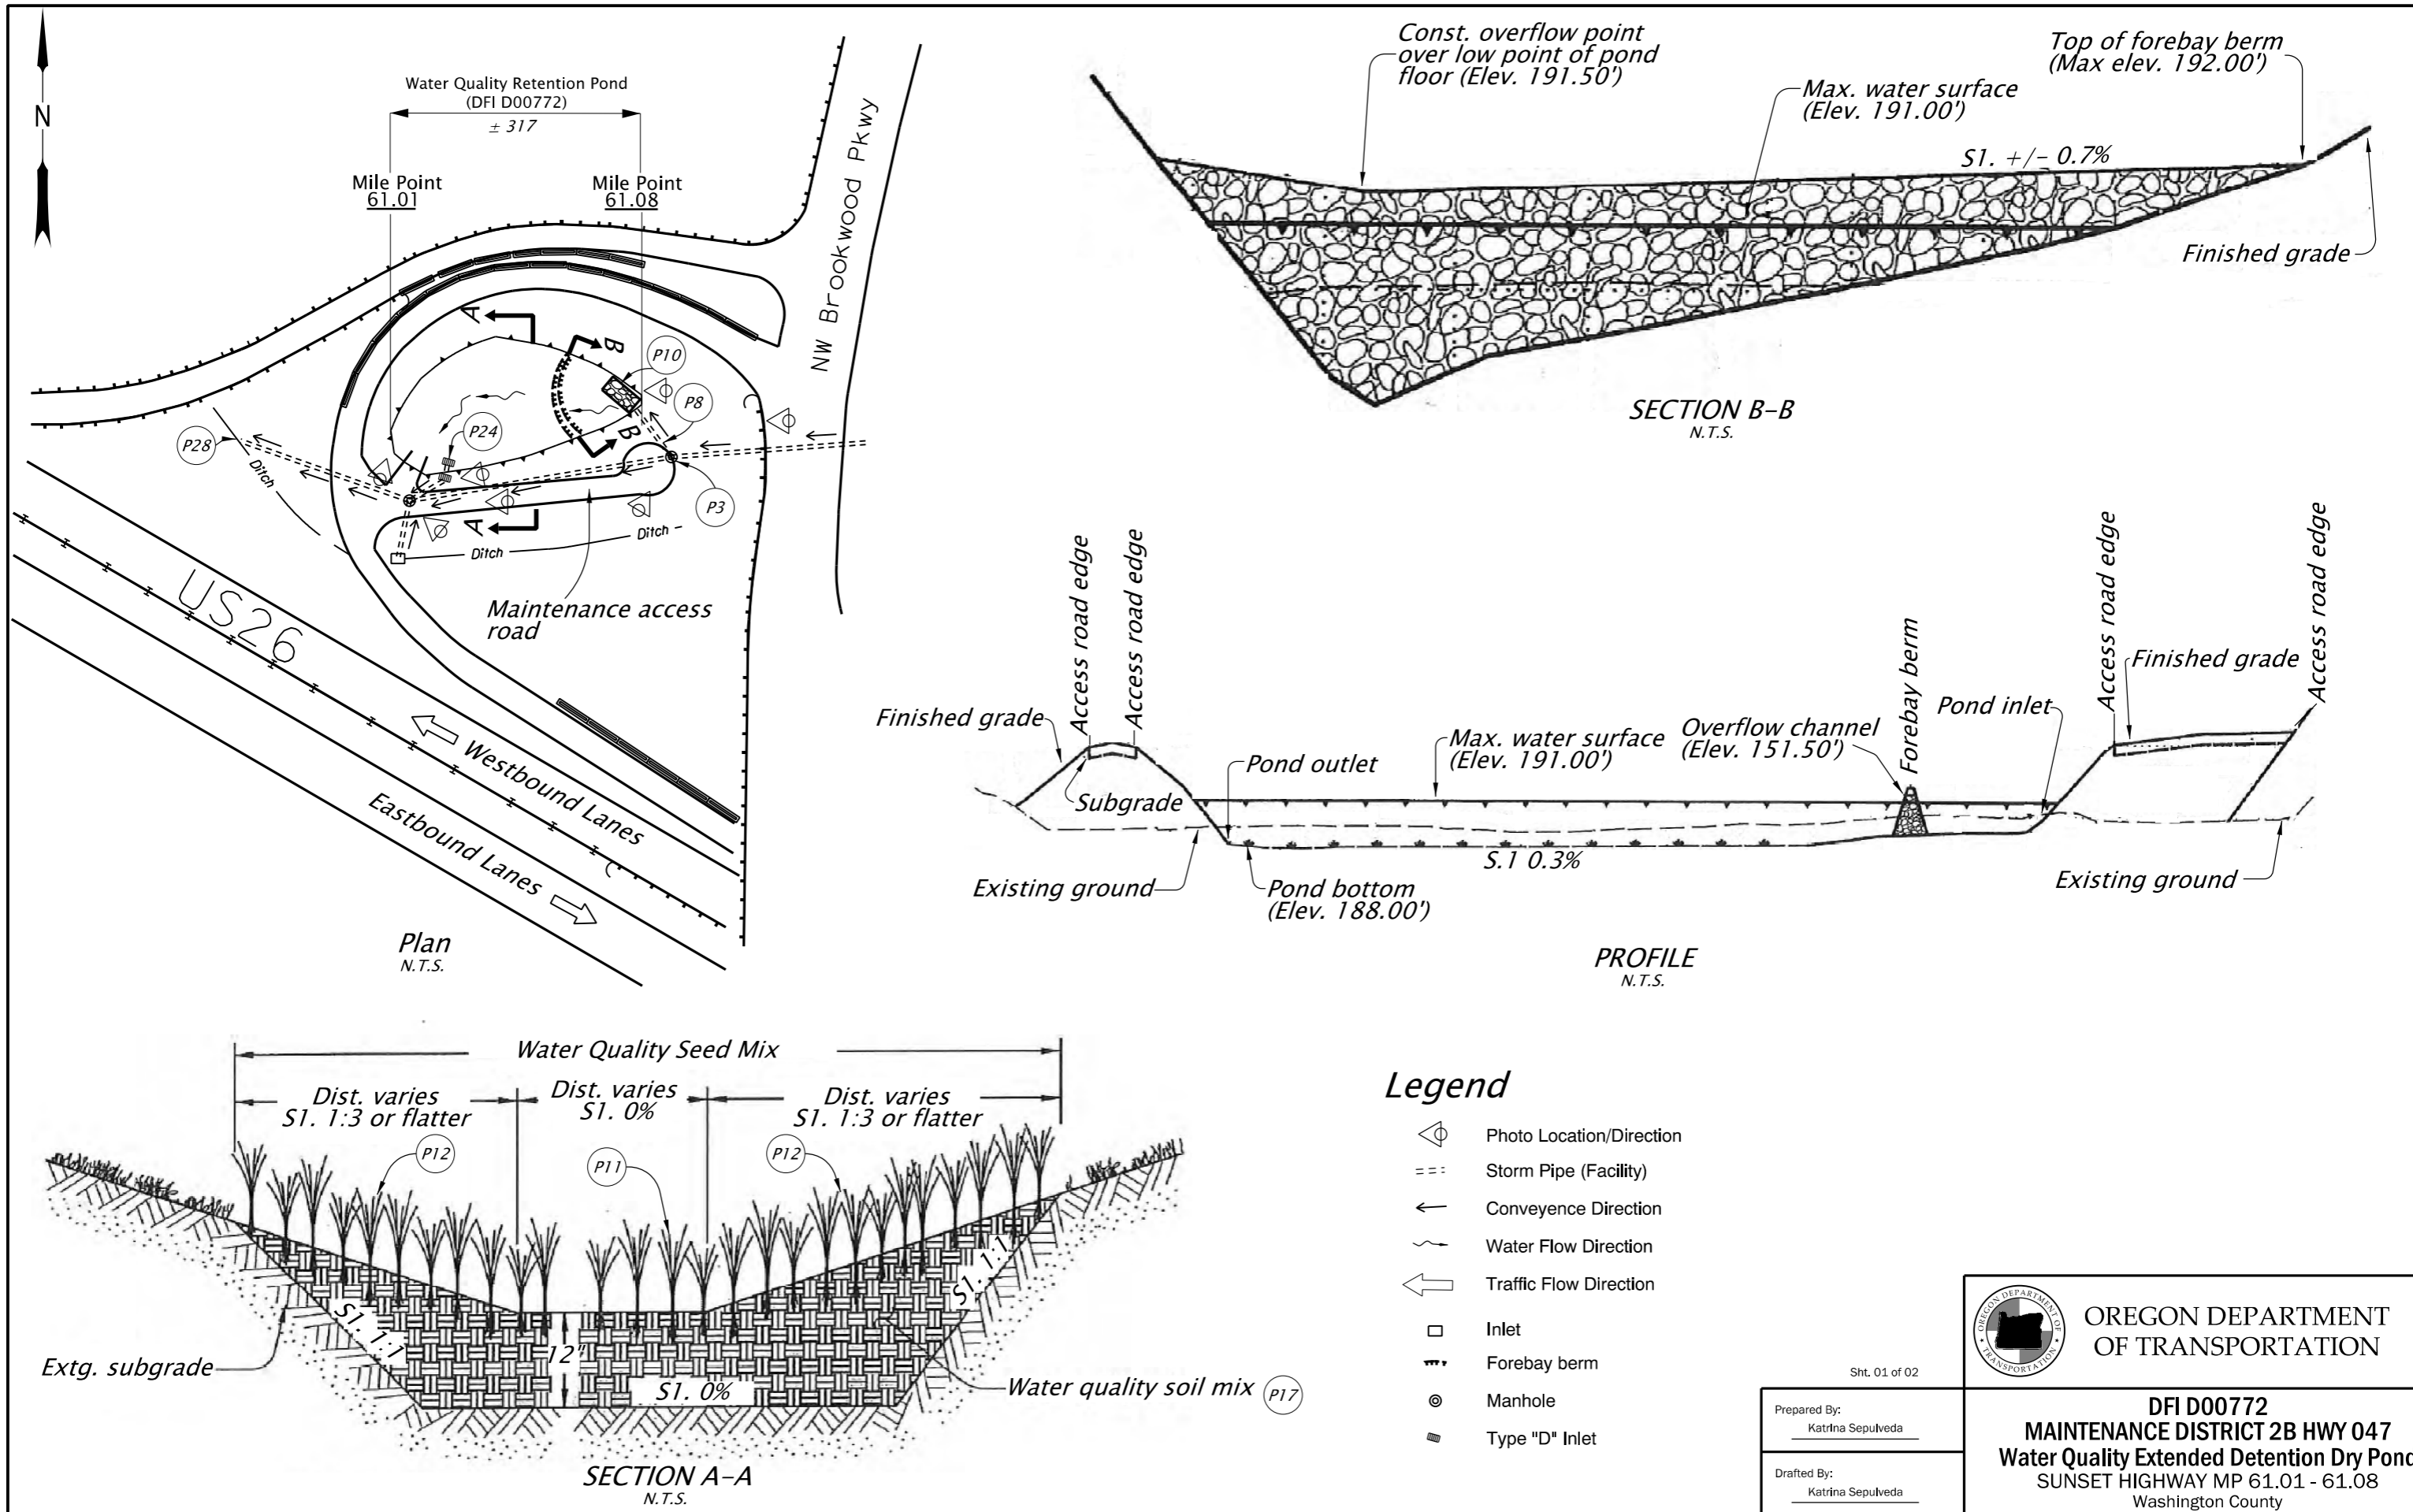

Legend

- Photo Location/Direction
- Storm Pipe (Facility)
- Conveyence Direction
- Water Flow Direction
- Traffic Flow Direction
- Inlet
- Forebay berm
- Manhole
- Type "D" Inlet


Sht. 01 of 02

Prepared By:
Katrina Sepulveda

Drafted By:
Katrina Sepulveda

OREGON DEPARTMENT OF TRANSPORTATION

DFI D00772
MAINTENANCE DISTRICT 2B HWY 047
Water Quality Extended Detention Dry Pond
SUNSET HIGHWAY MP 61.01 - 61.08
Washington County

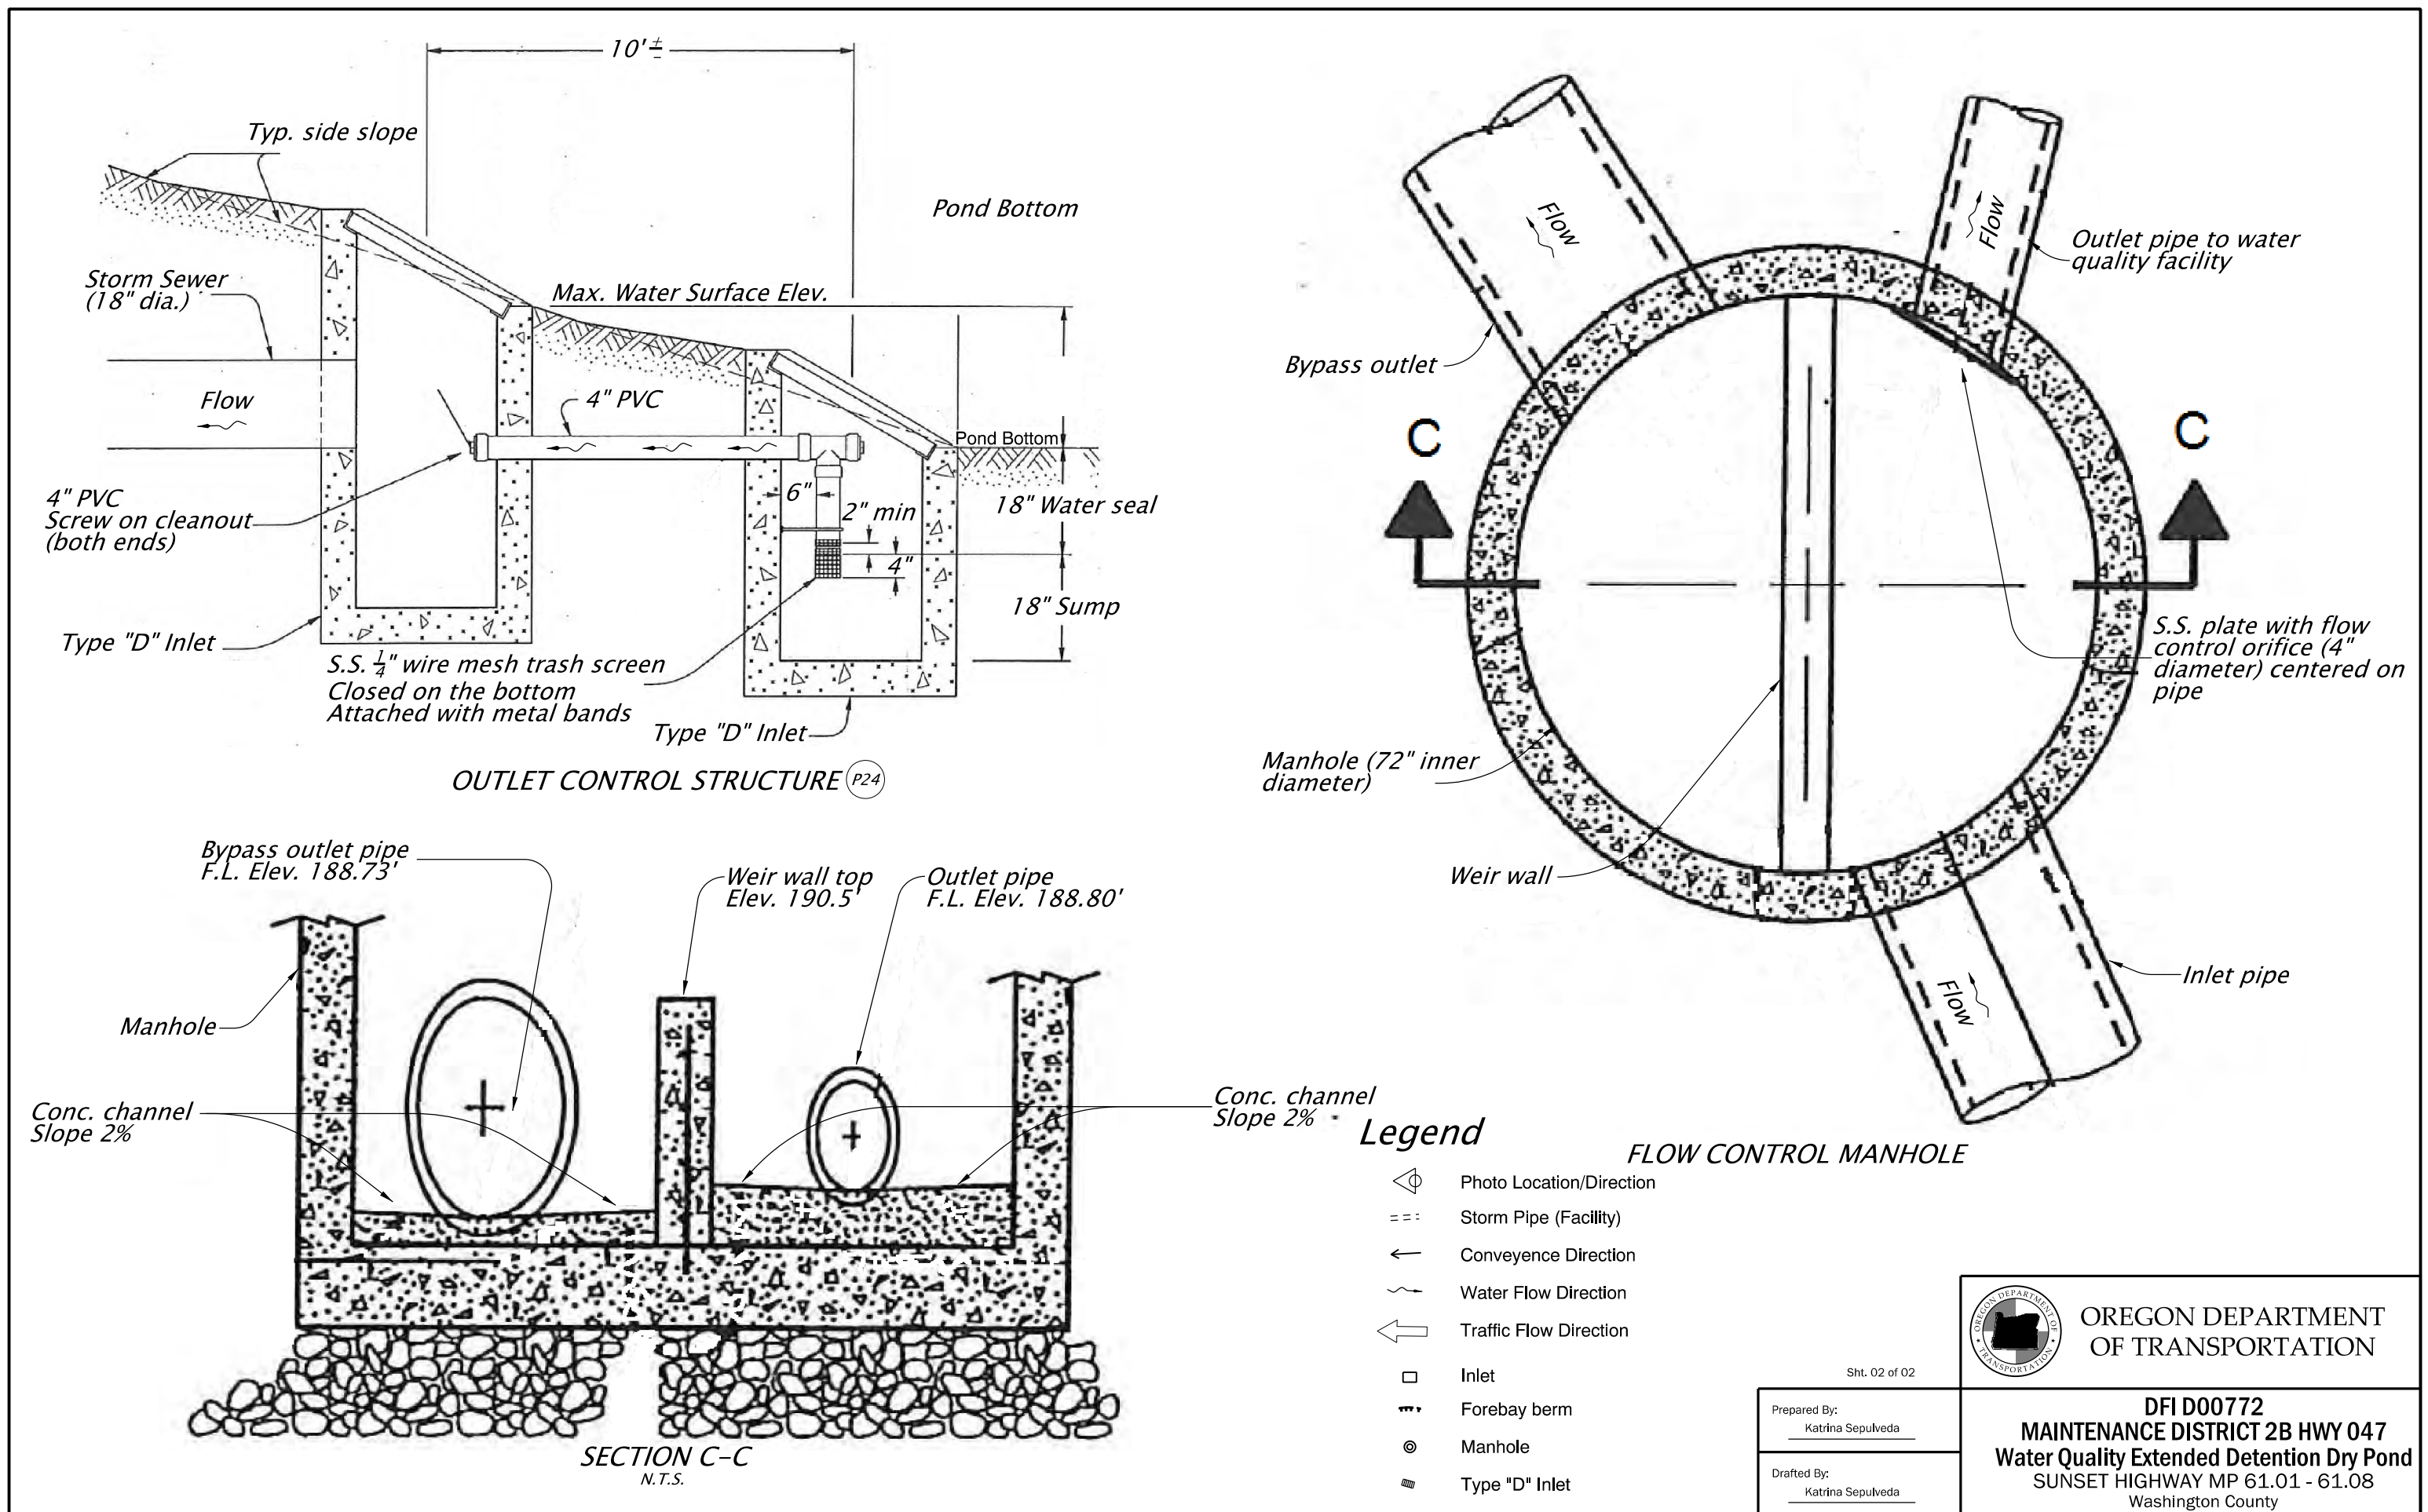

Sht. 02 of 02

Prepared By:
 Katrina Sepulveda

Drafted By:
 Katrina Sepulveda

OREGON DEPARTMENT OF TRANSPORTATION

DFI D00772
 MAINTENANCE DISTRICT 2B HWY 047
 Water Quality Extended Detention Dry Pond
 SUNSET HIGHWAY MP 61.01 - 61.08
 Washington County

B Appendix B – Project Contract Plans

Contents:

Site Specific Subset of Project Contract Plan 46V-060

Partial Plan Set

14607

Contract Plans

46V-060

INDEX OF SHEETS	
SHEET NO.	DESCRIPTION
1	Title Sheet
1A	Index of Sheets Cont'd.
1A-2	Std. Drg. Nos.
1B	Sheet Layout


STATE OF OREGON DEPARTMENT OF TRANSPORTATION

PLANS FOR PROPOSED PROJECT

**GRADING, DRAINAGE, STRUCTURES, PAVING,
SIGNING, ILLUMINATION AND SIGNALS**


US26 @ BROOKWOOD / HELVETIA (SHUTE RD) PROJECT

**SUNSET HIGHWAY
WASHINGTON COUNTY
JULY 2013**

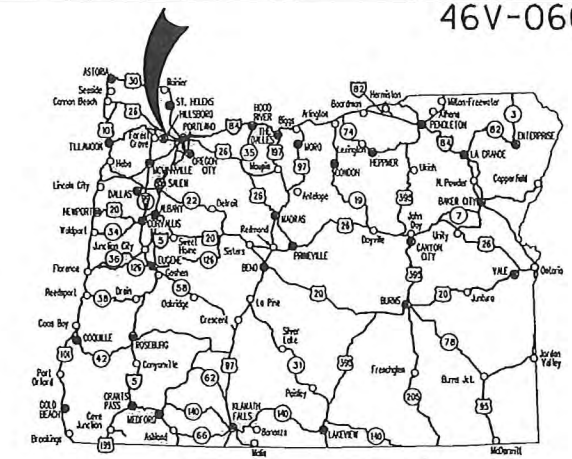

Overall length of project: 1.1 miles

ATTENTION:
Oregon Law Requires You To Follow Rules Adopted By The Oregon Utility Notification Center. Those Rules Are Set Forth In OAR 952-001-0010 Through OAR 952-001-0090. You May Obtain Copies Of The Rules By Calling The Center. (Note: The Telephone Number For The Oregon Utility Center Is (503) 232-1987.)

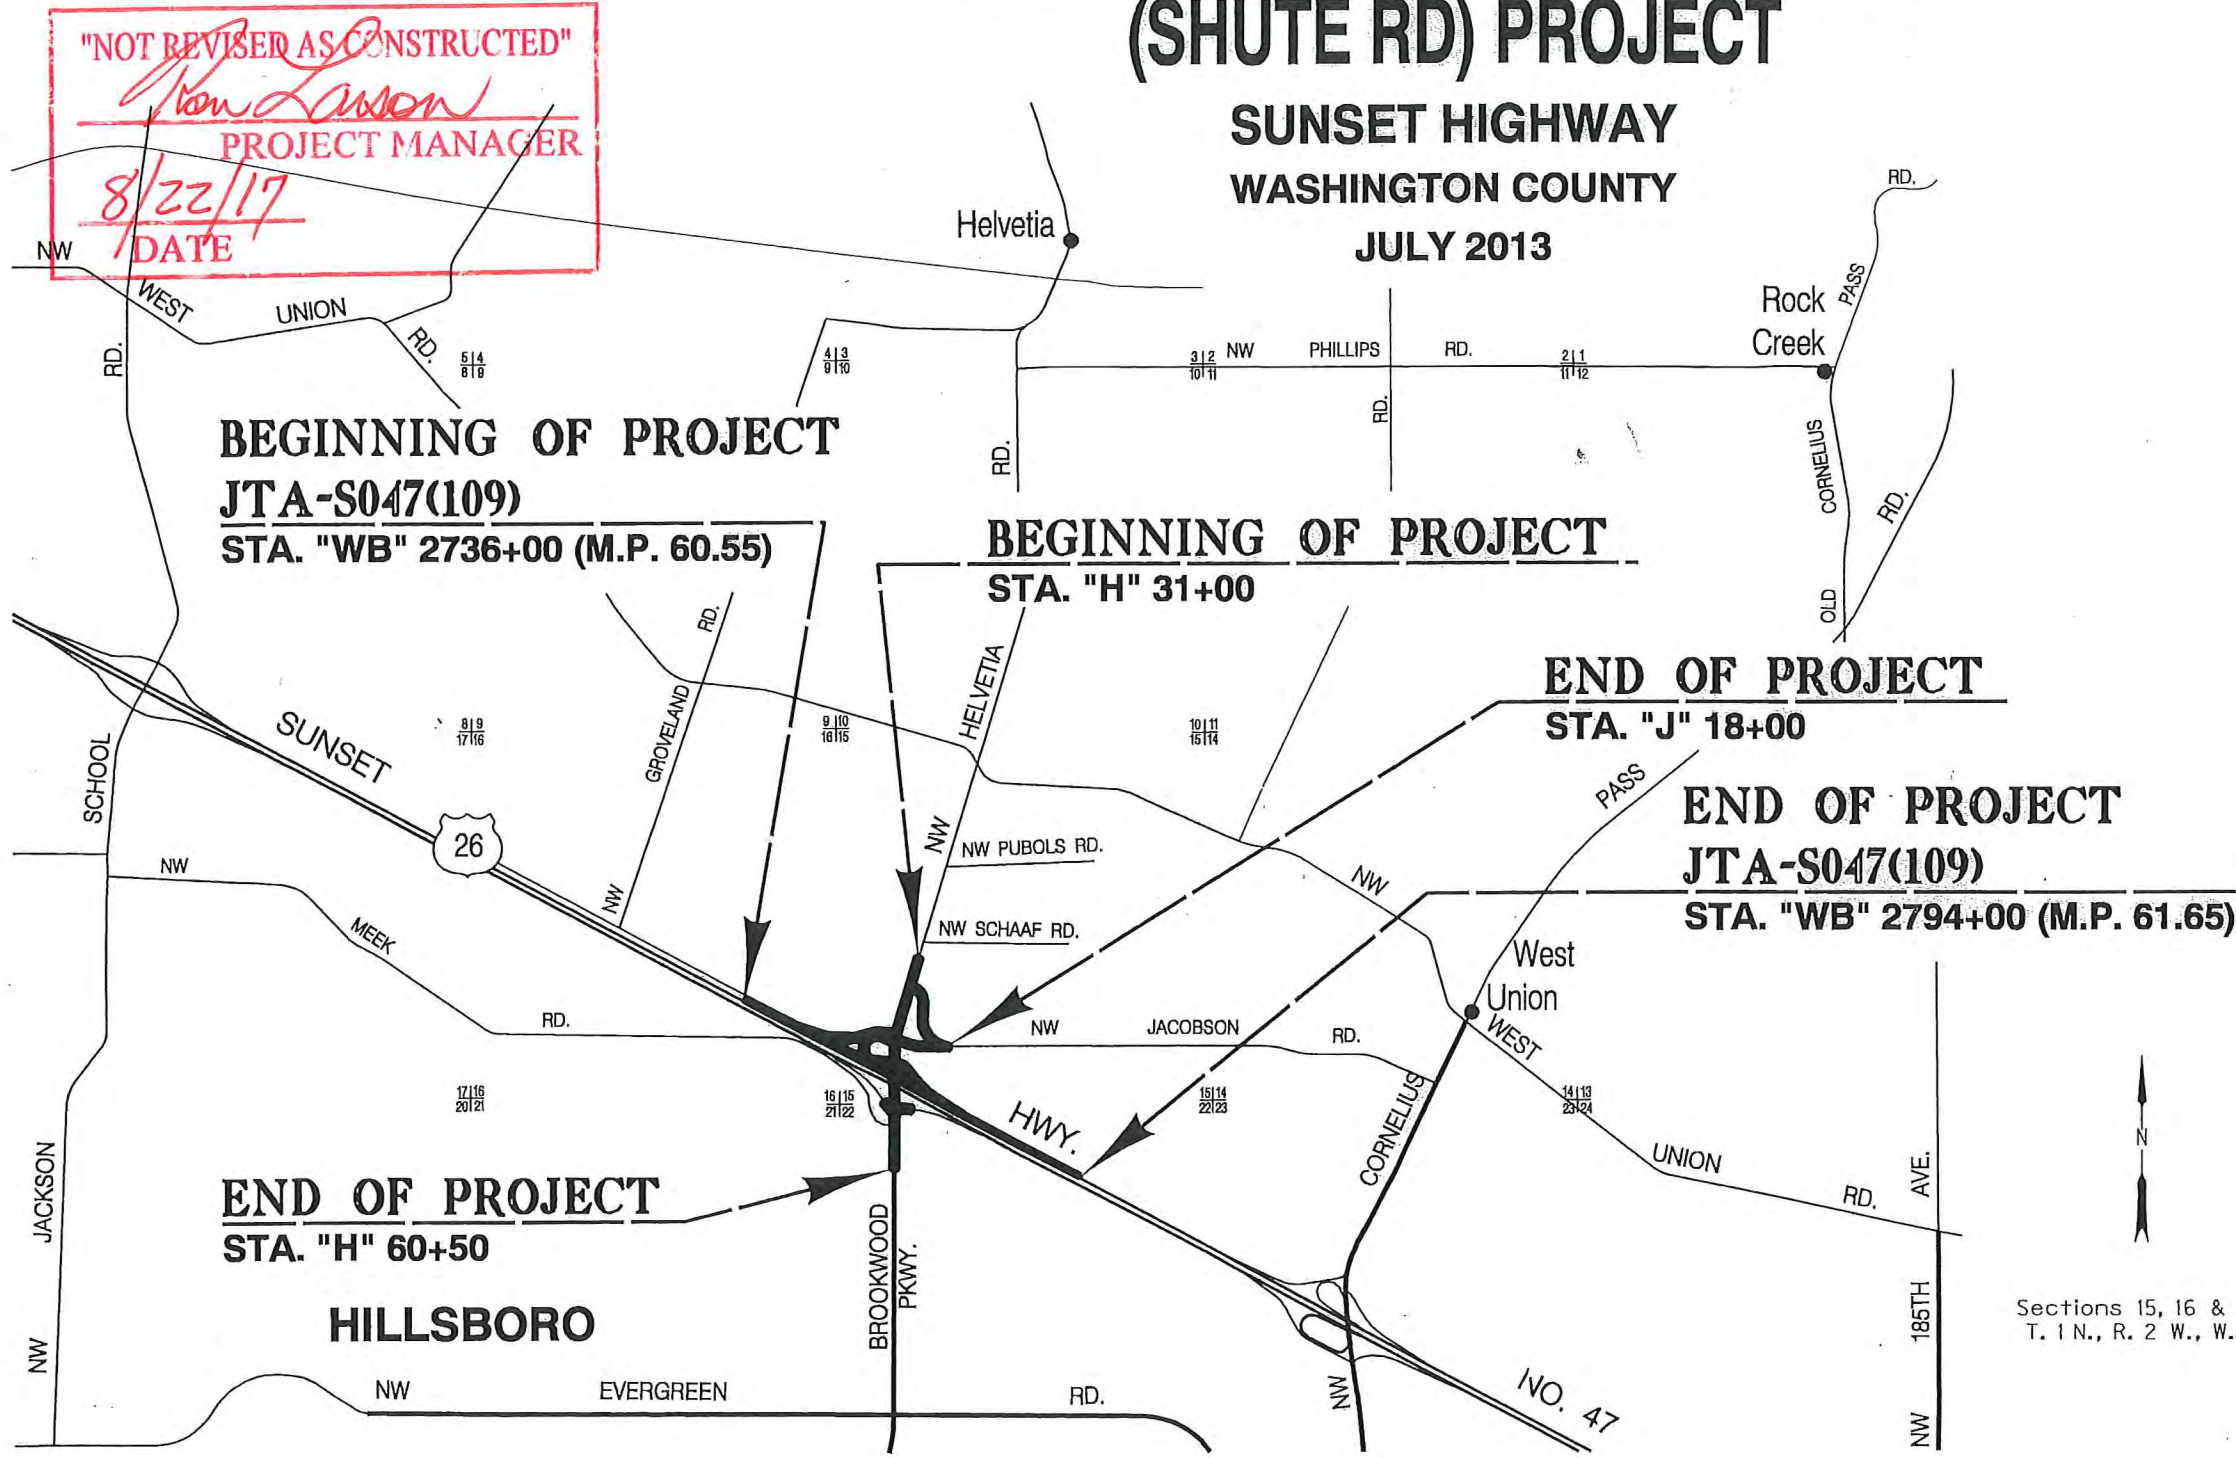

OREGON TRANSPORTATION COMMISSION
 Pat Egan CHAIR
 David Lohman COMMISSIONER
 Mary F. Olson COMMISSIONER
 Mark Frohnmayer COMMISSIONER
 Tommy Boney COMMISSIONER
 Matthew L. Garrett DIRECTOR OF TRANSPORTATION

These plans were developed using ODOT design standards. Exceptions to these standards, if any, have been submitted and approved by the ODOT Chief Engineer or their delegated authority.

Approving Authority: *Naveen G. Chandra*
 Naveen G. Chandra, Reg. 1 Project Delivery Mgr.
 6/11/13

[Signature]
 Concurrence by ODOT Chief Engineer

**US26 @ BROOKWOOD / HELVETIA
(SHUTE RD) PROJECT**
 SUNSET HIGHWAY
 WASHINGTON COUNTY

FEDERAL HIGHWAY ADMINISTRATION	PROJECT NUMBER	SHEET NO.
OREGON DIVISION	STATE	1

Sections 15, 16 & 22
T. 1 N., R. 2 W., W.M.



PE001829

INDEX OF SHEETS, CONT'D.	
SHEET NO.	DESCRIPTION
ROADWAY	
2A Thru 2A-14 Incl.	Typical Sections
2B Thru 2B-7 Incl.	Details
2C Thru 2C-57 Incl.	Traffic Control Plans
2D & 2D-2	Pipe Data Sheet
3	General Construction
4	General Construction
5	Alignment & R/W
5A	General Construction
5B	Drainage & Utilities
5B-2	Drainage & Utilities Notes
5C	Profile
6	Alignment & R/W
6A	General Construction
6A-2	Construction Notes
6B	Drainage & Utilities
6B-2	Drainage & Utilities Notes
6C	Profile
7	General Construction
8	Alignment & R/W
8A	General Construction
8A-2	Construction Notes
9	Alignment & R/W
9A	General Construction
9A-2	Construction Notes
9B	Drainage & Utilities
9B-2	Drainage & Utilities Notes
9C	Profile
10	Alignment & R/W
10A	General Construction
10A-2	Construction Notes
10B	Drainage & Utilities
10B-2	Drainage & Utilities Notes
10C	Profile
11	Alignment & R/W
11A	General Construction
11A-2	Construction Notes
11B	Drainage & Utilities
11B-2	Drainage & Utilities Notes
11C	Profile
11D	Profile
11E	Pedestrian Pathway Details
12	Alignment & R/W
12A	General Construction
12B	Drainage & Utilities
12C	Profile
13	Alignment & R/W
13A	General Construction

INDEX OF SHEETS, CONT'D.	
SHEET NO.	DESCRIPTION
GEO/HYDRO	
GA	Erosion & Sediment Notes
GA-2 Thru GA-43 Incl.	Erosion & Sediment Control Plan
GA-44	Erosion & Sediment Control Details
GB Thru GB-3 Incl.	Drill Hole Locations
GB-4	Wall 1 Subsurface Data
GB-5	Wall 2 Subsurface Data
GB-6 Thru GB-9 Incl.	Subsurface Data
GC	Wall 1 (Structure No. 22103)
GC-2 & GC-3	Wall 2 (Structure No. 22104)
GC-4	Wall 2 Sections (Structure No. 22104)
GC-5	Wall 2 Stages (Structure No. 22104)
GC-6	General Notes & Design Requirements (Structure No. 22103 & 22104)
GE	Culvert & Temporary Water Management Plan
GJ Thru GJ-3 Incl.	Water Quality Facility Details
GJ-4	Water Quality Facility No. 1
GJ-5 Thru GJ-7 Incl.	Water Quality Facility No. 2
GJ-8	Water Quality Facility No. 3
GL Thru GL-2 Incl.	Prospective Disposal Site
GN Thru GN-2 Incl.	Contour Grading Plan
GR	Weed Control Work Plan

INDEX OF SHEETS, CONT'D.	
DRAWING NO.	DESCRIPTION
91879	General Layout & Index
BRIDGE NO. 09722	
NW HELVETIA RD CONN OVER HWY 47	
91880	Plan & Elevation
91881	General Notes
91882	Foundation Data
91883	Staging
91884	Footing Plan
91885	Construction & Concrete Pour Sequence
91886	Deck Plan Span 1
91887	Deck Plan Span 2
91888	Deck Section
91889	Partial Framing Layout
91890	Steel Girder Details - Span 1
91891	Steel Girder Details - Span 2
91892	Girder Camber Details
91893	Field Splice Details
91894	Cross Beam (Bent 2) Details
91895	Cross Beam (Bent 2) Connection
91896	Misc. Welding Details
91897	Intermediate Cross Frame Details
91898	Cross Frames (Bents 1 & 3) Details
91899	Bent 3 (Bent 1 similar)
91900	Misc. (Bents 1 & 3) Details
91901	Bearing Details (Bents 1 & 3)
91902	Wingwalls
91903	Bent 2
91904	Bent 2 - Details
91905	Bearing Details (Bent 2)
91906	Ornamental Protective Fencing 1
91907	Ornamental Protective Fencing 2
91908	Ornamental Protective Fencing 3
91909	Temporary Barrier - Plan & Elevation
91910	Temporary Barrier Details

INDEX OF SHEETS, CONT'D.	
SHEET NO.	DESCRIPTION
STRUCTURE No. 22068 (SIGN BRIDGE)	
S-14078	Plan & Elevation
S-14079	Subsurface Data

STRUCTURE No. 22038	
S-14080	Canfliver Sign Support
S-14081	Subsurface Data

ILLUMINATION	
I-02155	Illumination Legend
I-02156 Thru I-02163 Incl.	Illumination Plan
I-02164	Temporary Illumination Legend & Pole Table
I-02165 Thru I-02168 Incl.	Temporary Illumination Plan
I-02169	Temporary Illumination Details

TRAFFIC SIGNALS	
17329	Signal Legend
17330	Signal Plan
17331	Detector Plan
17332	Existing Utility Plan
17333	Signal Removal Plan
17334	Signal Plan
17335	Detector Plan
17336	Existing Utility Plan
17337	Signal Removal Plan
17338	Interconnect Plan
17339	Details
17340	Pump Meter Legend
17341	Pump Meter Plan
17342	Temporary Signal Legend
17343 Thru 17347 Incl.	Temporary Signal & Detector Plan
17348	Existing Utilities
17349 Thru 17351 Incl.	Temporary Signal & Detector Plan
17352	Existing Utilities
17353 Thru 17355 Incl.	Details
17360	Signal Pole Footing - Detail 1 Bridge Dwg. No. 91717
17361	Signal Pole Footing - Detail 2 Bridge Dwg. No. 91718

PERMANENT PAVEMENT MARKINGS	
ST Thru ST-11 Incl.	Striping Plan

DRAWING NO.	DESCRIPTION
PERMANENT SIGNING	
S-14052 Thru S-14075 Incl.	Permanent Signing
S-14076	Rice Museum Signing Plan
STRUCTURE No. 22039	
S-14076	Canfliver Sign Support
S-14077	Subsurface Data

ITS	
ITS-1521	ITS Legend
ITS-1522 Thru ITS-1525 Incl.	ITS Plan
ITS-1526 Thru ITS-1527 Incl.	Details

"REVISED AS CONSTRUCTED"

PROJECT MANAGER
8/28/17
DATE

Added new Plan Sheets 2A-13, 2A-14, 2B-8 and 11E - Pedestrian Pathway Details, S-14076 - Rice Museum Signing Plan, ITS-1528 - Details


US26 @ BROOKWOOD / HELVETIA (SHUTE RD) PROJECT		
SUNSET HIGHWAY WASHINGTON COUNTY		
FEDERAL HIGHWAY ADMINISTRATION	PROJECT NUMBER	SHEET NO.
OREGON DIVISION	STATE	1A

Standard Drawings located on the web at:
http://www.oregon.gov/ODOT/HWY/ENG/SERVICES/standard_drawings_home.shtml

Sec. 15 & 16, T. 1 N., R. 2 W., W.M.
BROOKWOOD PKWY. / HELVETIA RD. INTERCHANGE




SCALE: 1"=100'

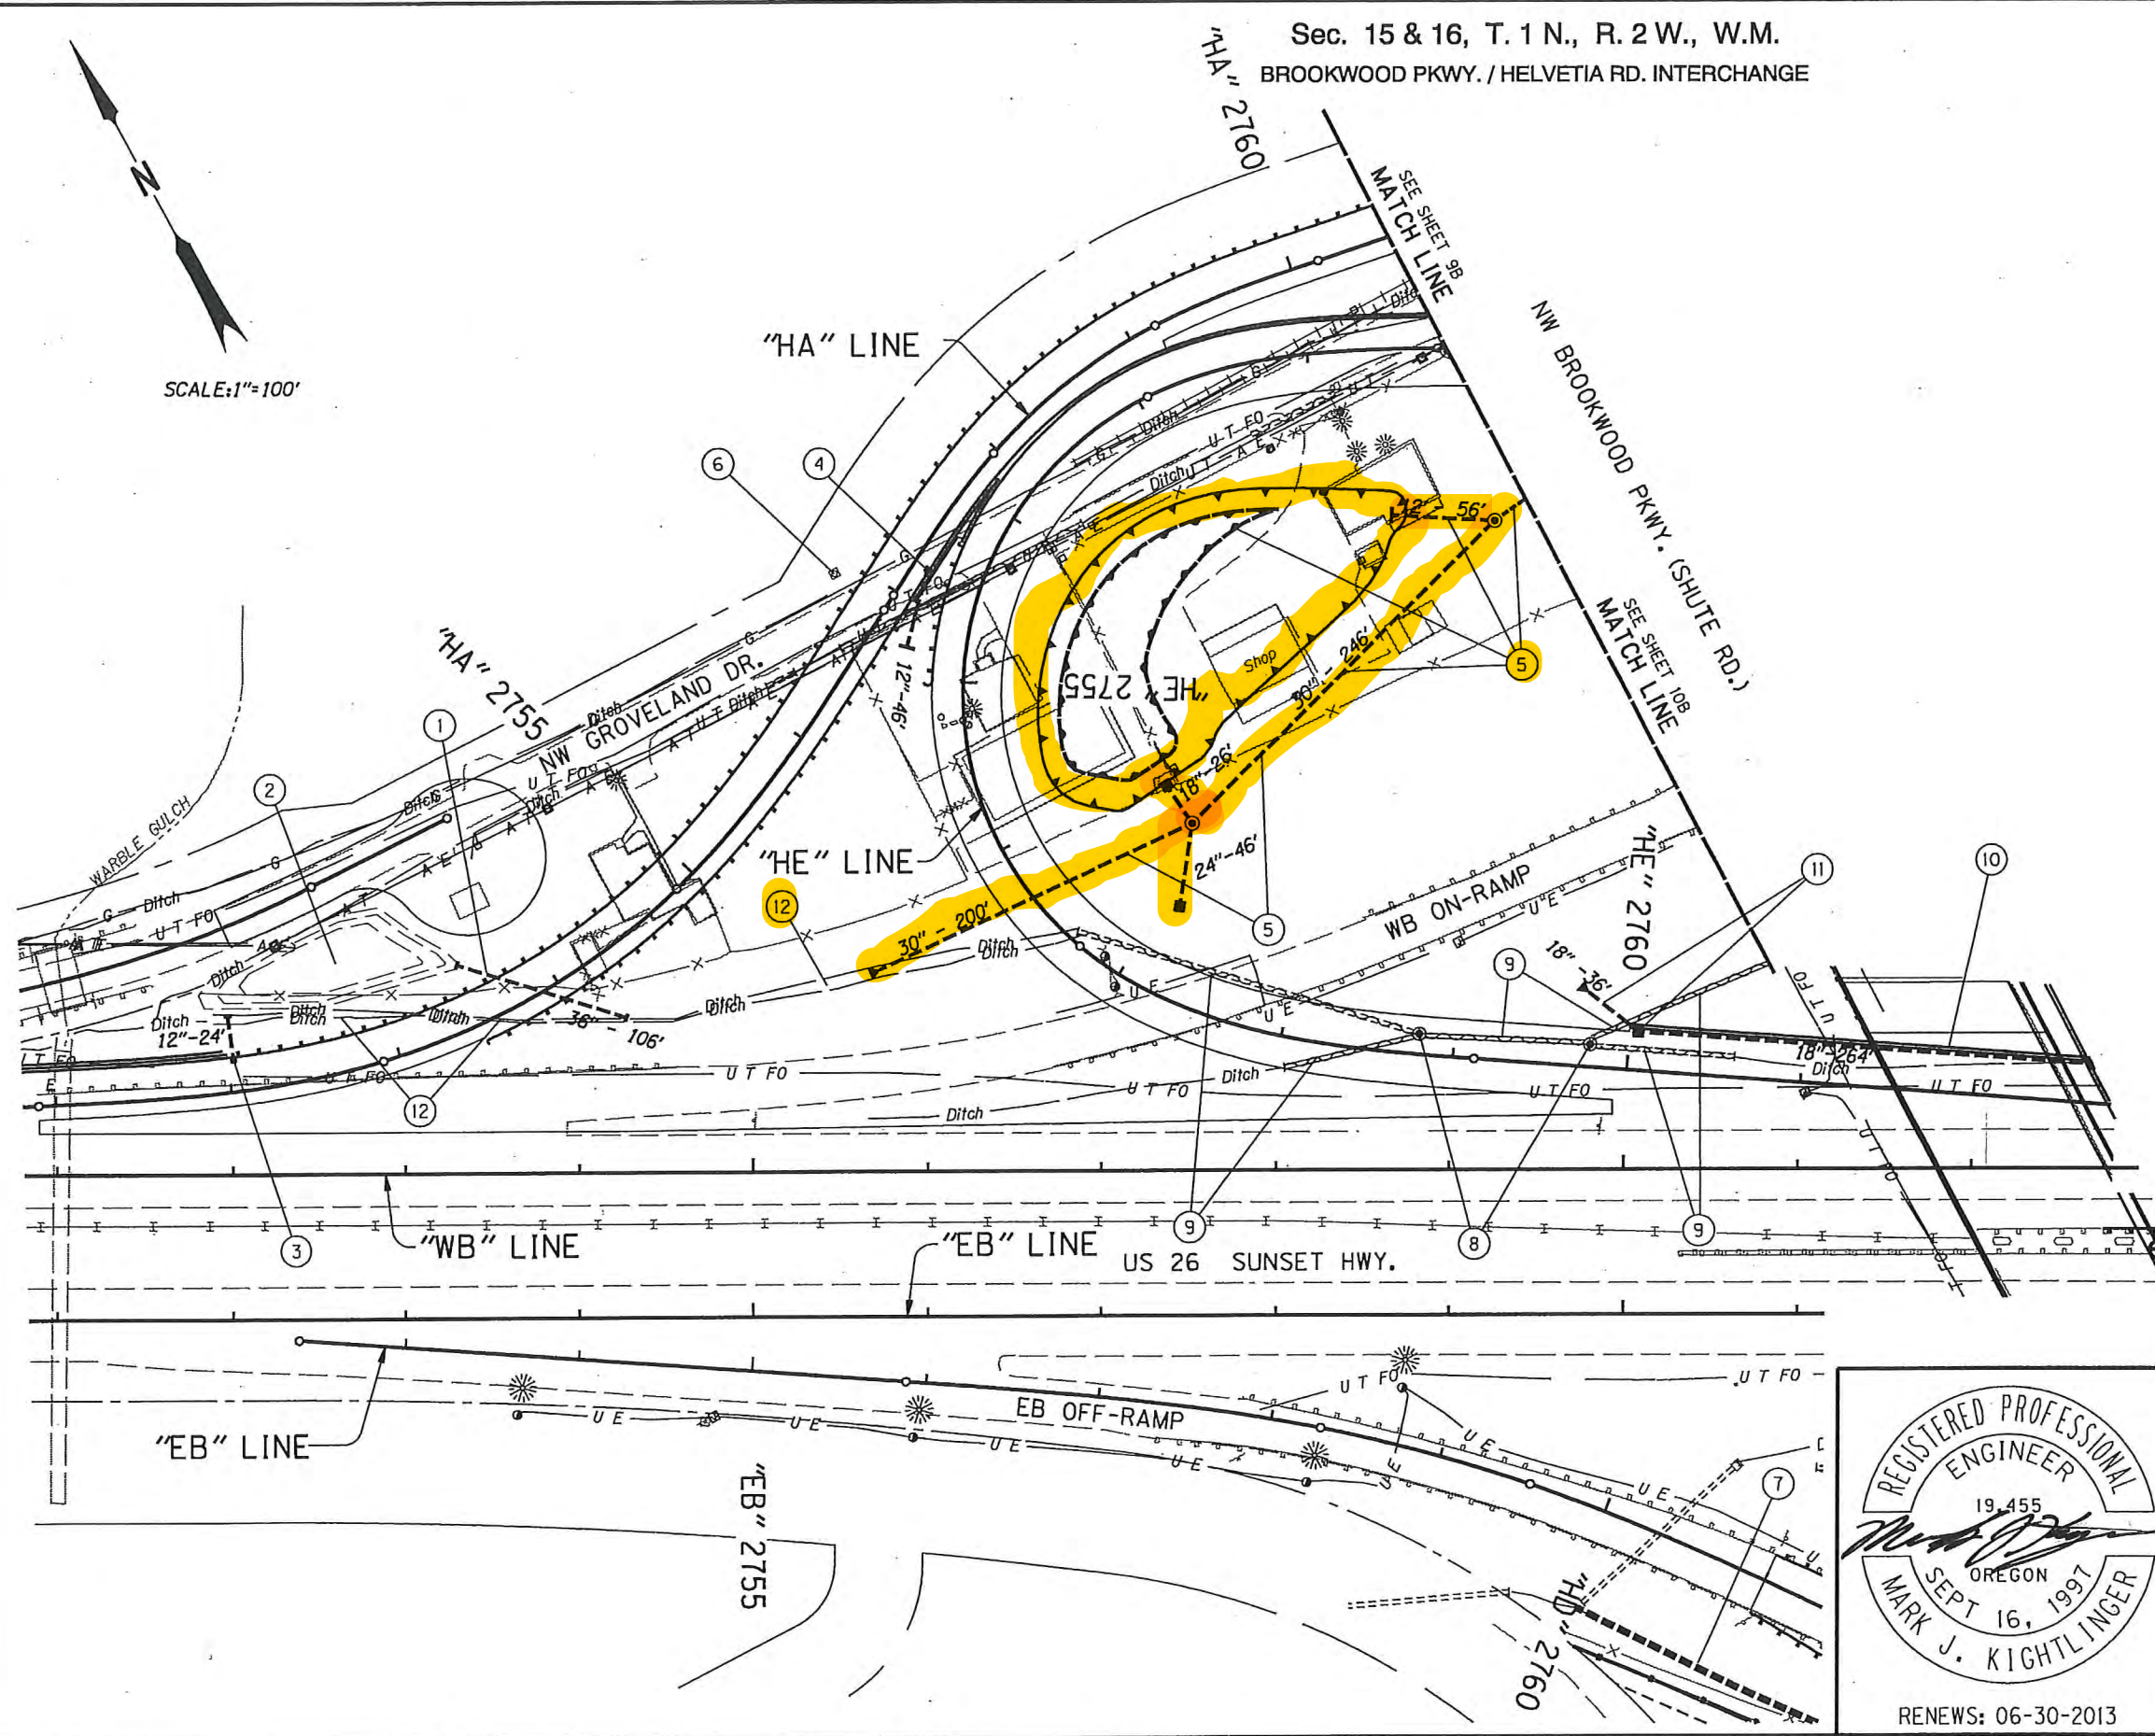

"NOT REVISED AS CONSTRUCTED"
Ron Lawson
 PROJECT MANAGER
 8/22/17
 DATE

Removal of pipes, shown thus:

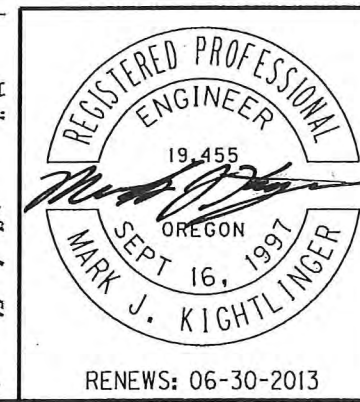

OREGON DEPARTMENT OF TRANSPORTATION	
Region 5 Tech Center 3012 Island Ave La Grange, OR 97850 (541) 963-3177	
US26 @ BROOKWOOD / HELVETIA (SHUTE RD) PROJECT SUNSET HIGHWAY WASHINGTON COUNTY	
Design Team Leader - Thomas Glen Wallace Designed By - Mark J. Kightlinger Drafted By - Mark J. Kightlinger	
DRAINAGE & UTILITIES	SHEET NO. 5B


- ① Sta. "HA" 2753+90
Inst 36" Culvert Pipe - 106'
5' depth
(Subject to in-water work period)
(See drg. no. RD300)
- ② Const. water quality facility no. 3
(Subject to in-water work period)
(For sht. nos., see sht. 1A)
- ③ Sta. "HA" 2752+03, Lt. Offset 18.42' Left
Const. Type "G-2" Inlet with 18" sump
Inst. 12" storm sewer pipe - 24'
5' depth
Inst. slope anchors
(See Drg. nos. RD330 & RD364)
- ④ Sta. "HA" 2757+20, Rt. Offset 8.42' Right
Const. Type "G-2" Inlet with 18" sump
Inst. 12" storm sewer pipe - 46'
5' depth
- ⑤ Const. water quality facility no. 2
(For sht. nos., see sht. 1A)
- ⑥ Monitoring well
Decommissioned by others
- ⑦ Const. ditch
4' flat bottom, 1:4 sides
Dit excavation - 73 cu.yd.
- ⑧ Remove manholes - 2
- ⑨ Remove extg. storm sewer pipes
- ⑩ Sta. "HE" 2760+05 to Sta "HE" 2762+69, Lt
~~Inst. 18" storm sewer pipe - 264'~~ * Install 18" Ductile Iron Pipe - 264'
5' depth
- ⑪ Sta. "HE" 2760+05 Offset 22.17' Left
Const. Type "G-2" Inlet
~~Inst. 18" storm sew. pipe - 36'~~ * Install 18" Ductile Iron Pipe - 36'
5' depth
Const. paved end slope

⑫ Exist. ditch
(Subject to in-water work period)

"REVISED AS CONSTRUCTED"
Ken Lawson
PROJECT MANAGER
8/22/17
DATE




OREGON DEPARTMENT OF TRANSPORTATION	
Region 5 Tech Center 3012 Island Ave La Grande, OR 97850 (541) 963-3177	
US26 @ BROOKWOOD / HELVETIA (SHUTE RD) PROJECT SUNSET HIGHWAY WASHINGTON COUNTY	
Design Team Leader - Thomas Glen Wallace Designed By - Mark J. Kightlinger Drafted By - Mark J. Kightlinger	
DRAINAGE & UTILITIES NOTES	SHEET NO. 5B-2

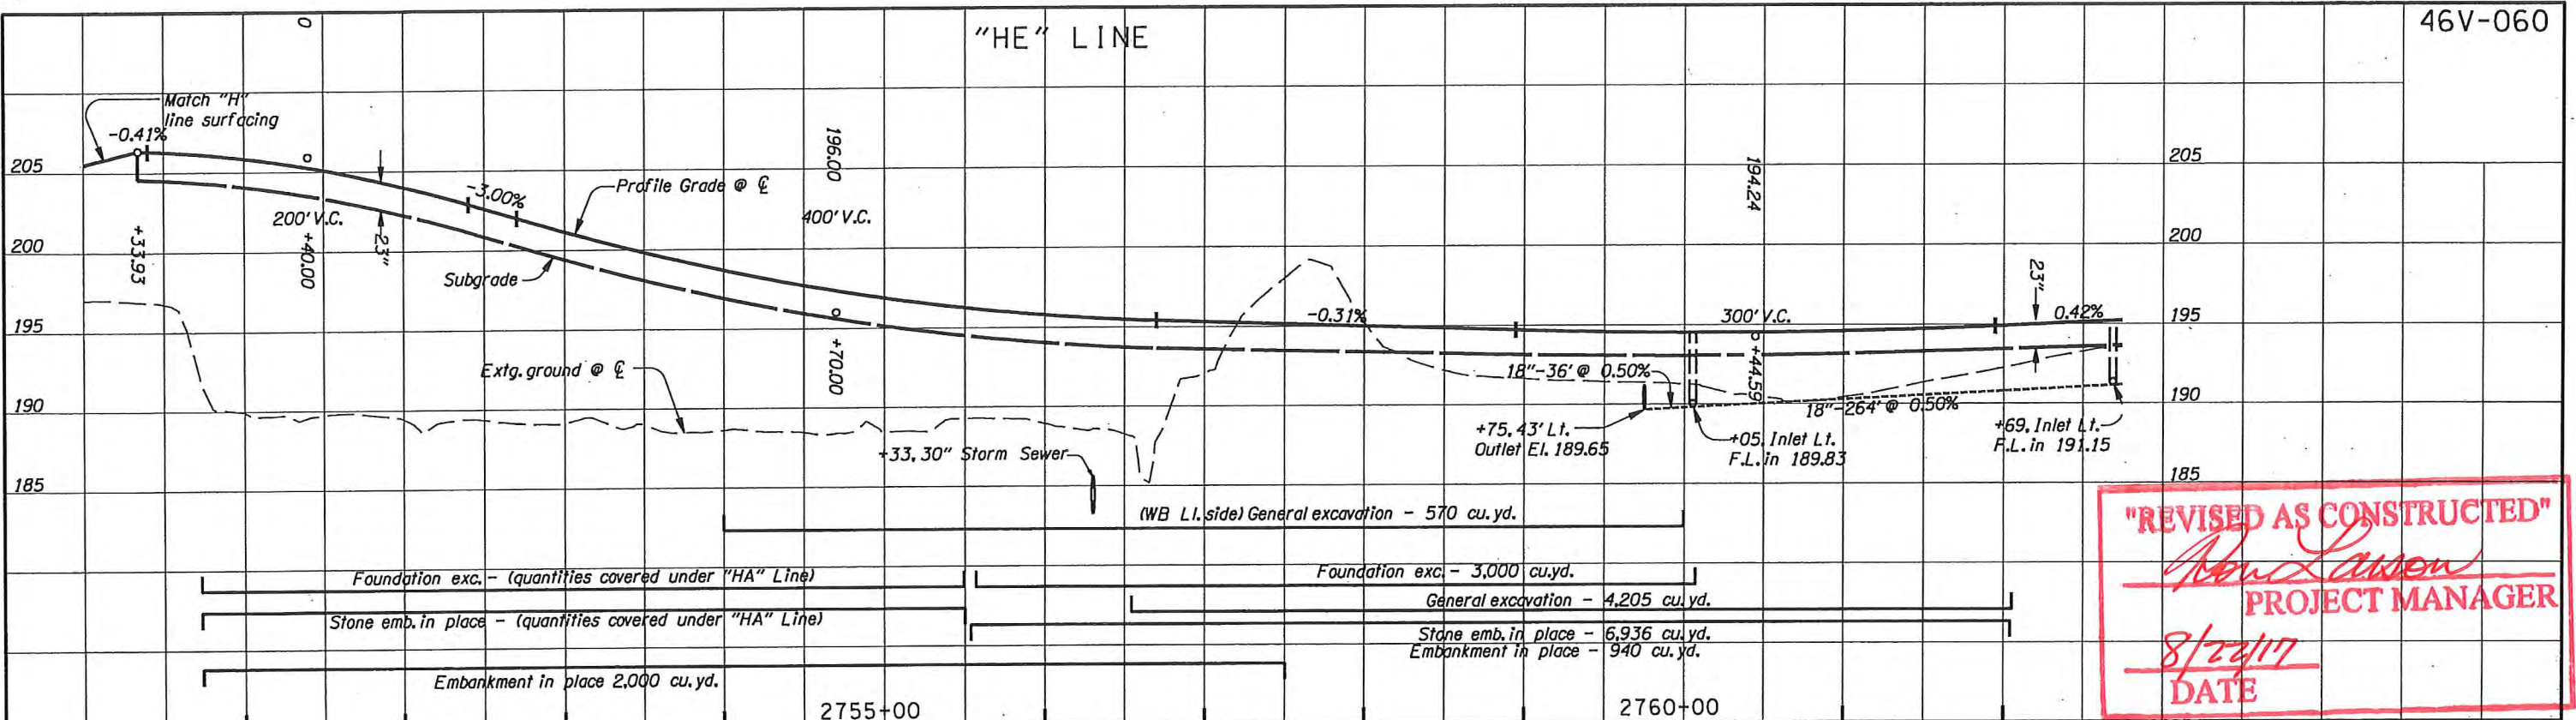

"REVISED AS CONSTRUCTED"
Mark J. Kightlinger
 PROJECT MANAGER
 8/24/17
 DATE

* Flowline elevation changed to match the elevation shown on Sheet GJ-8 by the EOR via e-mail on 11/25/13

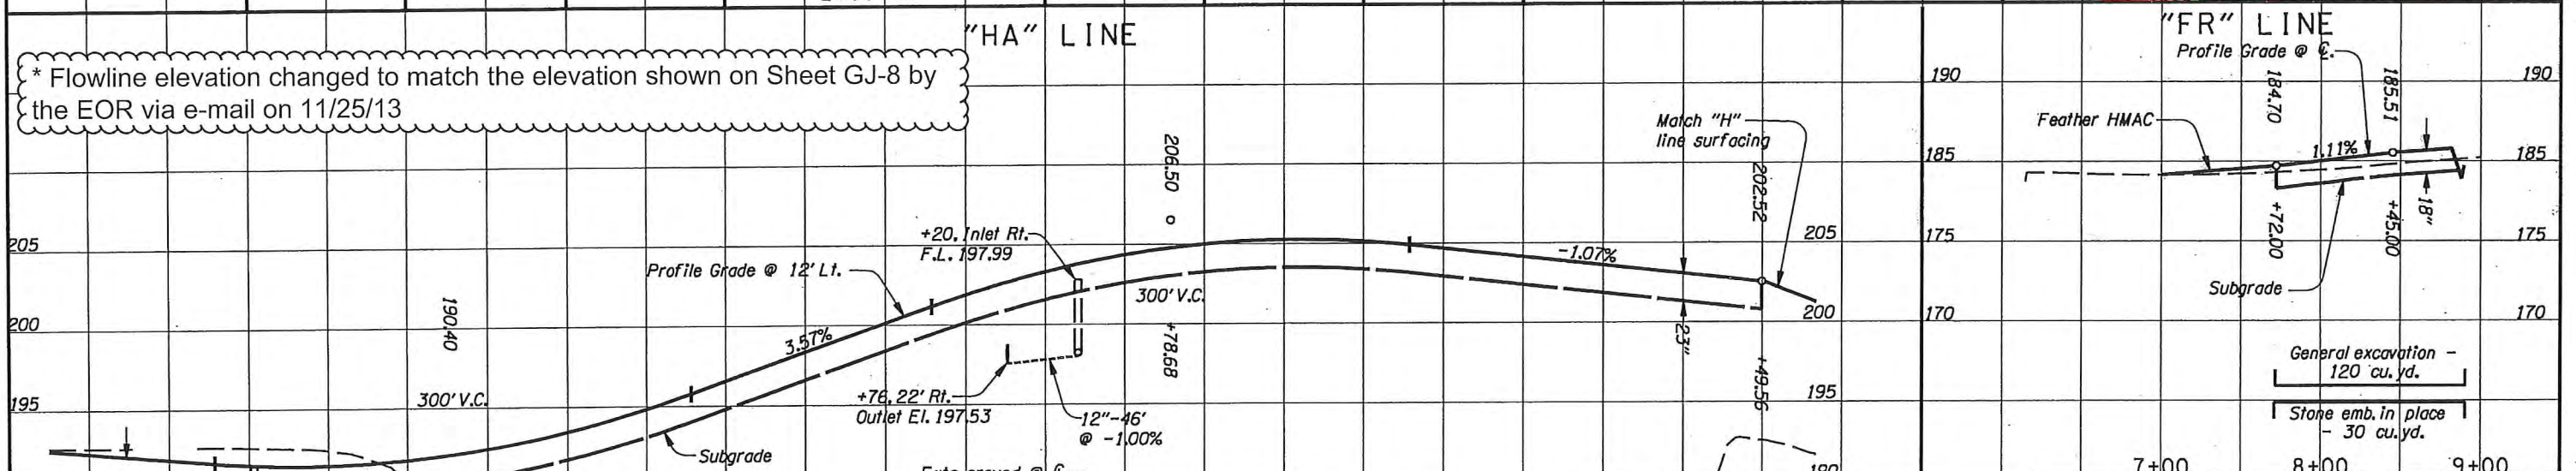

OREGON DEPARTMENT OF TRANSPORTATION

Region 5 Tech Center
 3012 Island Ave
 La Grande, OR 97850
 (541) 963-3177

US26 @ BROOKWOOD / HELVETIA (SHUTE RD) PROJECT
 SUNSET HIGHWAY
 WASHINGTON COUNTY

Design Team Leader - Thomas Glen Wallace
 Designed By - Mark J. Kightlinger
 Drafted By - Mark J. Kightlinger




RENEWS: 06-30-2013


PROFILE SHEET NO. 5C

Rev. No.	Description	Date	Engineer
1	Revised outlet flowline elev. to match 30" pipe as-built flowline elev.	08-11-2015	CLB

KEY	VALUE	DESCRIPTION
1	188.0	Elev. of pond bottom (ft.)
2	188.0	Elev. of lower inlet lip (ft.)
3	187.83	F.L. elev. of 4" PVC (ft.)
4	188.0	Elev. of center of orifice (ft.)
5	2.0	Orifice dia. in cap (inch)
6	188.0	F.L. elev. of outfall pipe (ft.)
7	191.0	Elev. of upper inlet lip (ft.)
8	3.0	Pond design depth (ft.)
9	1.06	Pond design volume (ac. ft.)

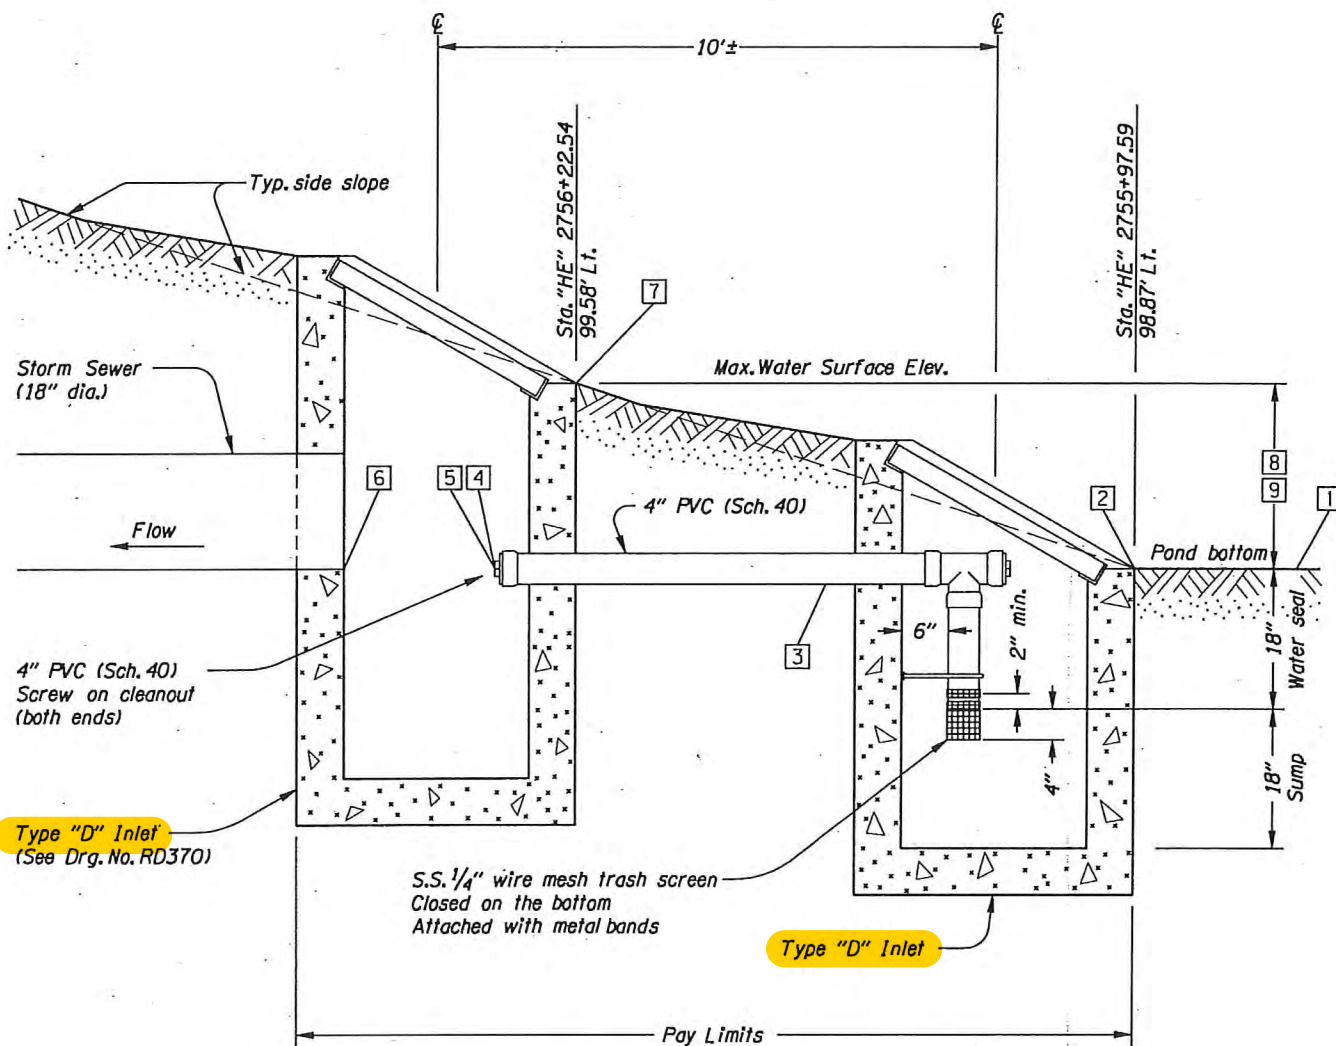


OUTLET CONTROL STRUCTURE

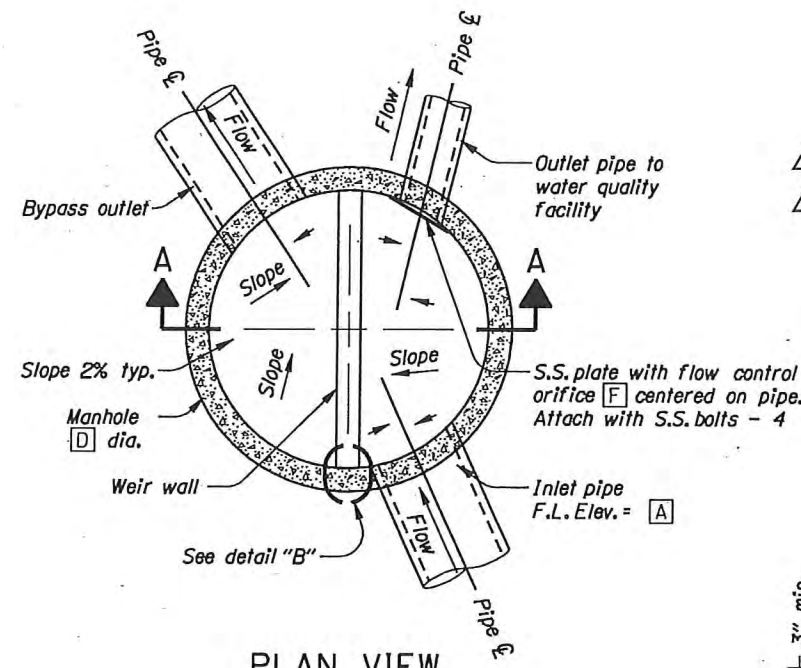


PLAN VIEW

KEY	VALUE	DESCRIPTION	
A	189.0	Invert elev. of inlet pipe (ft.)	188.80
B	189.0	Invert elev. of outlet pipe (ft.)	188.80
C	188.73	Invert elev. of bypass pipe (ft.)	
D	72	Inside dia. of manhole (inches)	
E	190.5	Top of weir wall elev. (ft.)	
F	4.0	Orifice dia. in plate (inch)	

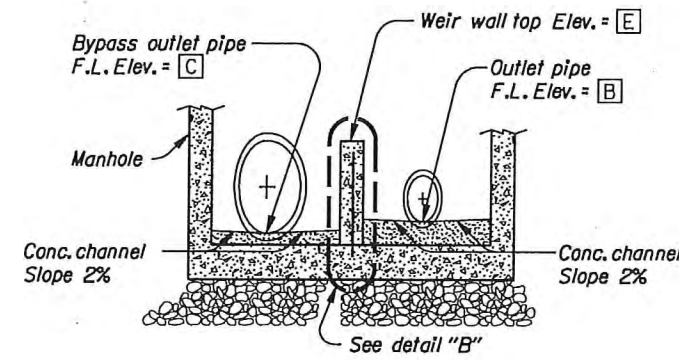

SECTION A-A

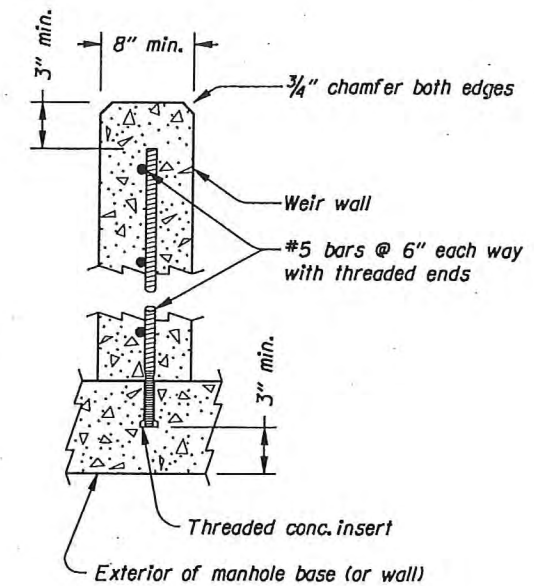


DETAIL "B"

SPLIT FLOW MANHOLE

(For details not shown, see drg. nos. RD336 & RD346)

"REVISED AS CONSTRUCTED"
Ron Larson
PROJECT MANAGER
 8/22/17
DATE

NOTE FOR ALL DETAILS:
 1. S.S. = stainless steel

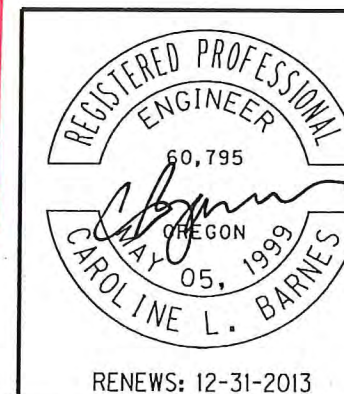


OREGON DEPARTMENT OF TRANSPORTATION
 Region 5 Tech Center
 3012 Island Ave
 La Grande, OR 97850
 (541) 963-3177

US26 @ BROOKWOOD / HELVETIA (SHUTE RD) PROJECT
 SUNSET HIGHWAY
 WASHINGTON COUNTY


Design Team Leader - Thomas Glen Wallace
 Designed By - Caroline L. Barnes
 Drafted By - F. Jeremy Schad

WATER QUALITY FACILITY DETAILS


SHEET NO. GJ

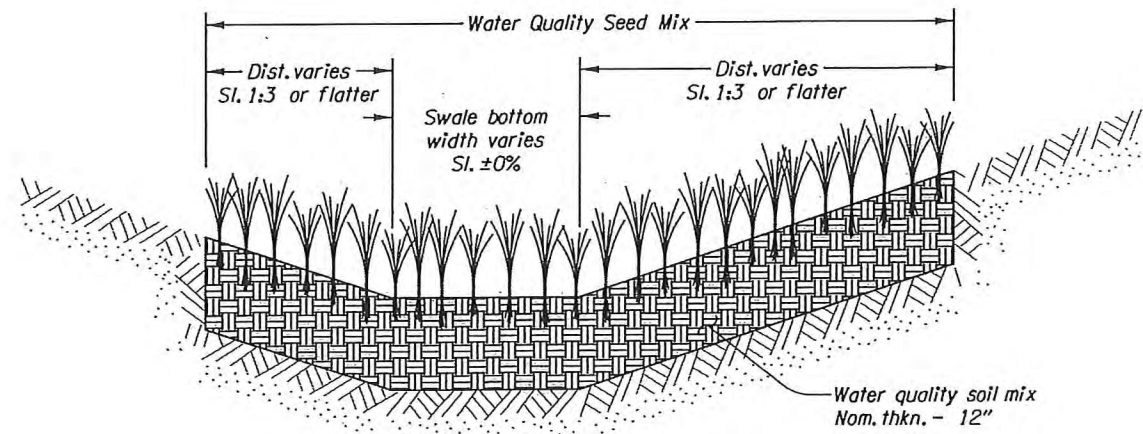


WATER QUALITY SWALE SECTION

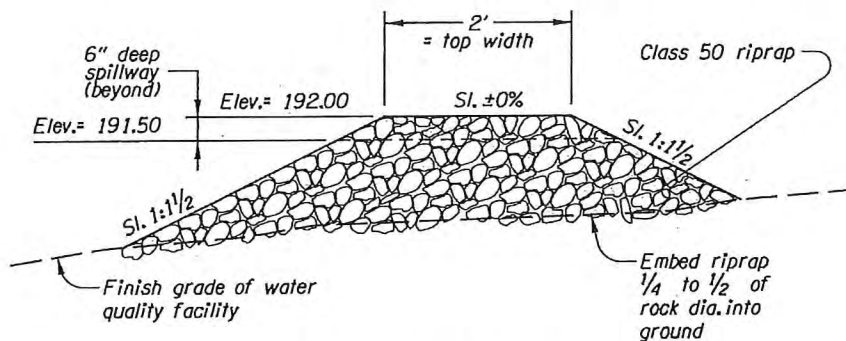


FOREBAY BERM

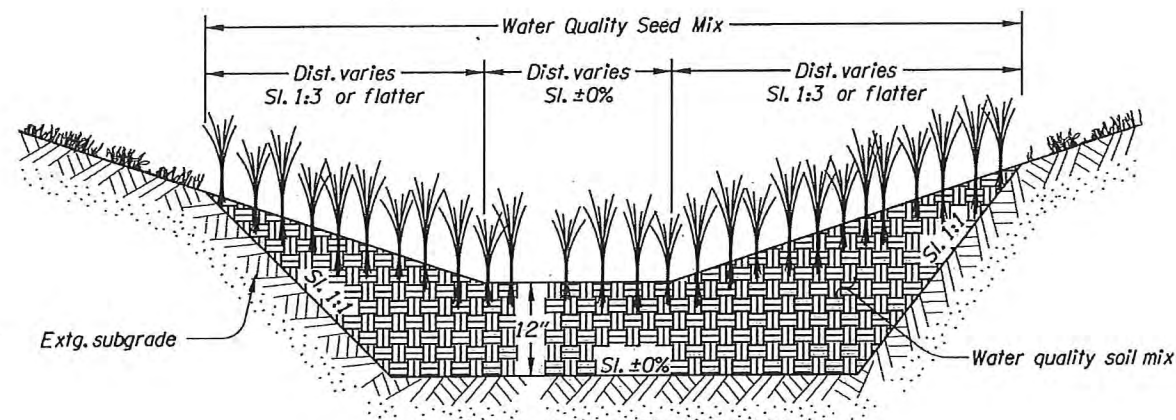

TYPICAL DRY POND SECTION

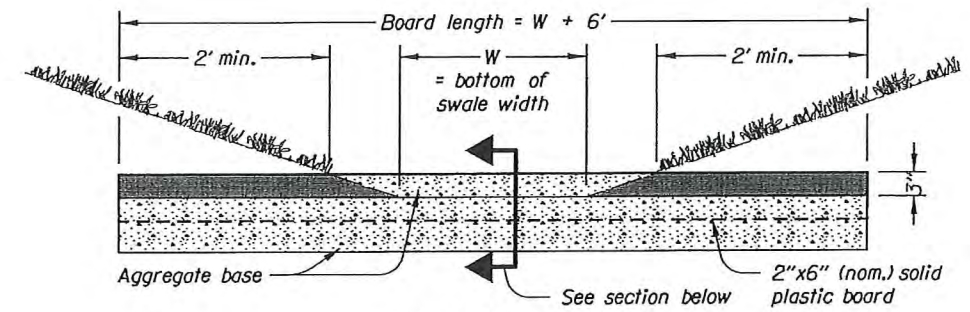

ELEVATION

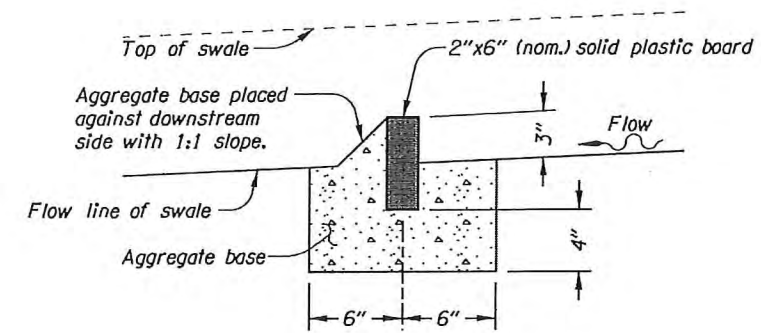

SECTION

FLOW SPREADING CHECK DAM

Space approx. every 50' or as directed.

"NOT REVISED AS CONSTRUCTED"
Ron Larson
PROJECT MANAGER
8/22/17
DATE

NOTES FOR ALL DETAILS:
1. Side-slopes are shown as vert. to horiz.

OREGON DEPARTMENT OF TRANSPORTATION

Region 5 Tech Center
 3012 Island Ave
 La Grande, OR 97850
 (541) 963-3177

US26 @ BROOKWOOD / HELVETIA
(SHUTE RD) PROJECT
 SUNSET HIGHWAY
 WASHINGTON COUNTY


Design Team Leader - Thomas Glen Wallace
 Designed By - Caroline L. Barnes
 Drafted By - F. Jeremy Schad

REGISTERED PROFESSIONAL
 ENGINEER
 60,795


 OREGON
 05, 1999
 CAROLINE L. BARNES
 RENEWS: 12-31-2013

WATER QUALITY FACILITY DETAILS


SHEET NO.
GJ-2

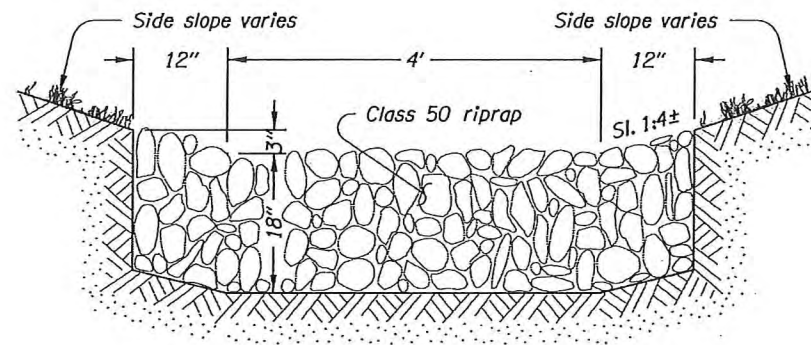

CHANNEL PROTECTION

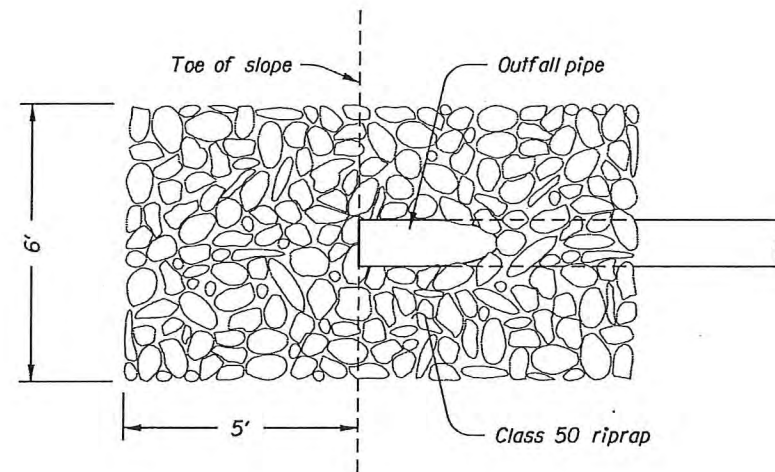

PLAN

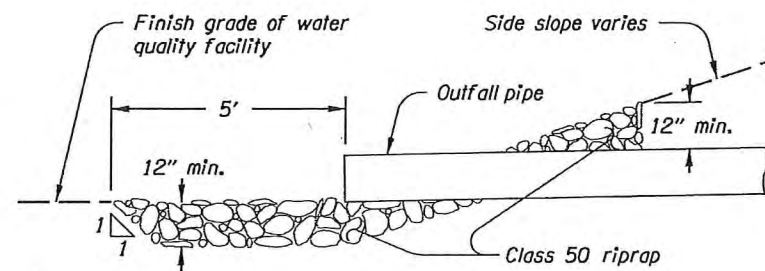


ELEVATION


INLET ENERGY DISSIPATOR

"NOT REVISED AS CONSTRUCTED"
Ken Lawson
 PROJECT MANAGER
 8/22/17
 DATE

NOTES FOR ALL DETAILS:
 1. Side-slopes are shown as vert. to horiz.

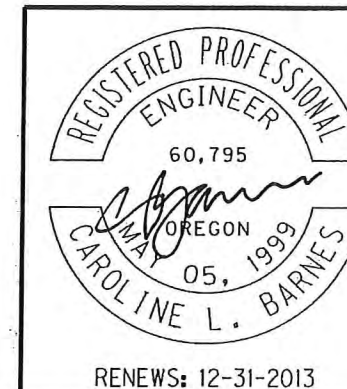

OREGON DEPARTMENT OF TRANSPORTATION	
Region 5 Tech Center 3012 Island Ave La Grande, OR 97850 (541) 963-3177	
US26 @ BROOKWOOD / HELVETIA (SHUTE RD) PROJECT SUNSET HIGHWAY WASHINGTON COUNTY	
Design Team Leader - Thomas Glen Wallace Designed By - Caroline L. Barnes Drafted By - F. Jeremy Schod	
WATER QUALITY FACILITY DETAILS	SHEET NO. GJ-3

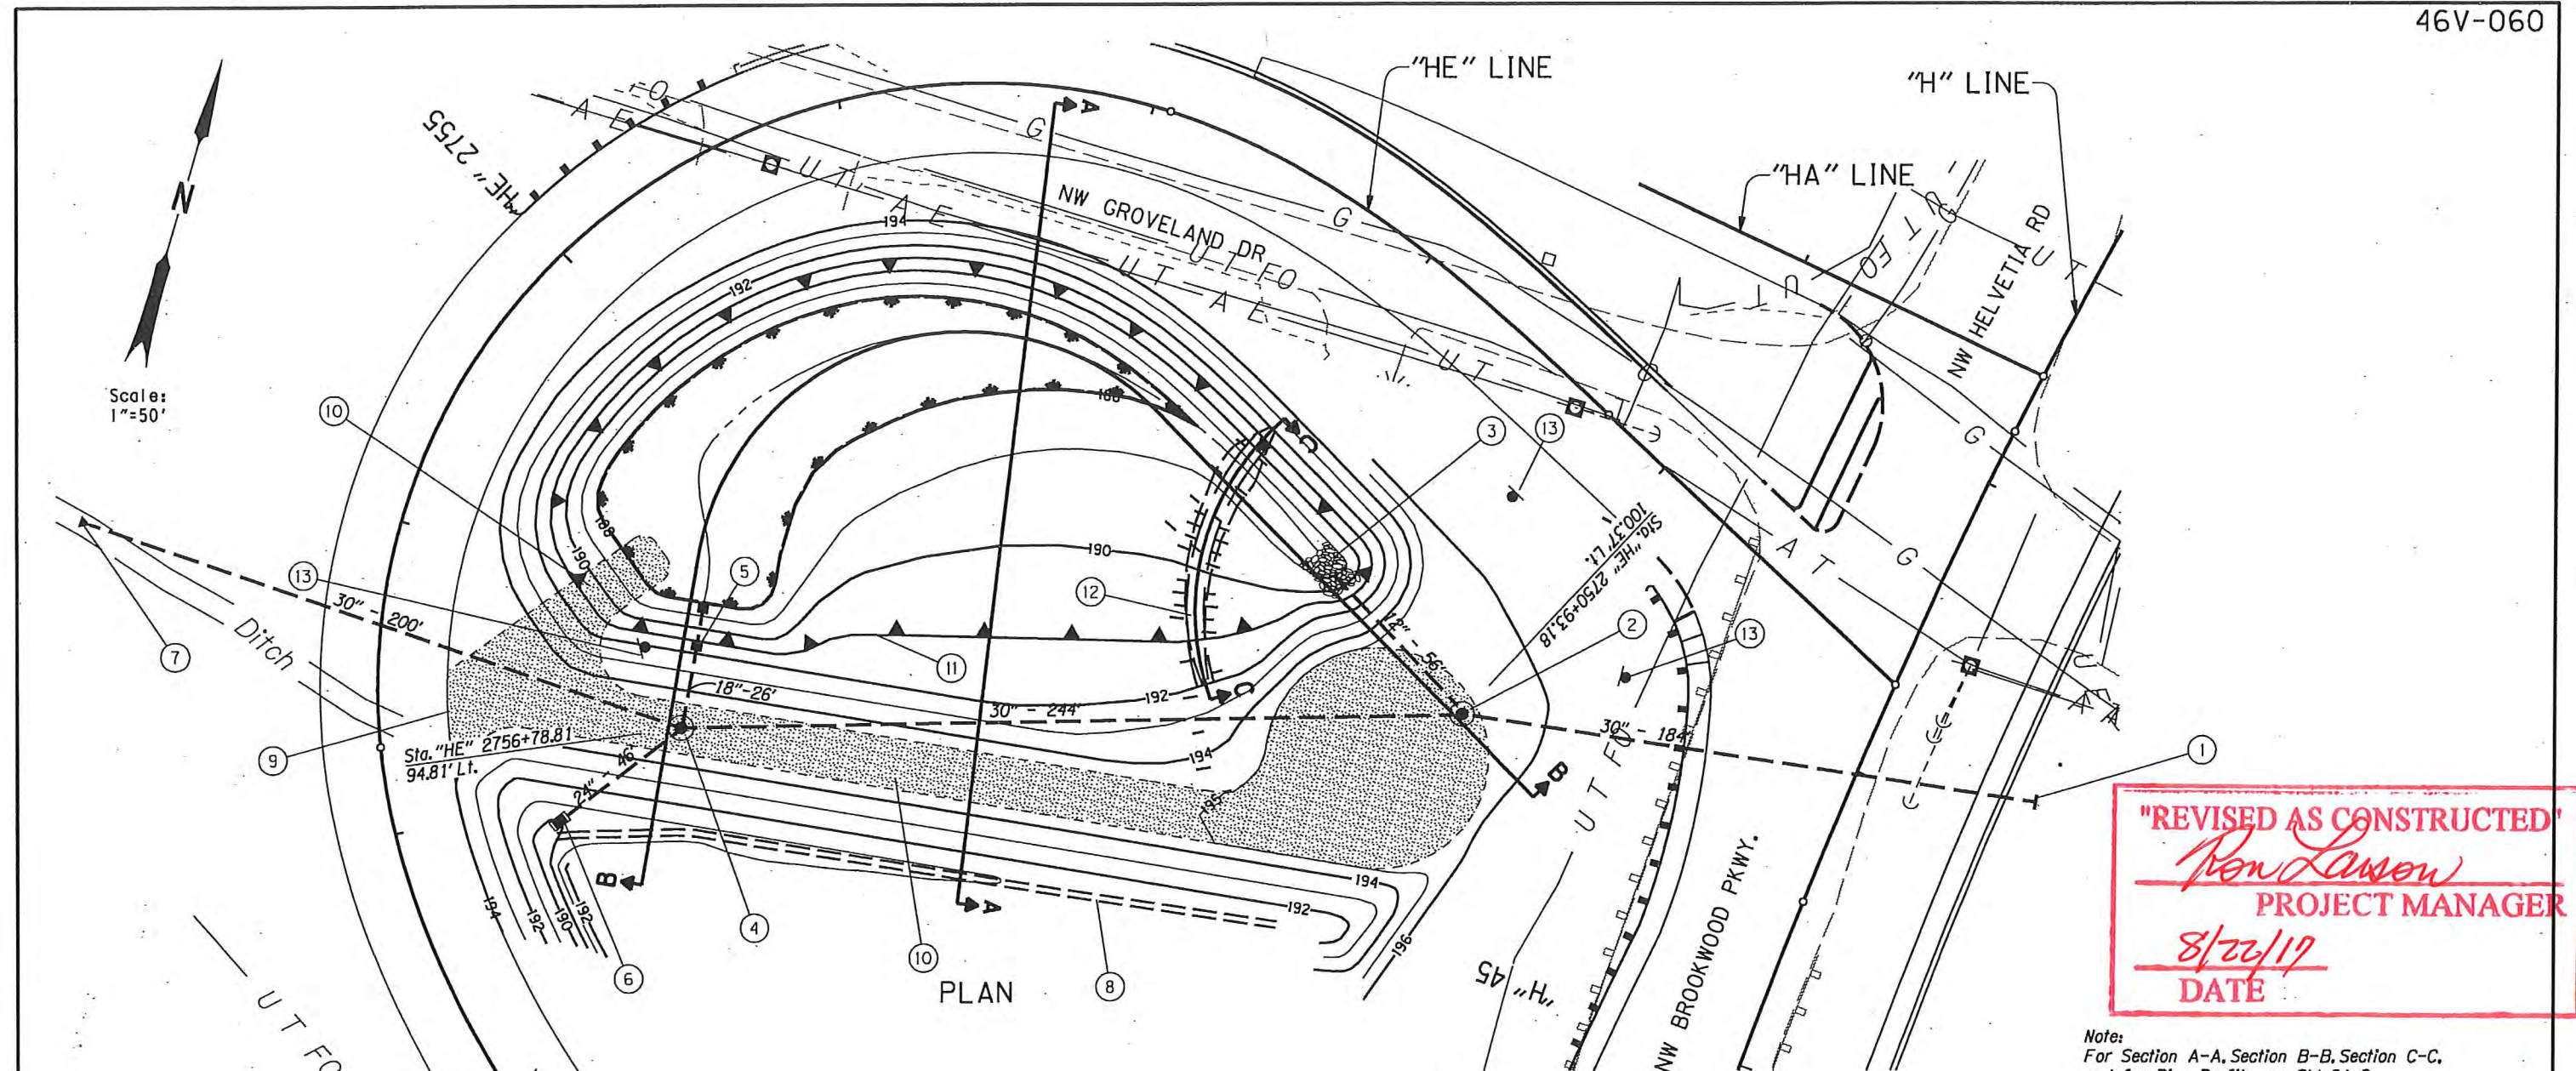

"REVISED AS CONSTRUCTED"
Ron Lawson
PROJECT MANAGER
8/22/17
DATE

Note:
For Section A-A, Section B-B, Section C-C,
and for Pipe Profile, see Sht. GJ-6

- ① Sta. "H" 43+86.53, 55.78' Lt.
Pipe inlet
Inst. 30" storm sew. pipe - 184'
20' depth
- ② Sta. "HE" 2750+93.18, 100.37' Lt.
Const. split flow manhole
(For details see sht. GJ)
Inst. 12" storm sew. pipe - 56'
5' depth
Inst. 30" storm sew. pipe - 246'
5' depth
- ③ Sta. "HE" 2751+53.24, 96.02' Lt.
Const. inlet energy dissipator
(For details see sht. GJ-3)
- ④ Sta. "HE" 2756+78.81, 94.81' Lt.
Const. manhole * Const. manhole - 72" dia.
Inst. 18" storm sew. pipe - 26'
5' depth
Inst. 24" storm sew. pipe - 46'
5' depth
Inst. 30" storm sew. pipe - 200'
5' depth
(See drg. nos. RD335)
- ⑤ Sta. "HE" 2756+22.54, 99.58' Lt.
Const. outlet control structure
(For details see sht. GJ)
- ⑥ Sta. "HE" 2757+12.23, 48.47' Lt.
Const. type "ME" inlet
(See drg. nos. RD368)
- ⑦ Sta. "HE" 2756+18.54, 95.56' Rt.
Const. paved end slope
(See drg. no. RD320)
- ⑧ Const. ditch
- ⑨ Const. gravel approach, W=25'
(See drg. no. RD715)
- ⑩ Const. maintenance access road
16' min. width
(For details see sht. GJ-7)
- ⑪ Const. water quality facility (#2)
extended detention dry ponds
See typical dry pond section
(For details see sht. GJ-2)
- ⑫ Sta. "HE" 2751+98.40, 116.18' Lt.
Const. forebay berm
along 80'R arc from
Sta. "HE" 2751+61.46, 148.46' Lt. to
Sta. "HE" 2752+05.95, 73.38' Lt.
(For details see sht. GJ-2)
- ⑬ Inst. stormwater treatment
field marker


Storm Facility No. D00772

OREGON DEPARTMENT OF TRANSPORTATION

Region 5 Tech Center
3012 Island Ave
La Grande, OR 97850
(541) 963-3177

**US26 @ BROOKWOOD / HELVETIA
(SHUTE RD) PROJECT
SUNSET HIGHWAY
WASHINGTON COUNTY**





Design Team Leader - Thomas Glen Wallace
Designed By - Caroline L. Barnes
Drafted By - F. Jeremy Schad

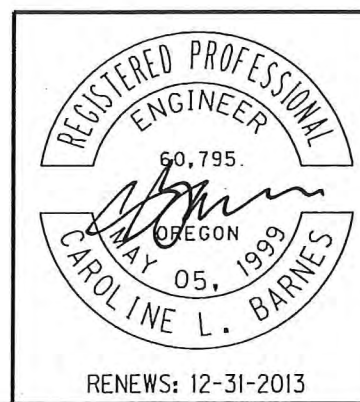


**WATER QUALITY
FACILITY NO. 2**

SHEET
NO.
GJ-5

Rev. No.	Description	Date	Engineer
1	Lowered flowline elevations and pipe grade to better match ditch grade	01-2014	MJK
2	Revised outlet flowline elevation and pipe grade	07-01-2014	CLB
3	Revised outlet flowline elevation and pipe grade to match as-built 30" pipe.	08-11-2015	CLB

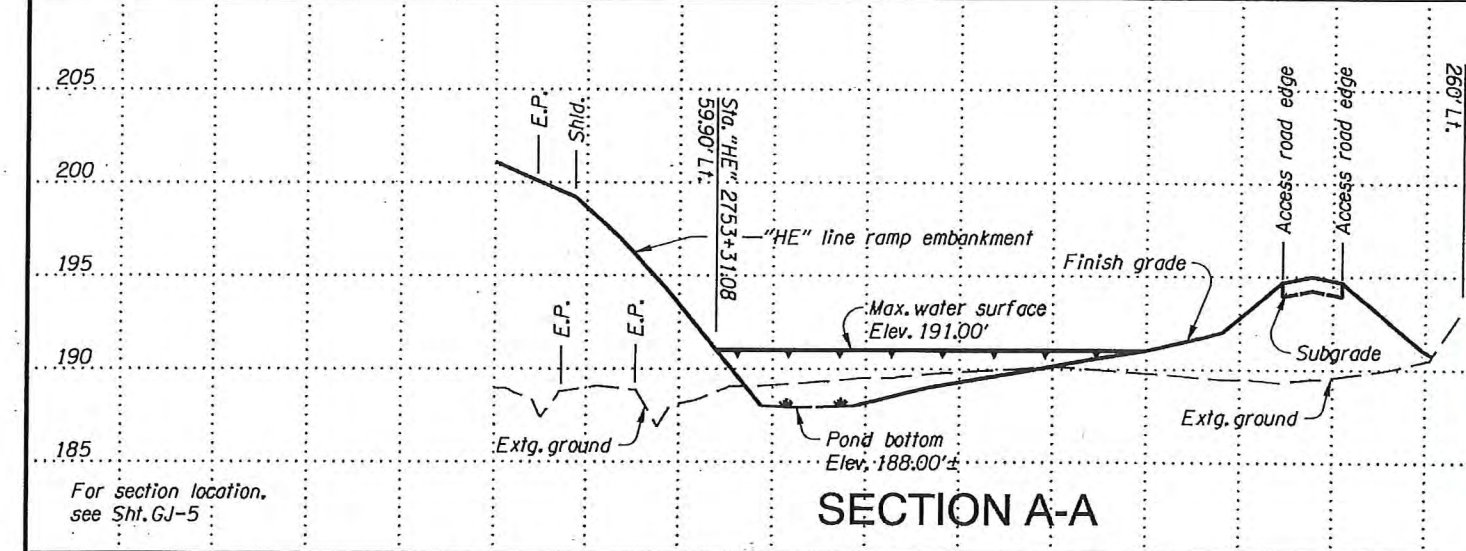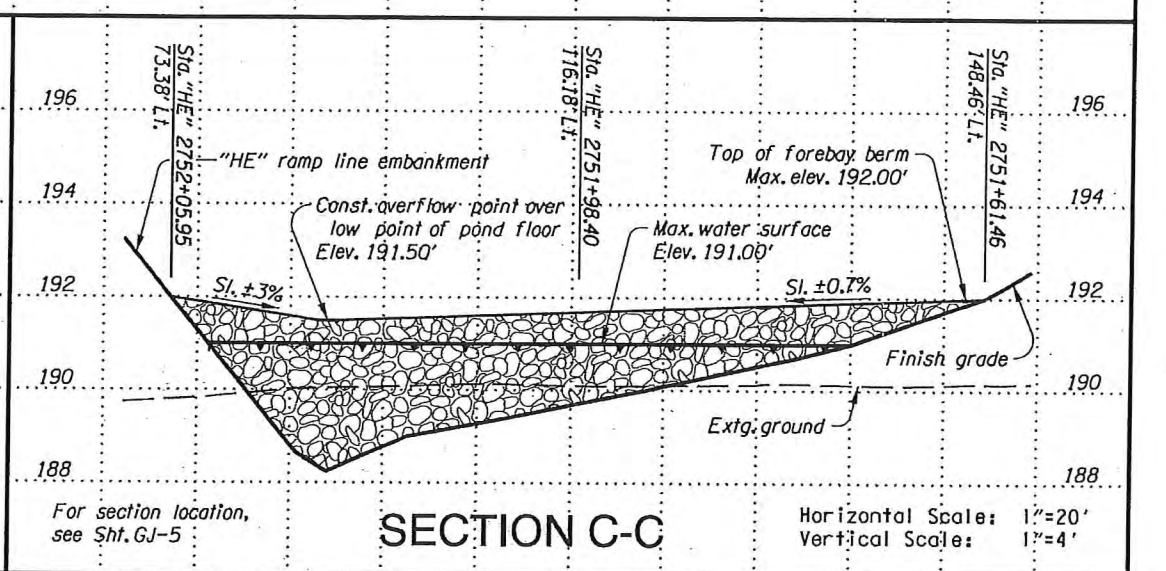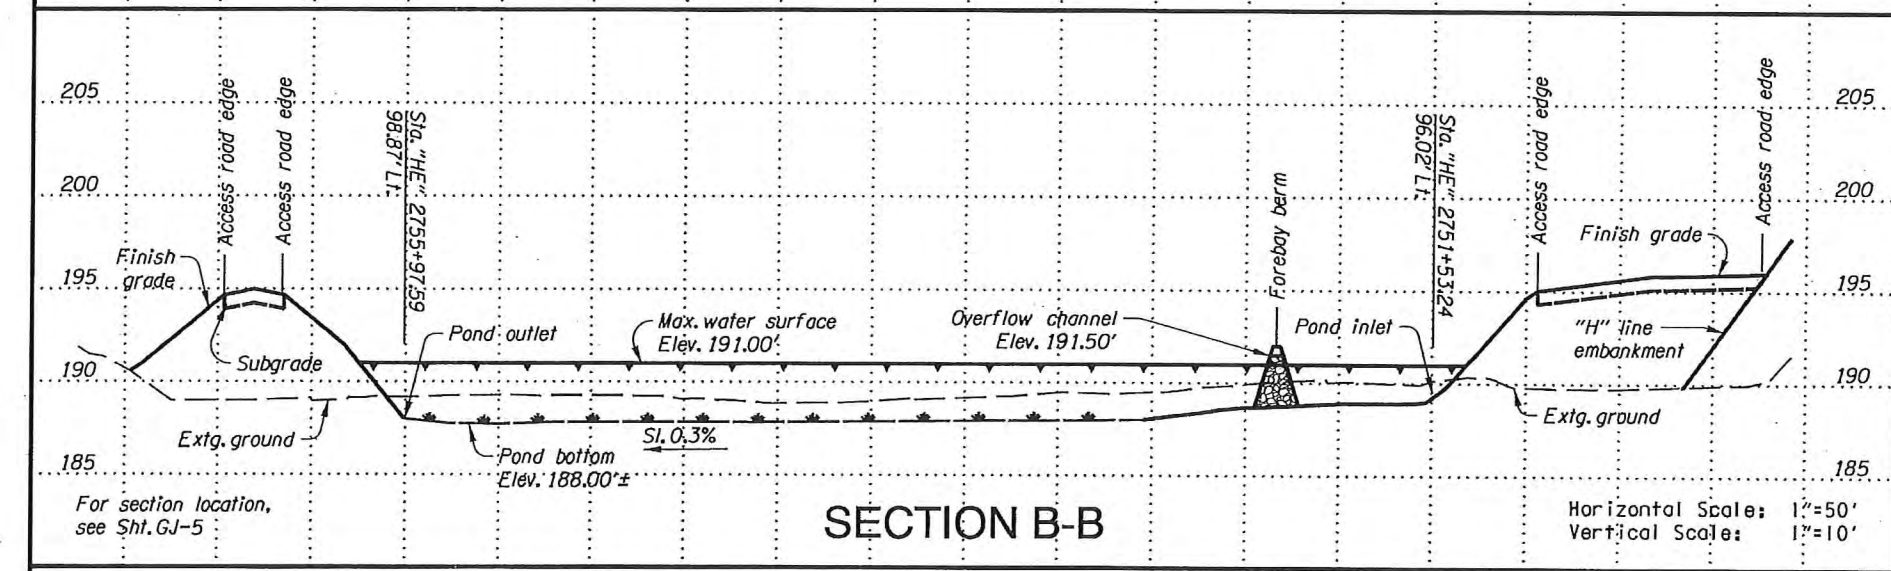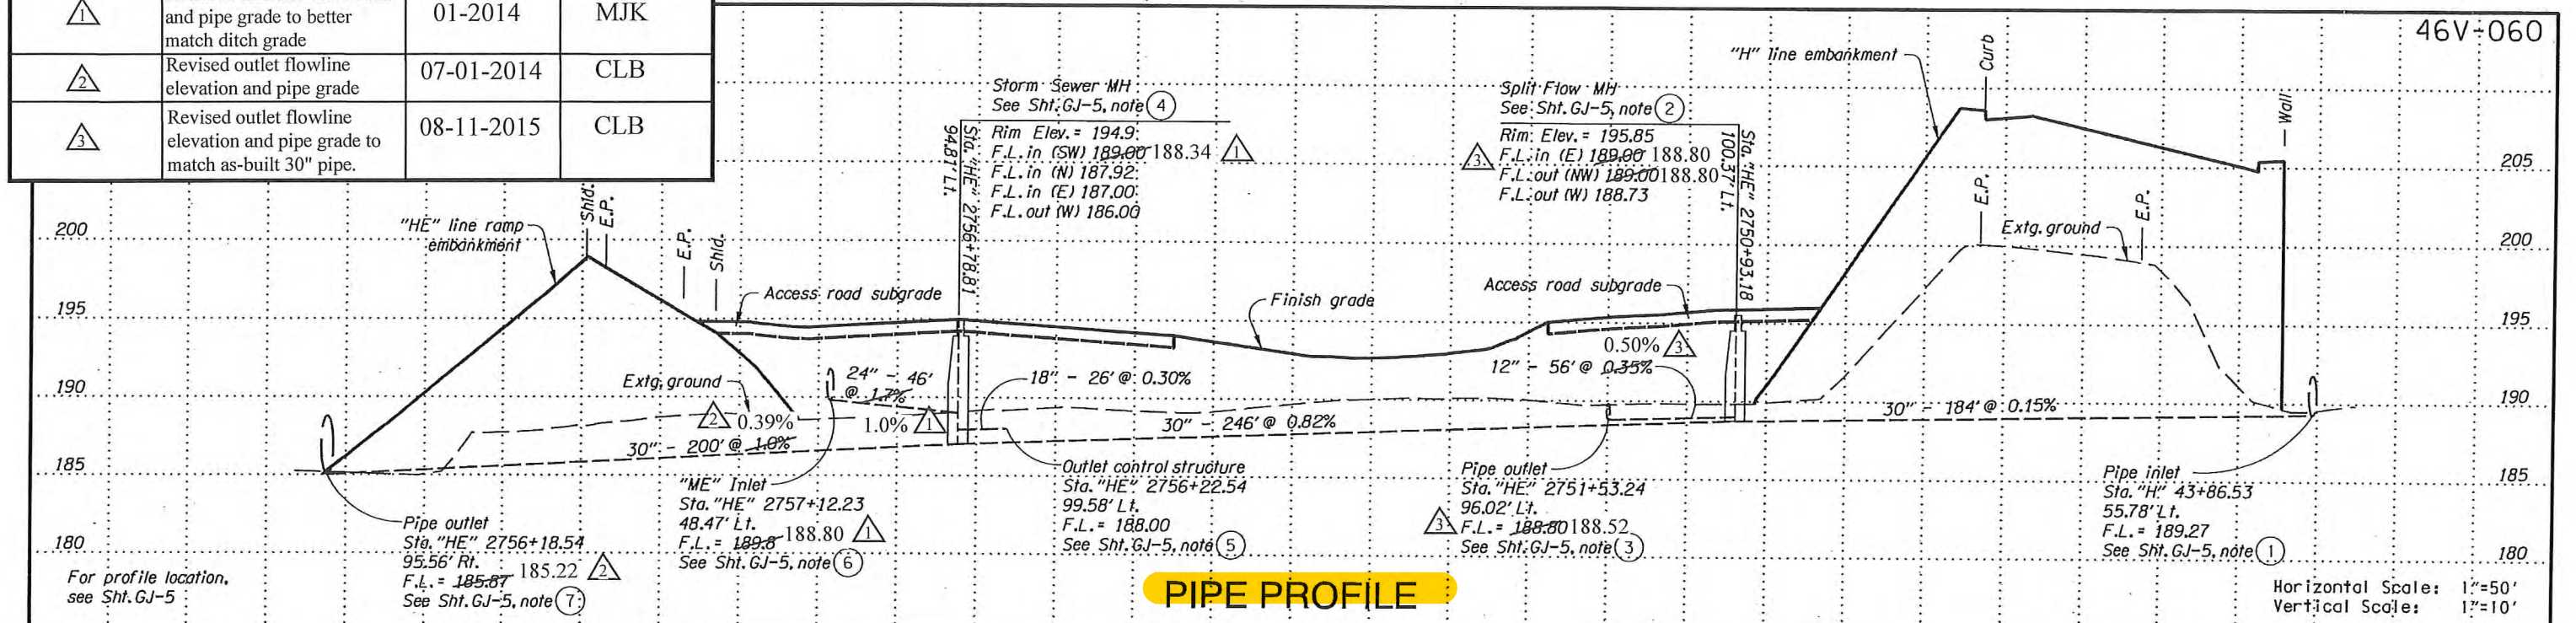

"REVISED AS CONSTRUCTED"
Ron Lawson
PROJECT MANAGER
8/22/17
DATE

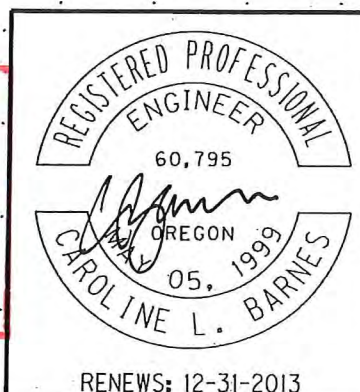

Storm Facility No. D00772

OREGON DEPARTMENT OF TRANSPORTATION

Region 5 Tech Center
3012 Island Ave
La Grande, OR 97850
(541) 963-3177



US26 @ BROOKWOOD / HELVETIA (SHUTE RD) PROJECT
SUNSET HIGHWAY
WASHINGTON COUNTY

Design Team Leader - Thomas Glen Wallace
Designed By - Caroline L. Barnes
Drafted By - F. Jeremy Schad

WATER QUALITY FACILITY NO. 2


SHEET NO. **GJ-6**

Scale:
1"=50'

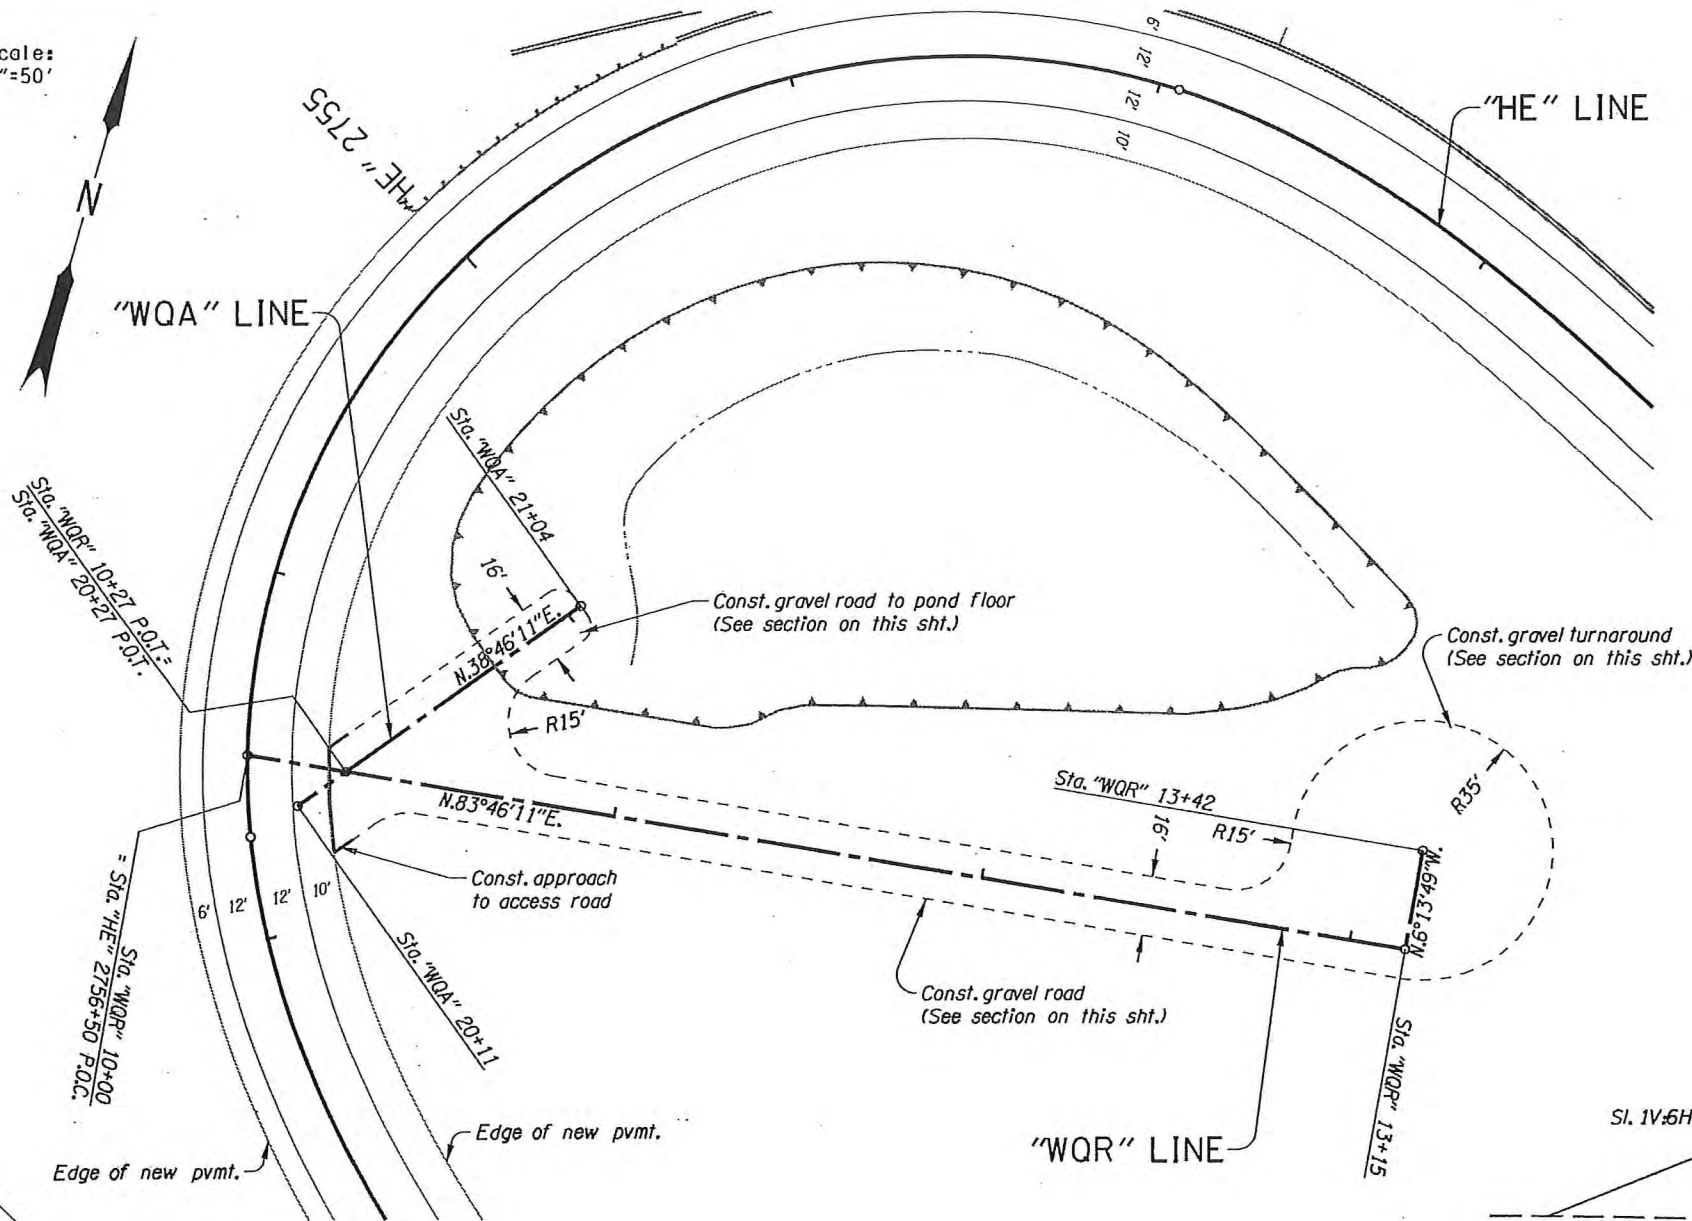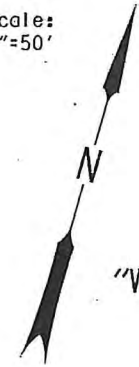


MAINTENANCE ACCESS ROAD

* STATIONING	LS (feet) (slope)	L (feet) (slope)	C (elev.)	R (feet) (slope)	RS (feet) (slope)
"WQR" 10+27 to "WQR" 13+15	2 @ 1V:4H	8 @ 4%	194.9± to 195.4±	8 @ 4%	2 @ 1V:4H
"WQR" 13+15 to "WQR" 13+42	2 to 0 @ 1V:4H	8 to 35 @ 4-2%	195.4± to 195.7±	8 to 35 @ 4-2%	2 to 0 @ 1V:4H
"WQA" 20+11 to "WQA" 20+27	0	0	195.1± to 194.9±	16 @ 4%	2 @ 1V:4H
"WQA" 20+27 to "WQA" 21+04	0	8 @ 0%	194.9± to 188.0±	8 @ 0%	0

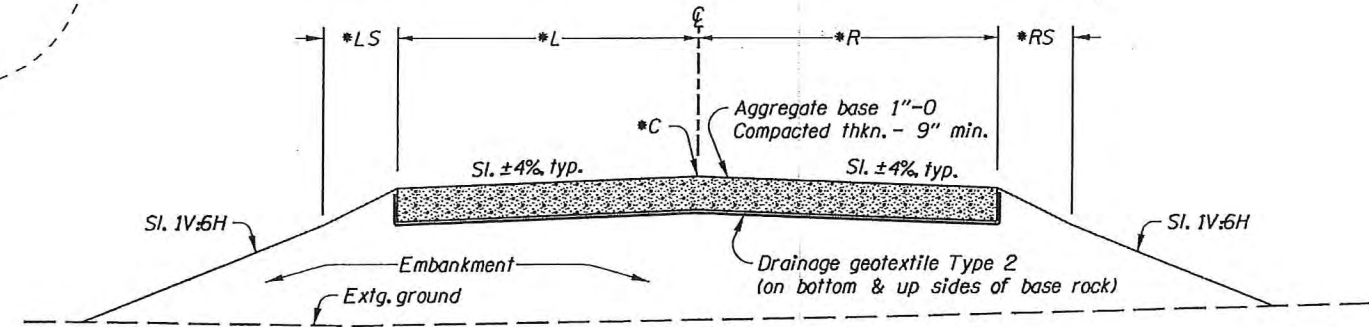

Sta. "WQR" 10+27 to Sta. "WQR" 13+42
"WQA" 20+11 to "WQA" 21+04

"NOT REVISED AS CONSTRUCTED"
Don Lawson
PROJECT MANAGER
8/22/17
DATE

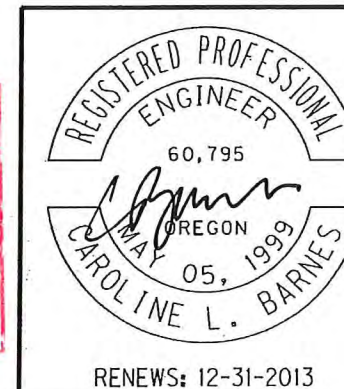

OREGON DEPARTMENT OF TRANSPORTATION

Region 5 Tech Center
3012 Island Ave
La Grange, OR 97850
(541) 963-3177

US26 @ BROOKWOOD / HELVETIA (SHUTE RD) PROJECT
SUNSET HIGHWAY
WASHINGTON COUNTY

Design Team Leader - Thomas Glen Wallace
Designed By - Caroline L. Barnes
Drafted By - F. Jeremy Schad

WATER QUALITY FACILITY NO.2

SHEET NO. GJ-7