

# OPERATION & MAINTENANCE MANUAL

## Water Quality Filter Strip

Manual prepared: May 2019

DFI No. D00787



Figure 1: DFI No. D00787, looking south from Van Duyn Rd. and I-5 southbound on ramp intersection

## 1. Identification

Drainage Facility ID (DFI): D00787  
Facility Type: Water Quality Filter Strip  
Construction Drawings: (V-File Numbers) 45V-31  
Location: District: 5  
Highway No.: 001  
Mile Post: 198.55(MA) to 198.62(MA),[right]

## 2. Manual Purpose

The purpose of this manual is to outline inspection needs and summarize maintenance actions.

## 3. Facility Location

The location map below details the facility location. The highway, mile posts, side streets, access location, and stormwater flow directions are noted on the map. **NOTE: Mile posts are based off of the V-File, and may vary from TransGIS mile posts.**

Facility location type: **On ramp**

Flow direction: [west]

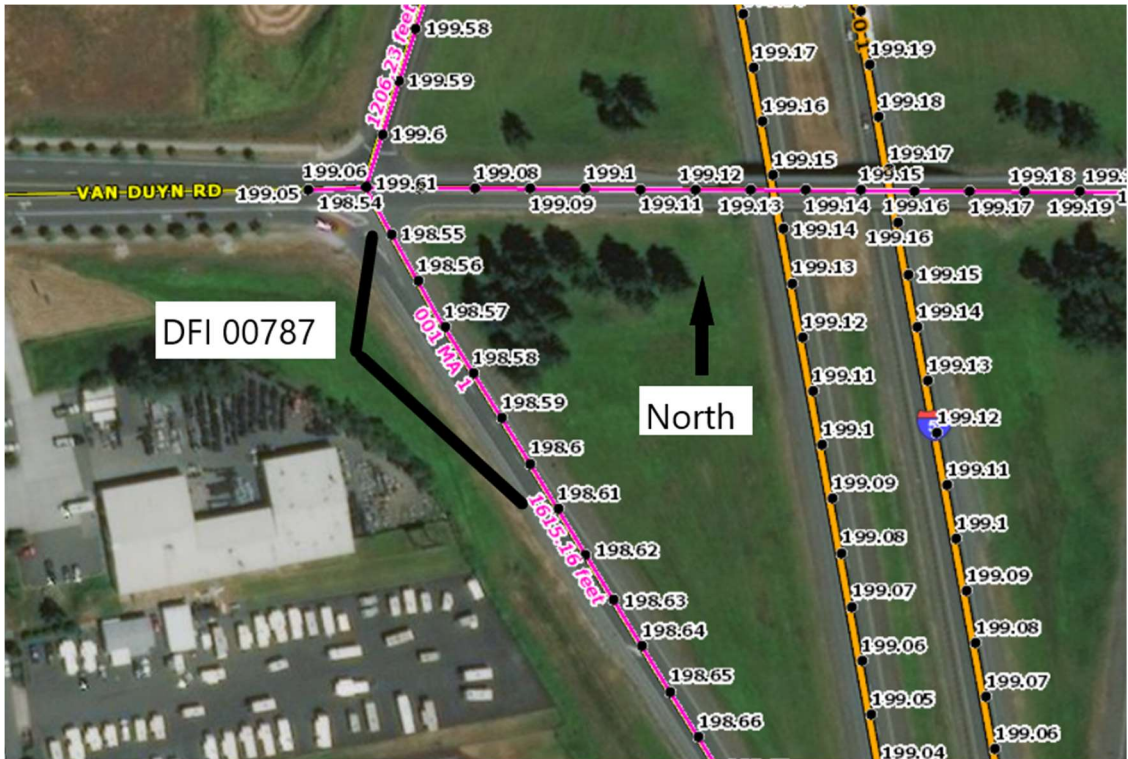



Figure 2: Facility location map

#### 4. Facility Summary

The width is measured perpendicular to the edge of pavement and is equivalent to the flow length. The length is measured parallel to the edge of pavement and is equivalent to the length of the contributing impervious area.

The length and width of the applicable facility components are:

| Component    | Length (feet) | Width (feet) |
|--------------|---------------|--------------|
| Filter Strip | 380           | 8 ft         |

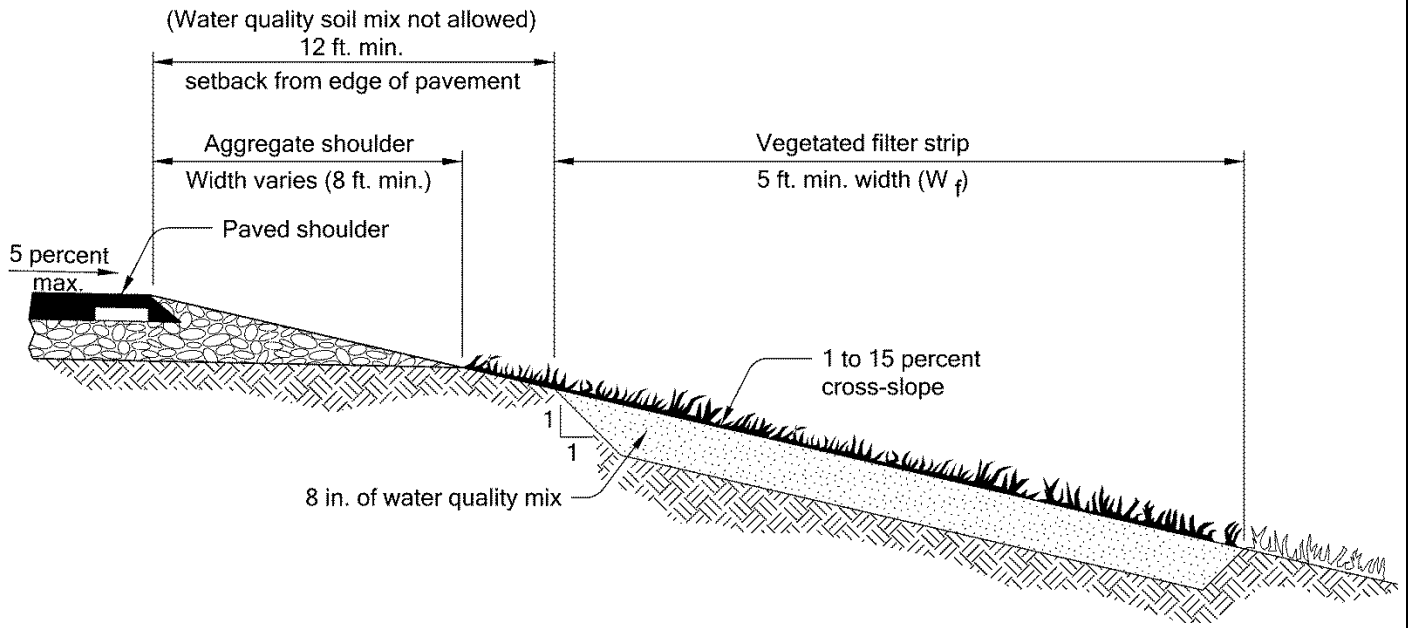

**Figure 3: Filter Strip Section (Typical)**

The slope of the facility is presented by a vertical distance (rise) followed by the horizontal distance (run).

| Side Slope   | Rise (feet) | Run (feet) |
|--------------|-------------|------------|
| Filter Strip | 1           | 6          |

## 5. Facility Access

Maintenance access to the facility:

|  |   |
|--|---|
| <input type="checkbox"/> Roadside pad          | <input checked="" type="checkbox"/> Roadside shoulder |
| <input type="checkbox"/> Access road with Gate | <input type="checkbox"/> Access road without Gate     |

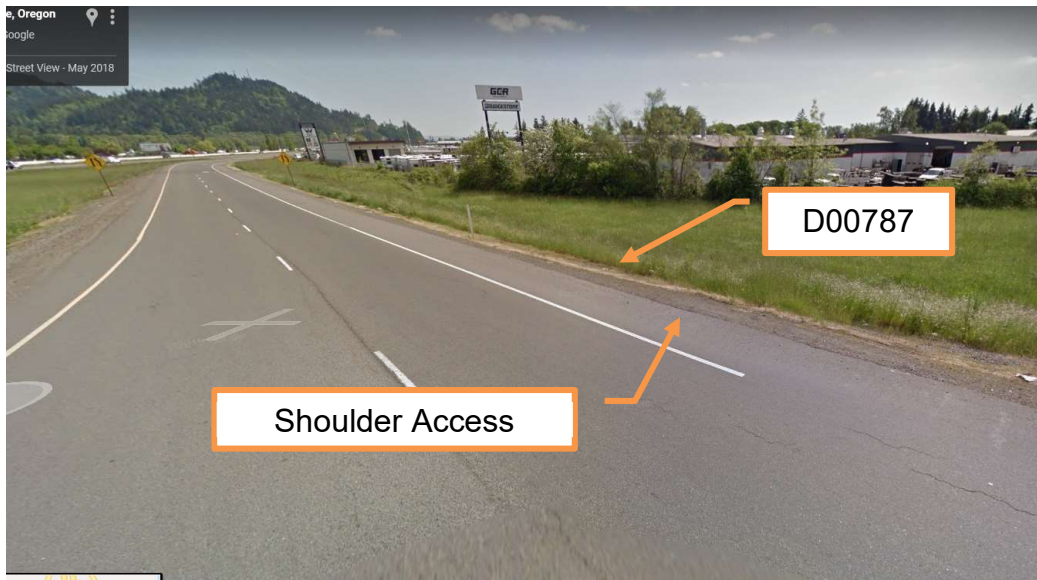


Figure 4: Facility access from right shoulder

## 6. Operational Components / Maintenance Items

### Classification and Standard Operational (Op) Plan:

This facility is classified as a:

|  |  |
|--|--|
| <p style="text-align: center;"><input checked="" type="checkbox"/> <b>Filter Strip</b><br/><b>(Op Plan A)</b></p> <p>A filter strip consists of a vegetated or media slope located parallel to the edge of pavement. It maintains sheet flow of stormwater runoff over the width of the strip.</p> | <p style="text-align: center;"><input type="checkbox"/> <b>Bioslope</b><br/><b>(Op Plan B)</b></p> <p>A bioslope consists of a filter strip and treatment zone. It is a flow-through stormwater treatment facility located along roadside embankments.</p> |
| <p><b>A standard operational plan illustrates the general facility footprint configuration and explains the purpose of each facility component. Operational plans (A, B) are provided in the Standard Operation Manual.</b></p>  |  |

See Appendix A for the site specific operational plan.

### Operational Components

Filter strips and bioslopes have many components that assist with treatment, conveyance, and infiltration of stormwater runoff. The components in use can vary depending on the facility design. The facility components table (Table 1) has been provided to highlight the applicable components for this facility. The component is in use when the box contains an “x” (e.g.  ).

The Standard Operation Manual for Water Quality Filter Strips and Bioslopes (implemented March, 2017) outlines facility operation, typical footprint configuration, and component definitions and details. A link to the manual is attached to the feature marker in TransGIS.

<https://gis.odot.state.or.us/TransGIS/>

## Maintenance Items

Operational components marked in Table 1 should be inspected and maintained according to Section 7. Each facility component is defined and detailed in the Standard Operation Manual using the associated ID number indicated below.

| <b>Table 1: Bioslope/Filter Strip Components</b> |                                     | <b>ID #</b> |
|--|-------------------------------------|-------------|
| <b>Facility Inlet</b>                            |                                     |             |
| Pavement Sheet Flow                              | <input checked="" type="checkbox"/> | <b>B1</b>   |
| Shoulder Aggregate                               | <input checked="" type="checkbox"/> | <b>B2</b>   |
| <b>Ground Cover</b>                              |                                     |             |
| Vegetated Slope                                  | <input checked="" type="checkbox"/> | <b>B3</b>   |
| Aggregate Media Slope                            | <input type="checkbox"/>            | <b>B4</b>   |
| <b>Underground Components</b>                    |                                     |             |
| Water Quality Mix                                | <input checked="" type="checkbox"/> | <b>B5</b>   |
| Ecology Mix                                      | <input type="checkbox"/>            | <b>B6</b>   |
| Granular Drain Backfill Material                 | <input type="checkbox"/>            | <b>B7</b>   |
| Geotextile Fabric                                | <input type="checkbox"/>            | <b>B8</b>   |
| Geocell Grid                                     | <input type="checkbox"/>            | <b>B9</b>   |
| <b>Structures</b>                                |                                     |             |
| Curb/Berm  | <input type="checkbox"/>            | <b>B10</b>  |
| Check Dam  | <input type="checkbox"/>            | <b>B11</b>  |
| Cleanout   | <input type="checkbox"/>            | <b>B12</b>  |
| <b>Facility Outlet</b>                           |                                     |             |
| Perforated Drain Pipe                            | <input type="checkbox"/>            | <b>B13</b>  |
| Open Slope Outlet                                | <input type="checkbox"/>            | <b>B14</b>  |
| Open Channel Outlet                              | <input type="checkbox"/>            | <b>B15</b>  |
| Storm Drain Outlet Pipe                          | <input type="checkbox"/>            | <b>B16</b>  |
| <b>Outfall Type</b>                              |                                     |             |
| Waterbody (Creek/Lake/Ocean)                     | <input type="checkbox"/> <b>C</b>   | <b>B17</b>  |
|  | <input type="checkbox"/> <b>L</b>   |             |
|  | <input type="checkbox"/> <b>O</b>   |             |
| Outfall Channel                                  | <input type="checkbox"/>            | <b>B18</b>  |
| Storm Drain System                               | <input type="checkbox"/>            | <b>B19</b>  |
| <b>Outfall Components</b>                        |                                     |             |
| Pervious Berm                                    | <input type="checkbox"/>            | <b>B20</b>  |
| Riprap Pad                                       | <input type="checkbox"/>            | <b>B21</b>  |

## 7. Maintenance

### Maintenance Frequency/Maintain Records

- a. Inspect annually. Preferably prior to the rainy season.
- b. Clean and maintain as necessary. Refer to Activity 125 for conditions when maintenance is needed.
- c. Keep a record of inspections, maintenance, and repairs.

### Maintenance Guide/Maintenance Actions

The ODOT Routine Road Maintenance Water Quality and Habitat Guide (the *Blue Book*) outlines the standard maintenance actions for water quality facilities under Activity 125.

There are standard maintenance tables for standard ODOT designs. The maintenance tables describe the maintenance component, the defect or problem, the condition when maintenance is needed, and the recommended maintenance to correct the problem. Use the following tables to maintain ODOT filter strips and bioslopes:

- Table 1 (General Maintenance): Contains general maintenance and inspection guidelines that are applicable to all ODOT water quality facilities
- Table 4 (Water Quality Filter Strips)
- Table 5 (Water Quality Bioslopes)

The ODOT Maintenance Guide can be viewed at the following website:

<http://www.oregon.gov/ODOT/HWY/OOM/pages/mguide.aspx>

The *Blue Book* can be viewed at the following website:

[http://www.oregon.gov/ODOT/Maintenance/Documents/blue\\_book.pdf](http://www.oregon.gov/ODOT/Maintenance/Documents/blue_book.pdf)

## 8. Limitations

Filter strips and bioslopes are NOT designed to allow the use of heavy equipment. Vehicles entering the facility can create depressions (tire ruts), damage vegetation, and damage structural components (e.g. flow spreaders). These conditions may result in poor treatment and drainage performance.



## 9. Waste Material Handling

Material removed from the facility is defined as waste by the Department of Environmental Quality (DEQ). Refer to the road waste section of the ODOT Maintenance Yard Environmental Management System (EMS) Policy and Procedures Manual for disposal options:

<http://www.oregon.gov/ODOT/HWY/OOM/pages/ems.aspx>


Contact any of the following for more detailed information about management of waste materials found on site:

|                                   |                |
|-----------------------------------|----------------|
| ODOT Clean Water Unit             | (503) 986-3008 |
| ODOT Statewide Hazmat Coordinator | (503) 667-7442 |
| ODOT Region 1 Hazmat Coordinator  | (503) 731-8290 |
| ODOT Region 2 Hazmat Coordinator  | (503) 986-2647 |
| ODOT Region 3 Hazmat Coordinator  | (541) 957-3594 |
| ODOT Region 4 Hazmat Coordinator  | (541) 388-6186 |
| ODOT Region 5 Hazmat Coordinator  | (541) 963-1590 |
| ODEQ Northwest Region Office      | (503) 229-5263 |

## **A Appendix A – Site Specific Operational Plan**


### **Contents:**

**Operational Plan: DFI D00787**

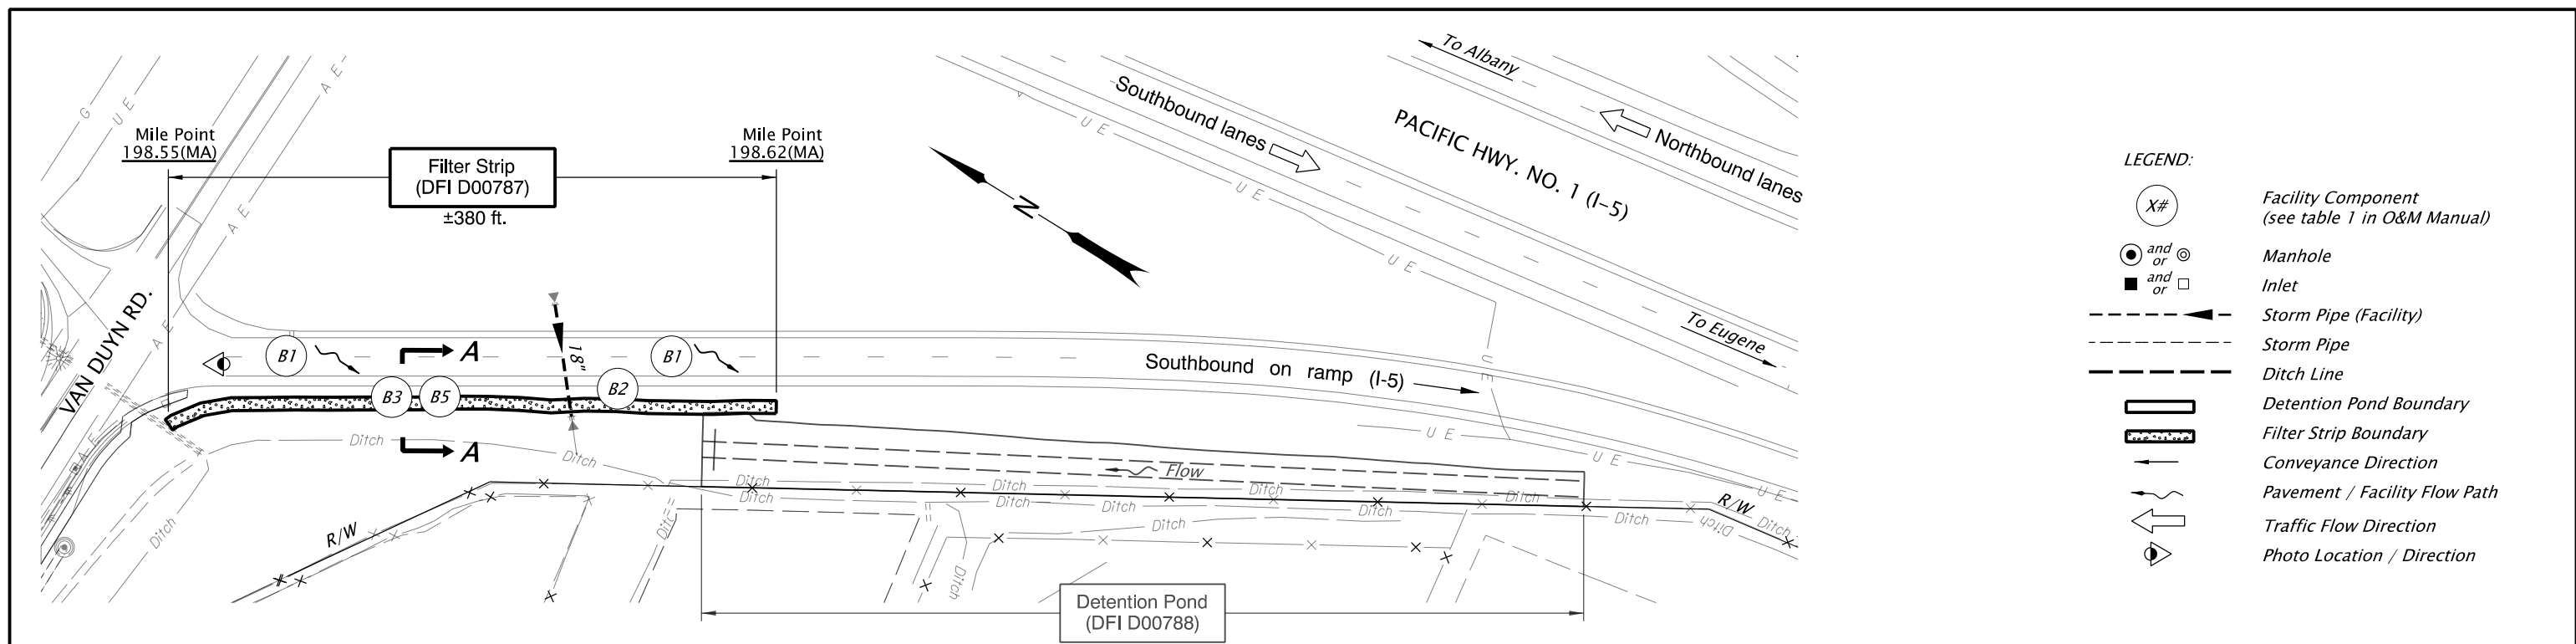

- LEGEND:**
- (X#) Facility Component (see table 1 in O&M Manual)
  - and/or ⊙ Manhole
  - and/or □ Inlet
  - Storm Pipe (Facility)
  - - - Storm Pipe
  - - - Ditch Line
  - ▭ Detention Pond Boundary
  - ▨ Filter Strip Boundary
  - Conveyance Direction
  - ↔ Pavement / Facility Flow Path
  - ↔ Traffic Flow Direction
  - ⊙ Photo Location / Direction

**PLAN**  
N.T.S.

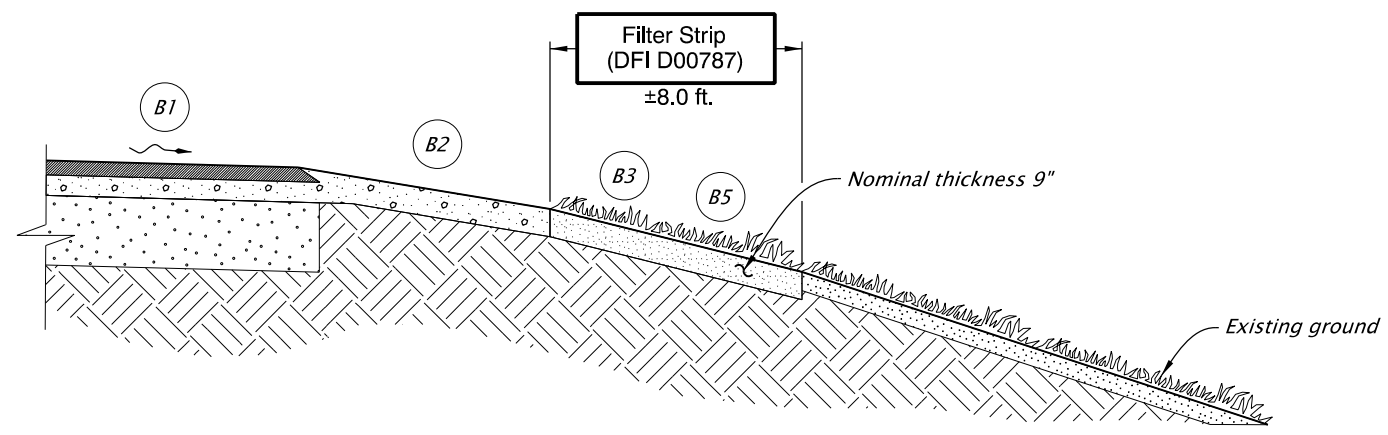

**SECTION A-A**  
N.T.S.



Sht. 1 of 2

Prepared By:  
Christopher Carman

Drafted By:  
Jeff Coon

**DFI D00787**  
**MAINT. DIST. 5 I-5 @ COBURG INTCHG. SEC.**  
**WATER QUALITY FILTER STRIP**  
PACIFIC HIGHWAY MP 198.55(MA)  
LANE COUNTY

## **B Appendix B – Project Contract Plans**

### **Contents:**

**Site Specific Subset of Project Contract Plan 45V-31**

STATE OF OREGON  
DEPARTMENT OF TRANSPORTATION

PLANS FOR PROPOSED PROJECT

GRADING, DRAINAGE, STRUCTURE, PAVING, SIGNING,  
ILLUMINATION, SIGNAL & ROADSIDE DEVELOPMENT


I-5 @ COBURG INTERCHANGE SEC.

PACIFIC HIGHWAY

LANE COUNTY

JUNE 2012

| INDEX OF SHEETS |                         |
|-----------------|-------------------------|
| SHEET NO.       | DESCRIPTION             |
| 1               | Title Sheet             |
| 1A              | Index Of Sheets Cont'd. |
| 1A-2            | Std. Drg. Nos.          |


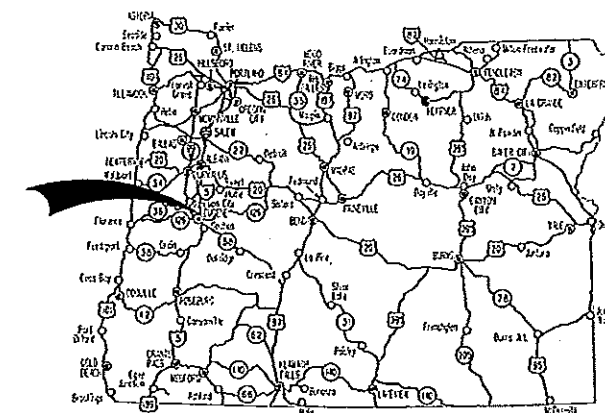


Overall Length Of Project - 0.3 Miles

BEGINNING OF PROJECT  
HPP-S001(395)

STA. "L"24+38 (M.P. 199.1)

**ATTENTION:**  
Oregon Law Requires You To Follow Rules Adopted By The Oregon Utility Notification Center. Those Rules Are Set Forth In OAR 952-001-0010 Through OAR 952-001-0090. You May Obtain Copies Of The Rules By Calling The Center. (Note: The Telephone Number For The Oregon Utility Center Is (503) 232-1987.)

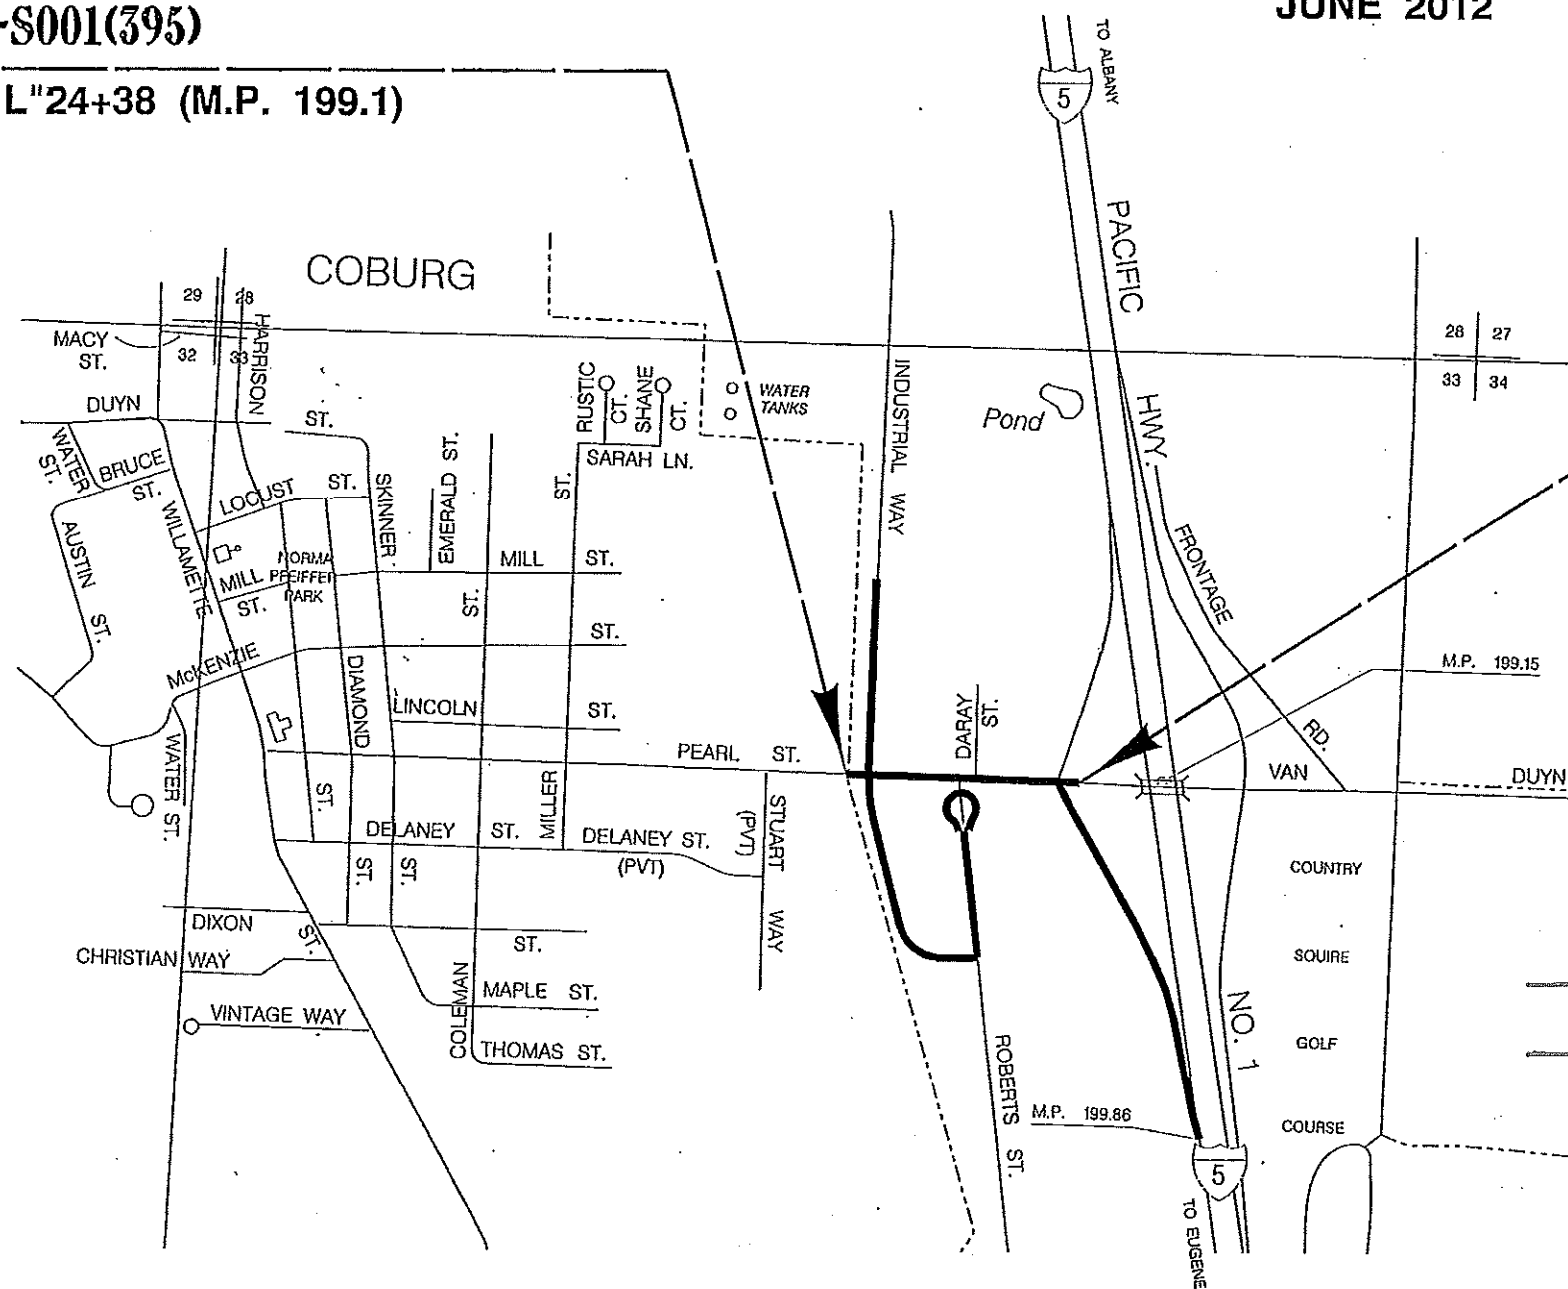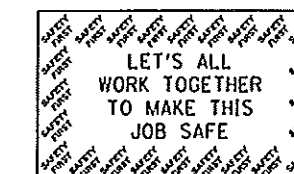

END OF PROJECT  
HPP-S001(395)

STA. "L"34+15 (M.P. 199.4)


REVISED AS CONSTRUCTED

5/29/13

DATE

PROJECT MANAGER

chuck Lemos

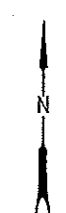

T. 16 S., R. 3 W., W.M.

OREGON TRANSPORTATION COMMISSION

- Pat Egan CHAIR
- David Lohman COMMISSIONER
- Mary F. Olson COMMISSIONER
- Mark Frohnmoyer COMMISSIONER
- Yammy Boney COMMISSIONER
- Matthew L. Garrett DIRECTOR OF TRANSPORTATION

These plans were developed using ODOT design standards. Exceptions to these standards, if any, have been submitted and approved by the ODOT Chief Engineer or their delegated authority.

By: *Carol A. Cartwright* 4/23/12  
Signature & date


Carol A. Cartwright - R2 Tech Center Manager  
Print name and title

*[Signature]*  
Concurrence by ODOT Chief Engineer


I-5 @ COBURG INTERCHANGE SEC.  
PACIFIC HIGHWAY  
LANE COUNTY

|                                |                |           |
|--------------------------------|----------------|-----------|
| FEDERAL HIGHWAY ADMINISTRATION | PROJECT NUMBER | SHEET NO. |
| OREGON DIVISION                | HPP-S001(395)  | 1         |



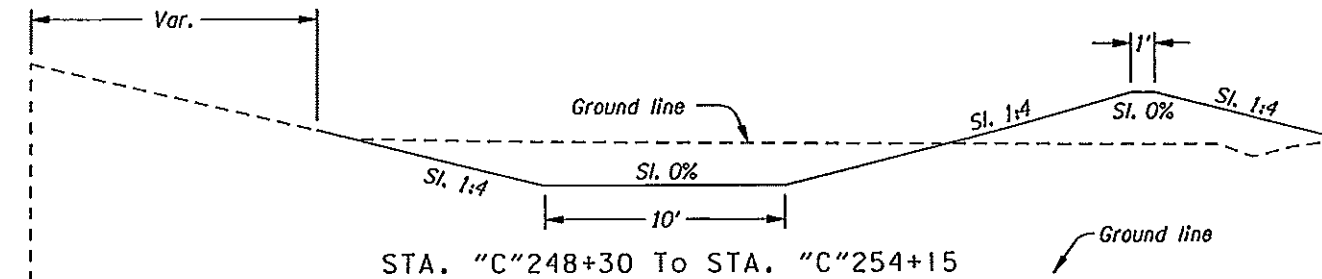

STA. "C"245+16 To STA. "C"249+00

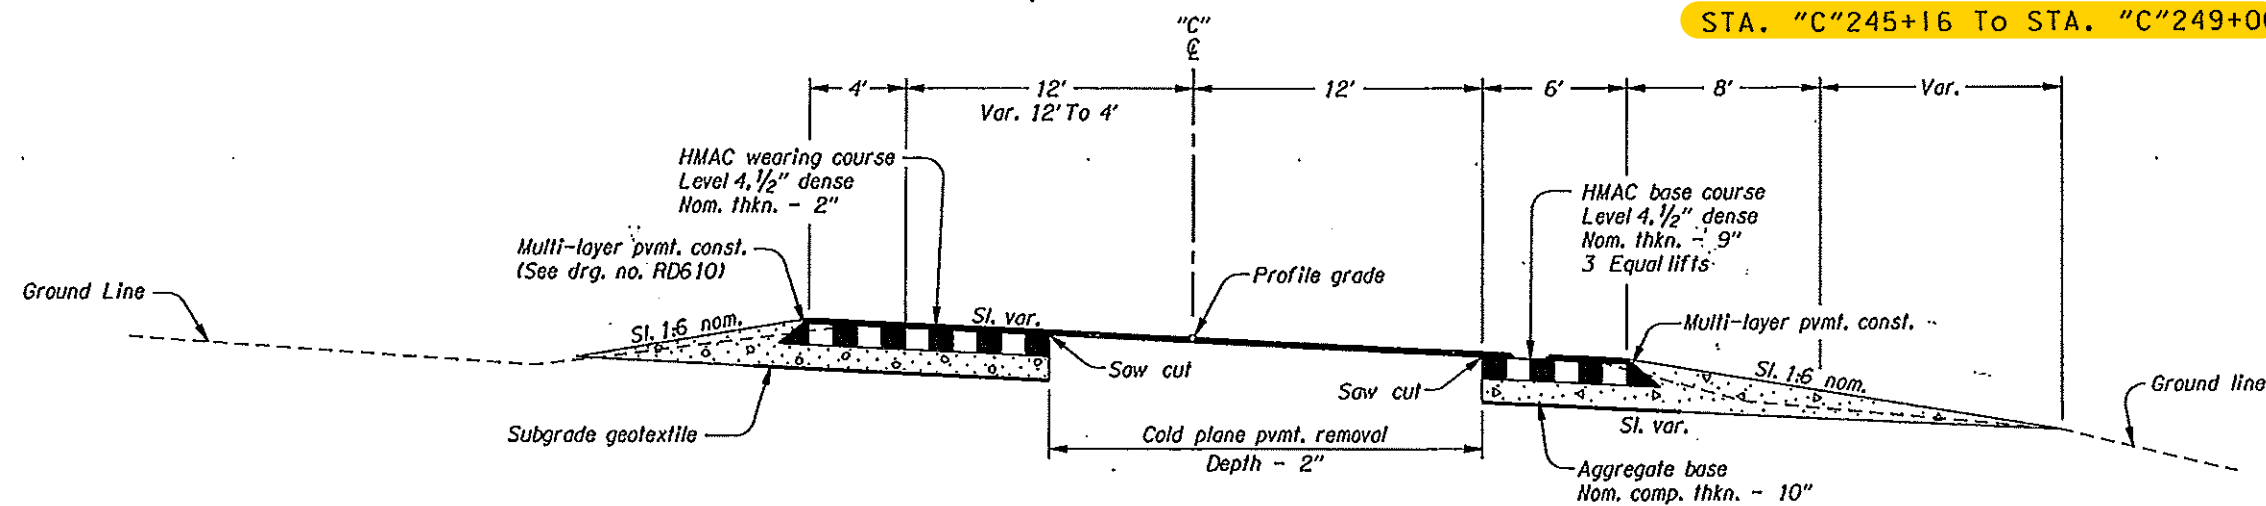

STA. "C"244+16 To STA. "C"254+00  
 "C"254+00 To "C"255+20 (Taper section)

- NOTE:
1. Side-slopes are shown as vert. to horiz.
  2. For standard superelevation, see drg. no. RD140.
  3. For slope rounding, see drg. no. RD150.

**OREGON DEPARTMENT OF TRANSPORTATION**

**REGION 2 TECH CENTER**

**I-5 @ COBURG INTERCHANGE SEC.**  
 PACIFIC HIGHWAY  
 LANE COUNTY

Design Team Leader - Edward W. Contrell  
 Designed By - Chris Bailey  
 Drafted By - D. Gentner-Doy

**TYPICAL SECTIONS**


SHEET NO.  
**2A-7**

REVISED AS CONSTRUCTED

5/29/13

DATE

PROJECT MANAGER

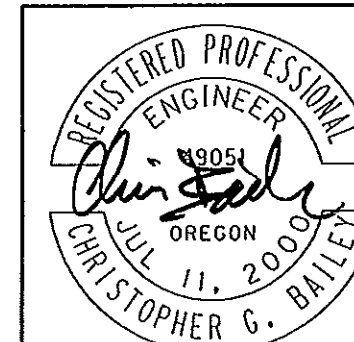

RENEWS: 12-31-2013

Sec. 33, T. 16 S., R. 3 W., W.M.


SEE SHEET 3C-2  
MATCH LINE "A"

"N" LINE  
(For profile, see sht. 3H)


"L" LINE  
(For profile, see shts. 3F & 3G)

BEGINNING OF PROJECT HPP-S001(395)  
STA. "L" 24+38 (M.P. 199.1)

END OF PROJECT HPP-S001(395)  
STA. "L" 34+15 (M.P. 199.4)

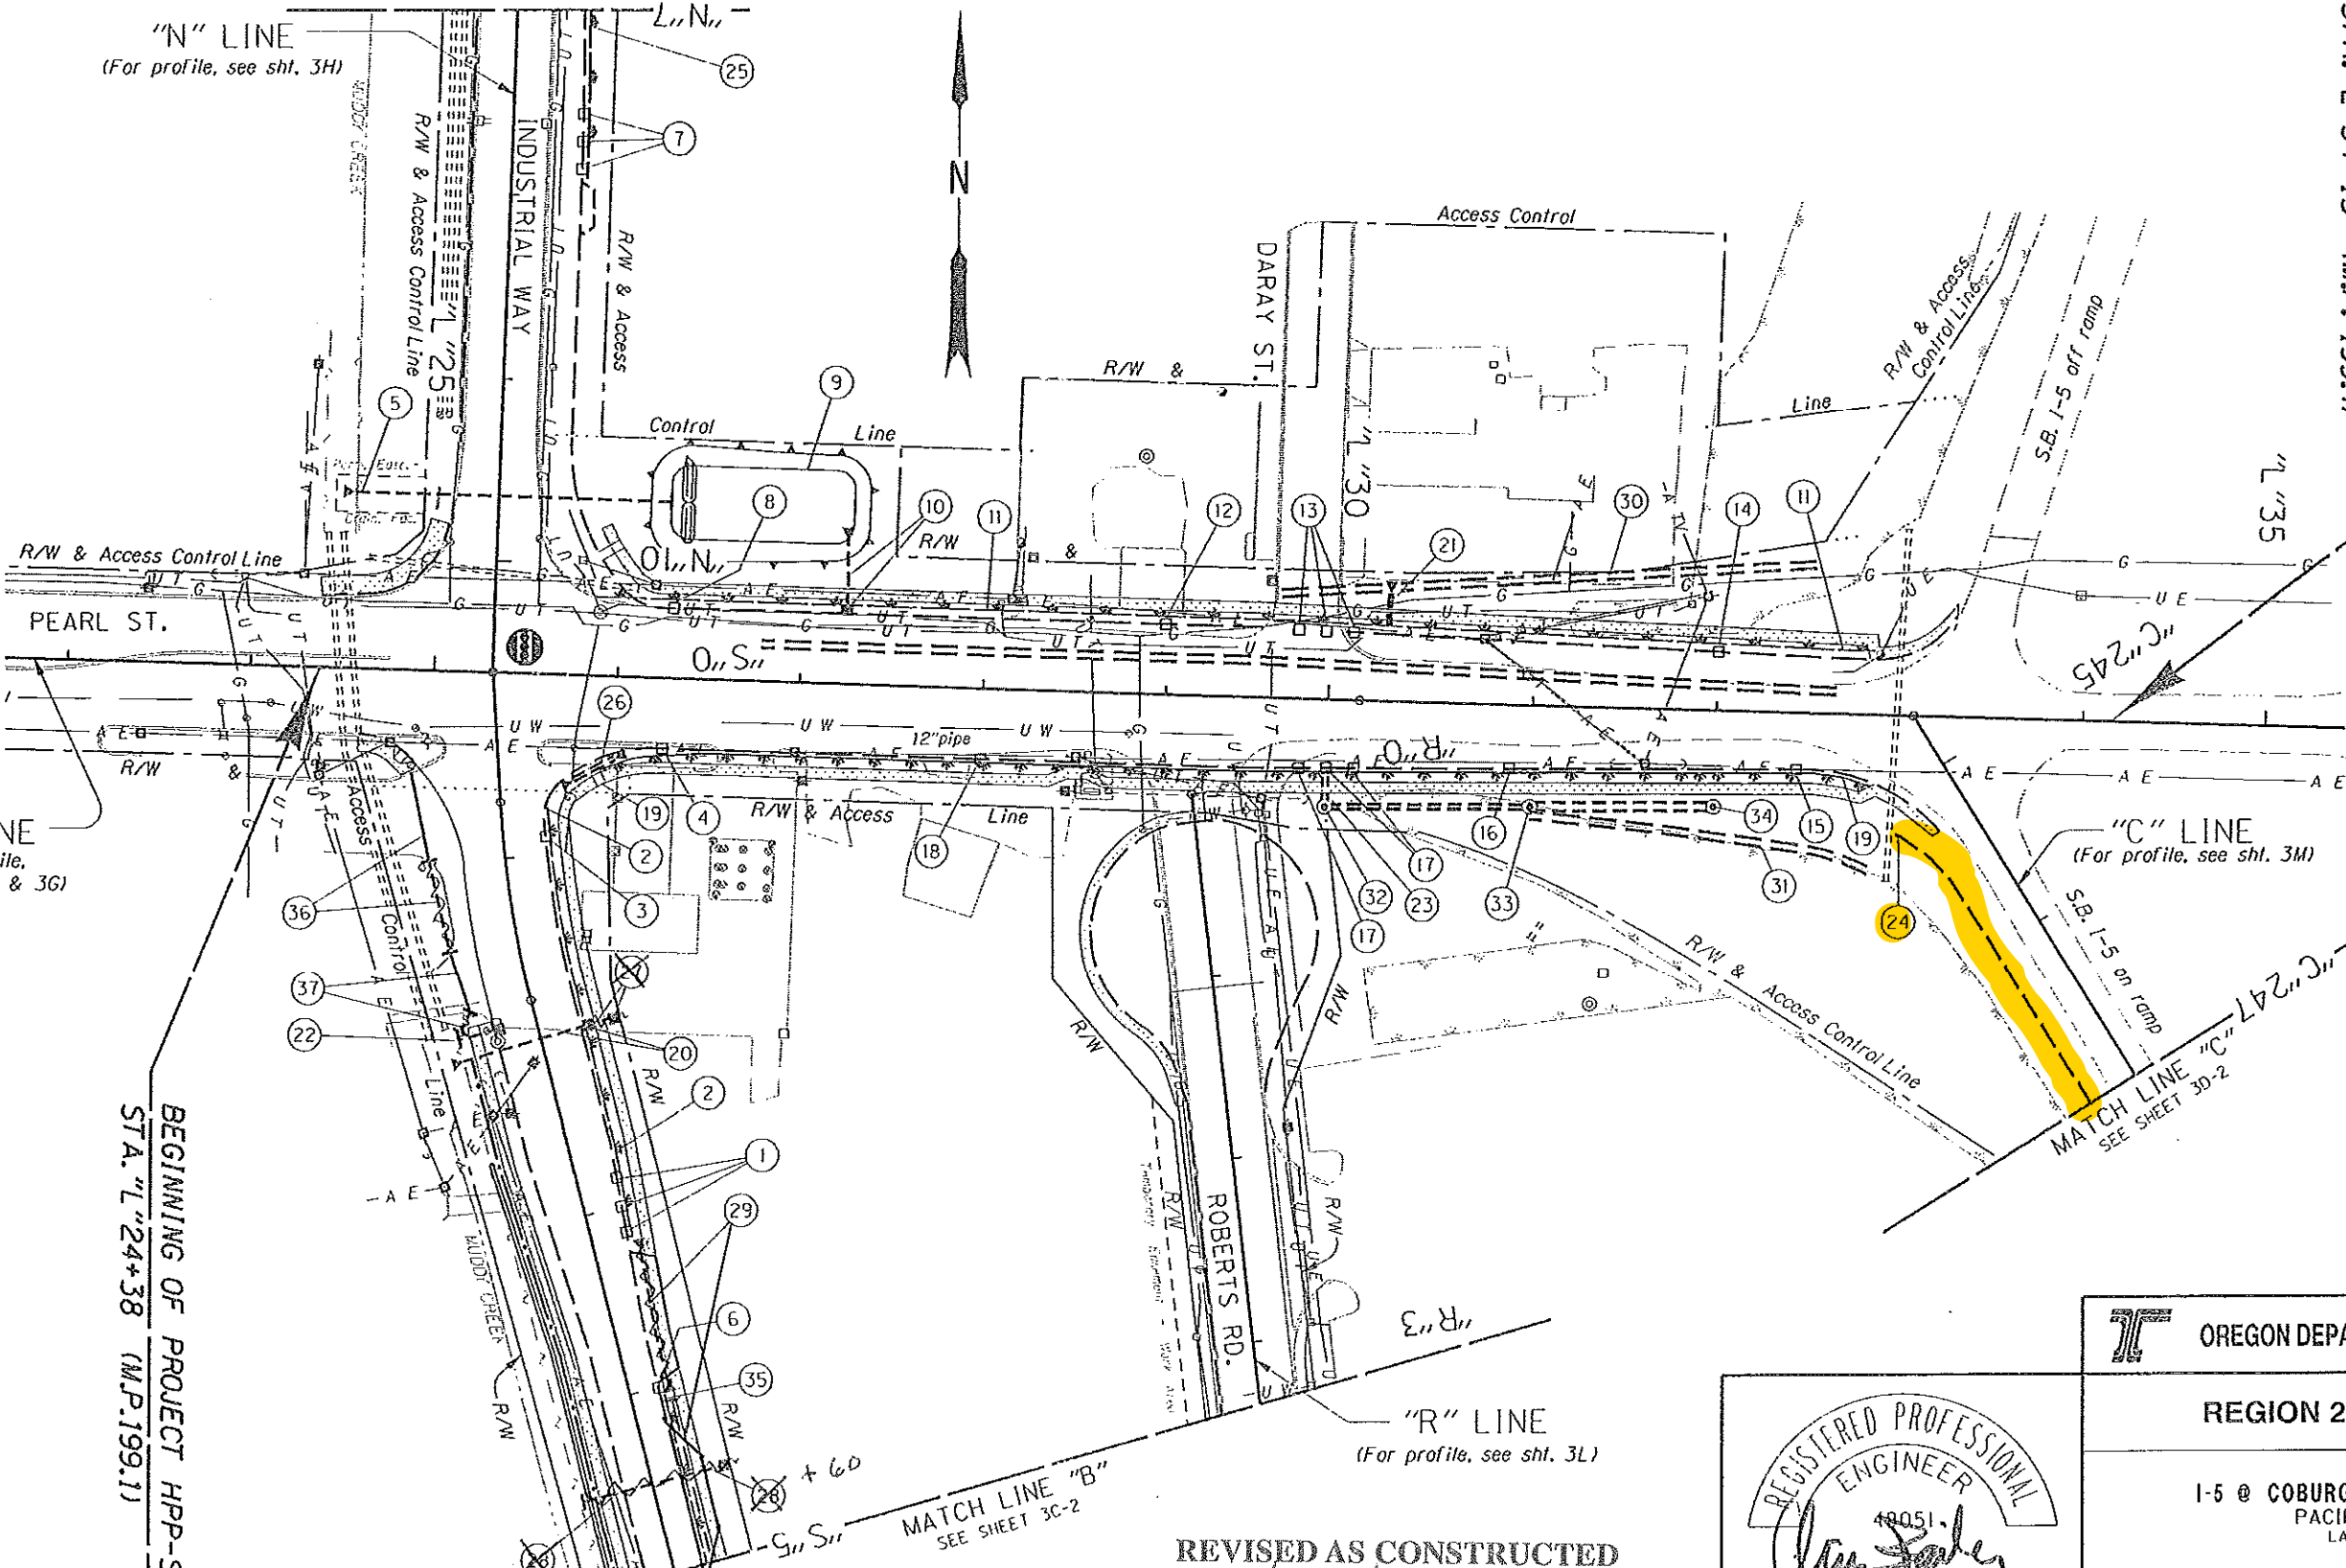

REVISED AS CONSTRUCTED  
 5/29/13  
 DATE  
 PROJECT MANAGER

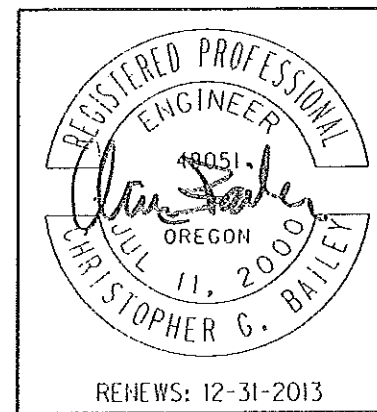

|  |                        |
|--|------------------------|
| OREGON DEPARTMENT OF TRANSPORTATION  |                        |
| REGION 2 TECH CENTER   |                        |
| I-5 @ COBURG INTERCHANGE SEC.<br>PACIFIC HIGHWAY<br>LANE COUNTY                                      |                        |
| Design Team Leader - Edward W. Cantrell<br>Designed By - Chris Bailey<br>Drafted By - D. Gantner-Day |                        |
| <b>DRAINAGE &amp; UTILITIES</b>  | SHEET NO.<br><b>3B</b> |

- ① Sta. "S"2+85 To Sta. "S"3+15, Lt.  
Const. conc. curb, modified opening - 24'  
(For details, see sht. 2B-2)  
(See drg. no. RD720)
- ② Sta. "S"0+57 To Sta. "S"3+31, Lt.  
Const. vegetated swale - 214'  
(For drg. nos., see sht. 1A)
- ③ Sta. "S"0+90, Lt.  
Const. conc. curb, modified opening - 8'  
(For details, see sht. 2B-2)
- ④ Sta. "L"26+25, Rt.  
Const. conc. curb, modified opening - 8'  
(For details, see sht. 2B-2)
- ⑤ Sta. "N"9+65 165'  
Inst. 12" culv. pipe - 169'  
5' depth  
Const. paved end slope, Lt.  
(See drg. no. RD320)
- ⑥ Sta. "S"4+00, Lt.  
Const. conc. curb, modified opening - 8'  
(For details, see sht. 2B-2)
- ⑦ Sta. "N"7+55 To Sta. "N"7+85, Lt.  
Const. conc. curb, modified opening - 24'  
(For details, see sht. 2B-2)
- ⑧ Sta. "L"26+30, Lt.  
Const. conc. curb, modified opening - 8'  
(For details, see sht. 2B-2)
- ⑨ Const. detention pond, Lt.  
(For drg. nos., see sht. 1A)
- ⑩ Sta. "L"27+27, 40.5' Lt.  
Const. type "G2-MA" mod. inlet  
Inst. 12" culv. pipe - 36'  
5' depth  
Const. paved end slope, Lt.  
Modify to conform to swale section  
(For details, see sht. 2B)
- ⑪ Sta. "L"25+87 To Sta. "L"32+86, Lt.  
Const. vegetated swale - 699'  
(For drg. nos., see sht. 1A)
- ⑫ Sta. "L"29+00, Lt.  
Const. conc. curb, modified opening - 8'  
(For details, see sht. 2B-2)
- ⑬ Sta. "L"29+71 To Sta. "L"30+20, Lt.  
Const. conc. curb, modified opening - 24'  
(For details, see sht. 2B-2)
- ⑭ Sta. "L"32+00, Lt.  
Const. conc. curb, modified opening - 8'  
(For details, see sht. 2B-2)
- ⑮ Sta. "L"32+60, Rt.  
Const. conc. curb, modified opening - 8'  
(For details, see sht. 2B-2)
- ⑯ Sta. "L"30+90, Rt.  
Const. conc. curb, modified opening - 8'  
(For details, see sht. 2B-2)
- ⑰ Sta. "L"29+70 To Sta. "L"30+00, Rt.  
Const. conc. curb, modified opening - 24'  
(For details, see sht. 2B-2)
- ⑱ Sta. "L"28+00, Rt.  
Const. conc. curb, modified opening - 8'  
(For details, see sht. 2B-2)
- ⑲ Sta. "L"25+87 To Sta. "L"32+86, Rt.  
Const. vegetated swale - 699'  
(For drg. nos., see sht. 1A)
- ⑳ Sta. "S"2+00, Lt.  
Const. type "G2-MA" mod. inlet  
Inst. 12" culv. pipe - 71'  
5' depth  
Const. paved end slope, Rt. - 37.5 sq. ft.  
Pipe water under sidewalk  
(For details, see sht. 2B)
- ㉑ Sta. "L"30+20, 40.77' Lt.  
Inst. 10" drain pipe - 32' 4 1/2'  
5' Depth  
(Under sidewalk)  
Const. paved end slope, Lt.  
(For details, see sht. 2B-3 & 2B-4)
- ㉒ Sta. "S"1+85.13, 14' Rt.  
Const. type "G-2" inlet  
Inst. 12" culv. pipe - 21'  
5' Depth  
(See drg. no. RD364)
- ㉓ Sta. "L"29+88, Rt.  
Inst. 10" drain pipe - 32'  
5' Depth  
(Under sidewalk)  
Const. paved end slope, Rt.  
(For details, see sht. 2B-3 & 2B-4)
- ㉔ Sta. "C"245+16 To Sta. "C"249+00, Rt.  
Const. bio-slope - 87 cu. yd.  
(For drg. nos., see sht. 1A)
- ㉕ Sta. "N"2+50 To Sta. "N"7+90, Lt.  
Const. vegetated swale - 540'  
(For drg. nos., see sht. 1A)
- ㉖ Sta. "L"25+88, Rt. 26'  
Inst. 10" drain pipe - 24'  
5' Depth  
(Under sidewalk ramp)  
Const. paved end slope, Lt. & Rt.  
(For details, see shts. 2B, 2B-3 & 2B-4)
- ㉗ Sta. "S"2+00, Lt.  
Const. type "G2-MA" mod. inlet  
Inst. 12" culv. pipe - 15'  
5' depth  
(For details, see sht. 2B)
- ㉘ Sta. "S"4+50  
Const. type "G2-MA" mod. inlet  
Inst. 12" culv. pipe - 81'  
5' depth  
(For details, see sht. 2B)
- ㉙ Sta. "S"3+31 To Sta. "S"3+95, Lt.  
Inst. 10" drain pipe - 156' 2x0'  
5' depth  
(Under driveway)  
Const. paved end slope, Lt. & Rt.  
(For details, see shts. 2B-3 & 2B-4)
- ㉚ Sta. "L"29+61 To Sta. "L"32+54, Lt.  
Const. "V" bottom ditch - 293'  
(For details, see sht. 2B)
- ㉛ Sta. "L"31+00 To Sta. "L"32+94, Rt.  
Const. "V" bottom ditch  
(For details, see sht. 2B)
- ㉜ Sta. "L"29+88, 58' Rt.  
Construct large manhole  
Inst. 10" drain pipe - 224'  
(For details, see sht. GJ-4)  
(See drg. no. RD346)
- ㉝ Sta. "L"31+00, 54.85' Rt.  
Construct large manhole  
Inst. 36" drain pipe - 200'  
(For details, see sht. GJ-4)
- ㉞ Sta. "L"32+00, 52' Rt.  
Construct large manhole  
(For details, see sht. GJ-4)
- ㉟ Sta. "S"3+95 To Sta. "S"5+45, Lt.  
Const. vegetated swale - 150'  
(For details, see sht. 2B-2)
- ㊱ Sta. "S"0+50 To Sta. "S"0+97.8, Rt.  
Const. trench drain - 48'  
Connect with 4" P.V.C. pipe - 47'  
(For details, see sht. 2B-5)
- ㊲ Sta. "S"1+44.4 To Sta. "S"1+76, Rt.  
Const. trench drain - 32' 3/4'  
Outfall 4" P.V.C. pipe - 12' 8'  
(For details, see sht. 2B-5)

VALLEY  
GUTTER

CONNECT  
TO INLET

REVISED AS CONSTRUCTED  
5/29/13  
DATE  
PROJECT MANAGER




RENEWS: 12-31-2013

|  |                          |
|--|--------------------------|
| OREGON DEPARTMENT OF TRANSPORTATION  |                          |
| REGION 2 TECH CENTER   |                          |
| 1-5 @ COBURG INTERCHANGE SEC.<br>PACIFIC HIGHWAY<br>LANE COUNTY                                      |                          |
| Design Team Leader - Edward W. Contrell<br>Designed By - Chris Bailey<br>Drafted By - D. Gentner-Day |                          |
| <b>DRAINAGE NOTES</b>  | SHEET NO.<br><b>3B-2</b> |




Sec. 33, T. 16 S., R. 3 W., W.M.

45V-31

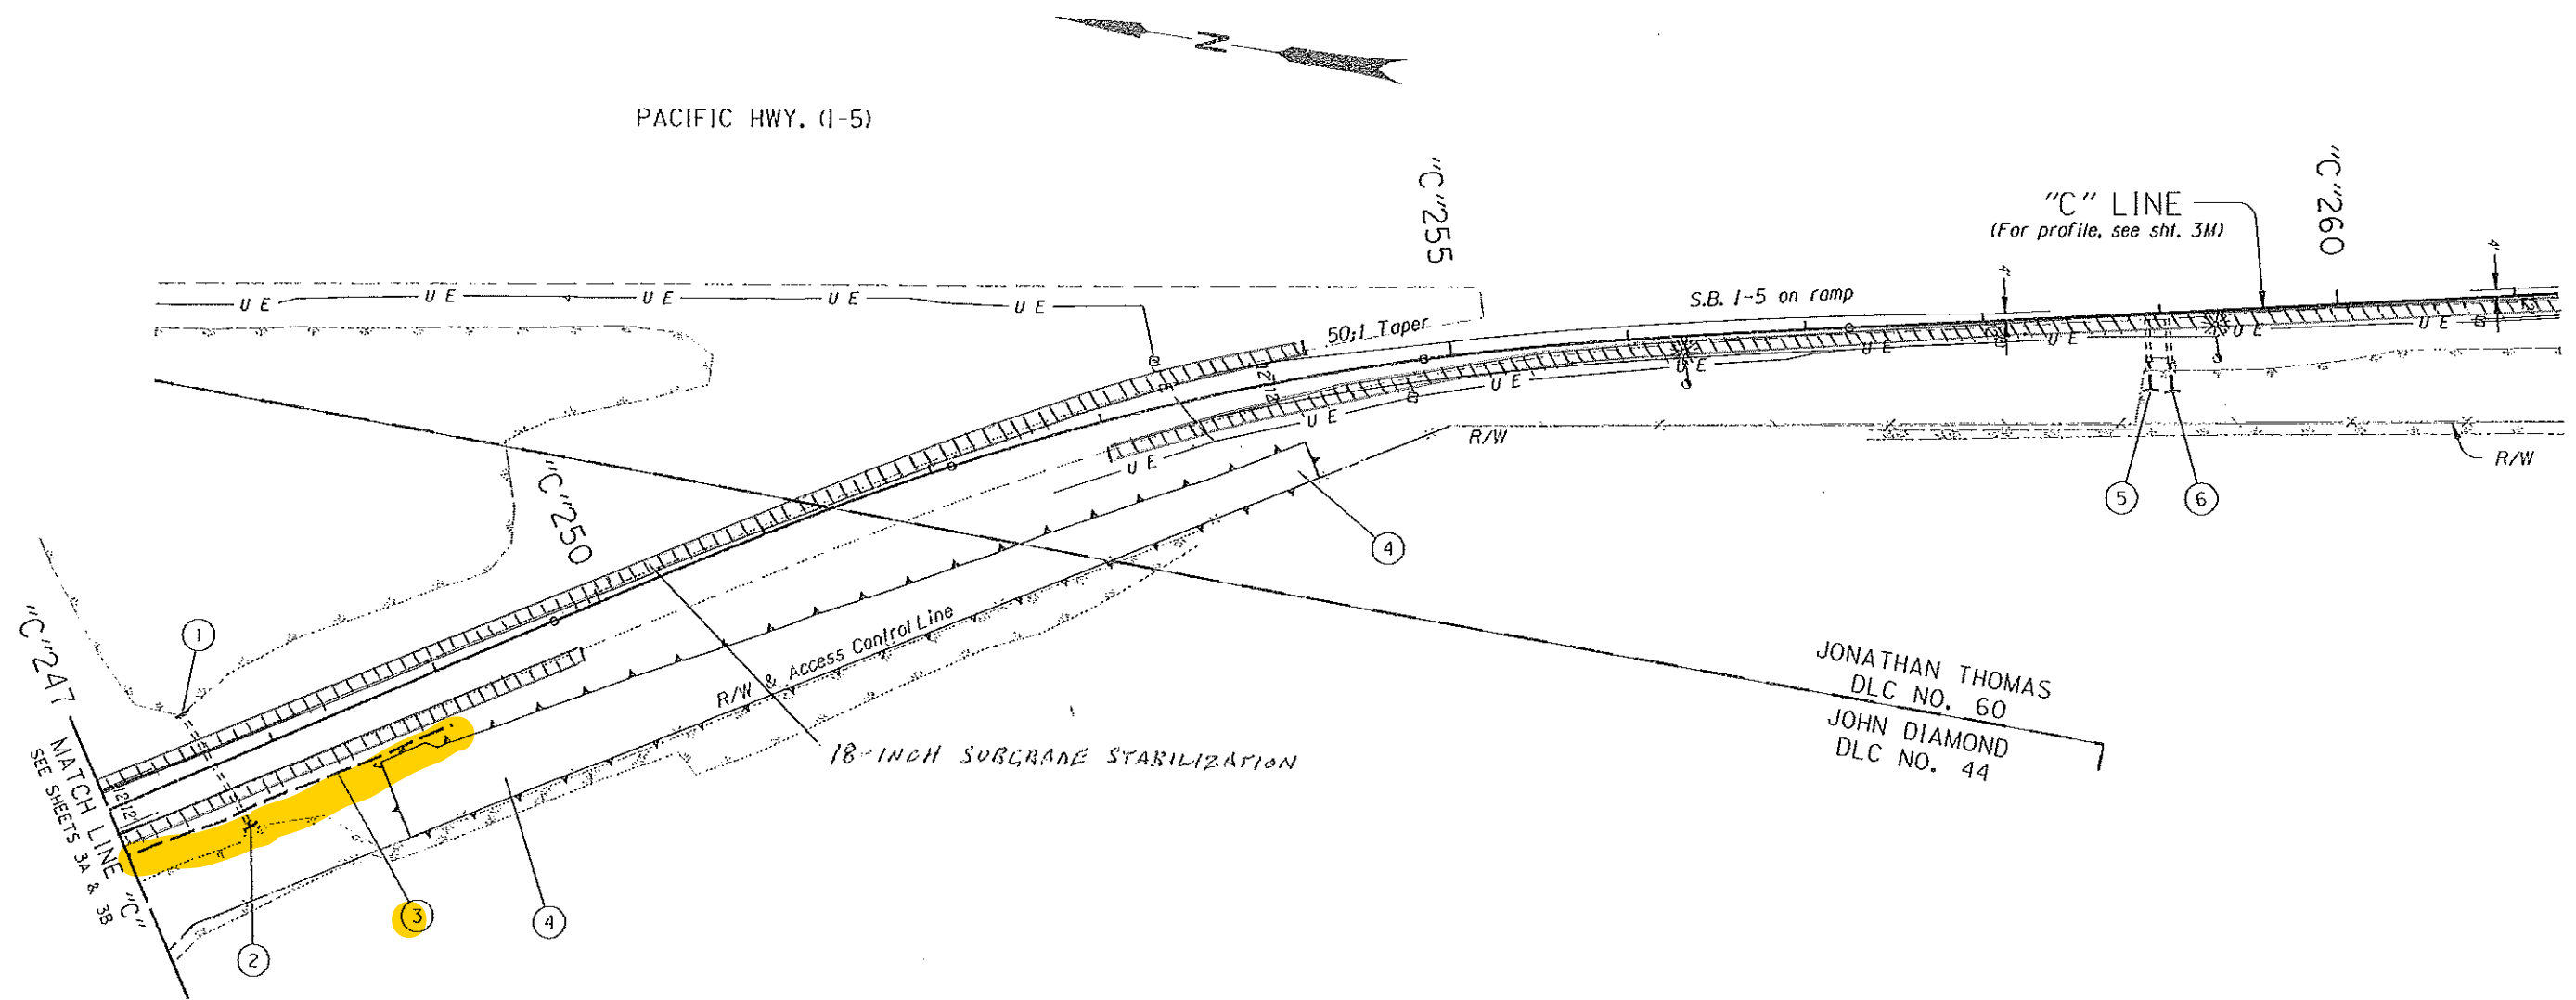

JONATHAN THOMAS  
DLC NO. 60  
JOHN DIAMOND  
DLC NO. 44


REVISED AS CONSTRUCTED  
5/29/13  
DATE  
*[Signature]*  
PROJECT MANAGER

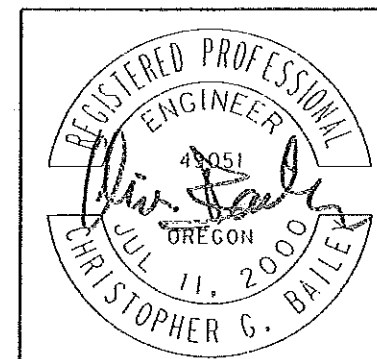


RENEWS: 12-31-2013


|  |                   |
|--|-------------------|
| OREGON DEPARTMENT OF TRANSPORTATION  |                   |
| REGION 2 TECH CENTER   |                   |
| I-5 @ COBURG INTERCHANGE SEC.<br>PACIFIC HIGHWAY<br>LANE COUNTY                                      |                   |
| Design Team Leader - Edward W. Cantrell<br>Designed By - Chris Bailey<br>Drafted By - D. Gentner-Day |                   |
| GENERAL CONSTRUCTION   | SHEET NO.<br>3D-2 |

- ① Sta. "C"247+59.10, Lt.  
Extg. 18" conc. pipe - 70.4' (In pl.)  
Extend - 4.5', 5' Depth 1.5'  
(See drg. no. RD318)
- ② Sta. "C"247+69.31, Rt.  
Extg. 18" conc. pipe - 70.4' (In pl.)  
Extend - 2.5', 5' Depth 2.2.5'
- ③ See sht. 3B-2, note 24  
Const. bio-slope
- ④ Sta. "C"248+30 To Sta. "C"254+15, Rt.  
Const. 10' wide detention pond  
(For drg. nos., see sht. 1A)
- ⑤ Sta. "C"258+92.98, Rt.  
Extg. 24" conc. pipe - 232' (In pl.)  
Extend - 16', 5' Depth 1.5'
- ⑥ Sta. "C"259+04.81, Rt.  
Extg. 24" conc. pipe - 232' (In pl.)  
Extend - 16', 5' Depth 1.5'

REVISED AS CONSTRUCTED  
5/29/13  
 DATE  
  
 PROJECT MANAGER

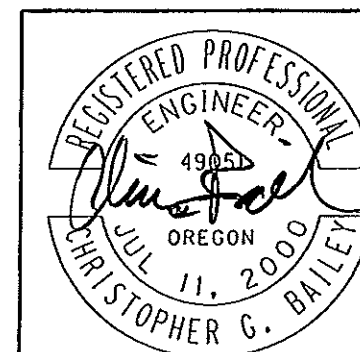

RENEWS: 12-31-2013

|   |                   |
|---|-------------------|
|  OREGON DEPARTMENT OF TRANSPORTATION |                   |
| REGION 2 TECH CENTER  |                   |
| I-5 @ COBURG INTERCHANGE SEC.<br>PACIFIC HIGHWAY<br>LANE COUNTY   |                   |
| Design Team Leader - Edward W. Contrell<br>Designed By - Chris Bailey<br>Drafted By - D. Gentner-Day                      |                   |
| CONSTRUCTION NOTES  | SHEET NO.<br>3D-3 |