

OPERATION & MAINTENANCE MANUAL

Detention Pond

Manual prepared: May, 2019

DFI No. **D00788**



Figure 1: DFI No. D00788, looking [south]

1. Identification

Drainage Facility ID (DFI):	D00788
Facility Type:	Detention Pond
Construction Drawings:	(V-File Numbers) 45V-31
Location:	District: 5
	Highway No.: 1
	Mile Post: 198.61 to 198.71, [right]

2. Manual Purpose

The purpose of this manual is to outline inspection needs and summarize maintenance actions for stormwater ponds.

3. Facility Location

The location map below details the facility location. The highway, mile posts, side streets, access location, and stormwater flow directions are noted on the map.

Facility location type: Roadway shoulder

Flow direction: [north]

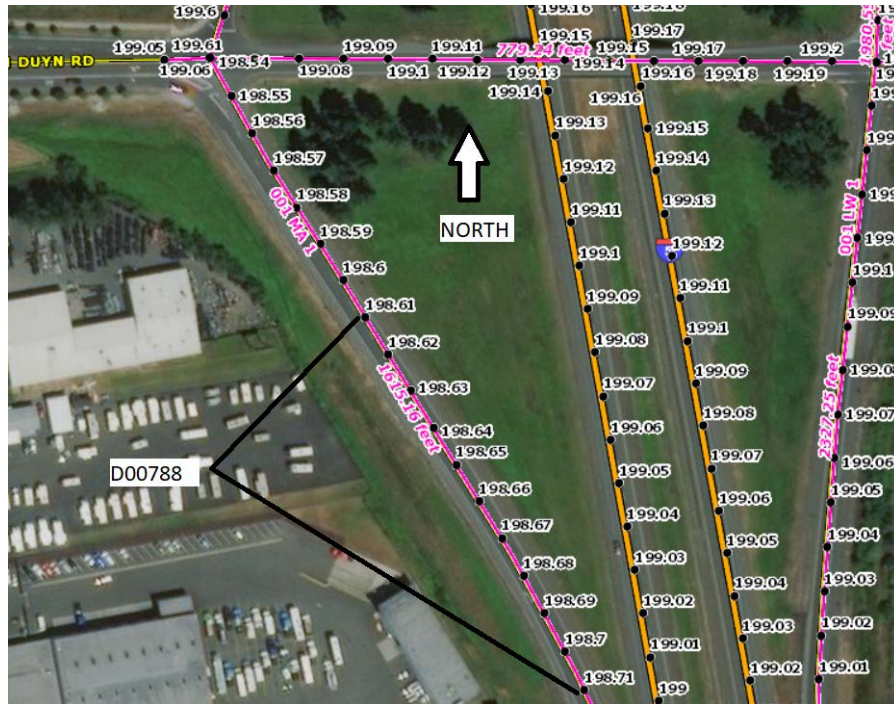


Figure 2: Facility location map

4. Facility Summary


The pond size is based on storage volume, the bottom and top surface areas and the depth are used for this measurement.

The bottom area and top area of the pond is:

Bottom Area (sq. ft.)	Top Area (sq. ft.)
5,850	15,210

The slope of the pond sides is presented by a vertical distance (rise) followed by the horizontal distance (run).


Depth and side slopes:

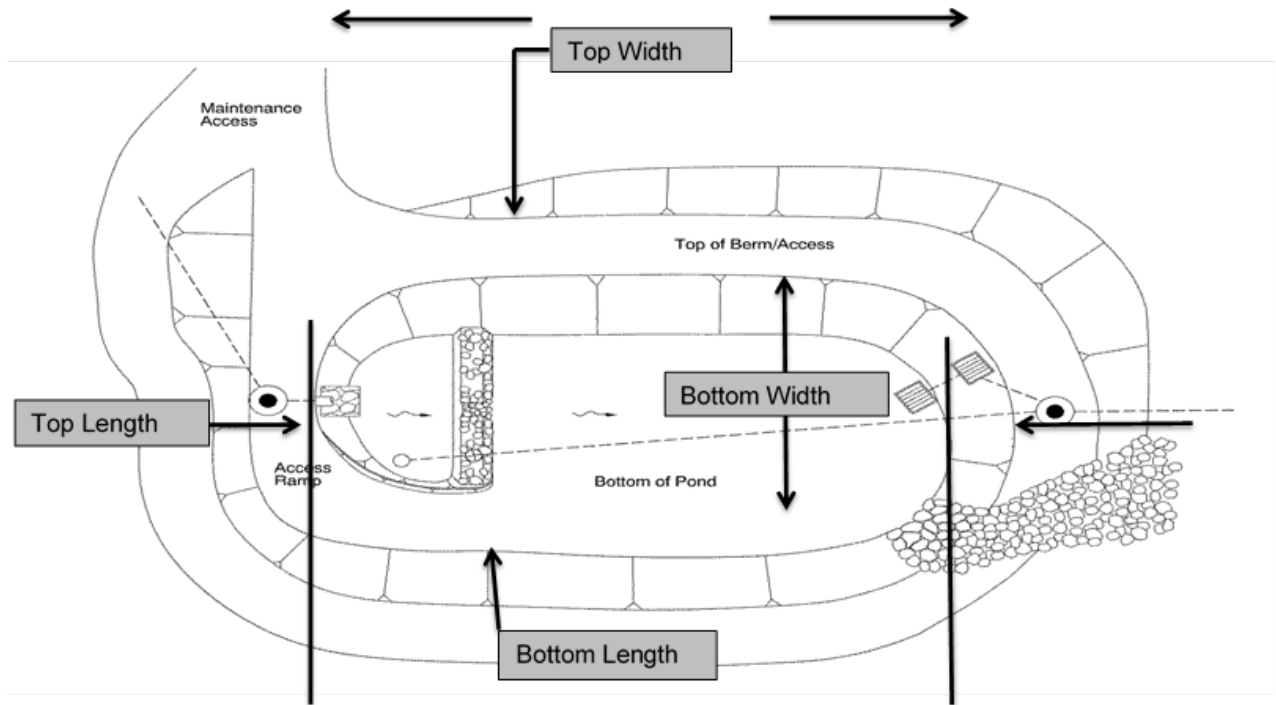

Depth (feet)	
2	

Side Slope	
Rise (feet)	1
Run (feet)	4

Site Specific Information: Water in pond restricted from leaving by steel plate and 4” diameter orifice.

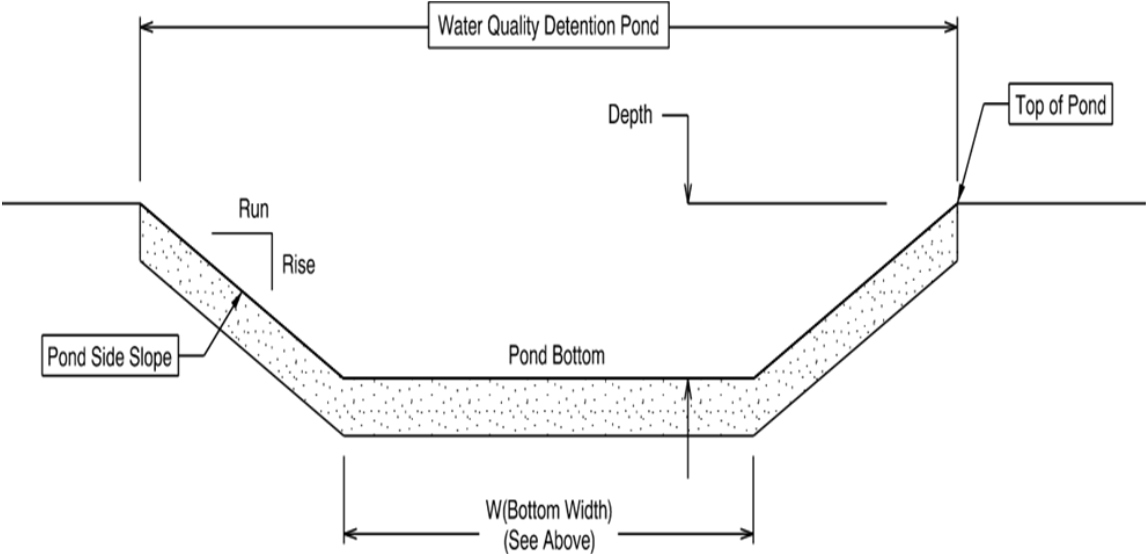

5. Facility Access

Maintenance access to the facility:

<input type="checkbox"/> Roadside pad	<input checked="" type="checkbox"/> Roadside shoulder
<input type="checkbox"/> Access road with Gate	<input type="checkbox"/> Access road without Gate



Figure 2: [shoulder access]

6. Operational Components / Maintenance Items

Classification and Standard Operational (Op) Plan:

This facility is classified as a:

<input checked="" type="checkbox"/> Detention Pond (Op Plan A)	<input type="checkbox"/> WQ Bioretention Pond (Op Plan B)	<input type="checkbox"/> WQ Extended Detention Dry Pond (Op Plan C)	<input type="checkbox"/> WQ Detention Pond/Biofiltration Swale Combo (Op Plan D)
A standard operational plan illustrates the general facility footprint configuration and explains the purpose of each facility component. Operational plans (A,B,C,D) are provided in the Standard Operation Manual.			

See Appendix A for the site specific operational plan.

Key Features/Items:

This facility is classified as a:

<input checked="" type="checkbox"/> Dry Pond	<input type="checkbox"/> Wet Pond
The pond is wet during storm events and dries during periods of no precipitation.	The pond has constant presence of water year round. A portion of the pond dries during periods of no precipitation.

This facility includes a **high flow bypass component**:

<input checked="" type="checkbox"/> No	<input type="checkbox"/> Yes
There is no bypass component. High flows drains into and through the facility	There is a bypass component. Only low/small flows drain into the pond. High flows are diverted around the pond using a bypass component

This facility includes a **proprietary structure(s)**:

<input checked="" type="checkbox"/> No	<input type="checkbox"/> Yes (DXXXXX)
There are no proprietary structures associated with this facility.	A proprietary structure is used in the operation of this facility. The proprietary structure is a/an: describe

Operational Components

The facility components table (**Table 1**) has been provided to highlight the applicable components for this facility. The component is in use when the box contains an “x” (e.g.).

The Standard Operation Manual for Ponds (implemented March, 2017) outlines facility operation, typical footprint configuration, and component definitions and details. A link to the manual is attached to the feature marker in TransGIS.

<https://gis.odot.state.or.us/TransGIS/>

Maintenance Items

Operational components marked in **Table 1** should be inspected and maintained according to Section 7. Each facility component is defined and detailed in the Standard Operation Manual using the associated ID number indicated in the table below.

Table 1: Stormwater Pond Components		ID #
Upstream Manholes/Structures		
Pre-treatment Manhole Type: N/A	<input type="checkbox"/>	P1
Water Quality Manhole Type: N/A	<input type="checkbox"/>	P2
Flow Splitter Manhole N/A	<input type="checkbox"/>	P3
Standard Manhole	<input type="checkbox"/>	P4
Sediment Basin/Forebay	<input type="checkbox"/>	P5
Forebay Dewatering Riser Pipe (outlet)	<input type="checkbox"/>	P6
Facility Inlet		
Pavement Sheet Flow	<input checked="" type="checkbox"/>	P7
Inlet Pipe(s)	<input type="checkbox"/>	P8
Open Channel Inlet	<input checked="" type="checkbox"/>	P9
Riprap Pad (Energy Dissipater)	<input type="checkbox"/>	P10
Ground Cover		
Grass Bottom	<input checked="" type="checkbox"/>	P11
Grass Side Slopes	<input checked="" type="checkbox"/>	P12
Granular Drain Rock	<input type="checkbox"/>	P13
Plantings	<input type="checkbox"/>	P14
Underground Components		
Geotextile Fabric: N/A	<input type="checkbox"/>	P15
Impermeable Liner	<input type="checkbox"/>	P16
Water Quality Mix	<input type="checkbox"/>	P17
Perforated Pipe	<input type="checkbox"/>	P18
Bottom Marker (ex. Porous Pavers)	<input type="checkbox"/>	P19

Flow Spreader		
Anchored Board (midpoint of pond or every 50 feet along pond bottom)	<input type="checkbox"/>	P20
Other: N/A	<input type="checkbox"/>	P21
Facility Outlet		
Catch Basin with Grate	<input type="checkbox"/>	P22
Outlet Pipe(s)	<input type="checkbox"/>	P23
Outlet/Flow Control Structure	<input checked="" type="checkbox"/>	P24
Auxiliary Outlet	<input type="checkbox"/>	P25
Hazmat Control Valve: N/A	<input type="checkbox"/>	P26
Outfall Type		
Waterbody (Creek/Lake/Ocean)	<input type="checkbox"/> C	P27
	<input type="checkbox"/> L	
	<input type="checkbox"/> O	
Ditch	<input type="checkbox"/>	P28
Storm Drain System	<input type="checkbox"/>	P29
Outfall Components		
Riprap Pad	<input type="checkbox"/>	P30
Riprap Bank Protection	<input type="checkbox"/>	P31

7. Maintenance

Maintenance Frequency/Maintain Records

- a. Inspect annually. Preferably prior to the rainy season.
- b. Clean and maintain as necessary. Refer to Activity 125 in the Maintenance Guide for conditions when maintenance is needed.
- c. Keep a record of inspections, maintenance, and repairs.

Maintenance Guide/Maintenance Actions

The Maintenance Guide outlines the standard maintenance actions for water quality facilities under Activity 125.

There are standard maintenance tables for standard ODOT designs. The maintenance tables describe the maintenance component, the defect or problem, the condition when maintenance is needed, and the recommended maintenance to correct the problem. Use the following tables to maintain ODOT Ponds:

- Table 1 (General Maintenance): Contains general maintenance and inspection guidelines that are applicable to all ODOT water quality facilities
- Table 2 (Maintenance of Stormwater Ponds): Contains maintenance information for ponds

The ODOT Maintenance Guide can be viewed at the following website:
<http://www.oregon.gov/ODOT/HWY/OOM/pages/mguide.aspx>

The Blue Book can be viewed at the following website:
http://www.oregon.gov/ODOT/Maintenance/Documents/blue_book.pdf

8. Limitations

There are access limitations for this facility:

<input checked="" type="checkbox"/> No	<input type="checkbox"/> Yes
There are no duty porous pavers installed in this pond.	

Ponds are designed to allow equipment access along the bottom if an access grid is installed. If an access grid is NOT installed, vehicles entering the pond can create depressions (tire ruts), damage vegetation, or damage structural components (e.g. flow spreaders). These conditions may result in poor treatment and drainage performance.

If no access grid then: Equipment wheels should be kept on the tops and side slopes. Mower arms may be run along the pond bottom.

9. Waste Material Handling

Material removed from the facility is defined as waste by the Department of Environmental Quality (DEQ). Refer to the road waste section of the ODOT Maintenance Yard Environmental Management System (EMS) Policy and Procedures Manual for disposal options:

<http://www.oregon.gov/ODOT/HWY/OOM/pages/ems.aspx>


Contact any of the following for more detailed information about management of waste materials found on site:

ODOT Clean Water Unit	(503) 986-3008
ODOT Statewide Hazmat Coordinator	(503) 667-7442
ODOT Region 1 Hazmat Coordinator	(503) 731-8290
ODOT Region 2 Hazmat Coordinator	(503) 986-2647
ODOT Region 3 Hazmat Coordinator	(541) 957-3594
ODOT Region 4 Hazmat Coordinator	(541) 388-6186
ODOT Region 5 Hazmat Coordinator	(541) 963-1590
ODEQ Northwest Region Office	(503) 229-5263

A Appendix A – Site Specific Operational Plan


Contents:

Operational Plan: DFI D00788

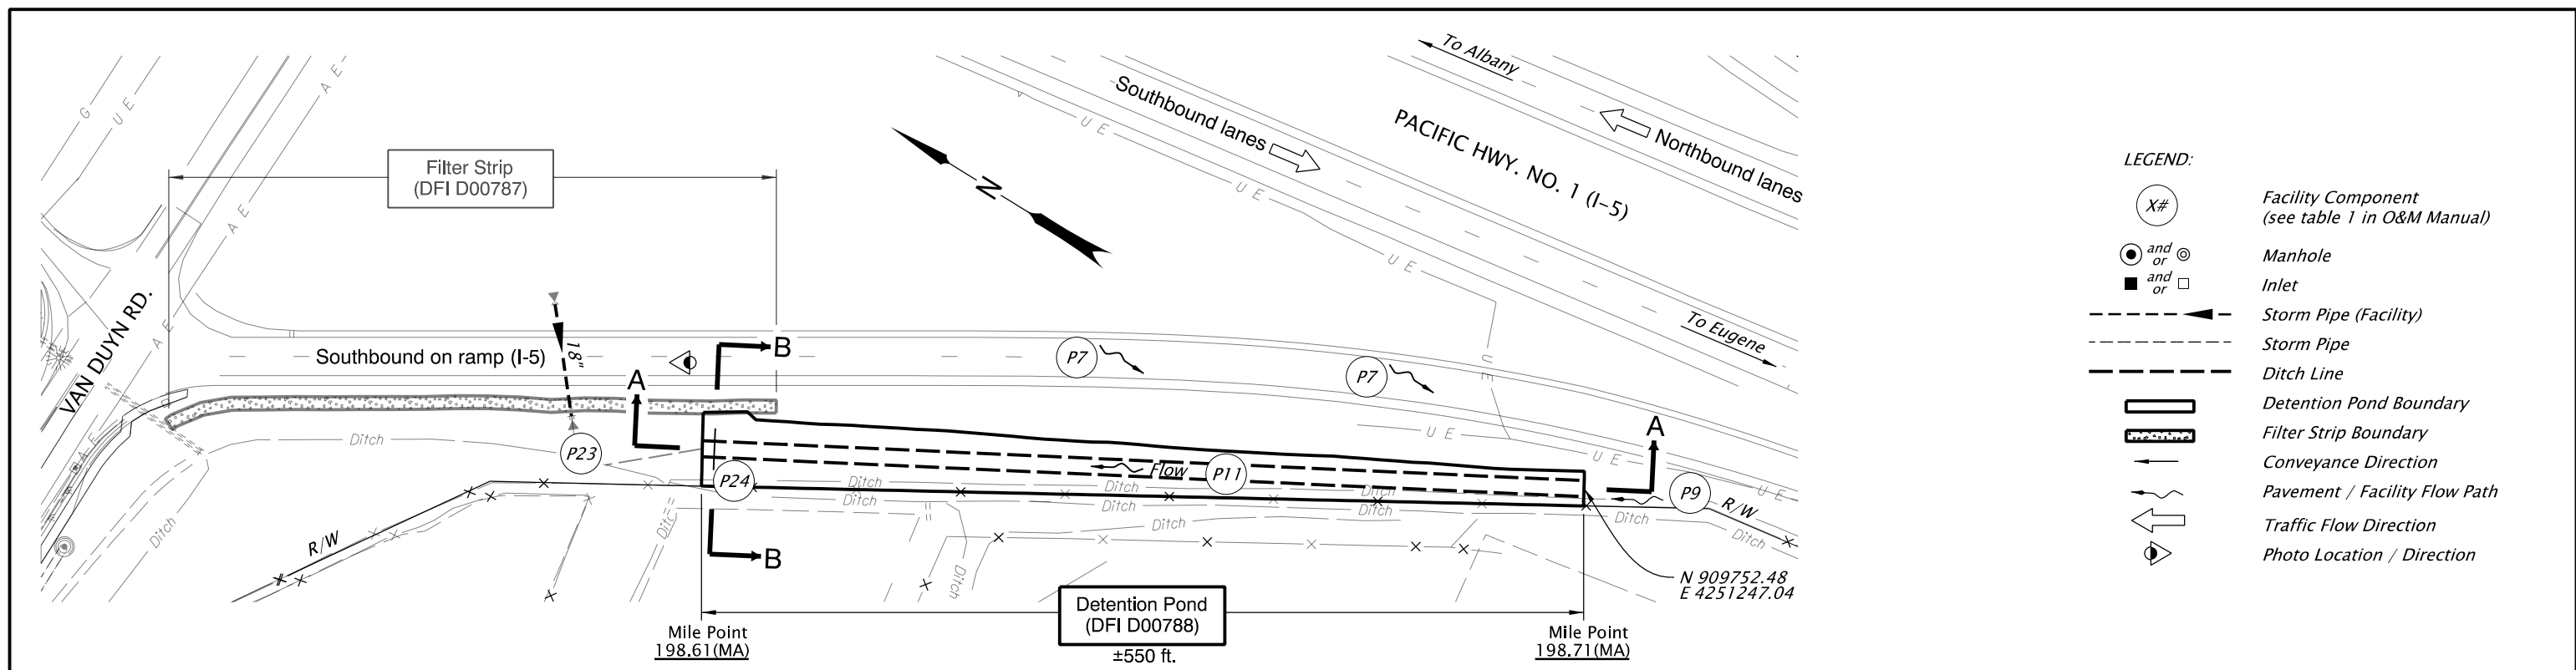


- LEGEND:**
- (X#) Facility Component (see table 1 in O&M Manual)
 - and ○ Manhole
 - and □ Inlet
 - Storm Pipe (Facility)
 - - - Storm Pipe
 - - - Ditch Line
 - ▭ Detention Pond Boundary
 - ▨ Filter Strip Boundary
 - Conveyance Direction
 - ↔ Pavement / Facility Flow Path
 - ↔ Traffic Flow Direction
 - ⊙ Photo Location / Direction

PLAN
N.T.S.

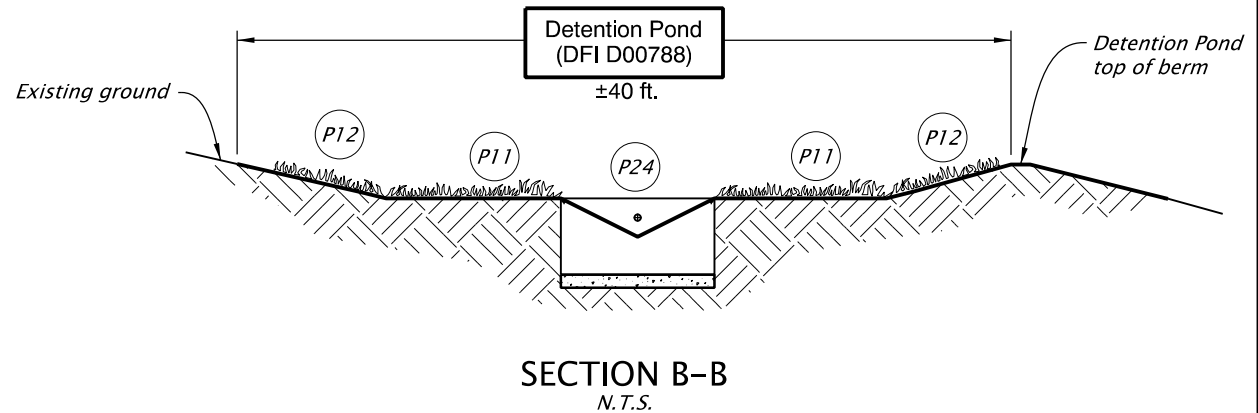

SECTION B-B
N.T.S.

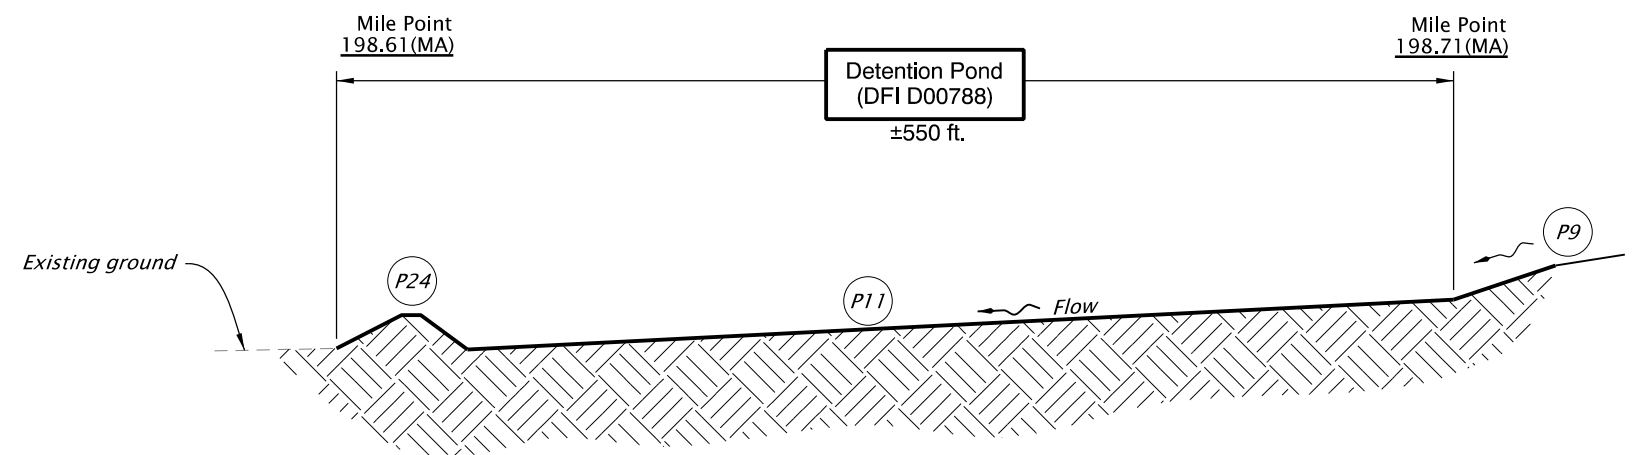

SECTION A-A
N.T.S.



Sht. 2 of 2		<p>DFI D00788 MAINT. DIST. 5 I-5 @ COBURG INTCHG. SEC. DETENTION POND PACIFIC HIGHWAY MP 198.61(MA) LANE COUNTY</p>
Prepared By:	Christopher Carman	
Drafted By:	Jeff Coon	

B Appendix B – Project Contract Plans

Contents:

Site Specific Subset of Project Contract Plan 45V-31

INDEX OF SHEETS	
SHEET NO.	DESCRIPTION
1	Title Sheet
1A	Index Of Sheets Cont'd.
1A-2	Std. Drg. Nos.

STATE OF OREGON
DEPARTMENT OF TRANSPORTATION

PLANS FOR PROPOSED PROJECT


GRADING, DRAINAGE, STRUCTURE, PAVING, SIGNING,
ILLUMINATION, SIGNAL & ROADSIDE DEVELOPMENT

I-5 @ COBURG INTERCHANGE SEC.

PACIFIC HIGHWAY

LANE COUNTY

JUNE 2012

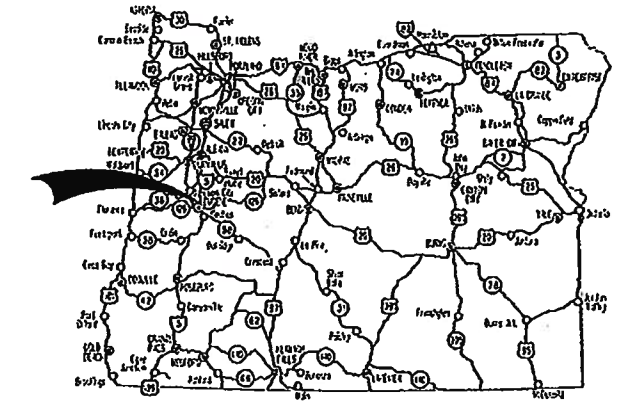


Overall Length Of Project - 0.3 Miles

**BEGINNING OF PROJECT
HPP-S001(395)**

STA. "L"24+38 (M.P. 199.1)

ATTENTION!
Oregon Law Requires You To Follow Rules Adopted By The Oregon Utility Notification Center. Those Rules Are Set Forth In OAR 952-001-0010 Through OAR 952-001-0090. You May Obtain Copies Of The Rules By Calling The Center. (Note: The Telephone Number For The Oregon Utility Center Is (503) 232-1987.)

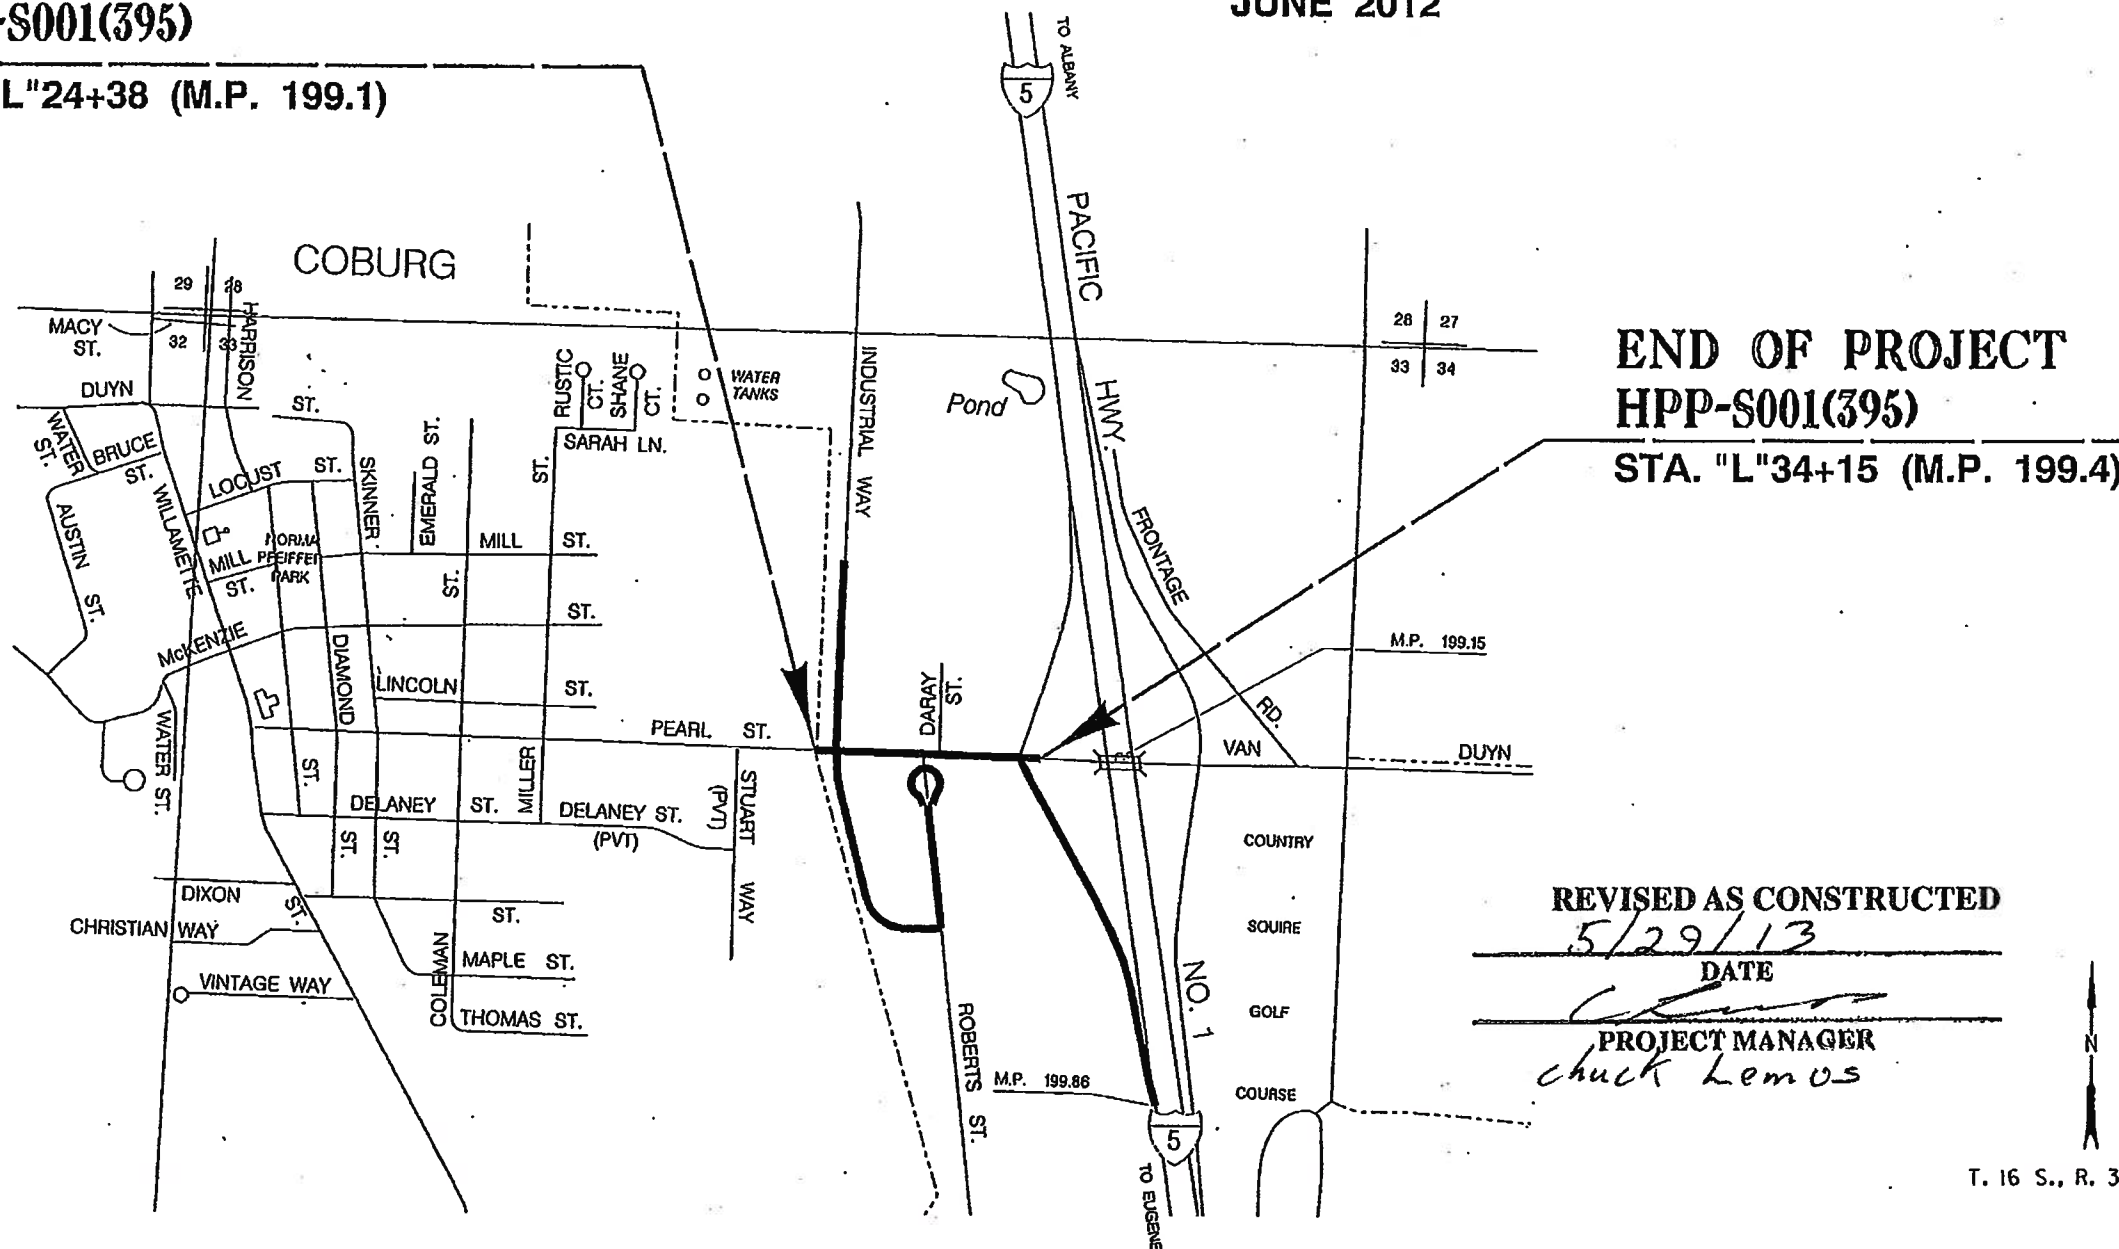

**END OF PROJECT
HPP-S001(395)**

STA. "L"34+15 (M.P. 199.4)

OREGON TRANSPORTATION COMMISSION

- Pat Egan CHAIR
- David Lohman COMMISSIONER
- Mory F. Olson COMMISSIONER
- Mark Frohnmayer COMMISSIONER
- Tammy Boney COMMISSIONER
- Matthew L. Garrett DIRECTOR OF TRANSPORTATION

These plans were developed using ODOT design standards. Exceptions to these standards, if any, have been submitted and approved by the ODOT Chief Engineer or their delegated authority.

By: Carol A. Cartwright 4/23/12
Signature & date

Carol A. Cartwright - R2 Tech Center Manager
Print name and title

[Signature]
Concurrence by ODOT Chief Engineer


REVISED AS CONSTRUCTED

5/29/13

DATE

PROJECT MANAGER

chuck Lemos

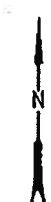


T. 16 S., R. 3 W., W.M.




FEDERAL HIGHWAY ADMINISTRATION	PROJECT NUMBER	SHEET NO.
OREGON DIVISION	HPP-S001(395)	1


PE001244

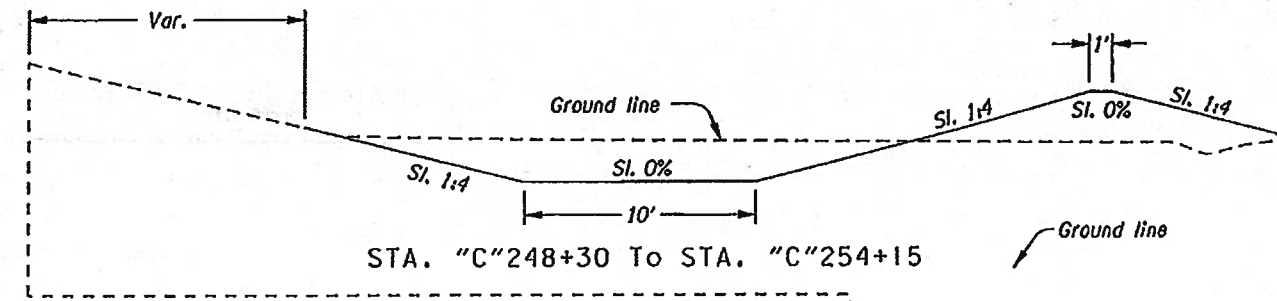

STA. "C"248+30 To STA. "C"254+15

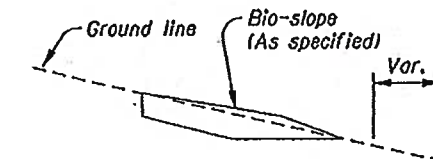

STA. "C"245+16 To STA. "C"249+00

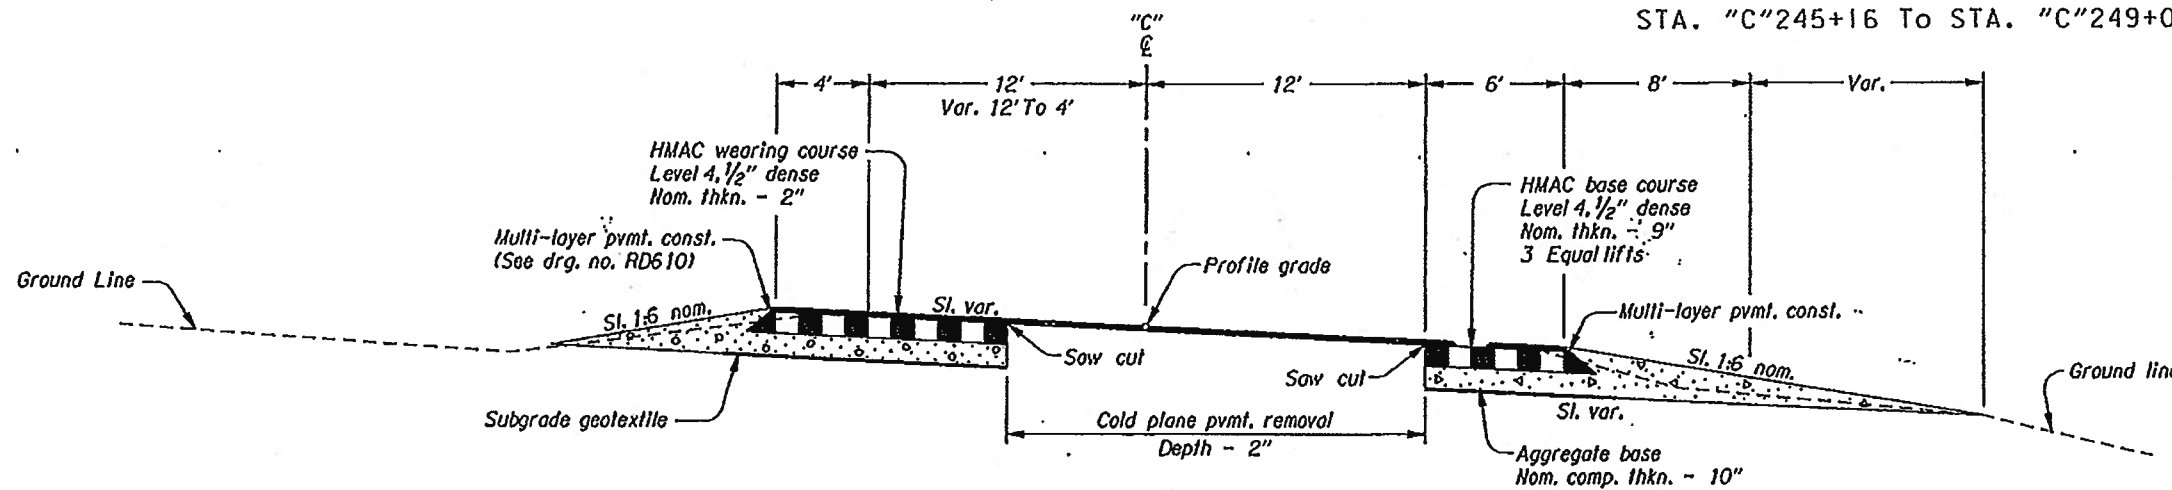

STA. "C"244+16 To STA. "C"254+00
 "C"254+00 To "C"255+20 (Taper section)

- NOTE:
1. Side-slopes are shown as vert. to horiz.
 2. For standard superelevation, see drg. no. RD140.
 3. For slope rounding, see drg. no. RD150.

OREGON DEPARTMENT OF TRANSPORTATION


REGION 2 TECH CENTER

**1-5 @ COBURG INTERCHANGE SEC.
 PACIFIC HIGHWAY
 LANE COUNTY**


Design Team Leader - Edward W. Contrell
 Designed By - Chris Bailey
 Drafted By - D. Gentner-Doy

TYPICAL SECTIONS SHEET NO. **2A-7**

REVISD AS CONSTRUCTED
 5/29/13
 DATE
 PROJECT MANAGER

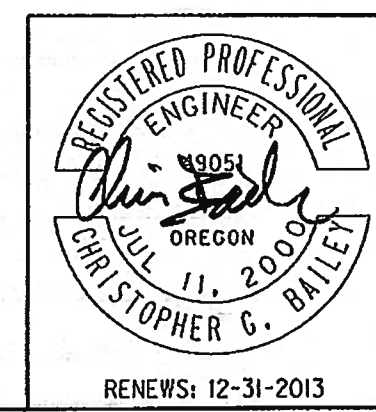


Sec. 33, T. 16 S., R. 3 W., W.M.

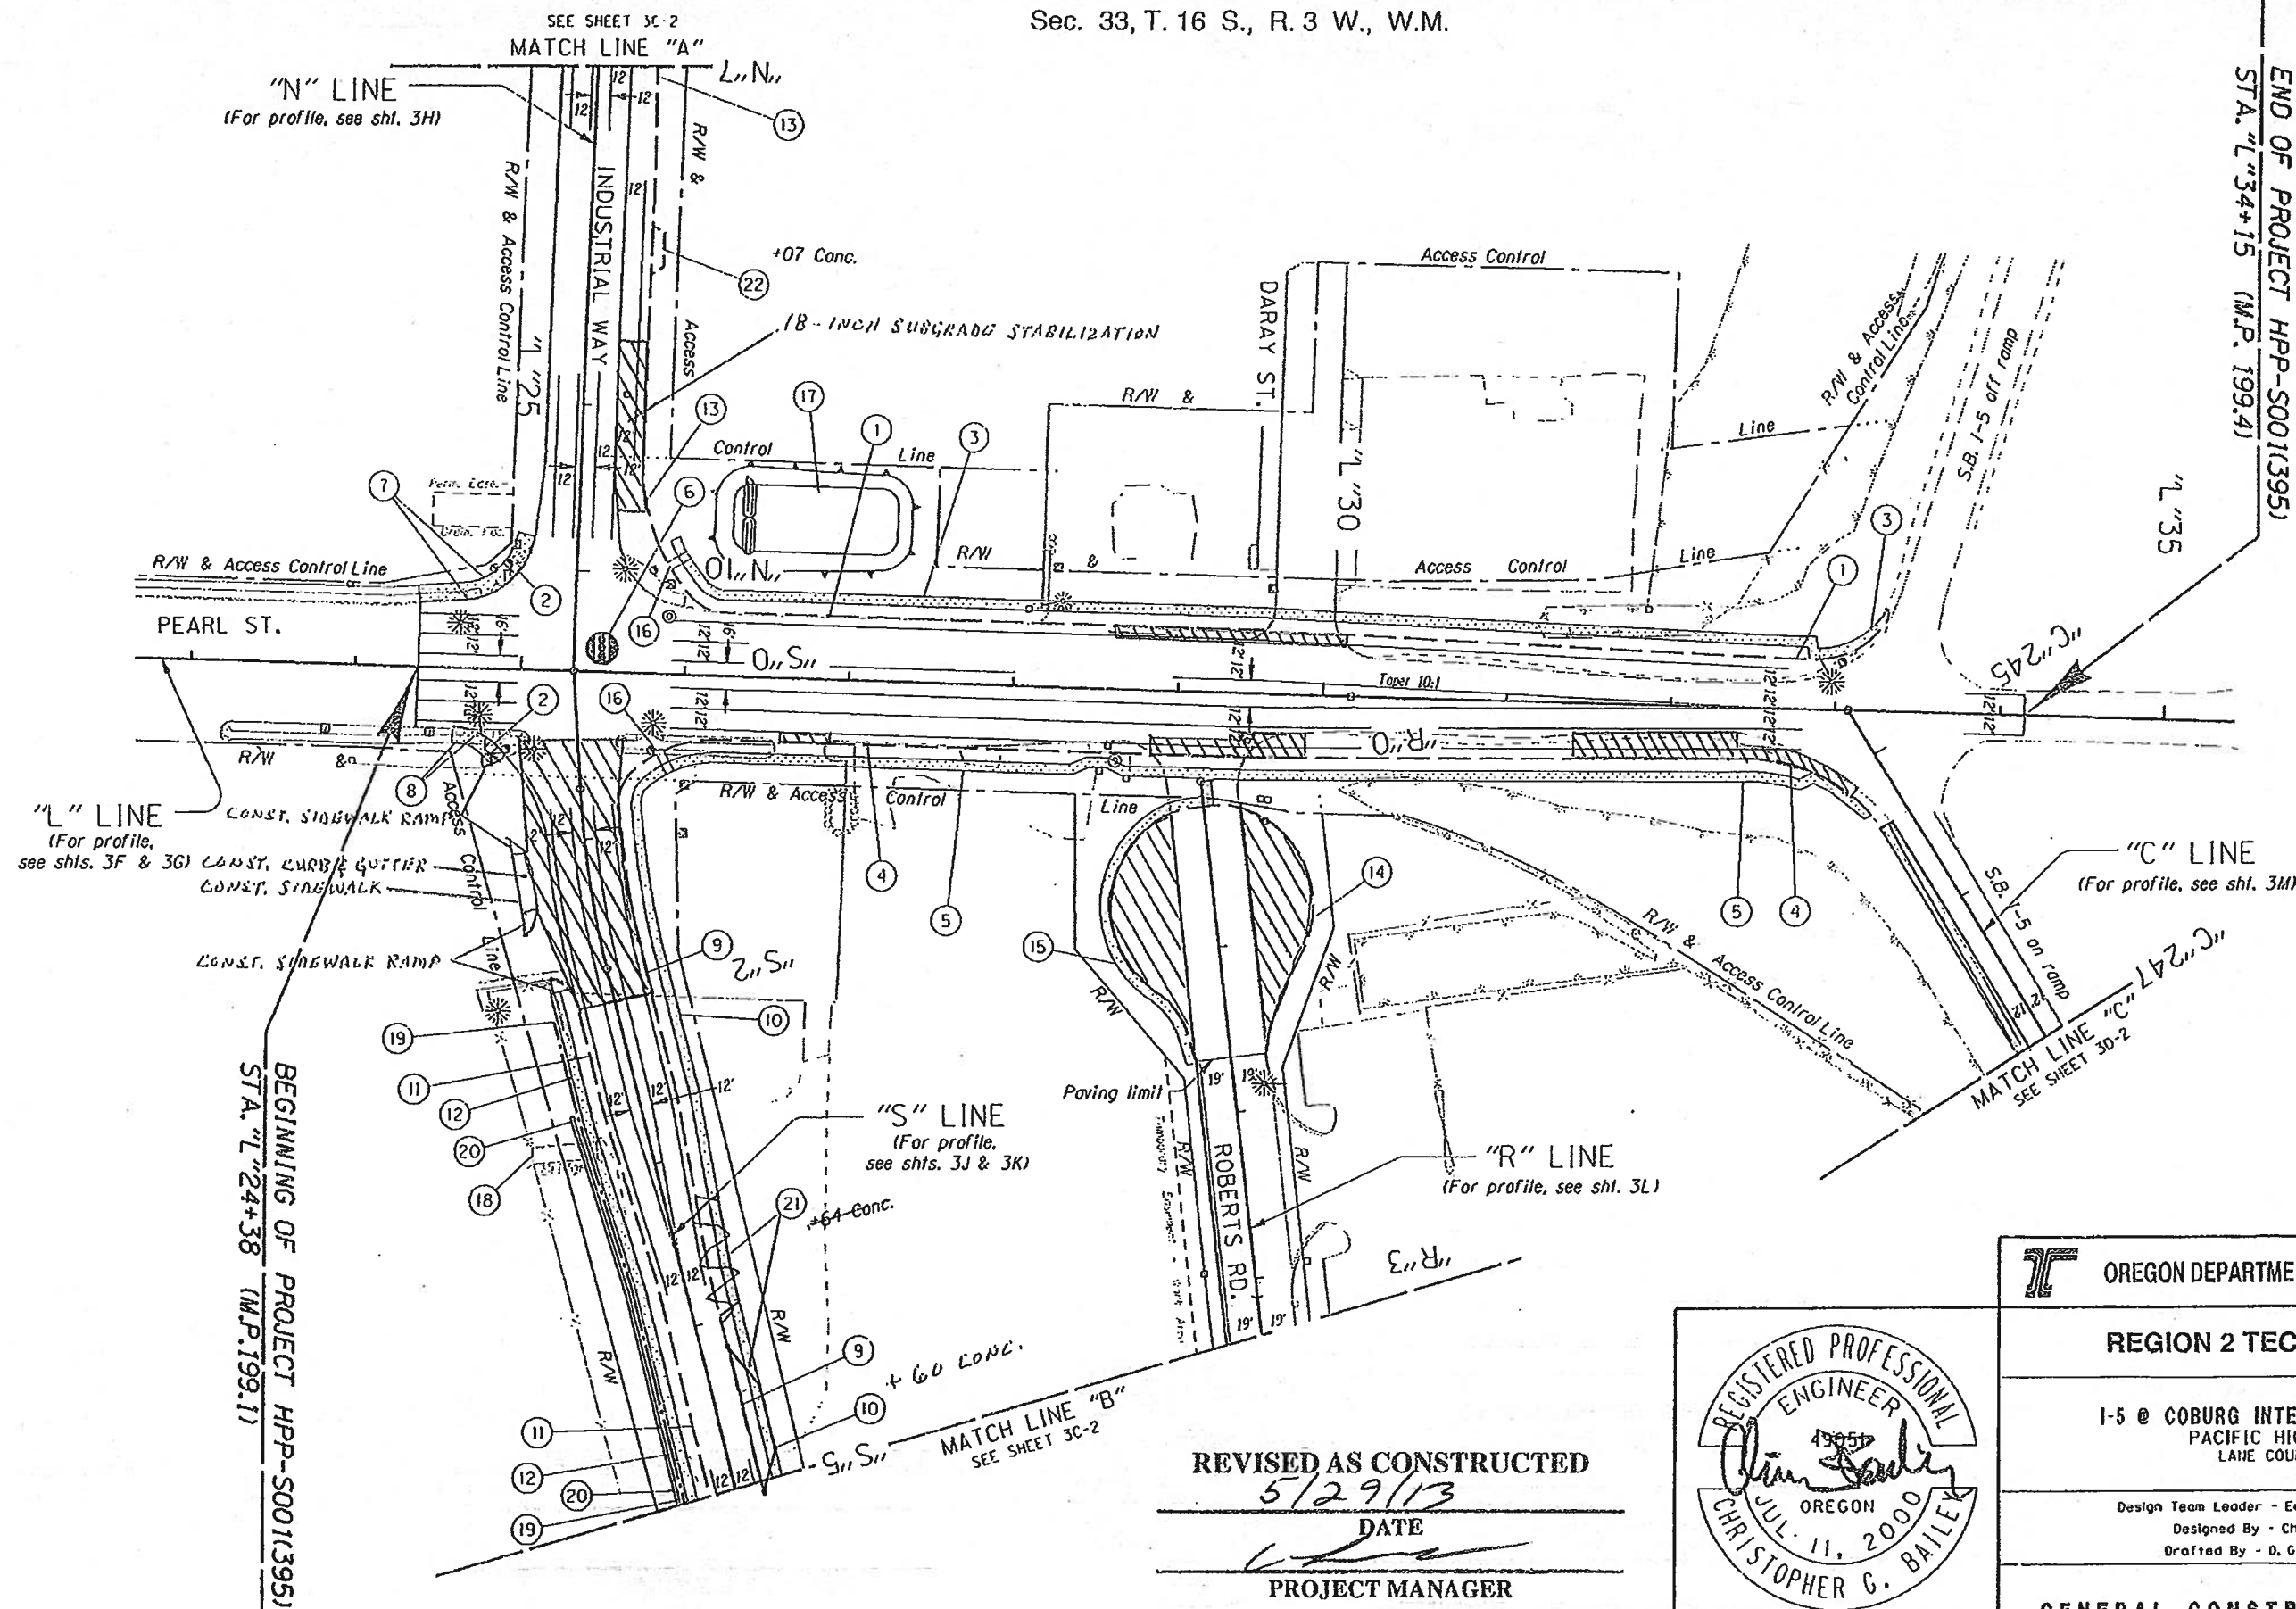

END OF PROJECT HPP-S001395)
STA. 1+34+15 (M.P. 199.4)

BEGINNING OF PROJECT HPP-S001395)
STA. 1+24+38 (M.P. 199.1)


REVISED AS CONSTRUCTED
5/29/13
DATE
PROJECT MANAGER

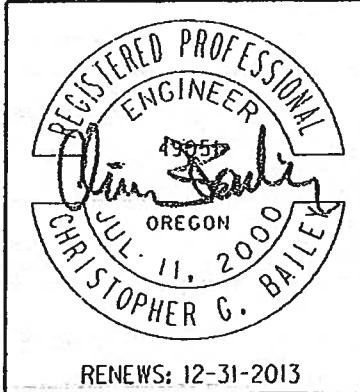

OREGON DEPARTMENT OF TRANSPORTATION	
REGION 2 TECH CENTER	
I-5 @ COBURG INTERCHANGE SEC. PACIFIC HIGHWAY LAINE COUNTY	
Design Team Leader - Edward N. Contrall Designed By - Chris Bailey Drafted By - D. Gentner-Day	
GENERAL CONSTRUCTION	SHEET NO. 3A


Sec. 33, T. 16 S., R. 3 W., W.M.

45V-31

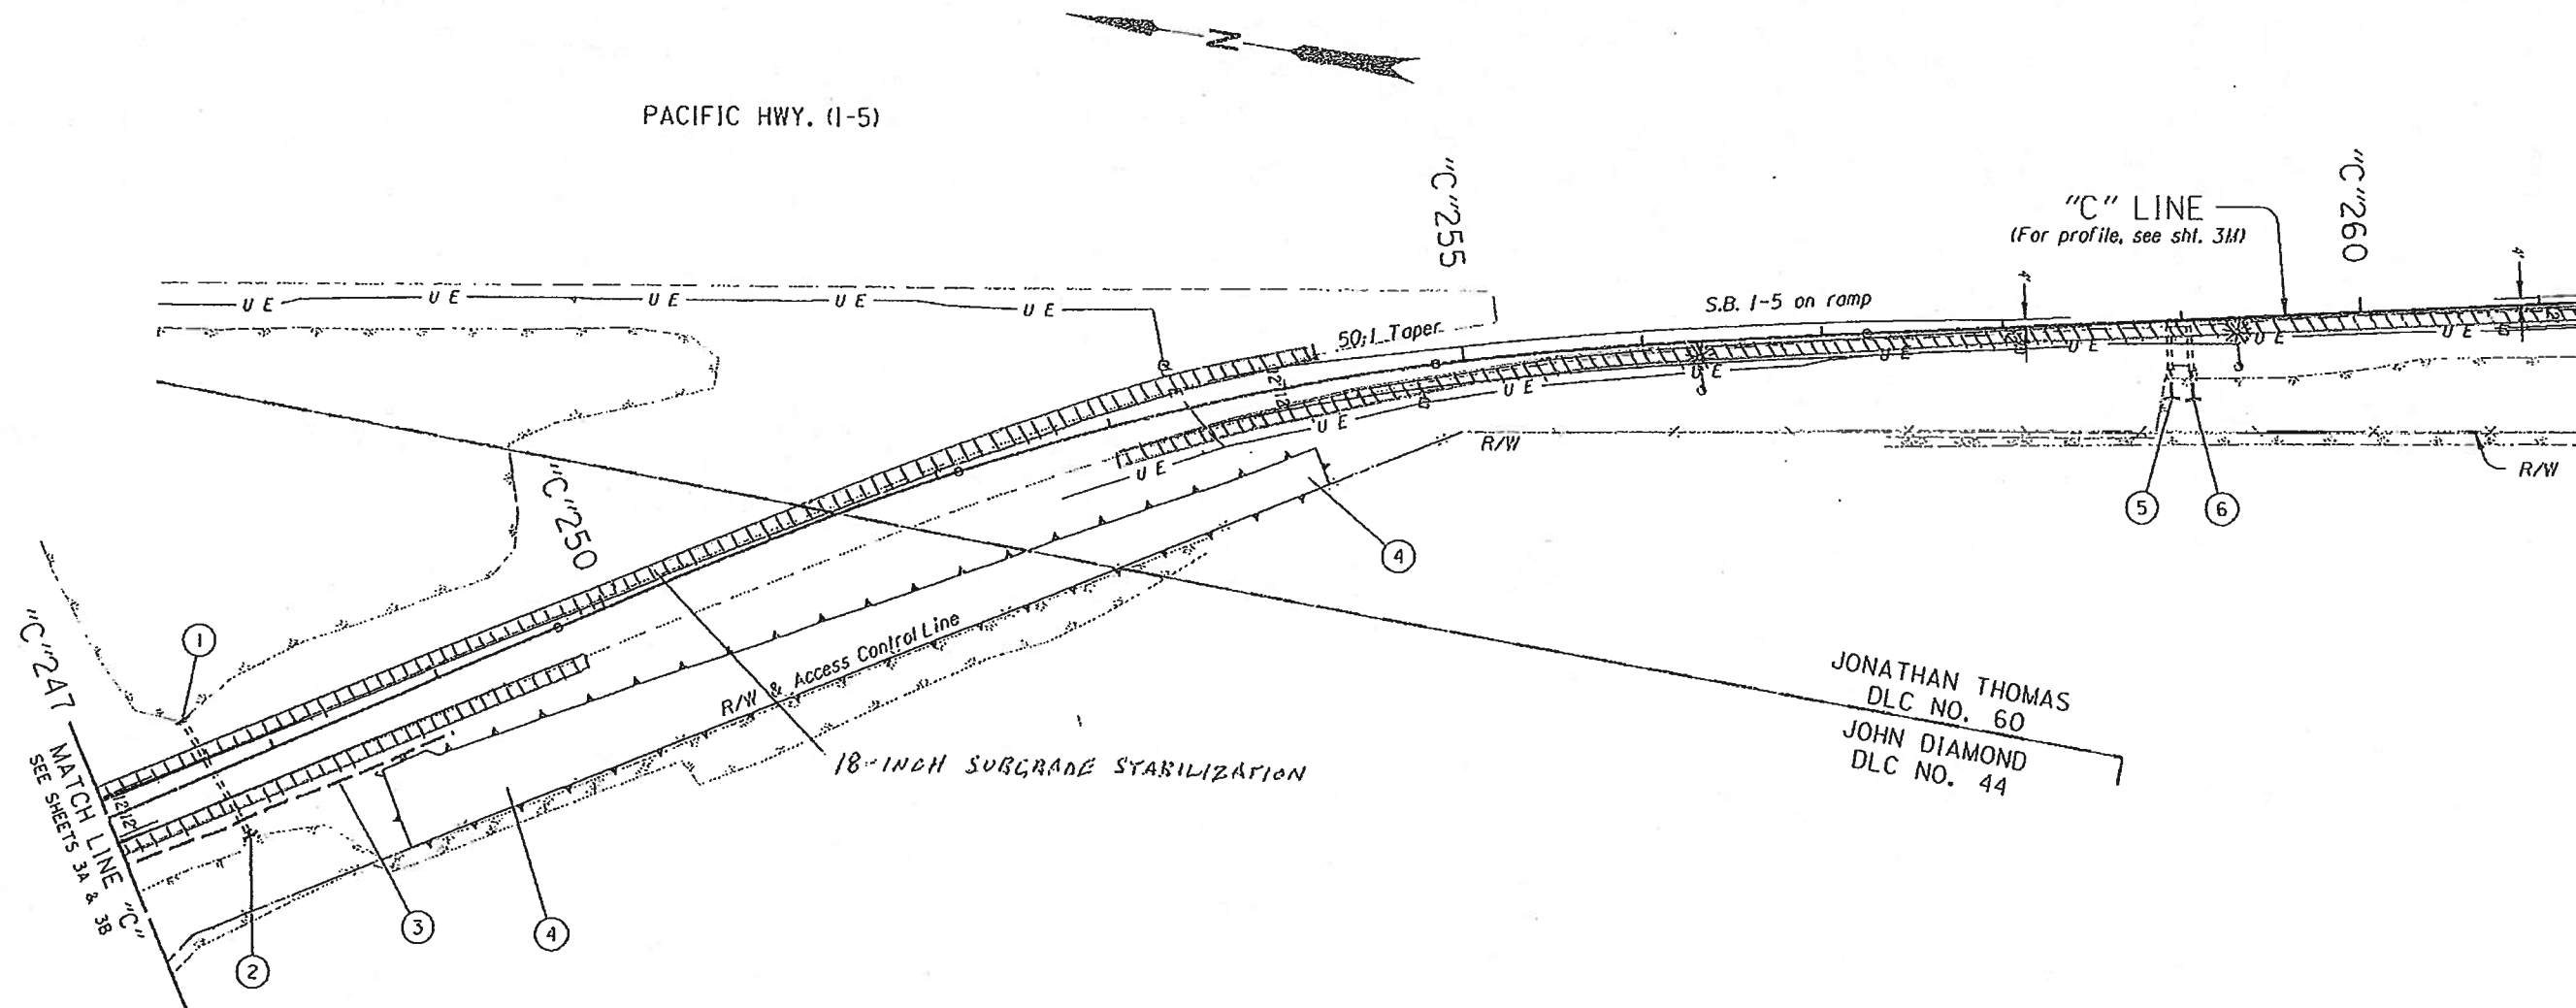

JONATHAN THOMAS
DLC NO. 60
JOHN DIAMOND
DLC NO. 44


REVISED AS CONSTRUCTED
5/29/13
DATE
C. Bailey
PROJECT MANAGER

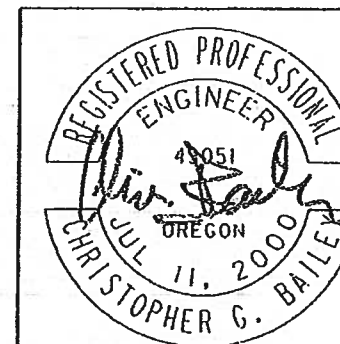



RENEWS: 12-31-2013


OREGON DEPARTMENT OF TRANSPORTATION	
REGION 2 TECH CENTER	
I-5 @ COBURG INTERCHANGE SEC. PACIFIC HIGHWAY LANE COUNTY	
Design Team Leader - Edward W. Cantrell Designed By - Chris Bailey Drafted By - D. Gentner-Day	
GENERAL CONSTRUCTION	SHEET NO. 30-2

- ① Sta. "C"247+59.10, Lt.
Extg. 18" conc. pipe - 70.4' (In pl.)
Extend - 4.5', 5' Depth 1.5'
(See drg. no. RD318)
- ② Sta. "C"247+69.31, Rt.
Extg. 18" conc. pipe - 70.4' (In pl.)
Extend - 2.5', 5' Depth 2.2.5'
- ③ See sht. 3B-2, note 24
Const. blo-slope
- ④ Sta. "C"248+30 To Sta. "C"254+15, Rt.
Const. 10' wide detention pond
(For drg. nos., see sht. 1A)
- ⑤ Sta. "C"258+92.98, Rt.
Extg. 24" conc. pipe - 232' (In pl.)
Extend - 16', 5' Depth 15'
- ⑥ Sta. "C"259+04.81, Rt.
Extg. 24" conc. pipe - 232' (In pl.)
Extend - 16', 5' Depth 15'

REVISED AS CONSTRUCTED
5/29/13
 DATE

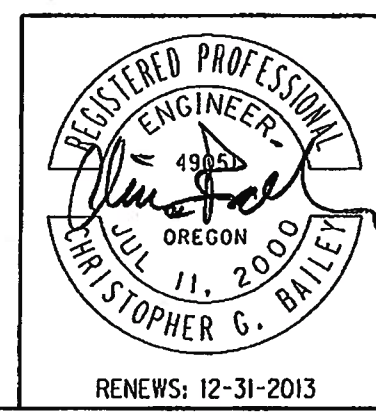 PROJECT MANAGER

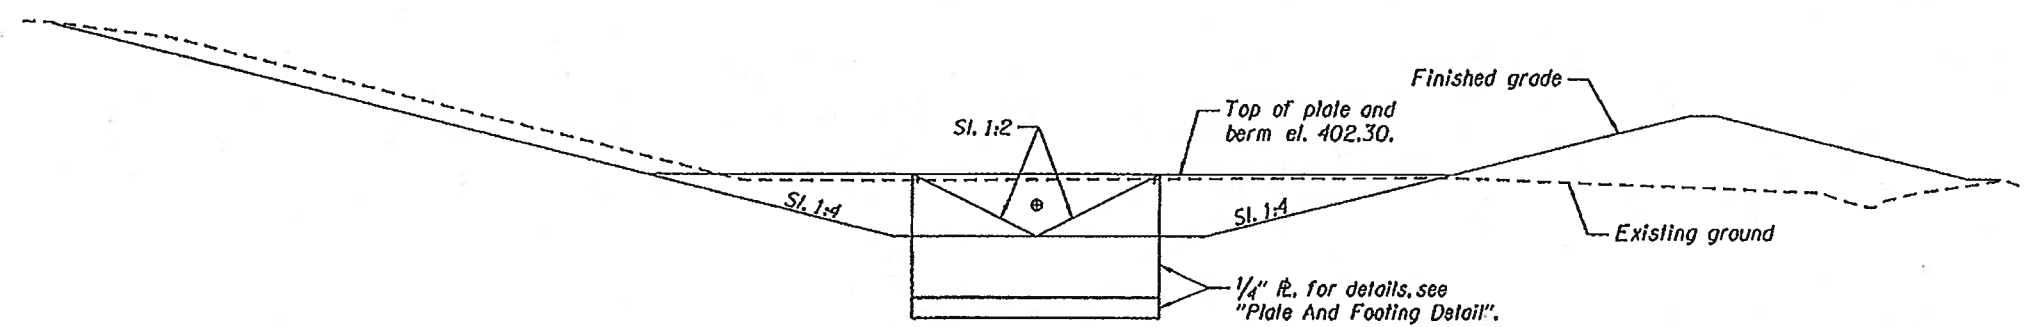

 OREGON DEPARTMENT OF TRANSPORTATION	
REGION 2 TECH CENTER	
I-5 @ COBURG INTERCHANGE SEC. PACIFIC HIGHWAY LANE COUNTY	
Design Team Leader - Edward M. Contrell Designed By - Chris Bailey Drafted By - D. Gentner-Doy	
CONSTRUCTION NOTES	SHEET NO. 3D-3



DETENTION POND SECTION AT STA. "C"248+58.41, 50.0' RT.

Note:
For detention pond details, see roadway sh. 3D-2 and 2A-7.


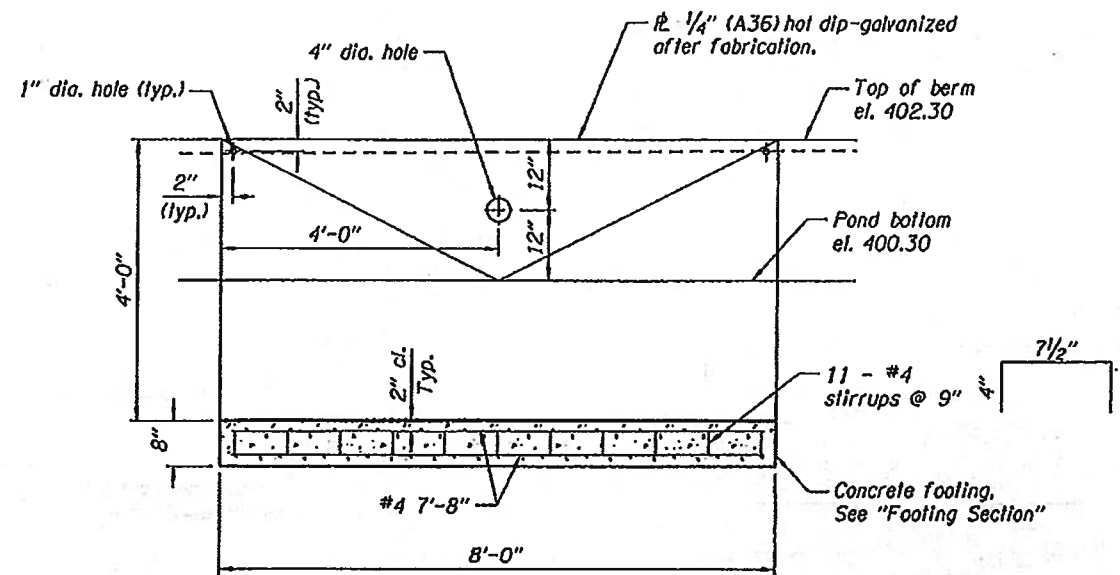


PLATE AND FOOTING DETAIL

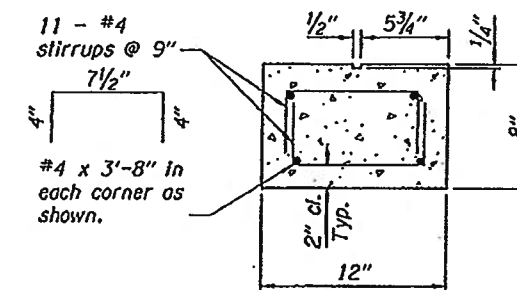


FOOTING SECTION

REVISED AS CONSTRUCTED

5/29/13

DATE

PROJECT MANAGER

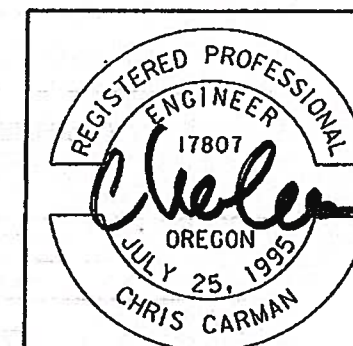

RENEWS: 12-31-2013

OREGON DEPARTMENT OF TRANSPORTATION

REGION 2 TECH CENTER

**I-5 @ COBURG INTERCHANGE
PACIFIC HIGHWAY
LANE COUNTY**

Reviewed By - Bo Miller, P.E.
Designed By - Chris Carman P.E.
Drafted By - Michael Skelton

**STORMWATER
DETAILS**

SHEET NO.
GJ-3