

OPERATION & MAINTENANCE MANUAL

Other (Water Quality Facility)

Manual prepared: February 2019 (rev. June 2019)

DFI No. D00833

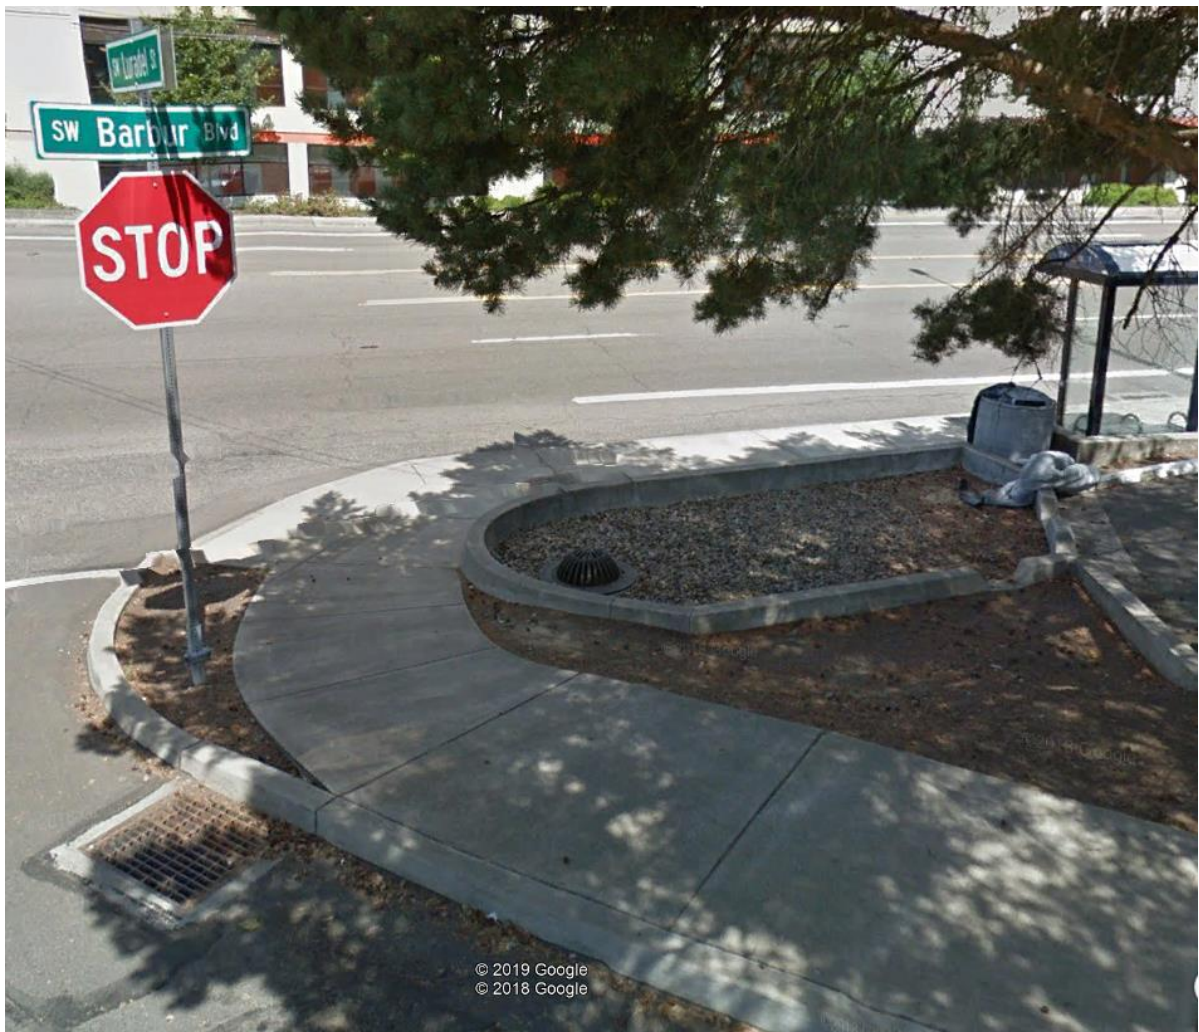


Figure 1: DFI No. D00833, looking northwest

Identification

Drainage Facility ID (DFI): D00833
Facility Type: Other (Water Quality Facility)
Construction Drawings: (V-File Numbers) 46V-141
Location: District: 2B
Highway No.: 091
Mile Post: 6.6 to 6.6, right

1. Manual Purpose

The purpose of this manual is to outline inspection needs and summarize maintenance actions.

2. Facility Location

The location map below details the facility location. The highway, mile posts, side streets, access location, and stormwater flow directions are noted on the map. **NOTE: Mile posts are based off of the V-File, and may vary from TransGIS mile posts.**

Facility location type: **Roadway shoulder**

Flow direction: southwest



Figure 2: Facility location map, looking northeast

3. Facility Summary

This facility is of irregular shape. This is a modified infiltration facility with elements of both swale and bioslope functions, and is surrounded by curbing. The facility receives water from the small parking lot that drains into the curb opening inlets. The width is measured approximately perpendicular to the curb opening inlets. The length is measured parallel to the curb opening inlets.

The approximate length, width, and area of the facility are:

Component	Length (feet)	Width (feet)	Area (sq. ft.)
Facility	18.5	3 (min) to 10	120

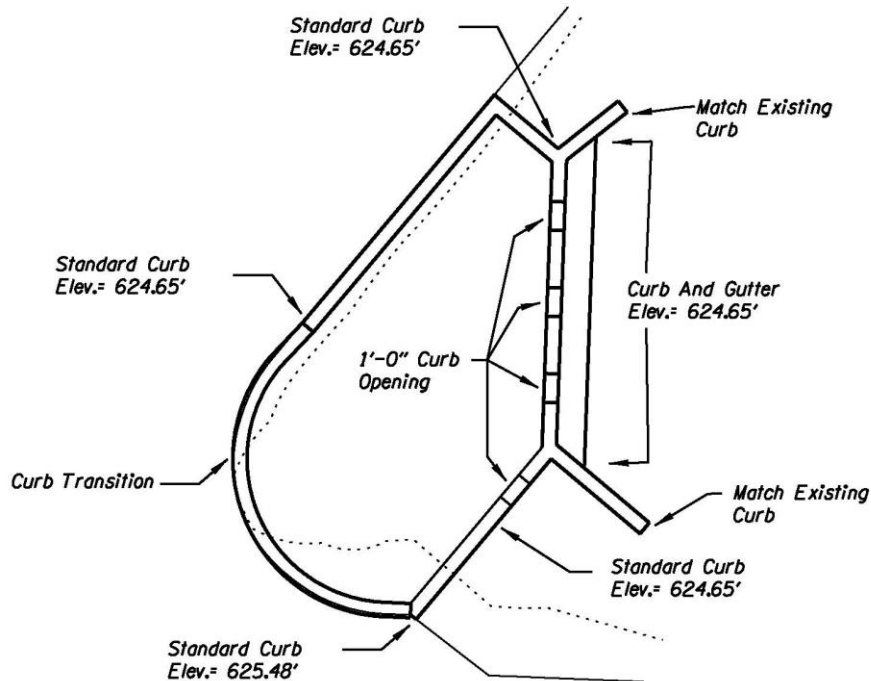


Figure 3: Other (Water Quality Facility) Plan View

The sides are essentially vertical. Typical is not provided, due to unique nature of the facility. The minimum depth of the infiltration layers within the curbs is:

Depth (feet)	3.25 min
--------------	----------

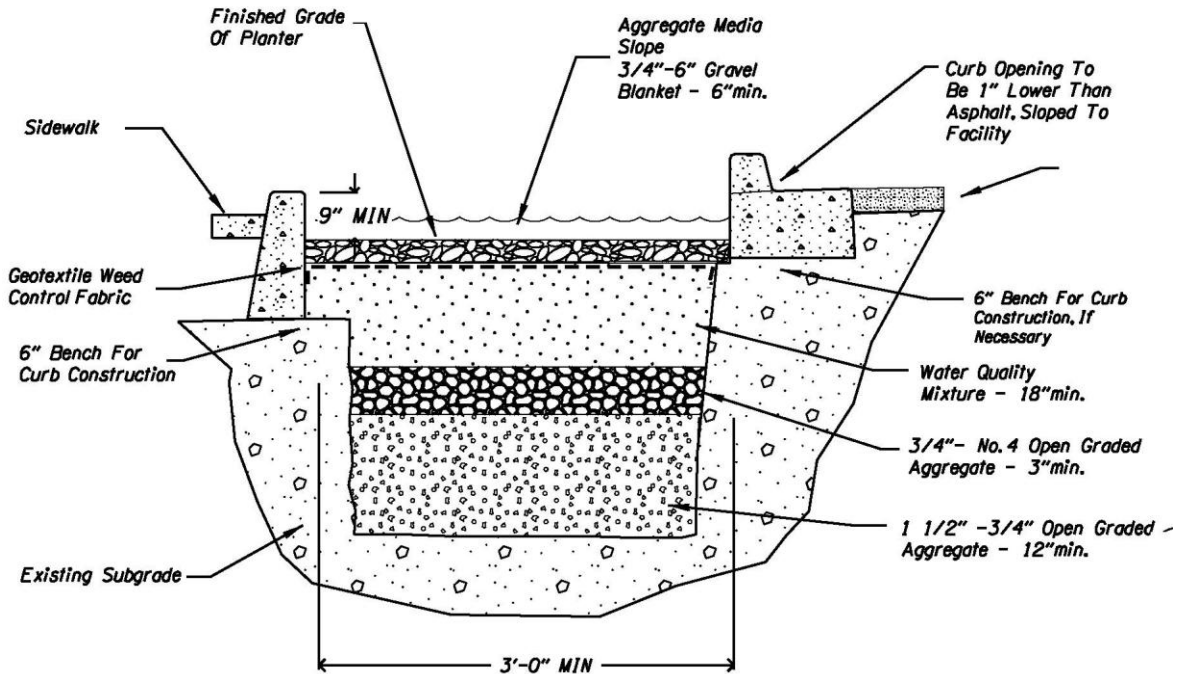


Figure 4: Other (Water Quality Facility) Section

Site Specific Information: This facility was created to compensate for impervious surface located elsewhere and impacted by the project. It collects water from the small parking area adjacent to the north. This facility may be considered a modified infiltration facility, and also has some characteristics of both a bioslope and a swale. Pavement flow from the parking area enters the facility via several curb openings (minimum slope of curb openings is about 4%). It then spreads across the aggregate media surface. Lower flows will infiltrate through the media. Higher flows may flow across the facility to the beehive grate over the manhole, as well as infiltrate. Outlet for flow can be by infiltration to surrounding soils, or through the 6" perforated pipe, or the beehive grate to the piped storm system. See Appendix A for additional details.

Note: Water in the pipe shown passing through the beehive manhole from a surface inlet on the road is not treated at this facility.

Facility Access is at the road shoulder on SW Luradel St.

4. Facility Access

Maintenance access to the facility:

<input type="checkbox"/> Roadside pad	<input checked="" type="checkbox"/> Roadside shoulder
<input type="checkbox"/> Access road with Gate	<input type="checkbox"/> Access road without Gate

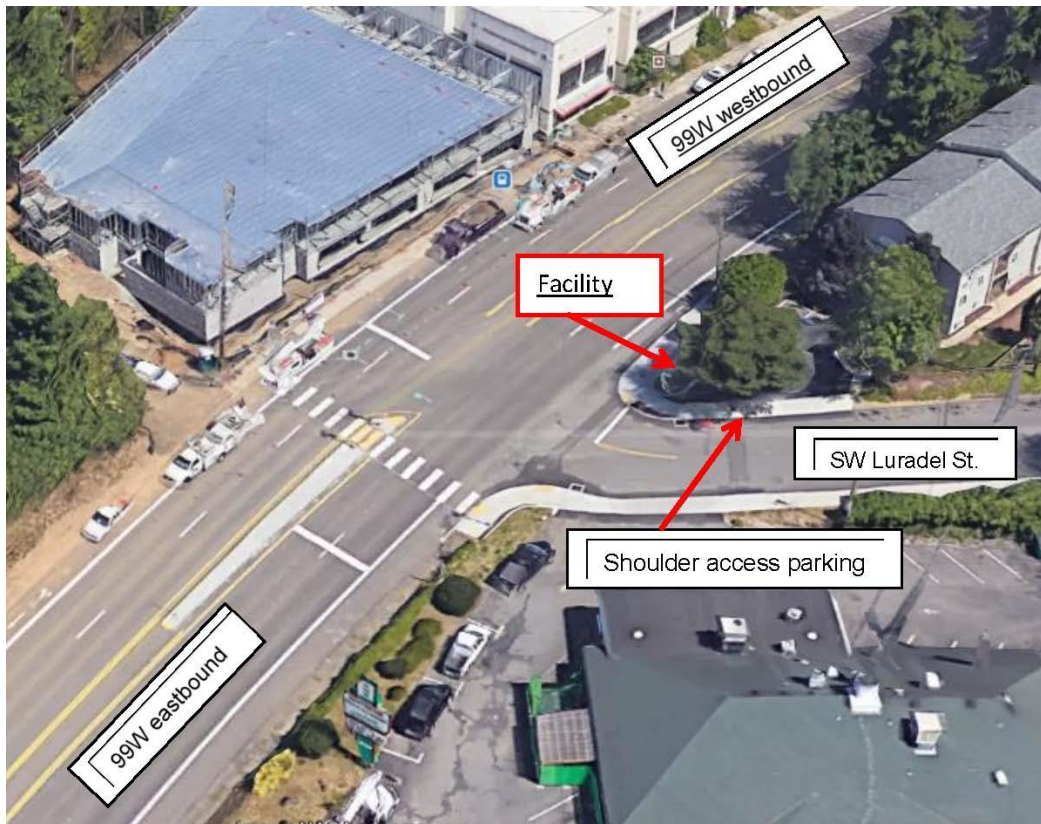


Figure 5: Facility Maintenance Access on shoulder of SW Luradel St.

5. Operational Components / Maintenance Items

Classification and Standard Operational (Op) Plan:

This facility is classified as a:

<input type="checkbox"/> Filter Strip (Op Plan A) A filter strip consists of a vegetated or media slope located parallel to the edge of pavement. It maintains sheet flow of stormwater runoff over the width of the strip.	<input checked="" type="checkbox"/> Other with bioslope and swale elements (Op Plan B) This facility consists of curb open inlets from which water flows over and infiltrates a gravel blanket to layers of fill similar to a bioslope. It is a flow-through stormwater treatment facility located along roadside curb.
A standard operational plan illustrates the general facility footprint configuration and explains the purpose of each facility component. Operational plans (A, B) are provided in the Standard Operation Manual.	

See Appendix A for the site specific operational plan

Operational Components

Swales and bioslopes have many components that assist with treatment, conveyance, and infiltration of stormwater runoff. The components in use can vary depending on the facility design. The facility components table (Table 1) has been provided to highlight the applicable components for this facility. The component is in use when the box contains an “x” (e.g.).

NOTE: This facility has elements similar to both a bioslope and a swale without vegetation. Therefore this table has some unusual components identified.

The Standard Operation Manual for Water Quality Filter Strips and Bioslopes outlines facility operation, typical footprint configuration, and component definitions and details. A link to the manual is attached to the feature marker in TransGIS.

<https://gis.odot.state.or.us/TransGIS/>

Also review the Standard Operation Manual for Water Quality Biofiltration Swales (implemented March 2017) outlines facility operation, typical footprint configuration, and component definitions and details.

Maintenance Items

Operational components marked in Table 1 should be inspected and maintained according to Section 7. Each facility component is defined and detailed in the Standard Operation Manual using the associated ID number indicated below.

Table 1: Bioslope/Filter Strip Components		ID #
Facility Inlet		
Pavement Sheet Flow	<input checked="" type="checkbox"/>	B1
Curb and gutter (with curb opening detail)	<input checked="" type="checkbox"/>	B2
Ground Cover		
Vegetated Slope	<input type="checkbox"/>	B3
Aggregate Media Slope 3/4" - #6 Gravel Blanket	<input checked="" type="checkbox"/>	B4
Underground Components		
Water Quality Mix	<input checked="" type="checkbox"/>	B5
Open Graded Aggregate (3/4" - #4)	<input checked="" type="checkbox"/>	B6
Open graded aggregate (1 1/2" - 3/4")	<input checked="" type="checkbox"/>	B7
Geotextile Weed Control Fabric	<input checked="" type="checkbox"/>	B8
Geocell Grid	<input type="checkbox"/>	B9
Structures		
Standard Curb	<input checked="" type="checkbox"/>	B10
Check Dam	<input type="checkbox"/>	B11
Cleanout	<input type="checkbox"/>	B12
Facility Outlet		
6" Perforated Drain Pipe	<input checked="" type="checkbox"/>	B13
Manhole Outlet with Beehive Grate	<input checked="" type="checkbox"/>	B14
Other: Infiltration to surrounding soils	<input checked="" type="checkbox"/>	B15
Storm Drain Outlet Pipe	<input checked="" type="checkbox"/>	B16
Outfall Type		
Waterbody (Creek/Lake/Ocean)	<input type="checkbox"/> C	B17
	<input type="checkbox"/> L	
	<input type="checkbox"/> O	
Outfall Channel	<input type="checkbox"/>	B18
Storm Drain System	<input checked="" type="checkbox"/>	B19
Outfall Components		
Pervious Berm	<input type="checkbox"/>	B20
Riprap Pad	<input type="checkbox"/>	B21

6. Maintenance

Maintenance Frequency/Maintain Records

- a. Inspect annually. Preferably prior to the rainy season.
- b. Clean and maintain as necessary. Refer to Activity 125 for conditions when maintenance is needed.
- c. Keep a record of inspections, maintenance, and repairs.

Maintenance Guide/Maintenance Actions

The ODOT Routine Road Maintenance Water Quality and Habitat Guide (the *Blue Book*) outlines the standard maintenance actions for water quality facilities under Activity 125.

There are standard maintenance tables for standard ODOT designs. The maintenance tables describe the maintenance component, the defect or problem, the condition when maintenance is needed, and the recommended maintenance to correct the problem. Use the following tables to maintain ODOT swales and bioslopes:

- Table 1 (General Maintenance): Contains general maintenance and inspection guidelines that are applicable to all ODOT water quality facilities
- Table 3 (Maintenance of Water Quality or Biofiltration Swales): Contains maintenance information for swales
- Table 5 (Water Quality Bioslopes)

The ODOT Maintenance Guide can be viewed at the following website:

<http://www.oregon.gov/ODOT/HWY/OOM/pages/mguide.aspx>

The *Blue Book* can be viewed at the following website:

http://www.oregon.gov/ODOT/Maintenance/Documents/blue_book.pdf

7. Limitations

This facility combines elements of swales and bioslopes. It is NOT designed to allow the use of heavy equipment. No access grid is installed. Vehicles entering the facility can create depressions (tire ruts), damage vegetation, and damage structural components (e.g. flow spreaders). These conditions may result in poor treatment and drainage performance.

8. Waste Material Handling

Material removed from the facility is defined as waste by the Department of Environmental Quality (DEQ). Refer to the road waste section of the ODOT Maintenance Yard Environmental Management System (EMS) Policy and Procedures Manual for disposal options:

<http://www.oregon.gov/ODOT/HWY/OOM/pages/ems.aspx>


Contact any of the following for more detailed information about management of waste materials found on site:

ODOT Clean Water Unit	(503) 986-3008
ODOT Statewide Hazmat Coordinator	(503) 667-7442
ODOT Region 1 Hazmat Coordinator	(503) 731-8290
ODOT Region 2 Hazmat Coordinator	(503) 986-2647
ODOT Region 3 Hazmat Coordinator	(541) 957-3594
ODOT Region 4 Hazmat Coordinator	(541) 388-6186
ODOT Region 5 Hazmat Coordinator	(541) 963-1590
ODEQ Northwest Region Office	(503) 229-5263


A Appendix A – Site Specific Operational Plan

Contents:


Operational Plan: DFI D00833

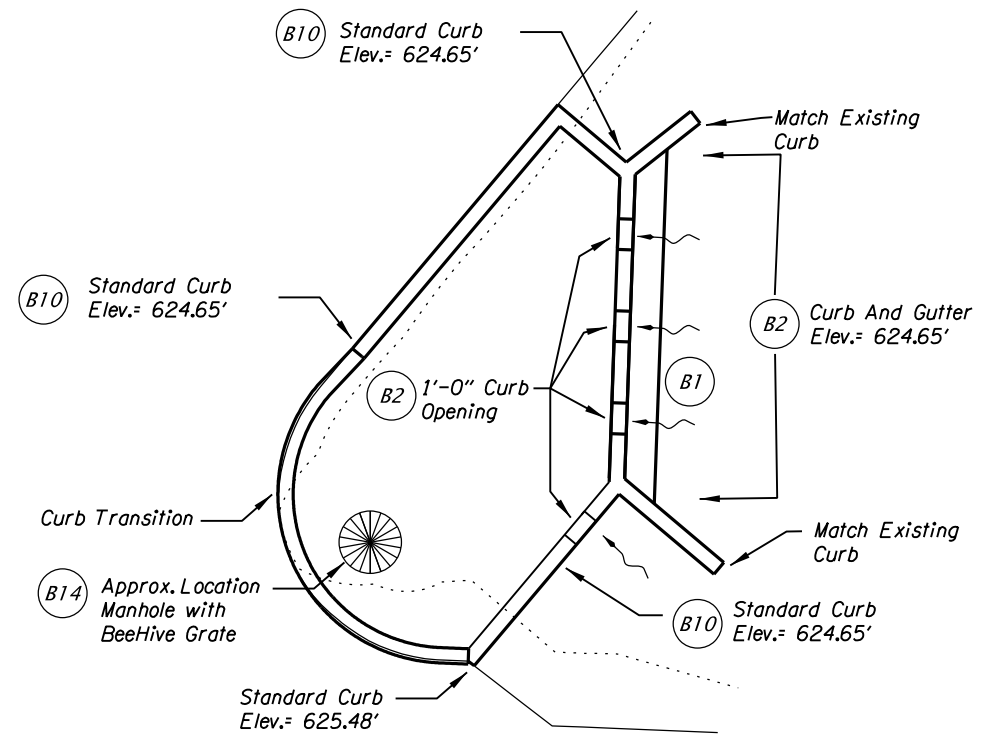


BIOSLOPE DETAIL

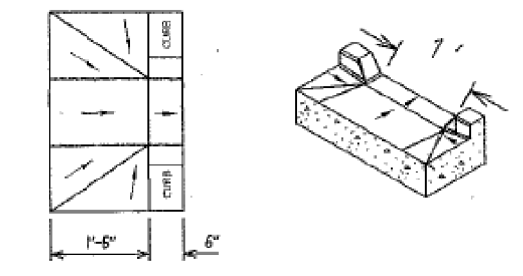



B2 CURB OPENING DETAIL

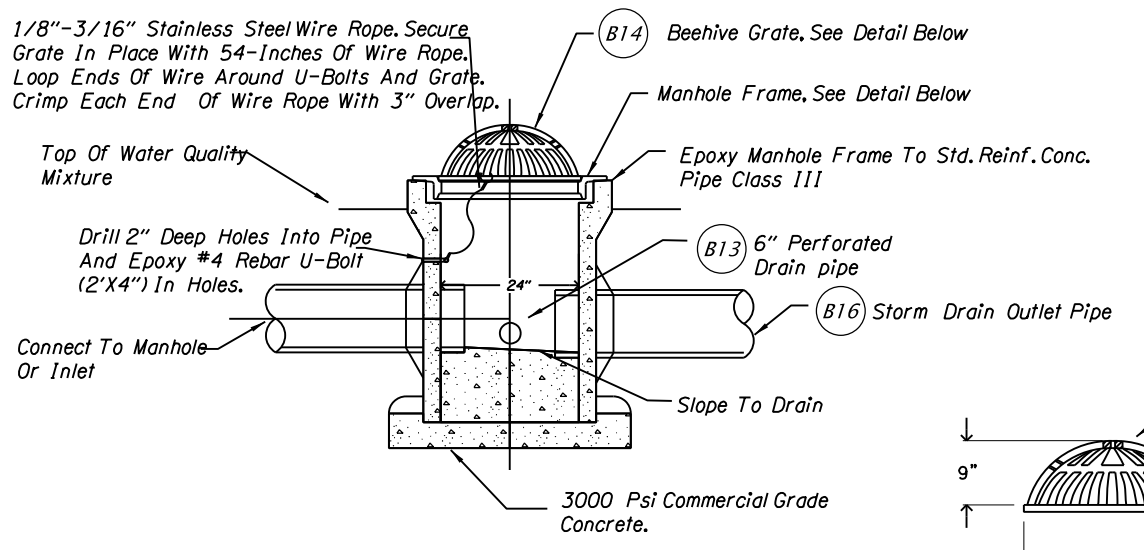


AREA DRAINAGE BASIN

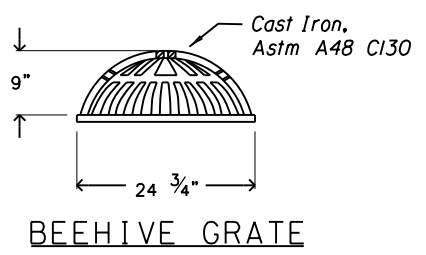

BEEHIVE GRATE

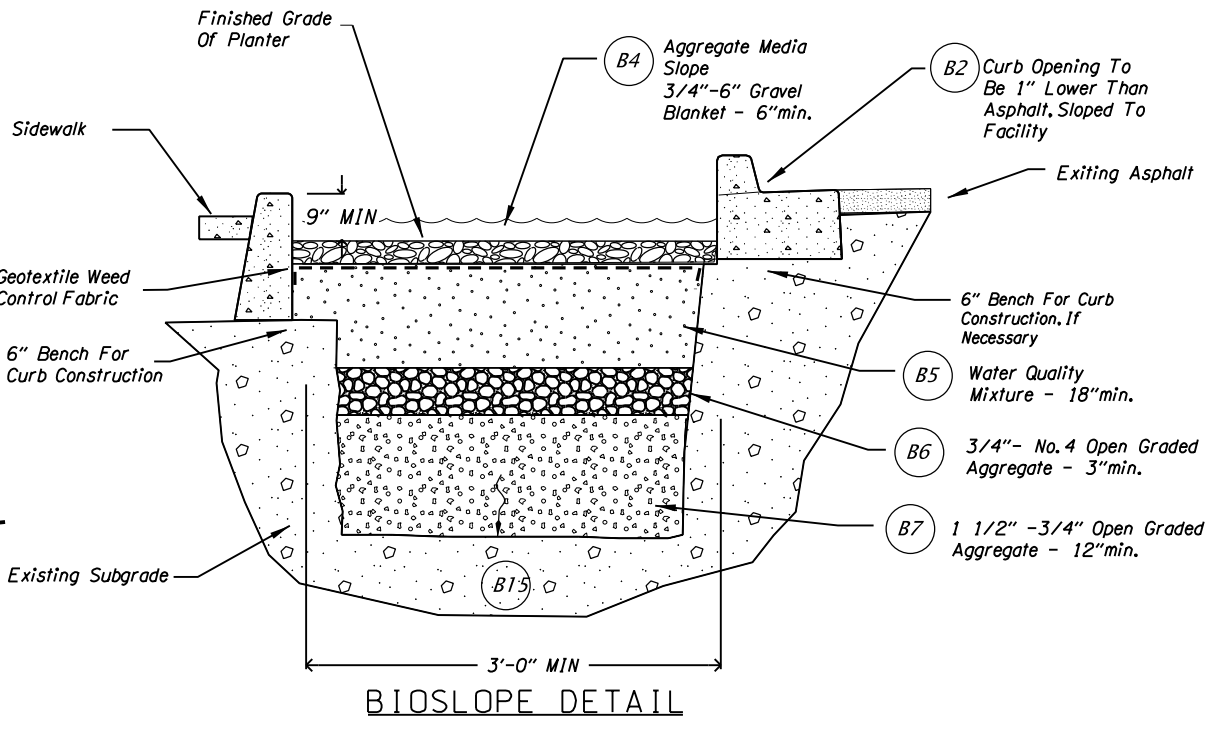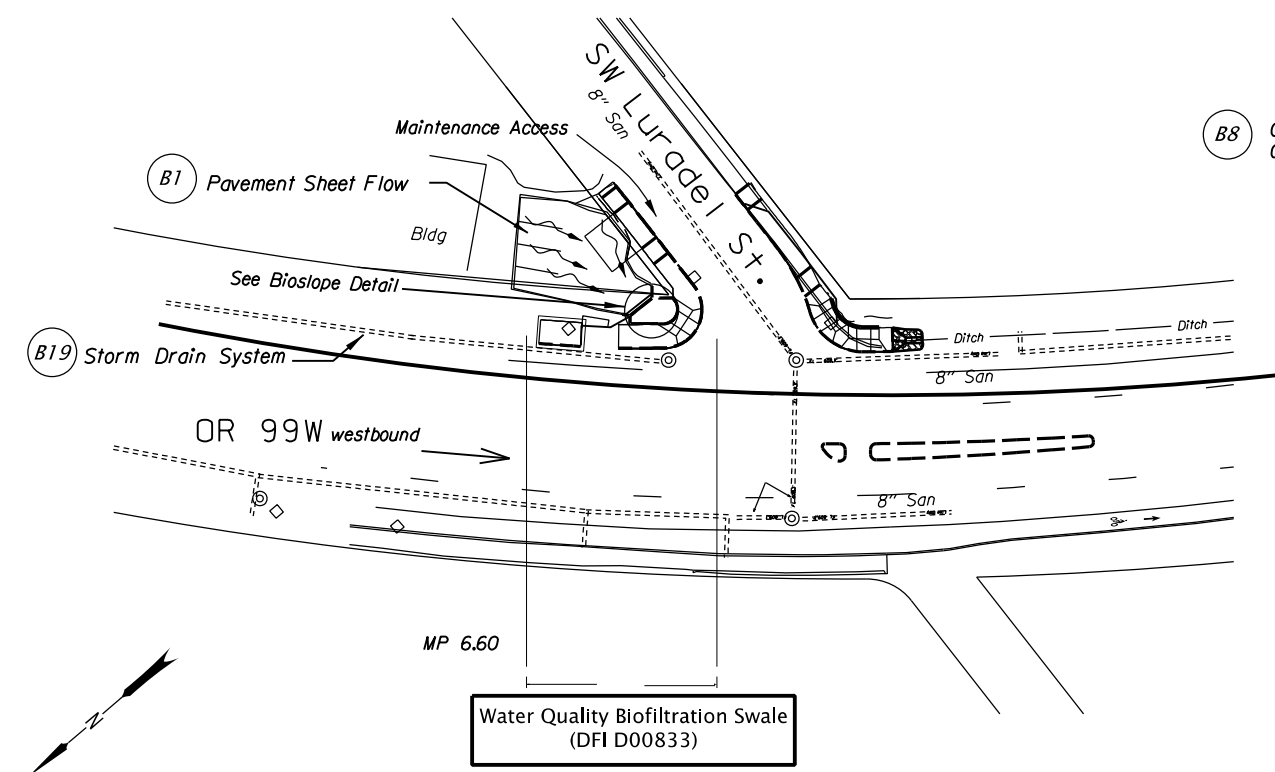

BIOSLOPE DETAIL

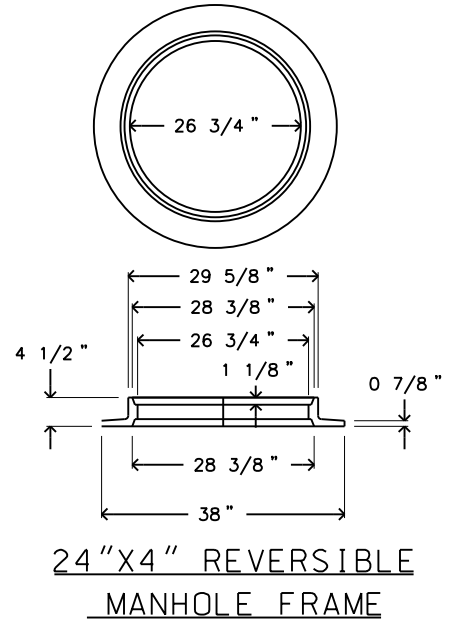

24"X4" REVERSIBLE MANHOLE FRAME

OREGON DEPARTMENT OF TRANSPORTATION

Sht. ## of ##
 Prepared By: Laila Bush
 Drafted By: McDonald/Kuehn

DFI D00833
MAINTENANCE DISTRICT 2B HWY 091
Water Quality Bioslope
 Pacific Highway MP 6.60
 Multnomah County

B Appendix B – Project Contract Plans

Contents:

Site Specific Subset of Project Contract Plan 46V-141


INDEX OF SHEETS	
SHEET NO.	DESCRIPTION
1	Title Sheet
1A	Index Of Sheets Cont. & Std. Drg. Nos.

STATE OF OREGON
 DEPARTMENT OF TRANSPORTATION
 PLANS FOR PROPOSED PROJECT
 SIGNAL & SIDEWALK

OR99W: SW BARBUR BLVD. AT SW LURADEL ST.
PEDESTRIAN CROSSING - SCP
 PACIFIC HIGHWAY WEST


MULTNOMAH COUNTY
 SEPTEMBER 2013

BEGINNING OF PROJECT
 STA. "C" 144+95 (M.P. 6.63)

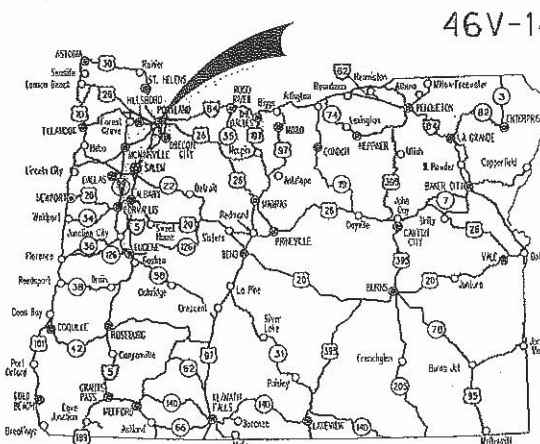


Overall Length Of Project - 0.10 Miles

ATTENTION:
 Oregon Law Requires You To Follow Rules Adopted By The Oregon Utility Notification Center. Those Rules Are Set Forth In OAR 952-001-0010 Through OAR 952-001-0090. You May Obtain Copies Of The Rules By Calling The Center. (Note: The Telephone Number For The Oregon Utility Center Is (503) 232-1987.)

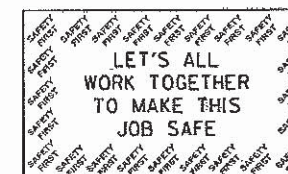

END OF PROJECT
 STA. "C" 146+42 (M.P. 6.53)

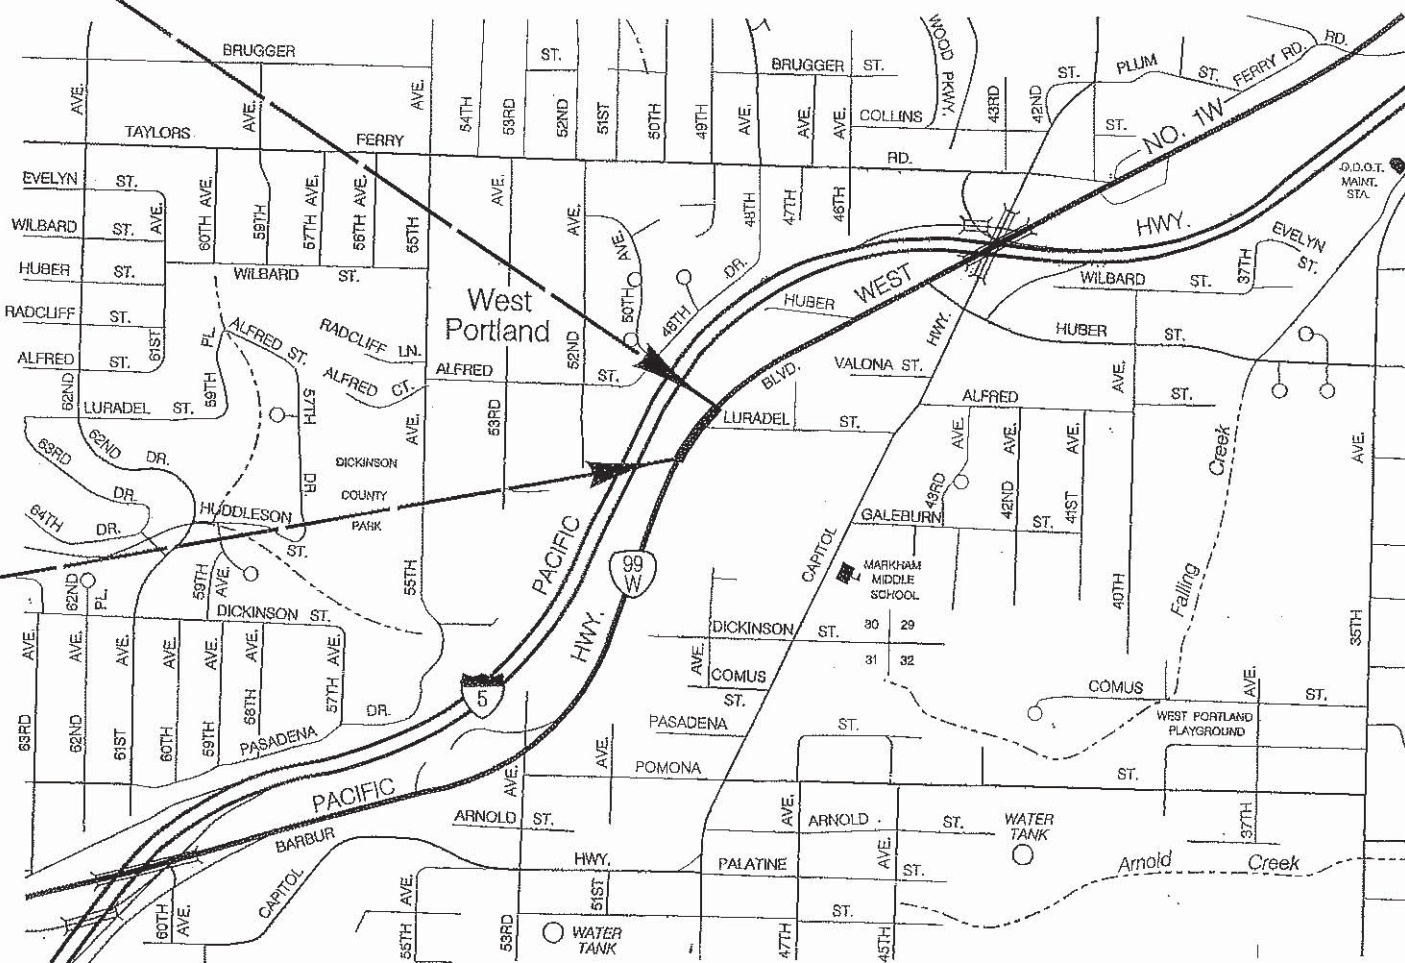

T. 1S., R. 1E., W.M.



"AS CONSTRUCTED"
 Wayne A. Stallen
 PROJECT MANAGER
 17 FEB 2015
 DATE

OR99W: SW BARBUR BLVD. AT SW LURADEL ST. PEDESTRIAN CROSSING - SCP PACIFIC HIGHWAY WEST MULTNOMAH COUNTY		
FEDERAL HIGHWAY ADMINISTRATION	PROJECT NUMBER	SHEET NO.
OREGON DIVISION	STATE	1

C8261136-000

INDEX OF SHEETS, CONT.	
SHEET NO.	DESCRIPTION
2B & 2B-2	Details
2C	Pipe Data Sheet
3	Alignment & General Construction
3A	Drainage & Utility Plan
3B	Drainage Profile
3C	Drainage Details
PERMANENT PAVEMENT MARKINGS	
ST	Striping Plan
PERMANENT SIGNING	
S-14094 Thru S-14096	Permanent Signing
TRAFFIC SIGNALS	
17362	Flashing Beacon Plan
17363	Flashing Beacon Details
17364	Rectangular Rapid Flashing Beacon

Standard Drg. Nos.

- RD300 - Trench Backfill, Bedding, Pipe Zone And Mult. Installations
- RD302 - Street Cut
- RD317 - Culvert Embankment Protection
- RD335 - Standard Storm Sewer Manhole
- RD336 - Standard Storm Sewer Manhole
- RD342 - Shallow Manholes
- RD344 - Standard Manhole Base Section
- RD356 - Manhole Covers And Frames
- RD364 - Concrete Inlets Type G-1, G-2, G-2M & G-2MA
- RD374 - Area Drainage Basin Or Field Inlet
- RD376 - Miscellaneous Drainage Structures Siphon Box, Inlet Cap & Inlet Adjustment
- RD386 - Fill Height Tables For Circular Concrete Pipe
- RD399 - Stormwater Treatment And Storage Facility Field Markers

- RD700 - Curbs
- RD701 - Drainage Curbs
- RD705 - Islands
- RD710 - Accessible Route Islands
- RD715 - Approaches And Non-Sidewalk Driveways
- RD720 - Sidewalks
- RD750 - Curb Line Sidewalk Driveways Or Alleys (Options M & N) Local Jurisdictions
- RD755 - Sidewalks Ramp Details
- RD759 - Truncated Dome Detectable Warning Surface Details & Locations

- TM200 - Sign Installation Details
- TM201 - Miscellaneous Sign Placement Details
- TM223 - Conventional Roads Directional Sign Layout Street Name Signs


- TM457 - Vehicle, Pedestrian Signal And Push Button Mounting Option Details
- TM458 - Pedestrian Ramp Placement Details
- TM467 - Pedestrian Signal And Pedestrian Push Button Details

- TM500, TM502 & TM503 - Pavement Marking Standard Detail Blocks
- TM520 - Durable Pavement Markings Method "A" Profile
- TM530 - Intersection Pavement Markings (Crosswalk, Stop Bar & Bike Lane Stencil)
- TM560 - Alignment Layout: General

- TM635 - Breakaway Sign & Luminaire Supports - Support Location Guidelines
- TM670 - Wood Post Sign Supports
- TM671 - 3 Second Gust Wind Speed Map
- TM676 - Sign Attachments
- TM677 - Sign Mounts
- TM681 - Perforated Steel Square Tube (PSST) Sign Support Installation
- TM687 - Perforated Steel Square Tube (PSST) Anchor Foundation
- TM688 - Perforated Steel Square Tube (PSST) Slip Base Foundation


- TM800 - Tables, Abrupt Edge And PCMS Details
- TM820 - Temporary Barricades
- TM821 - Temporary Sign Supports
- TM841 - Intersection Work Zone Details
- TM844 - Temporary Pedestrian Access Routing
- TM851 - Non-Freeway Multi-Lane Sections

R/W Map No. 6B-11-2

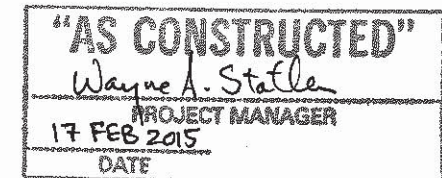

OR99W: SW BARBUR BLVD AT SW LURADEL ST PEDESTRIAN CROSSING SCP PACIFIC HIGHWAY WEST MULTNOMAH COUNTY		
FEDERAL HIGHWAY ADMINISTRATION	PROJECT NUMBER	SHEET NO.
OREGON DIVISION	STATE	1A

Standard Drawings located on the web at:
http://www.oregon.gov/ODOT/HWY/ENGSERVICES/pages/standard_drawings_home.aspx

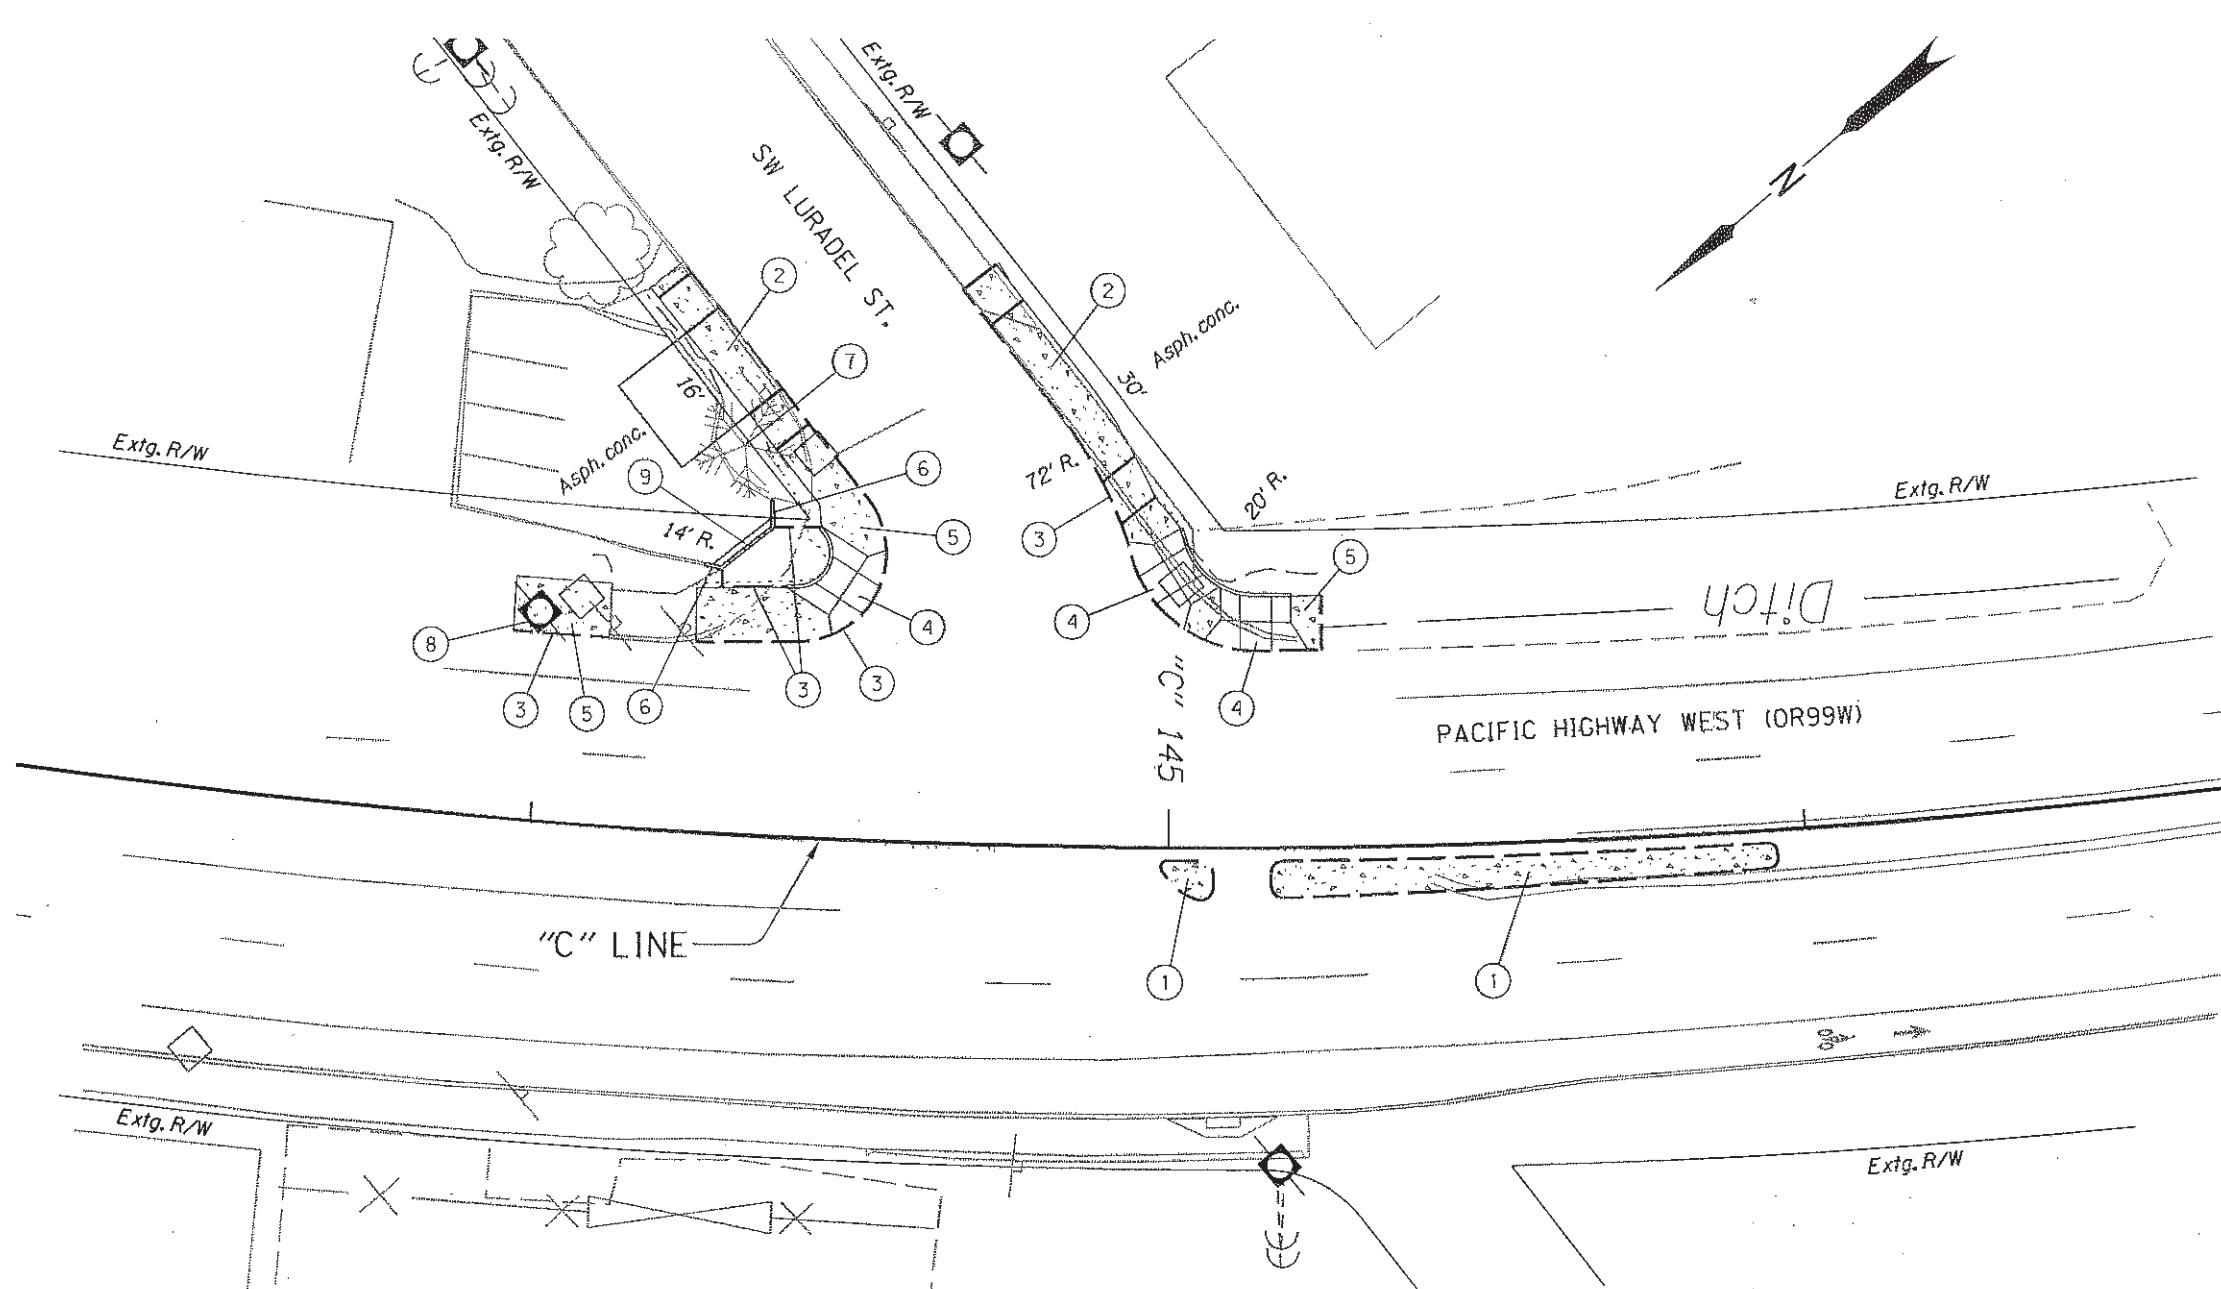

- ① Const. type "C" conc. island (non-mountable) - 860 sq.ft. (For details, see sht. 2B) (See drg. no. RD705)
- ② Const. P.C. conc. driveway Option "N" - 2 (490 sq.ft.) (See drg. no. RD750)
- ③ Const. standard curb - 200' Curb exposure E=7" (See drg. no. RD700)
- ④ Const. combination sidewalk ramp - 3 (See drg. no. RD755)
- ⑤ Const. conc. sidewalk - 740 sq.ft. (See drg. no. RD720)
- ⑥ Const. drainage conc. curb - 15' (See drg. no. RD701)
- ⑦ Protect & preserve tree (As directed)
- ⑧ Preserve and protect existing pole (As directed)
- ⑨ Const. curb & gutter - 12' (For details, see 3C)

"AS CONSTRUCTED"
 Wayne A. Statler
 PROJECT MANAGER
 17 FEB 2015
 DATE


OREGON DEPARTMENT OF TRANSPORTATION

REGION 1 - ROADWAY ENGINEERING SECTION

OR99W: SW BARBUR BLVD. AT SW LURADEL ST.
 PEDESTRIAN CROSSING - SCP
 PACIFIC HIGHWAY WEST
 MULTNOMAH COUNTY

Design Team Leader - John Wolf
 Designed By - Zdenek Vymazal
 Drafted By - Jalal Heydarpoor

REGISTERED PROFESSIONAL
 ENGINEER
 808879
 OREGON
 JUN. 11, 2008
 JOHN P. WOLF
 EXPIRES: 06-30-2014

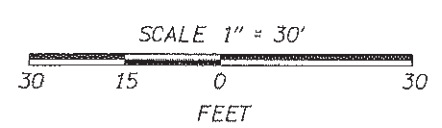

ALIGNMENT & GENERAL CONSTRUCTION


SHEET NO.
3

Erosion Control General Notes:

Provide an erosion and sediment control plan in compliance with Section 00280 of the Oregon Standard Specifications for Construction and Special Provisions. Implement this plan for all clearing and grading activities to prevent sediment-laden water from entering the roadway or drainage system, or violating applicable water standards.

At a minimum, install and maintain Type 3 inlet protection in all catch basins, install and maintain check dams in outflowing drainage channels, and Apply straw mulch to all exposed soils as needed or as directed to control erosion.

No.	DATE	REVISIONS	BY
1	10-03-2013	Moved Inlet & added water valves	BSC

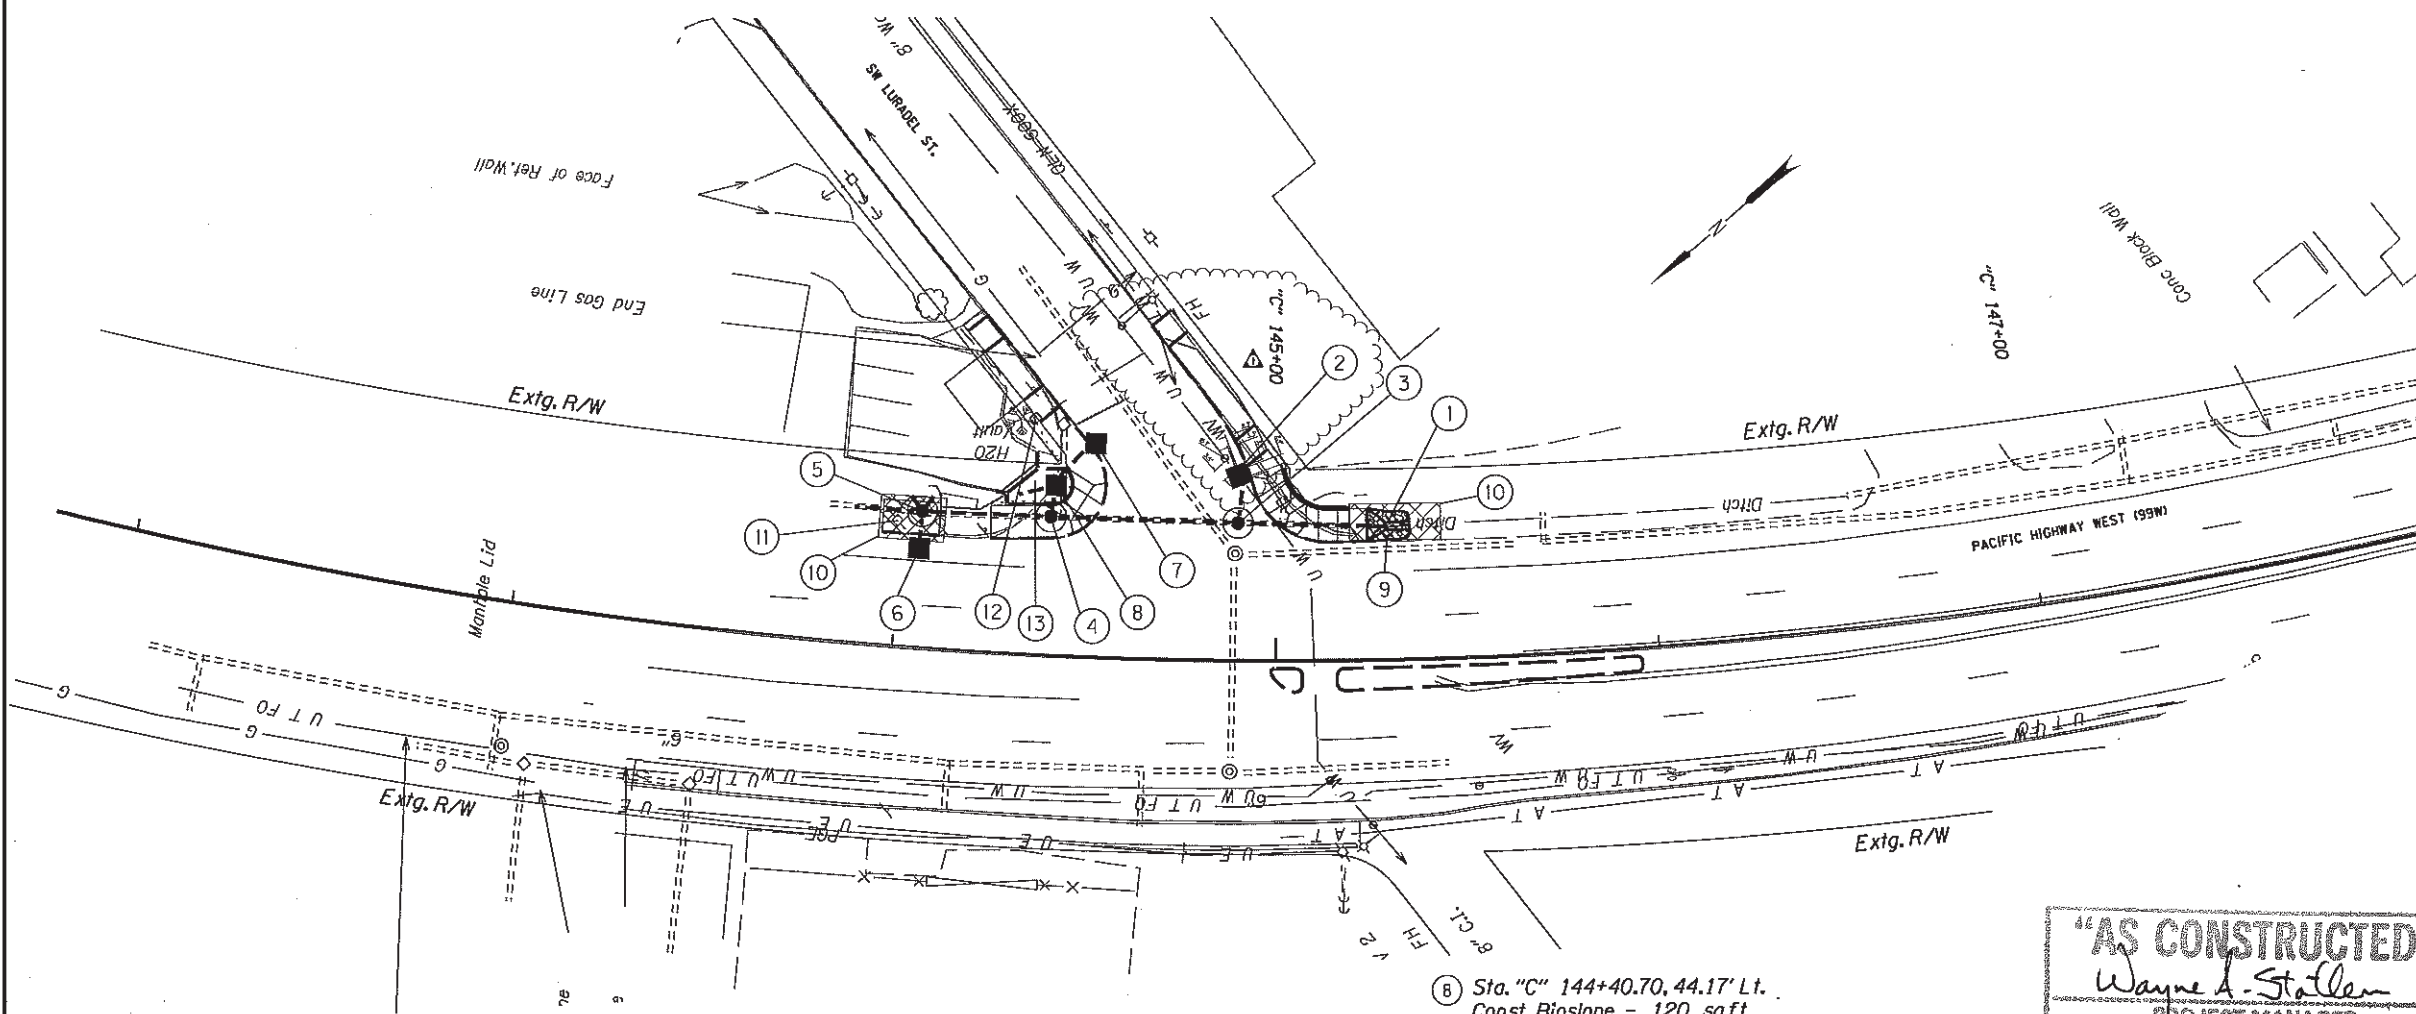


- ① Sta. "C" 145+24.06, 34.75' Lt.
Remove Extg. 12" Conc. Pipe - 29'
Inst. 12" Storm Sewer Pipe - 38'
5' depth
Trench Resurf. - 3 Sq.Yd.
(See drg. nos. RD300, RD386, & RD302)
- ② Sta. "C" 144+92.47, 49.18' Lt.
Remove Extg. Inlet
Remove Extg. 12" Conc. Pipe - 6'
Const. Type "G-2" Inlet
Inst. 12" Storm Sewer Pipe - 22'
5' depth
Trench Resurf. - 7 Sq.Yd.
(See drg. no. RD364)
- ③ Sta. "C" 144+89.83, 35.74' Lt.
Remove Extg. 12" Conc. Pipe - 49'
Const. 48" Shallow Manhole
Inst. 12" Storm Sewer Pipe - 49'
5' depth
Trench Resurf. - 13 Sq.Yd.
(See drg. nos. RD335, RD336, RD342, RD344, & RD356)
- ④ Sta. "C" 144+39.62, 36.02' Lt.
Remove Extg. 12" Conc. Pipe - 33'
Const. 48" Shallow Manhole
Inst. 12" Storm Sewer Pipe - 33'
5' depth
- ⑤ Sta. "C" 144+05.43, 35.48' Lt.
Remove Extg. Inlet
Const. 48" Storm Sewer Manhole
Connect Extg. 6" Drain Pipe - 2
- ⑥ Sta. "C" 144+05.18, 26.53' Lt.
Const. Type "G-2" Inlet
Inst. 12" Storm Sewer Pipe - 8'
5' depth
- ⑦ Sta. "C" 144+50.92, 55.49' Lt.
Remove Extg. Inlet
Remove Extg. 12" Conc. Pipe - 28'
Const. Type "G-2" Inlet
Inst. 12" Storm Sewer Pipe - 15'
5' depth

- ⑧ Sta. "C" 144+40.70, 44.17' Lt.
Const. Bioslope - 120 sq.ft.
Const. Area Drainage Basin w/ Beehive Inlet Grate
(For Details See Sht. 3C & drg. no. RD374)
Inst. 6" Drain Pipe - 10'
5' depth
Inst. 12" Storm Sewer Pipe - 10'
5' depth
- ⑨ Sta. "C" 145+24.05, 34.75' Lt.
Const. Riprap Basin - 5 Cu.Yd.
(See drg. RD 317)

- ⑩ Remove Exposed Topsoil 0-2' Feet
Material Contains Petroleum Hydrocarbons
And Will Be Disposed Of At A Landfill
Per Special Provision 00294.
Removal Area Shown Thus:
- ⑪ Preserve And Protect Utility Pole
- ⑫ Adjust Water Vault


"AS CONSTRUCTED"
Wayne A. Stollen
PROJECT MANAGER
17 FEB 2015
DATE

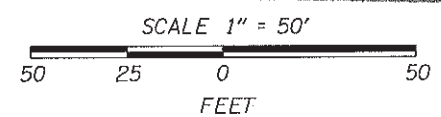

STORMWATER FIELD MARKER TABLE

FACILITY LOCATION		DFI #	TYPE S2 MARKER LOCATION		TYPE S1 MARKER	
STATION "E2"	MP		BEGIN	END	RED	GREEN
144+40.70	6.54	TBD	✓		✓	
144+40.80	6.55	TBD		✓		✓

✓ Check where appropriate
Red = Beginning of facility
Green = End of facility

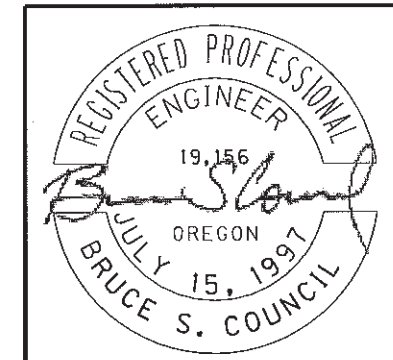

RENEWS: 12-31-2013

OREGON DEPARTMENT OF TRANSPORTATION

REGION I - Geo/Hydro/HazMat Unit



**OR99W: SW BARBUR BLVD. AT SW LURADEL ST.
PEDESTRIAN CROSSING - SCP**

PACIFIC HIGHWAY WEST
MULTNOMAH COUNTY

Reviewed By - Bruce Council
Designed By - David McDonald
Drafted By - David McDonald

DRAINAGE & UTILITIES



SHEET NO.
3A

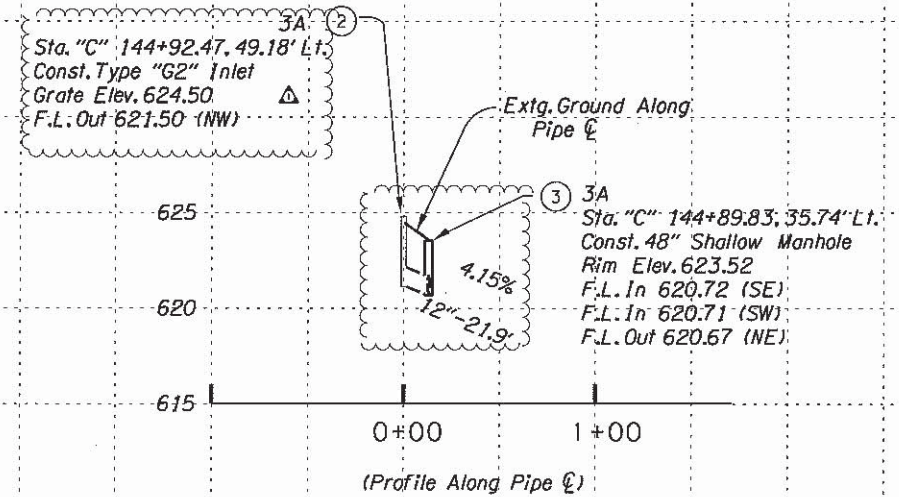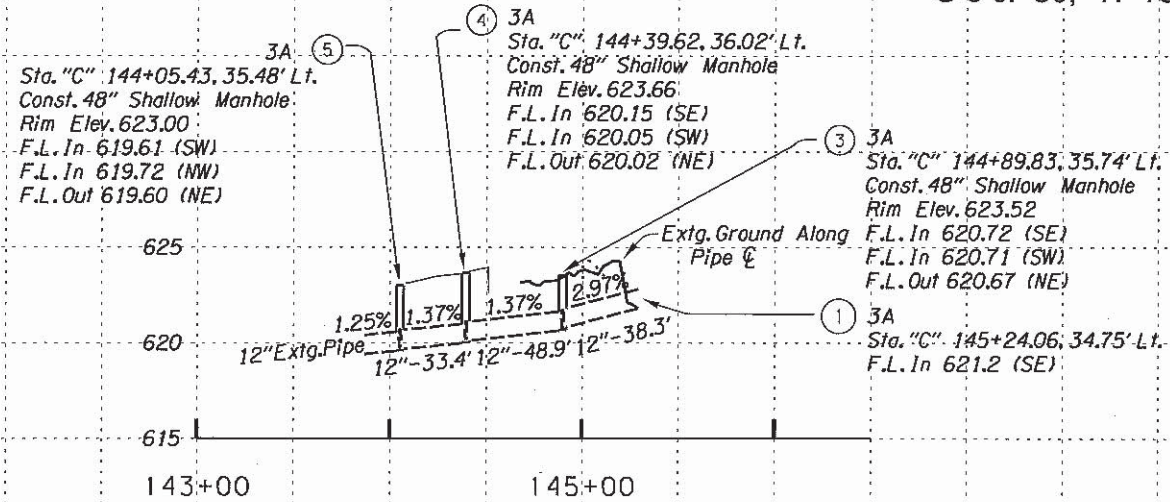

No.	DATE	REVISIONS	BY
1	10-03-2013	Moved Inlet & added water valves	BSC

"C" Line
(Profile Along Pipe \varnothing)


(Profile Along Pipe \varnothing)

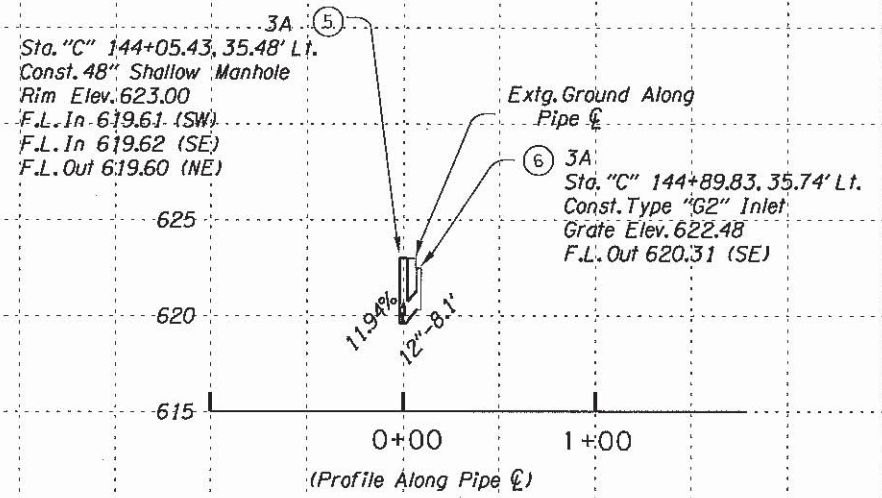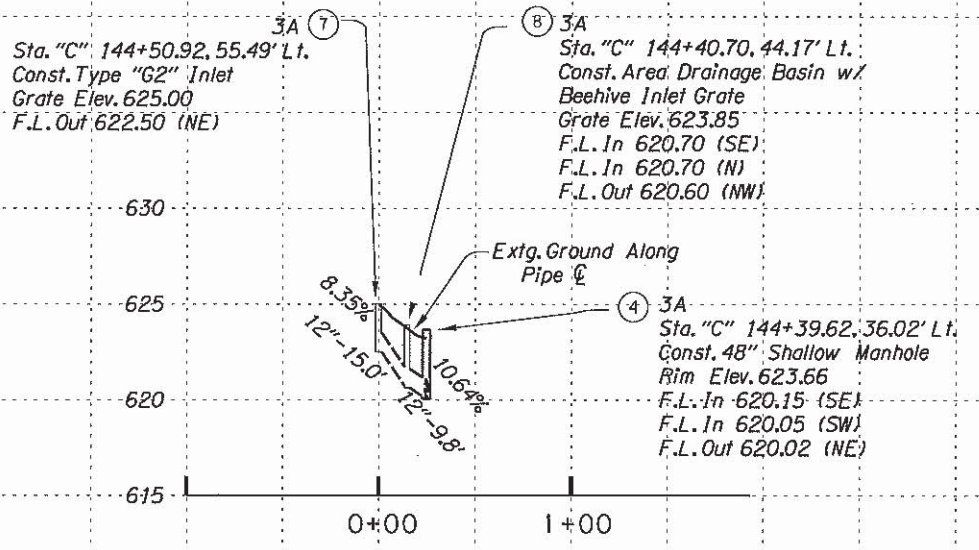

(Profile Along Pipe \varnothing)

(Profile Along Pipe \varnothing)

"AS CONSTRUCTED"
 Wayne A. Statler
 PROJECT MANAGER
 17 FEB 2015
 DATE

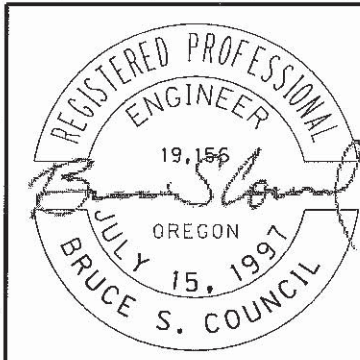

RENEWS: 12-31-2013

OREGON DEPARTMENT OF TRANSPORTATION


REGION 1 - Geo/Hydro/HazMat Unit

**OR99W: SW BARBUR BLVD. AT SW LURADEL ST.
 PEDESTRIAN CROSSING - SCP**
 PACIFIC HIGHWAY WEST
 MULTNOMAH COUNTY

Reviewed By - Bruce Council
 Designed By - David McDonald
 Drafted By - David McDonald


PROFILE

SHEET NO.
3B

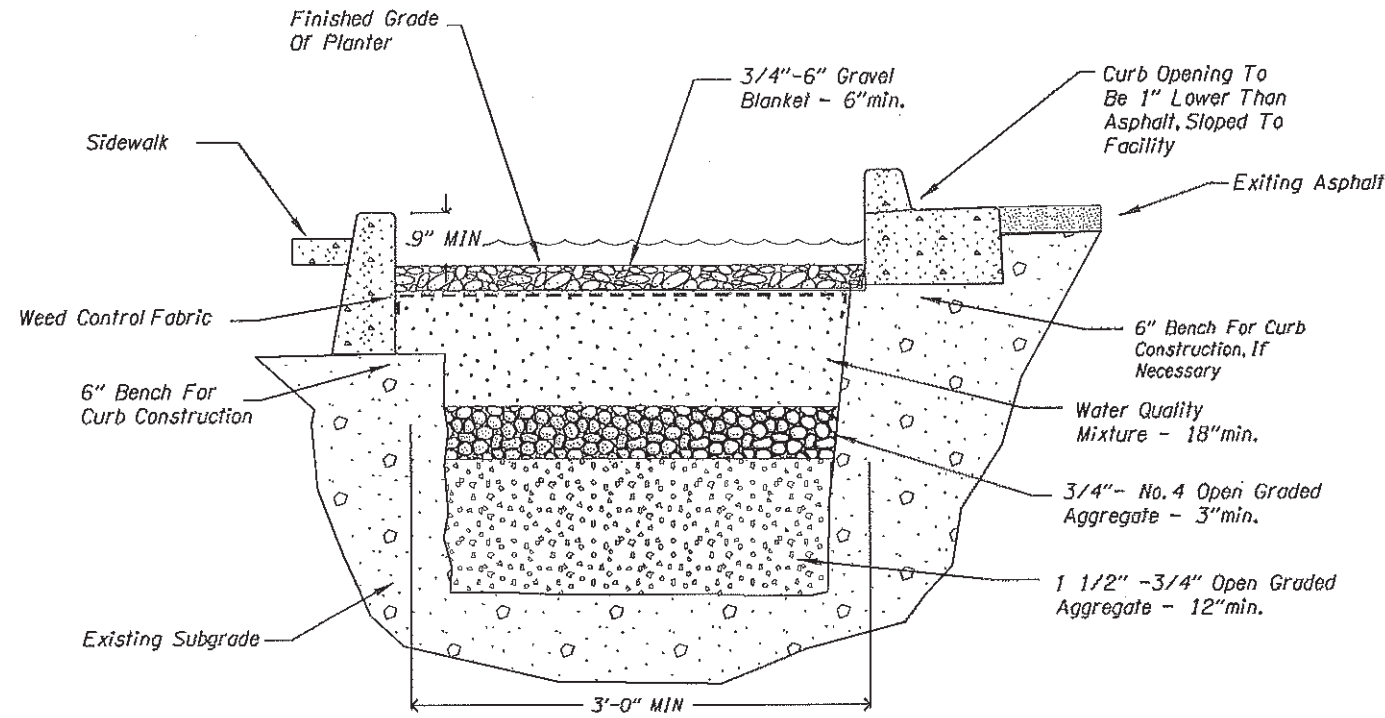


BIOSLOPE DETAIL



1/8"-3/16" Stainless Steel Wire Rope, Secure Grate In Place With 54-Inches Of Wire Rope, Loop Ends Of Wire Around U-Bolts And Grate. Crimp Each End Of Wire Rope With 3" Overlap.

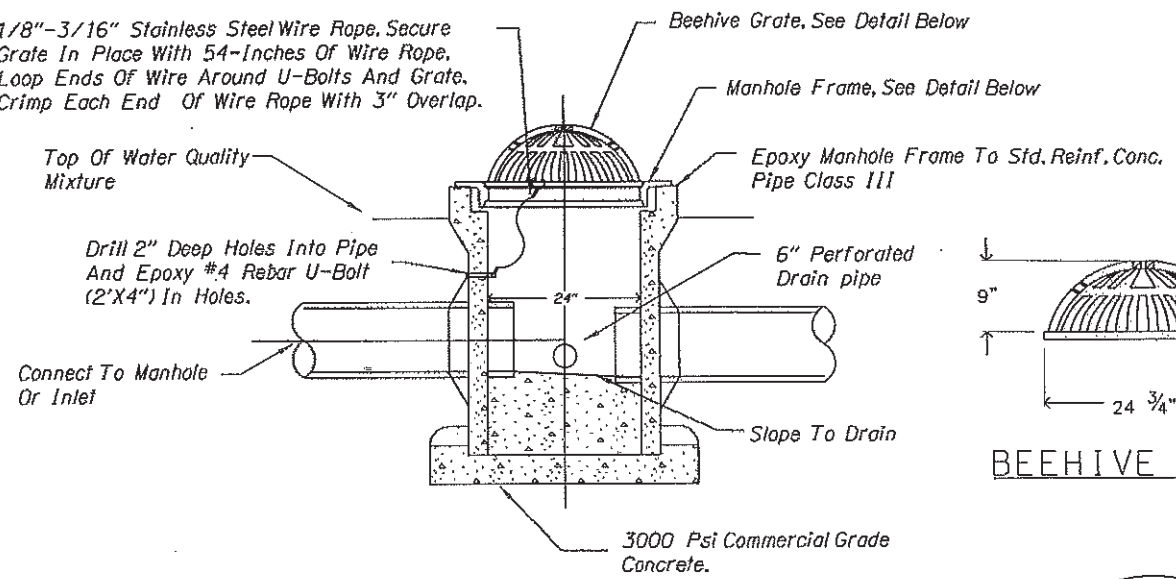


AREA DRAINAGE BASIN

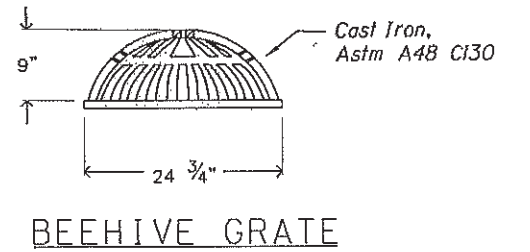


BEEHIVE GRATE

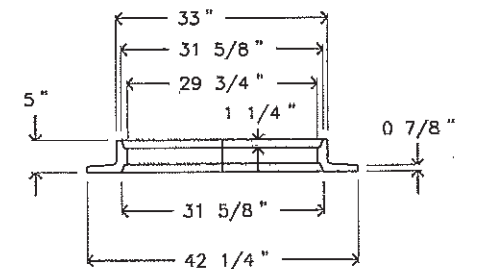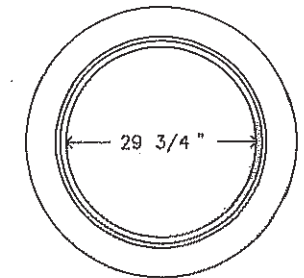


24"X4" REVERSIBLE MANHOLE FRAME

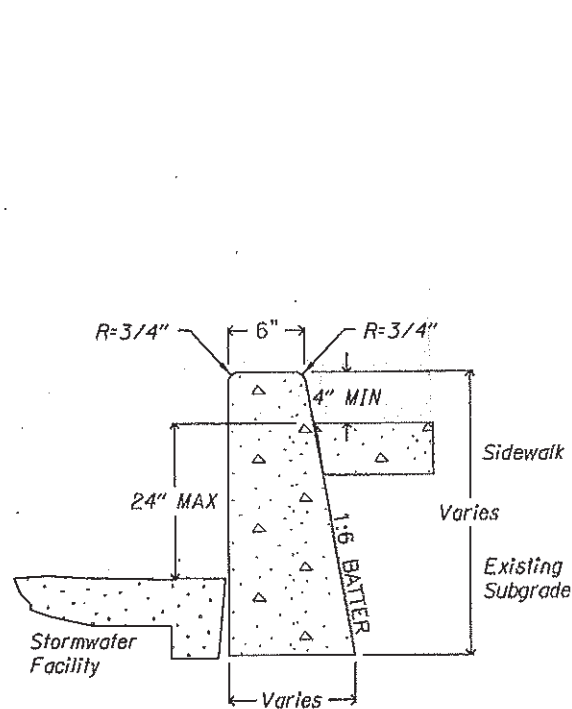

Standard Curb Detail

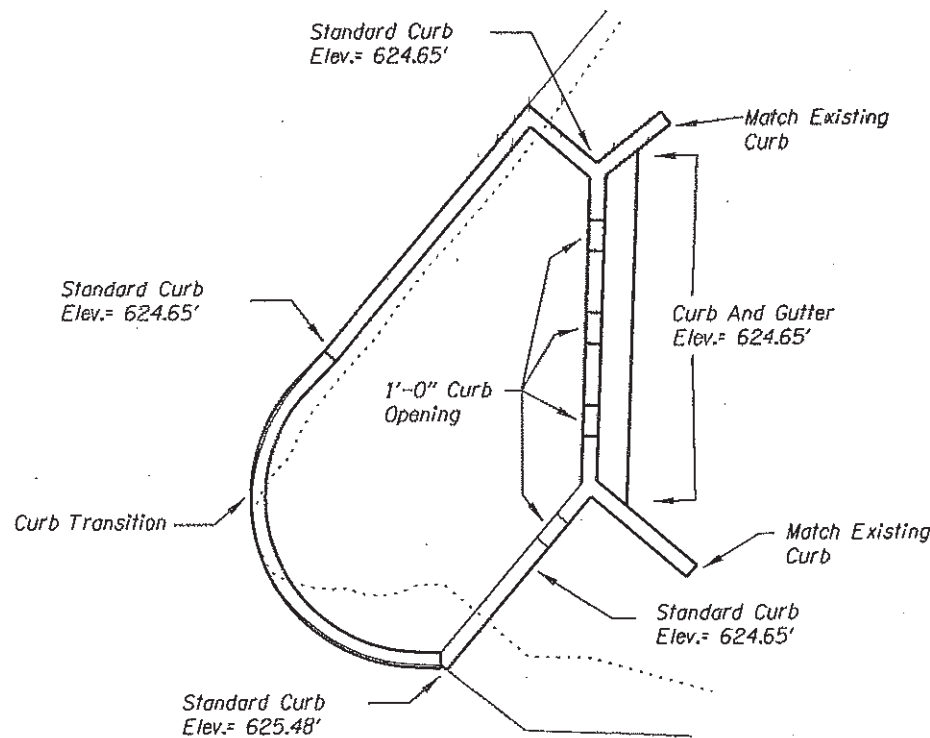


BIOSLOPE DETAIL

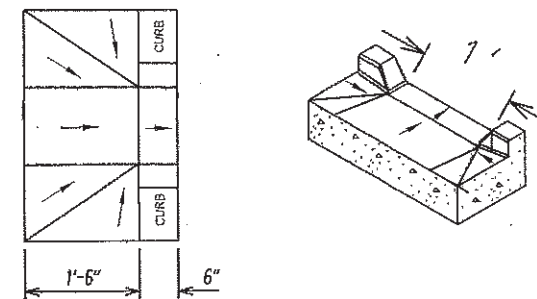

CURB OPENING DETAIL

Details Not to Scale

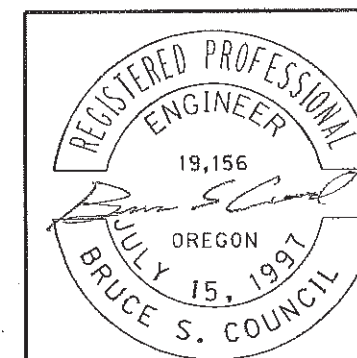

RENEWS: 12-31-2013

OREGON DEPARTMENT OF TRANSPORTATION	
REGION 1 - Geo/Hydro/HazMat Unit	
OR99W: SW BARBUR BLVD. AT SW LURADEL ST. PEDESTRIAN CROSSING - SCP PACIFIC HIGHWAY WEST MULTNOMAH COUNTY	
Reviewed By - Bruce Council Designed By - David McDonald Drafted By - David McDonald	
DRAINAGE & UTILITIES	SHEET NO. 3C

"AS CONSTRUCTED"
 Wayne A. Stallen
 PROJECT MANAGER
 17 FEB 2015
 DATE