

OPERATION & MAINTENANCE MANUAL

DFI No.: D00836

**Facility Type: Water Quality
Bioretention Pond**



November, 2018

1. Identification

Drainage Facility ID (DFI): **D00836**
Facility Type: Water Quality Bioretention Pond
Construction Drawings: 49V-019
Location: District: 08
Highway No.: 022
Mile Post: 1.00; 1.06 (beg./end)
Description: This facility is located along the north side of OR 62 east of the Poplar/Bullock intersection. Access is located via OR 62.

2. Facility Contact Information

Contact the Engineer of Record, Region Technical Center, or Geo-Environmental's Senior Hydraulics Engineer for:

- Operational clarification
- Maintenance clarification
- Repair or restoration assistance

Engineering Contacts:

Region Technical Center Hydro Unit Manager

Or

Geo-Environmental Senior Hydraulics Engineer (503) 986-3365.

3. Construction

Engineer of Record: Ben Wewerka – OBEC Consulting Engineers
Facility construction: 2018
Contractor: LTM, Inc. dba Knife River Materials

4. Storm Drain System and Facility Overview

A water quality bioretention pond is a basin that is designed to capture stormwater runoff and infiltrate it through a water quality mixture to remove pollutants. Pollutant removal is accomplished through physical, biological, and chemical treatment processes. The size of these facilities depends on the location and the amount of contributing impervious area.

This bioretention pond facility is located along the north side of OR 62 east of the Poplar/Bullock intersection. Access for this facility is available from a gated access road that connects to the multi-use path located on the north side of OR 62. The drainage is collected by a series of inlets and conveyed to the facility by a 36-inch storm pipe. The drainage area includes westbound and eastbound lanes of the OR 62. All stormwater is conveyed into the bioretention pond and drains out through a Type D Outlet structure and outfalls into a ditch that eventually flows into Bear Creek; see the Operational Plan, Appendix A.

A. Maintenance equipment access:

The facility can be accessed by a gated access road that connects to the multi-use path located on the north side of OR 62.

B. Heavy equipment access into facility:

Allowed (no limitations)

Allowed (with limitations)

Heavy equipment is restricted to the access road on the perimeter of the facility due to the lack of porous pavers inside the facility.

Not allowed

C. Special Features:

Amended Soils

Porous Pavers

Liners

Underdrains

5. Facility Haz Mat Spill Feature(s)

The water quality bioretention pond can be used to store a volume of liquid by blocking the Type D outlet structure.

6. Auxiliary Outlet (High Flow Bypass)

Auxiliary Outlets are provided if the primary outlet control structure can not safely pass the projected high flows. Broad-crested spillway weirs and over flow risers are the two most common auxiliary outlets used in stormwater treatment facility design. The auxiliary outlet feature is either a part of the facility or an additional storm drain feature/structure.

The auxiliary outlet feature for this facility is:

- Designed into facility
- Other, as noted below

7. Maintenance Requirements

Routine maintenance table for non-proprietary stormwater treatment and storage/detention facilities have been incorporated into ODOT's Maintenance Guide. These tables summarize the maintenance requirements for ponds, swales, filter strips, bioslopes, and detention tanks and vaults. Special maintenance requirements in addition to the routine requirements are noted below when applicable.

The ODOT Maintenance Guide can be viewed at the following website:

<http://www.oregon.gov/ODOT/HWY/OOM/MGuide.shtml>

Maintenance requirements for proprietary structures, such as underground water quality manholes and/or vaults with filter media are noted in Appendix C when applicable.

The following stormwater facility maintenance table (See ODOT Maintenance Guide) should be used to maintain the facility outlined in this Operation and Maintenance Manual or follow the Maintenance requirements outlined in Appendix C when proprietary structure is selected below:

- Table 1 (general maintenance)
- Table 2 (stormwater ponds)
- Table 3 (water quality or biofiltration swales)
- Table 4 (water quality filter strips)
- Table 5 (water quality bioslopes)
- Table 6 (detention tank)
- Table 7 (detention vault)
- Appendix C (proprietary structure)

Special Maintenance requirements:
Note: Special maintenance Requirements Require Concurrence from
ODOT SR Hydraulics Engineer.

8. Waste Material Handling

Material removed from the facility is defined as waste by the Department of Environment Quality (DEQ). Refer to the roadwaste section of the ODOT Maintenance Yard Environmental Management System (EMS) Policy and Procedures Manual for disposal options:

http://www.oregon.gov/ODOT/Maintenance/Documents/ems_manual.pdf




Contact any of the following for more detailed information about management of waste materials found on site:

ODOT Clean Water Unit	(503) 986-3008
ODOT Statewide Hazmat Coordinator	(503) 667-7442
ODOT Region 1 Hazmat Coordinator	(503) 731-8290
ODOT Region 2 Hazmat Coordinator	(503) 986-2647
ODOT Region 3 Hazmat Coordinator	(541) 957-3594
ODOT Region 4 Hazmat Coordinator	(541) 388-6186
ODOT Region 5 Hazmat Coordinator	(541) 963-1590
ODEQ Northwest Region Office	(503) 229-5263

Appendix A

Content:

- **Operational Plan and Profile Drawing(s)**

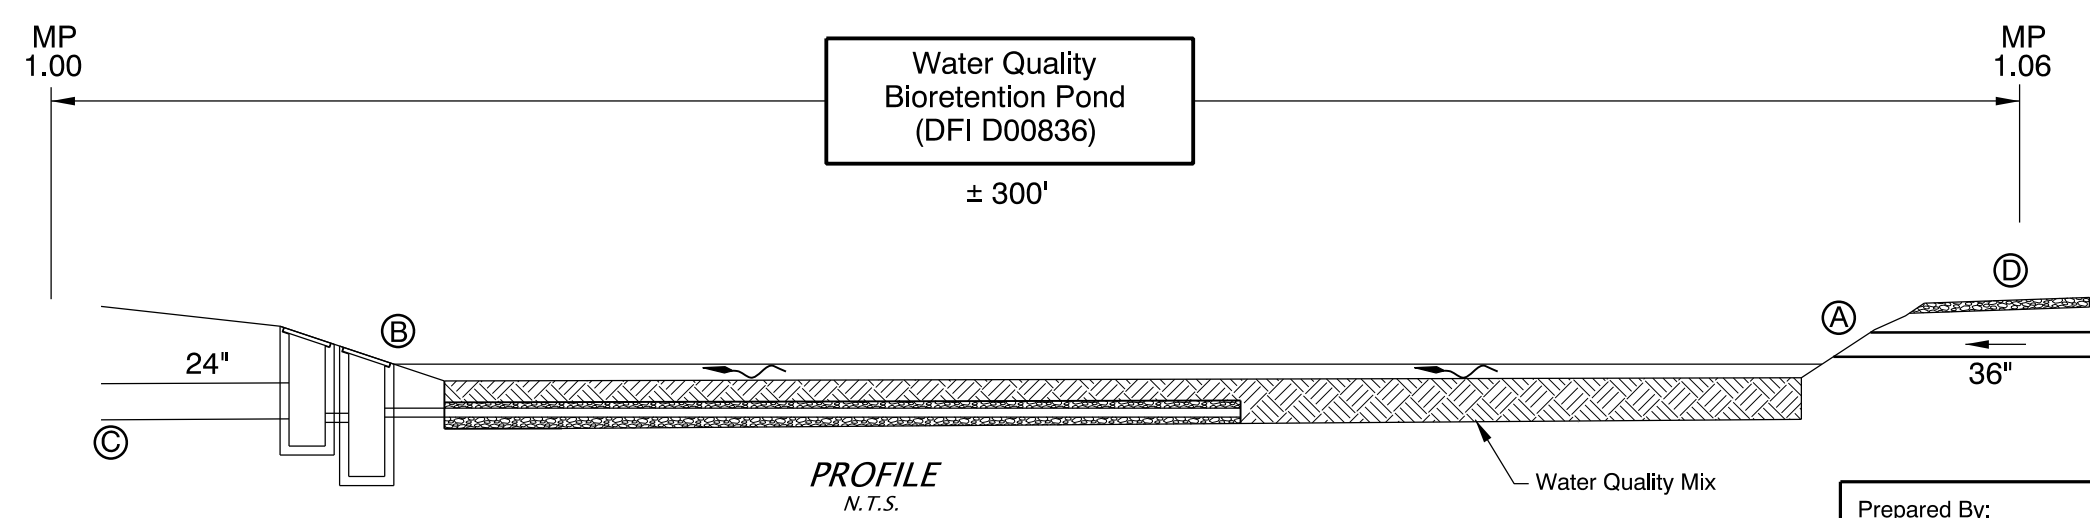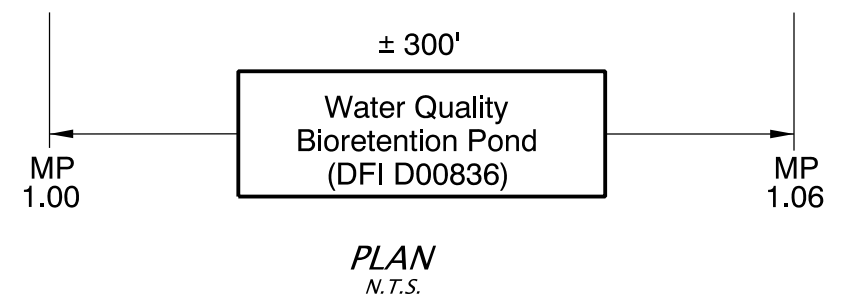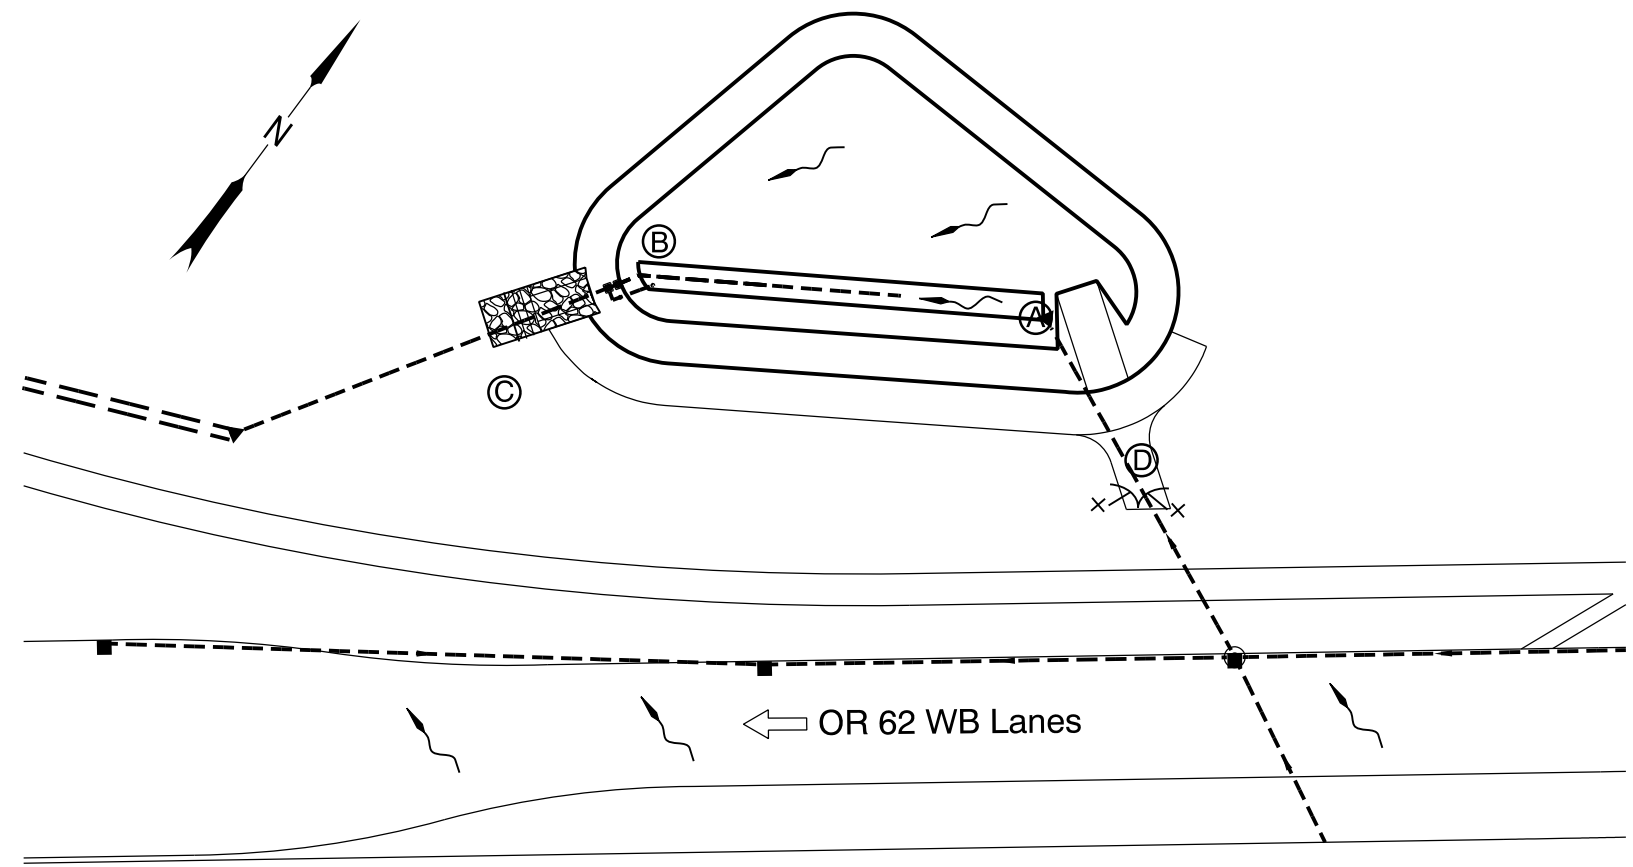

- LEGEND:
- (A) Pond Inlet
 - (B) Pond Outlet
 - (C) Outfall
 - (D) Maintenance Access
 - and ○ Manhole
 - and □ Inlet
 - - - Storm Pipe (Facility)
 - - - Storm Pipe
 - ← Conveyance Direction
 - ~ Pavement / Facility Flow Path

OREGON DEPARTMENT OF TRANSPORTATION

Prepared By: J. GONZALEZ
 Drafted By: J. GONZALEZ

DFI D00836
MAINTENANCE DISTRICT 08 HWY 022
WATER QUALITY BIORETENTION POND
 HIGHWAY MP 1.00 TO 1.06
 JACKSON

Appendix B

Content:

- **ODOT Project Plan Sheets**
 - *Cover/Title Sheet*
 - *Water Quality/Detention Plan Sheets*
 - *Other Details*

INDEX OF SHEETS	
SHEET NO.	DESCRIPTION
1	Title Sheet
1A	Index Of Sheets Cont'd.

STATE OF OREGON
DEPARTMENT OF TRANSPORTATION

PLANS FOR PROPOSED PROJECT

GRADING, DRAINAGE, STRUCTURES, PAVING, SIGNING,
ILLUMINATION, SIGNALS & ROADSIDE DEVELOPMENT

OR62: CORRIDOR SOLUTIONS UNIT 2 (MEDFORD)

CRATER LAKE HIGHWAY

JACKSON COUNTY

FEBRUARY 2016

BEGINNING OF PROJECT

STP-S022(040)

STA. "B" 2197+00 (M.P. 1.69)

BEGINNING OF PROJECT



STP-S022(040)

STA. "EX" 2297+00 (M.P. 1.73)

END OF PROJECT

STP-S022(040)

STA. "NBB" 155+58 (M.P. 0.70)

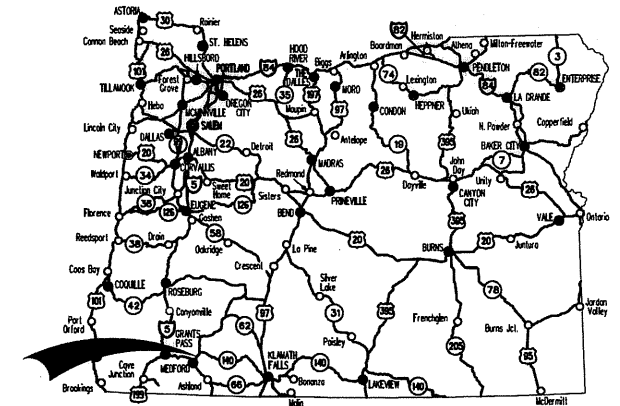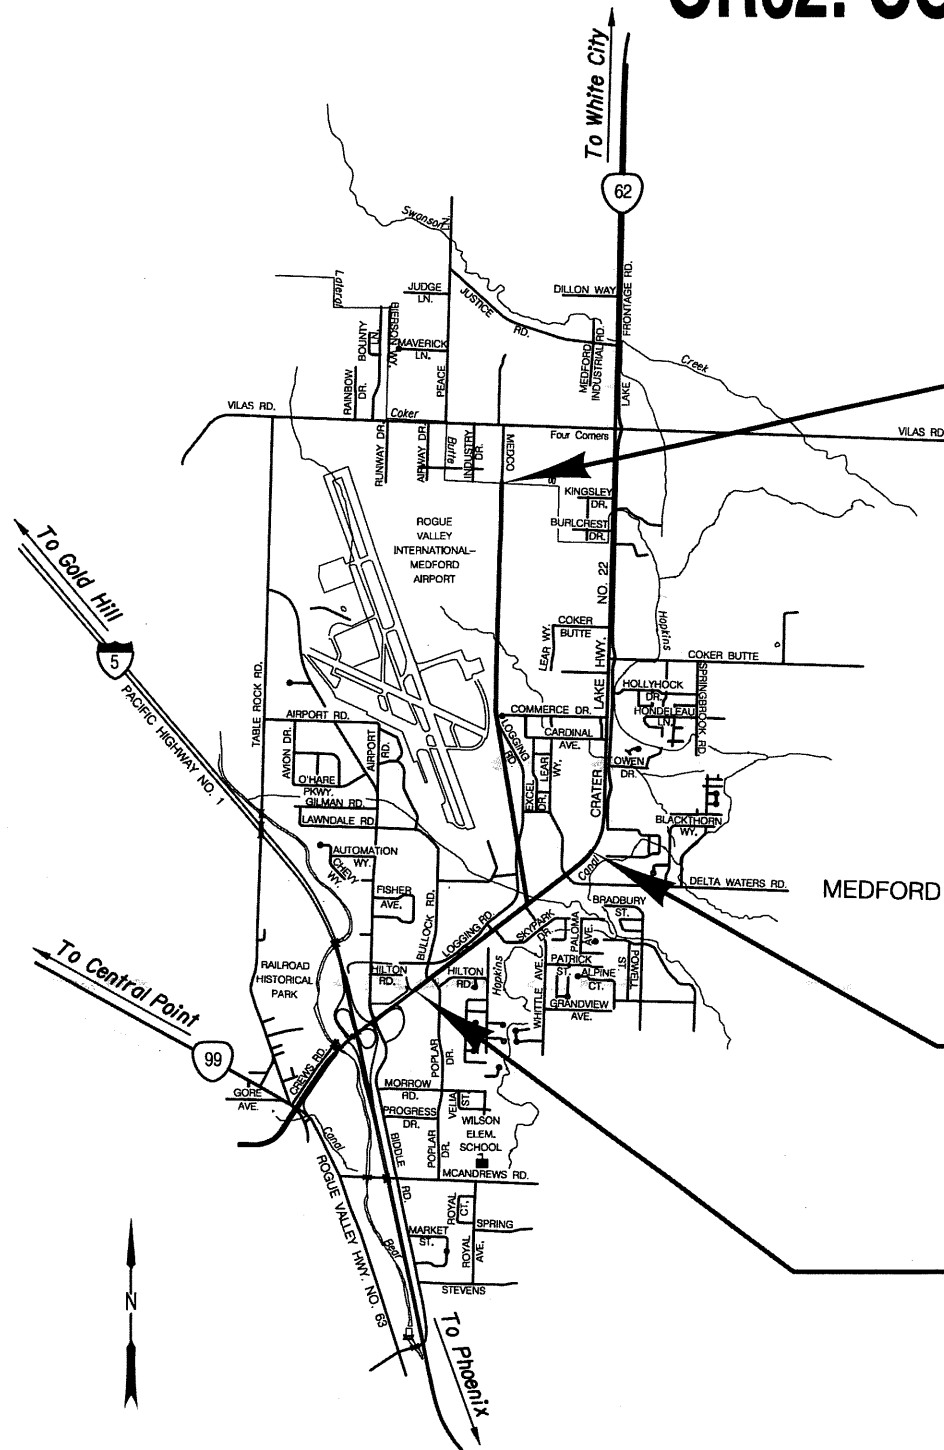

Overall Length Of Project - 2.70 Miles

ATTENTION:
Oregon Law Requires You To Follow Rules Adopted By The Oregon Utility Notification Center. Those Rules Are Set Forth In OAR 952-001-0010 Through OAR 952-001-0090. You May Obtain Copies Of The Rules By Calling The Center. (Notes The Telephone Number For The Oregon Utility Center Is (503) 232-1987.)



PLANS PREPARED FOR
OREGON DEPARTMENT OF TRANSPORTATION
OBEC CONSULTING ENGINEERS
CORPORATE OFFICE: 920 COUNTRY CLUB ROAD, SUITE 100B EUGENE, OREGON 97401-6088
REGIONAL OFFICES: LAKE OSWEGO; SALEM; MEDFORD, OREGON; VANCOUVER, WASHINGTON
www.obec.com

OREGON TRANSPORTATION COMMISSION
 Tammy Baney CHAIR
 Sean O'Hollaren COMMISSIONER
 Alando Simpson COMMISSIONER
 Susan Morgan COMMISSIONER
 David Lohman COMMISSIONER
 Matthew L. Garrett DIRECTOR OF TRANSPORTATION

These plans were developed using ODOT design standards. Exceptions to these standards, if any, have been submitted and approved by the ODOT Chief Engineer or their delegated authority.

Approving Authority: *Jaime Jordan*
Signature & date
 JAIME JORDAN - PROJECT MANAGER
Print name and title
Matthew L. Garrett
Concurrence by ODOT Chief Engineer

OR62: CORRIDOR SOLUTIONS UNIT 2 (MEDFORD)
CRATER LAKE HIGHWAY
JACKSON COUNTY

FEDERAL HIGHWAY ADMINISTRATION	PROJECT NUMBER	SHEET NO.
OREGON DIVISION	STATE	1

Sec. 6, 7, 18, T. 37 S., R. 1 W., W.M.

INDEX OF SHEETS CONT'D.	
SHEET NO.	DESCRIPTION
1A-2	Index Of Sheets Cont'd.
1A-3	Std. Drg. Nos.
1A-4	Layout Sheet
1B, 1B-2	Prospective Staging Area
2, 2A Thru 2A-25 Incl.	Typical Sections
2B Thru 2B-37 Incl.	Details
2C, 2C-2	Traffic Control Details
2C-3 Thru 2C-5A Incl.	Traffic Control Plan Advance Signing
2C-6 Thru 2C-19 Incl.	Traffic Control Plan
2C-19A	Traffic Control Plan Section
2C-19B	Traffic Control Plan Temporary Drainage
2C-20, 2C-21	Traffic Control Plan
2C-21A	Traffic Control Plan Section
2C-21B	Traffic Control Plan Temporary Drainage
2C-22, 2C-23	Traffic Control Plan
2C-23A	Traffic Control Plan Section
2C-23B	Traffic Control Plan Temporary Drainage
2C-24 Thru 2C-30 Incl.	Traffic Control Plan
2C-30A	Traffic Control Plan Temporary Drainage
2C-31 Thru 2C-50 Incl.	Traffic Control Plan
2D Thru 2D-7 Incl.	Pipe Data Sheet
3	Alignment And General Construction
3A	Profile
3B	Drainage, Utilities & Profile
4	Alignment And General Construction
4A	Profiles
4B	Drainage, Utilities & Profile
4C	Construction Notes
5	Alignment And General Construction
5A, 5A-2	Profiles
5B	Drainage & Utilities
5C	Drainage & Utilities Profile
6	Alignment And General Construction
6A	Profiles
6B	Drainage & Utilities
6C	Drainage & Utilities Profile
7	Alignment And General Construction
7A	Profile
7B	Drainage, Utilities & Profile
8	Alignment And General Construction
8A, 8A-2	Profiles
8B	Drainage, Utilities & Profile
9	Alignment And General Construction
9A	Profile
9B	Drainage & Utilities
9C	Profile
10	Alignment Plan
10A	General Construction
10A-2	Profiles

INDEX OF SHEETS CONT'D.	
SHEET NO.	DESCRIPTION
10B	Drainage & Utilities
10C	Profiles
11	Alignment Plan
11A	General Construction
11A-2	Profiles
11B	Drainage & Utilities
11C	Profiles
12	Alignment Plan
12A	General Construction
12A-2	Construction Notes
12A-3 Thru 12A-5 Incl.	Profiles
12B, 12B-2	Alignment Plan
12B-3	Profile
12C	Drainage & Utilities
12D	Construction Notes
12E, 12F	Profiles
13	Alignment Plan
13A	General Construction
13A-2	Construction Notes
13A-3, 13A-4	Profiles
13B	Drainage & Utilities
13C	Construction Notes
13D, 13E	Profiles
14	Alignment And General Construction
14A	Construction Notes
14A-2	Profiles
14B	Drainage & Utilities
14C	Construction Notes
14D	Profiles
15	Alignment And General Construction
15A	Profile
15B	Drainage & Utilities
15C	Profiles
16	Alignment, General Construction & Profiles
16A	Profile
16B	Drainage, Utilities & Profile
GEO/HYDRO	
GA Thru GA-4 Incl.	Erosion Control Details
GA-5 Thru GA-19 Incl.	Erosion Control Plan
GB Thru GB-5 Incl.	Geotechnical Data
RETAINING WALL NO. 21633	
GC	Plan And Elevation
GC-2	General Notes And Misc. Details
GC-3	Typical Section
RETAINING WALL NO. 21648	
GC-4	Plan And Elevation
GC-5	General Notes And Misc. Details
GC-6	Details
RETAINING WALL NO. 22197	
GC-7	Plan And Elevation
GC-8	General Notes And Misc. Details
GC-9	Wall Elevation
GC-10	Wall Details 1
GC-11	Wall Details 2

INDEX OF SHEETS CONT'D.	
SHEET NO.	DESCRIPTION
GEO/HYDRO	
GE	Drainage Plan
GE-A	Details
GE-1	Drainage Plan
GE-1A	Details
GE-2	Drainage Plan
GE-2A, GE-2B	Details
GE-3	Drainage Plan
GE-3A Thru GE-3D Incl.	Details
GE-4	Drainage Plan
GE-4A Thru GE-8 Incl.	Details
GG-1 Thru GG-3 Incl.	Temporary Water Management Concept Plan
GN-1	Planting Notes
GN-2	Landscape Details
GN-2A	Planting Details
GN-3 Thru GN-5 Incl.	Planting Plan
GN-6, GN-7	Layout Plan
GN-8, GN-9	Enlarged Planting Plan
STRUCTURES GENERAL PLAN	
94998	General Plan And Structure Drawing Index
BRIDGE NO. 21631	
94999	Plan And Elevation
95000	General Notes And Miscellaneous Details
95001	Foundation Data
95002	Foundation Plan
95003	Construction Sequence And Pay Limits
95004	Deck Plan
95005	Typical And Partial Deck Sections
95006	Modified Deck Bulb-T Girder Details
95007	Modified Deck Bulb-T Girder Schedule And Misc. Details
95008	Plan And Elevation - Bent 1
95009	Typical Bent Details - Bent 1
95010	Plan And Elevation - Bent 2
95011	Typical Bent Details - Bent 2
95012	Miscellaneous Bent Details
95013	Bent 1 Wingwall - Left
95014	Bent 1 Wingwall - Right
95015	Bent 2 Wingwall And Endblock
95016	Fence And Rail Details - 1
95017	Fence And Rail Details - 2
95018	Modified End Panel Details
95019	Miscellaneous Details
BRIDGE NO. 21643	
95020	Plan And Elevation
95021	General Notes And Misc. Details
95022	Foundation Data
95023	Foundation Plan
95024	Construction Sequence
95025	Typical Section
95026	Deck Plan
95027	26" Slab Schedule And Details
95028	Plan And Elevation - Bent 2 (Bent 1 Similar)

OR62: CORRIDOR SOLUTIONS UNIT 2 (MEDFORD)		
CRATER LAKE HIGHWAY JACKSON COUNTY		
FEDERAL HIGHWAY ADMINISTRATION	PROJECT NUMBER	SHEET NO.
OREGON DIVISION		1A

INDEX OF SHEETS CONT'D.	
DRAWING NO.	DESCRIPTION
95029	Typical Bent Section And Bearing Details
95030	Wingwalls - Bent 2 (Bent 1 Similar)
95031	Bridge Rail Details
95032	Miscellaneous Details
BRIDGE NO. 21632	
95033	Plan And Elevation
95034	General Notes And Typical Section
95035	Foundation Data
95036	Structure Details - 1
95037	Structure Details - 2
95038	Miscellaneous Details
CULVERT NO. 21644	
95039	Plan And Elevation
95040	General Notes And Typical Section
95041	Foundation Data
95042	Culvert Replacement Staging Details - 1
95043	Culvert Replacement Staging Details - 2
95044	Transition Structure Plan
95045	Transition Structure Typical Sections
95046	Wingwall And Apron Details
CULVERT NO. 21641	
95047	Plan And Elevation
95048	General Notes And Typical Section
95049	Foundation Data
95050	Wingwall And Apron Details
CULVERT NO. 21642	
95051	Plan And Elevation
95052	General Notes And Typical Section
95053	Foundation Data
95054	Culvert Details - 1
95055	Culvert Details - 2
95056	CL-4R Modified Chain Link Fence Details
RETAINING WALL NO. 21634	
95057	Plan And Elevation
95058	General Notes And Construction Sequence
95059	Foundation Data
95060	Typical Section And Details
95061	Wall Elevation
95062	Ground Anchor Details - 1
95063	Ground Anchor Details - 2
95064	Pile And Ground Anchors Data Table 1
95065	Pile And Ground Anchors Data Table 2
95066	Miscellaneous Details
RETAINING WALL NO. 21635	
95067	Plan And Elevation
95068	General Notes And Construction Sequence
95069	Foundation Data
95070	Typical Section And Details
95071	Wall Elevation
95072	Ground Anchor Details - 1
95073	Ground Anchor Details - 2
95074	Pile And Ground Anchors Data Table 1
95075	Pile And Ground Anchors Data Table 2
95076	Drainage & Joint Details
RETAINING WALL NO. 22150	
95077	Plan And Elevation
95078	General Notes

INDEX OF SHEETS CONT'D.	
DRAWING NO.	DESCRIPTION
95079	Foundation Data
95080	Wall Elevation And Architectural Wall Treatment
95081	Typical Sections
95082	Miscellaneous Details
RETAINING WALL NO. 22151	
95083	Plan And Elevation
95084	General Notes
95085	Foundation Data - 1
95086	Foundation Data - 2
95087	Foundation Data - 3
95088	Elevations And Architectural Treatment - 1
95089	Elevations And Architectural Treatment - 2
95090	Elevations And Architectural Treatment - 3
95091	Typical Sections
95092	Miscellaneous Details
RETAINING WALL NO. 21636	
95093	Plan And Elevation
95094	General Notes
95095	Foundation Data
95096	Wall Elevation
95097	Architectural Wall Treatment
95098	Typical Section And Details
95099	Miscellaneous Details
RETAINING WALL NO. 21678	
95100	Plan And Elevation
95101	General Notes
95102	Foundation Data
95103	Architectural Wall Treatment
95104	Typical Section And Details
RETAINING WALL NO. 21637	
95105	Plan And Elevation
95106	General Notes
95107	Foundation Data
95108	Architectural Wall Treatment
95109	Typical Section And Details
RETAINING WALL NO. 21679	
95110	Plan And Elevation
95111	General Notes
95112	Foundation Data
95113	Architectural Wall Treatment
95114	Typical Section And Details
RETAINING WALL NO. 21638	
95115	Plan And Elevation
95116	General Notes
95117	Foundation Data
95118	Architectural Wall Treatment
95119	Typical Section And Details
RETAINING WALL NO. 21639	
95120	Plan And Elevation
95121	General Notes
95122	Foundation Data
95123	Wall Elevation
95124	Architectural Wall Treatment
95125	Typical Section And Details
95126	Rail Details

INDEX OF SHEETS CONT'D.	
DRAWING NO.	DESCRIPTION
RETAINING WALL NO. 21640	
95127	Plan And Elevation
95128	General Notes
95129	Foundation Data
95130	Architectural Wall Treatment
95131	Typical Section And Details
95132	Miscellaneous Details
SIGN STRUCTURE NO. 21645	
S-15147	Monotube Cantilever Elevation
SIGN STRUCTURE NO. 21646	
S-15148	Monotube Cantilever Elevation
S-15148A	Drilled Shaft Details
SIGN STRUCTURE NO. 21647	
S-15149	Plan And Elevation
PERMANENT PAVEMENT MARKINGS	
ST	Striping Details
ST-2 Thru ST-9 Incl.	Striping Plan
PERMANENT SIGNING	
S-15134 Thru S-15146 Incl.	Permanent Signing
ILLUMINATION	
I-2400	Illumination Legend
I-2401	Illumination Details
I-2402 Thru I-2409 Incl.	Illumination Plan
I-2410, I-2411	Illumination Details
TRAFFIC SIGNALS	
18115	Legend
18116	Signal Plan
18117	Signal Removal Plan
18118	Detector Plan
18119	Existing Utility Plan
18120	Detector Plan
18121	Signal Details
18122	Strain Pole Foundation
15-017A	Automated Traffic Recorder Plan
15-017B	Automated Traffic Recorder Removal Plan
15-017C	Existing Utility Plan
ITS-1770	ITS Legend
ITS-1771 Thru ITS-1773 Incl.	ITS Plan
ITS-1774, ITS-1775	Fiber Splice Diagram
ITS-1776	ITS Details
ITS-1777	CCTV Details - 1
ITS-1778	CCTV Details - 2
SANITARY SEWER	
1	RVSS Relocation Plans
5001 Thru 5004 Incl.	Sanitary Sewer Plan And Profile

OR62: CORRIDOR SOLUTIONS UNIT 2 (MEDFORD)
 CRATER LAKE HIGHWAY
 JACKSON COUNTY

FEDERAL HIGHWAY ADMINISTRATION	PROJECT NUMBER	SHEET NO.
OREGON DIVISION		1A-2

Std. Drg. Nos.		Std. Drg. Nos.		Std. Drg. Nos.	
RD100	- Mailbox Support	RD815	- Chain Link Fence	TM488	- Terminal Cabinet Detail
RD101	- Mailbox Installation	RD820	- Fence Gates	TM490	- Crosswalk Closure Detail
RD140	- Roadway Cross Slopes Superelevated Sections			TM498	- Interconnect Wiring Details
RD300	- Trench Backfill, Bedding, Pipe Zone And Mult. Installations	RD1000	- Construction Entrances	TM500, TM501, TM502, TM503	- Pavement Marking Standard Details
RD302	- Street Cut	RD1005	- Check Dams Types 1, 3 & 4	TM515	- Raised Pavement Markers
RD306	- Concrete Encasement, Cradle And Cap Details	RD1010	- Inlet Protection Type 2, 3, 6 & 7	TM520, TM521	- Durable Pavement Markings
RD312	- Subsurface Drain	RD1015	- Inlet Protection Type 4	TM530	- Intersection Pavement Markings
RD316	- Sloped Ends For Metal Pipe	RD1032	- Sediment Barrier Type 8	TM531	- Turn Arrow Marking Details
RD317	- Culvert Embankment Protection	BR165	- Bridge End Panel	TM539	- Median And Left Turn Channelization Details
RD318	- Sloped Ends For Concrete Pipe	BR195	- Bridge ID Marker	TM560, TM561	- Alignment Layout
RD319	- Miscellaneous Culvert Details	BR200	- Concrete Bridge Rail Type "F"	TM570	- Traffic Delineators
RD320	- Paved End Slope For Culverts 60" Maximum Pipe Size	BR203	- Transition Concrete Bridge Rail To Guardrail	TM571	- Traffic Delineators Steel Post Details
RD326, RD327	- Coupling Bands For Corrugated Metal Pipe	BR236	- Trailing End Bridge Connection Conc. Bridge Rail To Guardrail	TM576	- Traffic Delineator Installation
RD328	- Slotted C.M.P. Drain Details	BR240, BR241, BR242, BR260	- Protective Fencing		
RD335	- Standard Storm Sewer Manhole				
RD336, RD338, RD342, RD344	- Manholes	BR350	- Temp. Diaphragm Beam For Prestressed Conc. Girders	TM602	- Triangular Base Breakaway Multi-Direction Slip Base
RD345	- Pipe To Manhole Connections			TM622, TM623, TM624,	- Monotube Cantilever Sign Support
RD346	- Large Precast Manhole	BR420	- 26" Precast Prestressed Slab	TM625, TM626, TM627	
RD348	- Manhole With Inlet	BR445	- Precast Prestressed Boxes & Slabs	TM629, TM630	
RD356	- Manhole Cover & Frames			TM635	- Slip Base & Fixed Base Luminaire Supports
RD360	- Manhole Frame Adjustment	BR720	- Standard Gravity Retaining Wall Details	TM652	- Breakaway Sign & Luminaire Supports
RD362	- Sanitary Cleanout	BR760	- Moment Slab On MSE Wall	TM653	- Traffic Signal Supports (Steel Details)
RD363	- Gutter Transition At Inlet			TM660	- Traffic Signal Supports (Foundation Requirements)
RD364	- Concrete Inlets Type G-1, G-2, G-2M & G-2MA	BR800	- Box Culvert Wingwalls Details	TM661	- Traffic Strain Pole Supports General Details And Design Criteria
RD365	- Frames & Grates For Concrete Inlets	BR805	- Box Culvert Extensions Details		- Traffic Strain Pole Supports Notes, Reactions and Details
RD366	- Concrete Inlets Type CG-1, CG-2 & Curb Inlet Channel	BR830	- Cast-In-Place Conc. Box Culverts	TM670	- Wood Post Sign Supports
RD370	- Ditch Inlet Type D	BR840, BR841	- Standard Double Box Culvert Details	TM671	- 3 Second Gust Wind Speed Map
RD372	- Ditch Inlet Top, Option 1 Type CG-3			TM675	- Extruded Aluminum Panels
RD376	- Miscellaneous Drainage Structures	BR970	- Luminaire Base On Structures With Mounting Details	TM676	- Sign Attachments
RD380, RD384, RD386, RD388,	- Pipe Fill Height Tables			TM677	- Sign Mounts
RD390, RD393		TM200	- Sign Installation Details	TM678	- Secondary Sign Mounting Details
RD398	- Culvert ID Marker	TM201	- Miscellaneous Sign Placement Details	TM680	- Signal Pole Mounts
RD399	- Stormwater Treatment and Storage Facility Field Marker	TM211	- Signing Details US And Interstate Route Shields	TM681, TM687, TM688	- Perforated Steel Square Tube Sign Supports
RD400, RD405, RD410, RD415,	- Guardrail	TM212	- Signing Details Oregon Route Signs		
RD420, RD440, RD450		TM221	- Signing Details Milepost Marker	TM800	- Tables, Abrupt Edge And PCMS Details
RD470	- Guardrail Over Low-Fill Culverts	TM222	- Installation Details Milepost Marker Posts	TM810	- Temporary Reflective Pavement Markers
RD480	- 31" Guardrail and Metal Median Barrier	TM223	- Conventional Roads Directional Sign Layout Name Streets	TM820	- Temporary Barricades
RD481	- 31" Guardrail and Metal Median Barrier Height Conversion	TM224	- Signing Details Directional Sign Layout	TM821	- Temporary Sign Supports
RD500	- Precast Concrete Barrier Pin And Loop Assembly	TM230, TM231, TM232, TM233	- Mounting Details For Removable Legend	TM830	- Temporary Concrete Barrier And Rumble Strips
RD515	- Median Barrier Anchoring Details			TM831	- Temporary Impact Attenuators
RD516	- Securing Concrete Barrier To Roadway	TM301	- Illumination Control Cabinets	TM840	- Closure Details
RD520	- Cast-In-Place Conc. Barrier Transition To Bridge Rail Type "F"	TM302	- Pad-Mount Illumination Control Cabinet	TM841, TM842, TM843	- Intersection Details
RD545	- Precast Tall (42") Concrete Barrier			TM844	- Temporary Pedestrian Access Routing
RD530	- Guardrail Transition To Concrete Barrier			TM851, TM852	- Non-Freeway Multi-Lane Sections
RD610	- Asphalt Concrete Pavement (ACP) Details	TM452	- Strain Pole Details		
RD700, RD701	- Curbs	TM457	- Vehicle, Ped. Signal & Push Button Mounting Details		
RD705	- Islands	TM458	- Pedestrian Ramp Placement Details		
RD706	- Traffic Separators And Transitions	TM460	- Vehicle Signal Details		
RD707	- Island Nose Treatments	TM462	- Adjustable Signal Head Mounting Details		
RD710	- Accessible Route Islands	TM463	- Spanwire Mounting Details		
RD715	- Approaches And Non-Sidewalk Driveways	TM465	- Overhead Sign, Fire Preemption & Photoelectronic Details		
RD720	- Sidewalks	TM467	- Ped. Signal And Ped. Push Button Details		
RD735	- Curb Line Sidewalk Driveways or Alleys (Options F and G) ODOT Highways	TM470	- Color Code Charts		
RD750	- Curb Line Sidewalk Driveways - Local Jurisdictions	TM472	- Traffic Signal Junction Boxes		
RD755	- Sidewalk Ramp Details	TM475	- Loop Details		
RD757	- Sidewalk Ramp Replacement Options	TM480	- Loop Entrance Details		
RD759	- Truncated Dome Detectable Warning Surface	TM482	- Controller Cabinet And Foundation Details		
RD770, RD771	- Pedestrian Handrail	TM485	- Service Cabinets And Service Cabinet Wiring Details		
RD810	- Barbed And Woven Wire Fences				


No.	DATE	REVISIONS	BY
1	1-27-16	Added std. drawing nos.	S.A.P.
2	2-16-17	Added std. drawing no.	S.A.P.

OR62: CORRIDOR SOLUTIONS UNIT 2 (MEDFORD)
 CRATER LAKE HIGHWAY
 JACKSON COUNTY

FEDERAL HIGHWAY ADMINISTRATION	PROJECT NUMBER	SHEET NO.
OREGON DIVISION		1A-3

Standard Drawings located on the web at:
http://www.oregon.gov/ODOT/HWY/ENGSERVICES/standard_drawings_home.shtml


Sec. 18, T. 37 S., R. 1 W., W.M.
(MEDFORD)

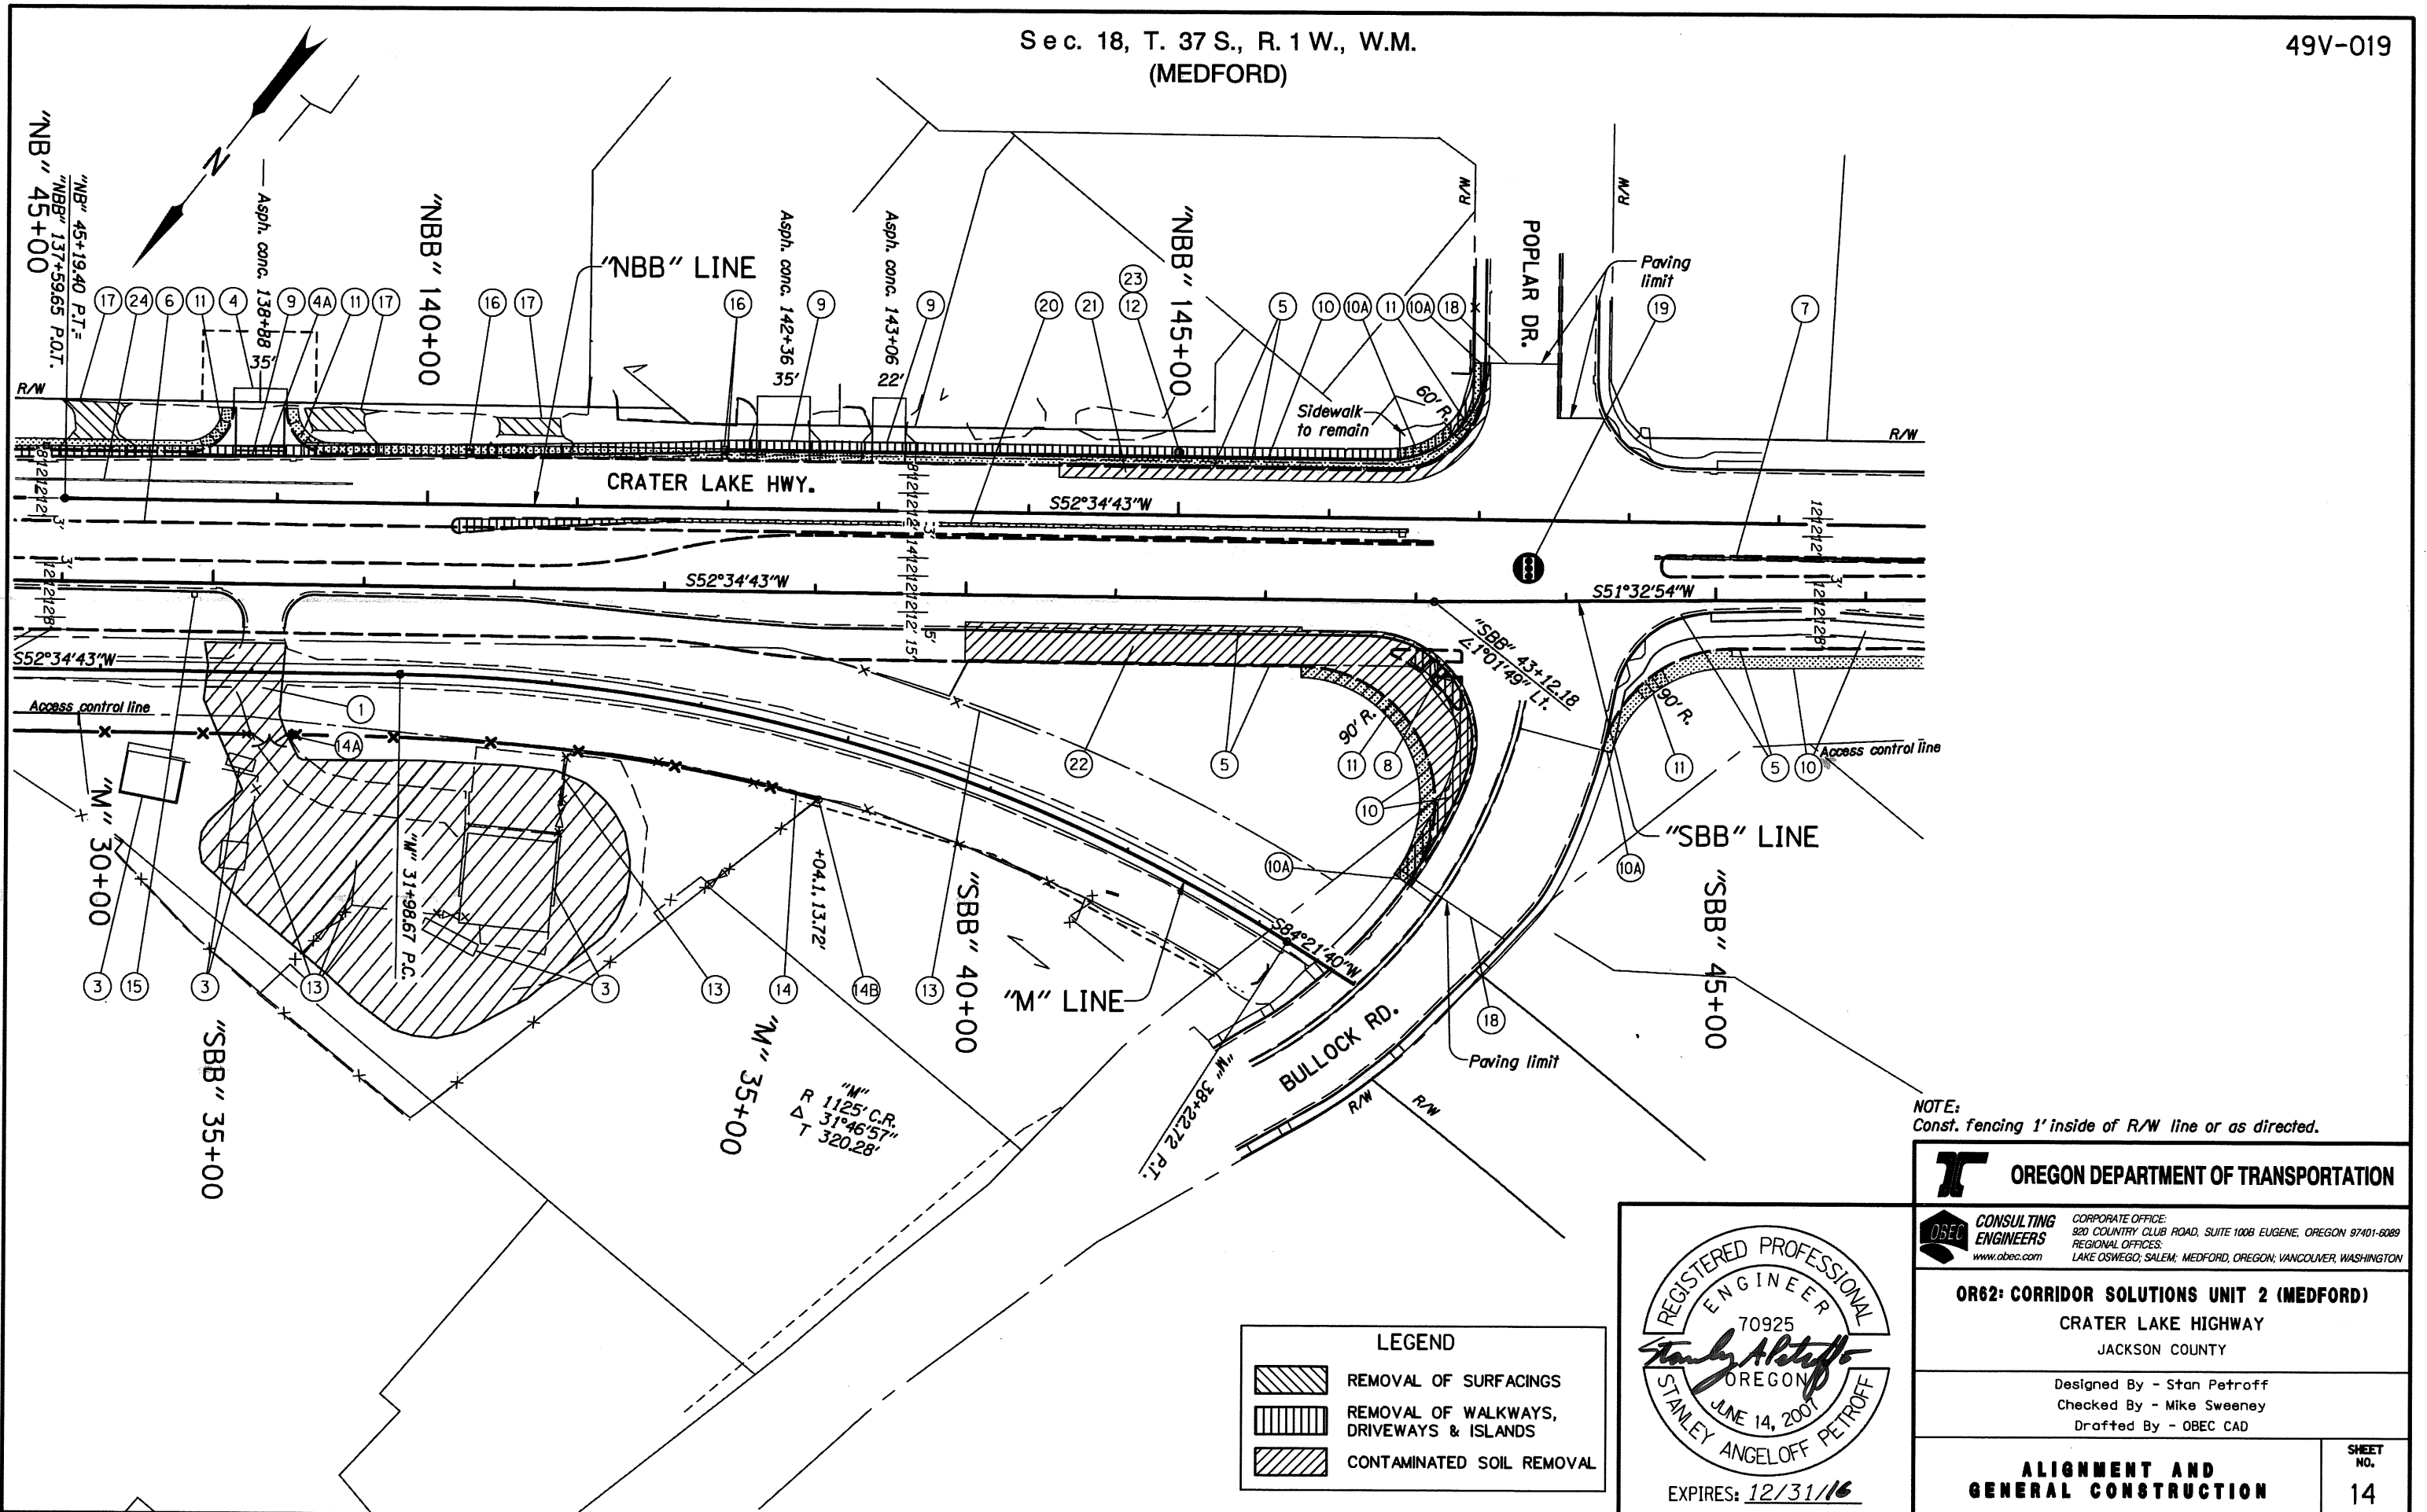

NOTE:
Const. fencing 1' inside of R/W line or as directed.

LEGEND

	REMOVAL OF SURFACINGS
	REMOVAL OF WALKWAYS, DRIVEWAYS & ISLANDS
	CONTAMINATED SOIL REMOVAL

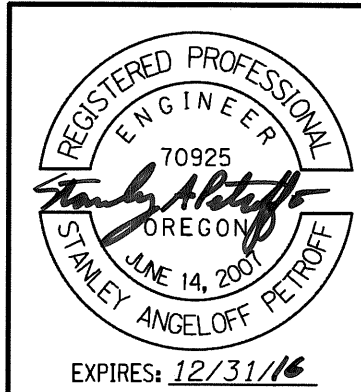

OREGON DEPARTMENT OF TRANSPORTATION

CONSULTING ENGINEERS
www.obec.com

CORPORATE OFFICE:
920 COUNTRY CLUB ROAD, SUITE 100B EUGENE, OREGON 97401-6089
REGIONAL OFFICES:
LAKE OSWEGO, SALEM, MEDFORD, OREGON, VANCOUVER, WASHINGTON

OR62: CORRIDOR SOLUTIONS UNIT 2 (MEDFORD)
CRATER LAKE HIGHWAY
JACKSON COUNTY


Designed By - Stan Petroff
Checked By - Mike Sweeney
Drafted By - OBEC CAD

ALIGNMENT AND GENERAL CONSTRUCTION

SHEET NO. 14

- ① South Pond
Contaminated soil removal - 2,241 cu. yds.
- ② Note not used
- ③ Removal of structure
(By others)
- ④ Const. asph. apr.
④A) Const. P.C. conc. valley gutter
- ⑤ Const. curb and gutter
Remove extg. curb
- ⑥ See sht. 13A, note 7
Const. type "C" conc. island, mountable
Remove extg. conc. island
- ⑦ Const. type "C" conc. island, mountable
Removal of island - 169 sq. yds.
(For details, see sht. 2B-30)
- ⑧ Const. type "C" conc. island, mountable
(Cut through design)
(For details, see sht. 2B-9)
- ⑨ Const. P.C. conc. dwy., option N-2
Const. asph. conc. connection
- ⑩ Const. P.C. conc. sidewalk
Remove extg. sidewalk
⑩A) Match extg. sidewalk - 3
(For details, see sht. 2B-19)
- ⑪ Const. P.C. conc. sidewalk ramp, option K - 5
- ⑫ Structure no. 21646
Sta. "NBB" 145+00
Const. new cantilever sign structure
Const. new sign structure drilled shaft
(For drg. nos., see sht. 1A)
- ⑬ Sta. "M" 30+00 to Sta. "M" 32+10 Rt.
Remove extg. fence - 644'
- ⑭ Sta. "SBB" 35+49.62 to Sta. "SBB" 39+04.11, Rt.
Const. type CL-6R fence - 382'
⑭A) Inst. 20'-6" double chainlink gate
⑭B) Connect to extg. fence
- ⑮ Remove mailbox
- ⑯ Remove and reinstall mailbox supports - 2
- ⑰ ~~Removal of driveways - 3~~
Removal of surfacing - 192 cu. yds.
- ⑱ Const. street connection - 2
- ⑲ Inst. traffic signal at Delta Waters Intersection
(For drg. nos., see sht. 1A)
- ⑳ Removal of island - 222 sq. yds.
- ㉑ Sta. "NBB" 144+20 to Sta. "NBB" 147+06, Lt.
Contaminated soil removal - 90 sq. yds. ㉑
cu.
- ㉒ Sta. "SBB" 40+00 to Sta. "SBB" 43+40, Rt.
Contaminated soil removal - 454 cu. yds.
- ㉓ Sta. "NBB" 145+00 (sign footing)
Contaminated soil removal - 35 cu. yds.

No.	DATE	REVISIONS	BY
①	1-29-16	Modified note	S.A.P.
②	2-2-16	Revised note	S.A.P.

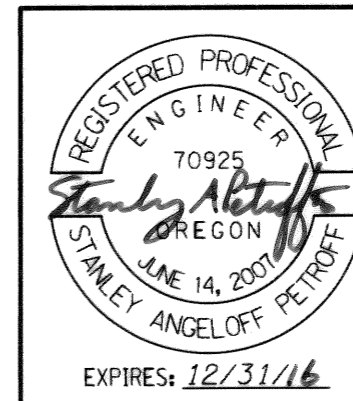

OREGON DEPARTMENT OF TRANSPORTATION

CONSULTING ENGINEERS
CORPORATE OFFICE: 920 COUNTRY CLUB ROAD, SUITE 1006 EUGENE, OREGON 97401-6089
REGIONAL OFFICES: LAKE OSWEGO, SALEM, MEDFORD, OREGON; VANCOUVER, WASHINGTON
www.obec.com


OR62: CORRIDOR SOLUTIONS UNIT 2 (MEDFORD)
CRATER LAKE HIGHWAY
JACKSON COUNTY

Designed By - Stan Petroff
Checked By - Mike Sweeney
Drafted By - OBEC CAD




CONSTRUCTION NOTES SHEET NO. 14A

"SBB" LINE


49V-019

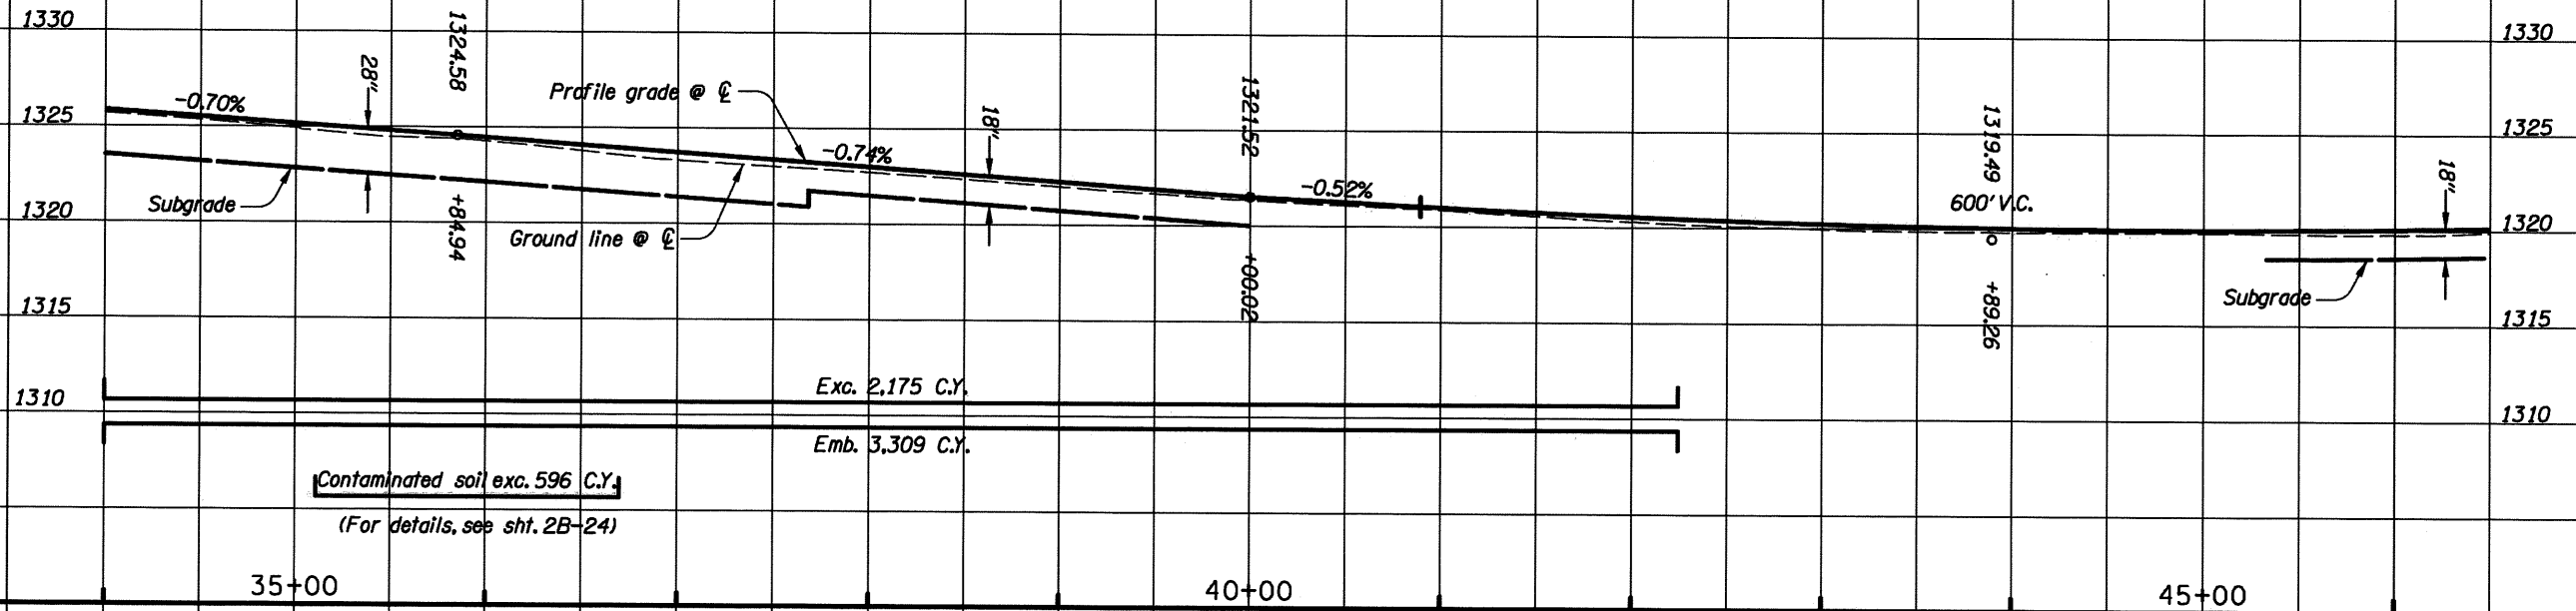

"NBB" LINE

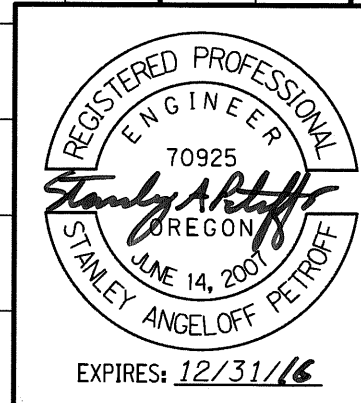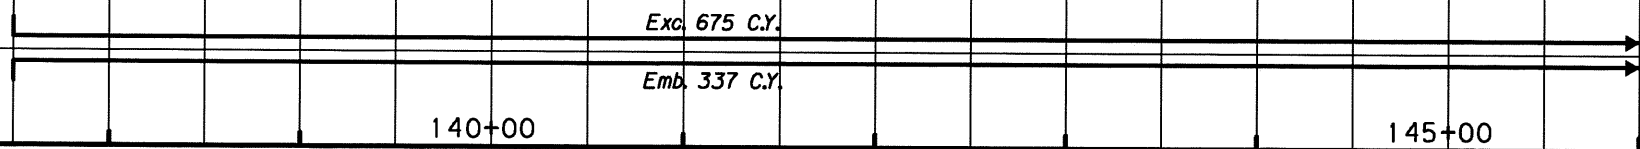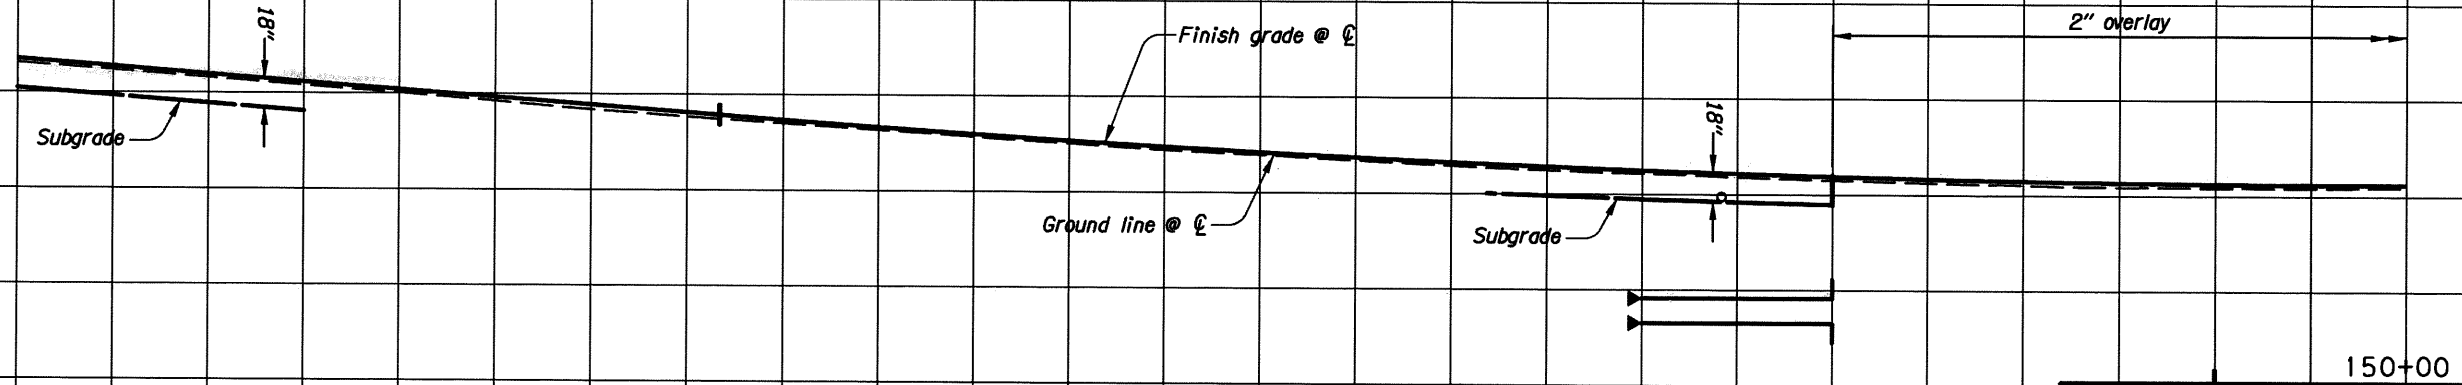


OREGON DEPARTMENT OF TRANSPORTATION	
CONSULTING ENGINEERS www.obec.com	<small>CORPORATE OFFICE: 920 COUNTRY CLUB ROAD, SUITE 100B EUGENE, OREGON 97401-6089 REGIONAL OFFICES: LAKE OSWEGO, SALEM, MEDFORD, OREGON; VANCOUVER, WASHINGTON</small>
OR62: CORRIDOR SOLUTIONS UNIT 2 (MEDFORD) CRATER LAKE HIGHWAY JACKSON COUNTY	
Designed By - Stan Petroff Checked By - Mike Sweeney Drafted By - OBEC CAD	
PROFILES	SHEET NO. 14A-2

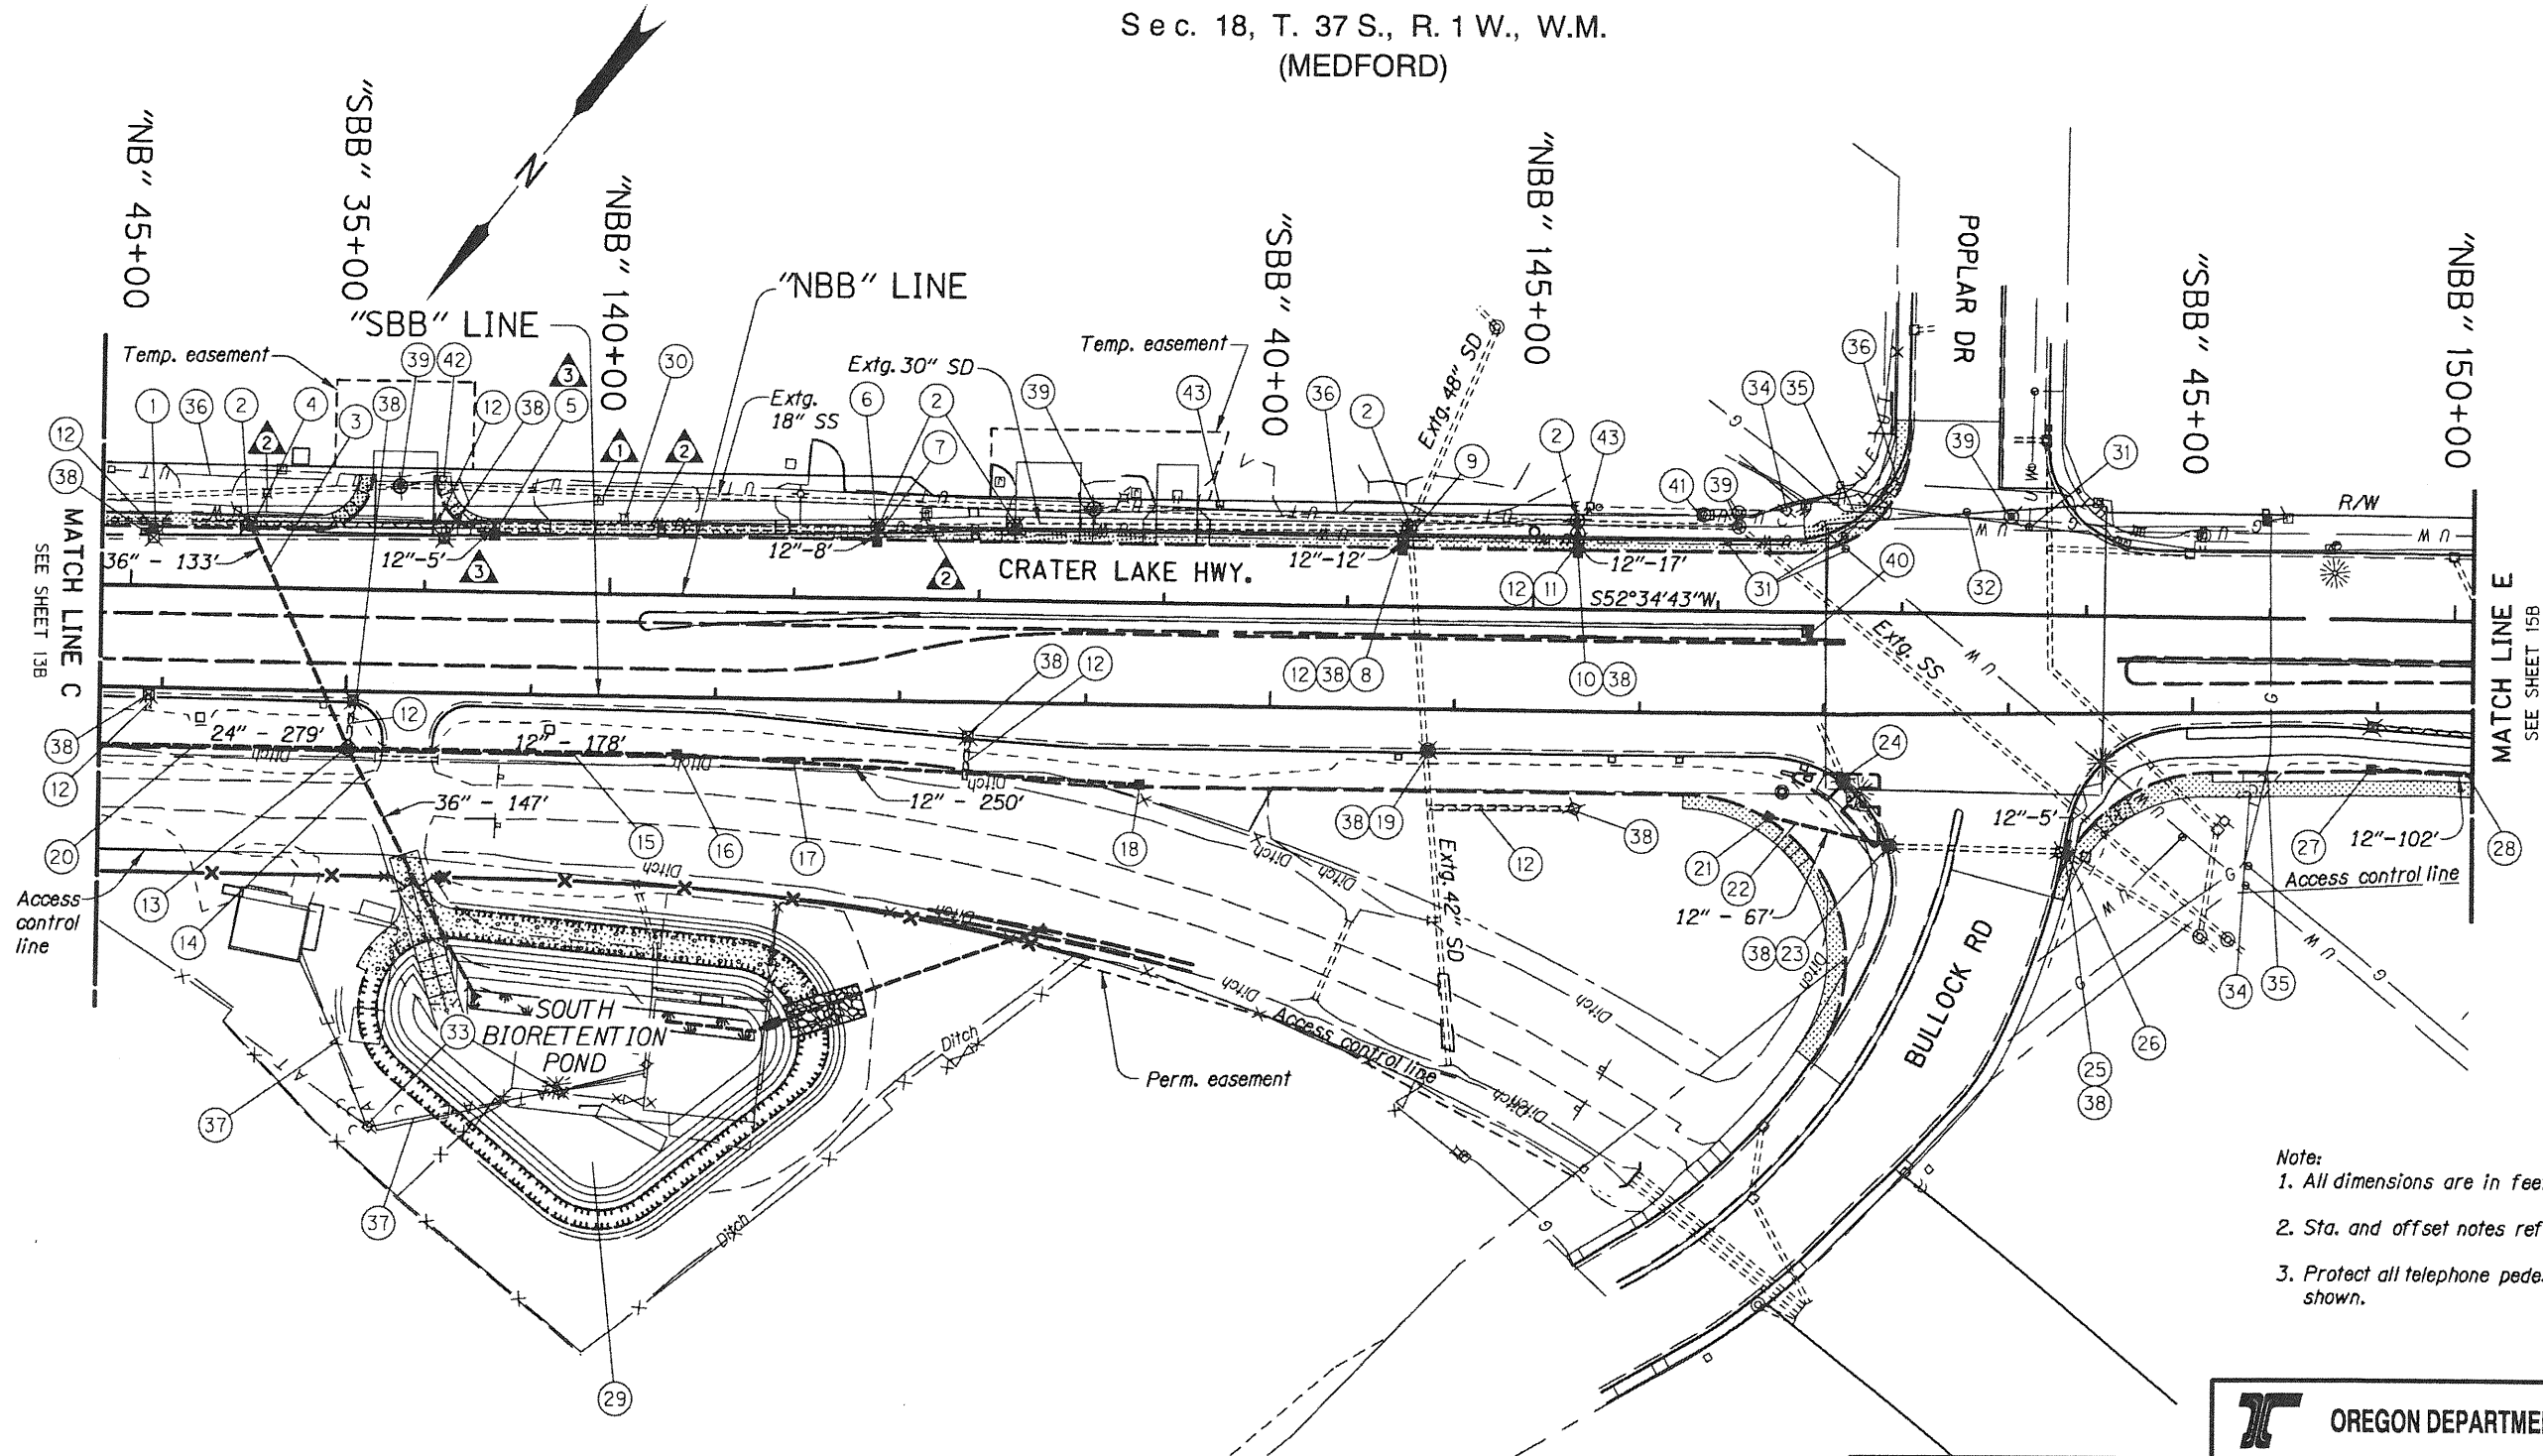

Note:
 1. All dimensions are in feet, unless otherwise noted
 2. Sta. and offset notes reference center of structures
 3. Protect all telephone pedestals unless otherwise shown.

LEGEND	
	ADJUST MANHOLE
	ABANDON PIPE
	REMOVE INLET
	ADJUST INLET

No.	DATE	REVISIONS	BY
1	4-18-16	Fiber optic vaults, adjusted by others	S.D.W.
2	4-18-16	Water meters, adjusted by others	S.D.W.
3	10-26-16	Relocate inlet & add pipe	J.L.J.

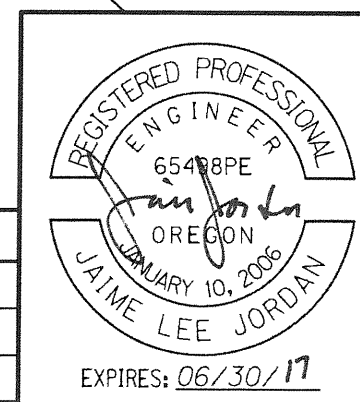

OREGON DEPARTMENT OF TRANSPORTATION	
OBEC CONSULTING ENGINEERS <small>CORPORATE OFFICE: 920 COUNTRY CLUB ROAD, SUITE 100B EUGENE, OREGON 97401-6029 REGIONAL OFFICES: LAKE OSWEGO, SALEM, MEDFORD, OREGON; VANCOUVER, WASHINGTON www.obec.com</small>	
OR62: CORRIDOR SOLUTIONS UNIT 2 (MEDFORD) CRATER LAKE HIGHWAY JACKSON COUNTY	
Designed By - Jaime Jordan Checked By - Ben Wawerka Drafted By - S. Wolfer	
DRAINAGE & UTILITIES	SHEET NO. 14B

For profiles, see sheet 14D

- ① Sta. "NBB" 137+51.70, 30.73' Lt. Const. type "CG-2" inlet over extg. storm sewer
- ② Minor adj. manhole - 4
- ③ Sta. "NBB" 138+04.31, 34.37' Lt. to Sta. "SBB" 35+01.86, 30.73' Rt. Inst. 36" storm sew. pipe - 133' 5' depth
- ④ NBB 138+04.31, 34.37' Lt. Plug extg. 30" storm sewer outflow at manhole
- ⑤ ~~Sta. "NBB" 139+09.95, 30.73' Lt. to Sta. "NBB" 139+37.2, 30.73' Lt.~~ Const. type "CG-2" inlet over extg. storm sewer Inst. 12" storm sew. pipe - 5' 5' depth Connect to extg. structure Plug extg. 30" storm sewer upstream of connection
- ⑥ Sta. "NBB" 141+44.71, 30.73' Lt. Const. type "CG-2" inlet
- ⑦ Sta. "NBB" 141+44.71, 30.73' Lt. to "NBB" 141+44.71, 39.17' Lt. Inst. 12" storm sew. pipe - 8' 5' depth Connect to extg. manhole
- ⑧ Sta. "NBB" 144+29.37, 30.73' Lt. Const. type "CG-2" inlet
- ⑨ Sta. "NBB" 144+29.37, 30.73' Lt. to Sta. "NBB" 144+32.81, 42.52' Lt. Inst. 12" storm sew. pipe - 12' 5' depth Connect to extg. manhole
- ⑩ Sta. "NBB" 145+23.67, 30.73' Lt. Const. type "CG-2" inlet
- ⑪ Sta. "NBB" 145+23.67, 30.73' Lt. to Sta. "NBB" 145+23.09, 47.09' Lt. Inst. 12" storm sew. pipe - 17' 5' depth Connect to extg. structure

- ⑫ Remove pipe - ~~453'~~ 281'
- ⑬ Sta. "SBB" 35+01.86, 30.73' Rt. Const. 84" storm sewer manhole with type "G-2" inlet
- ⑭ Sta. "SBB" 35+01.86, 30.73' Rt. to "SBB" 35+72.27, 159.55' Rt. Inst. 36" storm sew. pipe - 147' 5' depth Const. sloped end Const. paved end slope - 67 sq. ft.
- ⑮ Sta. "SBB" 36+80.00, 30.73' Rt. to Sta. "SBB" 35+01.86, 30.73' Rt. Inst. 12" storm sew. pipe - 178' 5' depth
- ⑯ Sta. "SBB" 36+80.00, 30.73' Rt. Const. type "CG-2" inlet
- ⑰ Sta. "SBB" 39+30.00, 42.73' Rt. to Sta. "SBB" 36+80.00, 30.73' Rt. Inst. 12" storm sew. pipe - 250' 5' depth
- ⑱ Sta. "SBB" 39+30.00, 42.73' Rt. Const. type "CG-2" inlet
- ⑲ Sta. "SBB" 40+86.27, 22.08' Rt. Const. 72" storm sewer manhole over extg. storm sewer
- ⑳ See sht. 13C, note 21
- ㉑ Sta. "SBB" 42+70.90, 55.48' Rt. Const. type "CG-2" inlet
- ㉒ Sta. "SBB" 42+70.90, 55.48' Rt. to Sta. "SBB" 43+35.24, 71.05' Rt. Inst. 12" storm sew. pipe - 67' 5' depth
- ㉓ Sta. "SBB" 42+35.24, 71.05' Rt. Const. storm sewer manhole over extg. storm sewer

- ㉔ Sta. "SBB" 43+11.21, 35.31' Rt. Const. inlet cap (See dwg. no. RD376)
- ㉕ Sta. "SBB" 44+27.01, 74.40' Rt. to Sta. "SBB" 44+31.83, 75.91' Rt. Inst. 12" storm sew. pipe - 5' 10' depth Connect to extg. storm sewer
- ㉖ Sta. "SBB" 44+31.83, 75.91' Rt. Const. type "CG-2" inlet over extg. storm sewer
- ㉗ Sta. "SBB" 45+96.58, 30.73' Rt. Const. type "CG-2" inlet
- ㉘ Sta. "SBB" 45+96.58, 30.73' Rt. to Sta. "SBB" 46+98.08, 37.12' Rt. Inst. 12" storm sew. pipe - 102' 5' depth
- ㉙ Const. south bioretention pond (D00836) (For details, see sht. GE-4)
- ㉚ Adj. water meter (By others)
- ㉛ Adj. water valve - 4 (By others)
- ㉜ Adj. gas valve (By others)
- ㉝ Remove utility pole - 2 (By others)
- ㉞ Relocate utility pole anchors - 2 (By others)
- ㉟ Adjust gas line (By others)
- ㊱ Relocate tel. line (By others)
- ㊲ Remove power and tel. lines (By others)

- ㊳ Remove inlet/manhole - 11
- ㊴ Minor adj. manhole - 5 (City of Medford non-reimbursable)
- ㊵ Adjust inlet
- ㊶ Adjust telephone manhole (By others, during construction)
- ㊷ Relocate Telephone pedestal (By others)
- ㊸ Protect telephone pedestal during construction - 2

Note:
All dimensions are in feet, unless otherwise noted


No.	DATE	REVISIONS	BY
①	5-6-16	Revised note	J.L.J.
②	10-26-16	Relocate inlet & add pipe	J.L.J.

OREGON DEPARTMENT OF TRANSPORTATION

OBEC CONSULTING ENGINEERS
CORPORATE OFFICE: 920 COUNTRY CLUB ROAD, SUITE 100B EUGENE, OREGON 97401-8029
REGIONAL OFFICES: LAKE OSWEGO; SALEM; MEDFORD, OREGON; VANCOUVER, WASHINGTON
www.obec.com


OR62: CORRIDOR SOLUTIONS UNIT 2 (MEDFORD)
CRATER LAKE HIGHWAY
JACKSON COUNTY

Designed By - Jaime Jordan
Checked By - Ben Wewerka
Drafted By - S. Wolfer

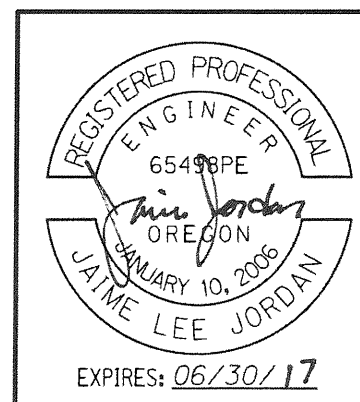


CONSTRUCTION NOTES SHEET NO. 14C


"NBB" LINE

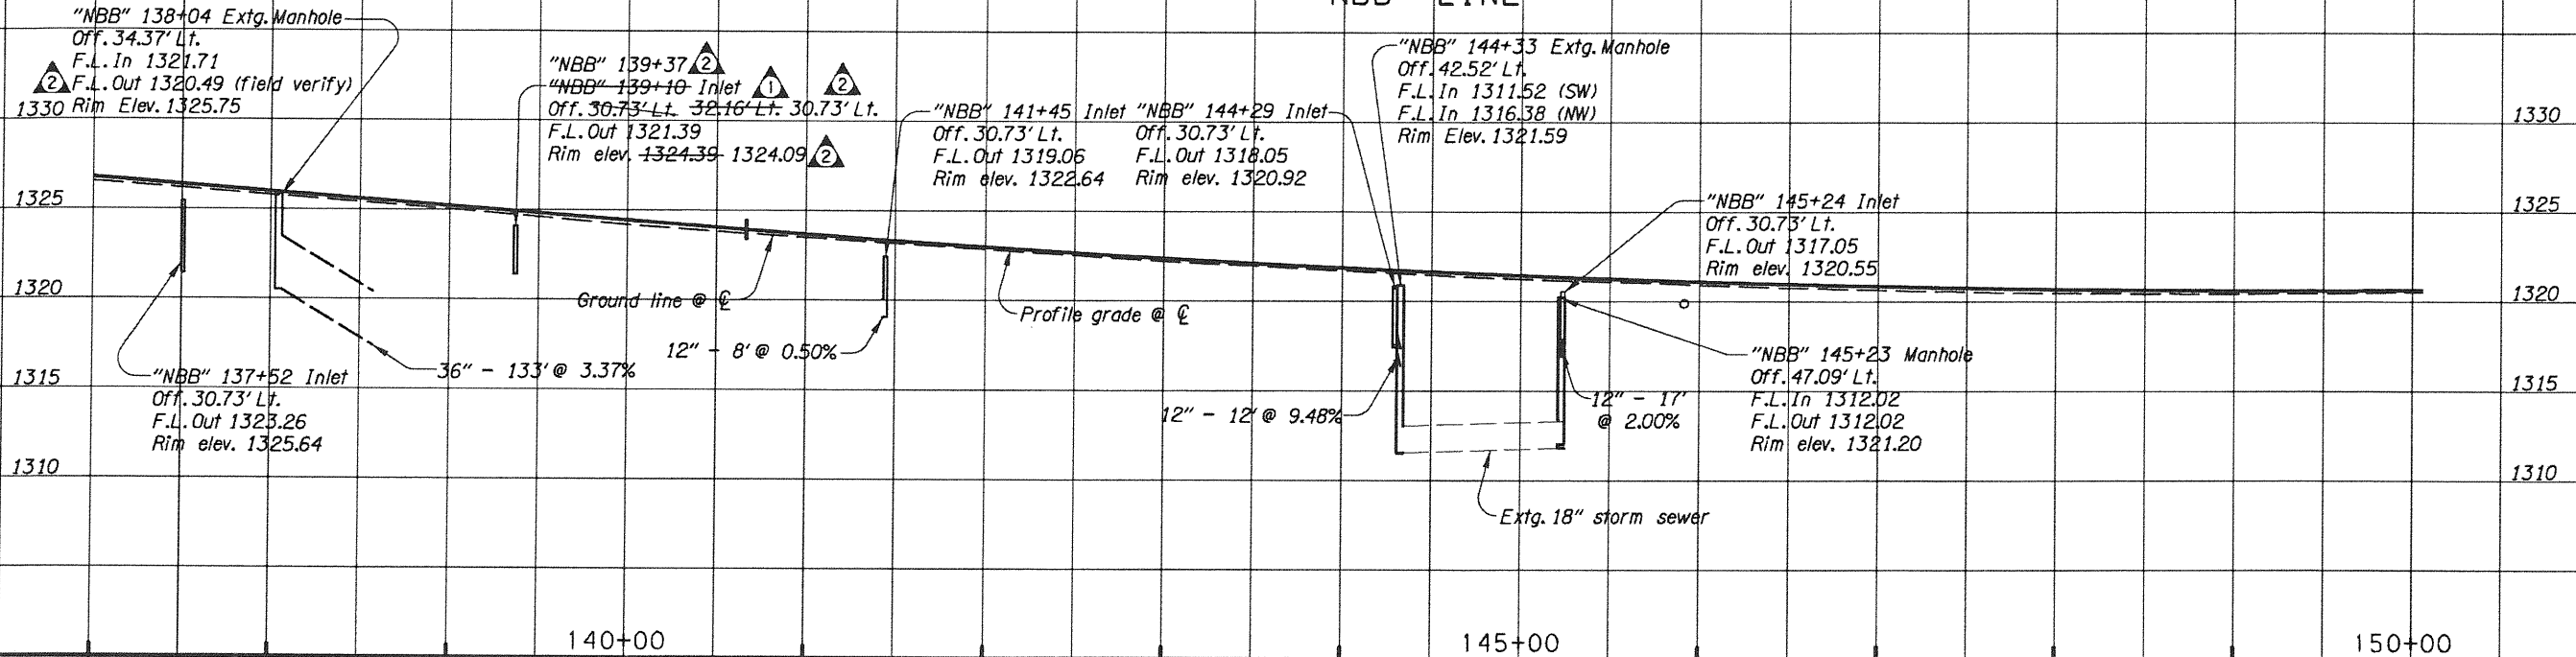

"SBB" LINE

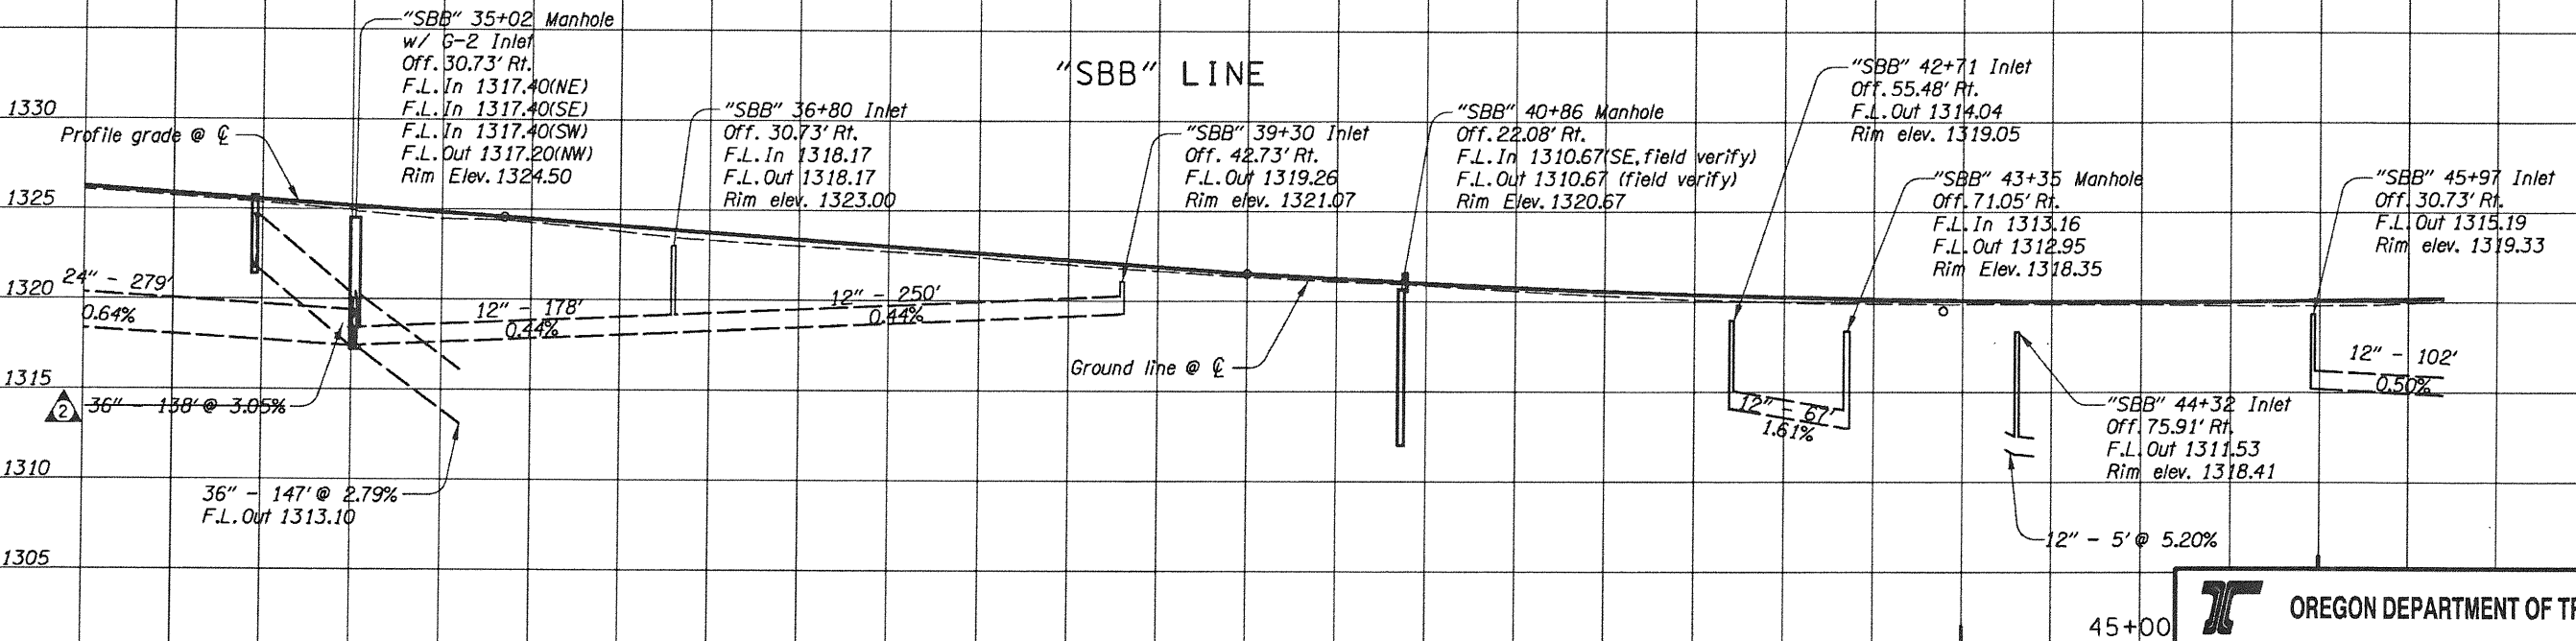

No.	DATE	REVISIONS	BY
①	5-6-16	Revised note	J.L.J.
②	10-28-16	Relocate inlet & add pipe. Add F.L. Out	J.L.J.

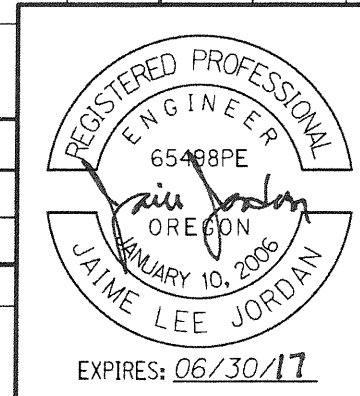

OREGON DEPARTMENT OF TRANSPORTATION

CONSULTING ENGINEERS
CORPORATE OFFICE: 920 COUNTRY CLUB ROAD, SUITE 100B EUGENE, OREGON 97401-6089
REGIONAL OFFICES: LAKE OSWEGO; SALEM; MEDFORD, OREGON; VANCOUVER, WASHINGTON
www.obec.com

OR62: CORRIDOR SOLUTIONS UNIT 2 (MEDFORD)
CRATER LAKE HIGHWAY
JACKSON COUNTY


Designed By - Jaime Jordan
Checked By - Ben Wewerka
Drafted By - S. Wolfer

PROFILES


SHEET NO. 14D

SOUTH BIORETENTION POND
(Drainage Facility ID #D00836)

Elevation in feet
1325
1320
1315
1310

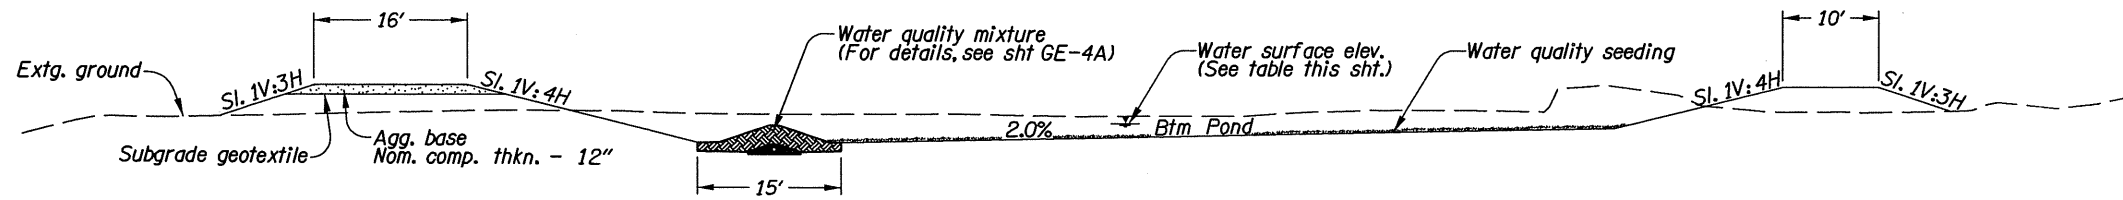


SECTION A-A VIEW

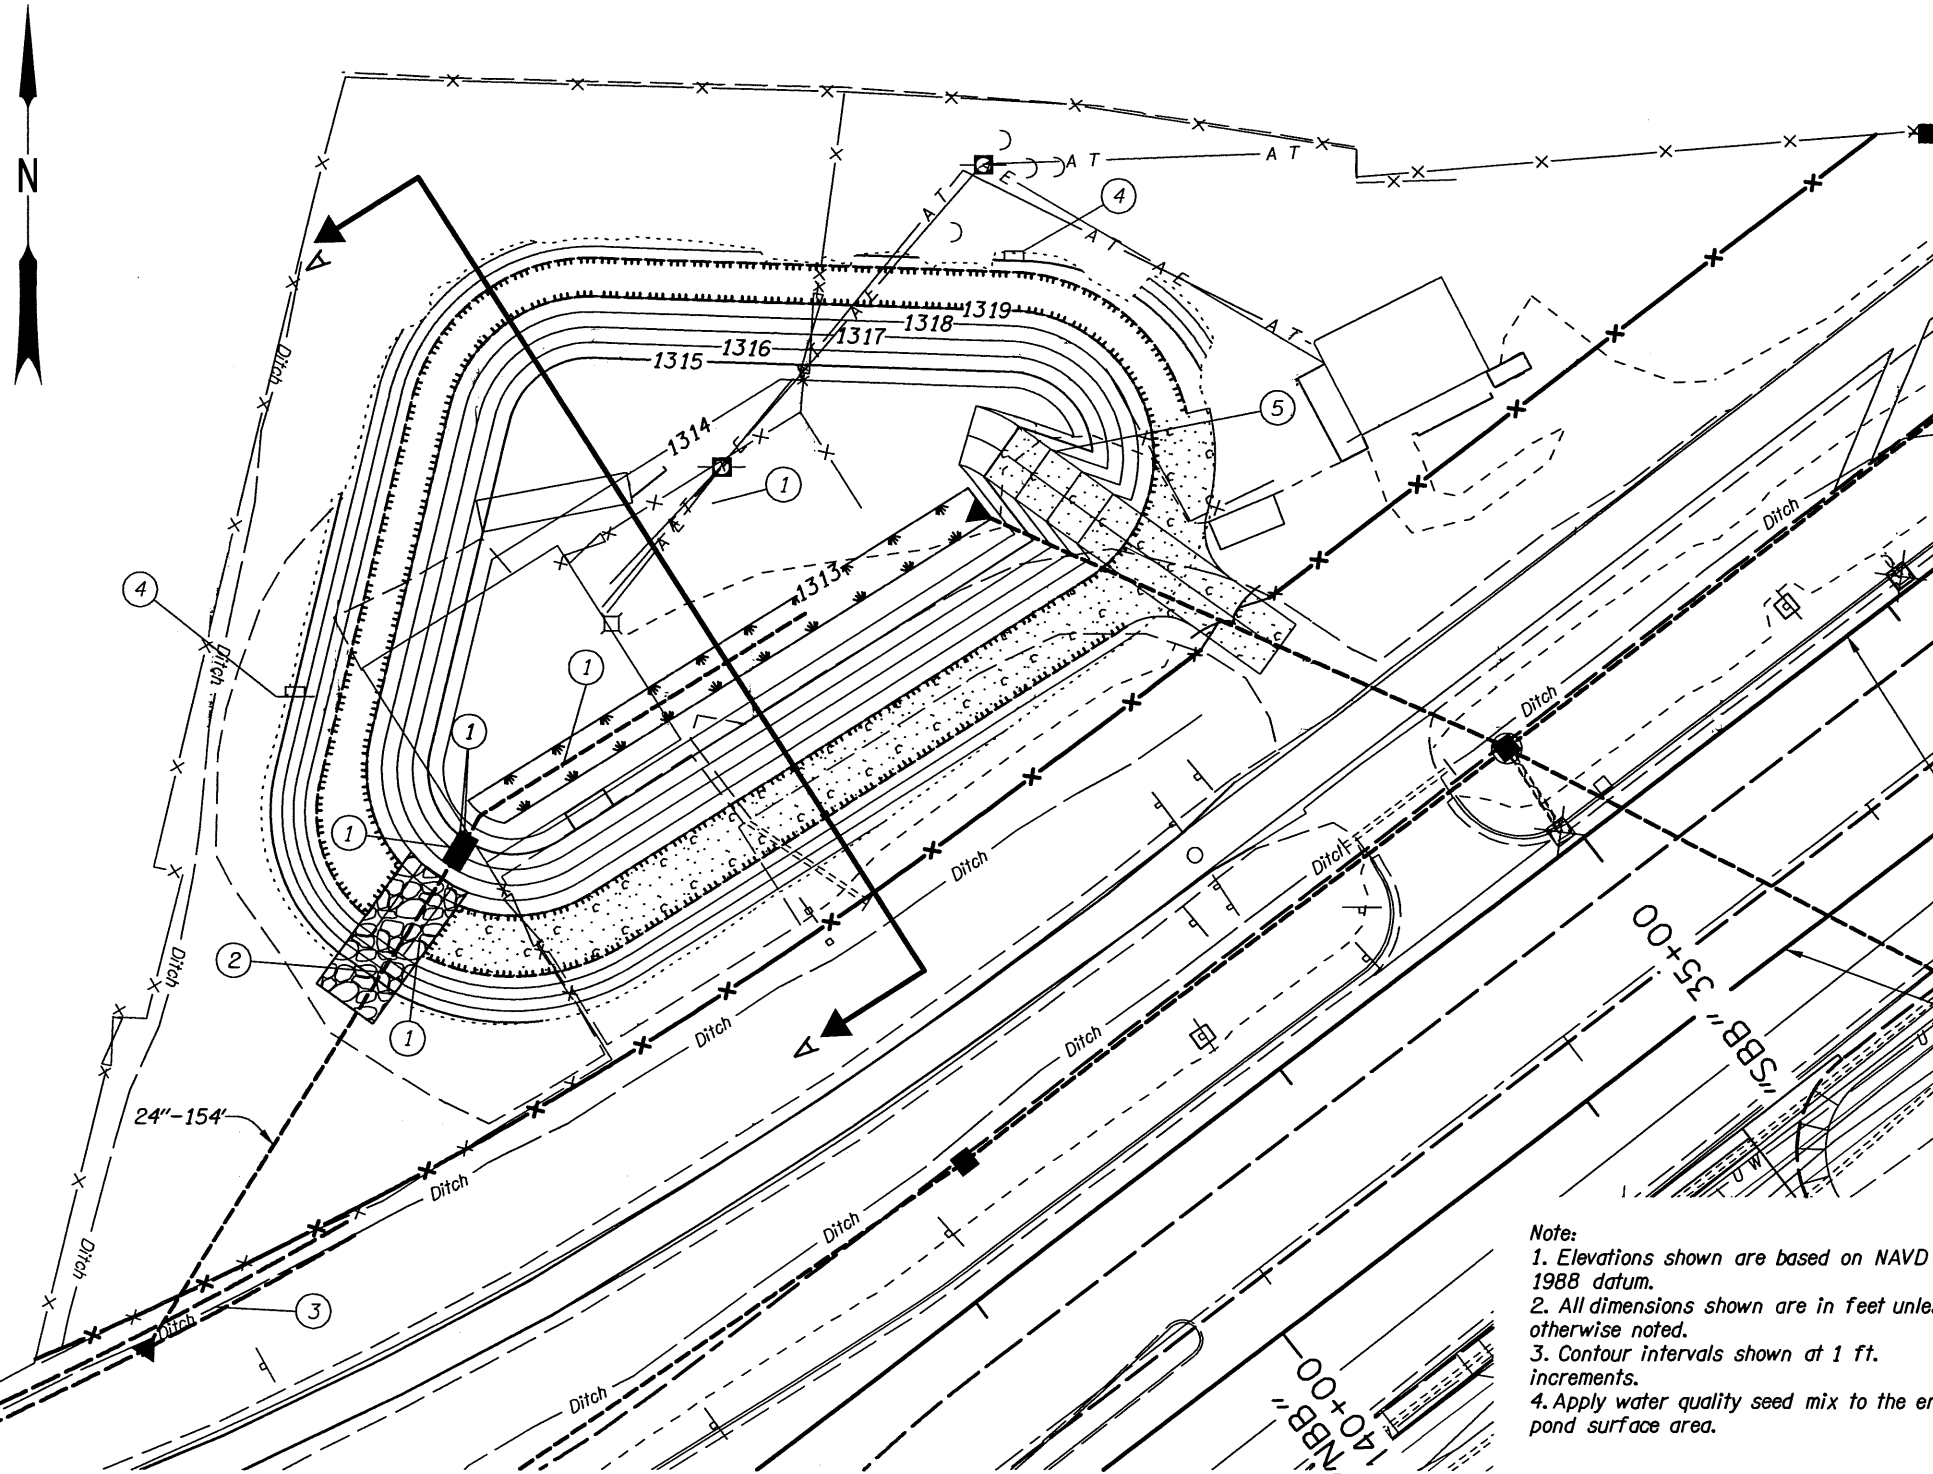

- ① Const. Bioretention Pond, DFI #D00836
(For details, see shfs. GE-2B, GE-4A & GE-4B)
- ② Inst. 24" Storm sewer (5' depth) - 154'
Const. sloped end (1:2)
Const. paved end slope - 25 sq. ft.
Const. riprap protection (Class 100) - 5 cu. yds.
(See dwg. no. RD 317)
- ③ Const. 2 ft. flat bottom ditch
(1V:2H & 1V:3H side slopes)
Ditch excavation - 130 cu. yds.
(For details, see Sht. GE-4B)
- ④ Inst. facility field markers, type S2 - 2
(See drg. no. RD399)
- ⑤ Const. maintenance access road
Agg. base - 430 tons
Subgrade geotextile - 700 sq. yds.
(For details, see sht. GE-4C)

POND STORAGE DATA		
STORM EVENT	WATER SURFACE ELEVATION	STORAGE VOLUME
Water Quality	1315.31'	0.48 Ac-Ft
2 Year	1316.09'	0.75 Ac-Ft
10 Year	1316.68'	0.97 Ac-Ft
50 Year	1317.21'	1.19 Ac-Ft

Note:
1. Elevations shown are based on NAVD 1988 datum.
2. All dimensions shown are in feet unless otherwise noted.
3. Contour intervals shown at 1 ft. increments.
4. Apply water quality seed mix to the entire pond surface area.

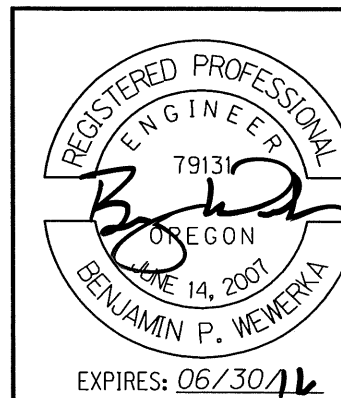

OREGON DEPARTMENT OF TRANSPORTATION

CONSULTING ENGINEERS
www.obec.com


CORPORATE OFFICE:
920 COUNTRY CLUB ROAD, SUITE 100B EUGENE, OREGON 97401-6089
REGIONAL OFFICES:
LAKE OSWEGO; SALEM; MEDFORD, OREGON; VANCOUVER, WASHINGTON

OR62: CORRIDOR SOLUTIONS UNIT 2 (MEDFORD)
CRATER LAKE HIGHWAY
JACKSON COUNTY


Designed By - Ben Wewerka
Checked By - Amy Jones
Drafted By - S. Wolfer

DRAINAGE PLAN

SHEET NO. **GE-4**

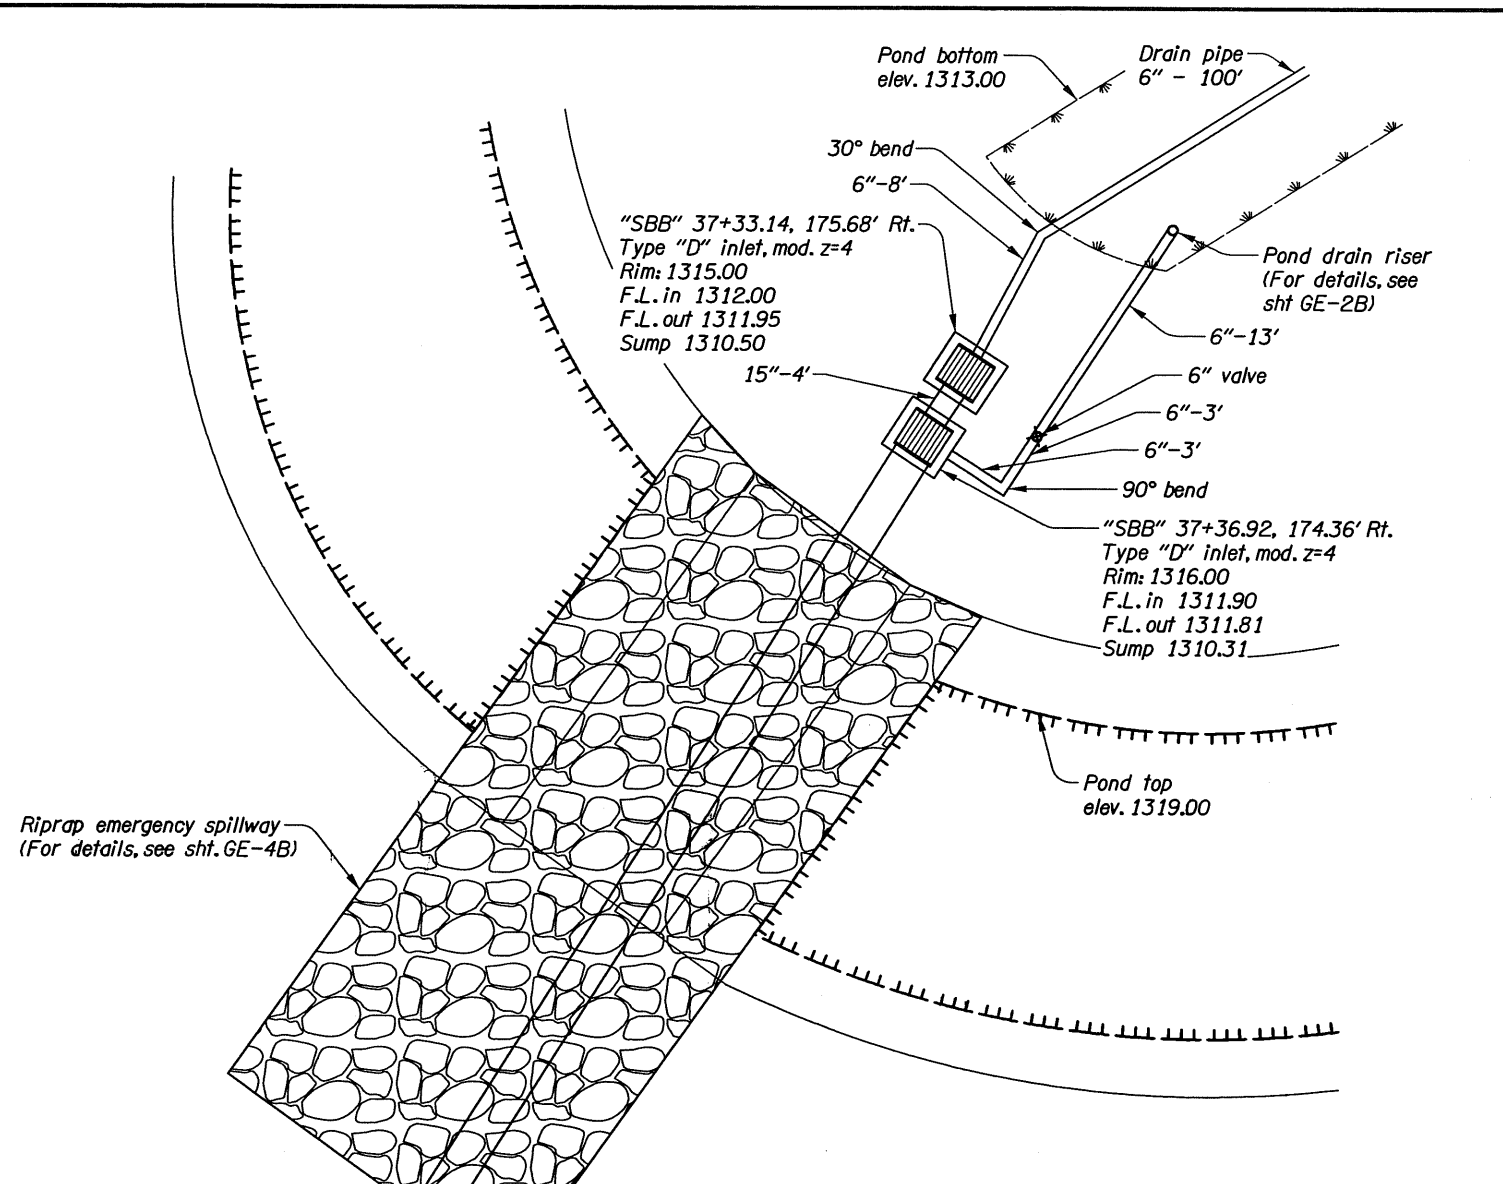


PLAN

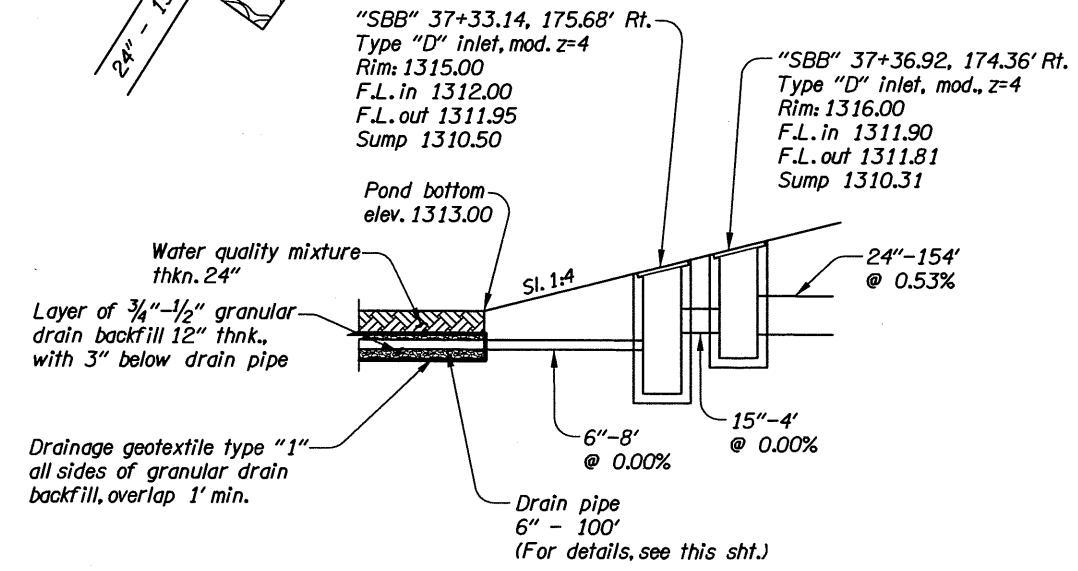


SECTION



OUTFALL STRUCTURE DETAIL

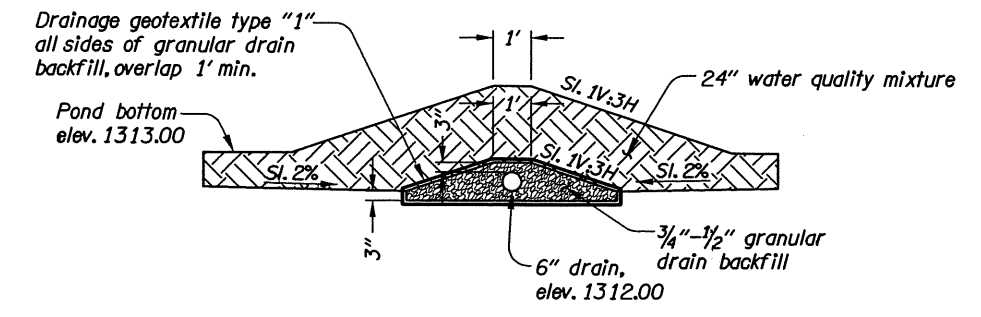


DRAIN PIPE DETAIL

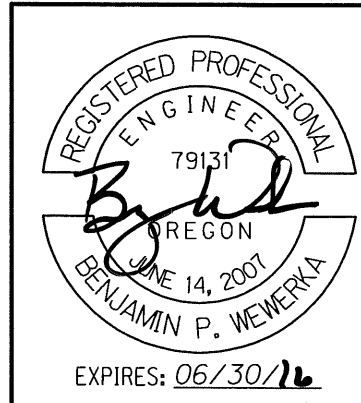


CONSULTING ENGINEERS www.obec.com <small>CORPORATE OFFICE: 920 COUNTRY CLUB ROAD, SUITE 100B EUGENE, OREGON 97401-6089 REGIONAL OFFICES: LAKE OSWEGO; SALEM; MEDFORD, OREGON; VANCOUVER, WASHINGTON</small>	
OR62: CORRIDOR SOLUTIONS UNIT 2 (MEDFORD) CRATER LAKE HIGHWAY JACKSON COUNTY	
Designed By - Ben Wewerka Checked By - Amy Jones Drafted By - S. Wolfer	
DETAILS	SHEET NO. GE-4A

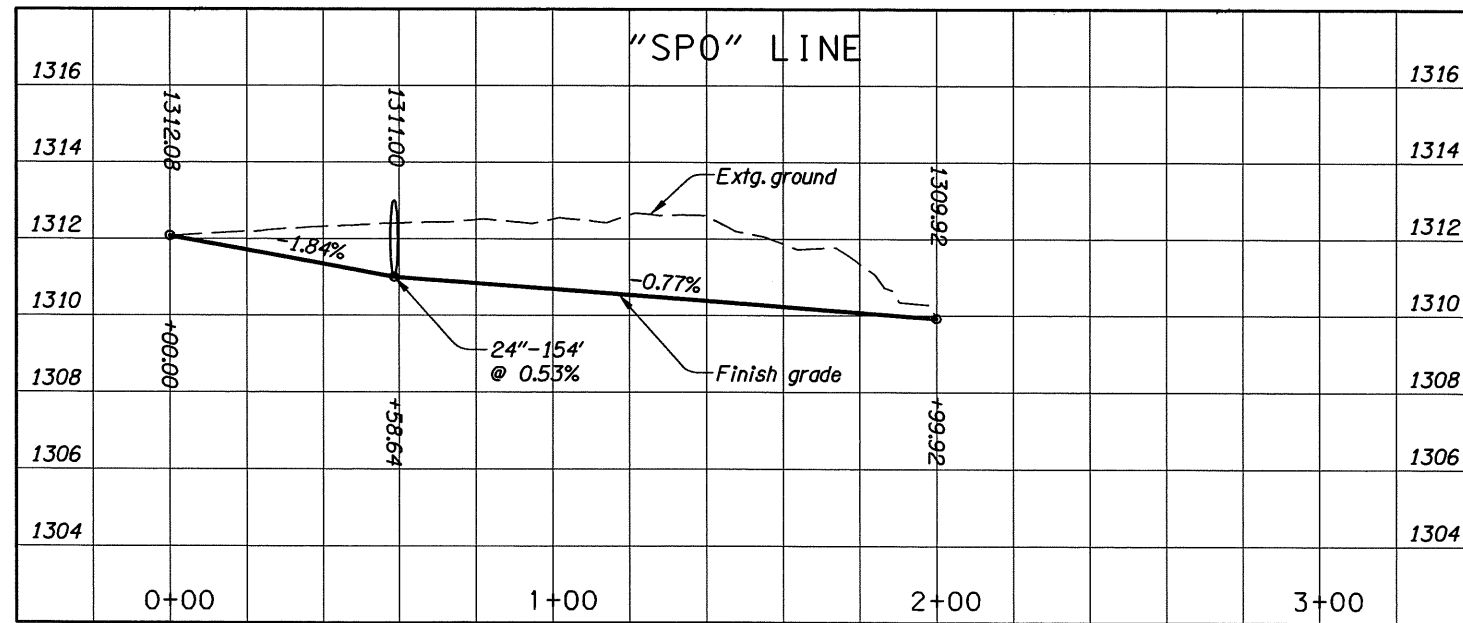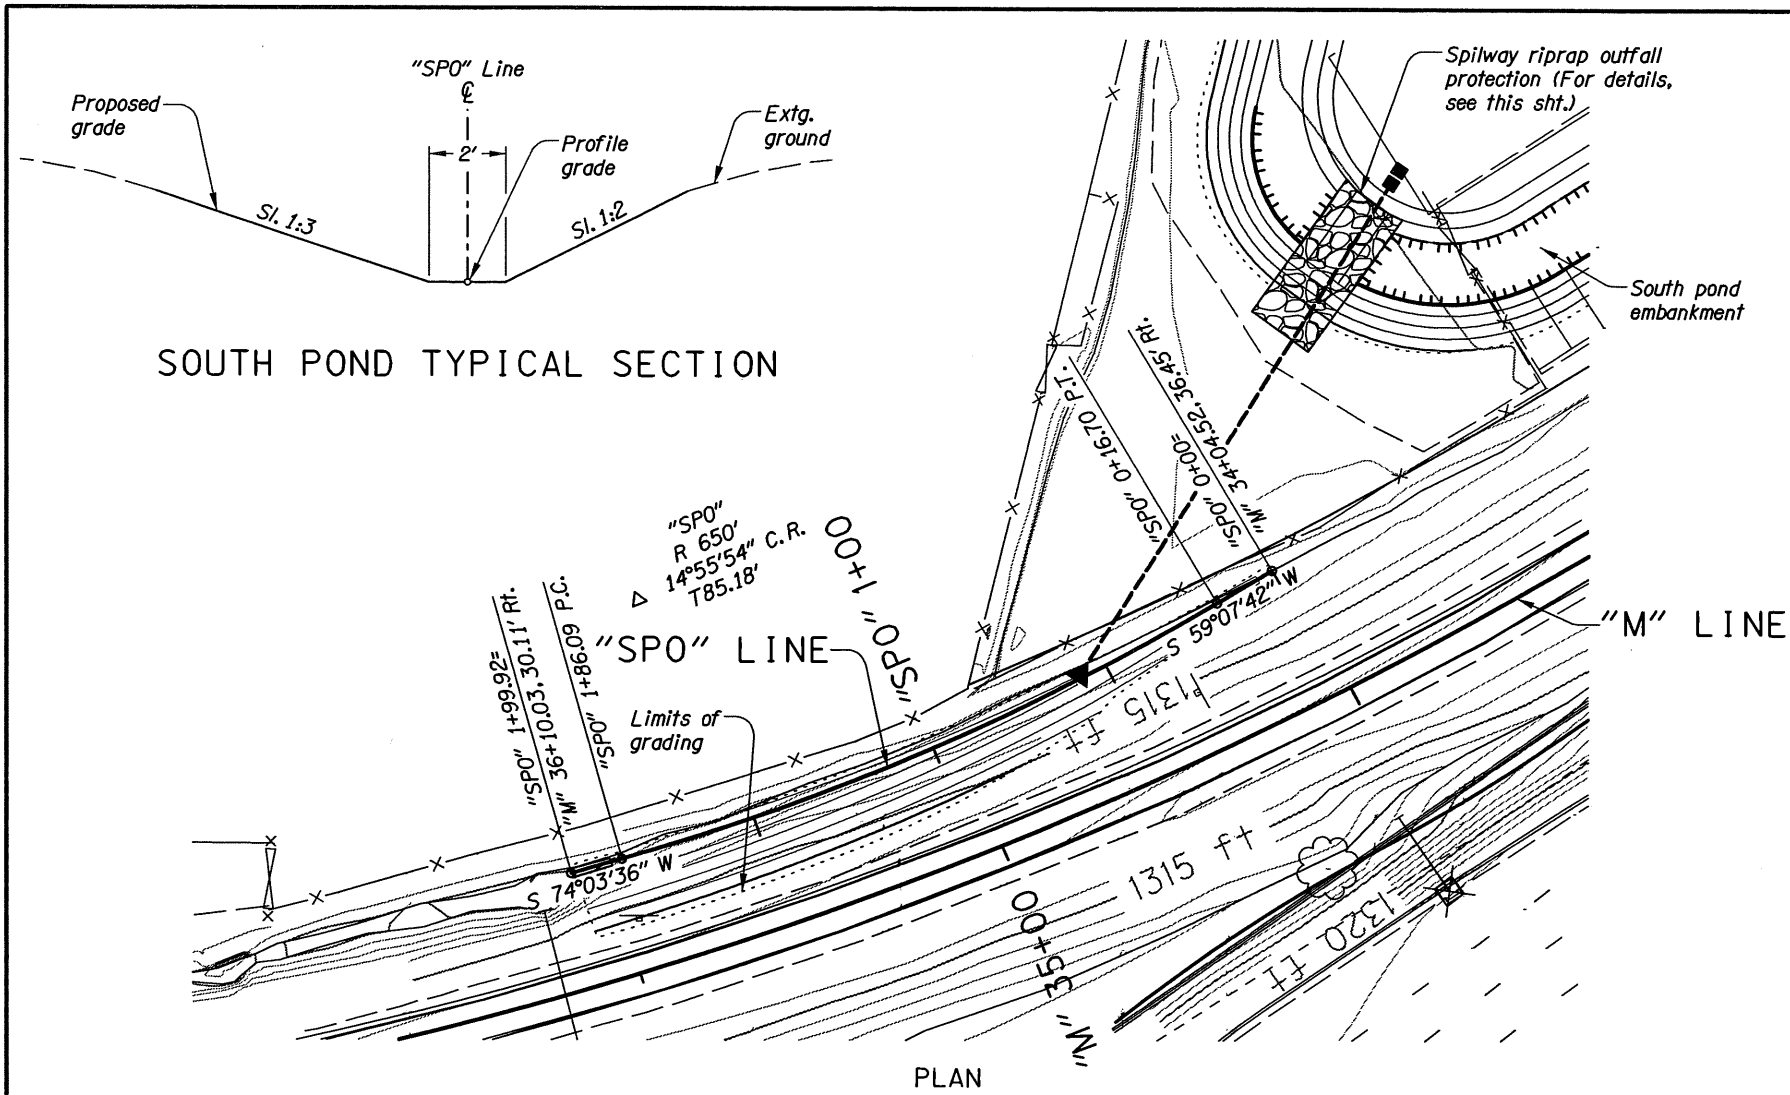

PROFILE
SOUTH POND OUTFALL DITCH

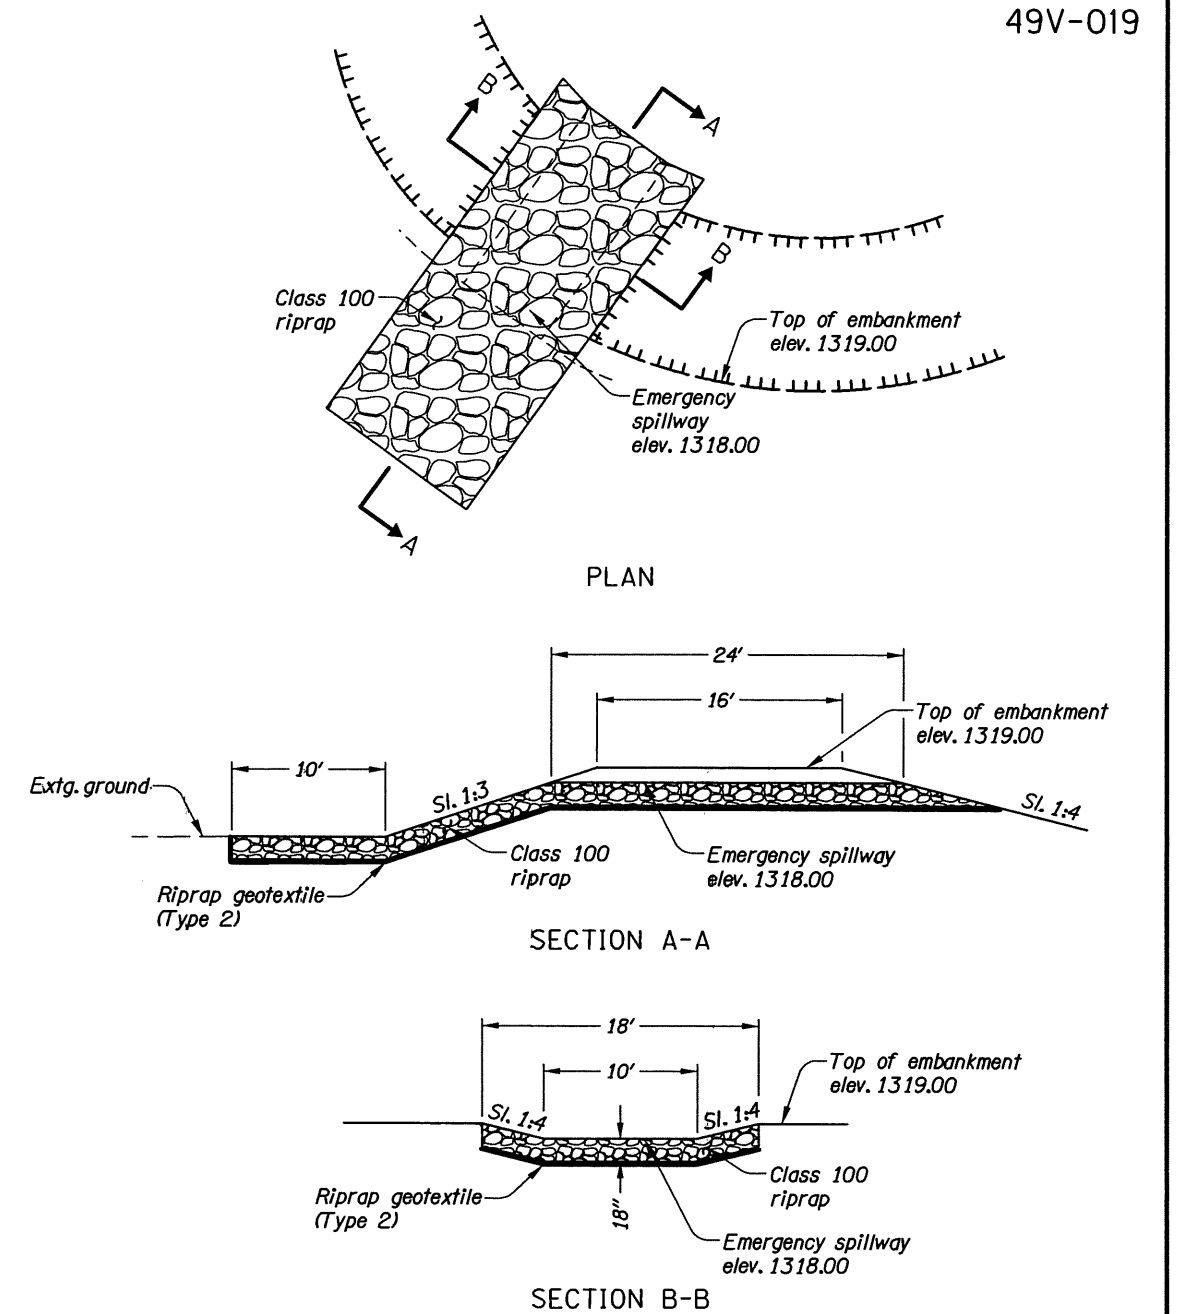

SOUTH POND RIPRAP DETAIL

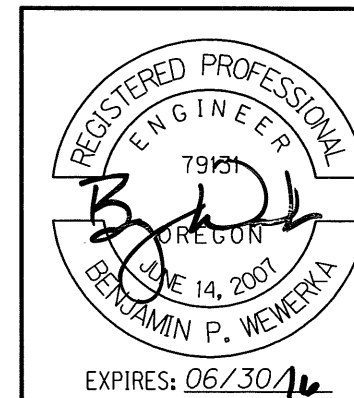

OREGON DEPARTMENT OF TRANSPORTATION


OBEC CONSULTING ENGINEERS
CORPORATE OFFICE: 920 COUNTRY CLUB ROAD, SUITE 100B EUGENE, OREGON 97401-6089
REGIONAL OFFICES: LAKE OSWEGO; SALEM; MEDFORD, OREGON; VANCOUVER, WASHINGTON

OR62: CORRIDOR SOLUTIONS UNIT 2 (MEDFORD)
CRATER LAKE HIGHWAY
JACKSON COUNTY


Designed By - Ben Wewerka
Checked By - Amy Jones
Drafted By - S. Wolfer

DETAILS

SHEET NO. **GE-4B**

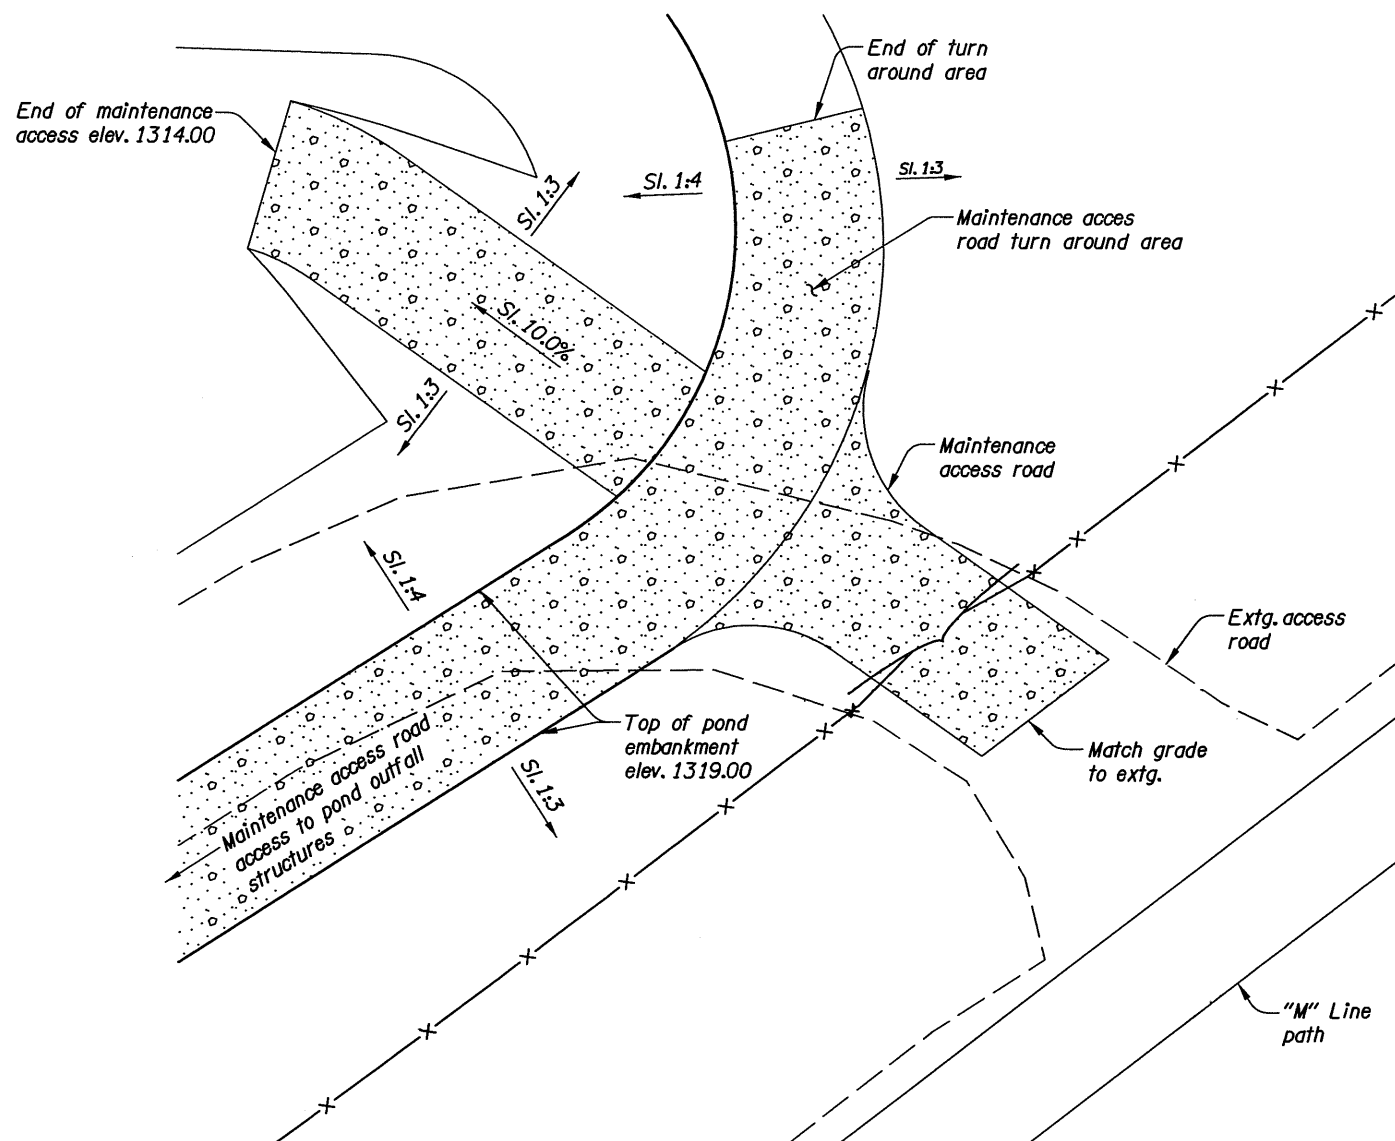


PLAN

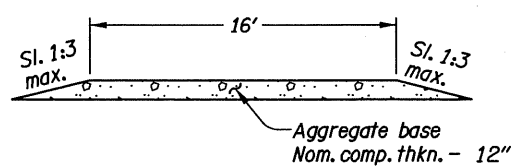


SECTION

SOUTH POND MAINTENANCE ACCESS DETAIL

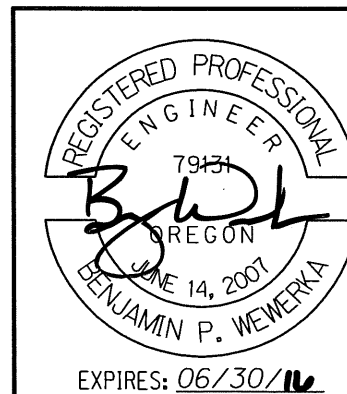


<p>OREGON DEPARTMENT OF TRANSPORTATION</p>	
<p>OBEC CONSULTING ENGINEERS <small>www.obec.com</small></p> <p><small>CORPORATE OFFICE: 920 COUNTRY CLUB ROAD, SUITE 100B EUGENE, OREGON 97401-6089 REGIONAL OFFICES: LAKE OSWEGO; SALEM; MEDFORD, OREGON; VANCOUVER, WASHINGTON</small></p>	
<p>OR62: CORRIDOR SOLUTIONS UNIT 2 (MEDFORD) CRATER LAKE HIGHWAY JACKSON COUNTY</p>	
<p>Designed By - Ben Wewerka Checked By - Amy Jones Drafted By - S. Wolfer</p>	
<p>DETAILS</p>	<p>SHEET NO. GE-4C</p>

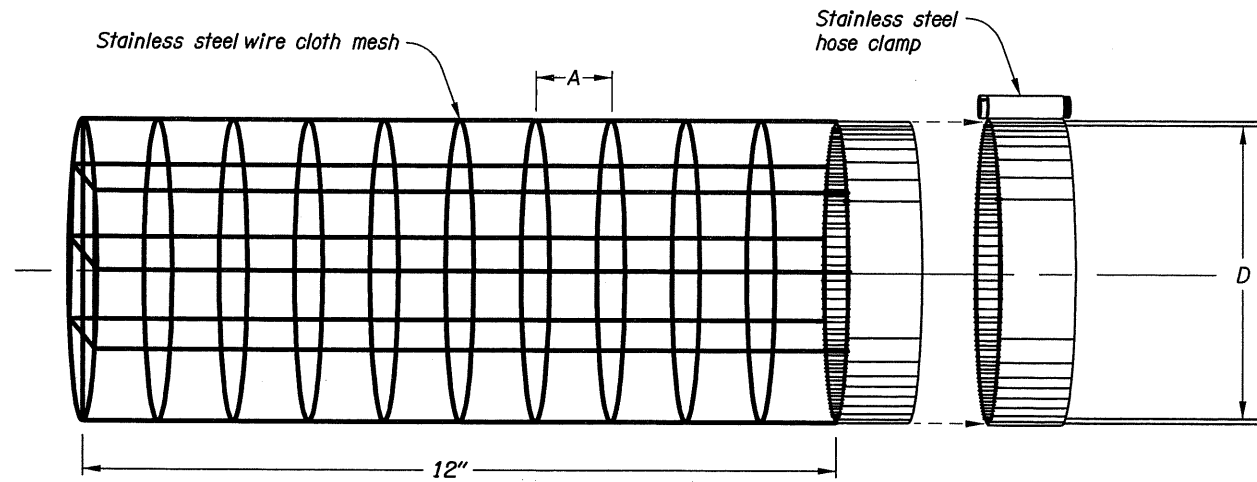


Facility	Riser Diameter (D)	Max. Opening Size (A)
D00834	6"	1"
D00835	6"	2"

WATER QUALITY ORIFICE SCREENING

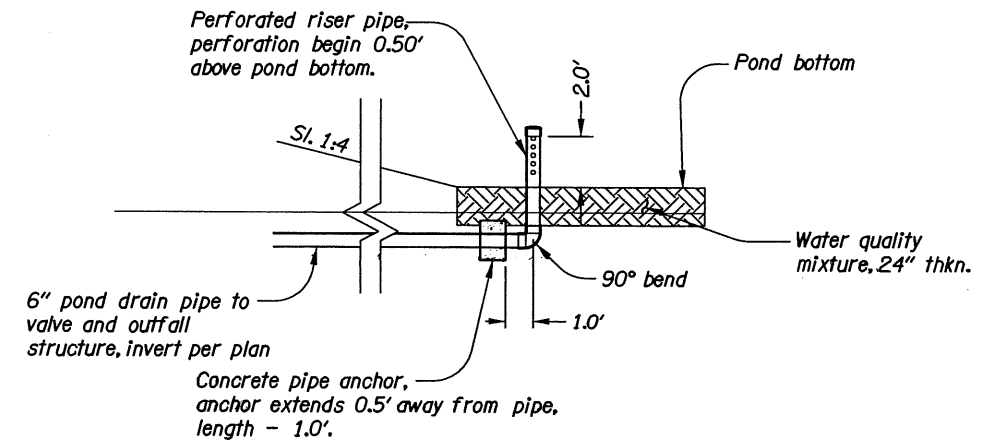


POND DRAIN DETAIL

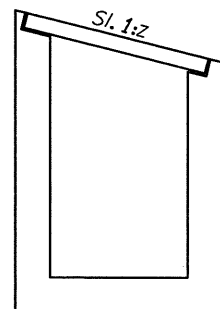

Notes:
For "z" see construction notes on plan views.
For details not shown see RD370.

MODIFIED TYPE "D" INLET

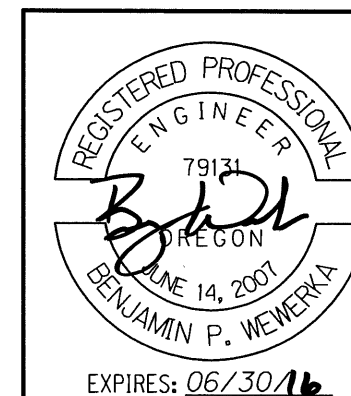

OREGON DEPARTMENT OF TRANSPORTATION

OBEC CONSULTING ENGINEERS
CORPORATE OFFICE: 920 COUNTRY CLUB ROAD, SUITE 100B EUGENE, OREGON 97401-6089
REGIONAL OFFICES: LAKE OSWEGO, SALEM, MEDFORD, OREGON; VANCOUVER, WASHINGTON
www.obec.com

OR62: CORRIDOR SOLUTIONS UNIT 2 (MEDFORD)
CRATER LAKE HIGHWAY
JACKSON COUNTY

Designed By - Ben Wewerka
Checked By - Amy Jones
Drafted By - S. Wolfer

DETAILS

SHEET NO.
GE-2B