

OPERATION & MAINTENANCE MANUAL

DFI No. : D00850
Facility Type: Water Quality
Biofiltration Swale



JUNE 2019

INDEX

1. IDENTIFICATION	1
2. FACILITY CONTACT INFORMATION	1
3. CONSTRUCTION.....	1
4. STORM DRAIN SYSTEM AND FACILITY OVERVIEW	2
5. FACILITY HAZ MAT SPILL FEATURE(S)	2
6. AUXILIARY OUTLET (HIGH FLOW BYPASS)	2
7. MAINTENANCE REQUIREMENTS.....	3
8. WASTE MATERIAL HANDLING.....	4

APPENDIX A: Operational Plan and Profile Drawing(s)

APPENDIX B: ODOT Project Plan Sheets

1. Identification

Drainage Facility ID (DFI): **D00850**
Facility Type: Water Quality Biofiltration Swale
Construction Drawings: 49V-030
Location: District: 08
Highway No.: US199; OR25
Mile Post: 10.04 to 10.07 (beg./end); LEFT
Description: This facility is located on the south side of eastbound US 199. Access to the facility can be obtained along the shoulder of eastbound US 199.

2. Facility Contact Information

Contact the Engineer of Record, Region Technical Center, or Geo-Environmental's Senior Hydraulics Engineer for:

- Operational clarification
- Maintenance clarification
- Repair or restoration assistance

Engineering Contacts:

Region Technical Center Hydro Unit Manager

Or

Geo-Environmental Senior Hydraulics Engineer (503) 986-3365.

3. Construction

Engineer of Record: DeLanie Cutsforth – Region 3 Tech Center, White City, (541) 774-6326

Facility construction: 2017
Contractor: N/A

4. Storm Drain System and Facility Overview

A water quality swale is a flat-bottomed open channel designed to treat stormwater runoff from highway pavement areas. This type of facility is lined with grass. Treatment by trapping sedimentation occurs when stormwater runoff flows through the grass.

This facility is located along the eastbound lane of US 199 (No. 025). Access for this facility is available from the south shoulder of eastbound US 199. Stormwater enters the facility via roadway runoff and a drainage ditch located along the south side of eastbound US 199. As the water flows west it is treated as it slows and spreads out within the swale before outfalling into an existing ditch.

A. Maintenance equipment access:

This facility can be accessed from the eastbound US 199 (Hwy 025) shoulder. Driving heavy equipment through swale may cause damage to the facility. Use of mower with extension arm recommended.

B. Heavy equipment access into facility:

- Allowed (no limitations)
- Allowed (with limitations)
- Not allowed

C. Special Features:

- Amended Soils
- Porous Pavers
- Liners
- Underdrains

5. Facility Haz Mat Spill Feature(s)

The water quality biofiltration swale can be used to store a volume of liquid by blocking the facility outlet through use of sandbags.

6. Auxiliary Outlet (High Flow Bypass)

Auxiliary Outlets are provided if the primary outlet control structure can not safely pass the projected high flows. Broad-crested spillway weirs and over flow risers are the two most common auxiliary outlets used in stormwater treatment facility design. The auxiliary outlet feature is either a part of the facility or an additional storm drain feature/structure.

The auxiliary outlet feature for this facility is:

Designed into facility

Other

There are no auxiliary outlets built into this facility. In the event that flows exceed design flows the water will overtop the driveway at the NE end of the swale and flow directly into Round Prairie Creek.

7. Maintenance Requirements

Routine maintenance table for non-proprietary stormwater treatment and storage/detention facilities have been incorporated into ODOT's Maintenance Guide. These tables summarize the maintenance requirements for ponds, swales, filter strips, bioslopes, and detention tanks and vaults. Special maintenance requirements in addition to the routine requirements are noted below when applicable.

The ODOT Maintenance Guide can be viewed at the following website:

<http://www.oregon.gov/ODOT/HWY/OOM/MGuide.shtml>

Maintenance requirements for proprietary structures, such as underground water quality manholes and/or vaults with filter media are noted in Appendix C when applicable.

The following stormwater facility maintenance table (See ODOT Maintenance Guide) should be used to maintain the facility outlined in this Operation and Maintenance Manual or follow the Maintenance requirements outlined in Appendix C when proprietary structure is selected below:

- Table 1 (general maintenance)
- Table 2 (stormwater ponds)
- Table 3 (water quality biofiltration swales)
- Table 4 (water quality filter strips)
- Table 5 (water quality bioslopes)
- Table 6 (detention tank)
- Table 7 (detention vault)
- Appendix C (proprietary structure)
- Special Maintenance requirements:

Note: Special maintenance Requirements Require Concurrence from ODOT SR Hydraulics Engineer.

8. Waste Material Handling

Material removed from the facility is defined as waste by DEQ. Refer to the roadwaste section of the ODOT Maintenance Yard Environmental Management System (EMS) Policy and Procedures Manual for disposal options: <http://egov.oregon.gov/ODOT/HWY/OOM/EMS.shtml>





Contact any of the following for more detailed information about management of waste materials found on site:

ODOT Clean Water Unit	(503) 986-3008
ODOT Statewide Hazmat Coordinator	(503) 229-5129
ODOT Region Hazmat Coordinator	(503) 731-8304
ODEQ Northwest Region Office	(503) 229-5263

Appendix A

Content:

- **Operational Plan and Profile Drawing(s)**

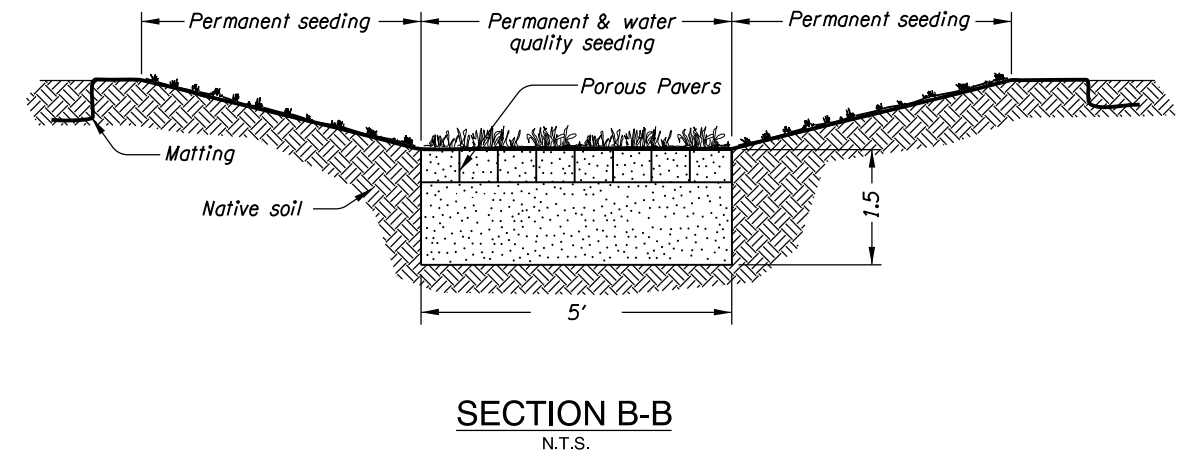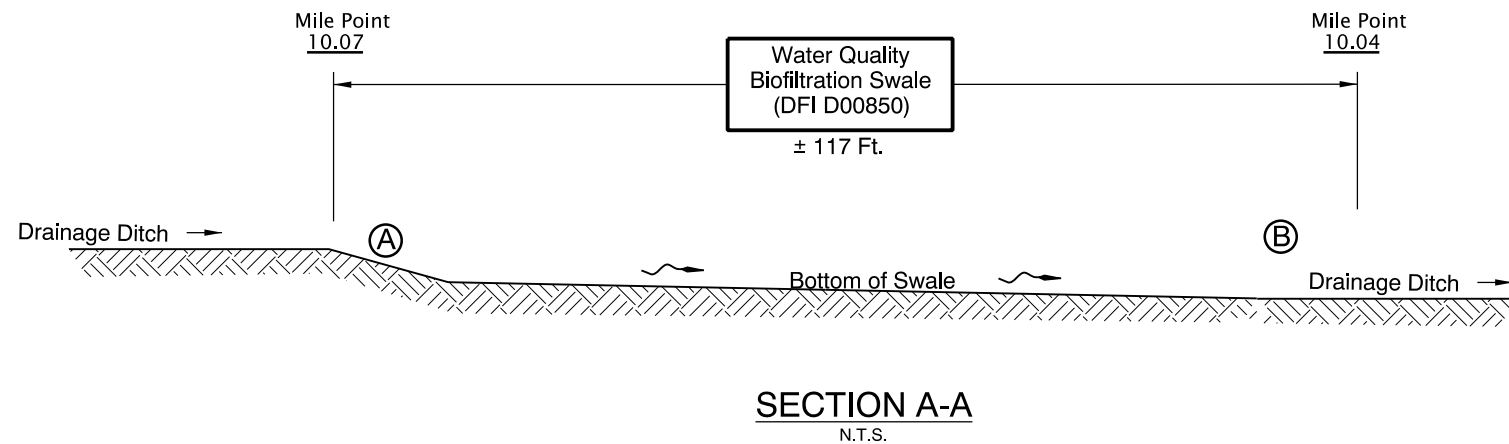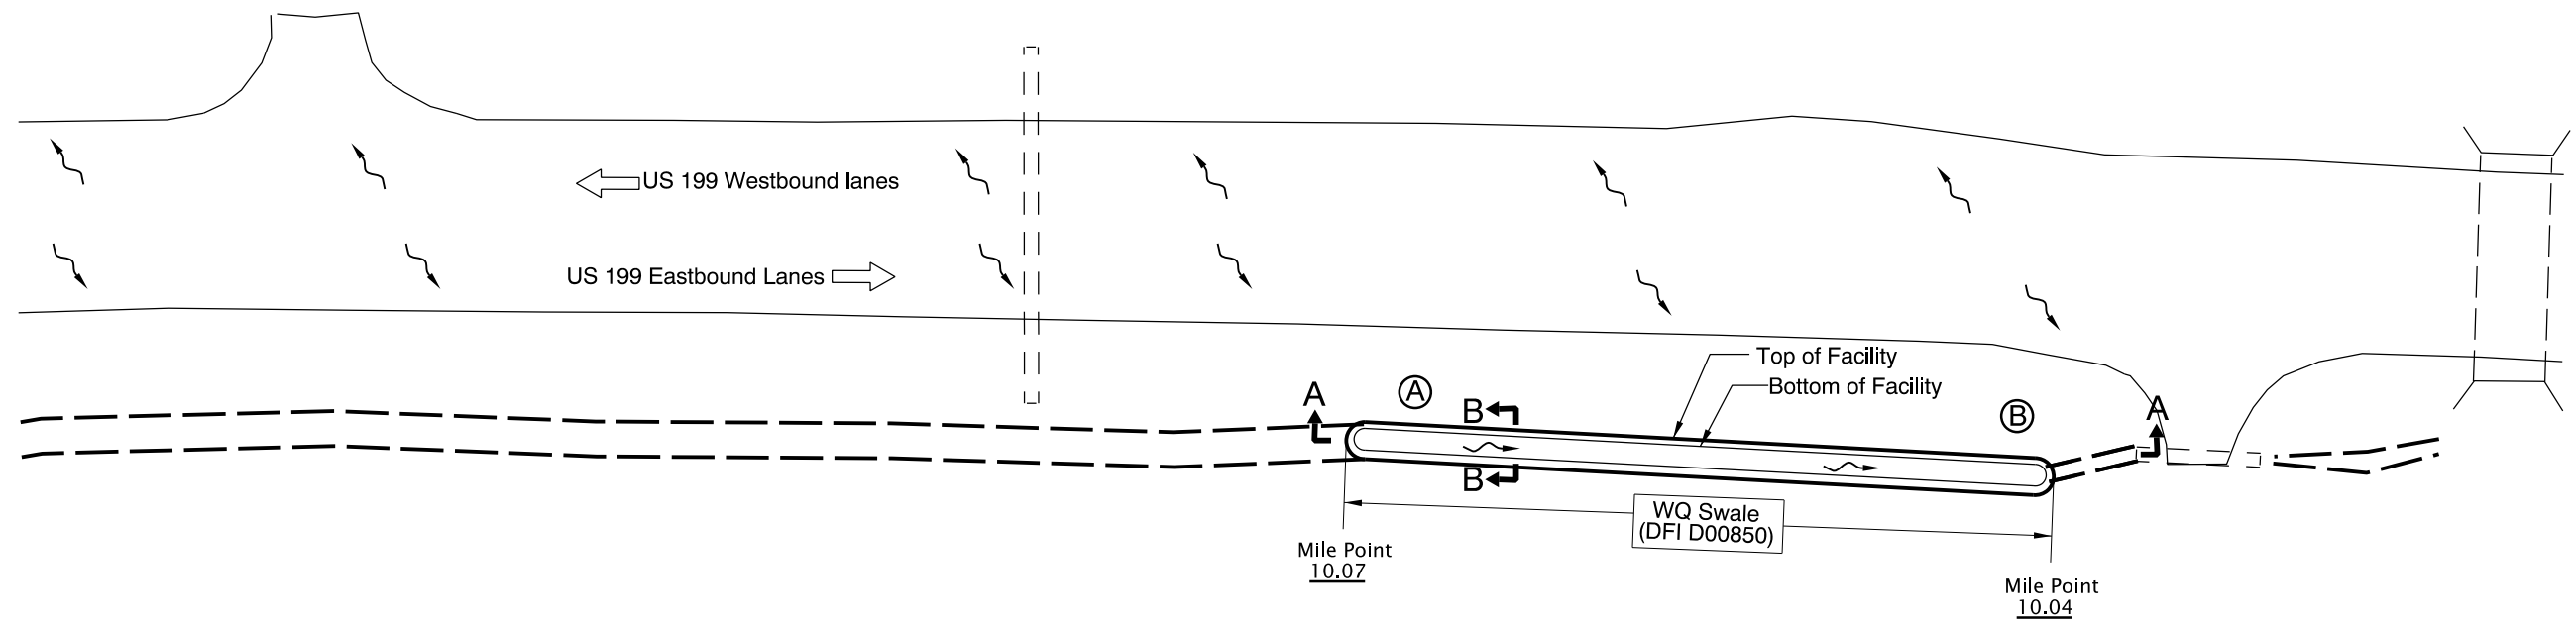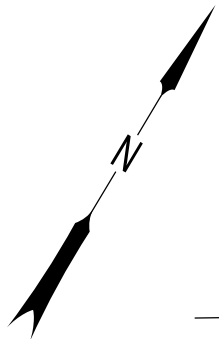

- LEGEND:**
- Ⓐ Swale Inlet w/Flow Spreader
 - Ⓑ Swale Outlet
 - and ○ Manhole
 - and □ Inlet
 - Storm Pipe (Facility)
 - Storm Pipe
 - ← Conveyance Direction
 - ~ Pavement / Facility Flow Path

Prepared By: D. Cutsforth

Drafted By: D. Cutsforth

OREGON DEPARTMENT OF TRANSPORTATION

DFI D00850
MAINTENANCE DISTRICT 8 HWY 025
WQ BIOFILTRATION SWALE
 MP 10.04 - 10.07
 JOSEPHINE COUNTY

Appendix B

Content:

- **ODOT Project Plan Sheets**
 - *Cover/Title Sheet*
 - *Water Quality/Detention Plan Sheets*
 - *Other Details*


INDEX OF SHEETS	
SHEET NO.	DESCRIPTION
1	Title Sheet
1A	Index Of Sheets Cont. & Std. Drg. Nos.

STATE OF OREGON
DEPARTMENT OF TRANSPORTATION

PLANS FOR PROPOSED PROJECT
GRADING, DRAINAGE, PAVING & SIGNING

**US199: APPLGATE RIVER -
SLATE CREEK**

REDWOOD HIGHWAY
JOSEPHINE COUNTY
MARCH 2016

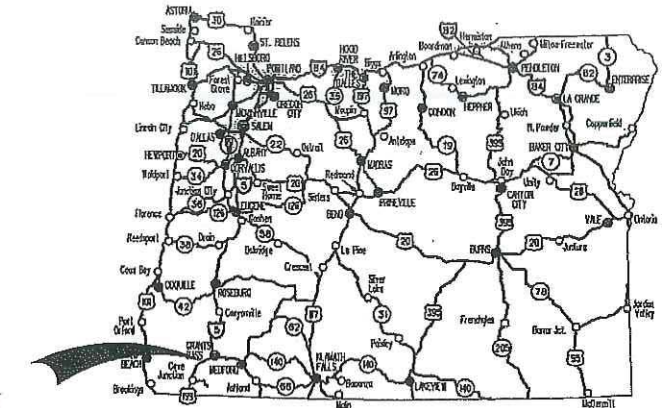

Overall Length Of Project - 7.24 Miles

ATTENTION:
Oregon Law Requires You To Follow Rules Adopted By The Oregon Utility Notification Center. Those Rules Are Set Forth In OAR 952-001-0010 Through OAR 952-001-0090. You May Obtain Copies Of The Rules By Calling The Center. (Note: The Telephone Number For The Oregon Utility Center is (503) 232-1987.)




REVISED AS CONSTRUCTED
J. Park
Project Manager
2/17/2017 **C14880**
Date **Contract No.**

END OF PROJECT NHPP-S025(053)
STA. "R" 1854+55.00 (M.P. 7.11)

BEGINNING OF PROJECT NHPP-S025(053)
STA. "R" 1492+84.50 (M.P. 14.26)

EQUA. STA. "R" 1753+24.23 = M.P. 9.03 Bk. =
= M.P. 9.33 Ah.

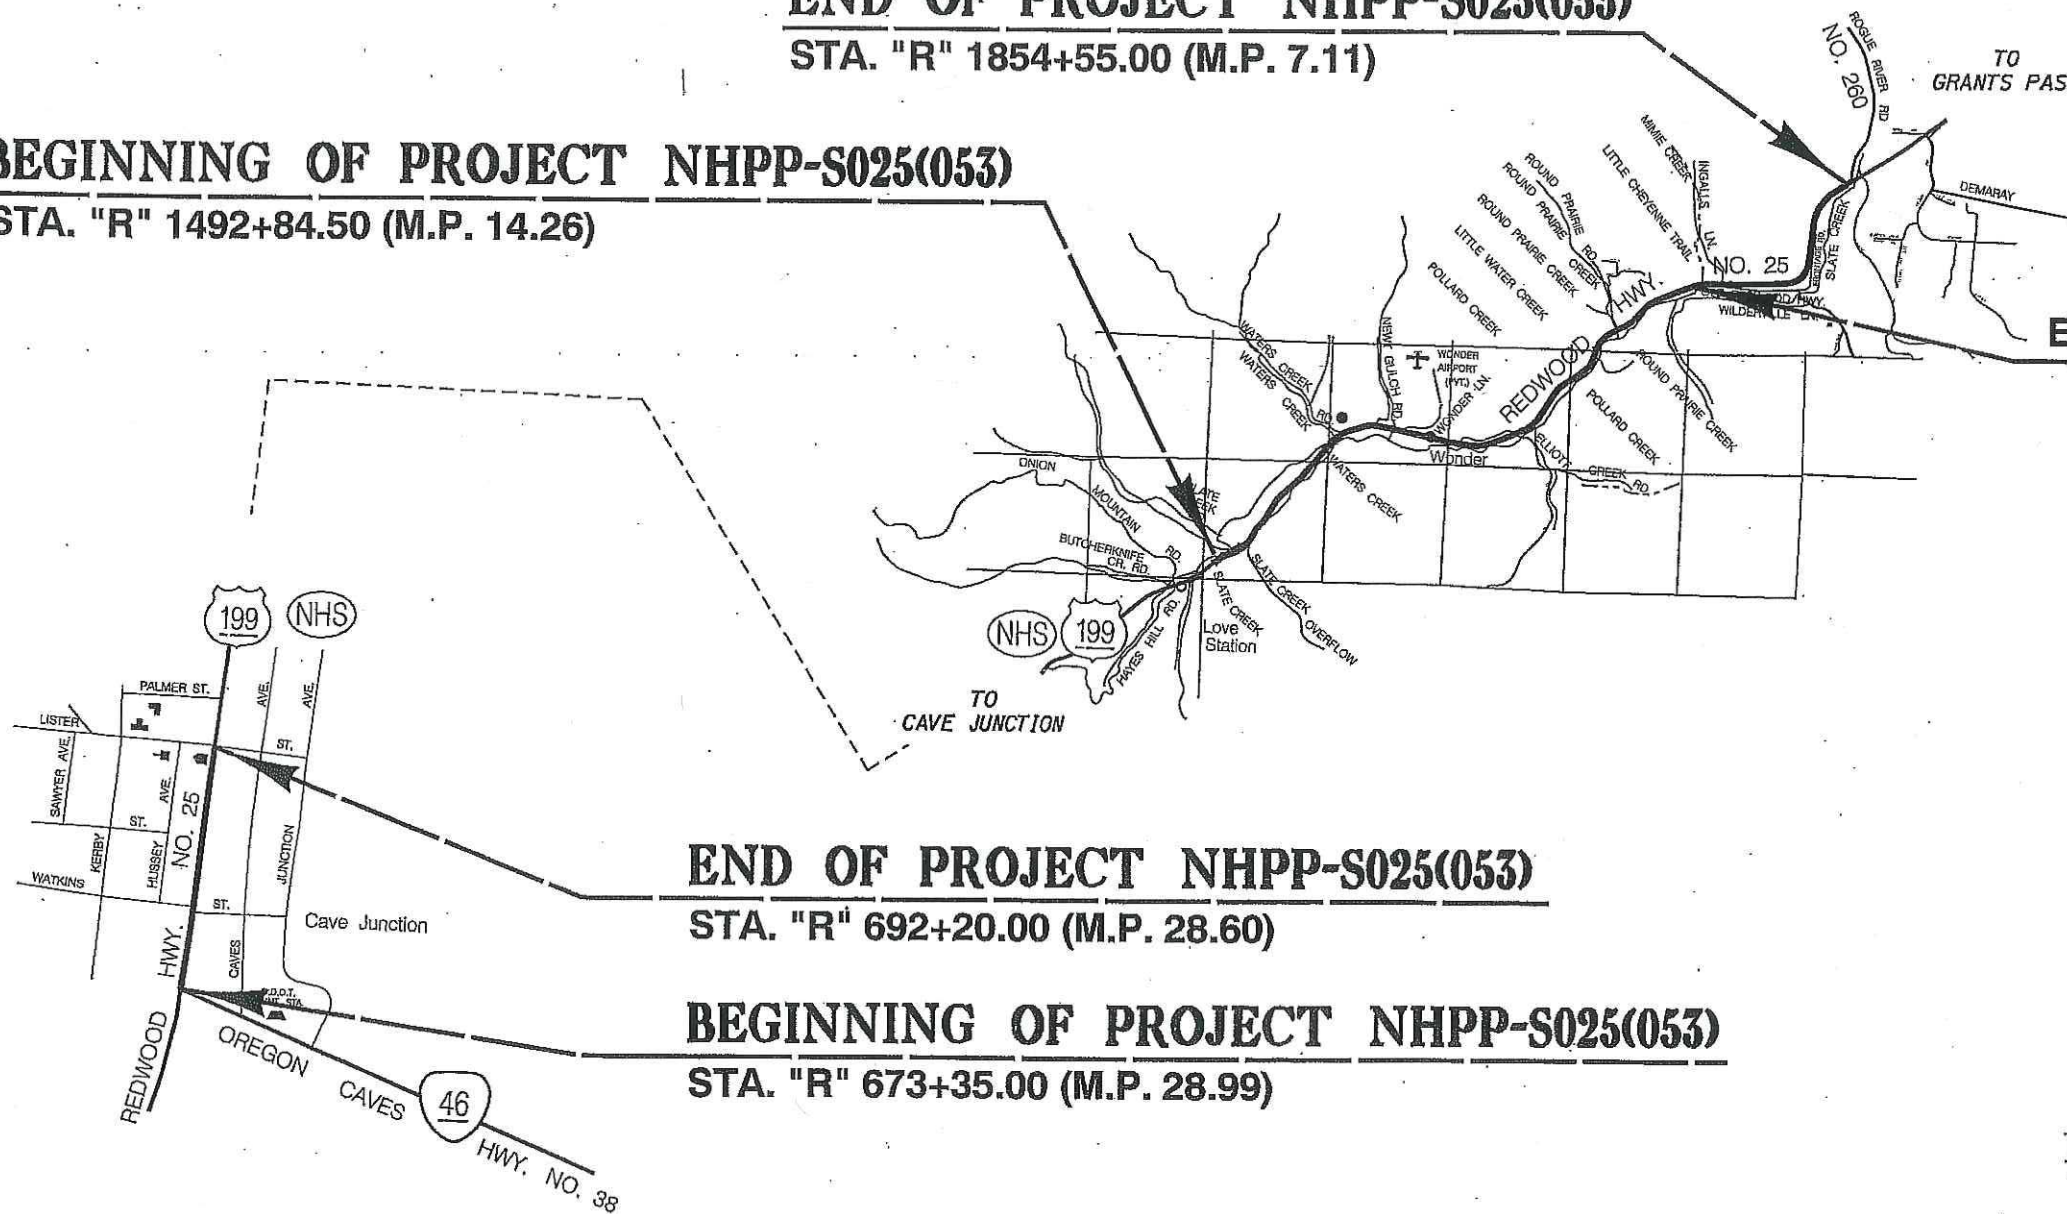

END OF PROJECT NHPP-S025(053)
STA. "R" 692+20.00 (M.P. 28.60)

BEGINNING OF PROJECT NHPP-S025(053)
STA. "R" 673+35.00 (M.P. 28.99)

OREGON TRANSPORTATION COMMISSION

Tammy Boney CHAIR
David Lohman COMMISSIONER
Susan Morgan COMMISSIONER
Alando Simpson COMMISSIONER
Sean O'Hollaren COMMISSIONER
Matthew L. Garrett DIRECTOR OF TRANSPORTATION

These plans were developed using ODOT design standards. Exceptions to these standards, if any, have been submitted and approved by the ODOT Chief Engineer or their delegated authority.

Approving Authority: *[Signature]*
Signature & date **1-26-2016**
MARK THOMPSON R3 TECH. CENTER MANAGER
Print name and title

[Signature]
Concurrence by ODOT Chief Engineer

**US199: APPLGATE RIVER -
SLATE CREEK
REDWOOD HIGHWAY
JOSEPHINE COUNTY**

FEDERAL HIGHWAY ADMINISTRATION	PROJECT NUMBER	SHEET NO.
OREGON DIVISION	NHPP-S025(053)	1

T. 036S., R. 006W., W.M.
T. 037S., R. 007W., W.M.



Standard Drg.Nos.

INDEX OF SHEETS, CONT.

SHEET NO.	DESCRIPTION
1B & 1B-2	Right of Way Hold Outs
1C-1 thru 1C-4	Survey Control Sheets
2 thru 2A-7	Typical Sections
2B thru 2B-5	Details
2B-6 thru 2B-20	Details (Cave Junction)
2B-21	Details
2C thru 2C-4	Traffic Control Plan
2C-5 & 2C-6	Traffic Control Plan (Cave Junction)
2D	Pipe Data Sheet
3 thru 6	General Construction
7	General Construction And Profiles
8 thru 10	General Construction
11	General Construction And Profiles
11A	General Construction Notes
12 thru 16	General Construction
17	General Construction And Profiles
17A	General Construction Notes
1B thru 21	General Construction (Cave Junction)

GEO/HYDRO

SHEET NO.	DESCRIPTION
GA thru GA-6	Erosion Control Plan
GG & GG-2	Temporary Water Management
GJ & GJ-2	Stormwater Details

BRIDGE

DRAWING NO.	DESCRIPTION
96911	Plan & Details

PERMANENT PAVEMENT MARKINGS

SHEET NO.	DESCRIPTION
ST thru ST-3	Striping Details
ST-4 thru ST-19	Striping Plan
ST-20 thru ST-22	Striping Plan (Cave Junction)

PERMANENT SIGNING

SHEET NO.	DESCRIPTION
S15804 thru S15823	Signing Plan
S15824 thru S15826	Signing Details
S15827 thru S15830	Sign and Post Data Table

SIGNAL PLANS

SHEET NO.	DESCRIPTION
18673	Signal Plan
18674	Detector Plan
18675	Existing Utilities
18676	Signal Plan
18677	Detector Plan
18678	Existing Utilities
18679	Removal Plan
18680	Signal Plan
18681	Detector Plan
18682	Existing Utilities
18683	Details

R/W Map Nos. 11B-7-26
11B-8-4

RD100	- Mailbox Support	RD1010	- Inlet Protection (Type 2.6 & 7)	TM800	- Tables, Abrupt Edge And PCMS Details
RD101	- Mailbox Installation	RD1006	- Check Dams Type 2 and 6	TM810	- Temporary Pavement Markings
RD140	- Roadway Cross Slopes Superelevated Sections	RD1015	- Inlet Protection Type 4	TM820	- Temporary Barricades
RD150	- Slope Rounding	RD1040	- Sediment Fence	TM821	- Temporary Sign Supports
		RD1055	- Matting	TM830	- Temporary Concrete Barrier And Rumble Strip Details
RD300	- Trench Backfill, Bedding, Pipe Zone And Multiple Installations			TM831	- Temporary Impact Attenuators
RD302	- Street Cut	TM200	- Sign Installation Details	TM833	- Temporary Impact Attenuators
RD316	- Sloped Ends For Metal Pipe	TM201	- Miscellaneous Sign Placement Details	TM841	- Intersection Work Zone Details
RD317	- Culvert Embankment Protection	TM211	- Sign Details US & Interstate Route Shields	TM842	- Signalized Intersection Details
RD318	- Sloped Ends For Concrete Pipe	TM221	- Signing Details Milepost Markers	TM844	- Temporary Pedestrian Access Routing
RD319	- Miscellaneous Culvert Details	TM222	- Installation Details Milepost Marker Posts	TM850	- 2-Lane, 2-Way Roadways
RD320	- Paved End Slope For Culverts 60" Maximum Pipe Size	TM223	- Conventional Roads Directional Sign Layout Street Name Signs	TM851	- Non-Freeway Multi-Lane Sections
RD324	- Safety End Section For Concrete, PVC, HDPE & Polypropylene Pipe			TM852	- Non-Freeway Multi-Lane Sections
RD325	- Coupling Bands For Corrugated Metal Pipe	TM230	- Mounting Details For Removable Legend 4" Through 8" Letters & Numbers	TM853	- Non-Freeway Multi-Lane Sections
RD326	- Coupling Bands For Corrugated Metal Pipe				
RD327	- Coupling Bands For Corrugated Metal Pipe	TM233	- Mounting Details For Removable Legend Various Arrow Sizes		
RD335	- Standard Storm Sewer Manhole				
RD336	- Standard Manhole Details	TM450	- Mast Arm Pole Details		
RD339	- Pipe To Structure Connections	TM452	- Strain Pole Details		
RD346	- Large Precast Manhole	TM457	- Vehicle, Pedestrian Signal And Push Button Mounting Option Details		
RD348	- Manhole With Inlet				
RD363	- Gutter Transition	TM467	- Pedestrian Signal And Pedestrian Push Button Details		
RD364	- Concrete Inlets Type G-1, G-2, G-2M & G-2MA				
RD365	- Frames & Grates For Concrete Inlets	TM470	- Color Code Charts		
RD366	- Concrete Inlets Type CG-1, CG-2	TM472	- Traffic Signal Junction Boxes/Hand Holes		
RD367	- Curb Inlet Channel	TM475	- Loop Details		
RD380	- Fill Height Tables For Aluminum & Steel Corrugated Pipe	TM480	- Loop Entrance Details		
RD384	- Fill Height Tables For Aluminum & Steel Spiral Rib Pipe				
RD386	- Fill Height Table For Circular Concrete Pipe	TM500	- Pavement Marking Standard Detail Blocks		
RD388	- Fill Height Tables For PVC Pipe	TM501	- Pavement Marking Standard Detail Blocks		
RD390	- Fill Height Table For Corrugated HDPE Pipe	TM502	- Pavement Marking Standard Detail Blocks		
RD391	- Fill Height Table For Steel Reinforced HDPE Pipe	TM503	- Pavement Marking Standard Detail Blocks		
RD393	- Fill Height Tables For Polypropylene Pipe	TM515	- Pavement Markers		
RD398	- Culvert ID Marker	TM517	- Recessed Pavement Markers		
RD399	- Stormwater Treatment And Storage Facility Field Markers	TM521	- Durable Pavement Markings Method "A" & Method "B" Surface & Groove Installed Non-Profiled		
		TM525	- High Performance Markings Surface & Groove Installed		
RD400	- Guardrail And Metal Median Barrier	TM530	- Intersection Pavement Markings (Crosswalk, Stop Bar & Bike Lane Stencil)		
RD405	- Guardrail And Metal Median Barrier Parts	TM531	- Turn Arrow Marking Details		
RD410	- Guardrail Parts (Thrie Beam)	TM539	- Median and Left Turn Channelization Details		
RD415	- Guardrail And Metal Median Barrier Parts	TM560	- Alignment Layout: General		
RD420	- Energy Absorbing Terminal	TM561	- Alignment Layout: Left Turn Lane, Centerline & Medians		
RD425	- Non Energy-Absorbing Terminal 3' Or 4' Flare	TM570	- Traffic Delineators		
RD435	- Guardrail Installation Terminal (Cut Or False Cut)	TM571	- Traffic Delineators Steel Post Details		
RD440	- Guardrail Installation At Bridge Ends	TM576	- Traffic Delineator Installation For Non-Freeways		
RD450	- Guardrail Anchors (Steel)				
RD470	- Guardrail Over Low-Fill Culverts	TM635	- Breakaway Sign & Luminaire Supports - Support Location Guidelines		
RD480	- 31" Guardrail And Metal Median Barrier				
RD481	- 31" Guardrail And Metal Median Barrier Height Conversion	TM670	- Wood Post Sign Supports		
RD610	- Asphalt Concrete Pavement (ACP) Details	TM671	- 3 Second Gust Wind Speed Map		
		TM676	- Sign Attachments		
RD700	- Curbs	TM678	- Secondary Sign Mounting Details		
RD705	- Islands	TM681	- Perforated Steel Square Tube (PSST) Sign Support Installation		
RD706	- Traffic Separators And Transitions				
RD707	- Island Nose Treatments	TM687	- Perforated Steel Square Tube (PSST) Anchor Foundation		
RD710	- Accessible Route Islands				
RD715	- Approaches And Non-Sidewalk Driveways	TM688	- Perforated Steel Square Tube (PSST) Slip Base Foundation		
RD720	- Sidewalks				
RD755	- Sidewalk Ramp Details				
RD756	- Sidewalk Ramp Placement Options Small Radii				
RD757	- Sidewalk Ramp Placement Options Large Radii				
RD759	- Truncated Dome Detectable Warning Surface Details & Locations				

BR233 - Thrie-Beam Rail And Transition
BR273 - Thrie Beam Rail Retrofit For Curb And Parapet Rail Connection Details

NOT REVISED AS CONSTRUCTED

2/17/2017 C14880
Date Contract No.

No.	DATE	REVISIONS	BY
1	03-07-16	Added RD324, RD339, RD400, RD440, RD706 & BR233	CE
US199: APPLEGATE RIVER - SLATE CREEK REDWOOD HIGHWAY JOSEPHINE COUNTY			
FEDERAL HIGHWAY ADMINISTRATION		PROJECT NUMBER	SHEET NO.
OREGON DIVISION		NHPP-S025(053)	1A

Standard Drawings located on the web at:
http://www.oregon.gov/ODOT/HWY/ENGSERVICES/pages/standard_drawings_home.aspx

NOT REVISED AS CONSTRUCTED

2/17/2017


C14880

Date


Contract No.

Sec. 2, T. 37S, R. 7W, W.M.

49V-030

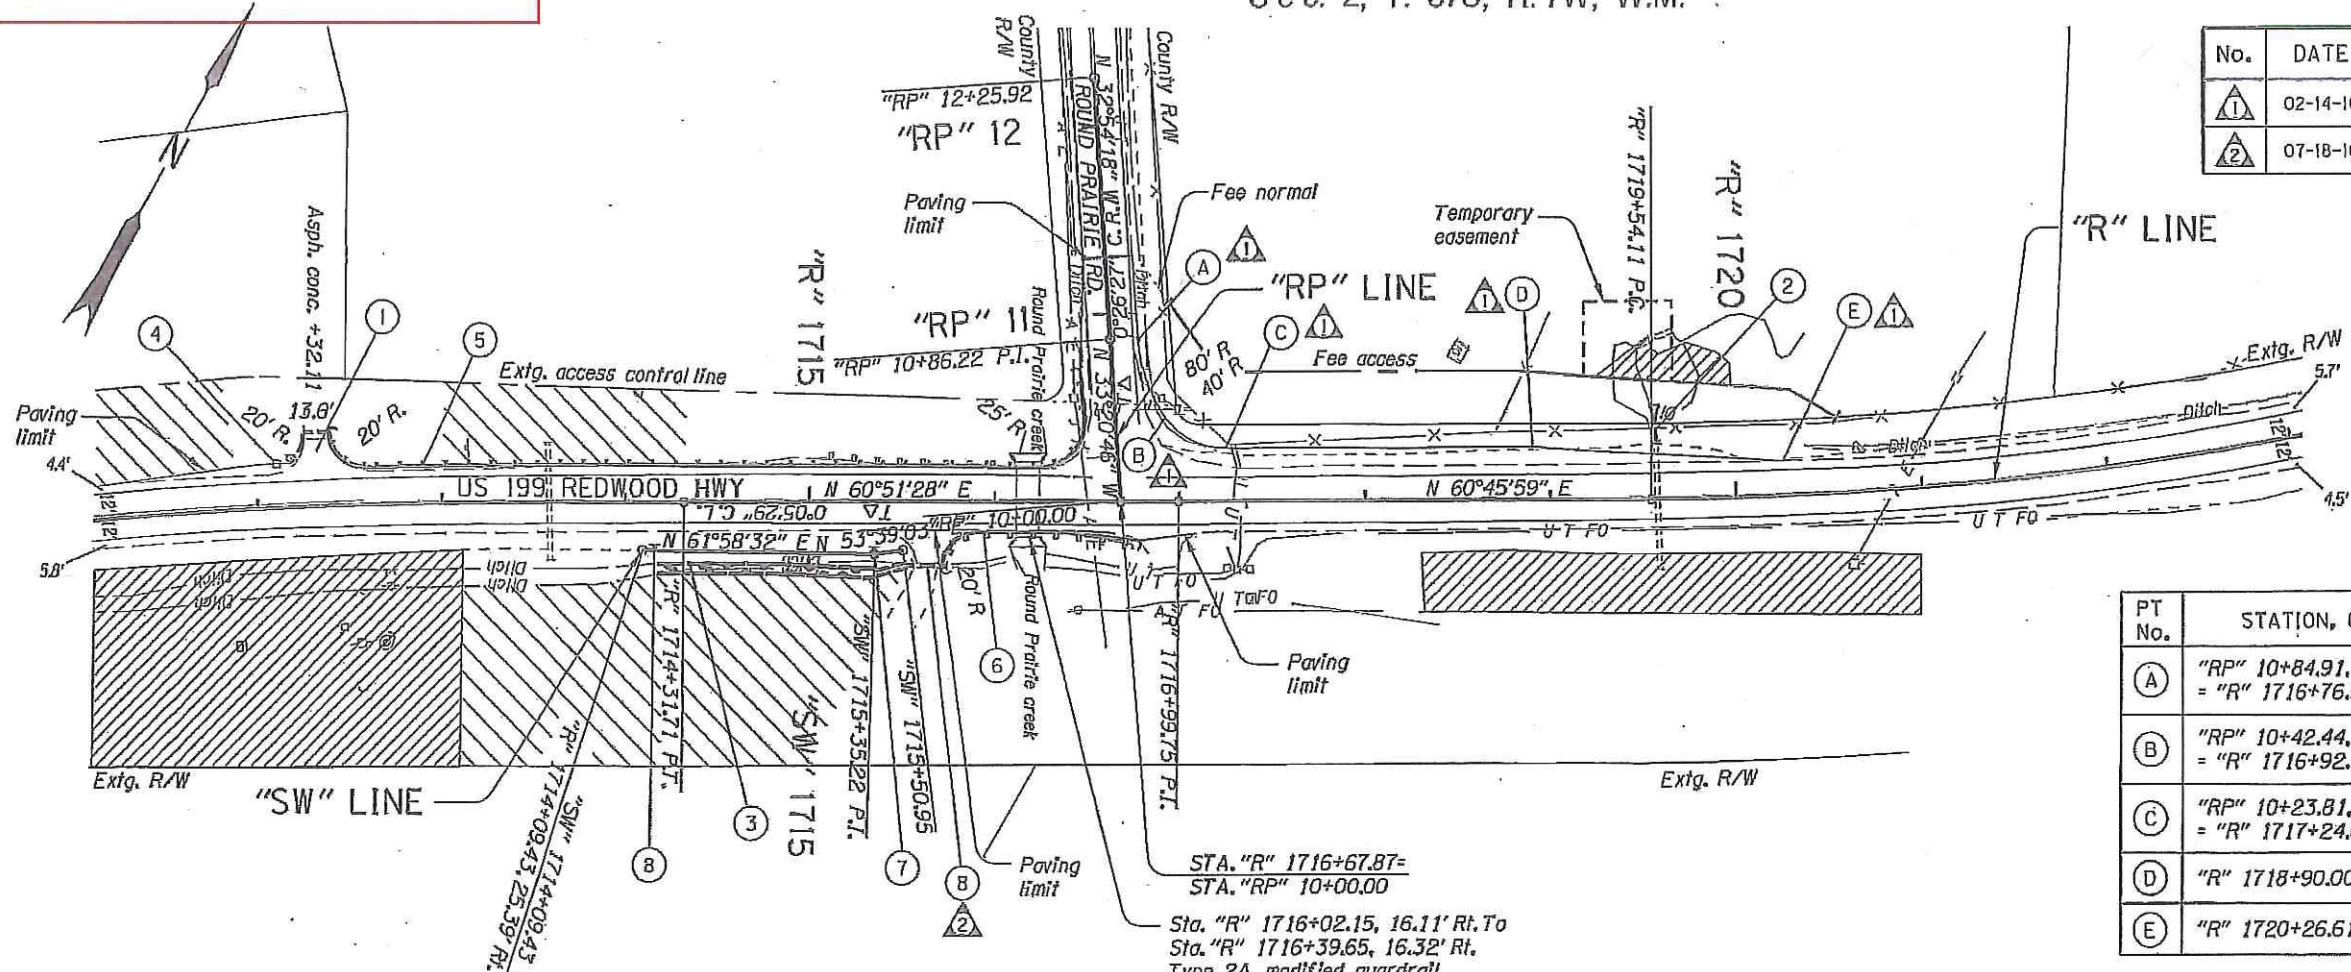



No.	DATE	REVISIONS	BY
1	02-14-16	Revised Table, Exc./Emb. C.Y. & Bubble call outs. Add RP profile	CRZ
2	07-18-16	Replace extg. culv.	CRZ

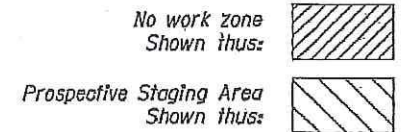

CONTROL POINT TABLE AT NEW EDGE OF PAVEMENT

PT No.	STATION, OFFSET	FINISH GRADE	DESCRIPTION
A	"RP" 10+84.91, 15.39' Rt. = "R" 1716+76.99, 85.81' Lt.	981.83	Match extg. edge of pvmt.
B	"RP" 10+42.44, 27.67' Rt. = "R" 1716+92.35, 44.36' Lt.	981.71	P.C.C.
C	"RP" 10+23.81, 59.05' Rt. = "R" 1717+24.66, 28.03' Lt.	981.67	P.T.
D	"R" 1718+90.00, 28.00' Lt.	982.82	Taper point
E	"R" 1720+26.61, 18.39' Lt.	984.27	Match extg. edge of pvmt.

Sta. "R" 1716+67.87=
Sta. "RP" 10+00.00
Sta. "R" 1716+02.15, 16.11' Rt. To
Sta. "R" 1716+39.65, 16.32' Rt.
Type 2A modified guardrail

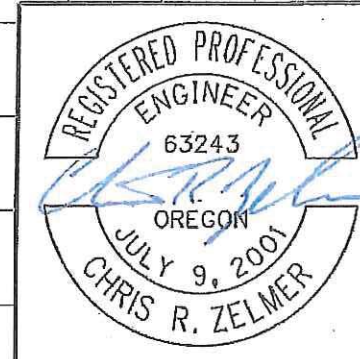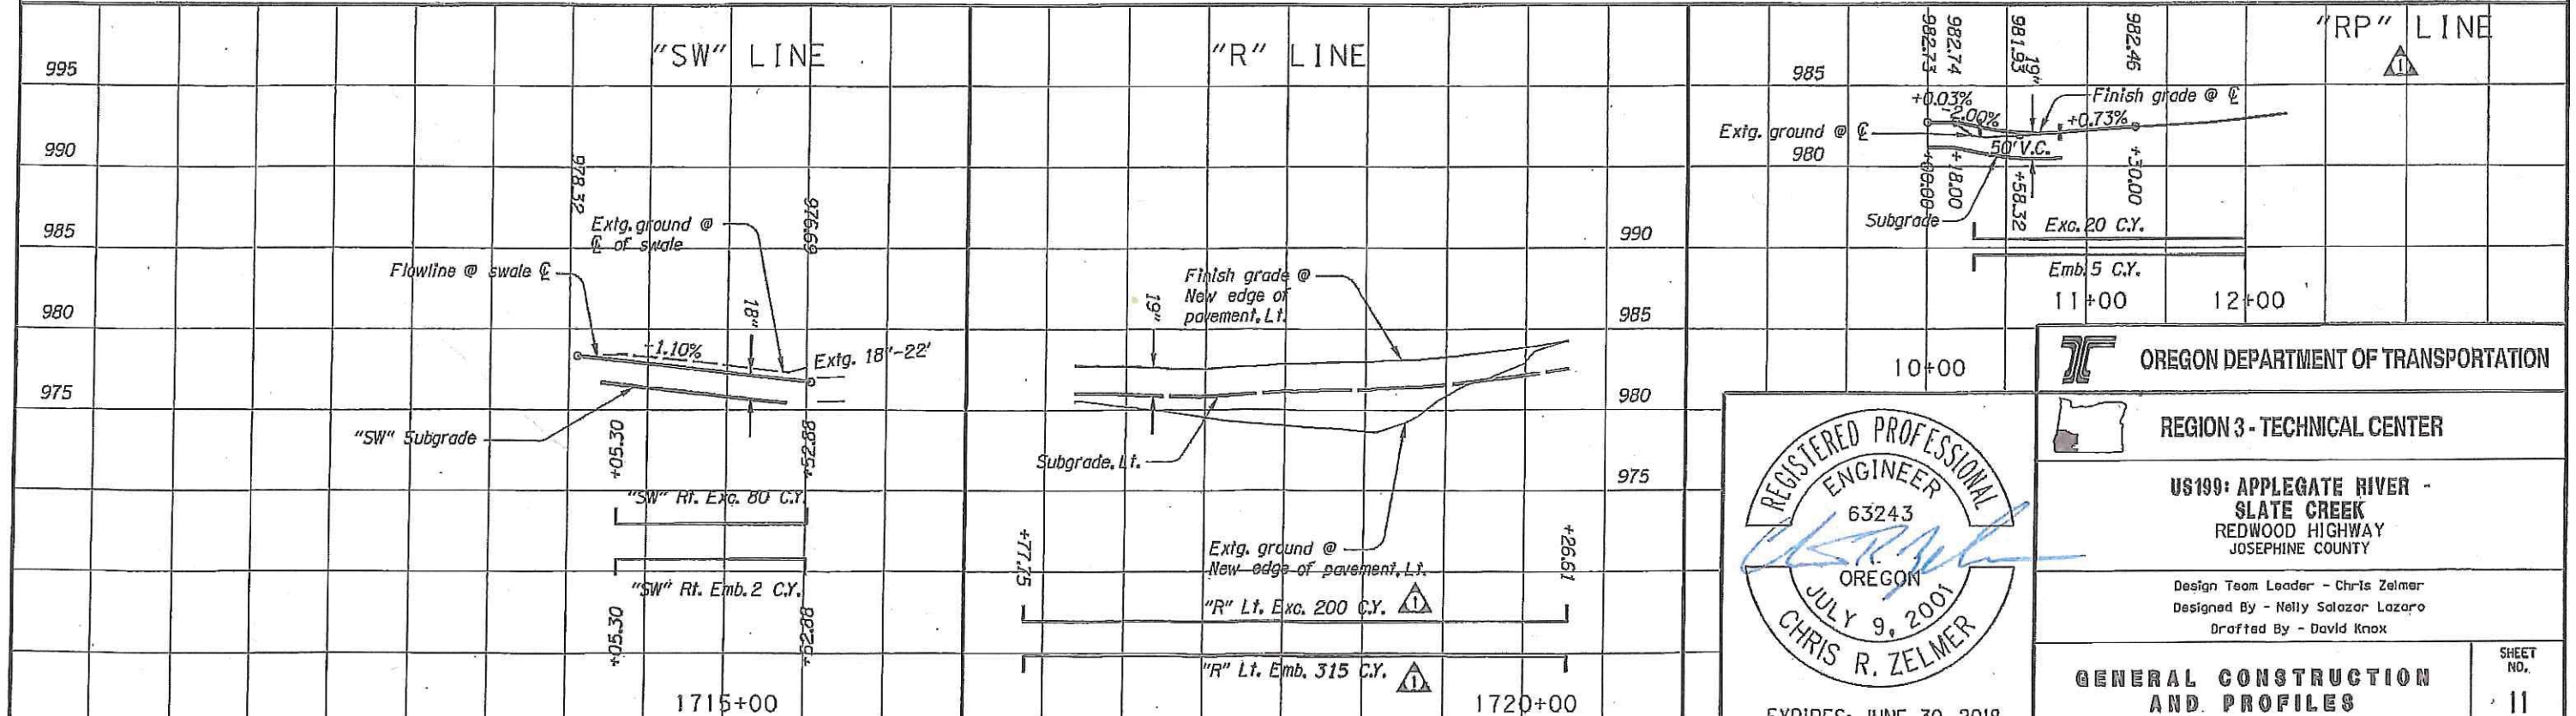

OREGON DEPARTMENT OF TRANSPORTATION

REGION 3 - TECHNICAL CENTER

US199: APPLEGATE RIVER - SLATE CREEK
REDWOOD HIGHWAY
JOSEPHINE COUNTY

Design Team Leader - Chris Zelmer
Designed By - Nelly Salazar Lazaro
Drafted By - David Knox

- ① Const. appr.
- ② Sta. "R" 1719+55.93, 44.83' Lt. To
Sta. "R" 1719+56.45, 31.13' Lt.
Extend 18" culvert pipe - 14' Lt.
5' depth
I.E. (18" In) = 978.06
I.E. (18" Out) = 977.26
S=0.0587'/ft.
Const. sloped end section
Connect to extg. culvert
Const. paved end slope, Lt.
- ③ Const. water quality swale
(For details, see sh. G, J)
- ④ Sta. "R" 1711+17.85 To
Sta. "R" 1712+17.39, Lt.
Inst. single mailbox support
Const. conc. collar
Const. mailbox service turnout
(For details, see sh. 2B)
- ⑤ Sta. "R" 1712+40.19, 37.88' Lt. To
Sta. "R" 1716+45.77, 68.71' Lt.
Remove extg. guardrail - 163.2'
Const. 31" guardrail - 400' (Type 2A)
Const. 31" guardrail - 37.5' (Type 2A modified)
Const. anchors - 4 (Type 1 modified)
Inst. end piece (Type C)
Const. 31" guardrail terminal, non-flared - 25'
Test level - 2
W=1', E=0'
(See drg. no. RD470)
(For details, see sh. 2B & 2B-3)

- ⑥ Sta. "R" 1715+71.21, 35.98' Rt. To
Sta. "R" 1716+76.91, 20.53' Rt.
Remove extg. guardrail - 115'
Const. 31" guardrail - 42.4' (Type 2A)
Const. 31" guardrail - 37.5' (Type 2A modified)
Const. 31" guardrail terminal, straight flare - 37.5'
Test level - 3
W=4', E=0.5'
Const. anchors - 2 (Type 1 modified)
Inst. end piece (Type C)
(See drg. no. RD420)
(For details, see sh. 2B)


- ⑦ Inst. Type "S2" marker - 2
(For details, see sh. G, J-2)

- ⚠ ⑧ Sta. "R" 1715+52.86, 33.87' Rt. To
Sta. "R" 1715+74.59, 34.28' Rt.
Remove culv. pipe - 22'
Inst. 18" culv. pipe - 22'
5' depth
F.L. (18" In) = 976.90 (E) (Match extg.)
F.L. (18" Out) = 976.81 (W) (Match extg.)
S= 0.0041'/ft.
Const. sloped end
Const. paved end slope

NOT REVISED AS CONSTRUCTED


2/17/2017 C14880
Date Contract No.

 OREGON DEPARTMENT OF TRANSPORTATION

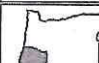 REGION 3 - TECHNICAL CENTER

US190: APLEGATE RIVER -
SLATE CREEK
REDWOOD HIGHWAY
JOSEPHINE COUNTY

Design Team Leader - Chris Zelmer
Designed By - Kelly Salazar Lazaro
Drafted By - David Knox




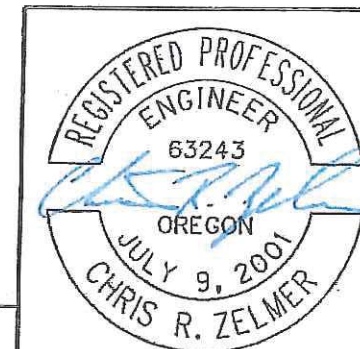


No.	DATE	REVISIONS	BY
⚠	17-18-16	Replace extg. culv.	CPZ

GENERAL CONSTRUCTION
NOTES

SHEET
NO.
11A

WATER QUALITY SWALE DETAILS

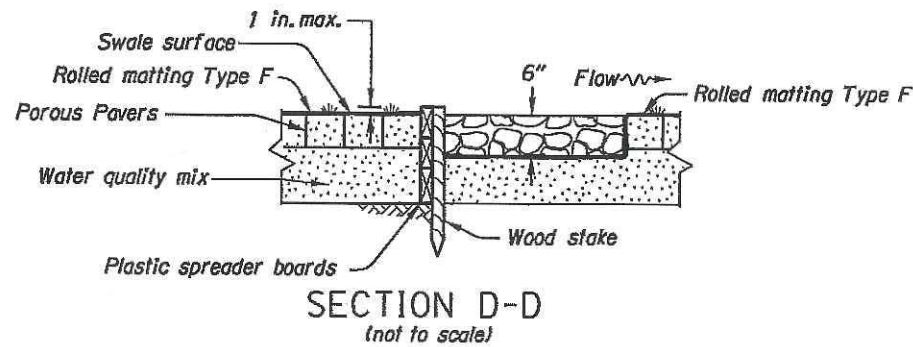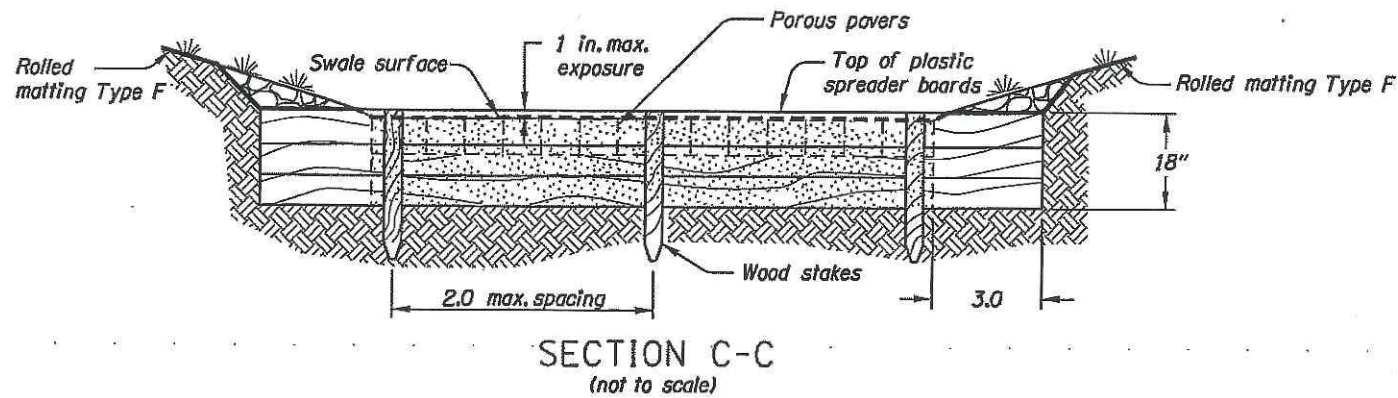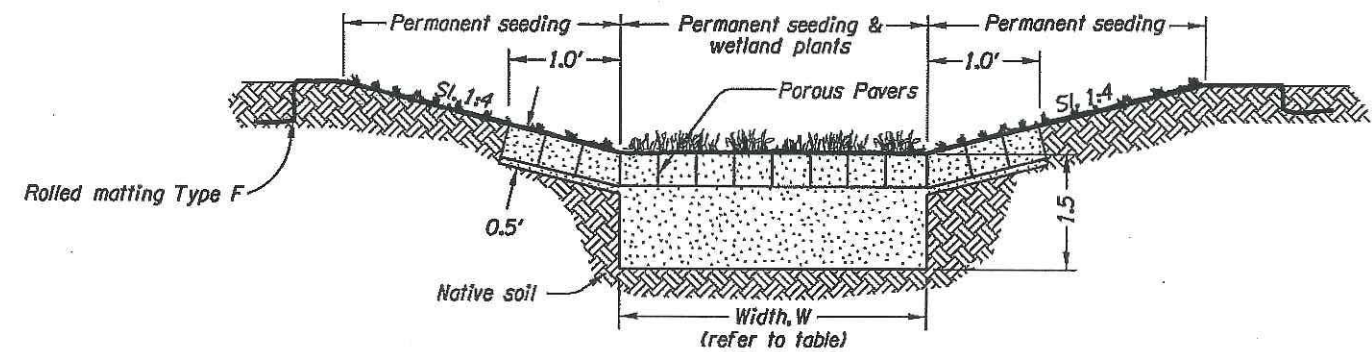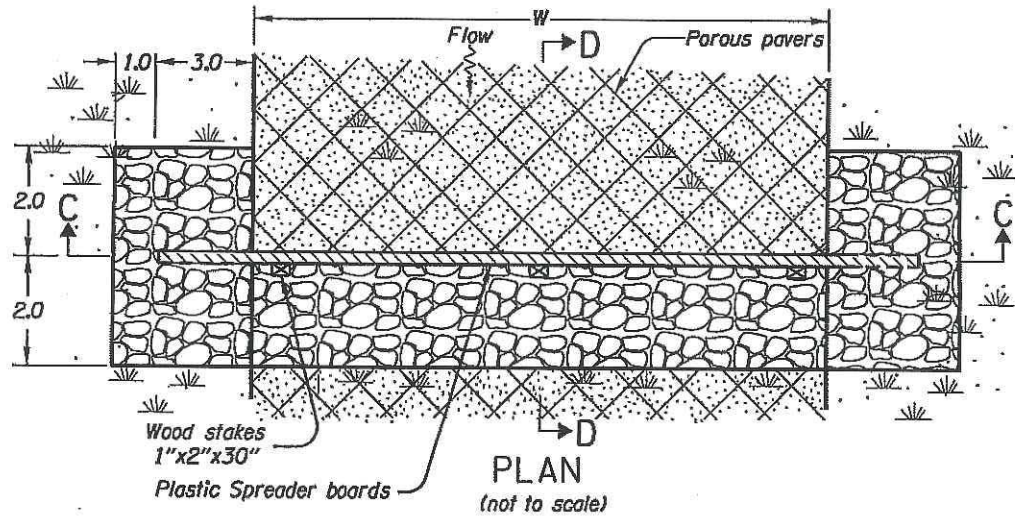

PLASTIC BOARD FLOW SPREADER DETAIL

- NOTES:
1. Construct spreader boards level.
 2. Extend spreader boards a minimum of 3 feet into side slopes.
 3. Reinforce side slopes at flow spreader locally with 1 1/2"-3/4" granular drain backfill material.
 4. Fasten wood stakes to spreader boards with 2 1/2" galvanized wood screws every 2" (minimum).
 5. Place plastic board flow spreader at beginning and end of swale and every 50 feet throughout length of biofiltration swale.
 6. Install matting according to RD1055. Omit check slots.
 7. Install Type S2 markers at beginning and end of biofiltration swale. See sheet GJ-2 for details.

1 1/2"-3/4" Granular Drain Backfill Material

Water quality mix

Note: All dimensions are in feet unless otherwise noted.

BIOFILTRATION SWALE DATA

Plan sheet & note#	Sta. to Sta.	W (ft.)	Longitudinal Slope (ft./ft.)	DFI #
Sheet 11, note 3	Sta. "SW" 1714+17.5, 9.5' Rt. To Sta. "SW" 1715+34.5, 10.6' Rt.	5.0	0.011	D00850

WETLAND PLANTS

SCIENTIFIC NAME	COMMON NAME	SPACING	QUANTITY (Each)
Carex Densa	Dense Sedge	1 per 2 sq.ft.	293
Eleocharis Palustris	Common Spikerush	1 per 2 sq.ft.	293
Juncus Tenuis	Poverty Rush	1 per 2 sq.ft.	293
Minulus Guttatus	Seep Monkey Flower	1 per 2 sq.ft.	293

NOT REVISED AS CONSTRUCTED


2/17/2017 C14880
Date Contract No.

OREGON DEPARTMENT OF TRANSPORTATION

REGION 3 - TECHNICAL CENTER

US199: APPEGATE RIVER - SLATE CREEK
REDWOOD HIGHWAY
JOSEPHINE COUNTY

Designed By - DeLanie Cutsforth
Reviewed By - Wade Holaday
Drafted By - David Knox


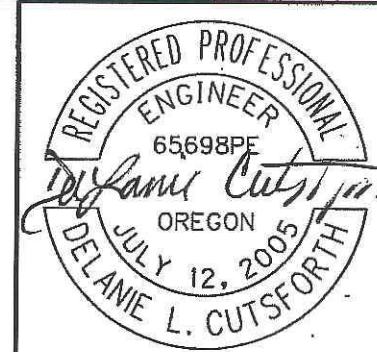


EXPIRES: 12-31-2017

STORMWATER DETAILS


SHEET NO. GJ

STORMWATER DRAINAGE FACILITY IDENTIFICATION

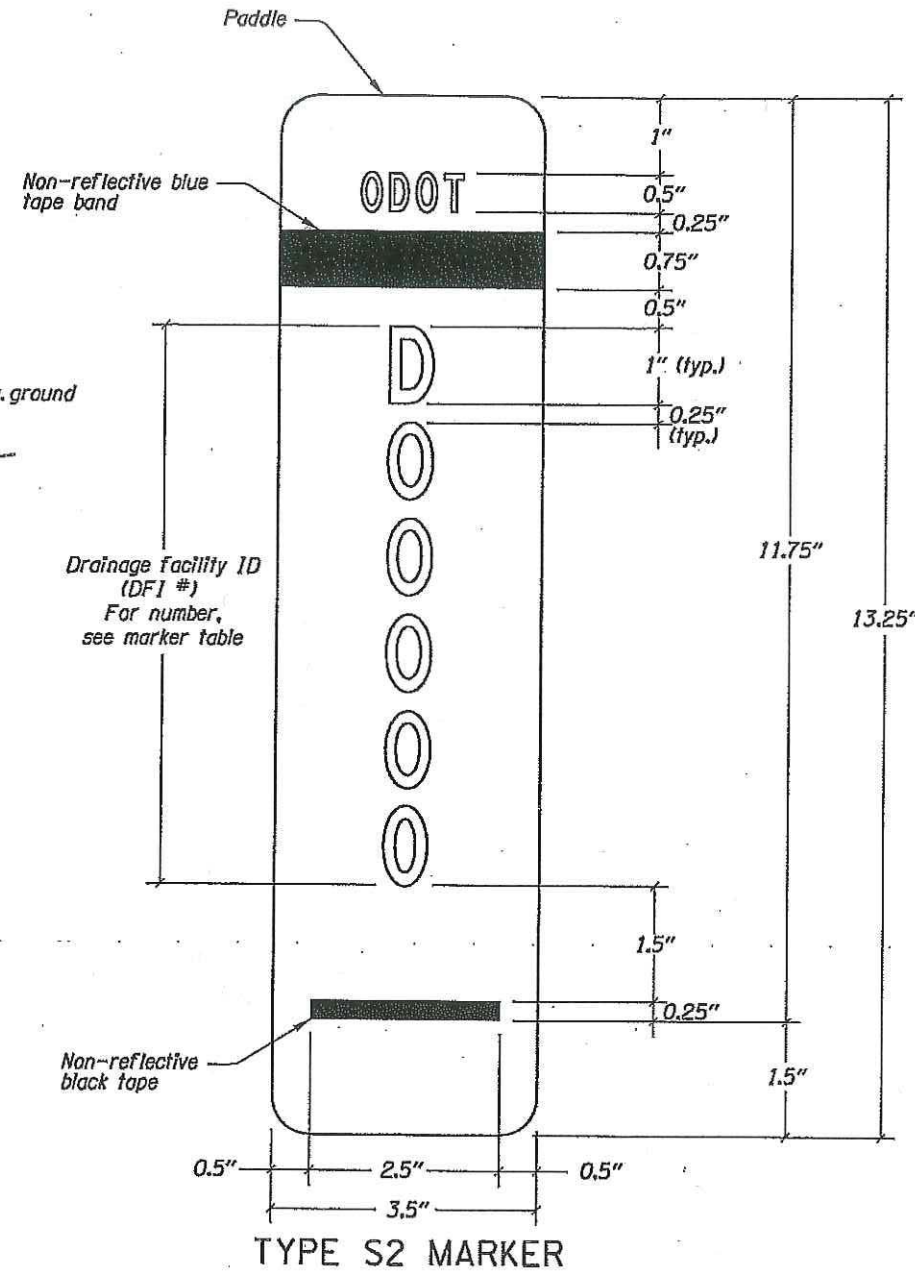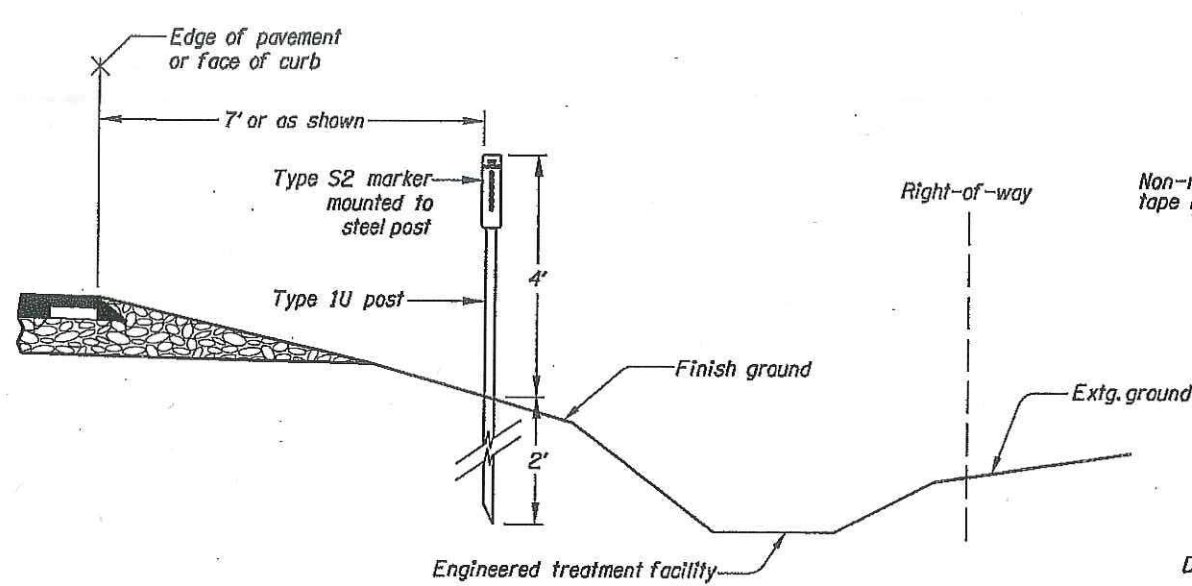


MARKER TABLE

FACILITY LOCATION	DFI #	TYPE S2 MARKER	
		BEGIN	END
Sta. "R" 1714+16	D00850	✓	
Sta. "R" 1715+35	D00850		✓

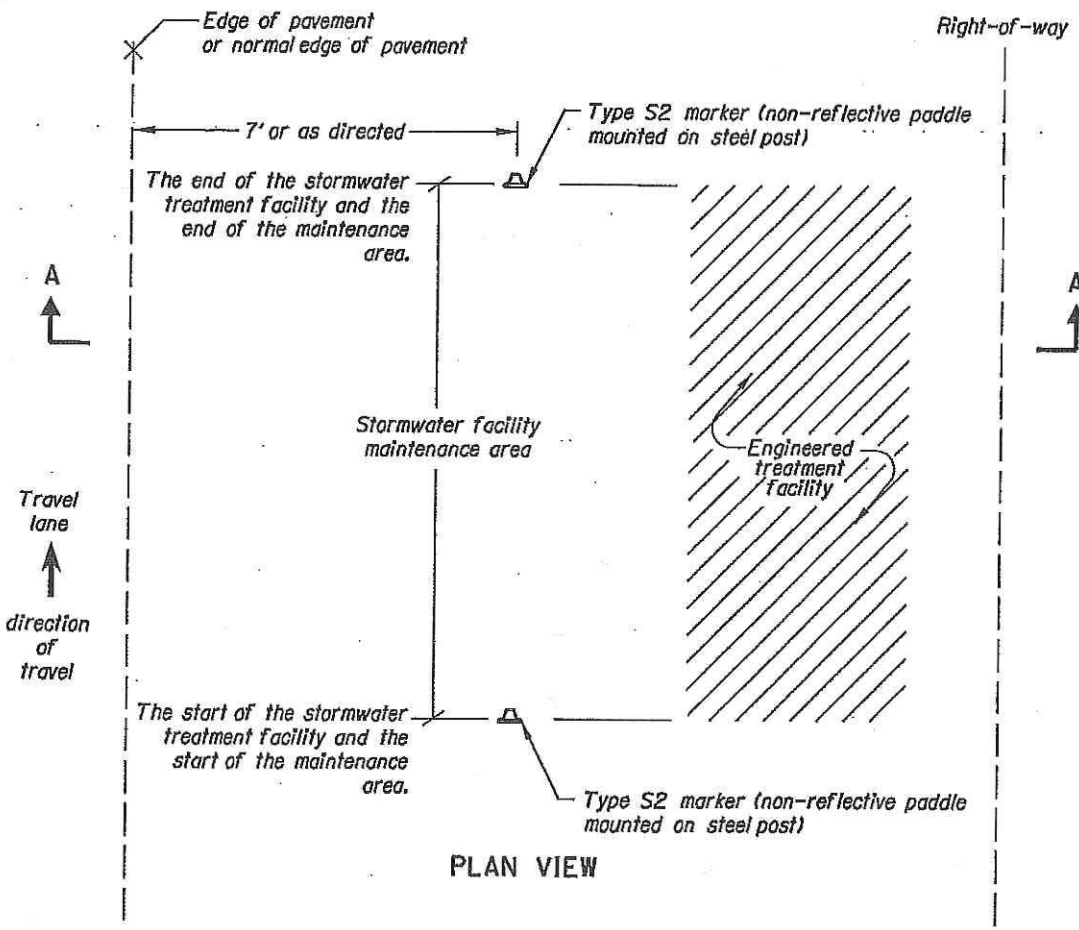

- Notes:
- Paddle:**
 - Aluminum sheet, nominal thickness 0.050"
 - White non-reflective background
 - Mount paddle to one (1) type 1U steel post using 3/16" diameter aluminum blind rivets and washers. See standard drawing TM570 detail labeled "Steel Posts" for mounting a traffic target. Install paddle onto Type 1U steel post using same hole pattern.
 - Text and numbers are type C font in non-reflectORIZED black
 - Band is non-reflective blue tape
 - Do not mount paddle to other highway signing posts
 - Install paddle parallel to travel lane
 - Prepare paddle for each "DFI" noted in the marker table
 - Steel Posts:**
 - See drg. no. TM571 for type 1U steel post dimensions
 - Place 7 feet from edge of pavement or as directed.
 - See marker table for installation locations.

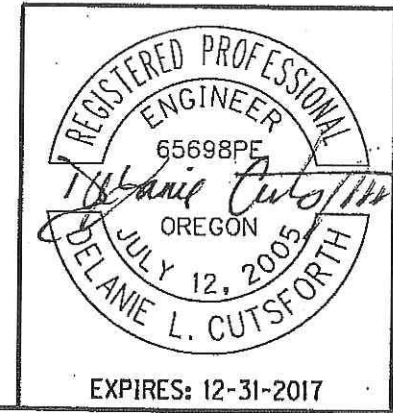

NOT REVISED AS CONSTRUCTED

2/17/2017 C14880
Date Contract No.

OREGON DEPARTMENT OF TRANSPORTATION

REGION 3 - TECHNICAL CENTER

US199: APPLGATE RIVER - SLATE CREEK
REDWOOD HIGHWAY
JOSEPHINE COUNTY

Designed By - DeLanie Cutsforth
Reviewed By - Wade Holaday
Drafted By - David Knox

STORMWATER DETAILS SHEET NO. GJ-2