

# OPERATION & MAINTENANCE MANUAL

## Water Quality Biofiltration Swale

Manual prepared: February 2019

DFI No. D00851



Figure 1: DFI No. D00851, looking east

## Identification

Drainage Facility ID (DFI): D00851  
Facility Type: Water Quality Biofiltration Swale  
Construction Drawings: (V-File Numbers) 47V-119  
Location: District: 2B  
Highway No.: 171  
Mile Post: 7.28 - 7.32 (Right Side)

### 1. Manual Purpose

The purpose of this manual is to outline inspection needs and summarize maintenance actions.

### 2. Facility Location

The location map below details the facility location. The highway, mile posts, side streets, access location, and stormwater flow directions are noted on the map.

Facility location type: Roadway shoulder

Flow direction: From road and sidewalk slopes and then to the West

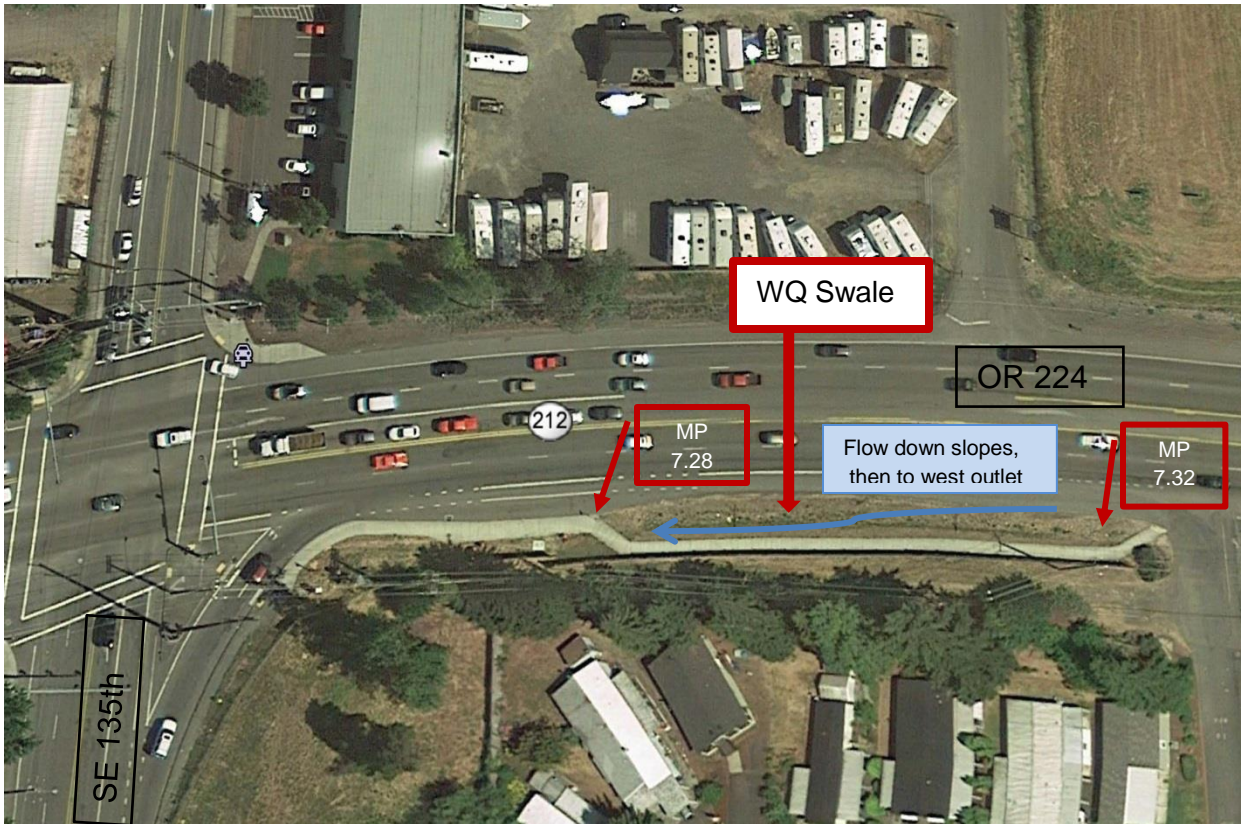



Figure 2: Facility location map

### 3. Facility Summary

The length and width of a swale are based on the bottom dimensions.

The bottom length and bottom width of the swale is:


Bottom Length (feet)	Bottom Width (feet)
234	2

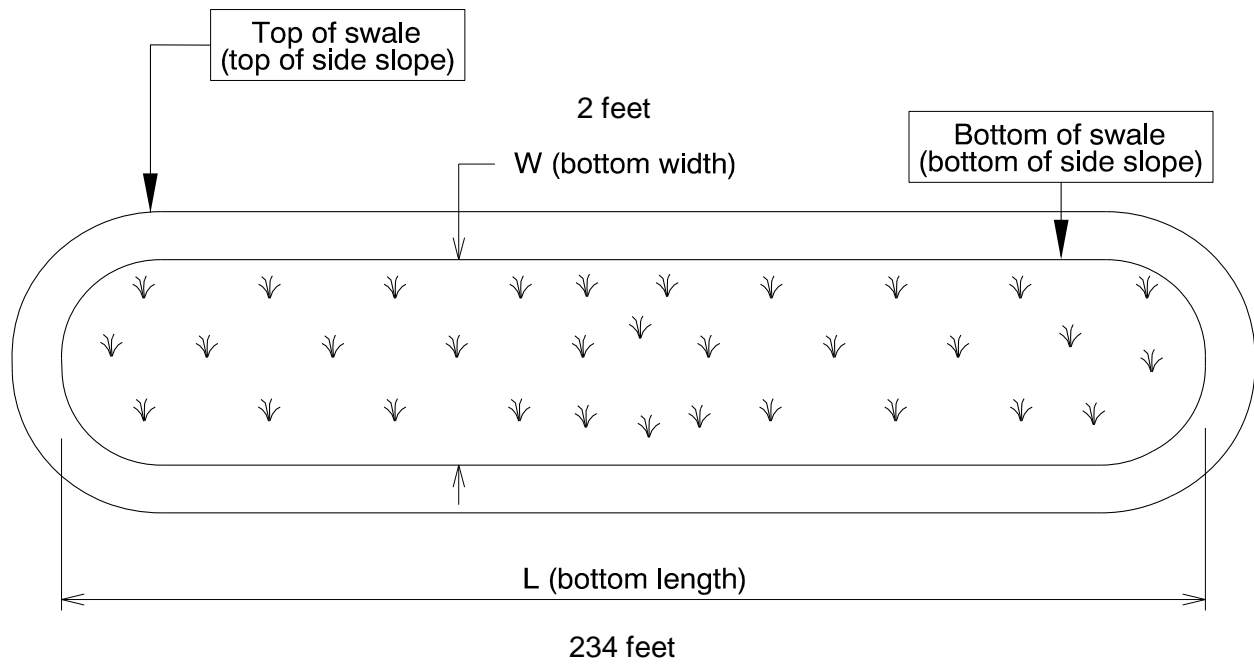

The depth of the swale is the vertical distance measured from the bottom of the swale to the top. The slope of the swale sides is presented by a vertical distance (rise) followed by the horizontal distance (run).

Depth and side slopes:

Depth (feet)	Rise (feet)	Run (feet)
Variable (typ. 1 ft.)	Variable	Variable

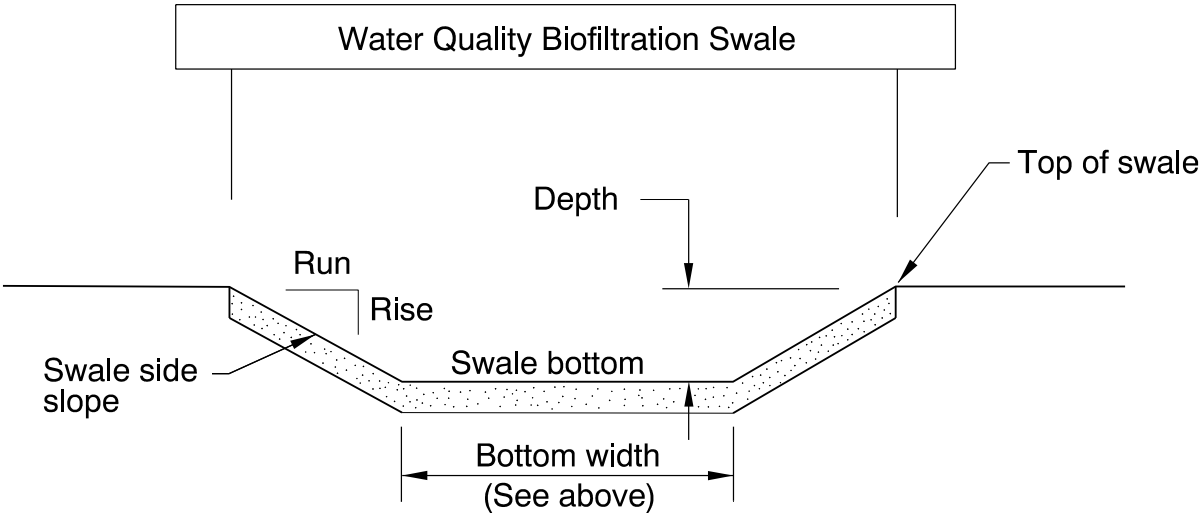

**Site Specific Information:**

There is a sidewalk in back of the swale. The water flows into the swale down the road (fore) and sidewalk (back) slopes, and then travels from east to west to a D inlet to a pipe. The swale is shallow (about 1 foot) and the plans were designed with variable slopes to match existing ditch grades.

## 4. Facility Access

Maintenance access to the facility:

<input type="checkbox"/> Roadside pad	<input checked="" type="checkbox"/> Roadside shoulder
<input type="checkbox"/> Access road with Gate	<input type="checkbox"/> Access road without Gate

Note: The sidewalk behind the swale also provides access for debris pick up or weeding but not for vector truck.



Figure 3: Maintenance Access for Eastbound traffic]

## 5. Operational Components / Maintenance Items

### Classification

This facility is classified as an:

<input checked="" type="checkbox"/> <b>On-line Swale</b>	<input type="checkbox"/> <b>Off-line Swale</b>
A swale that does not include a high flow bypass component; flow drains into and through the facility	A swale that treats low/small flows and diverts high flows using a bypass component

## Bypass Component

This facility includes a high flow bypass component:

<input checked="" type="checkbox"/> No	<input type="checkbox"/> Yes
There is no bypass component. High flows drain into and through the facility	There is a bypass component. Only low/small flows drain into the swale. High flows are diverted around the swale using a bypass component

## Operational Components

A swale has many components that assist with treatment, conveyance, and reducing flow velocity to minimize erosion. The components in use can vary depending if the facility was designed to operate on-line or off-line. The facility components table (**Table 1**) has been provided to highlight the applicable components for this facility. The component is in use when the box contains an “x” (e.g. ).

The Standard Operation Manual for Water Quality Biofiltration Swales (implemented March 2017) outlines facility operation, typical footprint configuration, and component definitions and details. A link to the manual is attached to the feature marker in TransGIS. <https://gis.odot.state.or.us/TransGIS/>

## Operational Plan

The applicable standard operational plan for this facility is:

<input type="checkbox"/> Operational Plan A	<input checked="" type="checkbox"/> Operational Plan B	<input type="checkbox"/> Operational Plan C
An on-line swale with roadside ditches	An on-line swale with piped inlets and outlets	An off-line swale with a piped high flow bypass
A standard operational plan illustrates the general facility footprint configuration and explains the purpose of each facility component. Operational plans (A, B, C) are provided in the Standard Operation Manual.		

See Appendix A for the site specific operational plan.

## Maintenance Items

Operational components marked in **Table 1** should be inspected and maintained according to Section 7. Each facility component is defined and detailed in the Standard Operation Manual using the associated ID number indicated below.

<b>Table 1: Swale Components</b>		<b>ID #</b>
<b>Manholes/Structures</b>		
Pre-treatment manhole	<input type="checkbox"/>	<b>S1</b>
Weir type flow splitter/flow splitter manhole	<input type="checkbox"/>	<b>S2</b>
Orifice type flow splitter/flow splitter manhole	<input type="checkbox"/>	<b>S3</b>
Standard manhole	<input type="checkbox"/>	<b>S4</b>
<b>Swale Inlet</b>		
Pavement sheet flow	<input checked="" type="checkbox"/>	<b>S5</b>
Inlet Pipe (s)	<input type="checkbox"/>	<b>S6</b>
Open channel inlet	<input type="checkbox"/>	<b>S7</b>
Riprap pad	<input type="checkbox"/>	<b>S8</b>
<b>Ground Cover</b>		
Grass bottom	<input checked="" type="checkbox"/>	<b>S9</b>
Grass side slopes	<input checked="" type="checkbox"/>	<b>S10</b>
Granular drain rock	<input type="checkbox"/>	<b>S11</b>
Plantings	<input type="checkbox"/>	<b>S12</b>
<b>Underground Components</b>		
Geotextile fabric	<input checked="" type="checkbox"/>	<b>S13</b>
Water quality mix	<input checked="" type="checkbox"/>	<b>S14</b>
Perforated pipe	<input type="checkbox"/>	<b>S15</b>
Porous pavers (access grid)	<input type="checkbox"/>	<b>S16</b>
<b>Flow Spreader</b>		
Rock basin (used at inlet)	<input type="checkbox"/>	<b>S17</b>
Anchored board (midpoint of swale or every 50 feet along swale bottom)	<input type="checkbox"/>	<b>S18</b>
Other: describe type	<input type="checkbox"/>	<b>S19</b>
<b>Swale Outlet</b>		
Catch basin with grate	<input checked="" type="checkbox"/>	<b>S20</b>
Outlet Pipe (s)	<input checked="" type="checkbox"/>	<b>S21</b>
Open channel outlet	<input type="checkbox"/>	<b>S22</b>
Auxiliary Outlet: describe type	<input type="checkbox"/>	<b>S23</b>
<b>Outfall Type</b>		
Waterbody (Creek/Lake/Ocean)	<input type="checkbox"/> <b>C</b>	<b>S24</b>
	<input type="checkbox"/> <b>L</b>	
	<input type="checkbox"/> <b>O</b>	
Ditch	<input type="checkbox"/>	<b>S25</b>
Storm drain system	<input checked="" type="checkbox"/>	<b>S26</b>
<b>Outfall Components</b>		
Riprap pad	<input type="checkbox"/>	<b>S27</b>
Riprap bank protection	<input type="checkbox"/>	<b>S28</b>



## 6. Maintenance

### Maintenance Frequency/Maintain Records

- a. Inspect annually. Preferably prior to the rainy season.
- b. Clean and maintain as necessary. Refer to Activity 125 for conditions when maintenance is needed.
- c. Keep a record of inspections, maintenance, and repairs.

### Maintenance Guide/Maintenance Actions

The ODOT Routine Road Maintenance Water Quality and Habitat Guide (the *Blue Book*) outlines the standard maintenance actions for water quality facilities under Activity 125.

There are standard maintenance tables for standard ODOT designs. The maintenance tables describe the maintenance component, the defect or problem, the condition when maintenance is needed, and the recommended maintenance to correct the problem. Use the following tables to maintain ODOT swales:

- Table 1 (General Maintenance): Contains general maintenance and inspection guidelines that are applicable to all ODOT water quality facilities
- Table 3 (Maintenance of Water Quality or Biofiltration Swales): Contains maintenance information for swales

The *Blue Book* can be viewed at the following website:

[http://www.oregon.gov/ODOT/Maintenance/Documents/blue\\_book.pdf](http://www.oregon.gov/ODOT/Maintenance/Documents/blue_book.pdf)

## 7. Limitations

Access grid installed:

<input checked="" type="checkbox"/> No	<input type="checkbox"/> Yes
There are ( <b>Choose applicable weight: no, light, med., heavy</b> ) duty porous pavers installed in this swale	

Swales are designed to allow equipment access along the bottom. If an access grid is **NOT** installed, vehicles entering the swale can create depressions (tire ruts), damage vegetation, and damage structural components (e.g. flow spreaders). These conditions may result in poor treatment and drainage performance.

Equipment wheels should be kept on the tops and side slopes. Mower arms may be run along the swale bottom.

## 8. Waste Material Handling

Material removed from the facility is defined as waste by the Department of Environmental Quality (DEQ). Refer to the roadwaste section of the ODOT Maintenance Yard Environmental Management System (EMS) Policy and Procedures Manual for disposal options:

[http://www.oregon.gov/ODOT/Maintenance/Documents/ems\\_manual.pdf](http://www.oregon.gov/ODOT/Maintenance/Documents/ems_manual.pdf)




Contact any of the following for more detailed information about management of waste materials found on site:

ODOT Clean Water Unit	(503) 986-3008
ODOT Statewide Hazmat Coordinator	(503) 667-7442
ODOT Region 1 Hazmat Coordinator	(503) 731-8290
ODOT Region 2 Hazmat Coordinator	(503) 986-2647
ODOT Region 3 Hazmat Coordinator	(541) 957-3594
ODOT Region 4 Hazmat Coordinator	(541) 388-6186
ODOT Region 5 Hazmat Coordinator	(541) 963-1590
ODEQ Northwest Region Office	(503) 229-5263

## **A Appendix A – Site Specific Operational Plan**

### **Contents:**

**Operational Plan: DFI D00851**

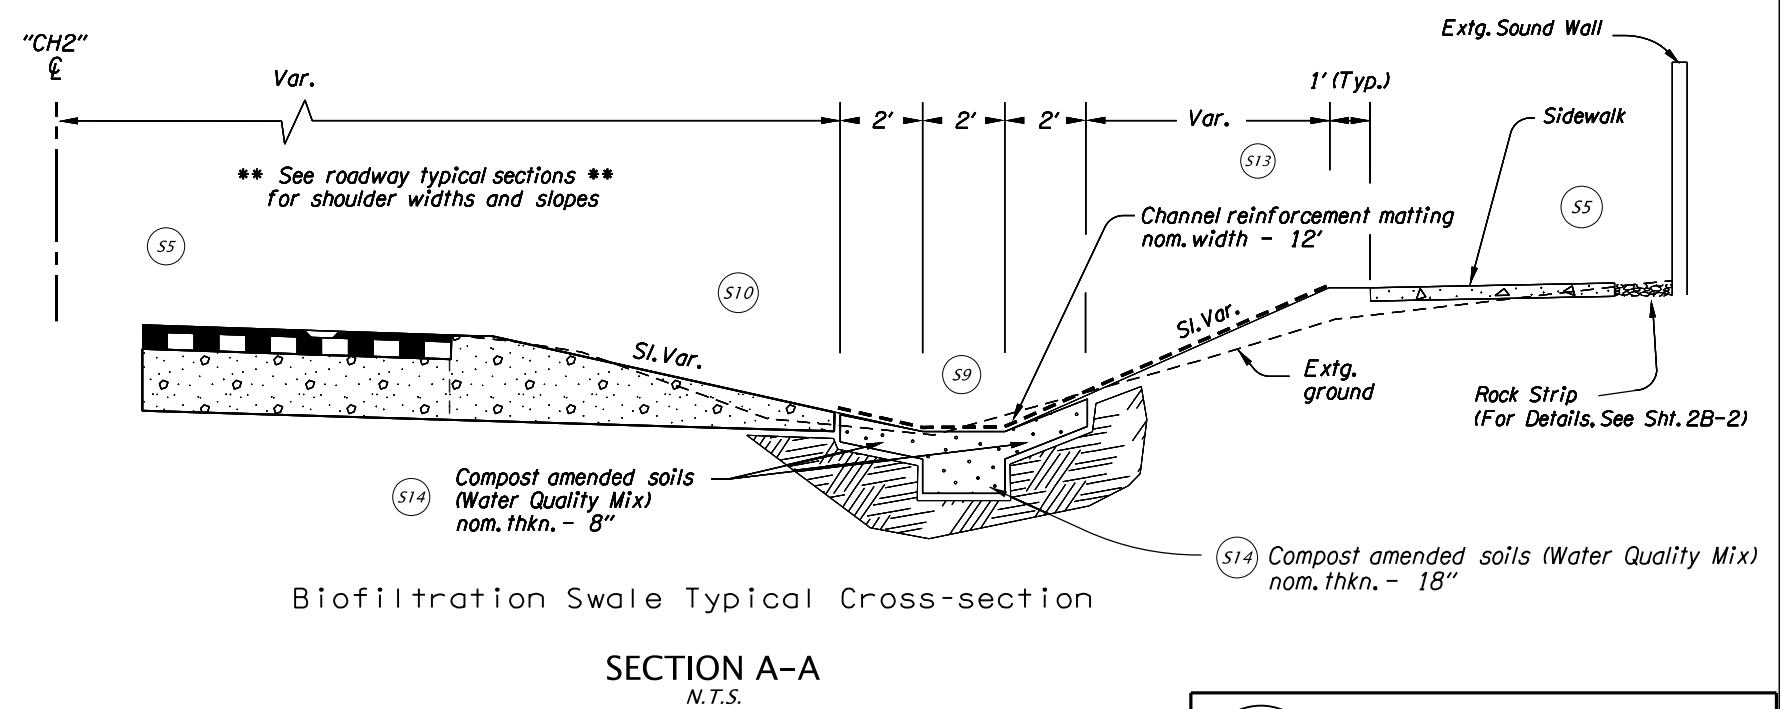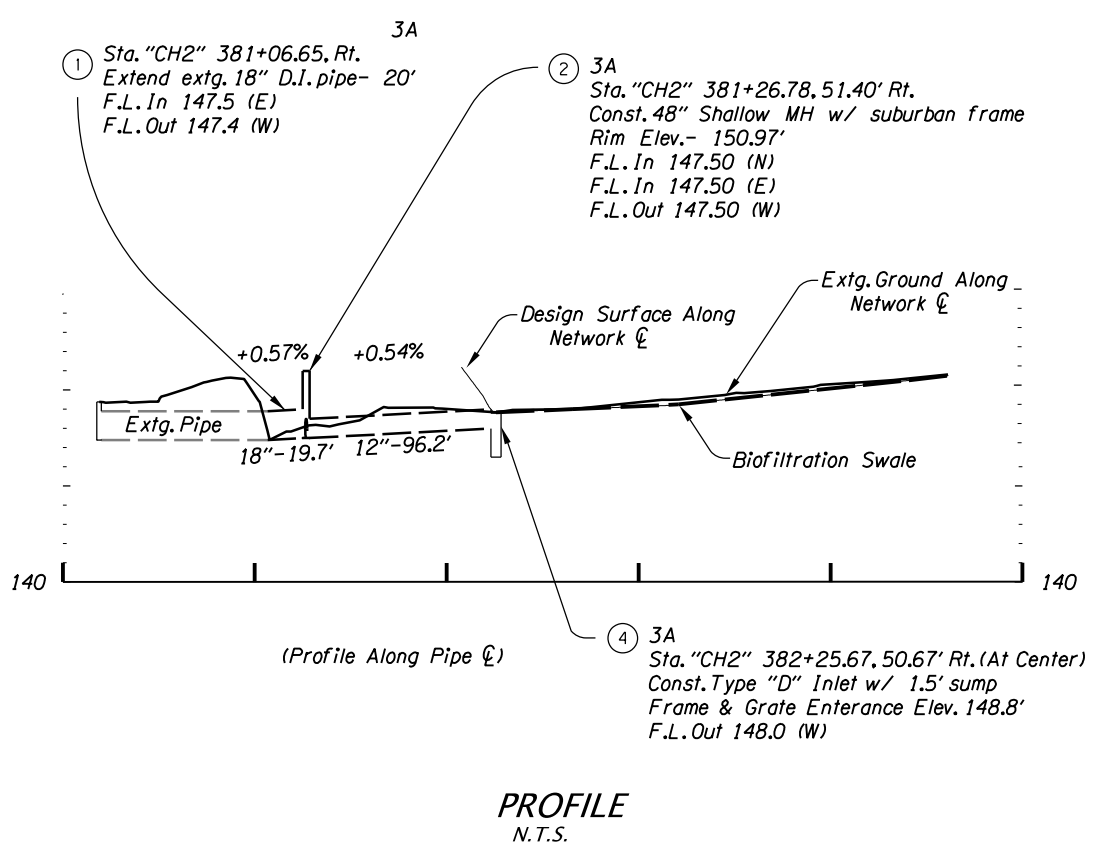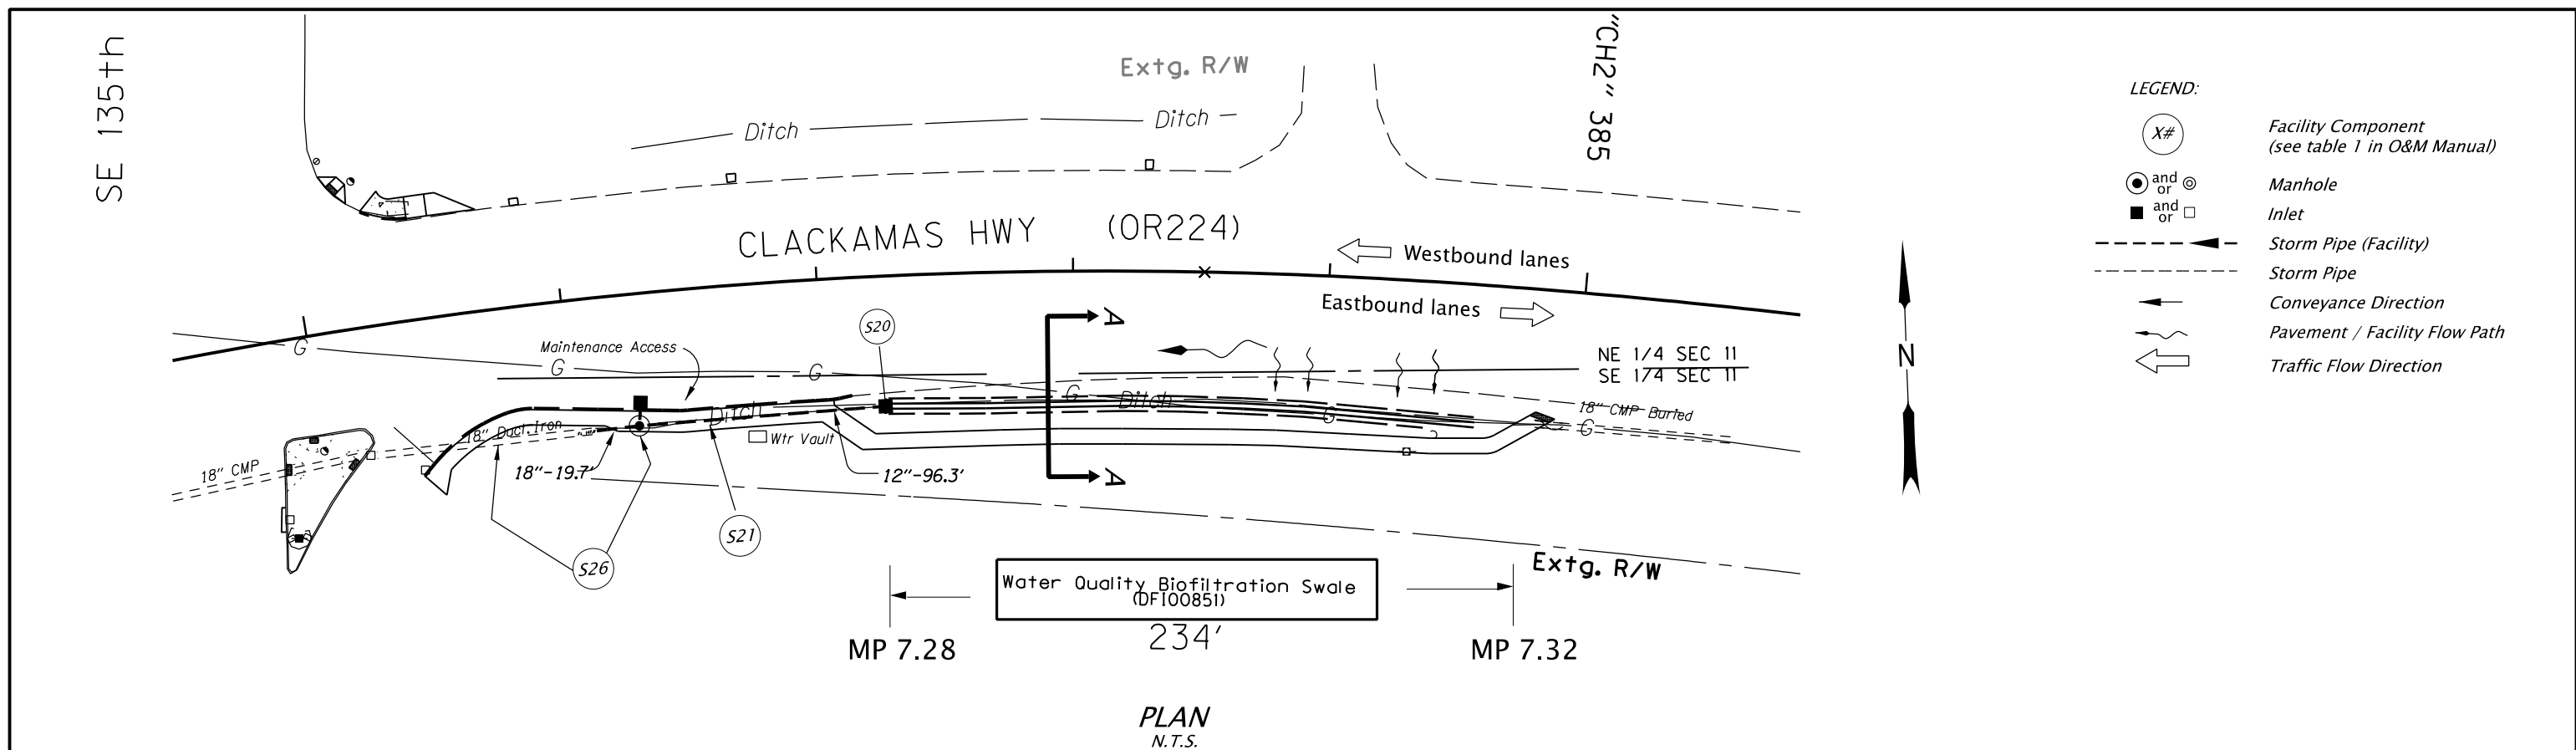

Sht. 01 of 01

Prepared By:  
*Elaine Jinx Kuehn*

Drafted By:  
*Elaine Jinx Kuehn*



**DFI D00851**  
**MAINTENANCE DISTRICT 2C HWY 171**  
**BioSwale**  
Clackamas Hwy MP 7.28 - 7.32  
Clackamas County

## **B Appendix B – Project Contract Plans**

### **Contents:**

**Site Specific Subset of Project Contract Plan 47V-119**

INDEX OF SHEETS	
SHEET NO.	DESCRIPTION
1	Title Sheet, Index of Sheets & Std. Drg. Nos.
1A	Index Of Sheets Cont. & Std. Drg. Nos.

STATE OF OREGON  
DEPARTMENT OF TRANSPORTATION

PLANS FOR PROPOSED PROJECT

GRADING, DRAINAGE, PAVING, SIGNING,  
ILLUMINATION & SIGNALS

**OR224: SE 135th AVE SEC.**

**CLACKAMAS HIGHWAY**

**CLACKAMAS COUNTY**


**OCTOBER 2014**

NOT REVISED AS CONSTRUCTED

30 JUN 2015 CONTRACT 14740


PROJ. MGR. MARJORIE WEST

*Marjorie West 9/24/15*

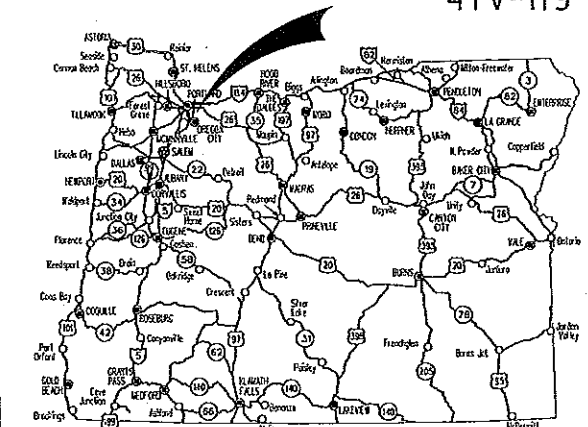

Overall Length Of Project - 0.13 Miles

**ATTENTION:**  
Oregon Law Requires You To Follow Rules Adopted By The Oregon Utility Notification Center. Those Rules Are Set Forth In OAR 952-001-0010 Through OAR 952-001-0090. You May Obtain Copies Of The Rules By Calling The Center. (Note: The Telephone Number For The Oregon Utility Center Is (503) 232-1987.)

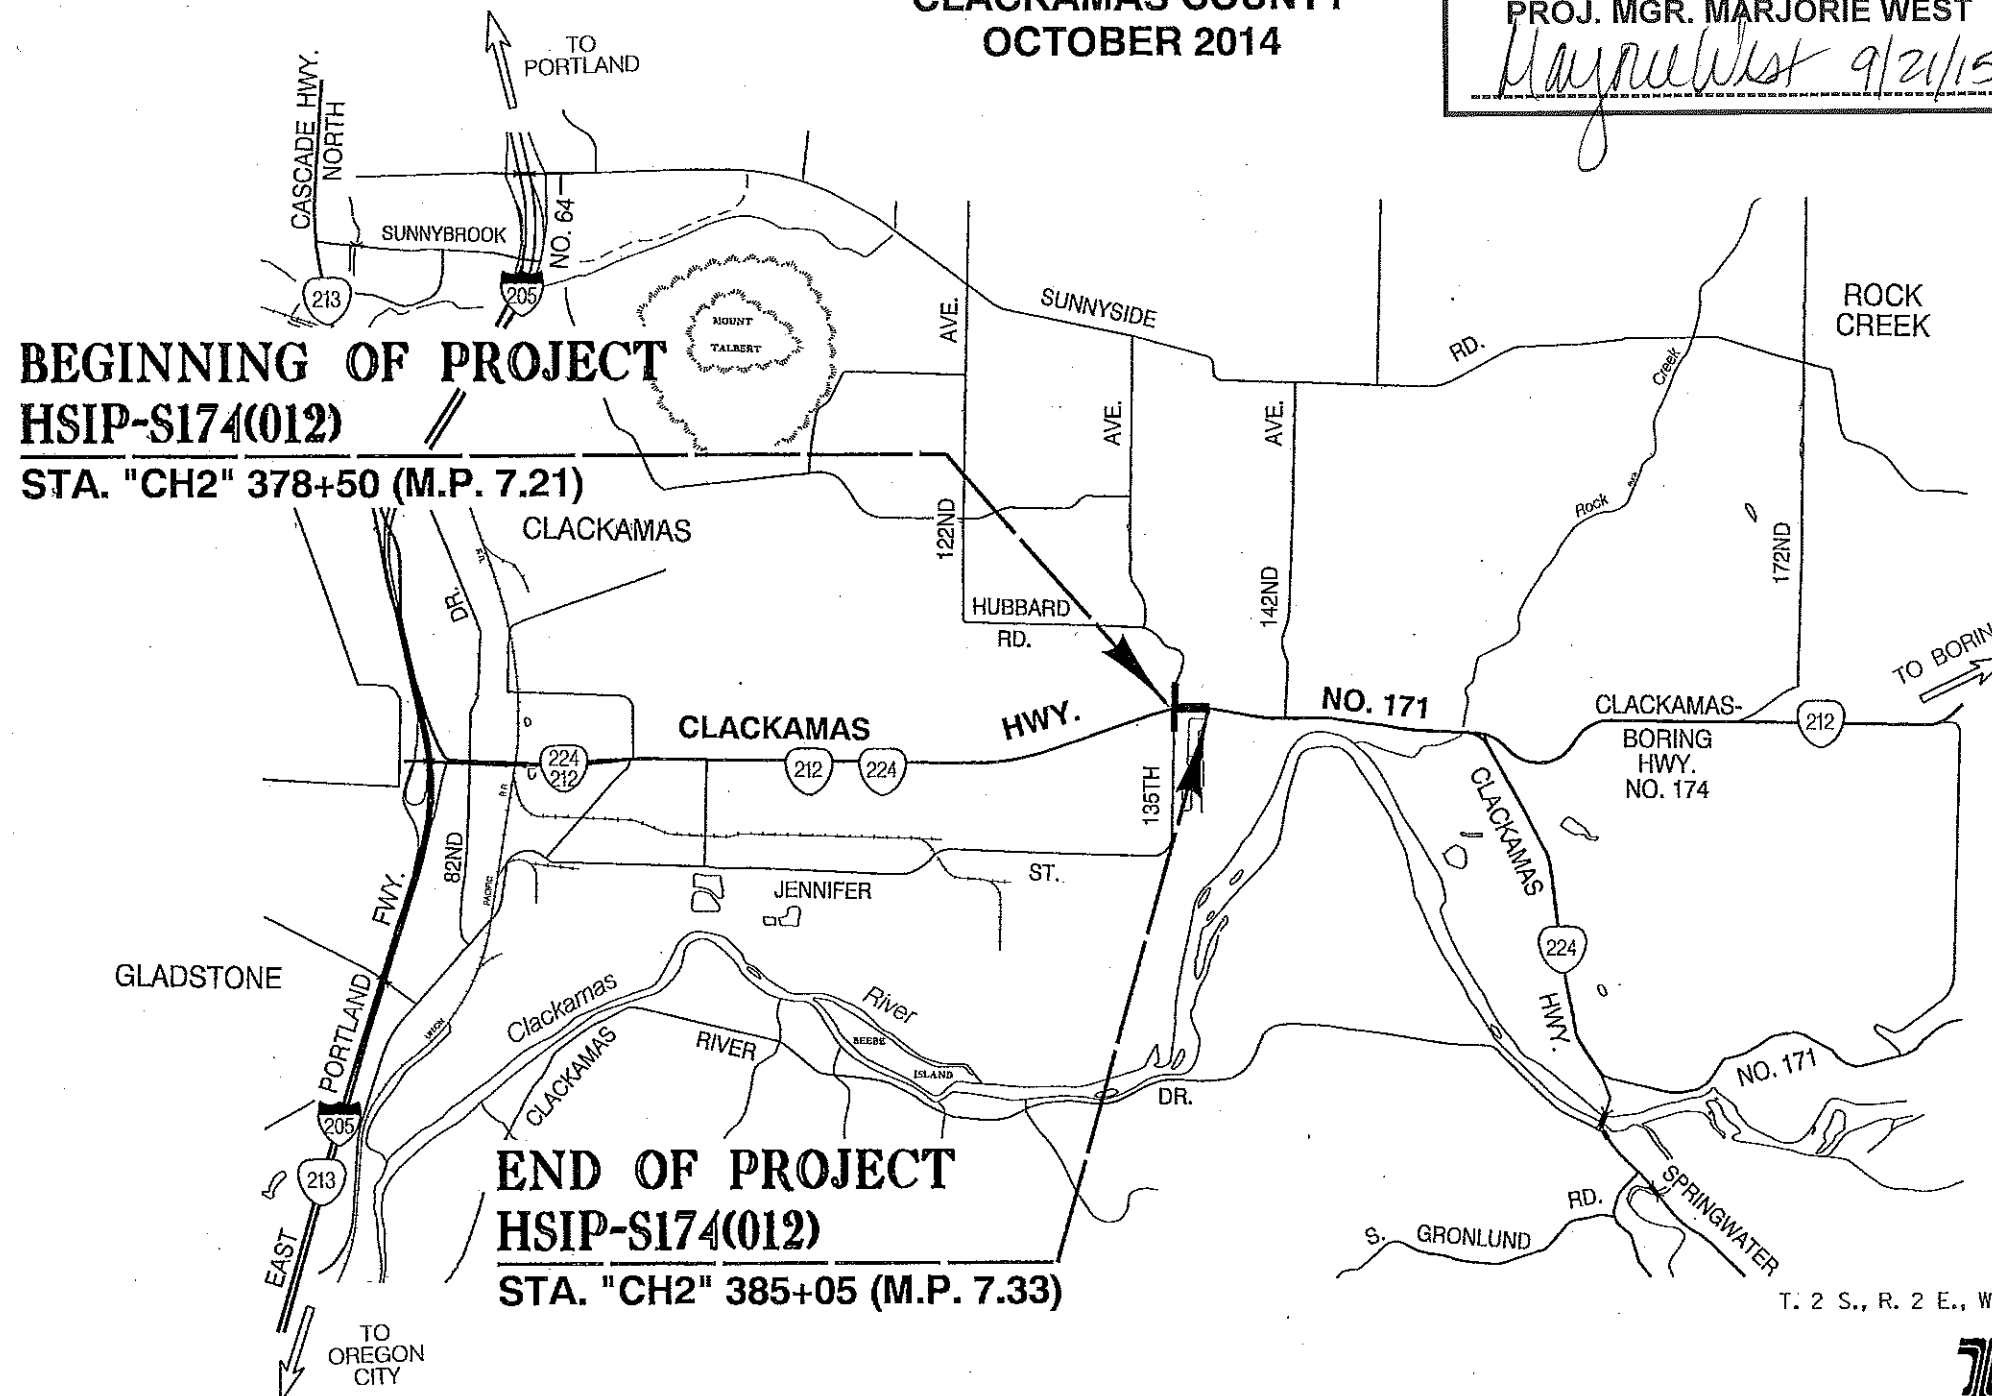

**BEGINNING OF PROJECT**  
**HSIP-S174(012)**  
**STA. "CH2" 378+50 (M.P. 7.21)**

**END OF PROJECT**  
**HSIP-S174(012)**  
**STA. "CH2" 385+05 (M.P. 7.33)**

**OREGON TRANSPORTATION COMMISSION**  
  
Catherine Mater CHAIR  
David Lohman COMMISSIONER  
Tammy Baney COMMISSIONER  
Susan Morgan COMMISSIONER  
Alando Simpson COMMISSIONER  
Matthew L. Garrett DIRECTOR OF TRANSPORTATION

These plans were developed using ODOT design standards. Exceptions to these standards, if any, have been submitted and approved by the ODOT Chief Engineer or their delegated authority.

Approving Authority: *Tamira J. Clark*  
Tamira J. Clark  
Technical Center Manager, Region 1

*A. Johnson*  
Concurrence by ODOT Chief Engineer

**OR224: SE 135TH AVE SEC.**  
**CLACKAMAS HIGHWAY**  
**CLACKAMAS COUNTY**

FEDERAL HIGHWAY ADMINISTRATION	PROJECT NUMBER	SHEET NO.
OREGON DIVISION	HSIP-S174(012)	1

PE002127 000

**NOT REVISED AS CONSTRUCTED**  
**30 JUN 2015 CONTRACT 14740**  
**PROJ. MGR. MARJORIE WEST**

*Marjorie West 9/21/15*

Standard Drg. Nos.

INDEX OF SHEETS, CONT.	
SHEET NO.	DESCRIPTION
2, 2A & 2A-2	Typical Sections
2B, 2B-2 & 2B-3	Details
2C	Pipe Data Sheet
3	Alignment & General Construction
3A	Drainage & Utility Plan & Details
3A-2 & 3A-3	Drainage & Utilities Details
3B	Profile
<b>GEO/HYDRO</b>	
GA	Erosion Control Plan
GA-2 & GA-3	Erosion Control Details
GB	Geotechnical Data
GJ	Water Quality Details
<b>PERMANENT PAVEMENT MARKINGS</b>	
ST thru ST-3	Striping Plan
<b>PERMANENT SIGNING</b>	
S-14623 thru S-14627	Permanent Signing
<b>SIGNALS</b>	
17449	Legend
17750	Removal Plan
17751	Signal Plan
17752	Detector Plan
17753	Existing Utilities
17754 thru 17756	Details

- RD150 - Slope Rounding
- RD700 - Curbs
- RD720 - Sidewalks
- RD755 - Sidewalk Ramp Details
- RD756 - Sidewalk Ramp Placement Options Curb Radii <15'
- RD757 - Sidewalk Ramp Placement Options Curb Radii >15'
- RD759 - Truncated Dome Detectable Warning Surface Details & Locations
- RD1000 - Construction Entrances
- RD1010 - Inlet Protection (Type 1, 2 & 3)
- RD1015 - Inlet Protection (Type 4) Biofilter Bags
- RD1030 - Sediment Barrier (Type 2 & 4) Biofilter Or Sandbags
- RD1040 - Sediment Fence, Supported Sediment Fence, Unsupported
- RD1055 - Matting
- TM570 - Traffic Delineators
- TM576 - Traffic Delineator Installation For Non-Freeways
- RD300 - Trench Backfill, Bedding, Pipe Zone And Mult. Installations
- RD319 - Miscellaneous Culvert Details
- RD335 - Standard Storm Sewer Manhole
- RD336 - Standard Storm Sewer Manhole
- RD342 - Shallow Manholes
- RD344 - Standard Manhole Base Section
- RD356 - Manhole Covers And Frames
- RD363 - Manhole Frame Adjustment
- RD364 - Concrete Inlets Type G-1, G-2, G-2M & G-2MA
- RD365 - Frames & Grates For Concrete Inlets
- RD370 - Ditch Inlet Type D
- RD376 - Miscellaneous Drainage Structures Siphon Box, Inlet Cap & Inlet Adjustment
- RD386 - Fill Height Tables For Circular Concrete Pipe
- RD388 - Fill Height Tables For PVC Pipe
- RD390 - Fill Height Tables For Corrugated HDPE Pipe
- RD399 - Stormwater Treatment And Storage Facility Field Markers
- TM200 - Sign Installation Details
- TM201 - Miscellaneous Sign Placement Details
- TM212 - Signing Details Oregon Route Signs
- TM223 - Conventional Roads Directional Sign Layout Street Name Signs

- TM450 - Mast Arm Pole Details
- TM457 - Vehicle, Pedestrian Signal And Push Button Mounting Option Details
- TM458 - Pedestrian Ramp Placement Details
- TM460 - Vehicle Signal Details
- TM462 - Adjustable Signal Head Mounting Details
- TM465 - Overhead Sign, Fire Preemption And Photoelectronic Control Details
- TM467 - Pedestrian Signal And Pedestrian Push Button Details
- TM470 - Color Code Charts
- TM472 - Traffic Signal Junction Boxes/Hand Holes
- TM475 - Loop Details
- TM480 - Loop Entrance Details
- TM485 - Service Cabinets And Service Cabinet Wiring Details
- TM500 - Pavement Marking Standard Detail Blocks
- TM501 - Pavement Marking Standard Detail Blocks
- TM503 - Pavement Marking Standard Detail Blocks
- TM521 - Durable Pavement Markings Method "A" & Method "B" Surface & Groove Installed Non-Profiled
- TM530 - Intersection Pavement Markings (Crosswalk, Stop Bar & Bike Lane Stencil)
- TM531 - Turn Arrow Marking Details
- TM570 - Traffic Delineators
- TM576 - Traffic Delineator Installation For Non-Freeways
- TM650 - Traffic Signal Supports General Details & Design Criteria
- TM651 - Traffic Signal Supports Notes And Reactions
- TM652 - Traffic Signal Supports Steel Details
- TM653 - Traffic Signal Supports Foundation Requirements
- TM670 - Wood Post Sign Supports
- TM671 - 3 Second Gust Wind Speed Map
- TM676 - Sign Attachments
- TM677 - Sign Mounts
- TM679 - Signal Mast Arm Street Name Sign Mounts
- TM681 - Perforated Steel Square Tube (PSST) Sign Support Installation
- TM687 - Perforated Steel Square Tube (PSST) Anchor Foundation
- TM688 - Perforated Steel Square Tube (PSST) Slip Base Foundation
- TM800 - Tables, Abrupt Edge And PCMS Details
- TM810 - Temporary Pavement Markings
- TM820 - Temporary Barricades
- TM821 - Temporary Sign Supports
- TM840 - Closure Details
- TM841 - Intersection Work Zone Details
- TM842 - Signalized Intersection Details
- TM843 - Multi-Lane Signalized Intersection Details
- TM844 - Temporary Pedestrian Access Routing
- TM850 - 2-Lane, 2-Way Roadways
- TM851 - Non-Freeway Multi-Lane Sections

R/W Map No. 1R-3-1796

Horizontal Datum: NAD-83 (COR 96) EPOCH 2002  
 Coordinates: OCRS PDX (Portland Zone)  
 Vertical Datum: North American Vertical Datum of 1988 (NAVD88)

<b>OR224: SE 135TH AVE SEC.</b>		
CLACKAMAS HIGHWAY CLACKAMAS COUNTY		
FEDERAL HIGHWAY ADMINISTRATION	PROJECT NUMBER	SHEET NO.
OREGON DIVISION	HSIP-S174(012)	1A


Standard Drawings located on the web at:  
[http://www.oregon.gov/ODOT/HWY/ENGSERVICES/pages/standard\\_drawings\\_home.aspx](http://www.oregon.gov/ODOT/HWY/ENGSERVICES/pages/standard_drawings_home.aspx)

Sec. 11, T. 2 S, R. 2 E, W.M.

BEGINNING OF PROJECT  
STA. "CH2" 378+50 (M.P. 7.21)

REVISED AS CONSTRUCTED  
30 JUN 2015 CONTRACT 14740  
PROJ. MGR. MARJORIE WEST  
*Marjorie West*


END OF PROJECT  
STA. "CH2" 385+05 (M.P. 7.33)

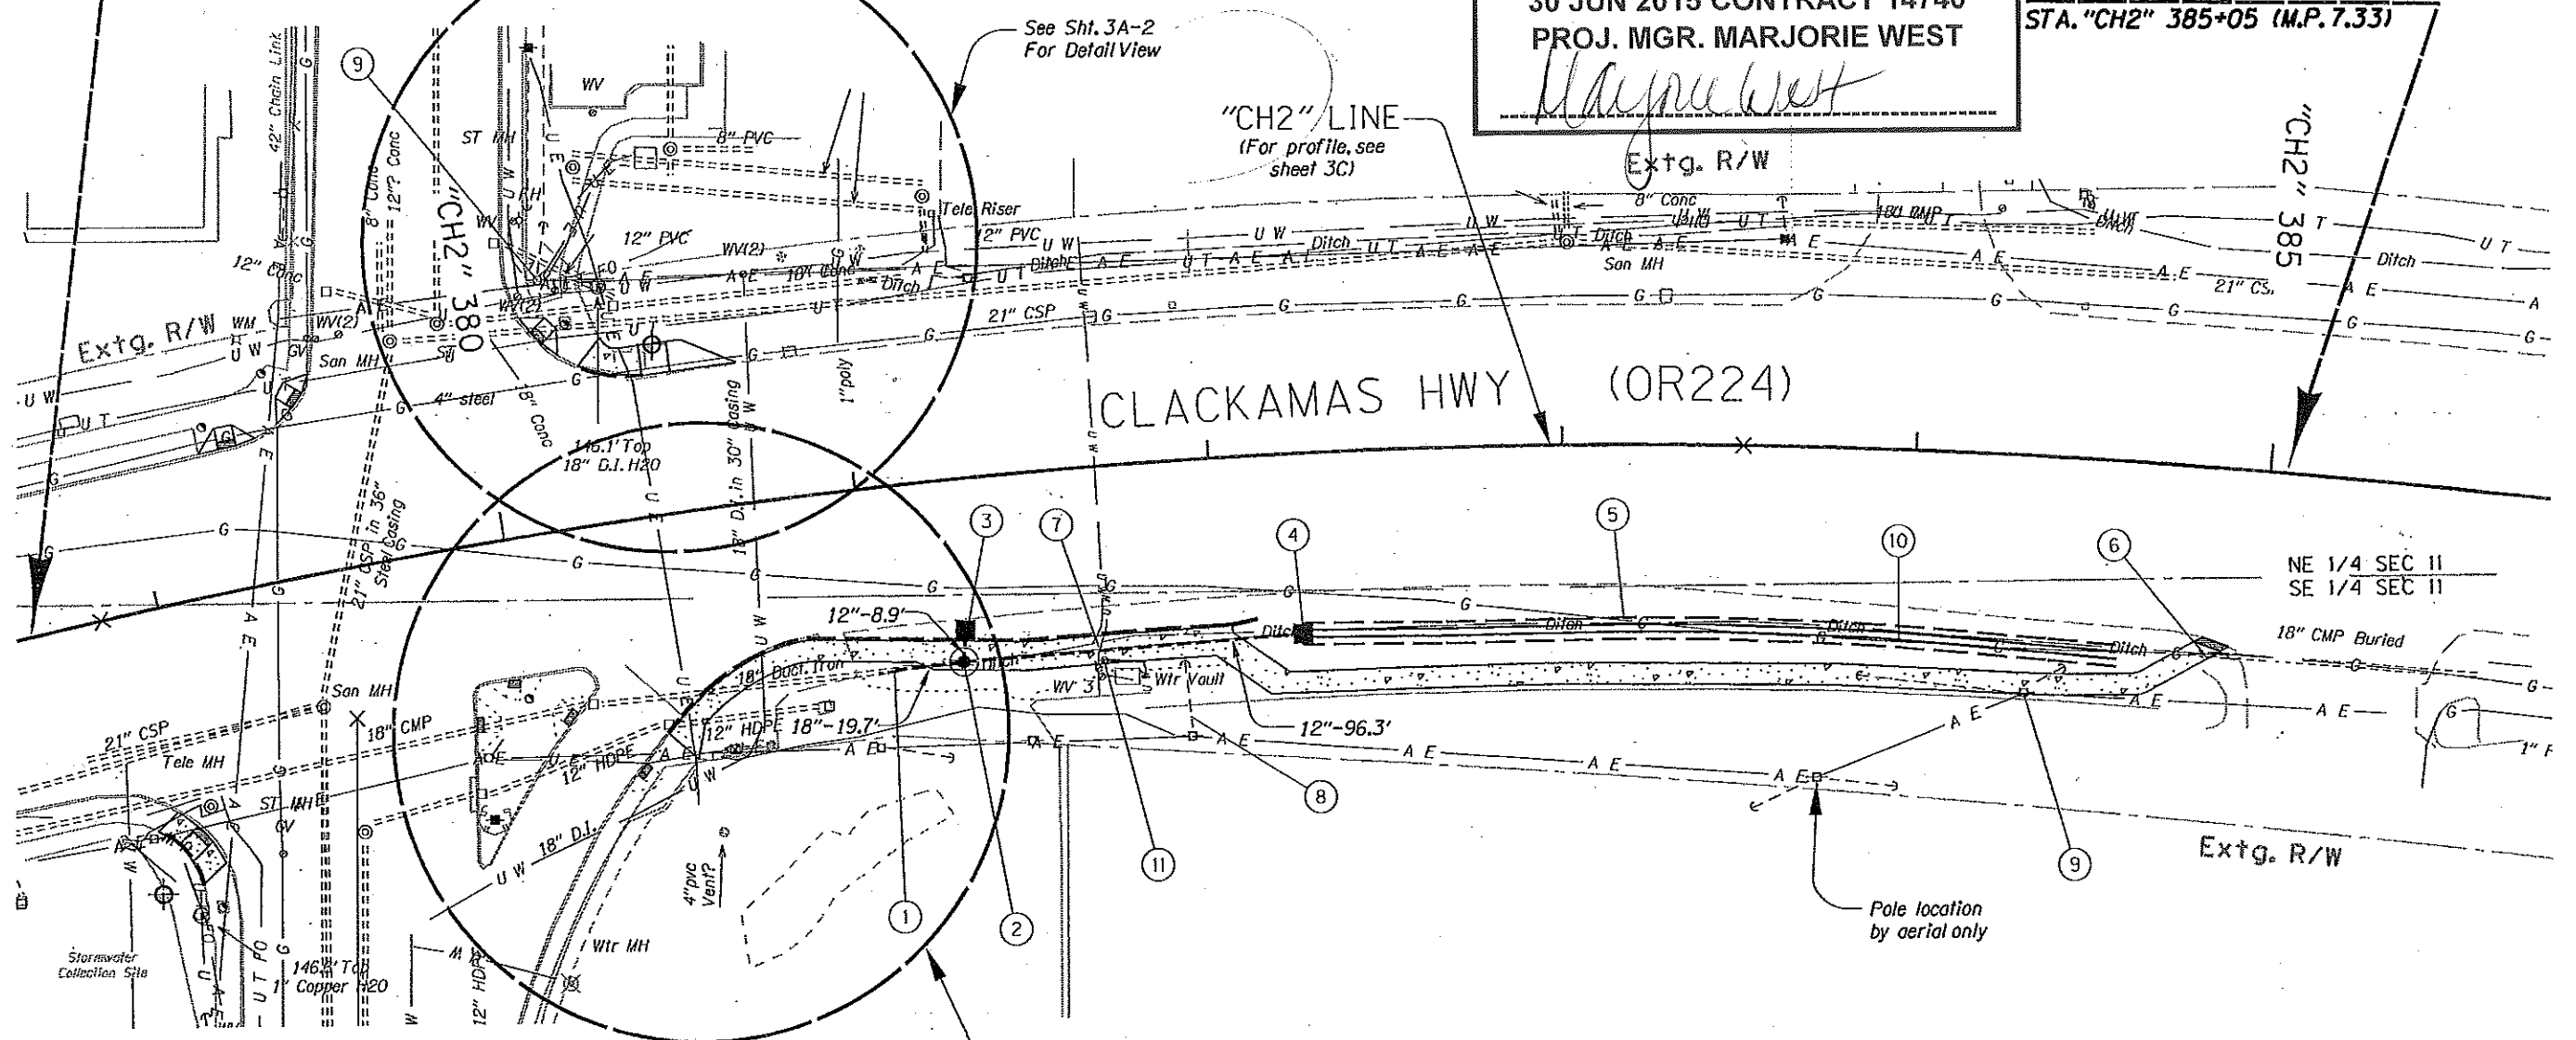

- ① Sta. "CH2" 381+06.65, Rt. Extend extg. 18" storm sewer pipe - 20' 5' depth (See drg. nos. RD300, & RD319)
- ② Sta. "CH2" 381+26.78, 51.40' Rt. Const. shallow MH w/ sub. frame & nonslip cover Rim elev. - 151.18' → 150.97' Inst. 12" storm sew. pipe - 9' 5' depth Inst. 12" storm sew. pipe - 96' 5' depth Increase sidewalk section around manhole and place subgrade geotextile between manhole and sidewalk (See drg. nos. RD335, RD336, RD342, RD344, RD356, RD360, RD386, RD388, & RD390)
- ③ Sta. "CH2" 382+27.29, Rt. → 381+27.79 Const. Type "G2" inlet w/ 1.5' sump (See drg. nos. RD364, RD365, & RD376)
- ④ Sta. "CH2" 382+25.67, 50.67' Rt. Const. Type "D" inlet w/ 1.5' sump F.L. Rim Elev. - 148.8' (See drg. no. RD370)
- ⑤ Sta. "CH2" 382+25.67 to 384+59.70, Const. Water Quality Biofiltration Swale - 230' Inst. water quality facility ID marker - 2 (For details see shts. GJ & GA) (See drg. no. RD399)
- ⑥ Sta. "CH2" 384+80.28, 54.53' Rt. Plug & abandon extg. 18" culvert pipe
- ⑦ Preserve and protect potable water line
- ⑧ Relocate utility pole anchor. (By others)
- ⑨ Relocate utility pole (By others)
- ⑩ Preserve and protect underground gas line
- ⑪ Adjust water valve (By others)

LEGEND  
(not all items shown are on this sheet)

- Remove manhole: ⊙
- Adjust manhole: ⊙
- Const. manhole: ⊙
- Remove inlet: ⊗
- Adjust inlet: ⊗
- Const. inlet: ⊗
- Infiltration ditch: ⊗
- Const. pipe: ---
- Plug and abandon pipe: ---

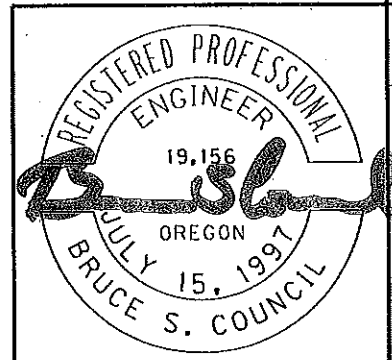


RENEWS: 12-31-2015

<b>OREGON DEPARTMENT OF TRANSPORTATION</b>	
REGION 1 - Geo/Hydro/HazMat Unit	
OR224: SE 135TH AVE SEC. CLACKAMAS HIGHWAY CLACKAMAS COUNTY	
Reviewed by - Bruce Council Designed by - David McDonald Drafted by - David McDonald	
<b>DRAINAGE &amp; UTILITIES</b>	SHEET NO. <b>3A</b>



REVISED AS CONSTRUCTED  
 30 JUN 2015 CONTRACT 14740  
 PROJ. MGR. MARJORIE WEST  
*Marjorie West 9/20/15*

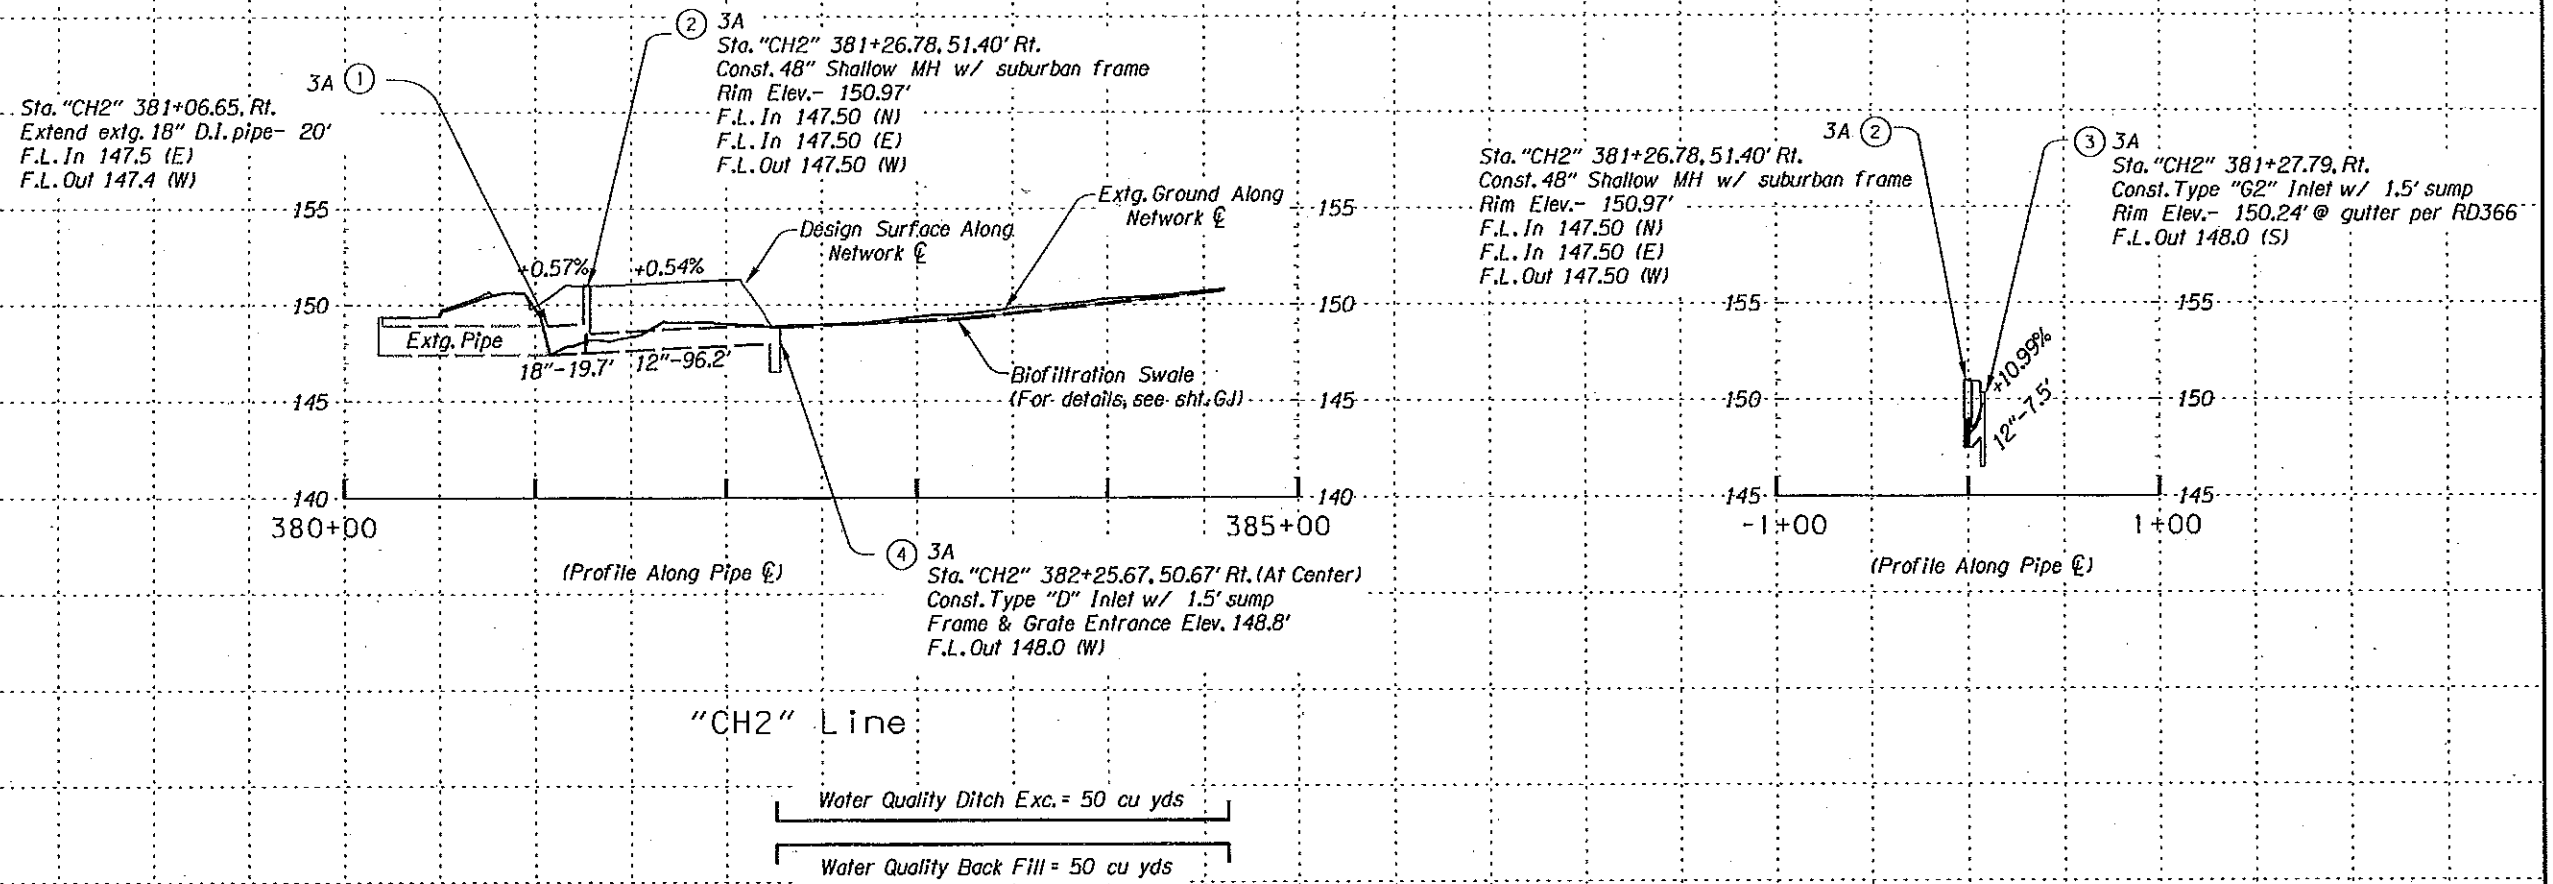

\*\* Match ditch flow line for type D inlet rim elevation. \*\*  
 Fine grade soil to match top elevation on back side.

Vertical Datum (NAVD88)

**REGISTERED PROFESSIONAL ENGINEER**  
 19,156  
 JULY 15, 1997  
 BRUCE S. COUNCIL  
 OREGON  
 RENEWS: 12-31-2015

**OREGON DEPARTMENT OF TRANSPORTATION**

REGION 1 - Geo/Hydro/HazMat Unit


OR224: SE 135TH AVE SEC.  
 CLACKAMAS HIGHWAY  
 CLACKAMAS COUNTY

Reviewed By - Bruce Council  
 Designed By - David McDonald  
 Drafted By - David McDonald

**PROFILE**

SHEET NO. 3B

REVISED AS CONSTRUCTED  
 30 JUN 2015 CONTRACT 14740  
 PROJ. MGR. MARJORIE WEST  
*Marjorie West 9/21/15*

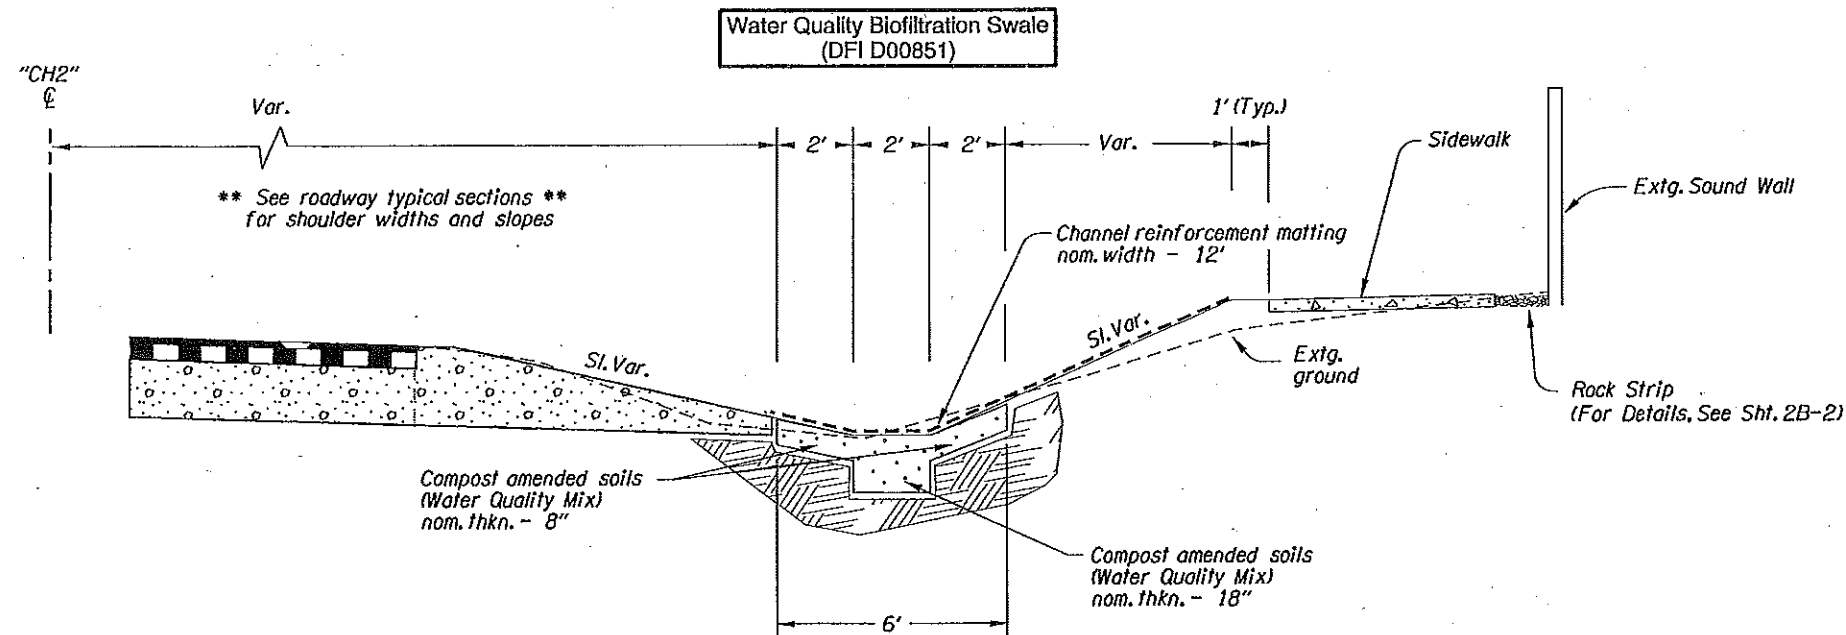

\*STA. 382+25.67 To STA. 384+59.70 Rt.

Biofiltration Swale Typical Cross-section

- GENERAL NOTES:
1. Create a suitable water quality mix by amending existing soils or installing an engineer approved water quality soil mixture. (See ODOT hydraulics Manual 14-E-1)
  2. Amend existing soil by placing 6" of compost material and mechanically combine into 12" of soil. (total 18" of amended soil) or 3" of compost material and mechanically combine into 5" of soil. (total 8" of amended soil).
  3. Sound wall height and location will vary.
  4. See shts. GA & GA-2 for seeding and matting information not shown on this sheet.

STORMWATER FIELD MARKER TABLE

FACILITY LOCATION		DFI #	TYPE S2 MARKER LOCATION		TYPE S1 MARKER	
STATION "CH2"	MP		BEGIN	END	RED	GREEN
382+25.67, Rt.	7.26	D00851	✓			
384+59.70, Rt.	7.28	D00851		✓		


Check where appropriate  
 Red = Beginning of facility  
 Green = End of facility

OREGON DEPARTMENT OF TRANSPORTATION

REGION 1 - Geo/Hydro/HazMat Unit

OR224 SE 135TH AVE SEC.  
 CLACKAMAS HIGHWAY  
 CLACKAMAS COUNTY

Reviewed By - Bruce Council  
 Designed By - David McDonald  
 Drafted By - David McDonald

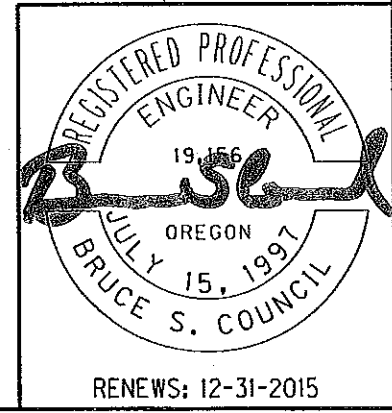

RENEWS: 12-31-2015

WATER QUALITY DETAILS

SHEET NO.  
 GJ