

OPERATION & MAINTENANCE MANUAL

Water Quality Biofiltration Swale

Manual prepared: November 2018

DFI No. D00898 and D00899



Figure 1: DFI No. D00898, looking northeast



Figure 2: DFI No. D00899, looking northeast

Identification

Drainage Facility ID (DFI): D00898
 Facility Type: Water Quality Biofiltration Swale
 Construction Drawings: (V-File Numbers) 43V-097
 Location: District: 1
 Highway No.: 047
 Mile Post: 54.46-54.49 [left side]

Drainage Facility ID (DFI): D00899
 Facility Type: Water Quality Biofiltration Swale
 Construction Drawings: (V-File Numbers) 43V-097
 Location: District: 1
 Highway No.: 047
 Mile Post: 54.58-54.56 [left side]

1. Manual Purpose

The purpose of this manual is to outline inspection needs and summarize maintenance actions.

2. Facility Location

The location map below details the facility location. The highway, mile posts, side streets, access location, and stormwater flow directions are noted on the map.

Facility location type: Roadway shoulder

Flow direction: southeast for D00898, northwest for D00899

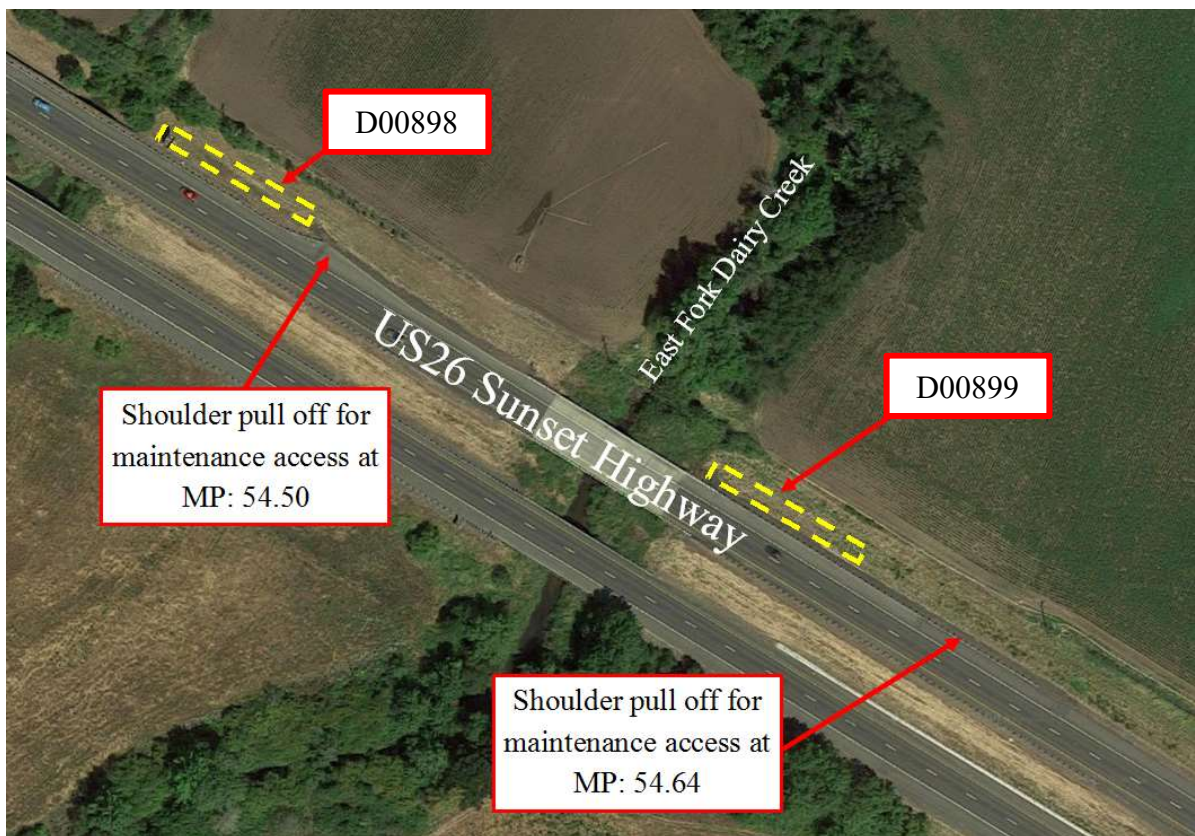



Figure 3: Facility location map for D00898 and D00899

3. Facility Summary

The length and width of a swale is based on the bottom dimensions.

The bottom length and bottom width of the swale is:


Facility ID	Bottom Length	Bottom Width	WQ Stage	25-Year Flood	W
D00898	131'	2'	0.19'	0.55'	10'
D00899	100'	9'	0.06'	0.21'	17'

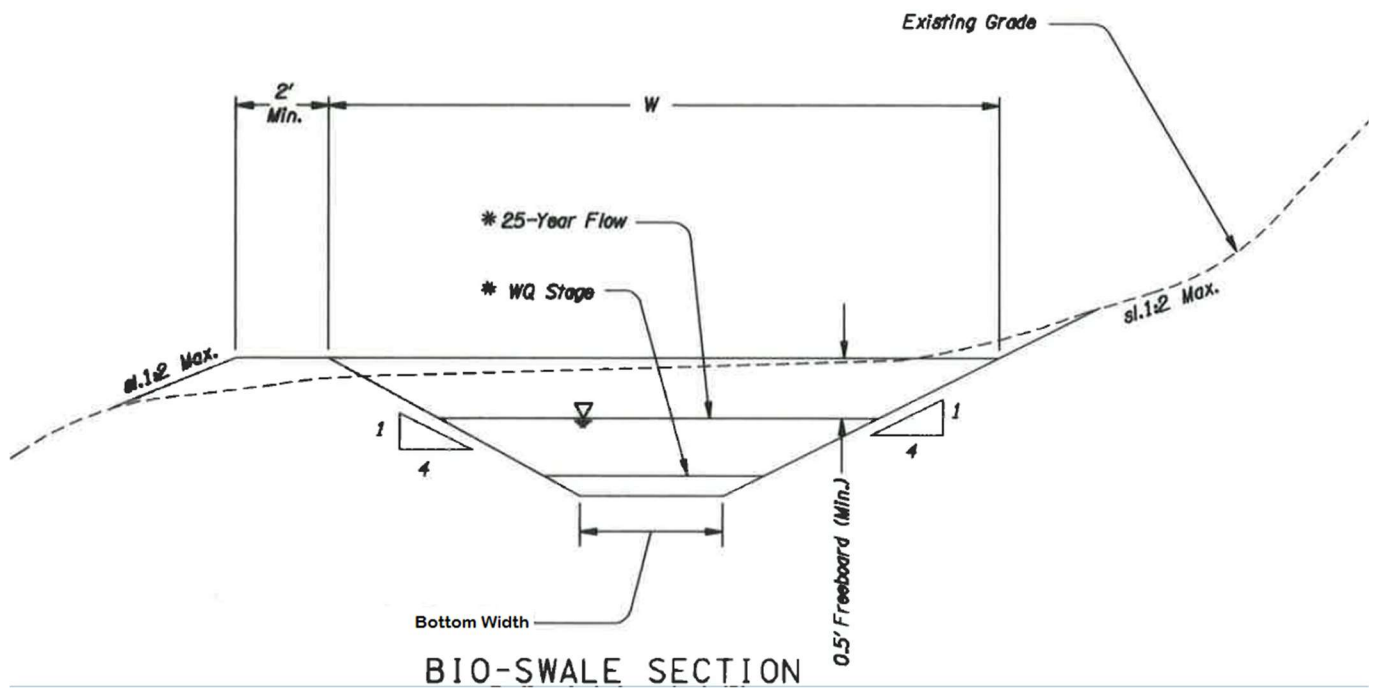

The depth of the swale is the vertical distance measured from the bottom of the swale to the top. The slope of the swale sides is presented by a vertical distance (rise) followed by the horizontal distance (run).

Depth and side slopes for all facilities:

Depth (feet)	Rise (feet)	Run (feet)
1.5	1	4

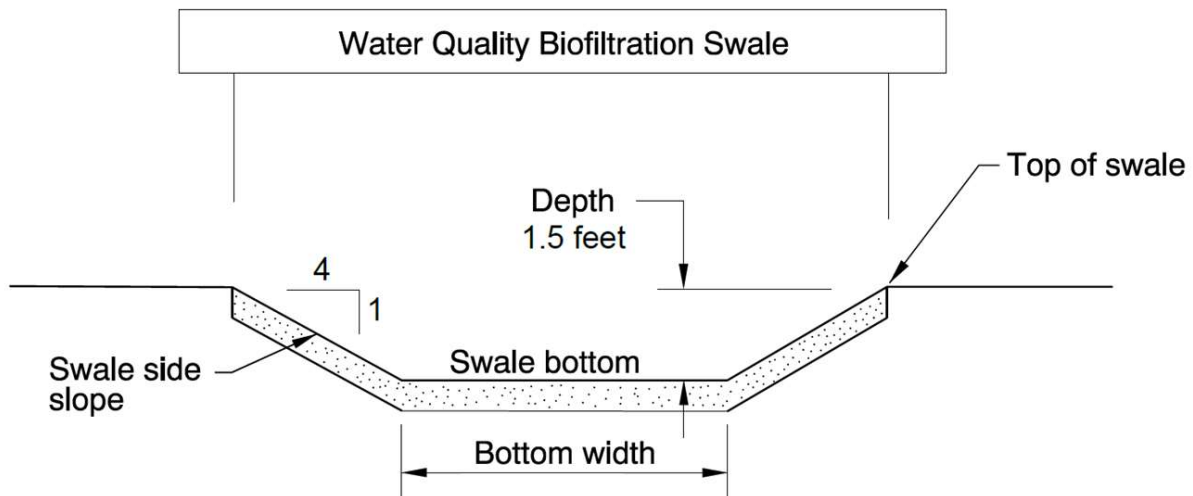

Site Specific Information: Both of the water quality swales have no pipe inlets or storm pipe bypasses. They are open ditches that water flows into and through, emptying into a rip rap basin

4. Facility Access

Maintenance access to the facility:

<input type="checkbox"/> Roadside pad	<input checked="" type="checkbox"/> Roadside shoulder
<input type="checkbox"/> Access road with Gate	<input type="checkbox"/> Access road without Gate



Figure 4: Maintenance access for D00898 for westbound traffic

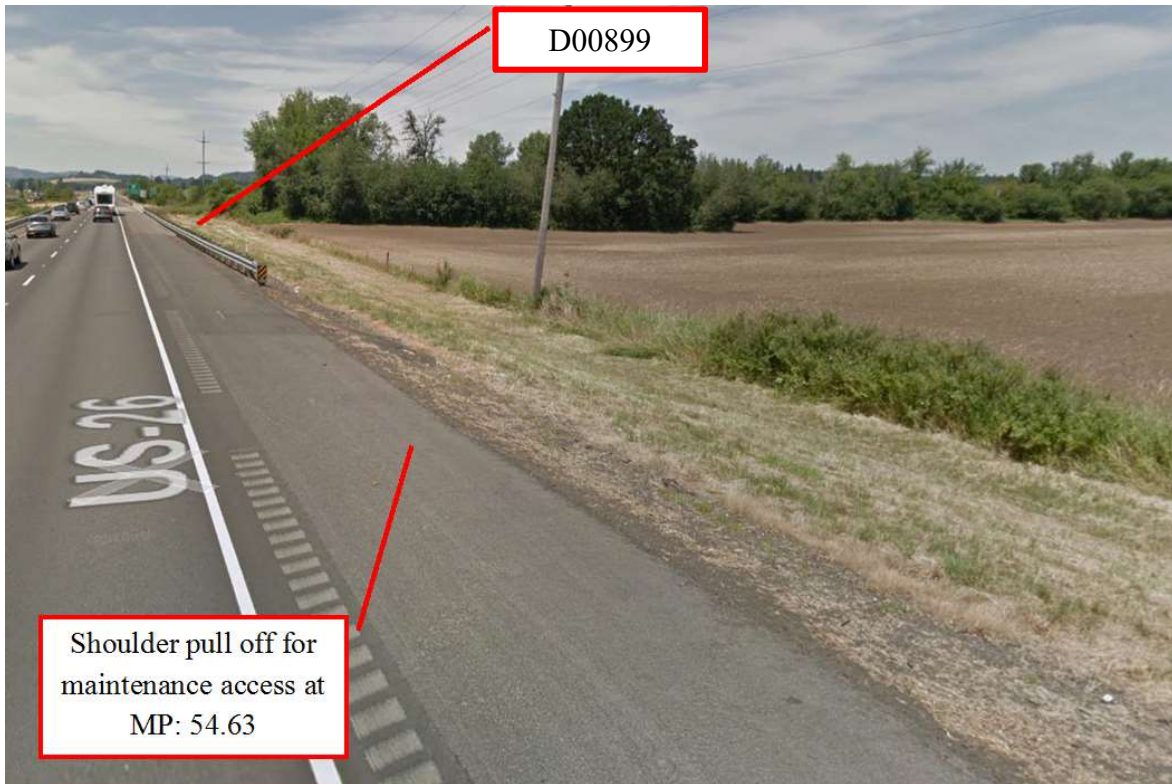


Figure 5: Maintenance access for D00899 for westbound traffic

5. Operational Components / Maintenance Items

Classification

<input checked="" type="checkbox"/> On-line Swale	<input type="checkbox"/> Off-line Swale
A swale that does not include a high flow bypass component; flow drains into and through the facility	A swale that treats low/small flows and diverts high flows using a bypass component

*Both facilities are on-line swales.

Bypass Component

<input checked="" type="checkbox"/> No	<input type="checkbox"/> Yes
There is no bypass component. High flows drain into and through the facility	There is a bypass component. Only low/small flows drain into the swale. High flows are diverted around the swale using a bypass component

Operational Components

A swale has many components that assist with treatment, conveyance, and reducing flow velocity to minimize erosion. The components in use can vary depending if the facility was designed to operate on-line or off-line. The facility components table (**Table 1**) has been provided to highlight the applicable components for this facility. The component is in use when the box contains an “x” (e.g.).

The Standard Operation Manual for Water Quality Biofiltration Swales (implemented March 2017) outlines facility operation, typical footprint configuration, and component definitions and details. A link to the manual is attached to the feature marker in TransGIS.

<https://gis.odot.state.or.us/TransGIS/>

Operational Plan

The applicable standard operational plan for both facilities is:

<input checked="" type="checkbox"/> Operational Plan A	<input type="checkbox"/> Operational Plan B	<input type="checkbox"/> Operational Plan C
An on-line swale with roadside ditches	An on-line swale with piped inlets and outlets	An off-line swale with a piped high flow bypass
A standard operational plan illustrates the general facility footprint configuration and explains the purpose of each facility component. Operational plans (A, B, C) are provided in the Standard Operation Manual.		

See Appendix A for the site specific operational plan.

Maintenance Items

Operational components marked in **Table 1** should be inspected and maintained according to Section 7. Each facility component is defined and detailed in the Standard Operation Manual using the associated ID number indicated below.

Table 1: Swale Components		ID #
Manholes/Structures		
Pre-treatment manhole	<input type="checkbox"/>	S1
Weir type flow splitter/flow splitter manhole	<input type="checkbox"/>	S2
Orifice type flow splitter/flow splitter manhole	<input type="checkbox"/>	S3
Standard manhole	<input type="checkbox"/>	S4
Swale Inlet		
Pavement sheet flow	<input type="checkbox"/>	S5
Inlet Pipe (s)	<input type="checkbox"/>	S6
Open channel inlet	<input checked="" type="checkbox"/>	S7
Riprap pad	<input type="checkbox"/>	S8
Ground Cover		
Grass bottom	<input checked="" type="checkbox"/>	S9
Grass side slopes	<input checked="" type="checkbox"/>	S10
Granular drain rock	<input type="checkbox"/>	S11
Plantings	<input type="checkbox"/>	S12
Underground Components		
Geotextile fabric	<input checked="" type="checkbox"/>	S13
Water quality mix	<input type="checkbox"/>	S14
Perforated pipe	<input type="checkbox"/>	S15
Porous pavers (access grid)	<input type="checkbox"/>	S16
Flow Spreader		
Rock basin (used at inlet)	<input type="checkbox"/>	S17
Anchored board (midpoint of swale or every 50 feet along swale bottom)	<input type="checkbox"/>	S18
Other: describe type	<input type="checkbox"/>	S19
Swale Outlet		
Catch basin with grate	<input type="checkbox"/>	S20
Outlet Pipe (s)	<input type="checkbox"/>	S21
Open channel outlet	<input type="checkbox"/>	S22
Auxiliary Outlet: Riprap lined drainage	<input checked="" type="checkbox"/>	S23
Outfall Type		
Waterbody (Creek/Lake/Ocean)	<input type="checkbox"/> C	S24
Ditch	<input checked="" type="checkbox"/>	S25
Storm drain system	<input type="checkbox"/>	S26
Outfall Components		
Riprap pad	<input type="checkbox"/>	S27
Riprap bank protection	<input type="checkbox"/>	S28

6. Maintenance

Maintenance Frequency/Maintain Records

- a. Inspect annually. Preferably prior to the rainy season.
- b. Clean and maintain as necessary. Refer to Activity 125 for conditions when maintenance is needed.
- c. Keep a record of inspections, maintenance, and repairs.

Maintenance Guide/Maintenance Actions

The ODOT Routine Road Maintenance Water Quality and Habitat Guide (the *Blue Book*) outlines the standard maintenance actions for water quality facilities under Activity 125.

There are standard maintenance tables for standard ODOT designs. The maintenance tables describe the maintenance component, the defect or problem, the condition when maintenance is needed, and the recommended maintenance to correct the problem. Use the following tables to maintain ODOT swales:

- Table 1 (General Maintenance): Contains general maintenance and inspection guidelines that are applicable to all ODOT water quality facilities
- Table 3 (Maintenance of Water Quality or Biofiltration Swales): Contains maintenance information for swales

The *Blue Book* can be viewed at the following website:

http://www.oregon.gov/ODOT/Maintenance/Documents/blue_book.pdf

7. Limitations

Access grid installed:

<input checked="" type="checkbox"/> No	<input type="checkbox"/> Yes
There are no duty porous pavers installed in this swale	

Swales are designed to allow equipment access along the bottom. If an access grid is **NOT** installed, vehicles entering the swale can create depressions (tire ruts), damage vegetation, and damage structural components (e.g. flow spreaders). These conditions may result in poor treatment and drainage performance.

Equipment wheels should be kept on the tops and side slopes. Mower arms may be run along the swale bottom.

8. Waste Material Handling

Material removed from the facility is defined as waste by the Department of Environmental Quality (DEQ). Refer to the roadwaste section of the ODOT Maintenance Yard Environmental Management System (EMS) Policy and Procedures Manual for disposal options:

http://www.oregon.gov/ODOT/Maintenance/Documents/ems_manual.pdf

Contact any of the following for more detailed information about management of waste materials found on site:

ODOT Clean Water Unit	(503) 986-3008
ODOT Statewide Hazmat Coordinator	(503) 667-7442
ODOT Region 1 Hazmat Coordinator	(503) 731-8290
ODOT Region 2 Hazmat Coordinator	(503) 986-2647
ODOT Region 3 Hazmat Coordinator	(541) 957-3594
ODOT Region 4 Hazmat Coordinator	(541) 388-6186
ODOT Region 5 Hazmat Coordinator	(541) 963-1590
ODEQ Northwest Region Office	(503) 229-5263




A Appendix A – Site Specific Operational Plan

Contents:

Operational Plan: DFI D00898 and D00899

Legend

- Water Flow Direction
- Traffic Flow Direction
- Picture Location/Direction

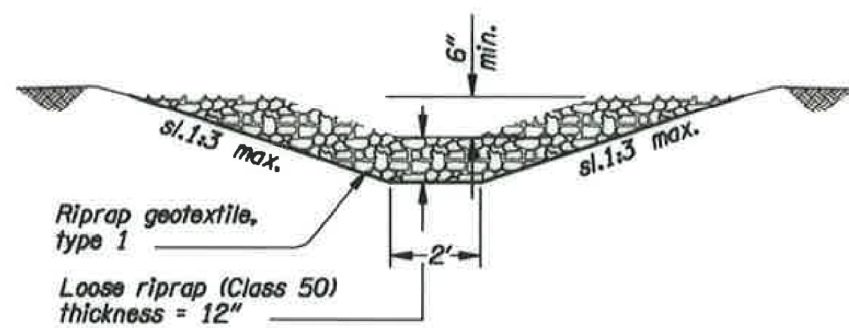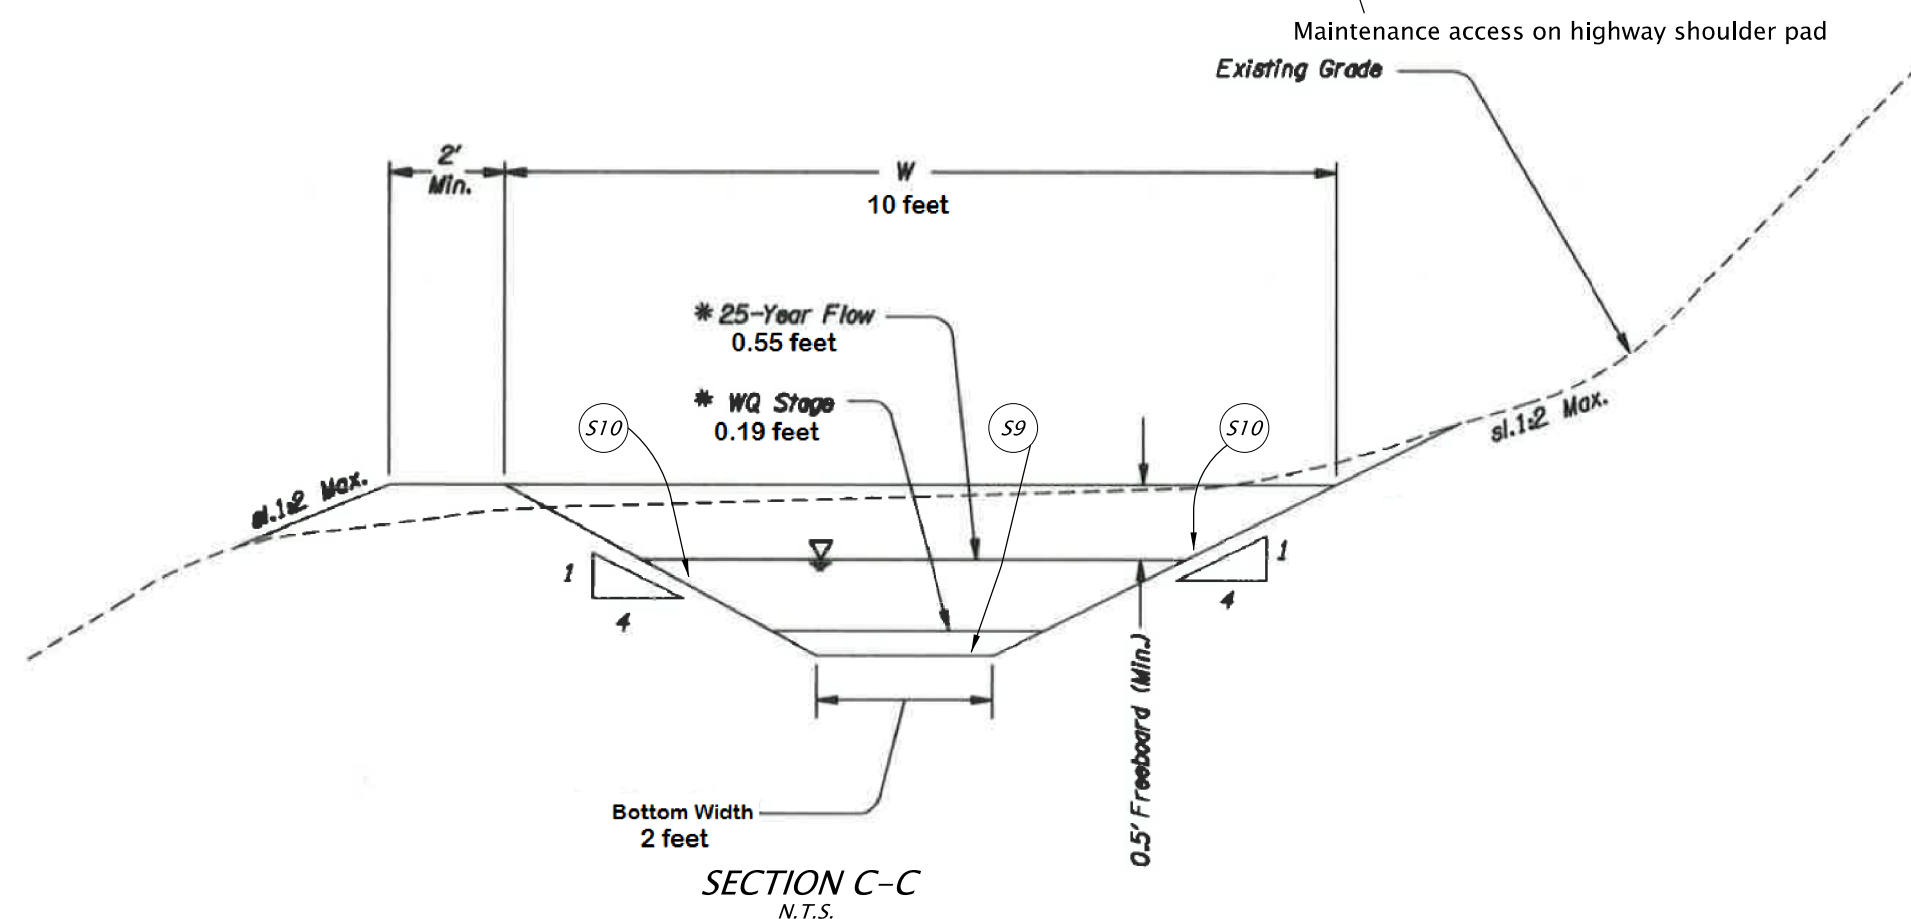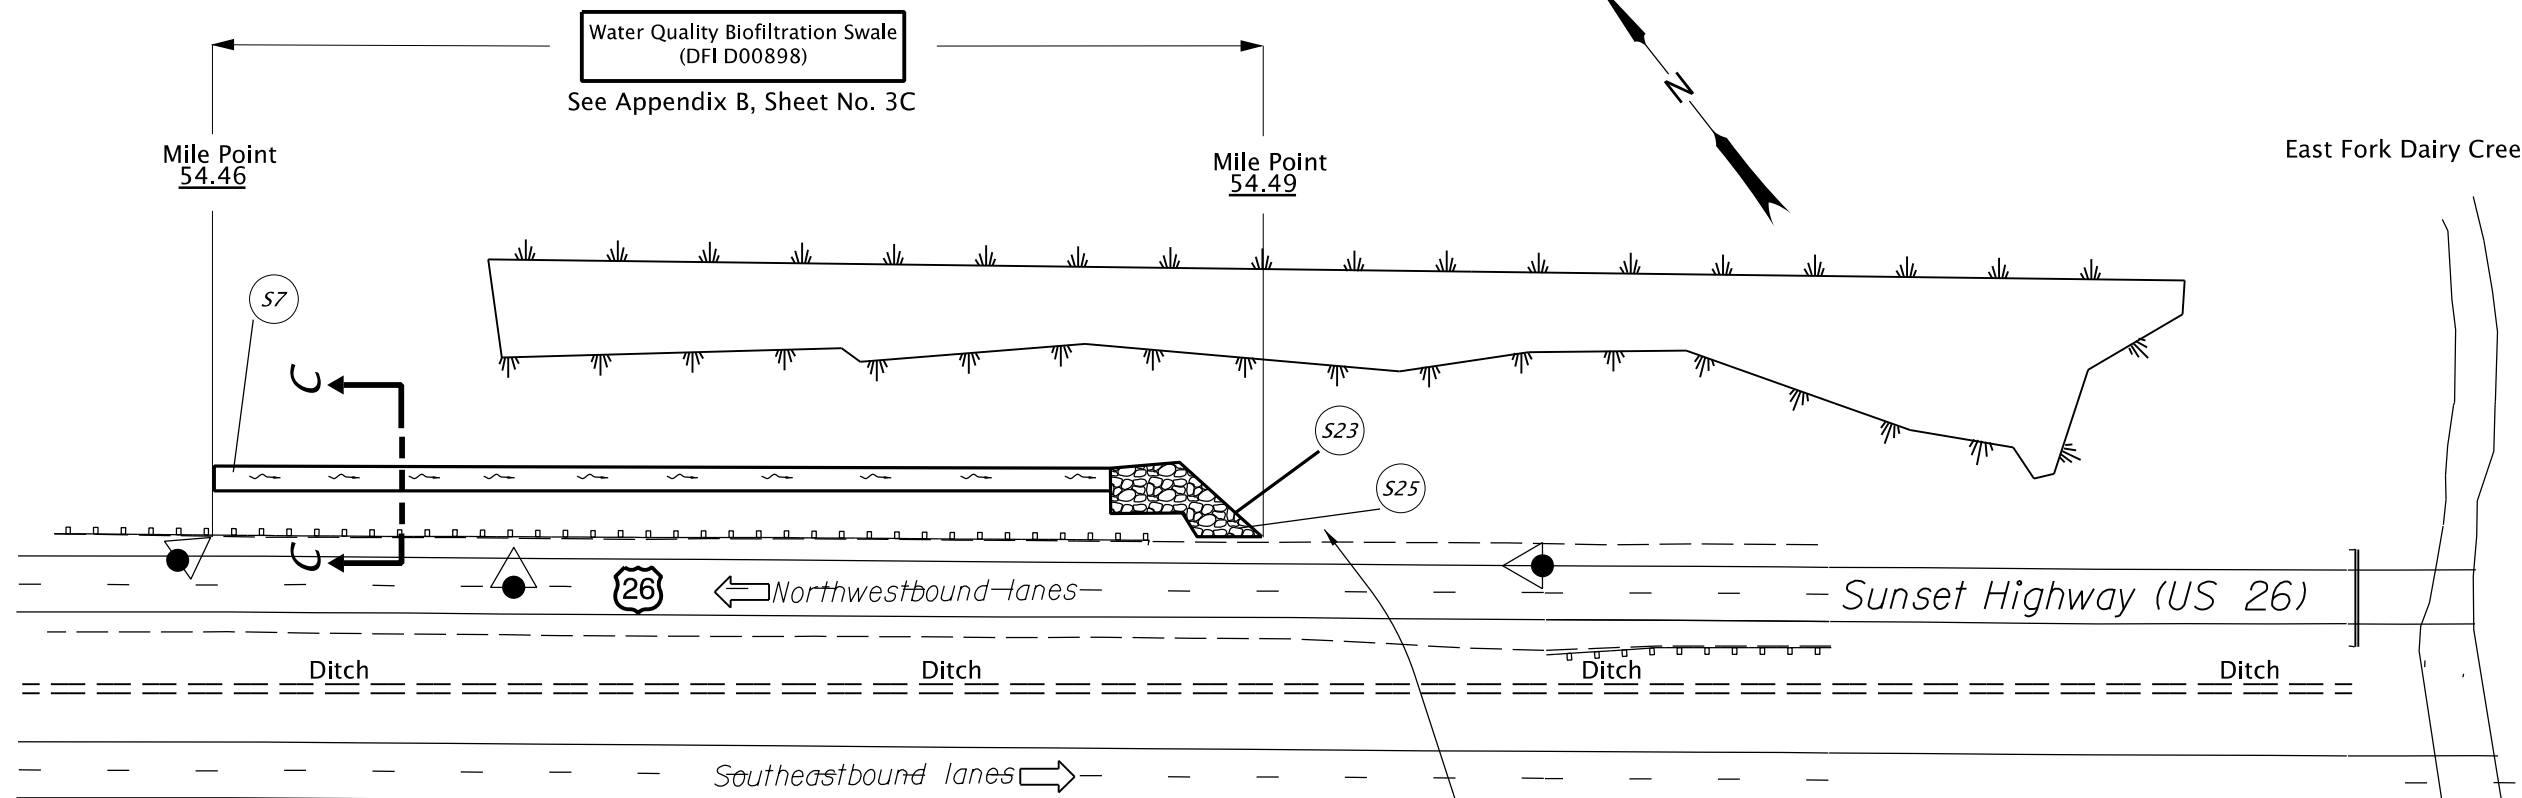


RIPRAP LINED DRAINAGE DITCH


	OREGON DEPARTMENT OF TRANSPORTATION
	Sht. 01 of 04
Prepared By: Katrina Sepulveda	DFI D00898 MAINTENANCE DISTRICT 1 HWY 047 Water Quality Biofiltration Swale Sunset Highway MP 54.46-54.49 Washington County
Drafted By: Katrina Sepulveda	

Water Quality Biofiltration Swale
(DFI D00899)
See Appendix B, Sheet No. 3C


- Legend**
- Water Flow Direction
 - Traffic Flow Direction
 - Picture Location/Direction

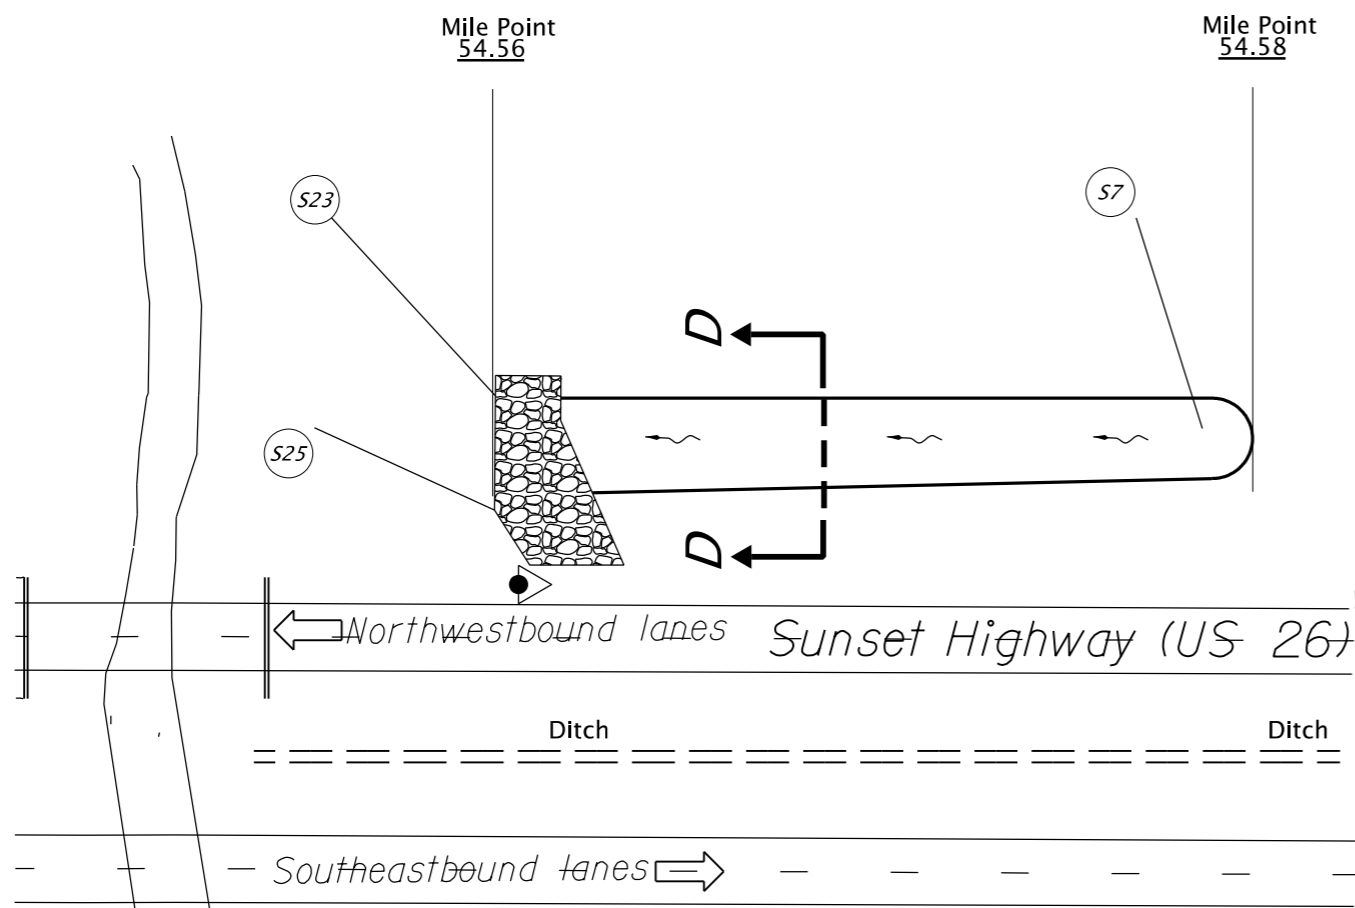

Maintenance access on shoulder at MP: 54.64

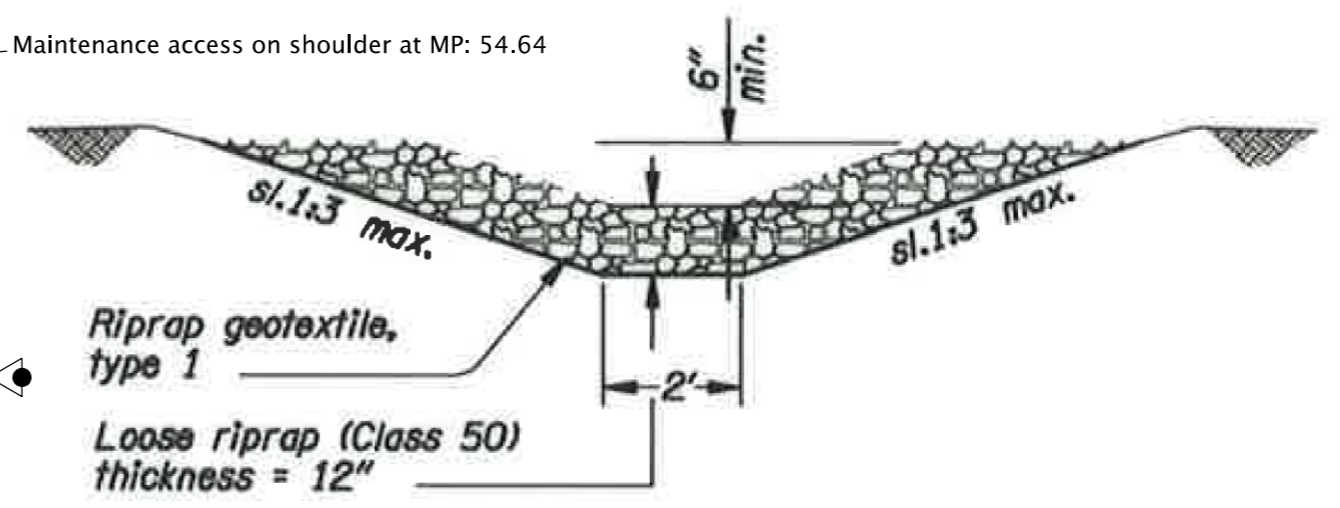

RIPRAP LINED DRAINAGE DITCH

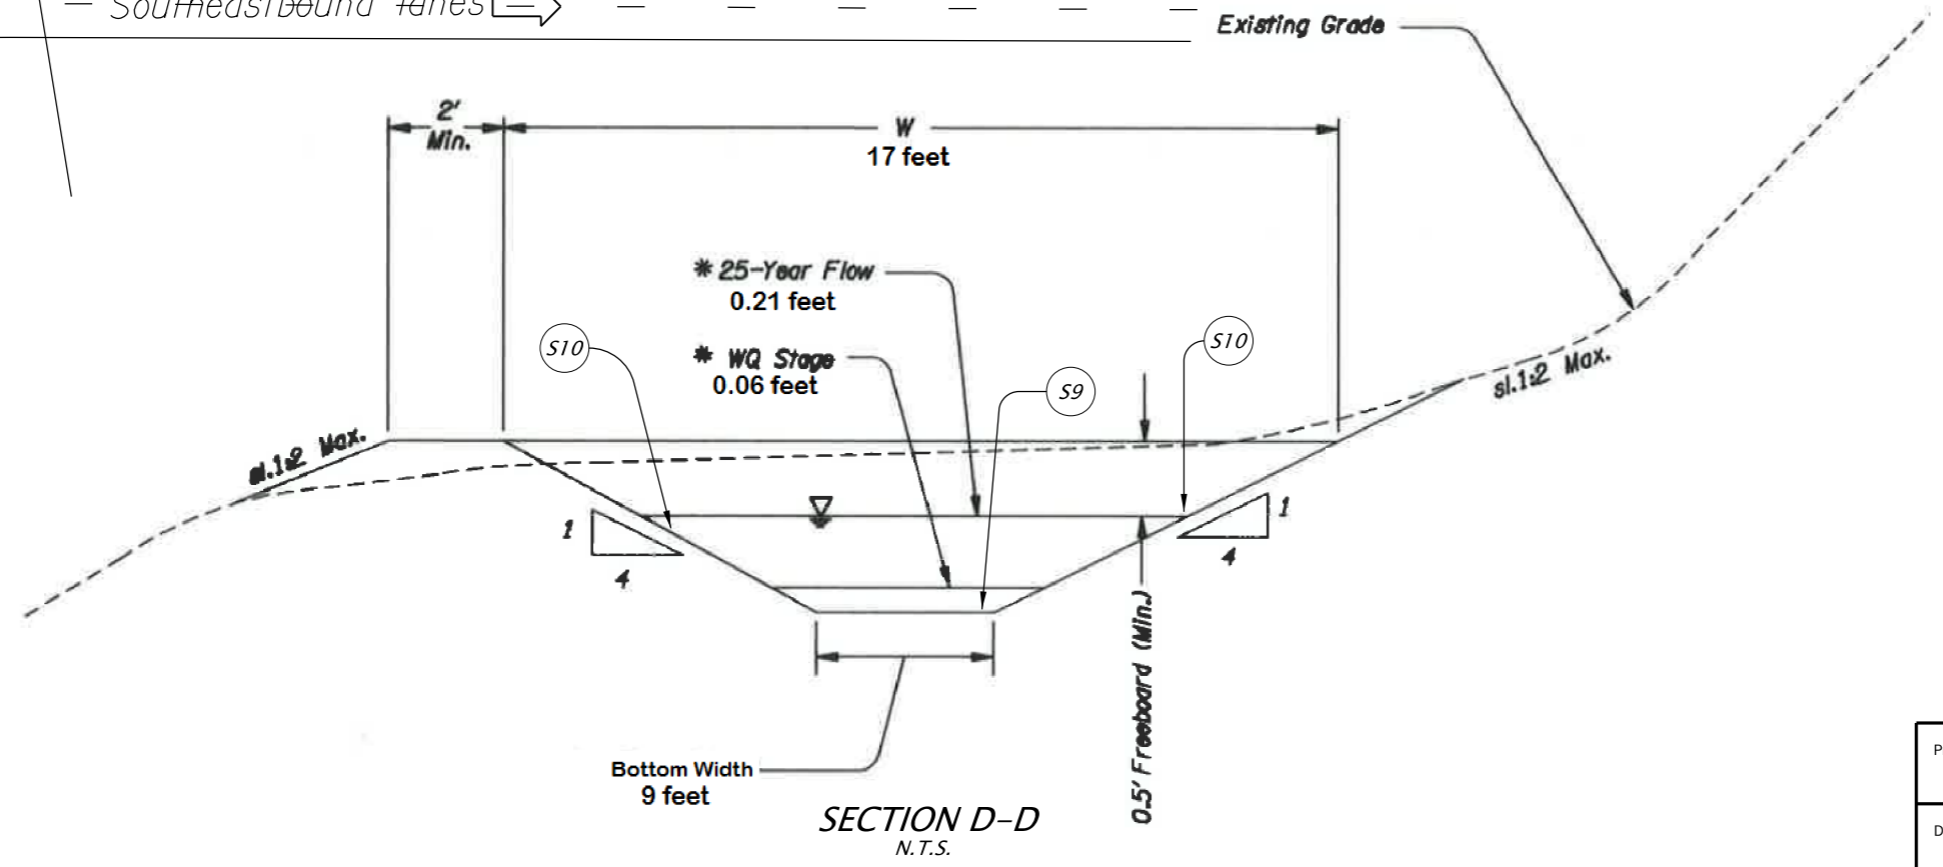

OREGON DEPARTMENT OF TRANSPORTATION

Sht. 02 of 04

Prepared By:
Katrina Sepulveda

Drafted By:
Katrina Sepulveda

DFI D00899
MAINTENANCE DISTRICT 1 HWY 047
Water Quality Biofiltration Swale
Sunset Highway MP 54.56-54.58
Washington County

B – Project Contract Plans

Contents:


Site Specific Subset of Project Contract Plan 43V-097

INDEX OF SHEETS	
SHEET NO.	DESCRIPTION
1	Title Sheet
1A	Index of Sheets and Standard Drg. Nos.


STATE OF OREGON
 DEPARTMENT OF TRANSPORTATION

PLANS FOR PROPOSED PROJECT
 STRUCTURES, GRADING, DRAINAGE, PAVING, SIGNING AND ROADSIDE DEVELOPMENT
US26: EAST FORK DAIRY CR - MCKAY CR - BUNDLE 511

SUNSET HIGHWAY
WASHINGTON COUNTY
APRIL 2010

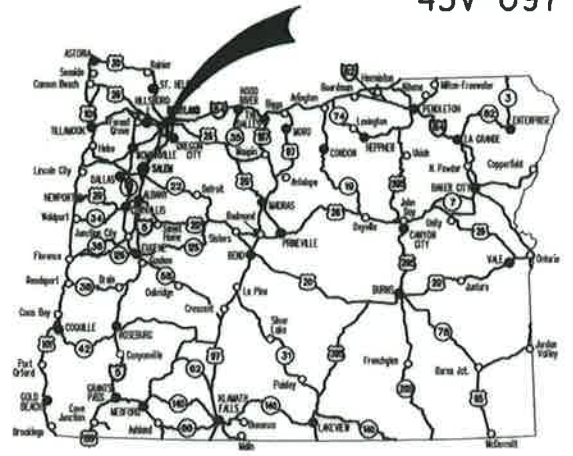

Overall Length Of Project - 3.61 Miles

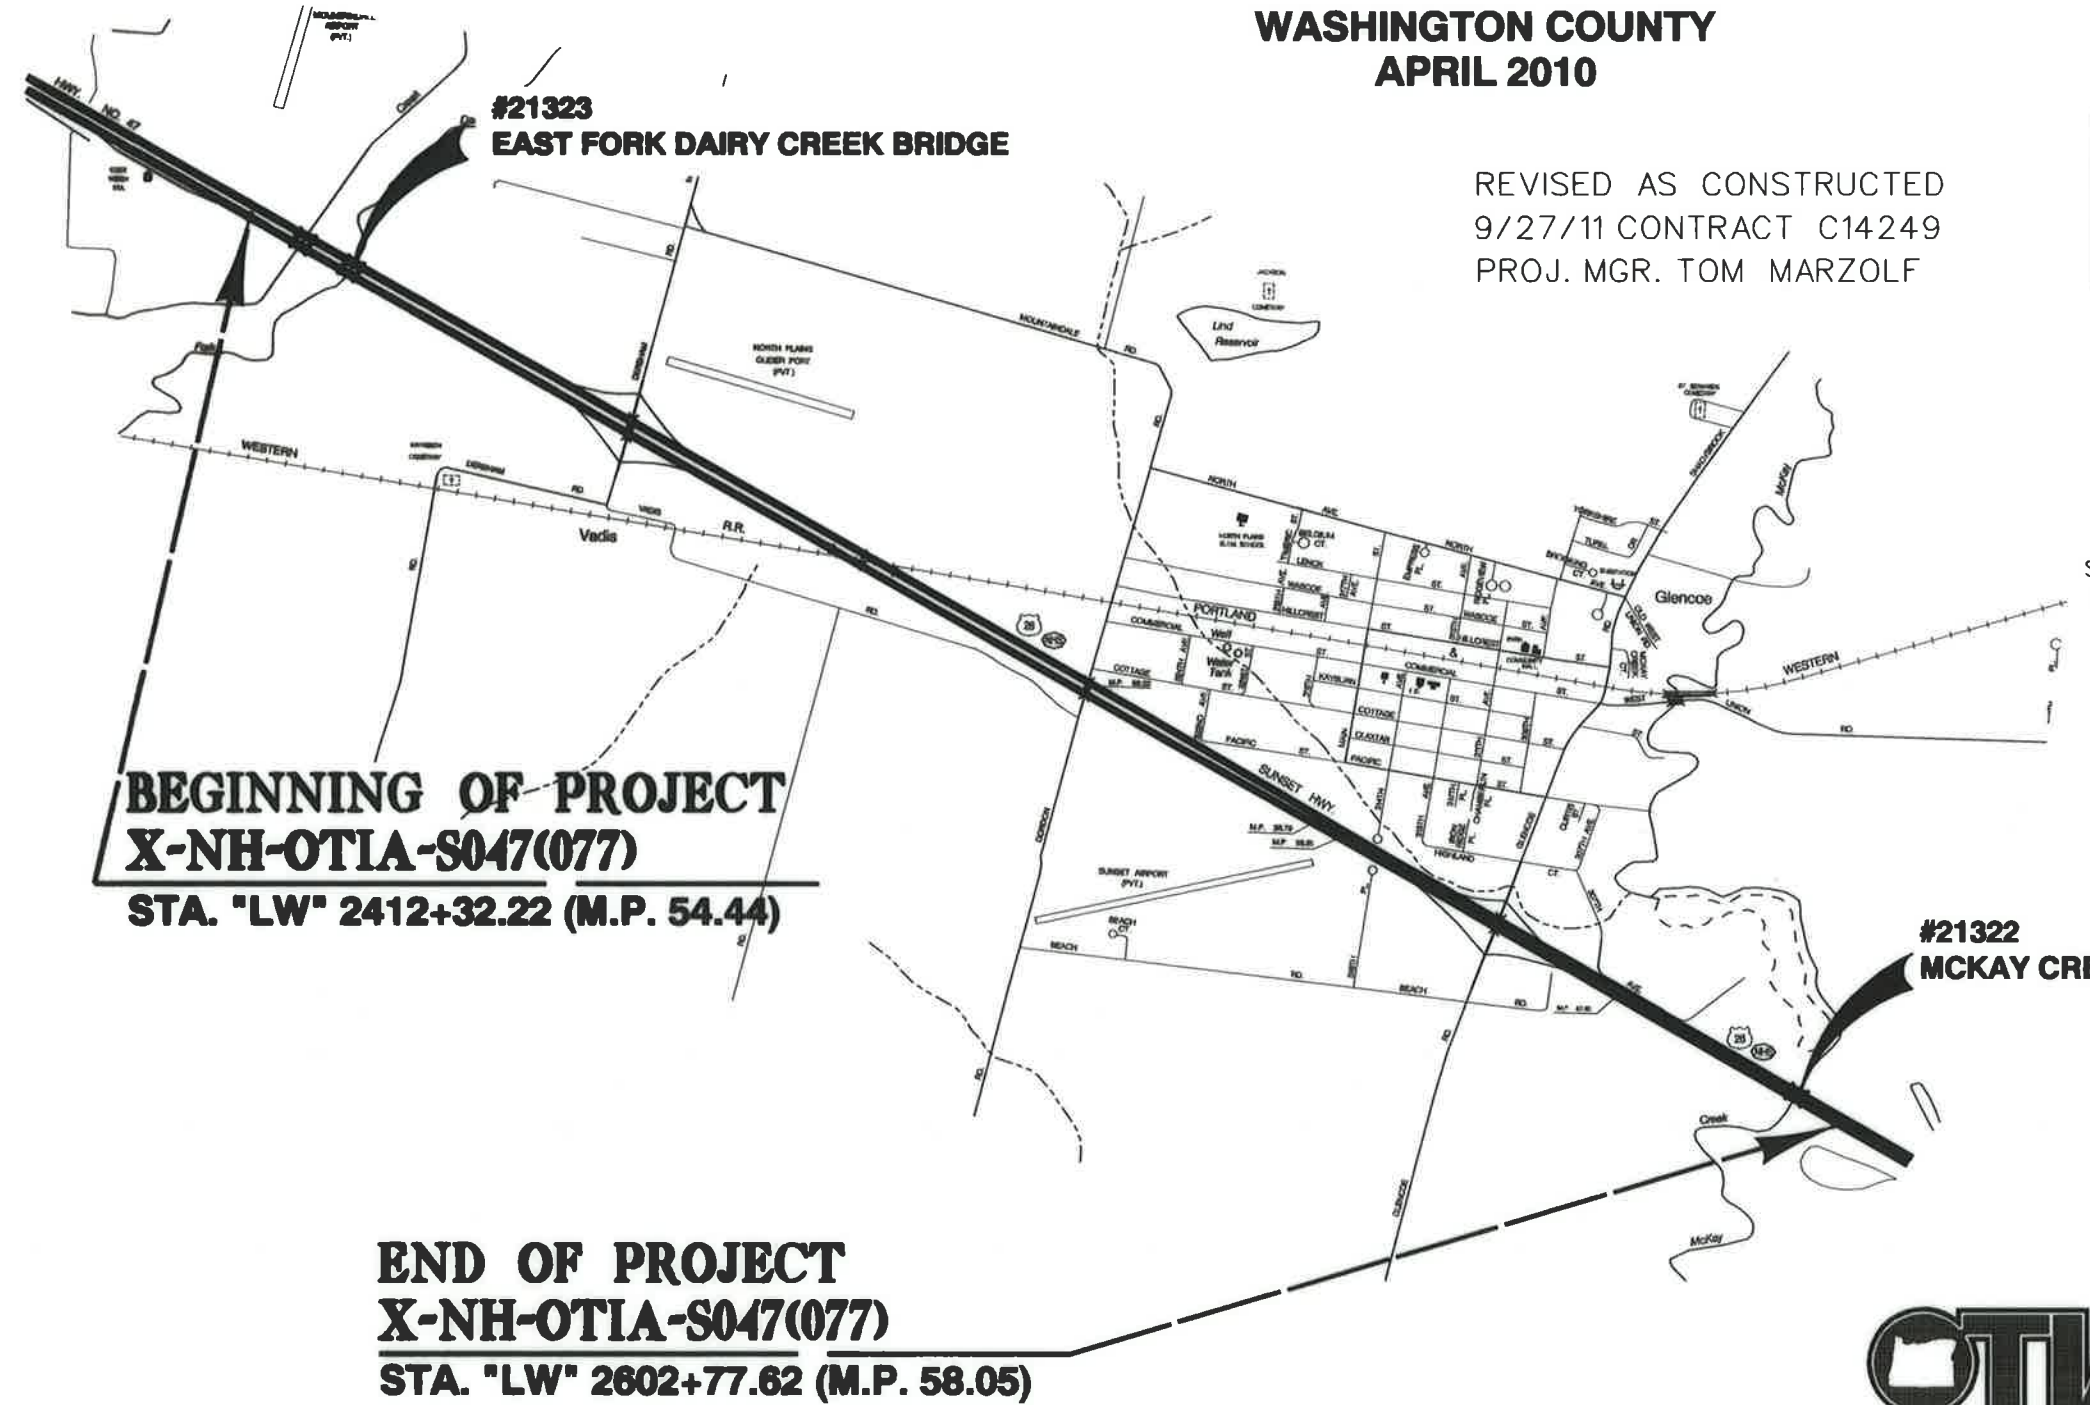

REVISED AS CONSTRUCTED
 9/27/11 CONTRACT C14249
 PROJ. MGR. TOM MARZOLF



ATTENTION:
 Oregon Law Requires You To Follow Rules Adopted By The Oregon Utility Notification Center. Those Rules Are Set Forth In OAR 952-001-0010 Through OAR 952-001-0090. You May Obtain Copies Of The Rules By Calling The Center. (Note: The Telephone Number For The Oregon Utility Center Is (503) 232-1987.)

OREGON TRANSPORTATION COMMISSION

Gail Achterman	CHAIR
Michael Nelson	VICE-CHAIR
Mary F. Olson	COMMISSIONER
Alan Brown	COMMISSIONER
David Lohman	COMMISSIONER
Matthew L. Garrett	DIRECTOR OF TRANSPORTATION

PLANS PREPARED FOR
ODOT
 BY:

These plans were developed using ODOT design standards. Exceptions to these standards, if any, have been submitted and approved by the ODOT Chief Engineer or their delegated authority.

Approving Authority: _____
 Signature & date

 Print name and title

 Concurrence by ODOT Chief Engineer

US26: EAST FORK DAIRY CR - MCKAY CR - BUNDLE 511
SUNSET HIGHWAY
WASHINGTON COUNTY

FEDERAL HIGHWAY ADMINISTRATION	PROJECT NUMBER	SHEET NO.
OREGON DIVISION	X-NH-OTIA-0047(077)	1



BEGINNING OF PROJECT
X-NH-OTIA-S047(077)
STA. "LW" 2412+32.22 (M.P. 54.44)

END OF PROJECT
X-NH-OTIA-S047(077)
STA. "LW" 2602+77.62 (M.P. 58.05)

INDEX OF SHEETS CONT'D.

SHEET NO.	DESCRIPTION
2	TYPICAL SECTIONS
2A	TYPICAL SECTIONS
2B	RIPRAP PLAN
2B-2	RIPRAP PLAN
2B-3	RIPRAP DETAILS
2B-4	DETAILS
2B-5	DETAILS
2B-6	DRAINAGE DETAILS
2C	TRAFFIC CONTROL PLAN
2C-2	TRAFFIC CONTROL PLAN
2C-3	DETOUR STRIPING PLAN
2C-4	DETOUR STRIPING PLAN
2C-5	TRAFFIC CONTROL PLAN
2C-6	TRAFFIC CONTROL PLAN
2C-7	DETOUR STRIPING PLAN
2C-8	DETOUR STRIPING PLAN
2D	PIPE DATA SHEET
3	ALIGNMENT AND GENERAL CONSTRUCTION
3A	PROFILE
3B	DETOUR ALIGNMENT AND GENERAL CONSTRUCTION
3B-2	DETOUR ALIGNMENT AND GENERAL CONSTRUCTION
3B-3	DETOUR PROFILE
3C	DRAINAGE AND RUNOFF TREATMENT PLAN
4	ALIGNMENT AND GENERAL CONSTRUCTION
4A	PROFILE
4B	DETOUR ALIGNMENT AND GENERAL CONSTRUCTION
4B-2	DETOUR ALIGNMENT AND GENERAL CONSTRUCTION
4B-3	DETOUR PROFILE
4C	DRAINAGE AND RUNOFF TREATMENT PLAN
6A	EROSION CONTROL PLAN
6A-2	EROSION CONTROL PLAN
6A-3	SITE STABILIZATION PLAN
6A-4	STREAMBANK STABILIZATION PLAN
6A-5	SITE STABILIZATION PLAN
6A-6	STREAMBANK STABILIZATION PLAN
6N	CONTOUR GRADING PLAN
6N2	CONTOUR GRADING PLAN
PERMANENT SIGNING & PAVEMENT MARKINGS	
SHEET NO.	DESCRIPTION
ST	STRIPING PLAN
ST-2	STRIPING PLAN
ST-3	STRIPING PLAN
ST-4	STRIPING PLAN
ST-5	STRIPING DETAILS
S-12013	SIGNING PLAN
S-12014	SIGNING PLAN
S-12015	SIGNING PLAN

**INDEX OF SHEETS
Bridge No. 21322**

DRAWING NO.	DESCRIPTION
83254	PLAN AND ELEVATION
83255	GENERAL NOTES
83256	FOUNDATION DATA
83257	FOUNDATION PLAN & DETAILS
83258	END BENT PLAN AND ELEVATION
83259	END BENT DETAILS
83260	WING WALL DETAILS
83261	BENTS 2 & 3 PLAN & ELEVATION
83262	BENTS 2 & 3 DETAILS
83263	DECK PLAN
83264	TYPICAL DECK SECTIONS & DETAILS
83265	SLAB SCHEDULE & DETAILS

**INDEX OF SHEETS
Bridge No. 21323**

Bridge Sheets	
DRAWING NO.	DESCRIPTION
83266	PLAN AND ELEVATION
83267	GENERAL NOTES
83268	FOUNDATION DATA
83269	FOUNDATION PLAN & DETAILS
83270	END BENT PLAN AND ELEVATION
83271	END BENT DETAILS
83272	WING WALL DETAILS
83273	BENTS 2 & 3 PLAN & ELEVATION
83274	BENTS 2 & 3 DETAILS
83275	DECK PLAN
83276	TYPICAL DECK SECTIONS & DETAILS
83277	SLAB SCHEDULE & DETAILS

Standard Drg. Nos.


- TM200 -Sign Installation Details
- TM201 -Miscellaneous Sign Placement Details
- TM500 -Pavement Marking Standard Detail Blocks
- TM502 -Pavement Marking Standard Detail Blocks
- TM515 -Raised Pavement Markers
- TM517 -Recessed Pavement Markers
- TM520 -Durable Pavement Markings Method "A" Profiled
- TM601 -Multi-Post Breakaway Sign Supports (Details)
- TM602 -Triangular Base Breakaway Sign Support (Multi-Directional Slip Base Design)
- TM635 -Breakaway Sign and Luminaire Supports (Location Guidelines)
- TM800 -Tables, Abrupt Edge, And PCMS Details
- TM810 -Temporary Reflective Pavement Markers
- TM820 -Temporary Barricades
- TM821 -Temporary Sign Supports
- TM830 -Temporary Concrete Barrier And Rumble Strip Details
- TM831 -Temporary Impact Attenuators
- TM860 -Freeway Sections
- RD140 -Roadway Cross Slopes Superelevated Sections
- RD300 -Trench Backfill, Bedding, Pipe Zone and Multiple Installations.
- RD317 -Culvert Embankment Protection
- RD326 -Coupling Bands for Corrugated Metal Pipe
- RD364 -Concrete Inlets Type G-1, G-2, G-2M, & G-2MA
- RD390 -Fill Height Table for HDPE Pipe
- RD400 -Guardrail And Metal Median Barrier
- RD405 -Guardrail And Metal Median Barrier Parts
- RD410 -Guardrail Parts (Thrie Beam)
- RD415 -Guardrail And Metal Median Barrier Parts
- RD420 -Energy Absorbing Terminal
- RD440 -Guardrail Installation At Bridge Ends
- RD450 -Guardrail Anchors (Steel)
- RD500 -Precast Concrete Barrier Pin and Loop Assembly
- RD610 -Asphalt Pavement Details
- RD700 -Curbs
- RD701 -Drainage Curbs
- RD1000 -Construction Entrances
- RD1005 -Check Dams
- RD1010 -Inlet Protection (Type 1, 2 and 3)
- RD1015 -Inlet Protection (Type 4) Biofilter Bags
- RD1035 -Sediment Barrier (Type 3)
- RD1040 -Sediment Fence, Supported Sediment Fence, Unsupported
- RD1055 -Matting
- BR165 -Bridge End Panel
- BR200 -Concrete Bridge Rail Type "F"
- BR203 -Transition Concrete Bridge Rail To Guardrail
- BR236 -Trailing End Bridge Connection Concrete Bridge Rail To Guardrail
- BR420 -26" Precast Prestressed Slab
- BR445 -Precast Prestressed Boxes And Slabs Details

No R/W Map No.

REVISED AS CONSTRUCTED
9/27/11 CONTRACT C14249

No.	DATE	REVISIONS	BY
1	04-15-10	Added standard drawings.	HJP

US26: EAST FORK DAIRY CR - MCKAY CR - BUNDLE 511		
SUNSET HIGHWAY WASHINGTON COUNTY		
FEDERAL HIGHWAY ADMINISTRATION	PROJECT NUMBER	SHEET NO.
OREGON DIVISION	I-88-071A-0047(077)	1A

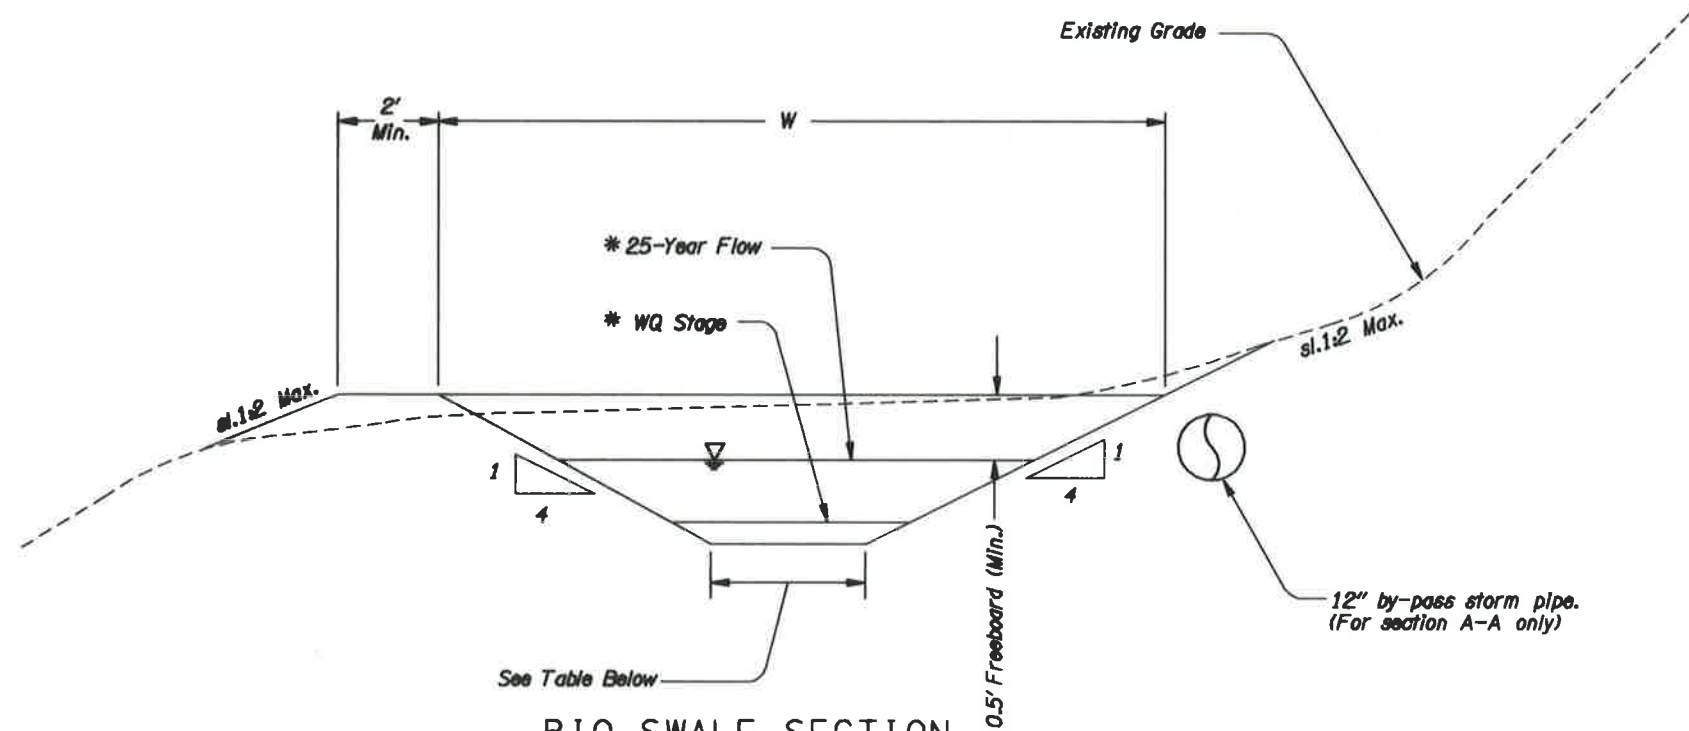

BIO-SWALE SECTION

Section A-A (see sheet, 4C)


Section B-B (see sheet, 4C)

Section C-C (see sheet, 3C)

Section D-D (see sheet, 3C)

*** BIO-SWALE'S DESIGN DATA:**

LOCATION	LENGTH	BOTTOM WIDTH	WQ STAGE	25-YR FL. STAGE	W
(BRIDGE-21322)					
SECTION A-A	134'	2'	0.2'	0.57'	10'
SECTION B-B	100'	4'	0.1'	0.33'	12'
(BRIDGE-21323)					
SECTION C-C	131'	2'	0.19'	0.55'	10'
SECTION D-D	100'	9'	0.06'	0.21'	17'

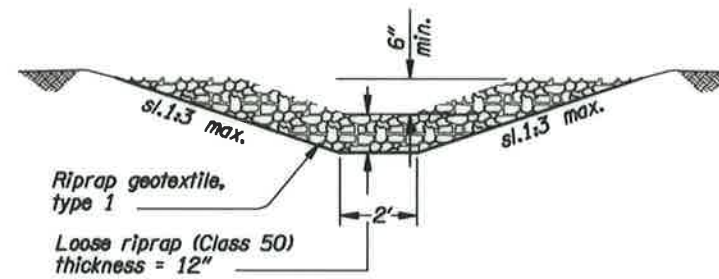

RIPRAP LINED DRAINAGE DITCH

Bio-swale specifications

1. Site stabilization - install surface runoff control measures. See site stabilization plans.
2. Seedbed preparation may include the following:
 - a. If infertile or coarse texture subsoil will be exposed during grading, stockpile topsoil and respread it over the finished slope and roll it to provide a firm seedbed.
 - b. If construction fills have left soil exposed with a loose, rough, or irregular surface, break with a chisel plow or other implement.
 - c. Topsoil to be installed as indicated on the site stabilization plans.
3. Do not apply fertilizers to areas within 50 feet of U.S. waters.

REVISED AS CONSTRUCTED
9/27/11 CONTRACT C14249

OREGON DEPARTMENT OF TRANSPORTATION

exeltech

Lacey, WA Seattle, WA Portland, OR


US20 EAST FORK DAIRY CR - MCKAY CR - BUNDLE 511

SUNSET HIGHWAY
WASHINGTON COUNTY

Design Team Leader - Karl Kirker


Designed By - Harold Peterfeso

Drafted By - Neil Henry

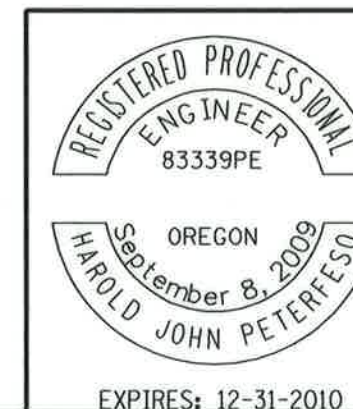

DRAINAGE DETAILS

SHEET NO.
2B-6

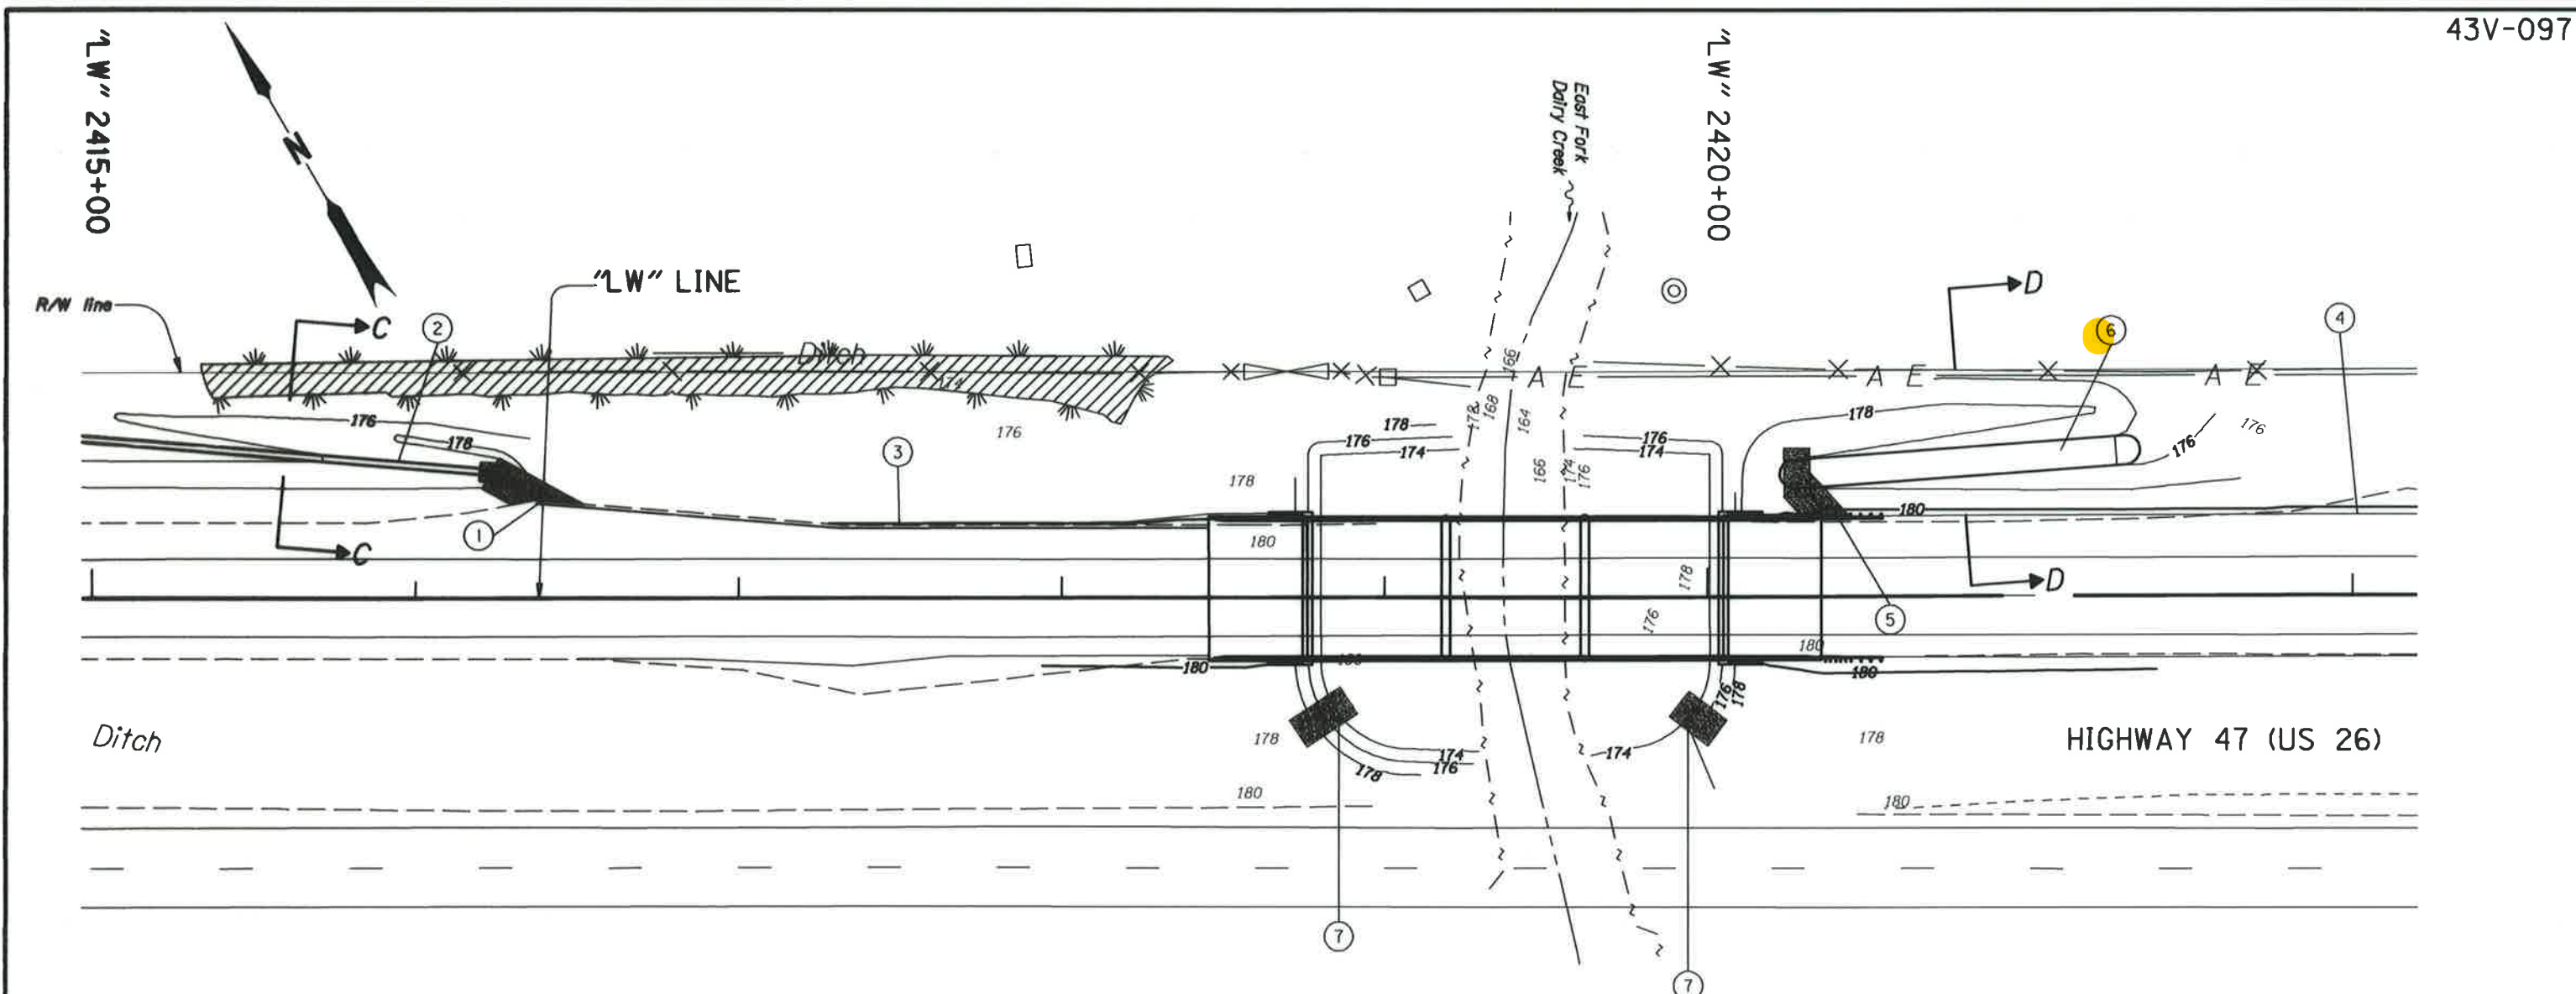

① Install riprap lined drainage ditch—7.3 c.y. riprap, class 50 (See detail, sheet 2B-6)
 Ditch exc.—8.7 c.y.
 Riprap geotextile, type 1—21.8 s.y.
 Sta. "LW" 2416+40.19, 30' Lt. to
 Sta. "LW" 2416+24.40, 38' Lt.

② Construct swale
 2' bottom width, 131 lf.
 S=0.0200'/Ft.
 Ditch exc.—14.0 c.y.
 Emb.—85.0 c.y.
 (See bio-swale section sheet 2B-6)
 Sta. "LW" 2416+24.70, 39' Lt. (beg. bio-swale)
 Sta. "LW" 2414+95.10, 50' Lt. (end bio-swale)
 Beg. El.=177.05
 End El.=174.43
 Const. 6'Wx5'Lx12"D class 50 riprap pad at beginning—1.0 c.y.
 Ditch exc.—1.0 c.y.
 Riprap geotextile, type 1—3.3 s.y.

③ See sht. 3, note 6.

④ See sht. 3, note 7


⑤ Install riprap lined drainage ditch—4.2 c.y. riprap, class 50 (See detail, sheet 2B-6)
 Ditch exc.—5.0 c.y.
 Riprap geotextile, type 1—12.7 s.y.
 Sta. "LW" 2420+35.81, 24' Lt. to
 Sta. "LW" 2420+30.50, 32' Lt.

⑥ Construct swale
 9' bottom width, 100 lf.
 S=0.0200'/Ft.
 Ditch exc.—36.0 c.y.
 Emb.—116.0 c.y.
 (See bio-swale section sheet 2B-6)
 Sta. "LW" 2420+27.04, 38' Lt. (beg. bio-swale)
 Sta. "LW" 2421+29.82, 45' Lt. (end bio-swale)
 Beg. El.=178.00
 End El.=176.00
 Const. 15'Wx8'Lx12"D class 50 riprap pad at beginning—4.5 c.y.
 Ditch exc.—4.5 c.y.
 Riprap geotextile, type 1—13.3 s.y.

⑦ Construct riprap ditch—12.6 c.y. riprap, class 50
 Ditch exc.—24.4 c.y.
 Riprap geotextile, type 1—37.7 s.y.
 Sta. "LW" 2418+73, 42' Rt. to Sta. "LW" 2418+89, 32' Rt.
 Sta. "LW" 2419+91, 33' Rt. to Sta. "LW" 2420+03, 42' Rt.
 (See detail, sheet 2B-5).

Note:
 For sections C-C & D-D see sheet 2B-6.

REVISED AS CONSTRUCTED
 9/27/11 CONTRACT C14249

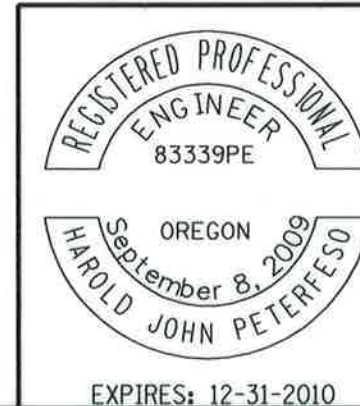

OREGON DEPARTMENT OF TRANSPORTATION

exeltech

Lacey, WA Seattle, WA Portland, OR



US26: EAST FORK DAIRY CR - MCKAY CR - BUNDLE 511

SUNSET HIGHWAY
 WASHINGTON COUNTY

Design Team Leader - Karl Kirker
 Designed By - Harold Peterfeso
 Drafted By - Nell Henry

**DRAINAGE AND RUNOFF
 TREATMENT PLAN**

SHEET
 NO.
3C

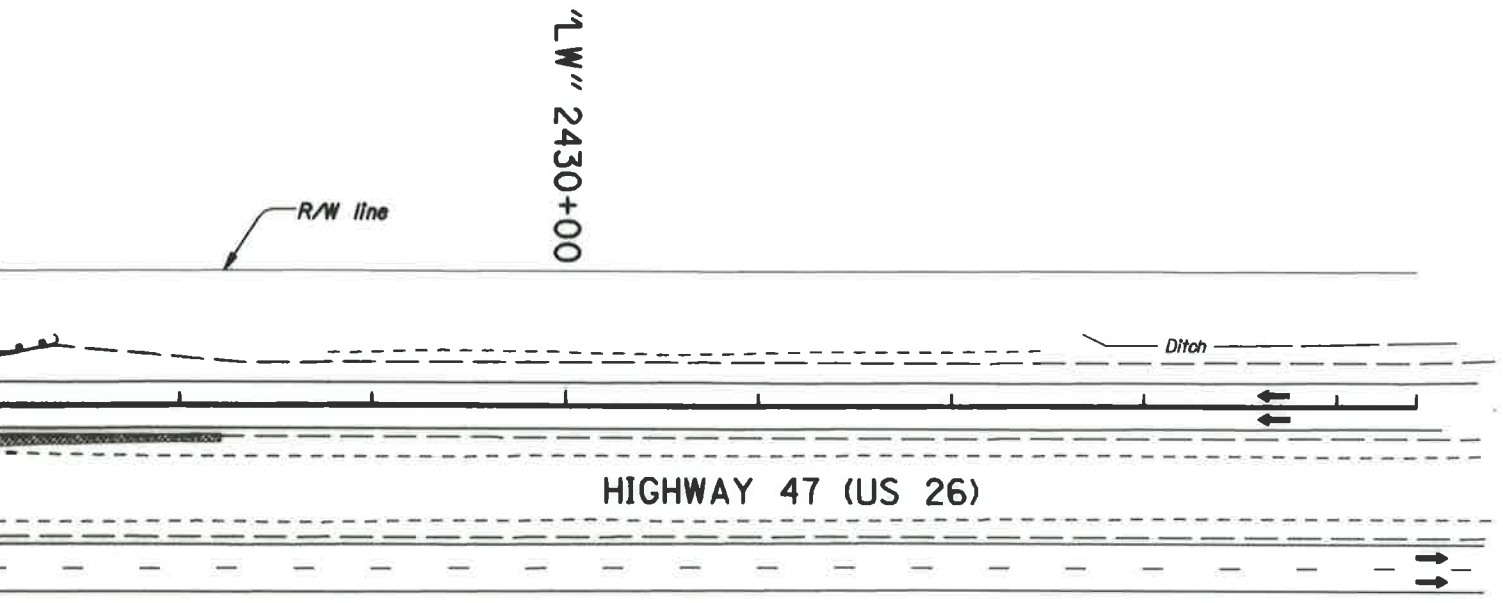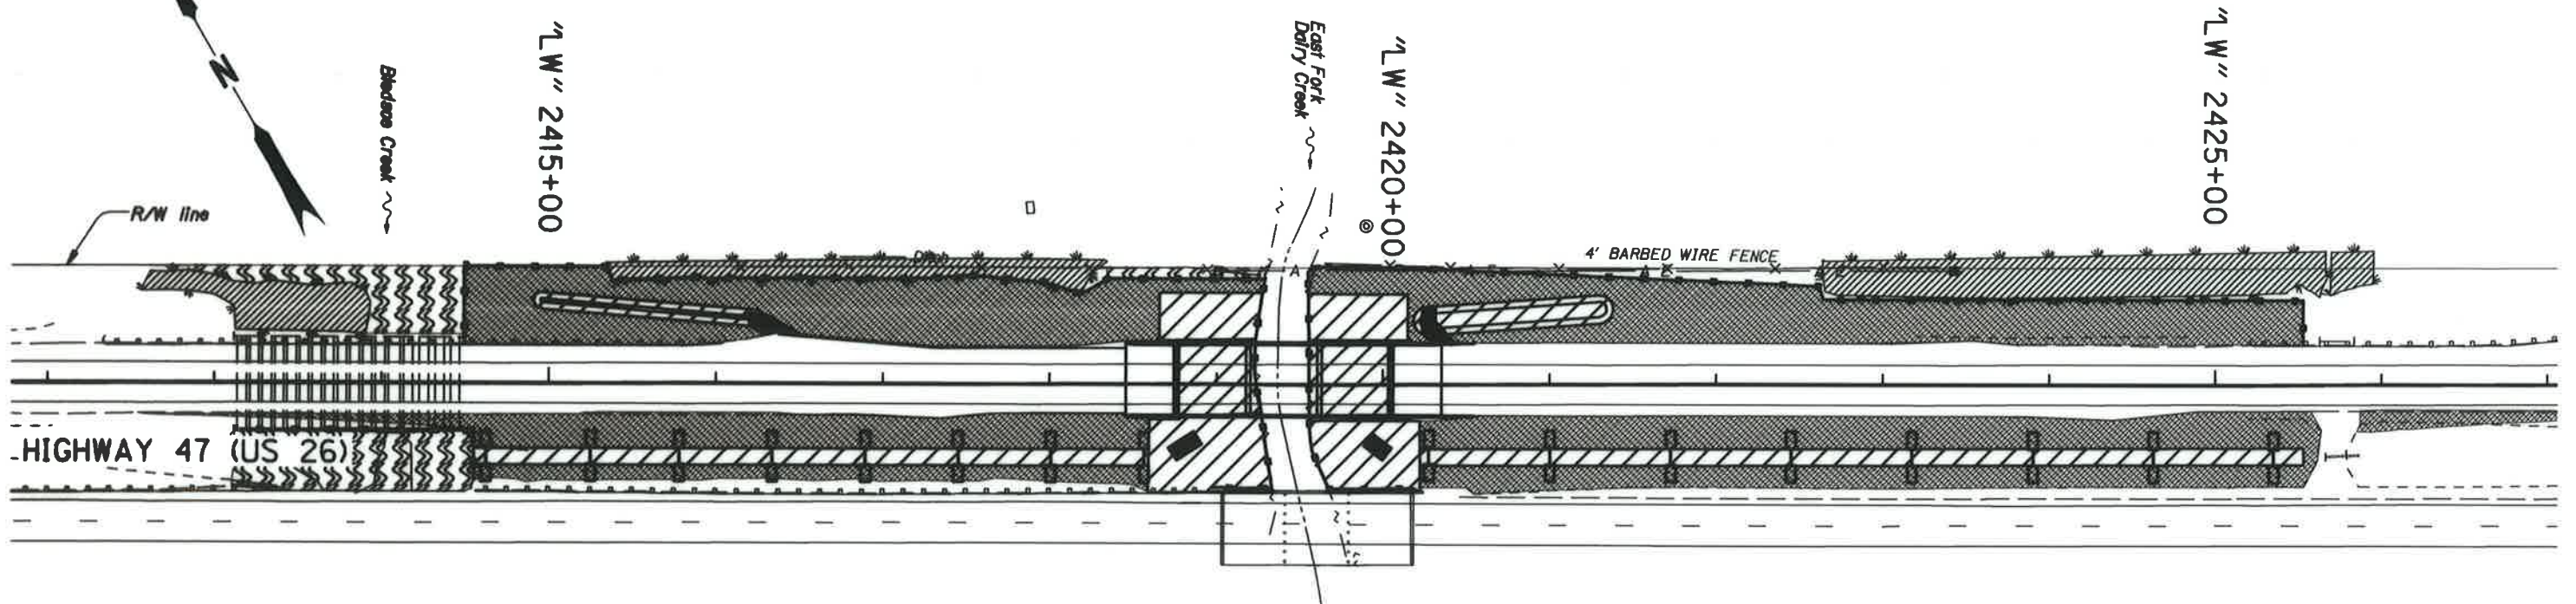


LEGEND

	Bioswale
	Wetland boundary
	Biodegradable matting over 6" of topsoil See Drg. No. RD1055 See general notes.
	Temporary mulching See general notes.
	12" Check dam See Drg. No. RD1005
	Riprap
	No work area
	Sediment Fence, supported

GENERAL NOTES:

1. See sheet 2B-6 for seedbed preparation to be applied at areas with matting and temporary mulching.

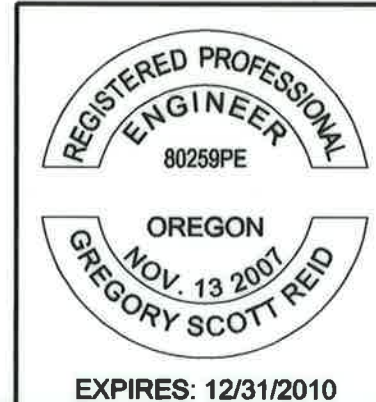

REVISED AS CONSTRUCTED
9/27/11 CONTRACT C14249

OREGON DEPARTMENT OF TRANSPORTATION

exeltech
Lacey, WA Seattle, WA Portland, OR

US26: EAST FORK DAIRY CR - MCKAY CR - BUNDLE 511
SUNSET HIGHWAY
WASHINGTON COUNTY








Design Team Leader - Kari Kirker
Designed By - Harold Peterfeso
Drafted By - Neil Henry

SITE STABILIZATION PLAN



SHEET NO. GA-3

Sec. 34, T. 2 N, R. 3 W, WM

LEGEND

-  Biodegradable matting
See Drg. No. RD1055
Slope application
-  Proposed riprap
-  Temporary Mulching
-  No work area
-  Riprap
-  Check dam
See Drg. No. RD1005.
-  Sediment Fence, supported

HIGHWAY 47 (US 26)

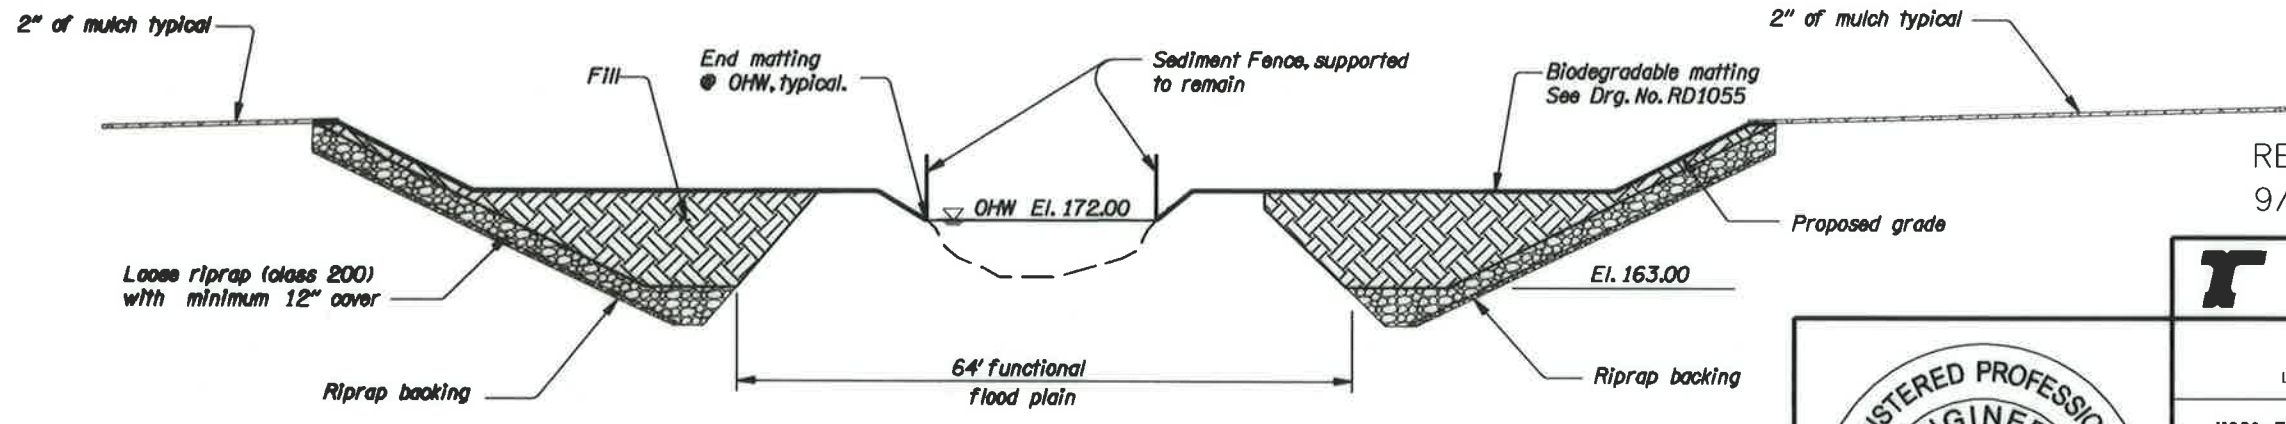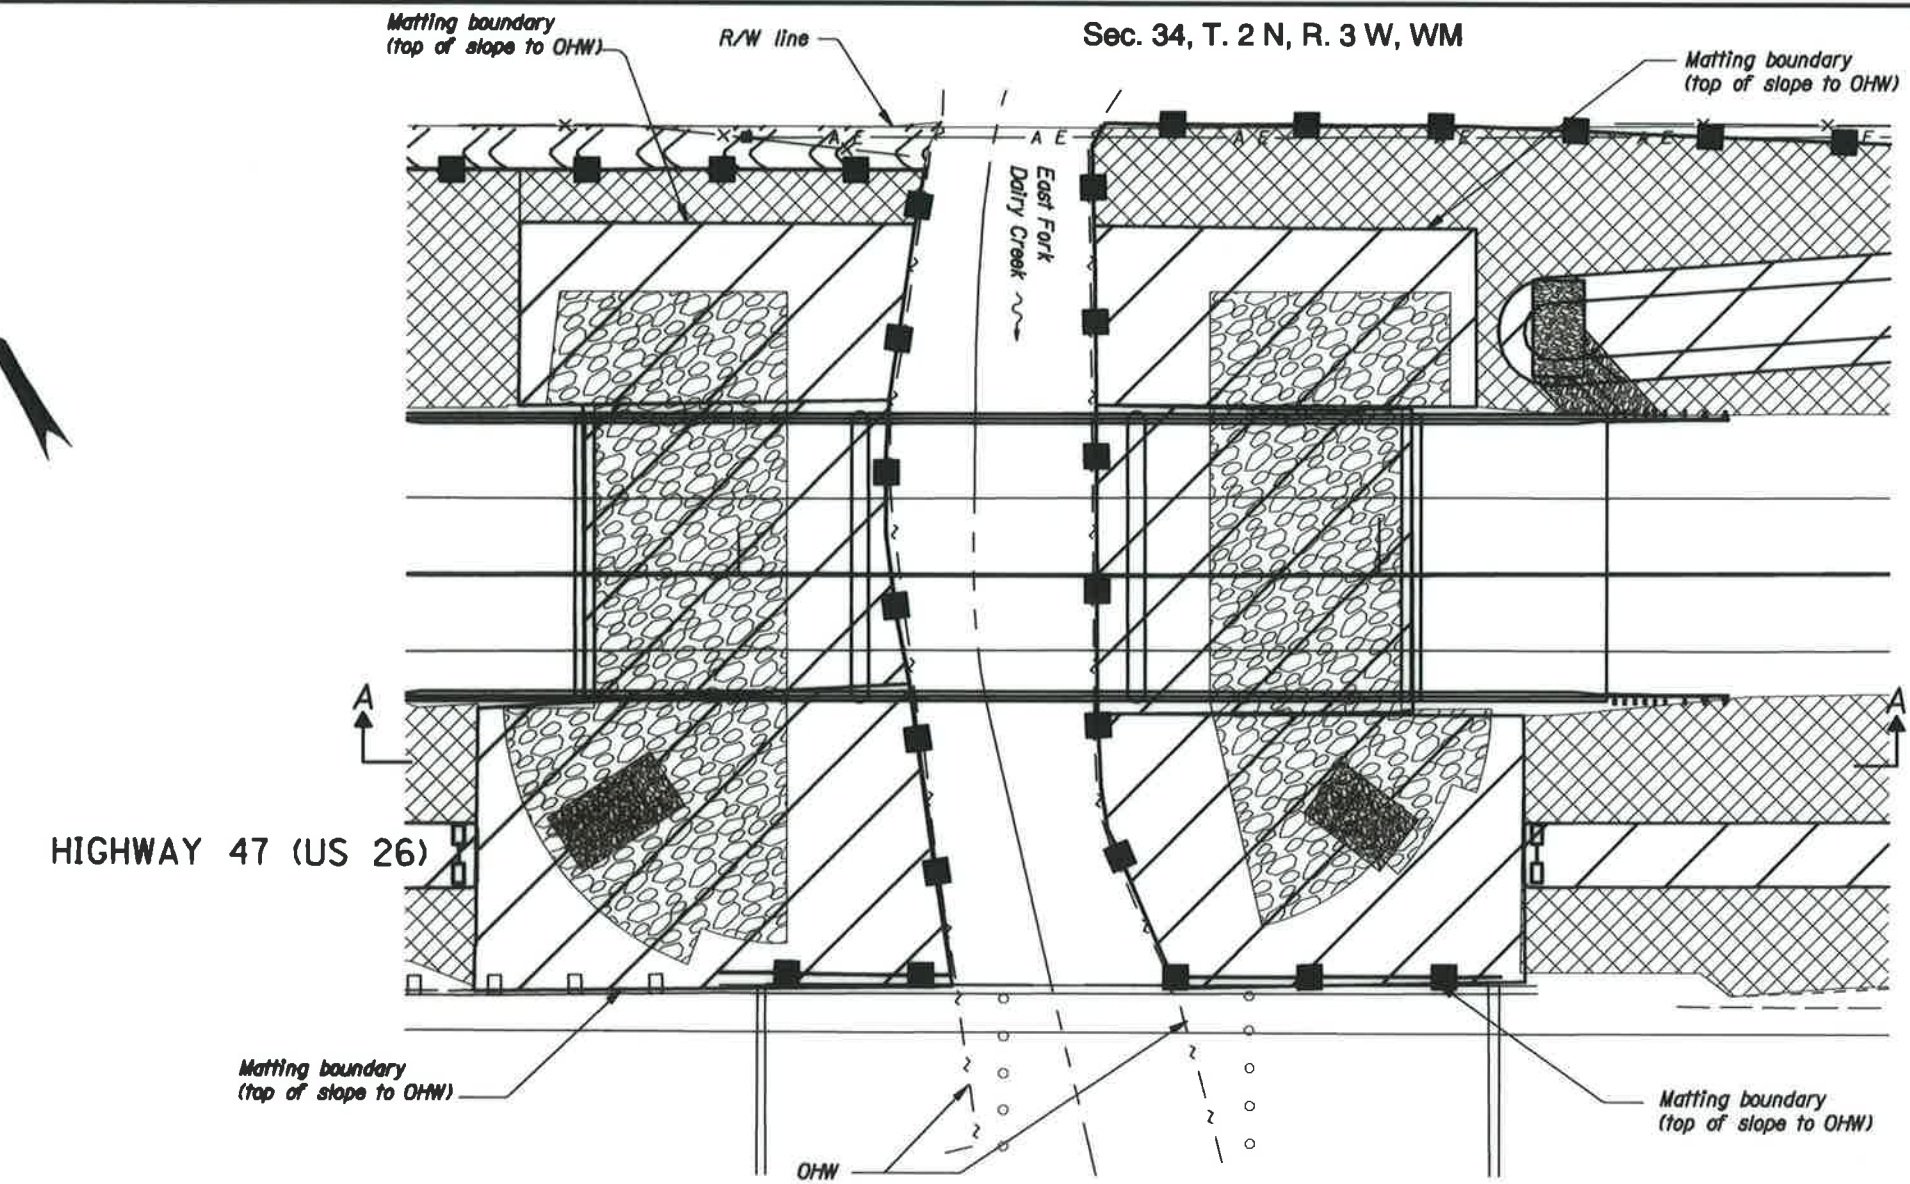

SECTION A-A

REVISED AS CONSTRUCTED
9/27/11 CONTRACT C14249

OREGON DEPARTMENT OF TRANSPORTATION

exeltech

Lacey, WA Seattle, WA Portland, OR


US20: EAST FORK DAIRY CR - MCKAY CR - BUNDLE 511
SUNSET HIGHWAY
WASHINGTON COUNTY

Design Team Leader - Karl Kirker
Designed By - Harold Peterfeso
Drafted By - Nell Henry

STREAMBANK STABILIZATION PLAN

SHEET NO.
GA-4



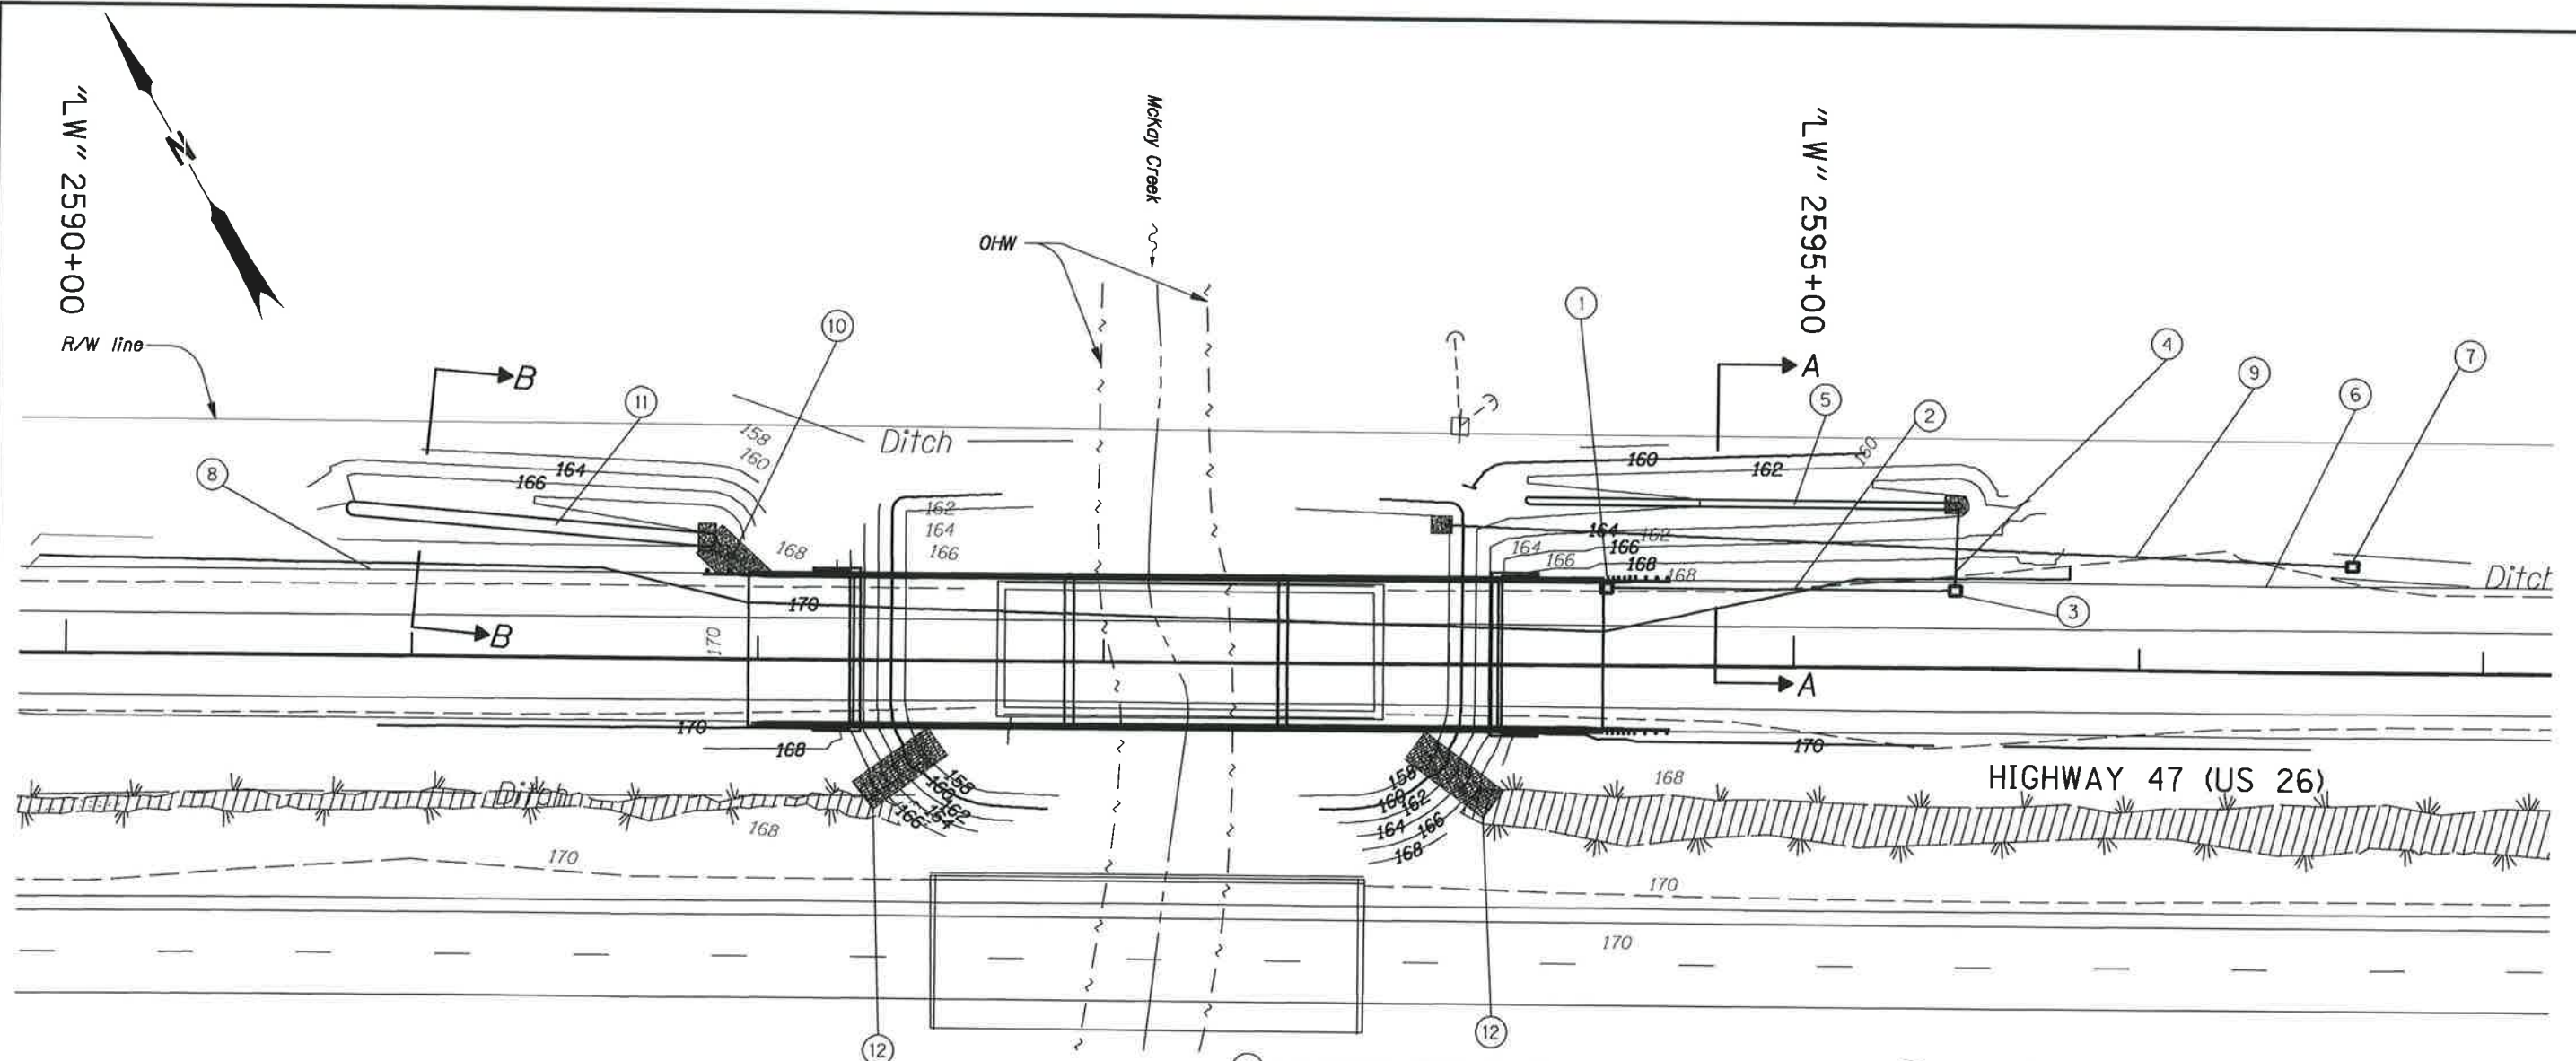

① Sta. "LW" 2594+46.50, 22.63' Lt.
Install type G-1 inlet
Rim El.=169.72
Inv. El.=166.72
(See Drg. No. RD364)

② Install 12 inch HDPE pipe-100 l.f.
S=0.0100'/Ft.
3' deep.
(See Drg. No. RD300, RD390)

③ Sta. "LW" 2595+46.00, 22.23' Lt.
Install type G-1 inlet
Rim El.=170.20
Inv. El.=165.72

④ Sta. "LW" 2593+45.42, 46' Lt.
Install 12 inch HDPE pipe-22 l.f.
S=0.1009'/Ft.
3' deep and daylight to bio-swale end
(See Drg. No. RD300, RD390)

⑤ Construct swale
2' bottom width, 134 l.f.
S=0.0200'/Ft.
Ditch exc.-25.0 c.y.
Emb.-422.0 c.y.
(See bio-swale section, sheet 2B-6)
Sta. "LW" 2595+45.38, 47' Lt. (beg. bio-swale)
Sta. "LW" 2594+18.07, 47' Lt. (end bio swale)
Beg. El.=163.50
End El.=160.88
Const. 10'Wx5'Lx12"D Class 50 riprap pad at beginning-1.9 c.y.
Ditch exc.-1.9 c.y.
Riprap geotextile, type 1-5.6 s.y.

⑥ See sht 4, note 9.

⑦ Sta. "LW" 2596+61.85, 29' Lt.
Install type G-2MA inlet
Rim El.=168.90±
Inv. El.=165.40.
Location and elevation to be field verified,
if relocation is necessary submit to engineer
for approval.
(See Drg. No. RD364)

⑧ See sht. 4, note 8.


⑨ Install 12 inch HDPE pipe-262 l.f.
S=0.0282'/Ft.
3.5' deep and daylight to grade
End Sta. "LW" 2594+00.19, 40' Lt.
Const. 6'Wx5'Lx12"D class 50 riprap pad at outlet-1.0 c.y.
(See Drg. No. RD300, RD317, RD390)
Ditch exc.-1.0 c.y.
Riprap geotextile, type 1-3.3 s.y.

⑩ Install riprap lined drainage ditch-5.2 c.y. riprap, class 50
(See detail, sheet 2B-6)
Ditch exc.-6.3 c.y.
Riprap geotextile, type 1-15.6 s.y.
Sta. "LW" 2591+97.19, 24' Lt. to
Sta. "LW" 2591+87.30, 33' Lt.

⑪ Construct swale
4' Bottom Width, 100 l.f.
S=0.0200'/Ft.
Ditch exc.-14.0 c.y.
Emb.-151.0 c.y.
(See bio-swale section, sheet 2B-6)
Sta. "LW" 2591+85.61, 35' Lt. (beg. bio-swale)
Sta. "LW" 2590+82.85, 43' Lt. (end bio swale)
Beg. El.=168.00
End El.=166.00
Const. 8'Wx5'Lx12"D class 50 riprap pad at beginning-1.5 c.y.
Ditch exc.-1.5 c.y.
Riprap geotextile, type 1-4.4 s.y.

⑫ Construct riprap ditch-20.5 c.y. riprap, class 50
Ditch exc.-40.7 c.y.
Riprap geotextile, type 1-61.3 s.y.
Sta. "LW" 2592+30.39' Rt. to Sta. "LW" 2592+52, 23' Rt.
Sta. "LW" 2593+90, 23' Rt. to Sta. "LW" 2594+12, 41' Rt.
(See detail, sheet 2B-5)

Note:
For sections A-A & B-B see sheet 2B-6.

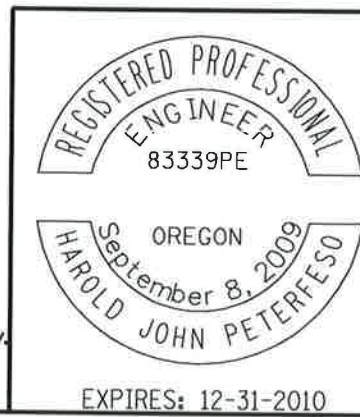


REVISED AS CONSTRUCTED
9/27/11 CONTRACT C14249



exeltech		
Laasy, WA	Seattle, WA	Portland, OR
US26: EAST FORK DAIRY CR - MCKAY CR - BUNDLE 511		
SUNSET HIGHWAY WASHINGTON COUNTY		
Design Team Leader - Kari Kirker Designed By - Harold Peterfeso Drafted By - Neil Henry		
DRAINAGE AND RUNOFF TREATMENT PLAN		SHEET NO. 4C

Sec. 7, T. 1 N, R. 2 W, WM

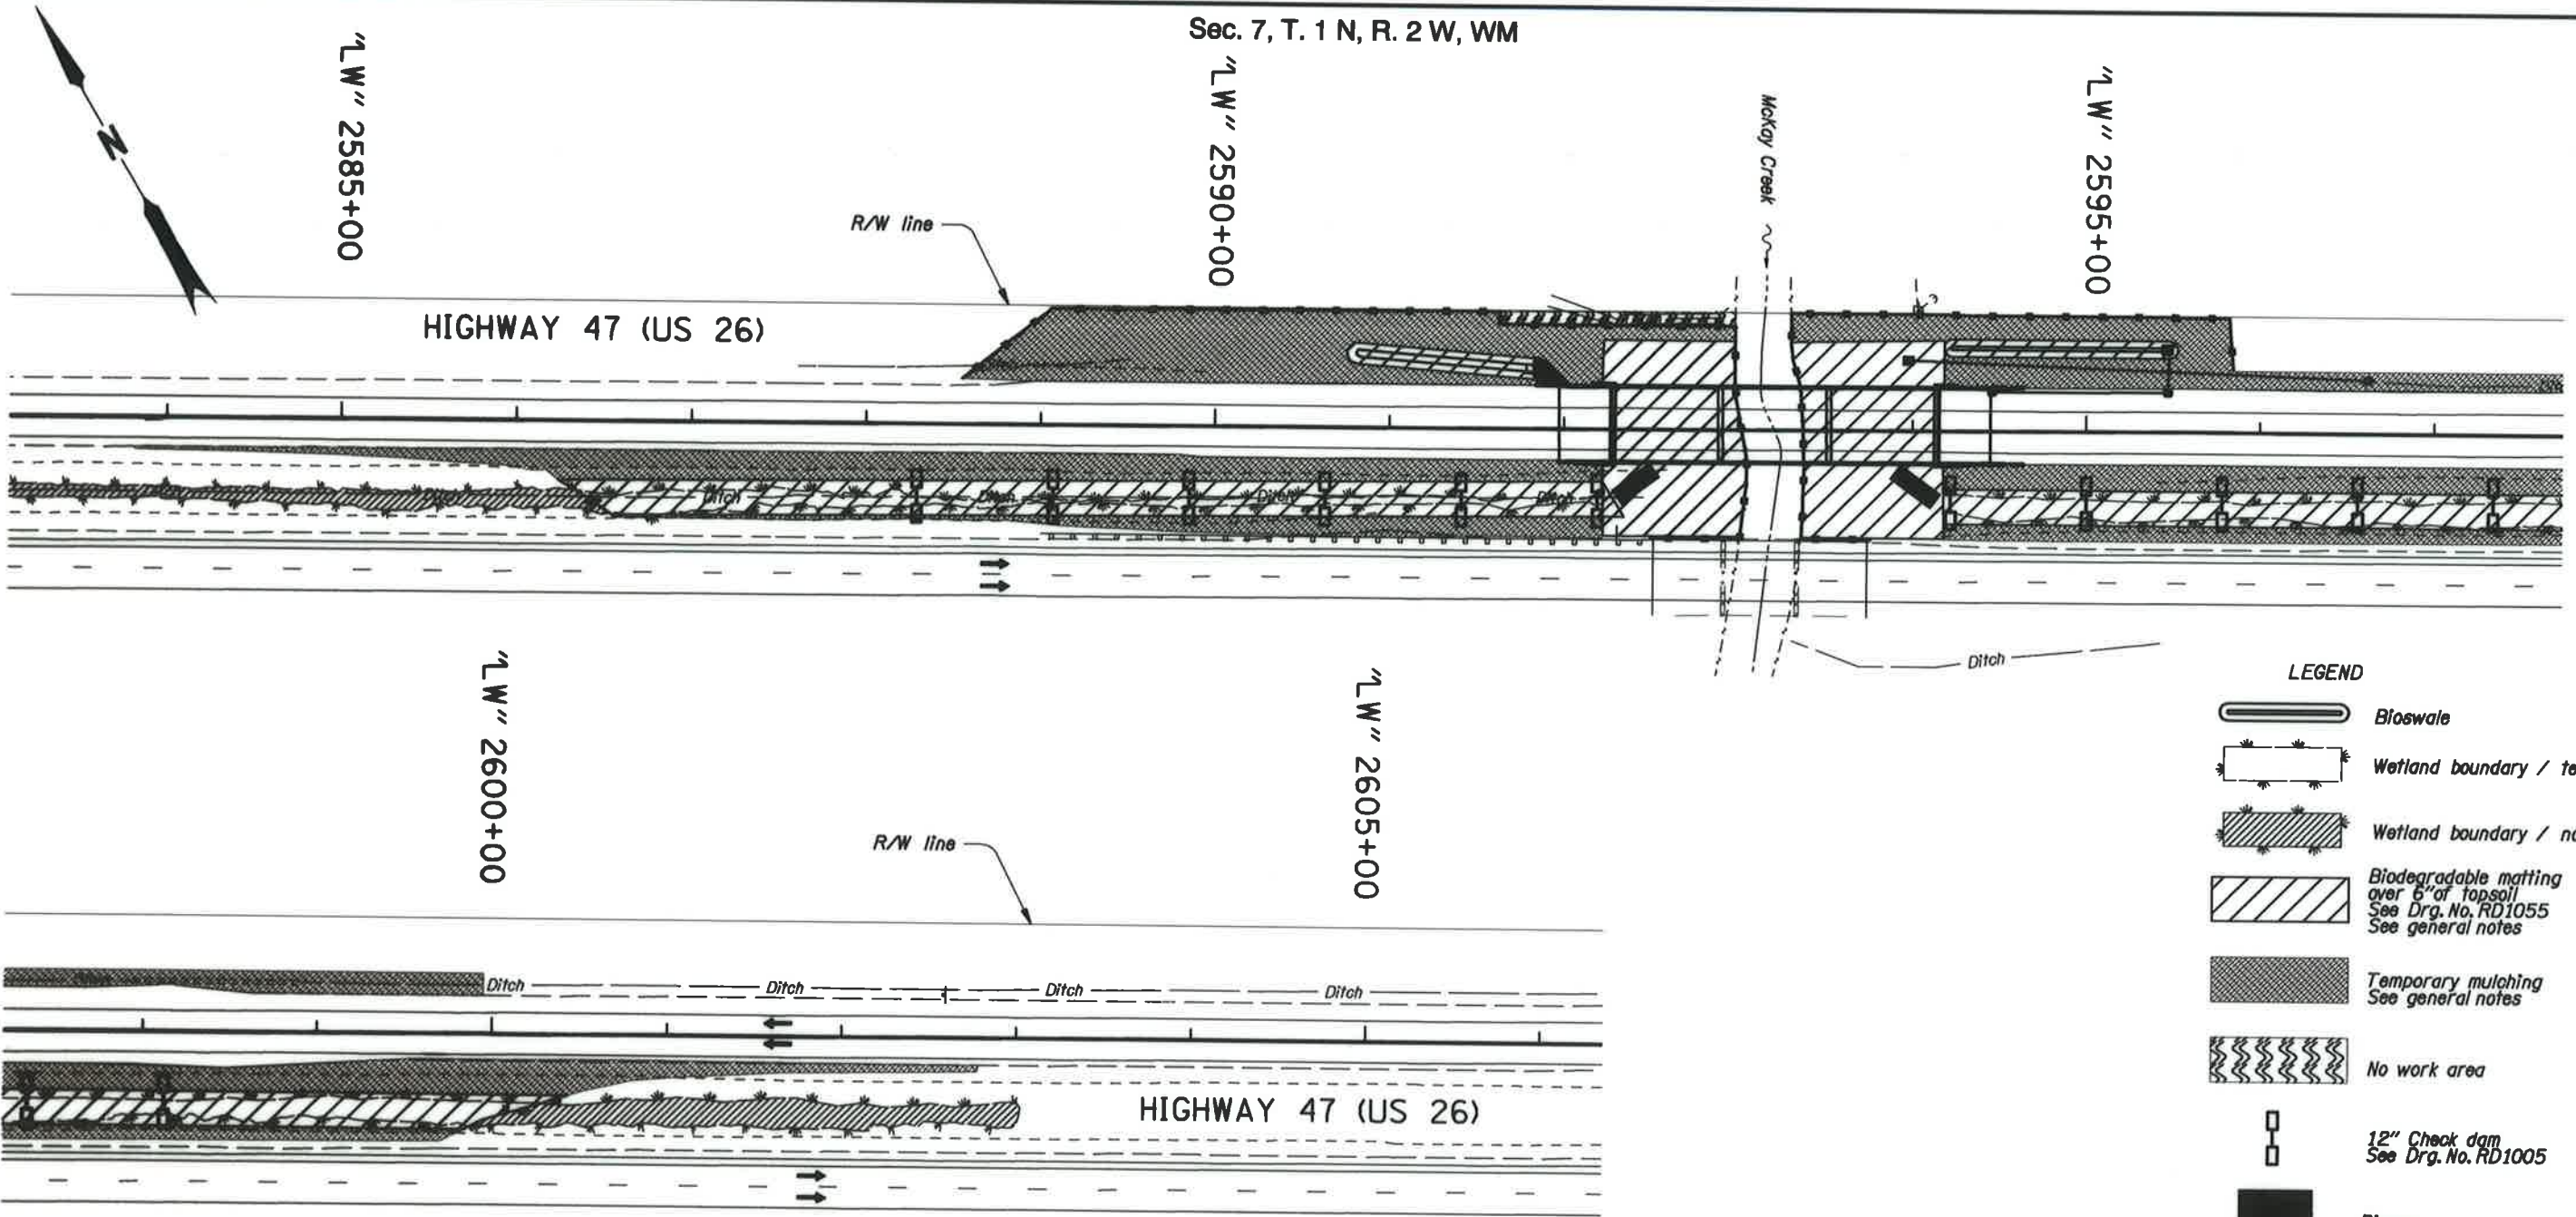

LEGEND

- Blowwale
- Wetland boundary / temporary impact
- Wetland boundary / no impact
- Biodegradable matting over 6" of topsoil
See Drg. No. RD1055
See general notes
- Temporary mulching
See general notes
- No work area
- 12" Check dam
See Drg. No. RD1005
- Riprap
- Sediment Fence, supported

GENERAL NOTES:

1. See sheet 2B-6 for seedbed preparation to be applied at areas with matting and temporary mulching.

REGISTERED PROFESSIONAL
ENGINEER
80259PE

OREGON
NOV. 13 2007
GREGORY SCOTT REID

EXPIRES: 12/31/2010

OREGON DEPARTMENT OF TRANSPORTATION

exelitech

Laasy, WA Seattle, WA Portland, OR

US26: EAST FORK DAIRY CR - MCKAY CR - BUNDLE 511
SUNSET HIGHWAY
WASHINGTON COUNTY


Design Team Leader - Kari Kirker
Designed By - Harold Peterfeso
Drafted By - Neil Henry

SITE STABILIZATION PLAN







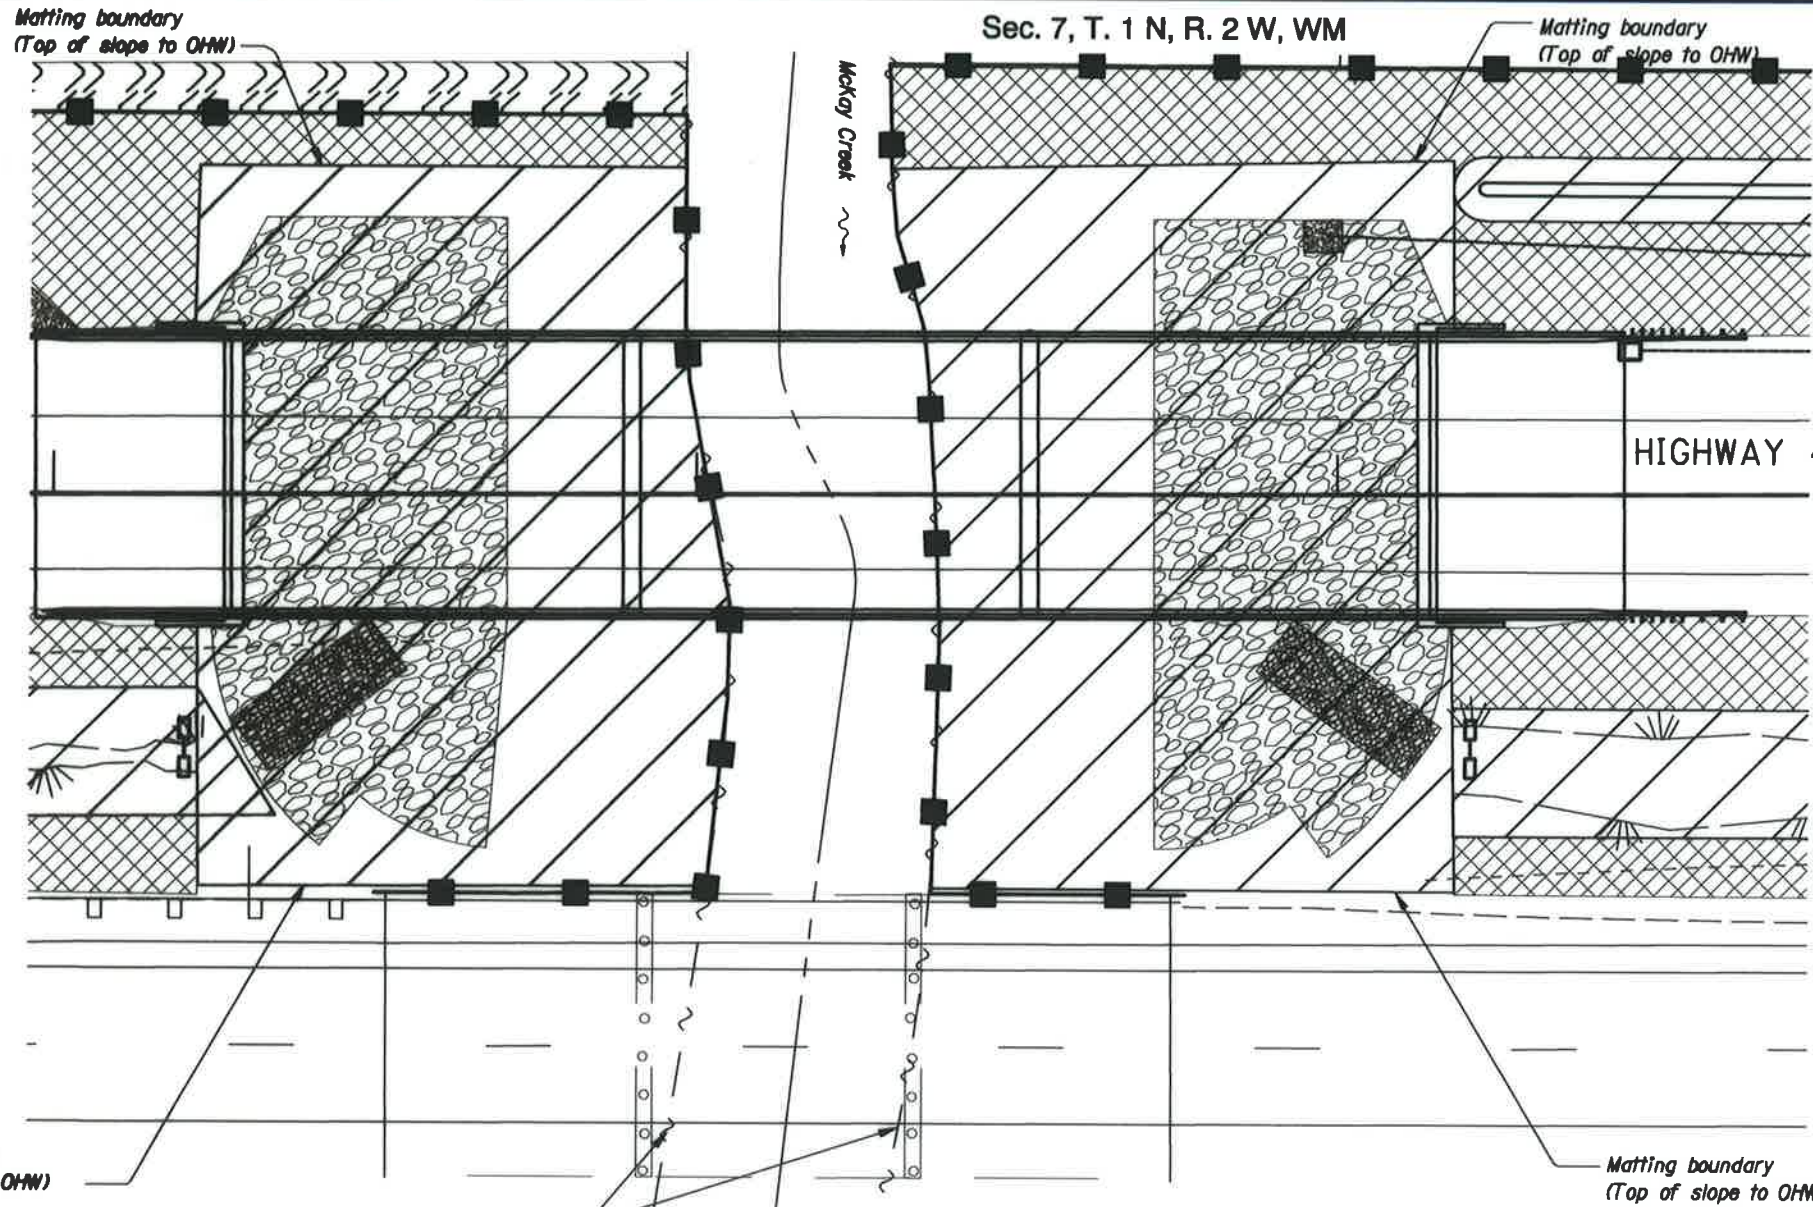

SHEET NO.
GA-5


REVISED AS CONSTRUCTED
9/27/11 CONTRACT C14249

Sec. 7, T. 1 N, R. 2 W, WM



LEGEND

-  Biodegradable matting
See Drg. No. RD1055
Slope application
-  Proposed riprap
-  Temporary mulching
-  No work area
-  Wetland boundary / temporary impact
-  Check dam
See Drg. No. RD1005.
-  Riprap
-  Sediment Fence, supported

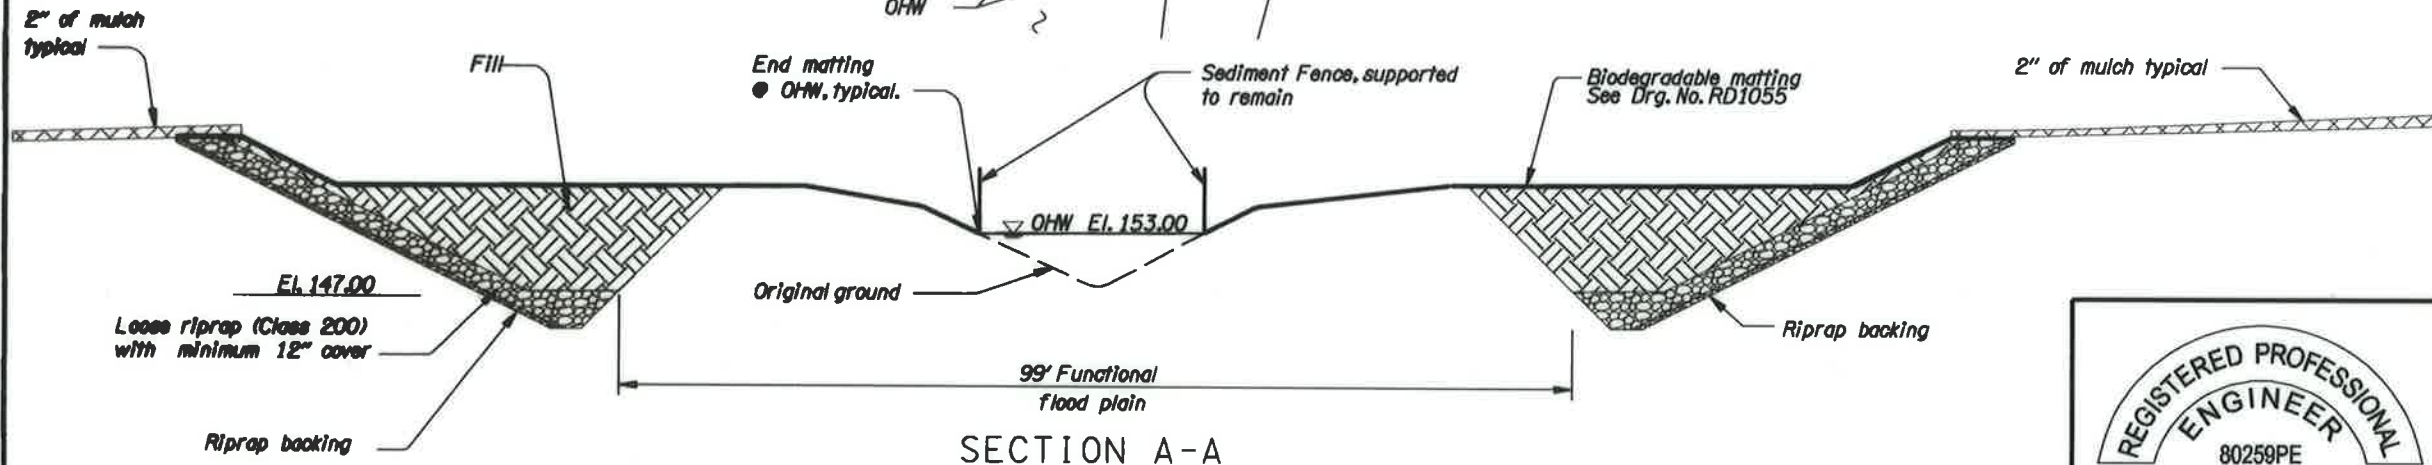

REVISED AS CONSTRUCTED
9/27/11 CONTRACT C14249

OREGON DEPARTMENT OF TRANSPORTATION

exeltech

Lahey, WA Seattle, WA Portland, OR

US26: EAST FORK DAIRY CR - MCKAY CR - BUNDLE 511

SUNSET HIGHWAY
WASHINGTON COUNTY

Design Team Leader - Kari Kirker
Designed By - Harold Peterfeso
Drafted By - Nell Henry

**STREAMBANK
STABILIZATION
PLAN**

SHEET
NO.

GA-6

REGISTERED PROFESSIONAL
ENGINEER
80259PE

OREGON
NOV. 13 2007
GREGORY SCOTT REID

EXPIRES: 12/31/2010