

# **OPERATION & MAINTENANCE MANUAL**

**DFI No. : D00900**

**Facility Type: Water Quality  
Biofiltration Swale**



**December, 2018**

**INDEX**

**1. IDENTIFICATION..... 1**

**2. FACILITY CONTACT INFORMATION..... 1**

**3. CONSTRUCTION..... 1**

**4. STORM DRAIN SYSTEM AND FACILITY OVERVIEW ..... 2**

**5. FACILITY HAZ MAT SPILL FEATURE(S)..... 2**

**6. AUXILIARY OUTLET (HIGH FLOW BYPASS)..... 2**

**7. MAINTENANCE REQUIREMENTS..... 3**

**8. WASTE MATERIAL HANDLING..... 4**

**APPENDIX A: Operational Plan and Profile Drawing(s)**

**APPENDIX B: ODOT Project Plan Sheets**

## 1. Identification

Drainage Facility ID (DFI): **D00900**  
Facility Type: Water Quality Biofiltration Swale  
Construction Drawings: 43V-169  
Location: District: 07  
Highway No.: 241  
Mile Post: 0.60/0.62 (beg./end), Left  
Description: This facility is located along the east shoulder of OR 241 southbound behind concrete barrier.

## 2. Facility Contact Information

Contact the Engineer of Record, Region Technical Center, or Geo-Environmental's Senior Hydraulics Engineer for:

- Operational clarification
- Maintenance clarification
- Repair or restoration assistance

### Engineering Contacts:

Region Technical Center Hydro Unit Manager

Or

Geo-Environmental Senior Hydraulics Engineer (503) 986-3365.

## 3. Construction

Engineer of Record: Chris Blevins – Region 3 Tech Center, Roseburg

Facility construction: 2010

#### **4. Storm Drain System and Facility Overview**

A water quality swale is a flat-bottomed open channel designed to treat stormwater runoff from highway pavement areas. This type of facility is lined with grass. Treatment by trapping sedimentation occurs when stormwater runoff flows through the grass.

This facility is located along the east should of southbound OR 241. Access for this facility is available from the roadside shoulder and a nearby vehicle pullout. Stormwater enters the facility via roadway runoff and stormwater inlets located along the eastern side of southbound OR 241. As the water flows north it is treated as it slows and spreads out within the swale before out falling into Isthmus Slough.

A. Maintenance equipment access:

This facility can be accessed from the southbound OR 241 shoulder and nearby vehicle pull out.

B. Heavy equipment access into facility:

- Allowed (no limitations)
- Allowed (with limitations)
- Not allowed

C. Special Features:

- Amended Soils
- Porous Pavers
- Liners
- Underdrains

#### **5. Facility Hazmat Spill Feature(s)**

The water quality biofiltration swale can be used to store a volume of liquid by blocking the facility outlet through use of sandbags.

#### **6. Auxiliary Outlet (High Flow Bypass)**

Auxiliary Outlets are provided if the primary outlet control structure cannot safely pass the projected high flows. Broad-crested spillway weirs and over flow risers are the two most common auxiliary outlets used in stormwater treatment facility design. The auxiliary outlet feature is either a part of the facility or an additional storm drain feature/structure.

The auxiliary outlet feature for this facility is:

Designed into facility

Other

There are no auxiliary outlets built into this facility. In the event that flows exceed design flows the water will overtop the swale.

## 7. Maintenance Requirements

Routine maintenance table for non-proprietary stormwater treatment and storage/detention facilities have been incorporated into ODOT's Maintenance Guide. These tables summarize the maintenance requirements for ponds, swales, filter strips, bioslopes, and detention tanks and vaults. Special maintenance requirements in addition to the routine requirements are noted below when applicable.

The ODOT Maintenance Guide can be viewed at the following website:

<http://www.oregon.gov/ODOT/HWY/OOM/MGuide.shtml>

Maintenance requirements for proprietary structures, such as underground water quality manholes and/or vaults with filter media are noted in Appendix C when applicable.

The following stormwater facility maintenance table (See ODOT Maintenance Guide) should be used to maintain the facility outlined in this Operation and Maintenance Manual or follow the Maintenance requirements outlined in Appendix C when proprietary structure is selected below:

- Table 1 (general maintenance)
- Table 2 (stormwater ponds)
- Table 3 (water quality biofiltration swales)
- Table 4 (water quality filter strips)
- Table 5 (water quality bioslopes)
- Table 6 (detention tank)
- Table 7 (detention vault)
- Appendix C (proprietary structure)
- Special Maintenance requirements:

Note: Special maintenance Requirements Require Concurrence from ODOT SR Hydraulics Engineer.

## 8. Waste Material Handling

Material removed from the facility is defined as waste by the Department of Environment Quality (DEQ). Refer to the road waste section of the ODOT Maintenance Yard Environmental Management System (EMS) Policy and Procedures Manual for disposal options:

[http://www.oregon.gov/ODOT/Maintenance/Documents/ems\\_manual.pdf](http://www.oregon.gov/ODOT/Maintenance/Documents/ems_manual.pdf)




Contact any of the following for more detailed information about management of waste materials found on site:

ODOT Clean Water Unit	(503) 986-3008
ODOT Statewide Hazmat Coordinator	(503) 667-7442
ODOT Region 1 Hazmat Coordinator	(503) 731-8290
ODOT Region 2 Hazmat Coordinator	(503) 986-2647
ODOT Region 3 Hazmat Coordinator	(541) 957-3594
ODOT Region 4 Hazmat Coordinator	(541) 388-6186
ODOT Region 5 Hazmat Coordinator	(541) 963-1590
ODEQ Northwest Region Office	(503) 229-5263

# **Appendix A**

## **Content:**

- **Operational Plan and Profile Drawing(s)**

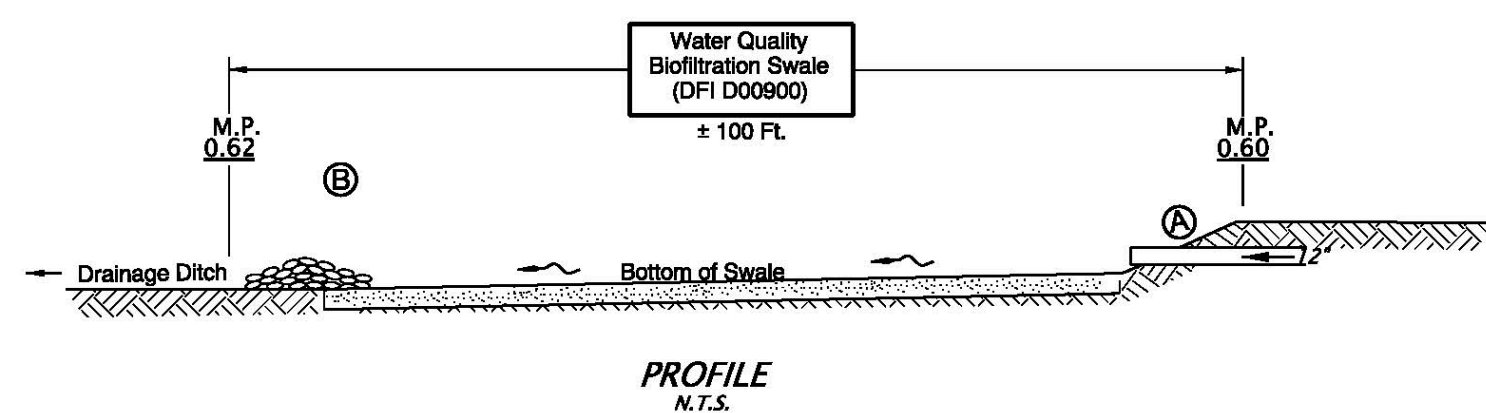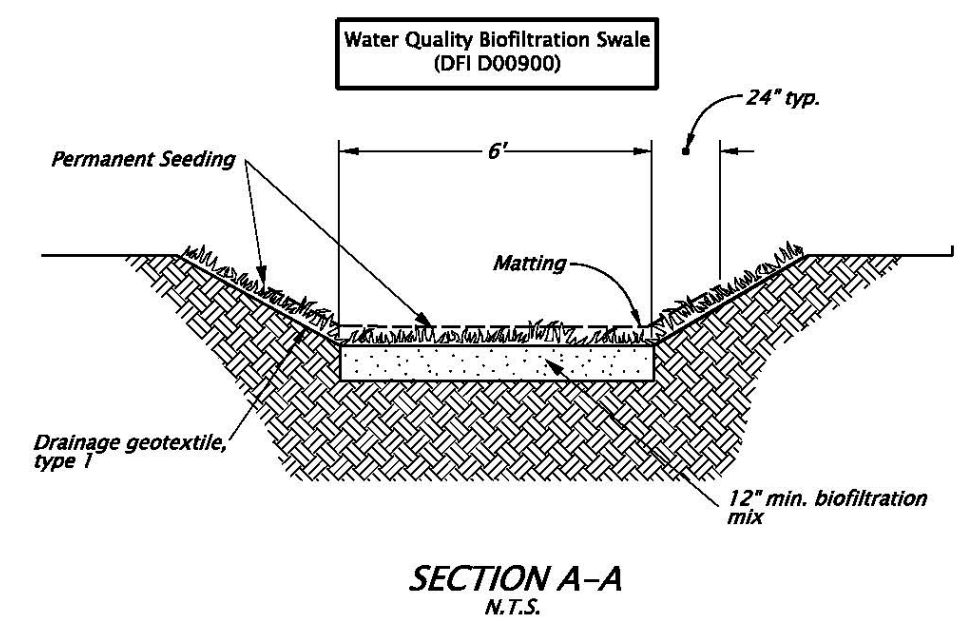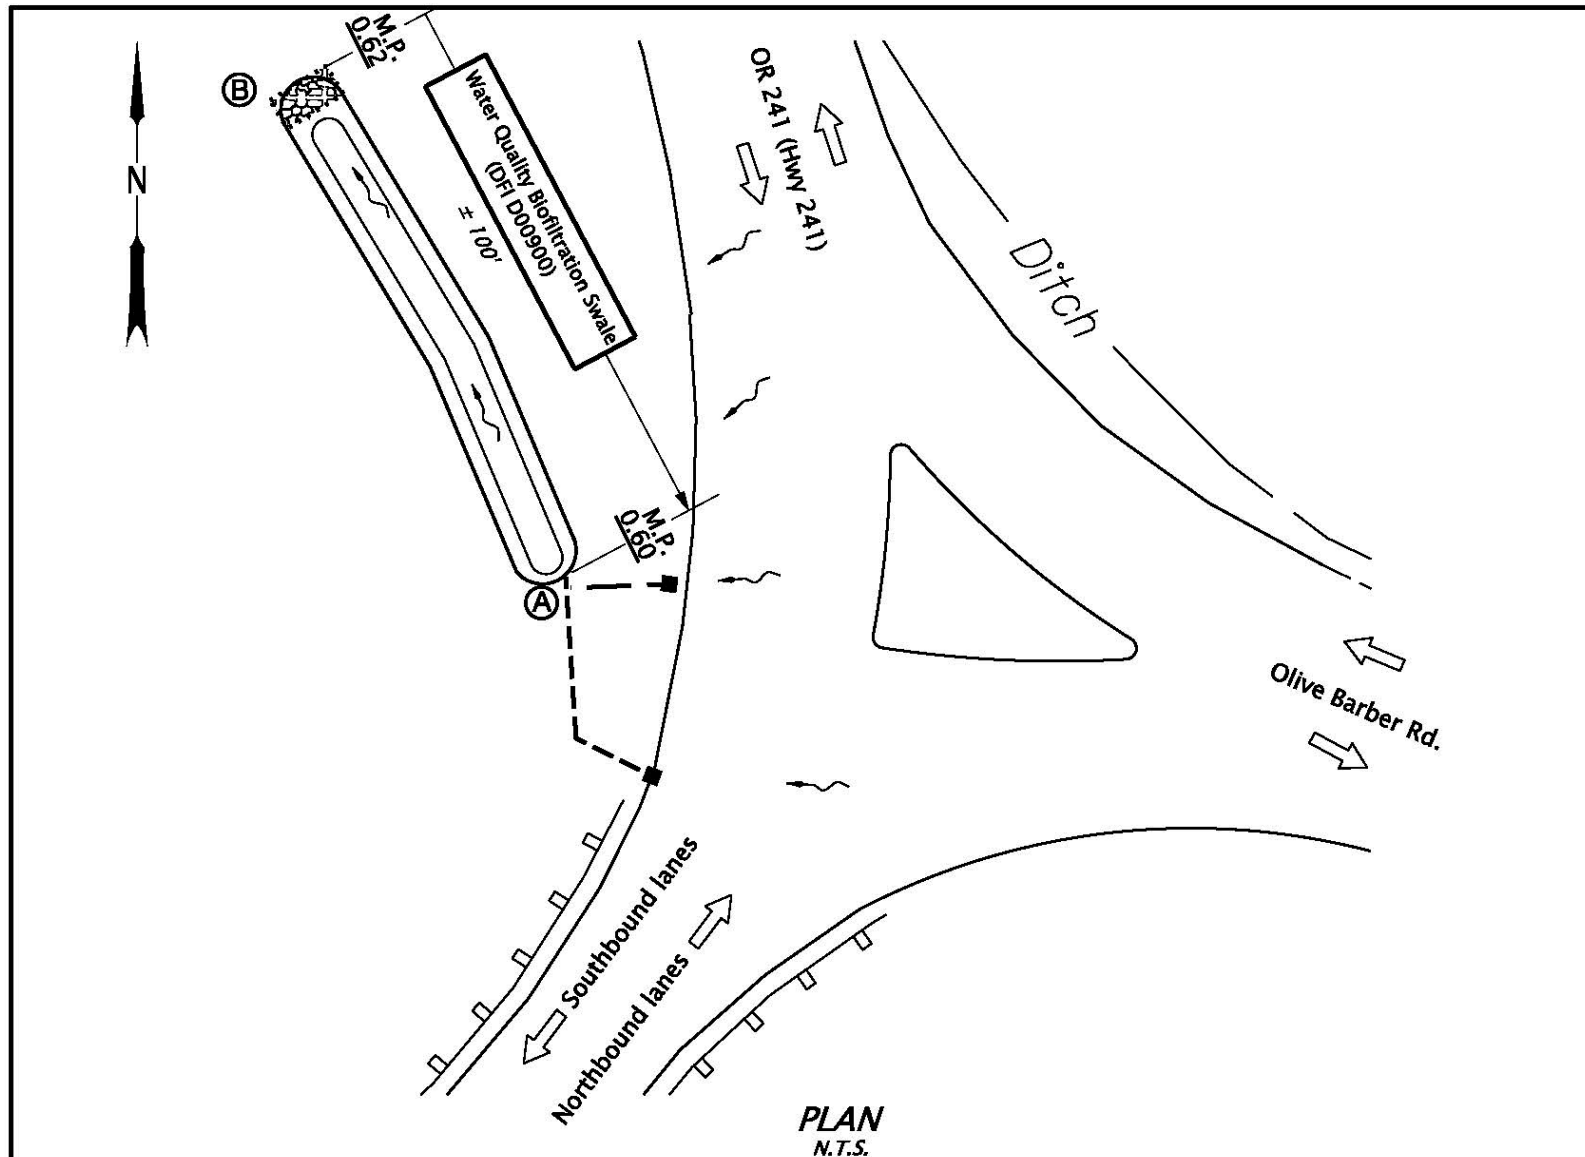


- LEGEND:**
- (A) Swale Inlet w/Flow Spreader
  - (B) Swale Outlet
  - and □ Inlet
  - ⊙ and ⊗ Manhole
  - Storm Pipe (Facility)
  - Storm Pipe
  - ← Conveyance Direction
  - ~ Pavement / Facility Flow Path

Sht. 1 of 1

Prepared By:  
D. Cutsforth

Drafted By:  
D. Cutsforth


**OREGON DEPARTMENT OF TRANSPORTATION**

**DFI D00900**  
**MAINTENANCE DISTRICT 7 HWY 241**  
**WATER QUALITY BIOFILTRATION SWALE**  
 HIGHWAY MP 0.51  
 COOS COUNTY



## Appendix B

### Content:

- **ODOT Project Plan Sheets**
  - *Cover/Title Sheet*
  - *Details*
  - *Water Quality Plan & Profile Sheets*



INDEX OF SHEETS	
SHEET NO.	DESCRIPTION
1	Title Sheet
1A	Index Of Sheets Cont'd. & Std. Dwg. Nos.

STATE OF OREGON  
DEPARTMENT OF TRANSPORTATION


PLANS FOR PROPOSED PROJECT

STRUCTURE

**OR241: ISTHMUS SLOUGH,  
EAST APPROACH BR #01132F  
COOS RIVER HIGHWAY**


COOS COUNTY  
SEPTEMBER 2010

**"Not Revised As Constructed"**  
Date: 3/5/12  
Signature: [Signature]  
Print Name: Don Deery

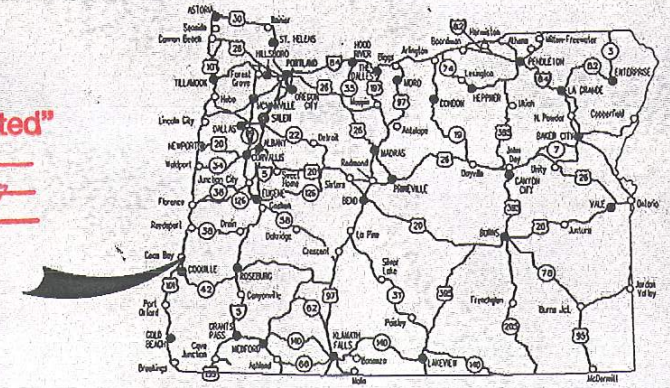

Overall Length Of Project - 0.09 Miles

**ATTENTION:**  
Oregon Law Requires You To Follow Rules Adopted By The Oregon Utility Notification Center. Those Rules Are Set Forth In OAR 952-001-0010 Through OAR 952-001-0090. You May Obtain Copies Of The Rules By Calling The Center. (Note: The Telephone Number For The Oregon Utility Center Is (503) 232-1987.)

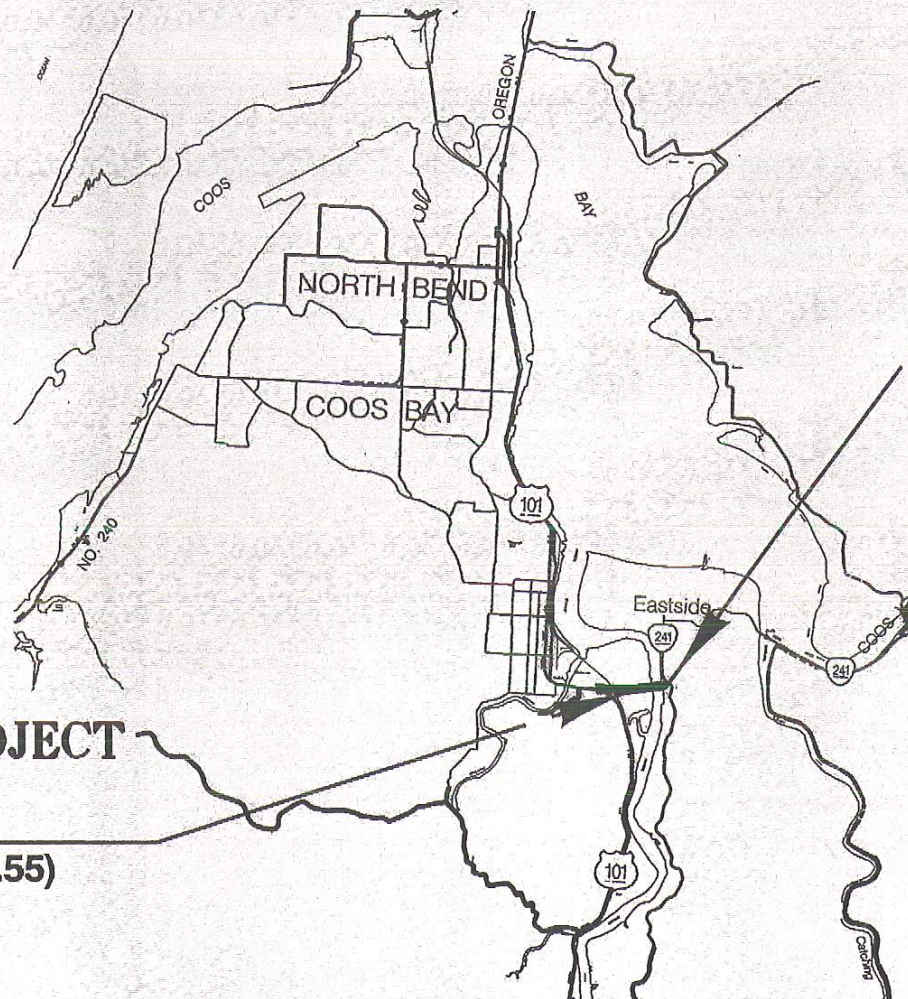

**END OF PROJECT**  
**X-BHO-S241 (004)**  
**STA. "CR" 32+94.70 (M.P. 0.64)**

**BEGINNING OF PROJECT**  
**X-BHO-S241 (004)**  
**STA. "CR" 28+27.50 (M.P. 0.55)**

T. 25 S., R. 13 W., W.M.



**OREGON TRANSPORTATION COMMISSION**

Gail Achterman	CHAIR
Michael Nelson	VICE-CHAIR
Mary Olson	COMMISSIONER
Alan Brown	COMMISSIONER
David Lohman	COMMISSIONER
Matthew L. Garrett	DIRECTOR OF TRANSPORTATION

These plans were developed using ODOT design standards. Exceptions to these standards, if any, have been submitted and approved by the ODOT Chief Engineer or their delegated authority.

Approving Authority: [Signature]  
Signature & date 7-28-10


Mark Thompson Reg. 3 Tech. Ctr. Mgr.  
Print name and title

[Signature]  
Concurrence by ODOT Chief Engineer

**OR241: ISTHMUS SLOUGH,  
EAST APPROACH BR #01132F  
COOS RIVER HIGHWAY  
COOS COUNTY**


FEDERAL HIGHWAY ADMINISTRATION	PROJECT NUMBER	SHEET NO.
OREGON DIVISION	X-BHO-S241 (004)	1



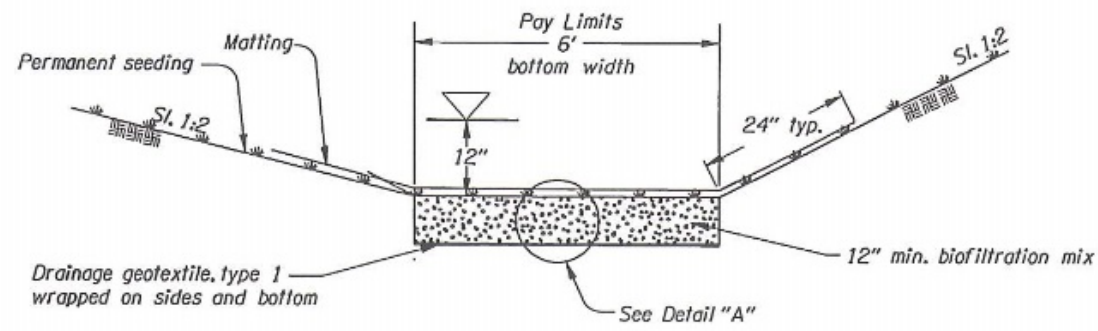

**BIOFILTRATION SWALE**


Not to scale

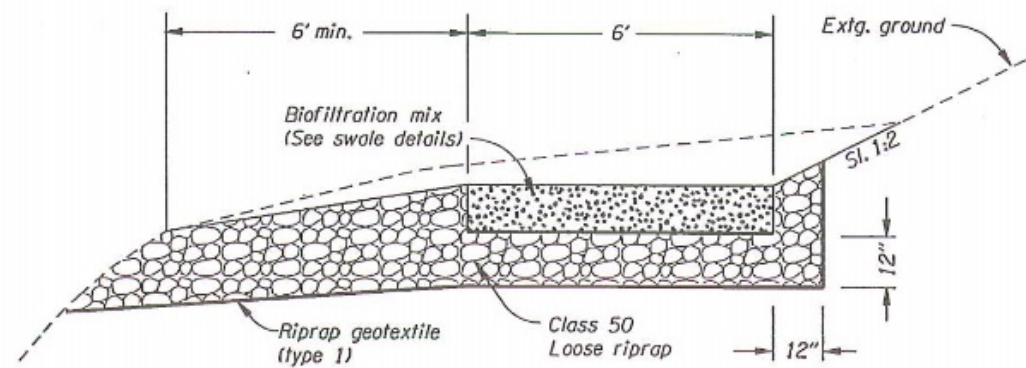

**RIPRAP DETAIL**

(Located at terminus of biofiltration swale)

Not to scale

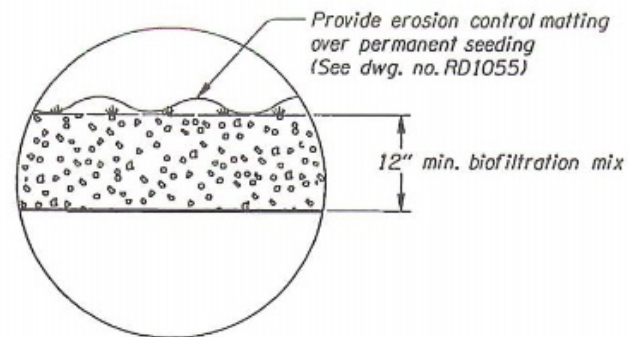


**DETAIL "A"**

Not to scale


**"Not Revised As Constructed"**

Date: 3/5/12  
Signature: [Signature]  
Print Name: Don Deery

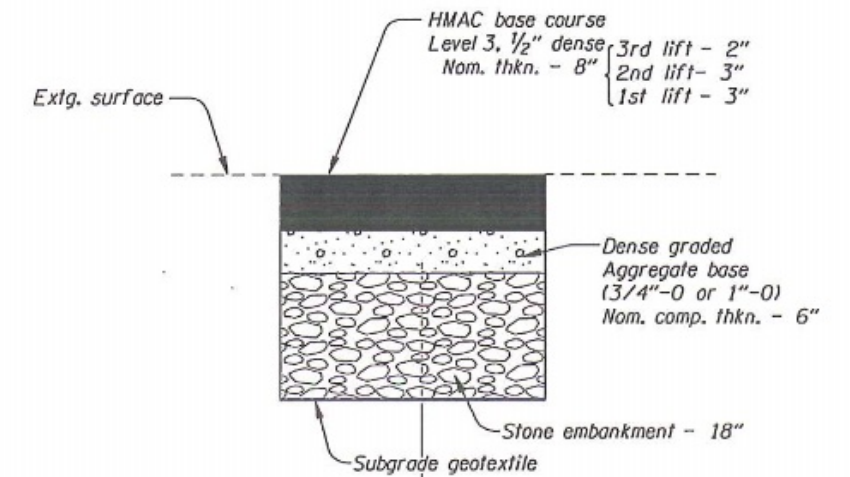

**32" ASPHALT CONCRETE PAVEMENT REPAIR**

(Locations as directed by the Engineer)

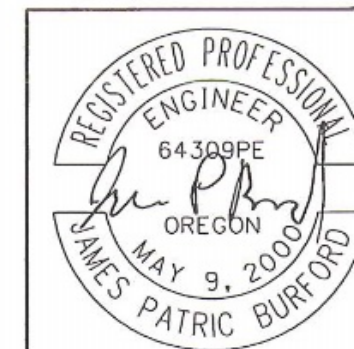

**OREGON DEPARTMENT OF TRANSPORTATION**

**REGION 3 - TECHNICAL CENTER**

**OR241: ISTHMUS SLOUGH, EAST APPROACH BR #01132F**  
COOS RIVER HIGHWAY  
COOS COUNTY

Design Team Leader - James P. Burford  
Designed By - Chris Blevins  
Drafted by - Linda K. Coffel


**DETAILS** SHEET NO. **2B**



Sec. 36, T. 25S, R. 13W, W.M.

**"Revised As Constructed"**

Date: 3/5/12  
 Signature: [Signature]  
 Print Name: Don Dugg


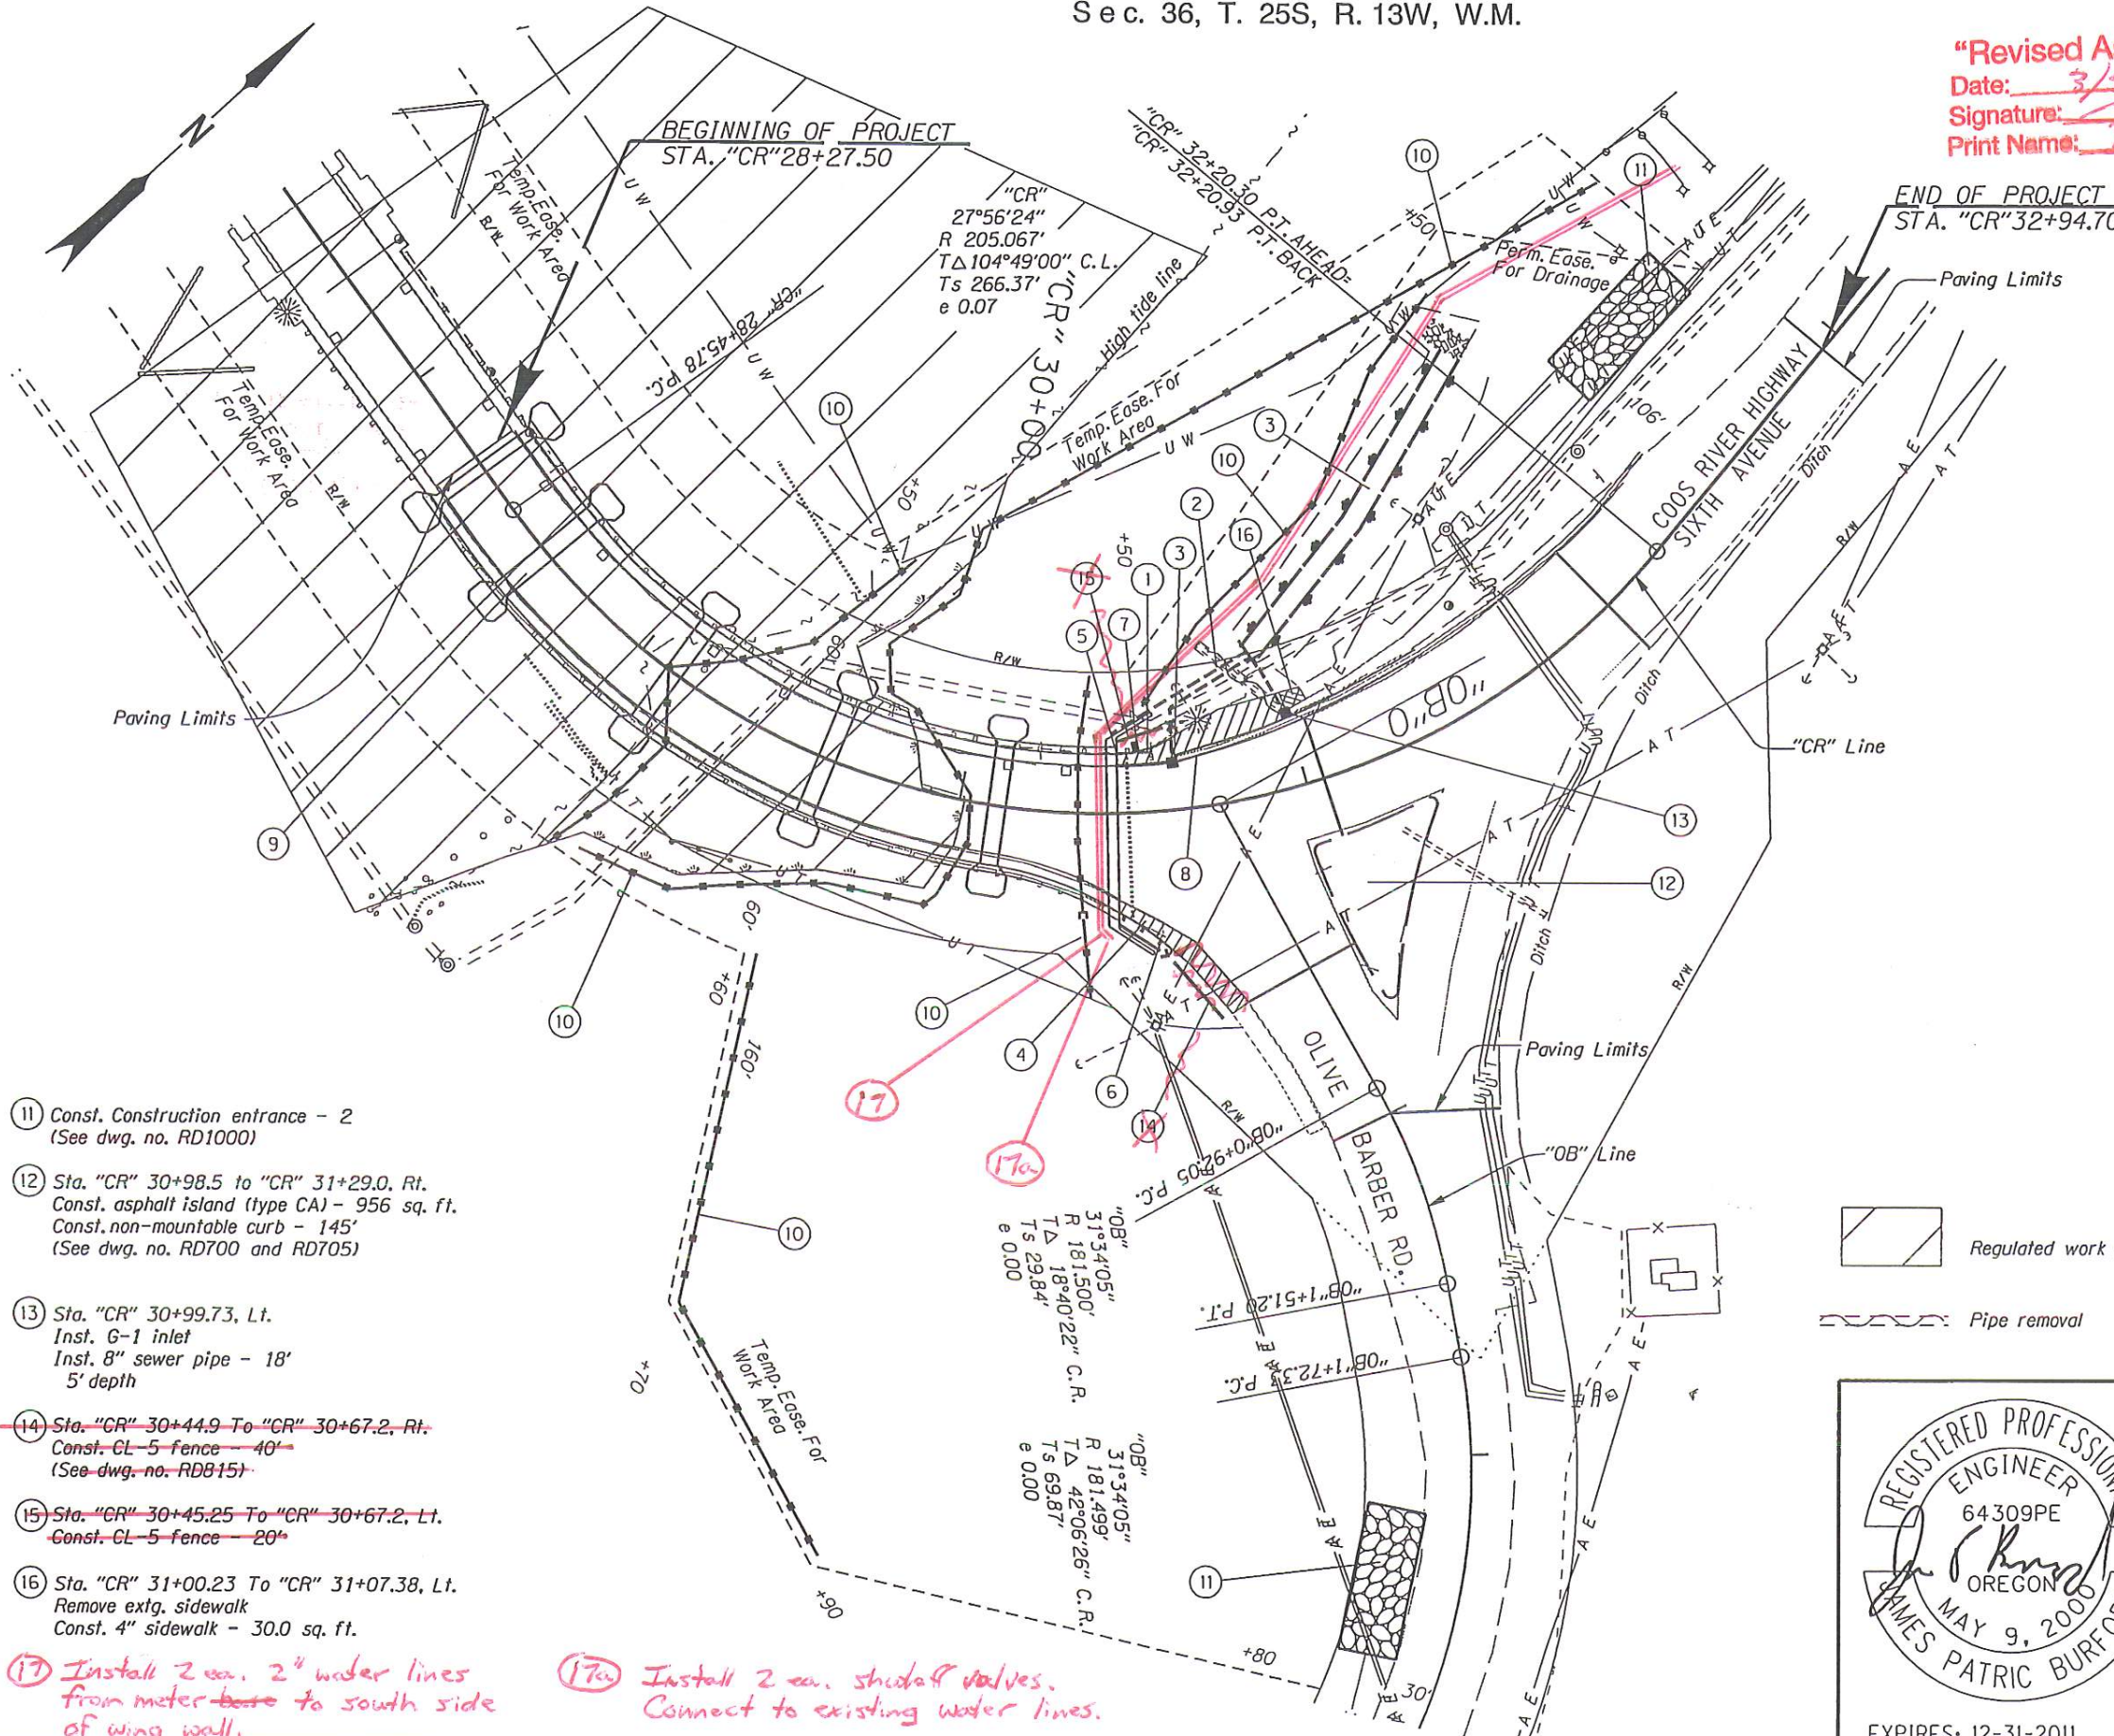


- ① Remove retaining wall
- ② Sta. "CR"30+43.58 to "CR"30+92.33, Lt.  
Inst. 6" galvanized pipe - 45'
- ③ Sta. "CR"30+62.12, 12.0' Lt.  
Inst. G-1 inlet  
Inst. 12" storm sew. pipe - 43'  
5' depth  
Const. biofiltration swale - 68 sq. yds.  
Const. loose riprap, Class 50 - 10 C.Y.  
(For details see sht. 2B)  
(See dwg. nos. RD300, RD326, RD364)
- ④ Sta. "CR"30+44.97 to "CR" 30+73.32, Rt.  
Remove extg. sidewalk  
Const. monolithic curb & sidewalk - 245 sq. ft.  
(See dwg. nos. RD700 & RD720)
- ⑤ Sta. "CR"30+45.20 to 31+00.23, Lt.  
Remove extg. sidewalk  
Const. monolithic curb & sidewalk - 344 sq. ft.
- ⑥ Sta. 30+44.5 to "CR"30+56.97, Rt.  
Const. guardrail bridge transition  
Inst. guardrail end piece (type C)  
(For details see sht. 2B-3)  
(See dwg. no. RD405, RD410 & RD415)
- ⑦ Sta. "CR"30+44.68 to "CR"30+63.84, Lt.  
Const. guardrail bridge transition  
Inst. guardrail end piece (type C)  
(For details see shts. 2B-3)
- ⑧ Sta. "CR" 30+63.64 To "CR" 31+45.5, Lt.  
Const. conc. barrier - 50.0'  
Const. conc. barrier terminal  
(See dwg. nos. RD500, RD510)
- ⑨ Const. bridge #01132F  
(For details see sht. 1A for dwg. nos.)
- ⑩ Const. sediment fence supported  
(See dwg. no. RD1040)

- ⑪ Const. Construction entrance - 2  
(See dwg. no. RD1000)
- ⑫ Sta. "CR" 30+98.5 to "CR" 31+29.0, Rt.  
Const. asphalt island (type CA) - 956 sq. ft.  
Const. non-mountable curb - 145'  
(See dwg. no. RD700 and RD705)
- ⑬ Sta. "CR" 30+99.73, Lt.  
Inst. G-1 inlet  
Inst. 8" sewer pipe - 18'  
5' depth
- ⑭ ~~Sta. "CR" 30+44.9 To "CR" 30+67.2, Rt.  
Const. CL 5 fence - 40'  
(See dwg. no. RDB15)~~
- ⑮ ~~Sta. "CR" 30+45.25 To "CR" 30+67.2, Lt.  
Const. CL 5 fence - 20'~~
- ⑯ Sta. "CR" 31+00.23 To "CR" 31+07.38, Lt.  
Remove extg. sidewalk  
Const. 4" sidewalk - 30.0 sq. ft.

⑰ Install 2 ea. 2" water lines from meter base to south side of wing wall.

⑰a Install 2 ea. shut-off valves. Connect to existing water lines.

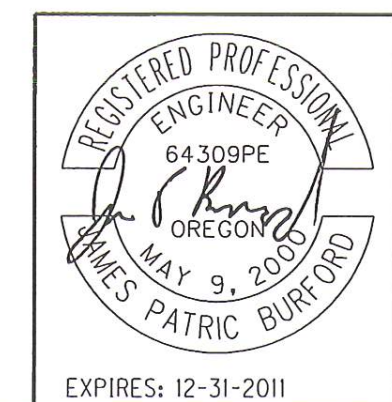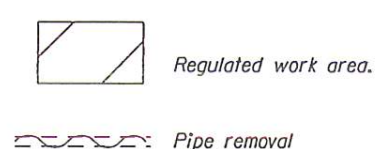


<b>OREGON DEPARTMENT OF TRANSPORTATION</b>	
<b>REGION 3 - TECHNICAL CENTER</b>	
OR241: ISTHMUS SLOUGH, EAST APPROACH BR #01132F COOS RIVER HIGHWAY COOS COUNTY	
Design Team Leader - James P. Burford Designed by - Chris Blevins Drafted by - Linda K. Coffel	
<b>GENERAL CONSTRUCTION</b>	SHEET NO. <b>3</b>



**"Not Revised As Constructed"**

Date: 3/5/12  
 Signature: [Signature]  
 Print Name: Don Deary

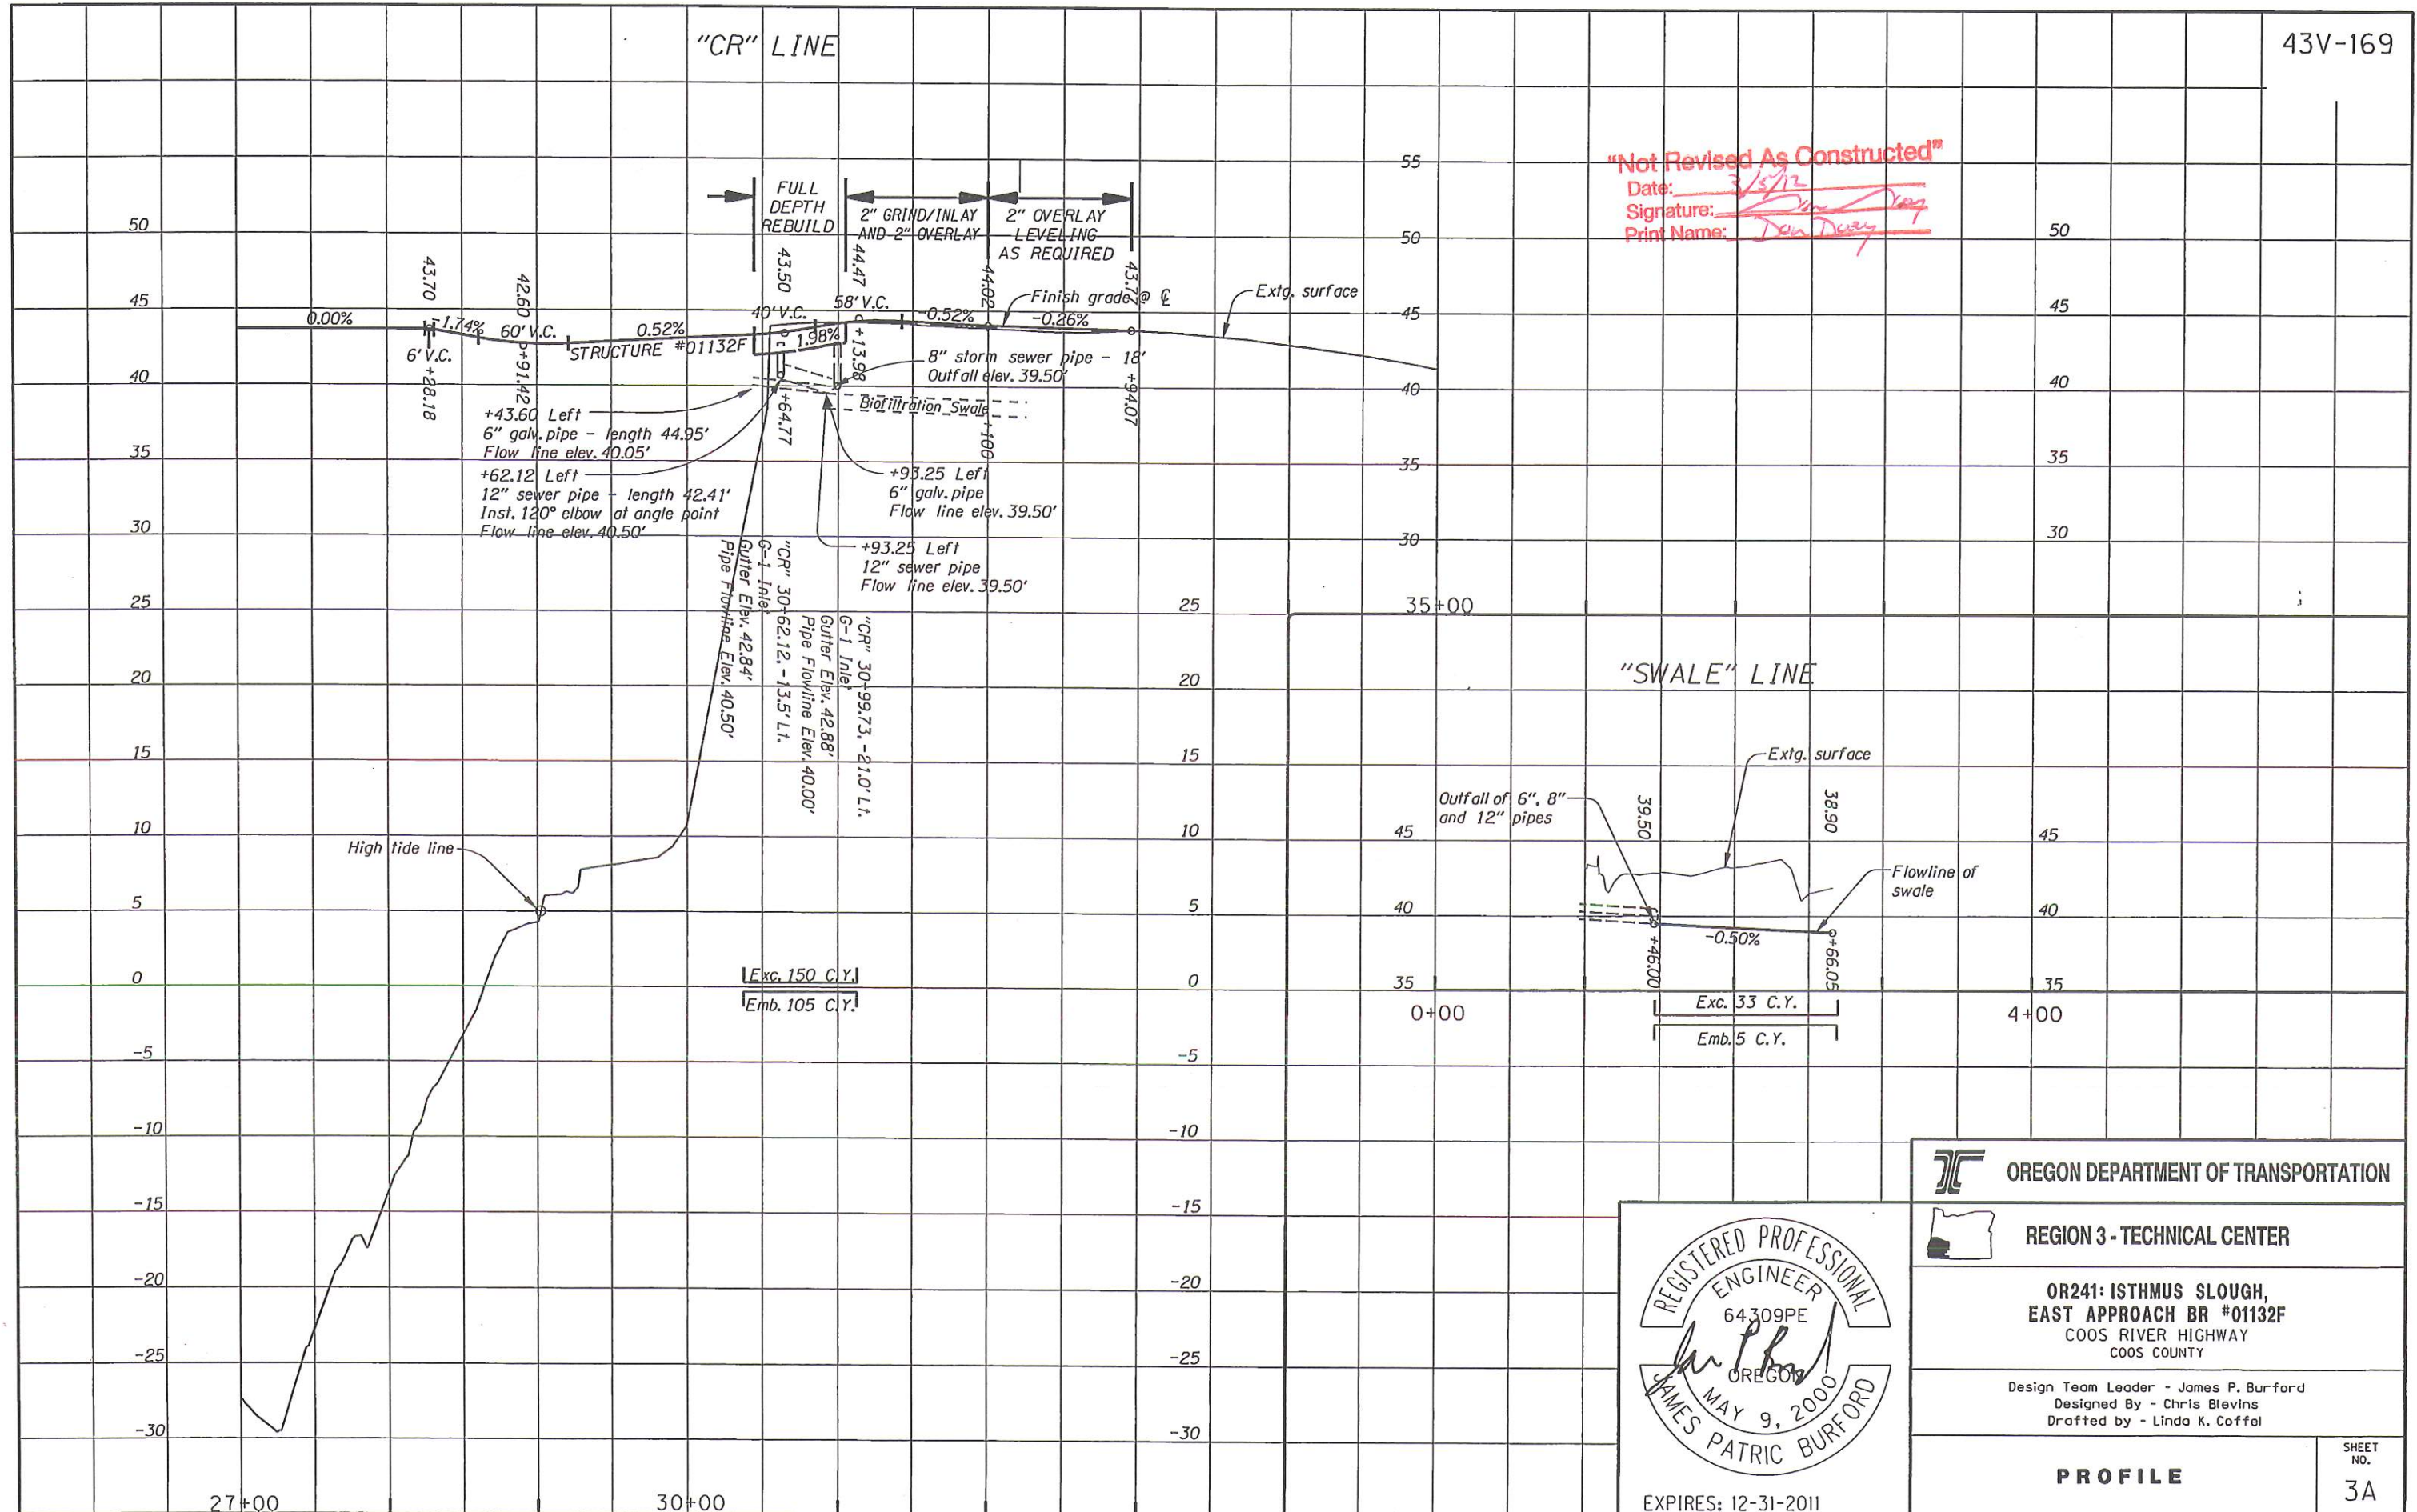


**OREGON DEPARTMENT OF TRANSPORTATION**

**REGION 3 - TECHNICAL CENTER**

**OR241: ISTHMUS SLOUGH,  
 EAST APPROACH BR #01132F  
 COOS RIVER HIGHWAY  
 COOS COUNTY**

Design Team Leader - James P. Burford  
 Designed By - Chris Blevins  
 Drafted by - Linda K. Coffel

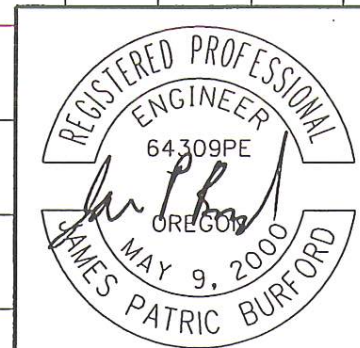

**PROFILE**

SHEET NO.  
**3A**