

OPERATION & MAINTENANCE MANUAL

Water Quality Planter

Manual prepared: May 2019

DFI No. D00913



Figure 1: DFI No D00913, looking South

Identification

Drainage Facility ID (DFI):	D00913
Facility Type:	Water Quality Planter
Construction Drawings:	47V-081
Locations:	District: 1
	Highway No.: 92
	Mile Post: 46.96 (Left)

1. Manual Purpose

The purpose of this manual is to outline inspection needs and summarize maintenance actions for water quality planters.

2. Facility Location

The location map below details the facility location. The highway, mile posts, side streets, access location, and stormwater flow directions are noted on the map.

Facility location type: In Sidewalk

Flow direction: East

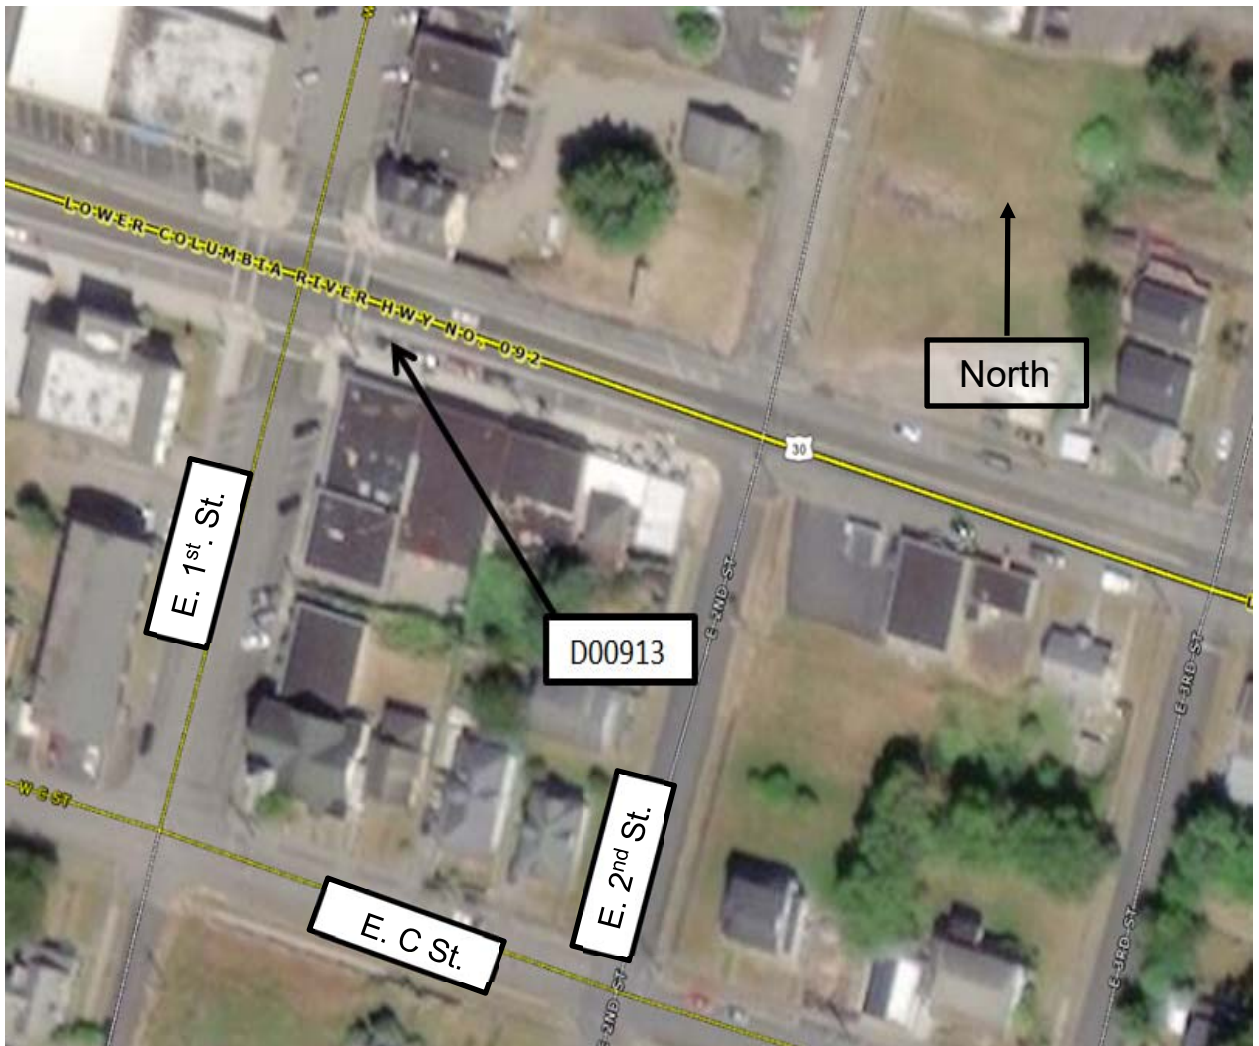


Figure 2: Facility Location Map


3. Facility Summary

The length and width of the WQ Planter is based on the dimensions of the inside of the treatment cell.

The length and width of the WQ Planters are:

Facility DFI	Length (Feet)	Width (Feet)
D00913	22	3.5

INTEGRITY
De

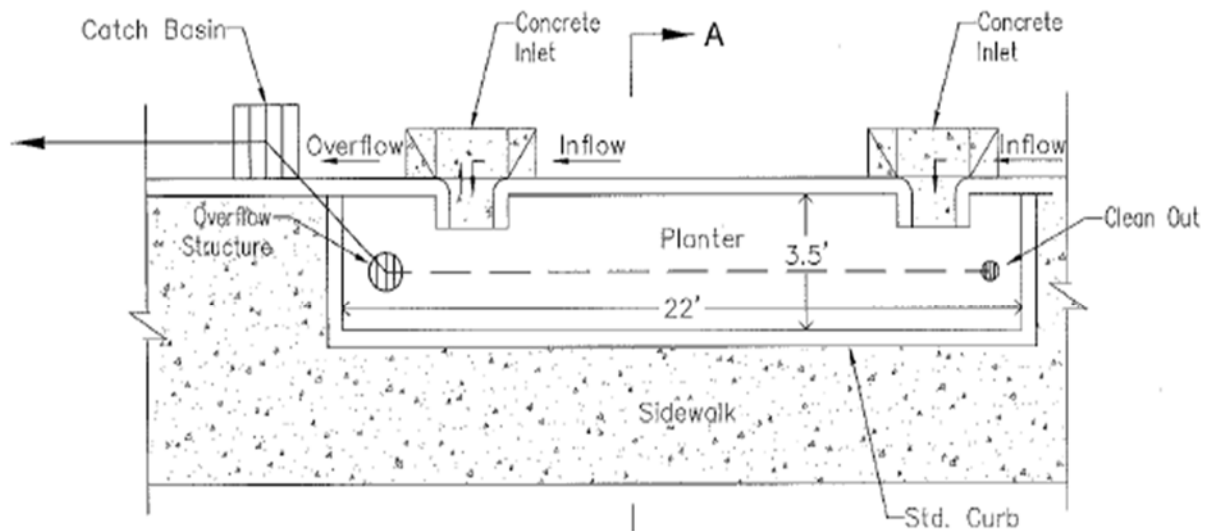

Site Specific Information: The planters have two curb inlets. The second downstream inlet serves as a high flow bypass going into the storm drain system.

4. Facility Access

Maintenance access to the facility: Curb and gutter (travel lane)

Lane Closure Needed

Water quality planters do not typically have access roads/access pads, nor are they gated, as they are located in urban areas alongside sidewalks and curbs. Use caution when accessing these facilities as there may be pedestrians or cyclists in the vicinity.



Figure 3: [Looking south at the SE corner of US30 and 1st St.]

5. Operational Components / Maintenance Items

Classification and Standard Operational (Op) Plan:

This facility is classified as a:

<input type="checkbox"/> Filterra (Op Plan A)	<input checked="" type="checkbox"/> WQ Planter (Op Plan B)	<input type="checkbox"/> MWS (Op Plan C)
A Filterra is a single chamber treatment cell that utilizes filter media, a plant, and a perforated underdrain.	A WQ Planter is a single chamber treatment cell that utilizes plants, filter media, and a perforated underdrain. The auxiliary outlet is located inside of the treatment cell.	A <u>Modular Wetland System</u> is a three chamber treatment cell that utilizes plants, filter media, filter media cartridges, and a perforated underdrain network.
A standard operational plan illustrates the general facility footprint configuration and explains the purpose of each facility component. Operational plans (A and B) are provided in the Standard Operation Manual.		

See Appendix A for the site specific operational plan.

Operational Components

The facility components table (**Table 1**) has been provided to highlight the applicable components for this facility. The component is in use when the box contains an “x” (e.g.).

The Standard Operation Manual for Water Quality Planters (implemented April 2018) outlines facility operation, typical footprint configuration, and component definitions and details. A link to the manual is attached to the feature marker in TransGIS.

<https://gis.odot.state.or.us/TransGIS/>

Maintenance Items

Operational components marked in **Table 1** should be inspected and maintained according to Section 7. Each facility component is defined and detailed in the Standard Operation Manual using the associated ID number indicated below.

Table 1: Facility Components		ID #
Facility Inlet		
Inlet Grate	<input type="checkbox"/>	P1
Curb Inlet	<input checked="" type="checkbox"/>	P2
Sidewalk Chute	<input type="checkbox"/>	P3
Bypass Inlet	<input checked="" type="checkbox"/>	P4
Treatment		
Plants (Tree or Shrub)	<input type="checkbox"/>	P5
Grass	<input type="checkbox"/>	P6
Filter Media	<input checked="" type="checkbox"/>	P7
Filter Media Cartridge	<input type="checkbox"/>	P8

Planter Components		
Perforated Pipe	<input checked="" type="checkbox"/>	P9
Outlet Grate	<input type="checkbox"/>	P10
Outfall Type		
Waterbody (Creek/Lake/Ocean)	<input type="checkbox"/>	P11
Ditch	<input type="checkbox"/>	P12
Storm Drain System	<input checked="" type="checkbox"/>	P13

6. Maintenance

Maintenance Frequency/Maintain Records

- a. Full inspection annually. Preferably prior to the rainy season.
- b. Clean and maintain as necessary. Refer to Activity 125 for conditions when maintenance is needed.
- c. Keep a record of inspections, maintenance, and repairs.

Maintenance Guide/Maintenance Actions

The ODOT Routine Road Maintenance Water Quality and Habitat Guide (the *Blue Book*) outlines the standard maintenance actions for water quality facilities under Activity 125.

There are standard maintenance tables for standard ODOT designs. The maintenance tables describe the maintenance component, the defect or problem, the condition when maintenance is needed, and the recommended maintenance to correct the problem. Use the following tables to maintain these water quality planters:

- Table 1 (General Maintenance): Contains general maintenance and inspection guidelines that are applicable to all ODOT water quality facilities. Maintenance of inlets, outlets, trash removal and noxious weeds is recommended seasonally.
- Table 3 (Maintenance of Water Quality or Biofiltration Swales): Contains maintenance information for swales. The planted area of these planters should be maintained as described for the bottom and sides of swales, by using equipment other than mowers to control plant height. Replant if needed with plants from the original plans, or as recommended by ODOT landscaping and stormwater staff.

The *Blue Book* can be viewed at the following website:

http://www.oregon.gov/ODOT/Maintenance/Documents/blue_book.pdf

7. Limitations

Vactors may be used at the inlet, outlet, and grated areas. No heavy equipment may be used in the planted areas.

8. Waste Material Handling

Material removed from the facility is defined as waste by the Department of Environmental Quality (DEQ). Refer to the road waste section of the ODOT Maintenance Yard Environmental Management System (EMS) Policy and Procedures Manual for disposal options:

<http://www.oregon.gov/ODOT/HWY/OOM/pages/ems.aspx>

Contact any of the following for more detailed information about management of waste materials found on site:


ODOT Clean Water Unit	(503) 986-3008
ODOT Statewide Hazmat Coordinator	(503) 667-7442
ODOT Region 1 Hazmat Coordinator	(503) 731-8290
ODOT Region 2 Hazmat Coordinator	(503) 986-2647
ODOT Region 3 Hazmat Coordinator	(541) 957-3594
ODOT Region 4 Hazmat Coordinator	(541) 388-6186
ODOT Region 5 Hazmat Coordinator	(541) 963-1590
ODEQ Northwest Region Office	(503) 229-5263

A Appendix A – Site Specific Operational Plan


Contents:

Operational Plan: DFI D00913


- LEGEND:**
- Photo Location / Direction
 - Facility Component (see table 1 in O&M Manual)
 - Manhole
 - Inlet
 - Storm Pipe (Facility)
 - Conveyance Direction
 - Pavement / Facility Flow Path

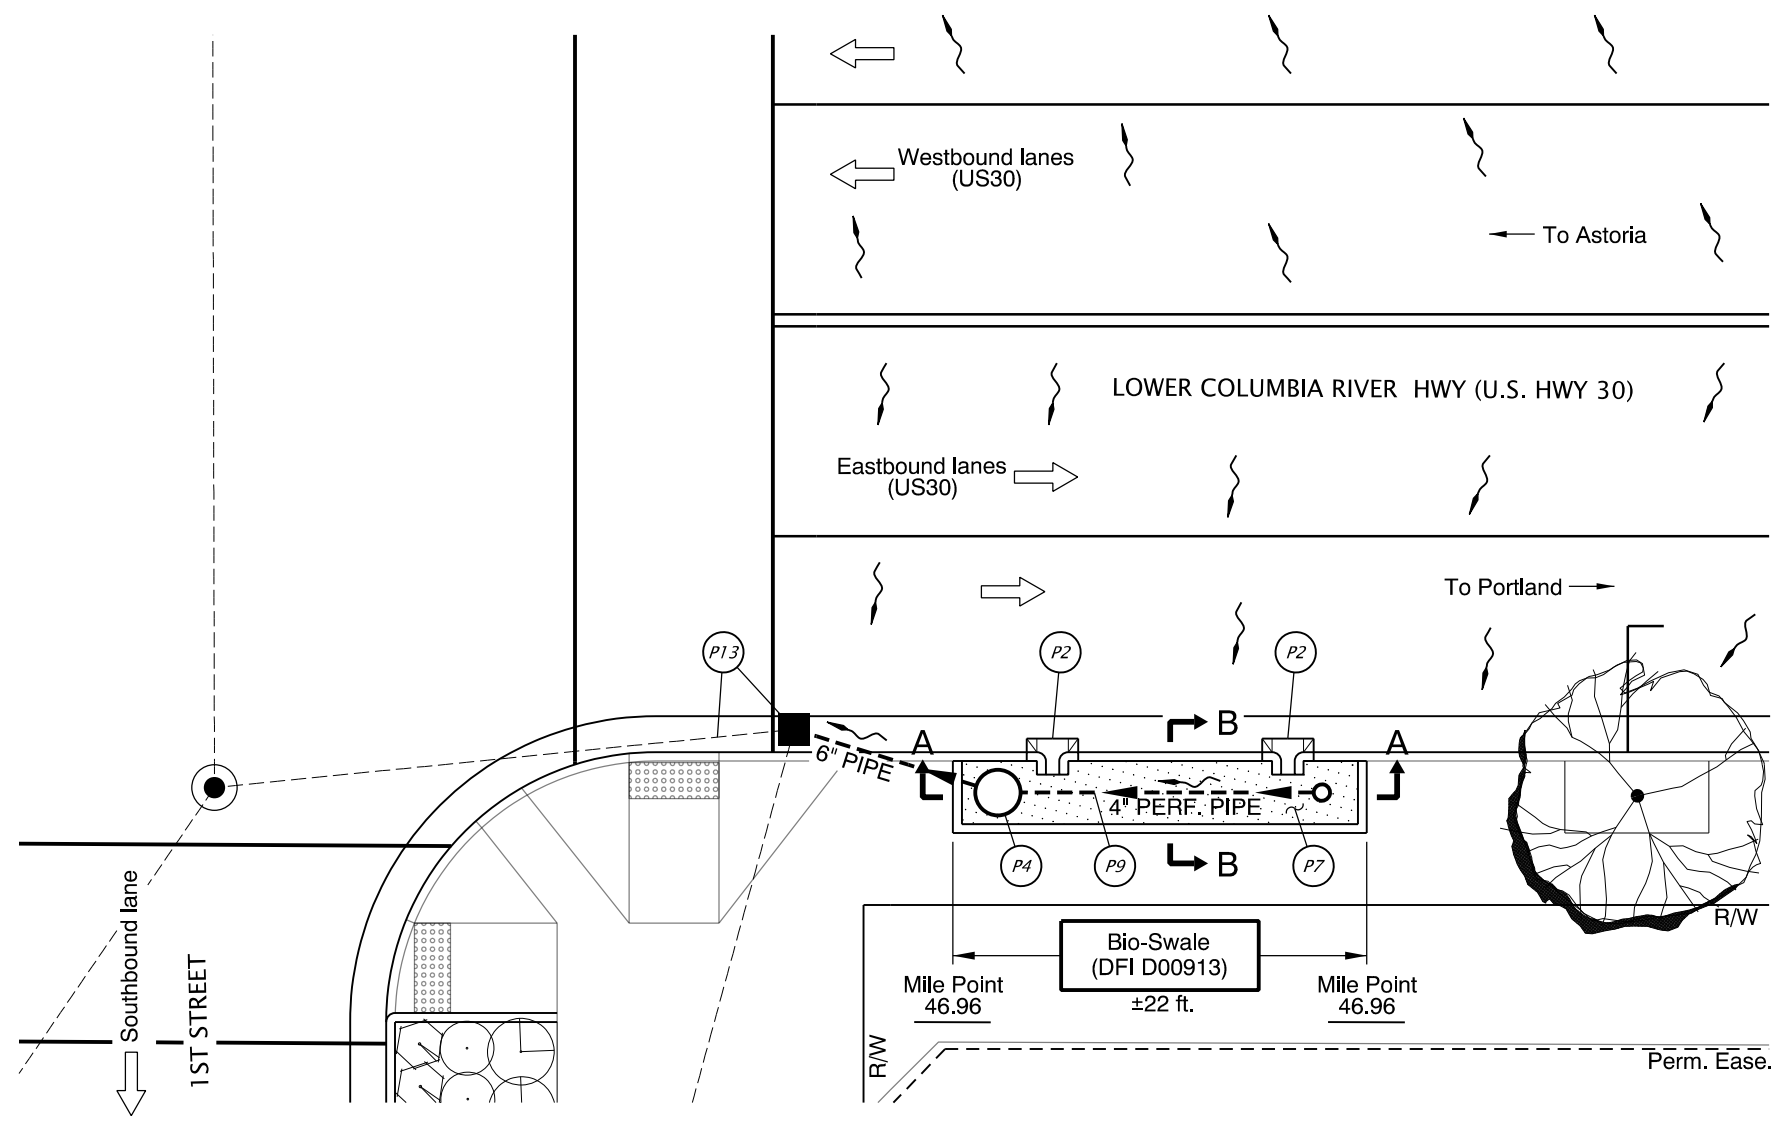

PLAN
N.T.S.

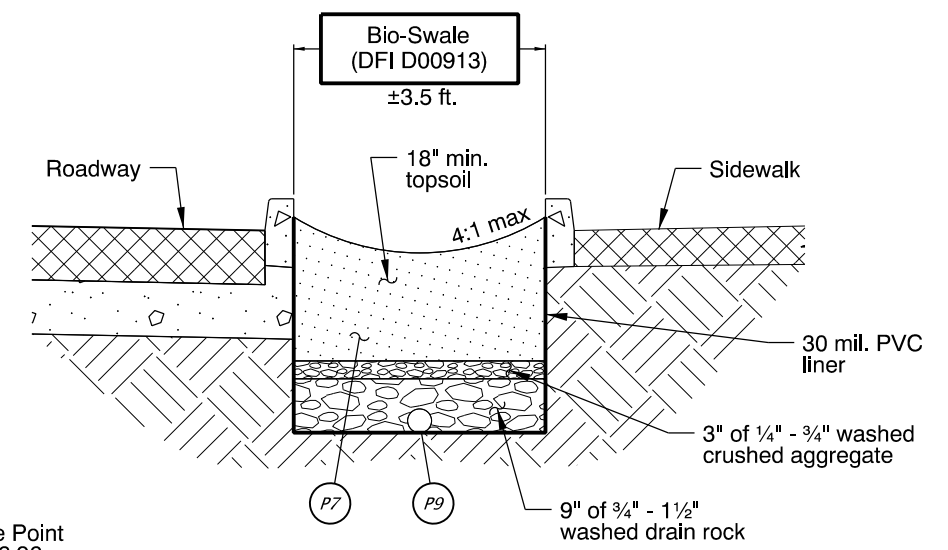

SECTION B-B
N.T.S.

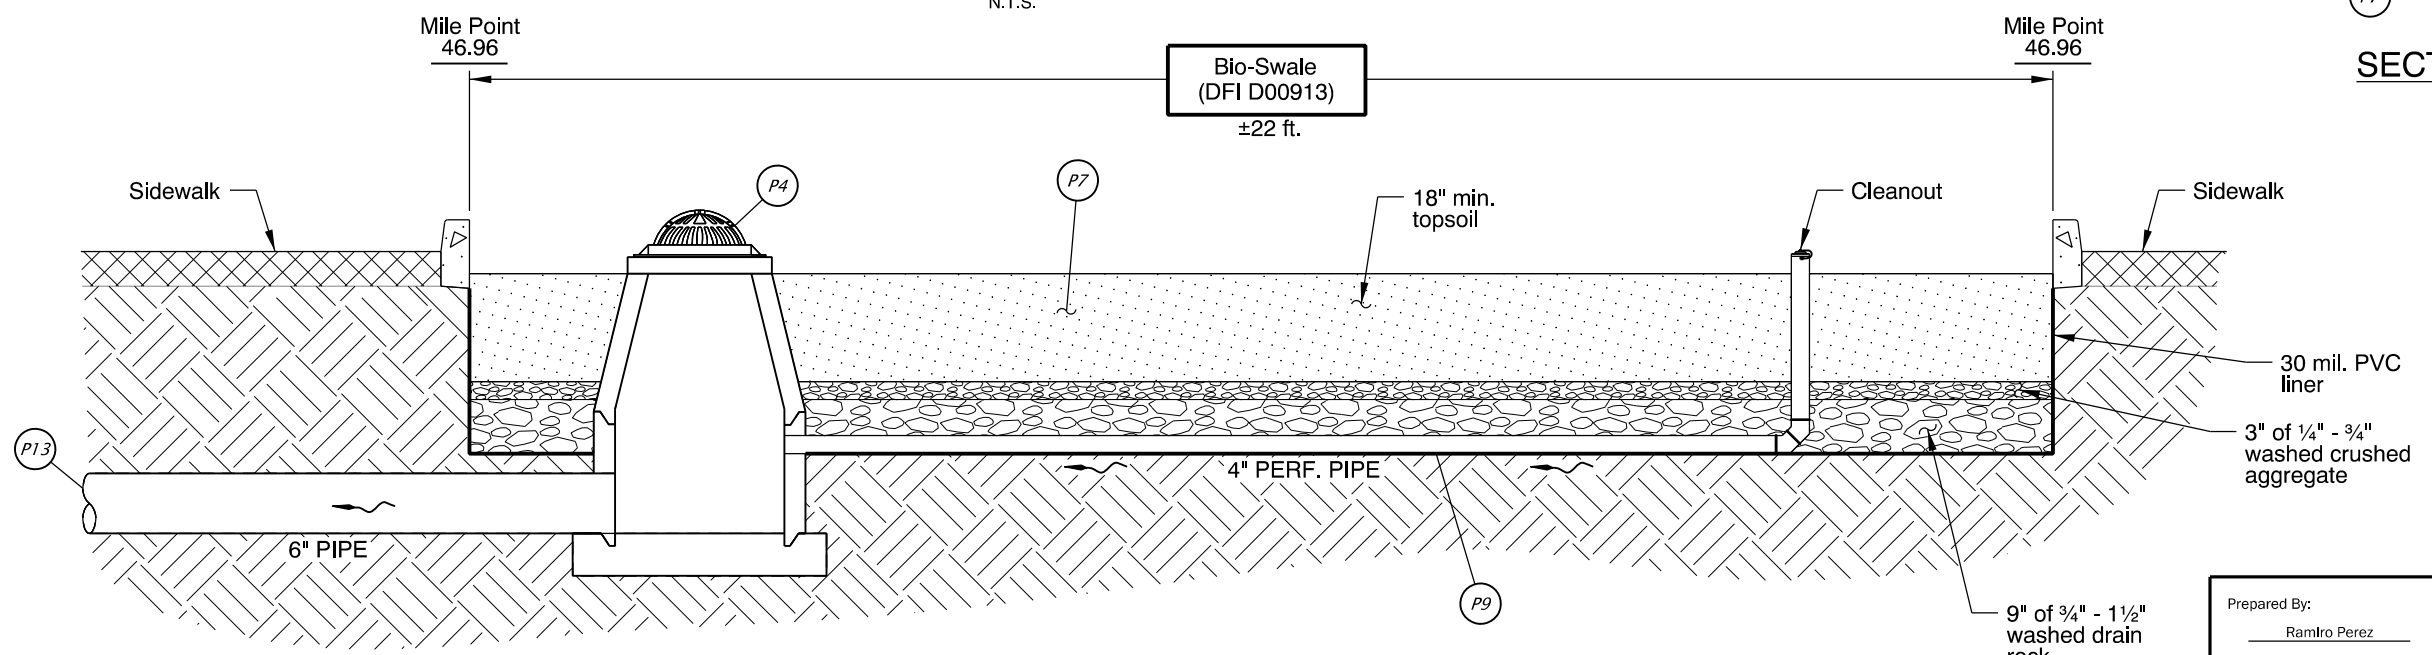

SECTION A-A
N.T.S.



DFI D00913
MAINTENANCE DISTRICT 1 US30
WATER QUALITY PLANTER
LOWER COLUMBIA HIGHWAY MP 46.96
COLUMBIA COUNTY

Prepared By:
 Ramiro Perez

Drafted By:
 Michael Skelton

B Appendix B – Project Contract Plans

Contents:

Site Specific Subset of Project Contract Plan 47V-081

INDEX OF SHEETS	
SHEET NO.	DESCRIPTION
1	Title Sheet
1A	Index Of Sheets Cont'd. & Std. Drg. Nos.

STATE OF OREGON
DEPARTMENT OF TRANSPORTATION
PLANS FOR PROPOSED PROJECT


GRADING, DRAINAGE, STRUCTURES, PAVING, STRIPING, SIGNING,
ILLUMINATION, SIGNALS, & ROADSIDE DEVELOPMENT

US30: B STREET BIKE/PED PATH SEC.

LOWER COLUMBIA RIVER HIGHWAY


COLUMBIA COUNTY

OCTOBER 2014

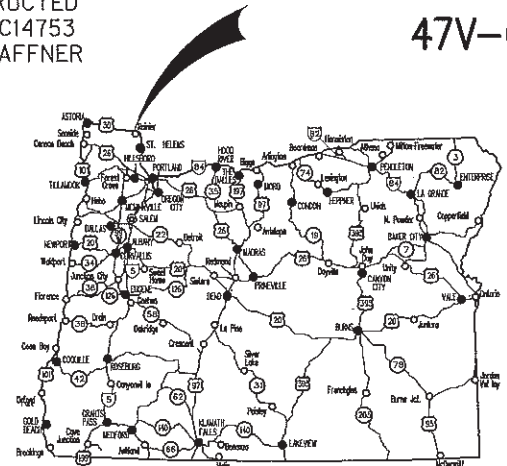

Overall Length Of Project - 0.23 Miles

ATTENTION:
Oregon Law Requires You To Follow Rules Adopted By The Oregon Utility Notification Center. Those Rules Are Set Forth In OAR 952-001-0010 Through OAR 952-001-0090. You May Obtain Copies Of The Rules By Calling The Center. (Note: The Telephone Number For The Oregon Utility Center Is (503) 232-1987.)

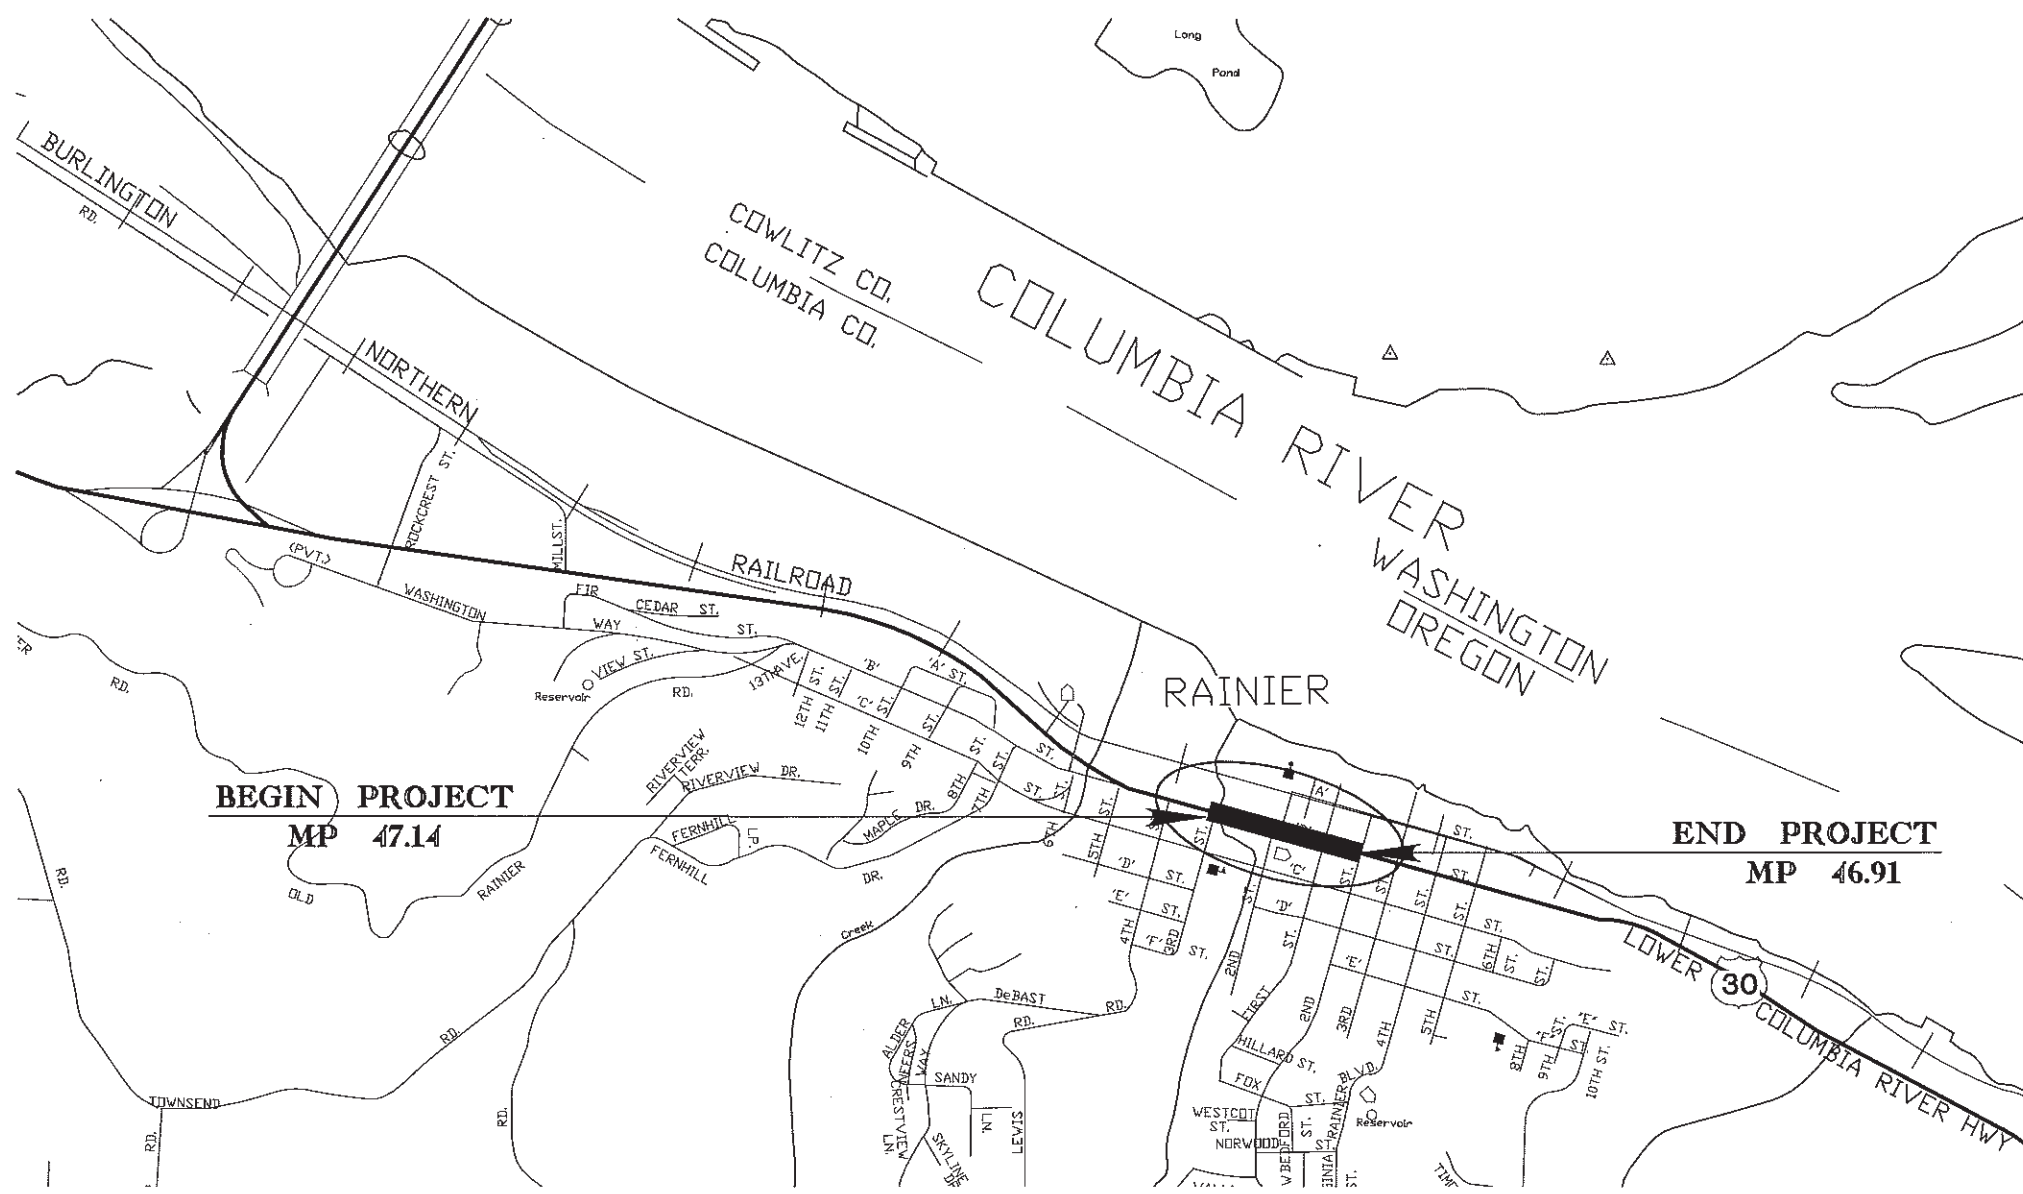

BEGIN PROJECT
MP 47.14

END PROJECT
MP 46.91

OREGON TRANSPORTATION COMMISSION
Catherine Mator CHAIR
David Lahman COMMISSIONER
Susan Morgan COMMISSIONER
Alando Simpson COMMISSIONER
Tammy Boney COMMISSIONER
Matthew L. Garrett DIRECTOR OF TRANSPORTATION

These plans were developed using AASHTO design standards. Exceptions to these standards, if any, have been submitted and approved by the ODOT Chief Engineer or their delegated authority.

Approving Authority:
Signature & date 7/5/15

Brady Berry, P.E., Project Manager
Print name and title

Concurrence by ODOT Chief Engineer


US30: B STREET BIKE/PED PATH SEC.
LOWER COLUMBIA RIVER HIGHWAY
COLUMBIA COUNTY

T. 7 N., R. 2 W., W.M.




FEDERAL HIGHWAY ADMINISTRATION	PROJECT NUMBER	SHEET NO.
OREGON DIVISION	STATE	1

P:\ODOT\034325\Construction\Record Drawings\Civil\034325-C-CS01.dwg

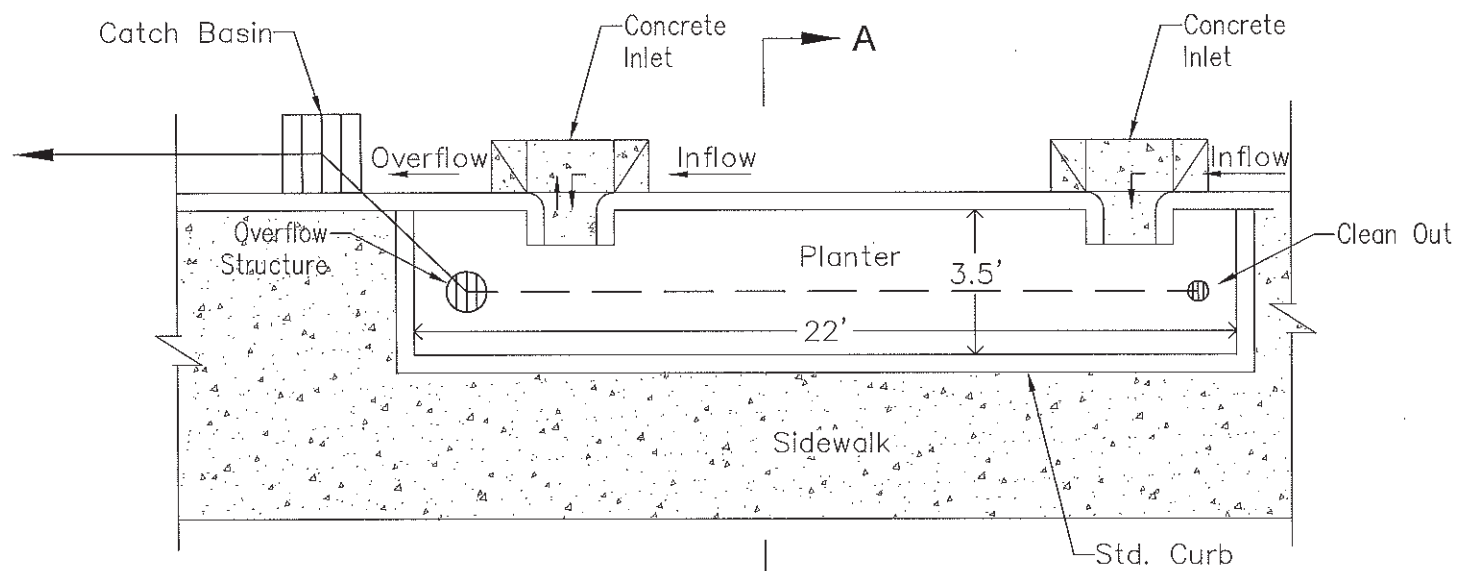



Plan View

Provide and Install Spreading Rush (Juncus Patens) Plugs at 12" On-Center in all Water Quality Planters

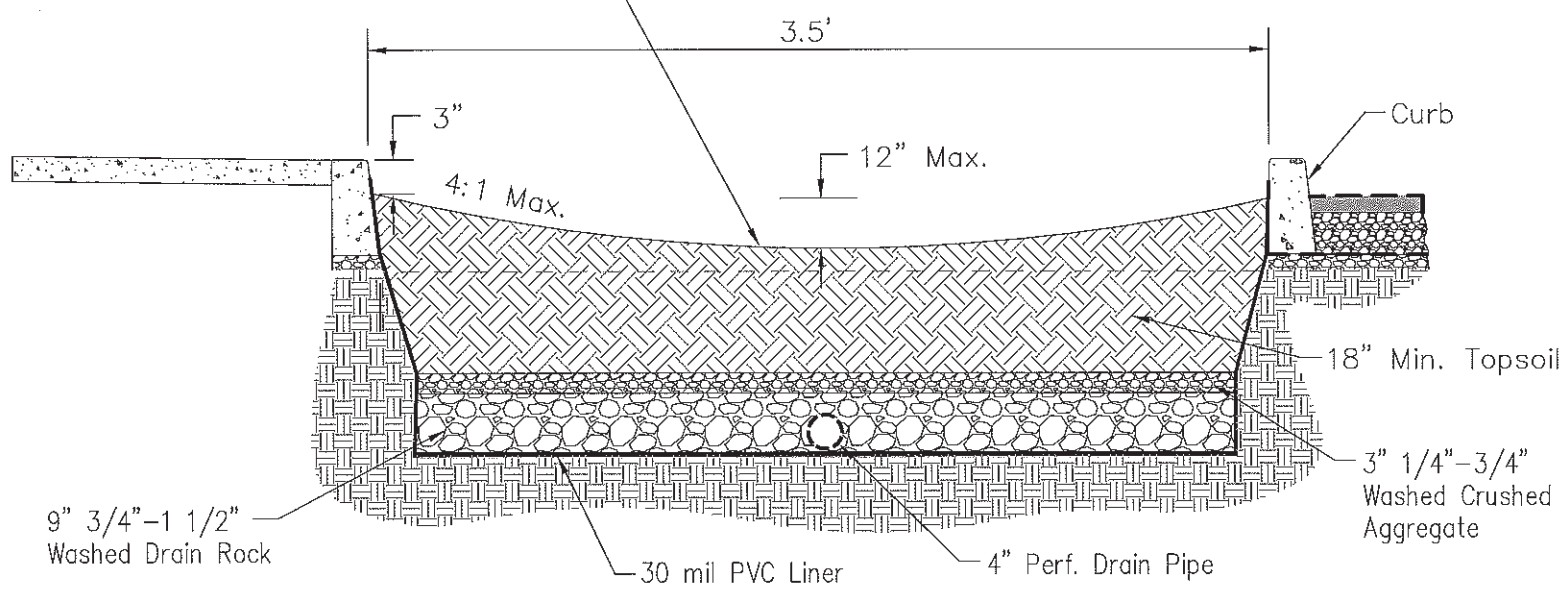


Section A-A

Water Quality Planter
N.T.S

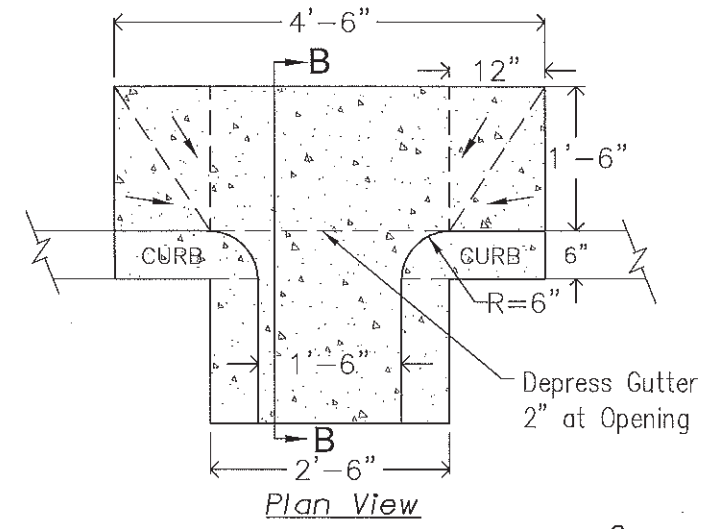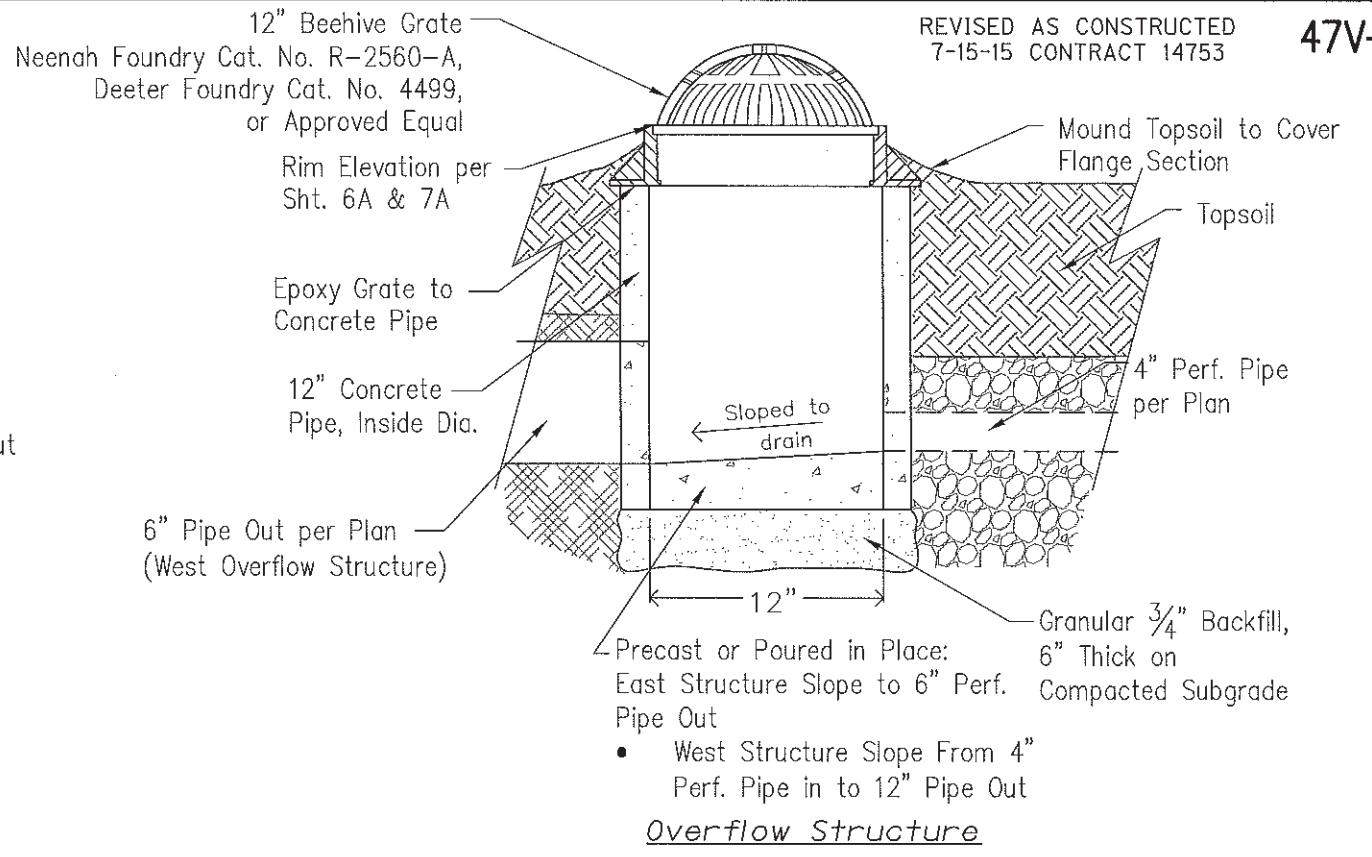

Plan View

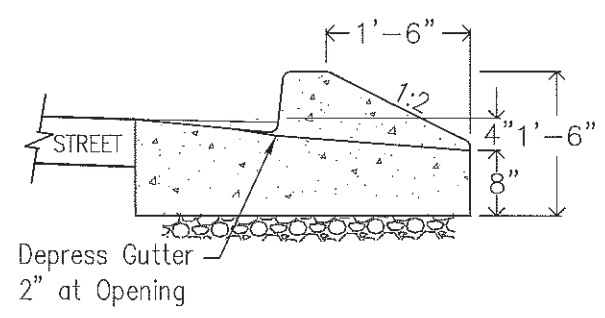

Section B-B

Concrete Inlet
N.T.S.

OREGON DEPARTMENT OF TRANSPORTATION


WHPacific 9755 S.W. Barnes Road Suite 300
Portland, OR 97225
t: 503.626.0455 f: 503.526.0775

US30: B STREET BIKE/PED PATH SEC.
LOWER COLUMBIA RIVER HIGHWAY
COLUMBIA COUNTY

Reviewed By - Brady Berry
Designed By - Sarah Jones
Drafted By - Sarah Jones

DRAINAGE DETAILS

SHEET
NO.
2B-2

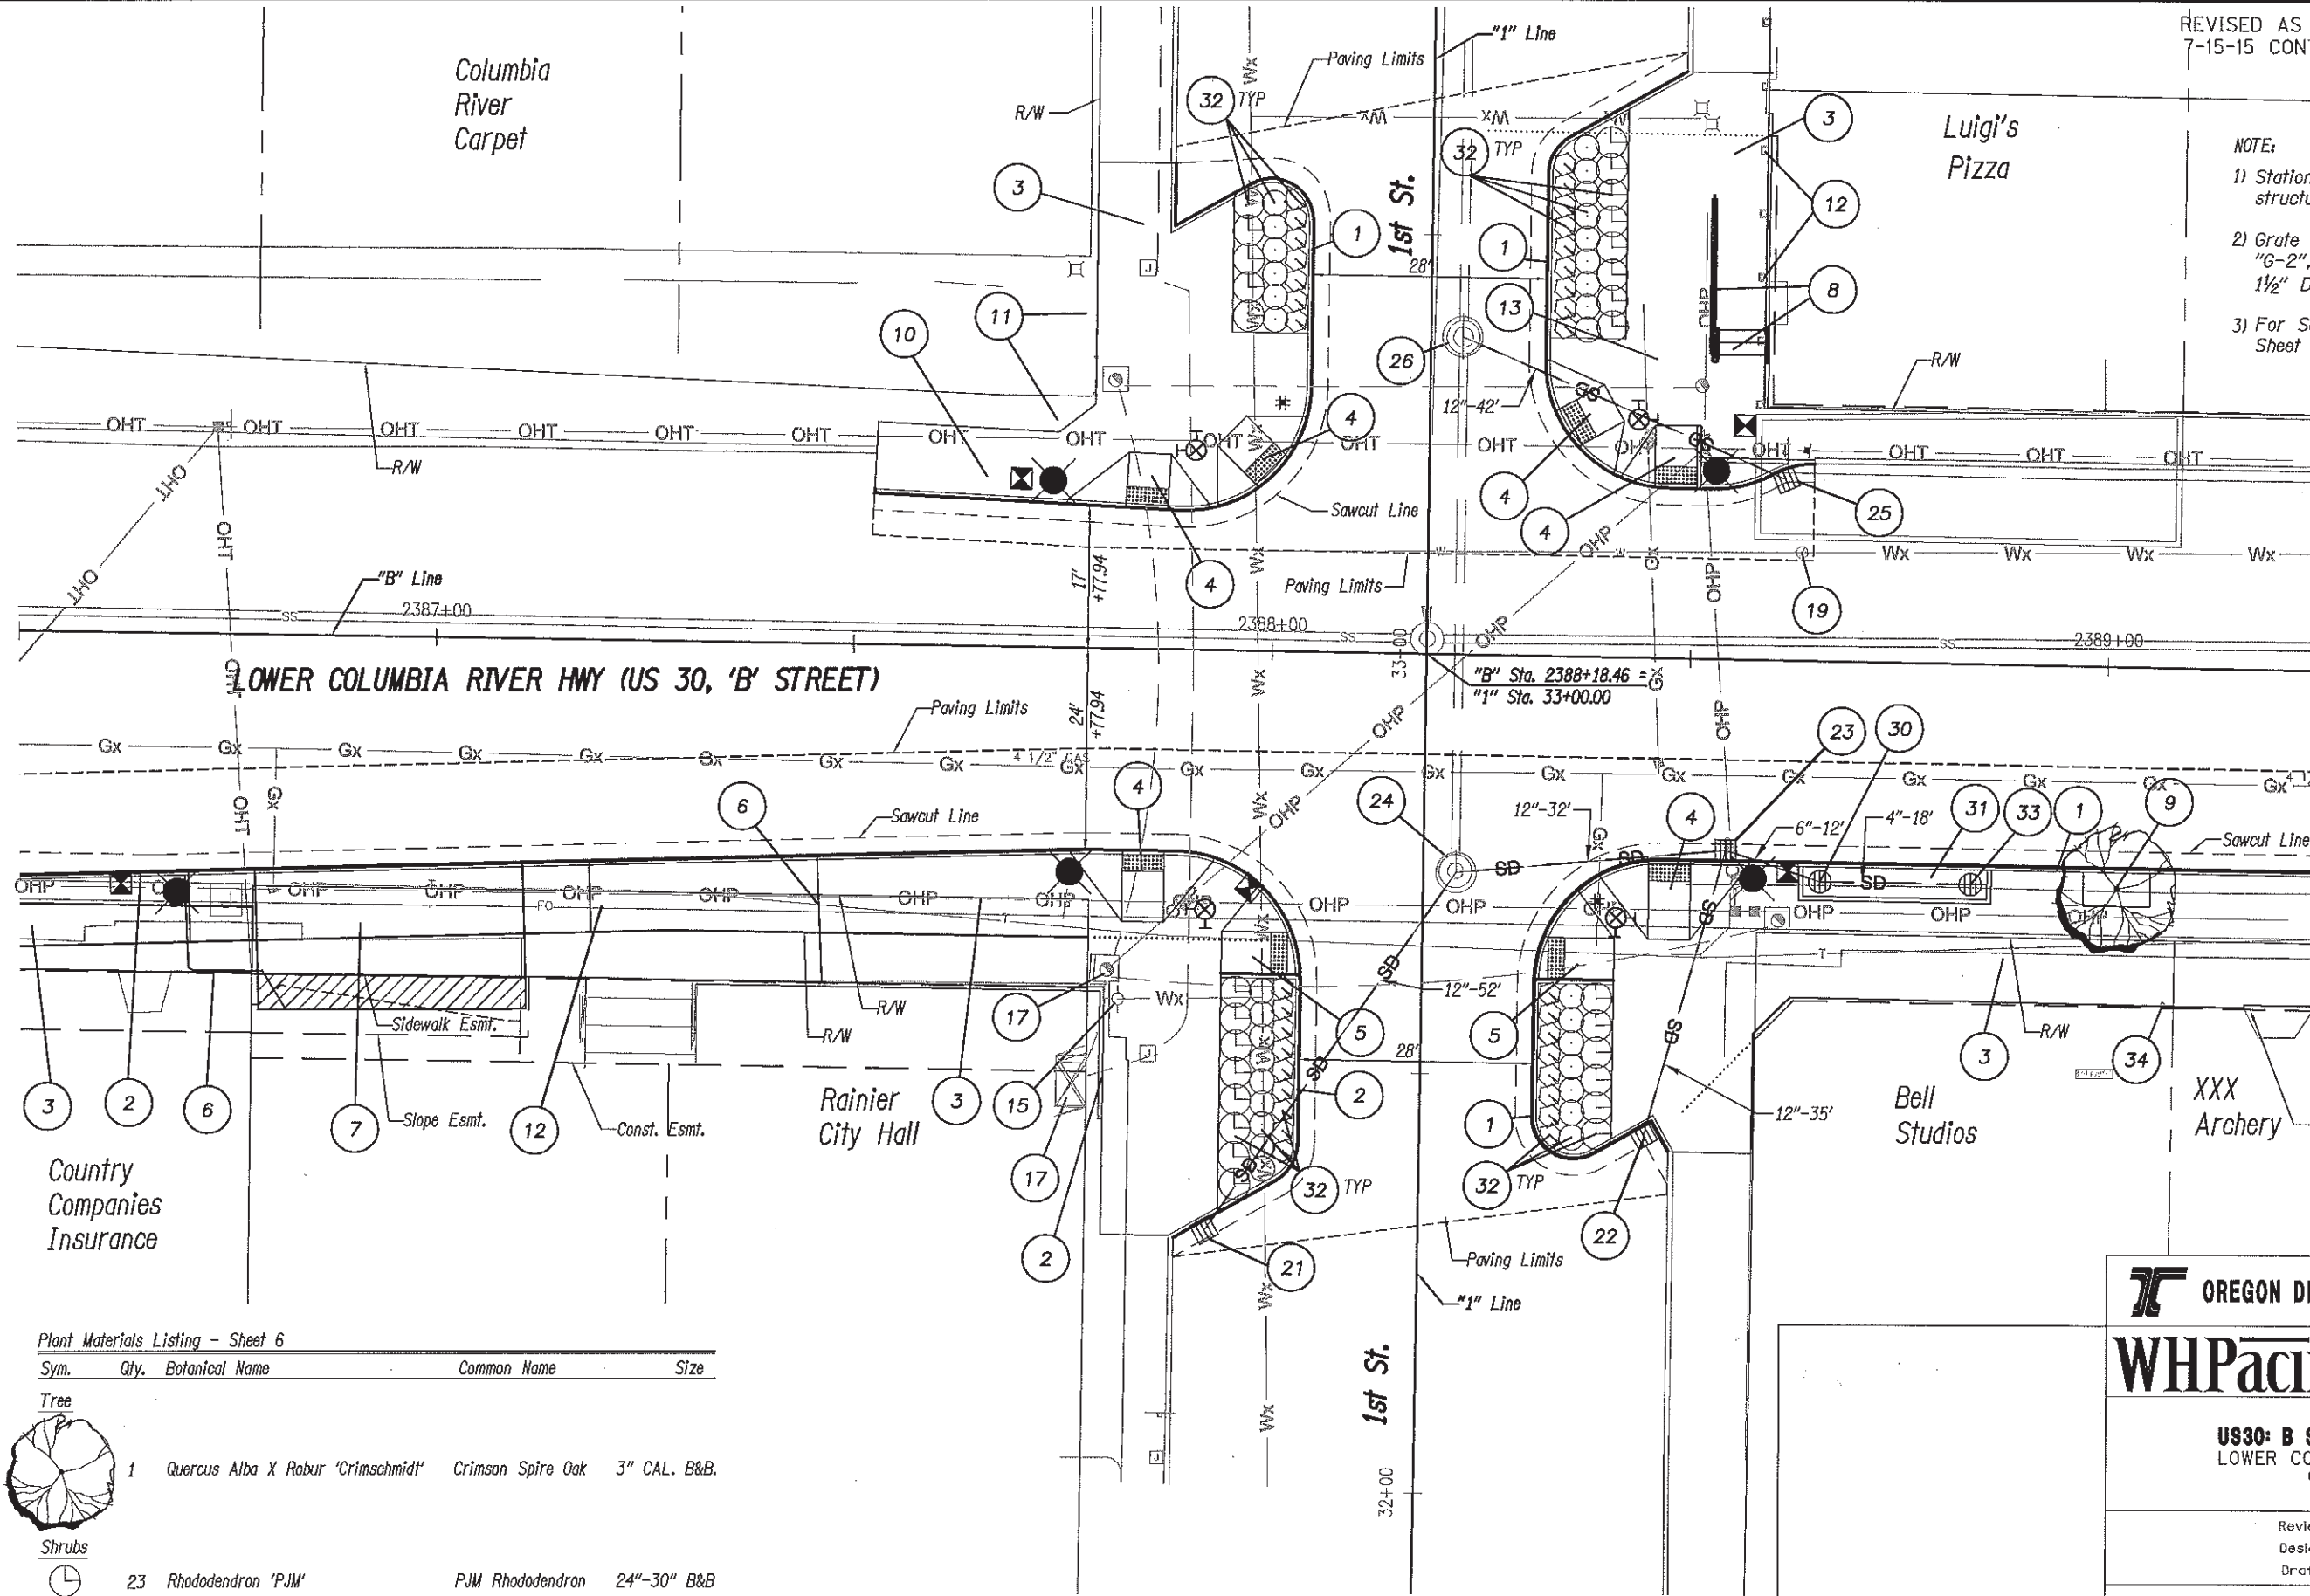

NOTE:
 1) Station / offset is to center of structure unless otherwise noted.
 2) Grate Elevation Call-outs For Type "G-1", "G-2", "CG-1" and "CG-2" Inlets Include 1/2" Drop at Flow Line.
 3) For Scoring See Typical Scoring Detail, Sheet 2B.

Plant Materials Listing - Sheet 6

Sym.	Qty.	Botanical Name	Common Name	Size
------	------	----------------	-------------	------

- Tree**
- 1 Quercus Alba X Robur 'Crimschmidt' Crimson Spire Oak 3" CAL. B&B.
- Shrubs**
- 23 Rhododendron 'PJM' PJM Rhododendron 24"-30" B&B
 - 26 Mahonia aquifolium 'Compacta' Compact Oregon Grape 3 Gal. Cont.
 - 28 Pennisetum alopecuroides 'Hameln' Dwarf Fountain Grass 1 Gal. Cont.

OREGON DEPARTMENT OF TRANSPORTATION

WHPacific 9755 S.W. Barnes Road Suite 300
 Portland, OR 97225
 t: 503.626.0455 f: 503.526.0775

US30: B STREET BIKE/PED PATH SEC.
 LOWER COLUMBIA RIVER HIGHWAY
 COLUMBIA COUNTY

Reviewed By - Brady Berry
 Designed By - Sarah Jones
 Drafted By - Sarah Jones

GENERAL CONSTRUCTION

SHEET NO.
6

CONSTRUCTION NOTES

- 1 Const. Standard Curb
7" Exposure
(See Drg. No. RD700)
- 2 Const. Standard Curb
5" Exposure
(See Drg. No. RD700)
- 3 Const. P.C. Conc. Walk
(For Details, See Sht. 2B)
(See Drg. No. RD720)
- 4 Const. Perpendicular Sidewalk Ramp - 4
(For Details, See Sht. 2B-7, 2B-8 & 2B-9)
(See Drg. No. RD755)
- 5 Const. Perpendicular Sidewalk Ramp
With Single Flare - 4
(For Details, See Sht. 2B-7, 2B-8 & 2B-9)
(See Drg. No. RD755)
- 6 Const. 3" PVC Rain Drain. Const. Thru
Face of Curb.
- 7 Sta. "B" 2386+94.58, 27.35' Rt.
Const. Commercial Driveway, Reinforced - 32' Wide
(See Drg. No. RD735, Option 'G')
- 8 Const. Stairs and Handrail
(See Drg. No. RD120)
- 9 Install Deciduous Tree - 3" Cal.
(For Street Tree Legend, See Sht. 5)
- 10 Const. P.C. Conc. Transition Between Extg. Pavement
and New Walk (For Details, See Sht. 2B-7)
- 11 Const. Paving Wedge Behind New Sidewalk. Daylight
Paving at 3:1
- 12 Existing Bin Wall Found 10-12" from Building Face.
Cantilever Sidewalk Constructed. No. 4 Reinforcement
Installed with Thickened Concrete Edge and Stay in
Place Metal form.
- 13 (remove note and number)
- 14 (remove note and number)
- 15 Sta. "B" 2387+82.11, 41.76' Rt.
Adjust Hydrant to Finished Sidewalk Grade
- 16 (remove note and number)
- 17 (remove note and number)
- 18 (remove note and number)
- 19 (remove note and number)
- 20 (remove note and number)
- 21 Sta. "B" 2387+92.50, 64.60' Rt.
Const. Type G-1 Inlet (No Sump)
Over Extg. Pipe
Top Grate Elev. at F.L. = 49.84
Adjust I.E. (Out) as Required
(See Drg. No. RD364)
- 22 Sta. "B" 2388+45.30, 56.88' Rt.
Const. Type G-1 Inlet (No Sump)
Top Grate Elev. at F.L. - 49.53
(See Drg. No. RD364)
- 23 Sta. "B" 2388+54.61, 22.74' Rt.
Const. Type G-2 Inlet (No Sump)
Top Grate Elev. at F.L. - 47.38
Inst. 12" Sew. Pipe - 35'
5' Depth
Inst. 6" Sew. Pipe - 12'
5' Depth
I.E. (12" Out) - 46.10
Sl. 6.00%
(See Drg. No. RD364)
- 24 Sta. "B" 2388+22.4, 26.0' Rt.
Connect To Extg. Manhole
Inst. 12" Sew. Pipe - 84'
5' Depth
(For Profiles, See Sht. 6C)
- 25 Sta. "B" 2388+61.00, 21.98' Lt.
Const. Type G-2 Inlet (No Sump)
Top Grate Elev. at F.L. - 45.64.
I.E. (12" Out)=42.19.
(See Drg. No. RD364)
- 26 Sta. "B" 2388+22.3, 37.9' Lt.
Connect to Extg. Manhole
Inst. 12" Sew. Pipe - 42'
5' Depth
- 27 (remove note and number)
- 28 (remove note and number)
- 29 (remove note and number)
- 30 Sta. "B" 2388+65.94, 26.25' Rt.
Inst. Overflow Structure
Rim Elevation Per Detail - 47.87
Inst. 4" Perf. Sew. Pipe - 18'
(For Details, See Sht. 2B-2)
- 31 Sta. "B" 2388+63.94 to 2388+85.94, Rt.
Const. Water Quality Planter
(For Details, See Sht. 2B-2)
- 32 Install Plant Materials.
(See Plant Materials List, Sht. 6)
- 33 Sta. "B" 2388+83.94, 26.25' Rt.
Inst. Overflow Structure
Rim Elevation Per Detail - 49.38

Tree Well Data Table	
Station	Offset
"B" 2389+01.47	26.43' Rt.

 OREGON DEPARTMENT OF TRANSPORTATION

WHPacific 9755 S.W. Barnes Road Suite 300
Portland, OR 97225
t: 503.626.0455 f: 503.526.0775

US30: B STREET BIKE/PED PATH SEC.
LOWER COLUMBIA RIVER HIGHWAY
COLUMBIA COUNTY

Reviewed By - Brady Berry
Designed By - Sarah Jones
Drafted By - Sarah Jones

CONSTRUCTION NOTES

SHEET
NO.
6A