

# OPERATION & MAINTENANCE MANUAL

## Water Quality Bioretention Pond

Manual prepared: September 2019

DFI No. D00927



Figure 1: DFI No. D00927, looking West

### 1. Identification

|                             |                                 |
|-----------------------------|---------------------------------|
| Drainage Facility ID (DFI): | D00927                          |
| Facility Type:              | Water Quality Bioretention Pond |
| Construction Drawings:      | (V-File Numbers) 49V-060        |
| Location:                   | District: 1                     |
|                             | Highway No.: 009                |
|                             | Mile Post: 65.61 to 65.62, Left |

## 2. Manual Purpose

The purpose of this manual is to outline inspection needs and summarize maintenance actions for stormwater ponds.

## 3. Facility Location

The location map below details the facility location. The highway, mile posts, side streets, access location, and stormwater flow directions are noted on the map.

Facility location type: Roadway shoulder

Flow direction: South to North




Figure 2: D00927 facility location map

## 4. Facility Summary

The pond size is based on storage volume, the bottom and top surface areas and the depth are used for this measurement.

The bottom area and top area of the pond is:

| Bottom Area (sq. ft.) | Top Area (sq. ft.) |
|-----------------------|--------------------|
| 2,167                 | 6,509              |

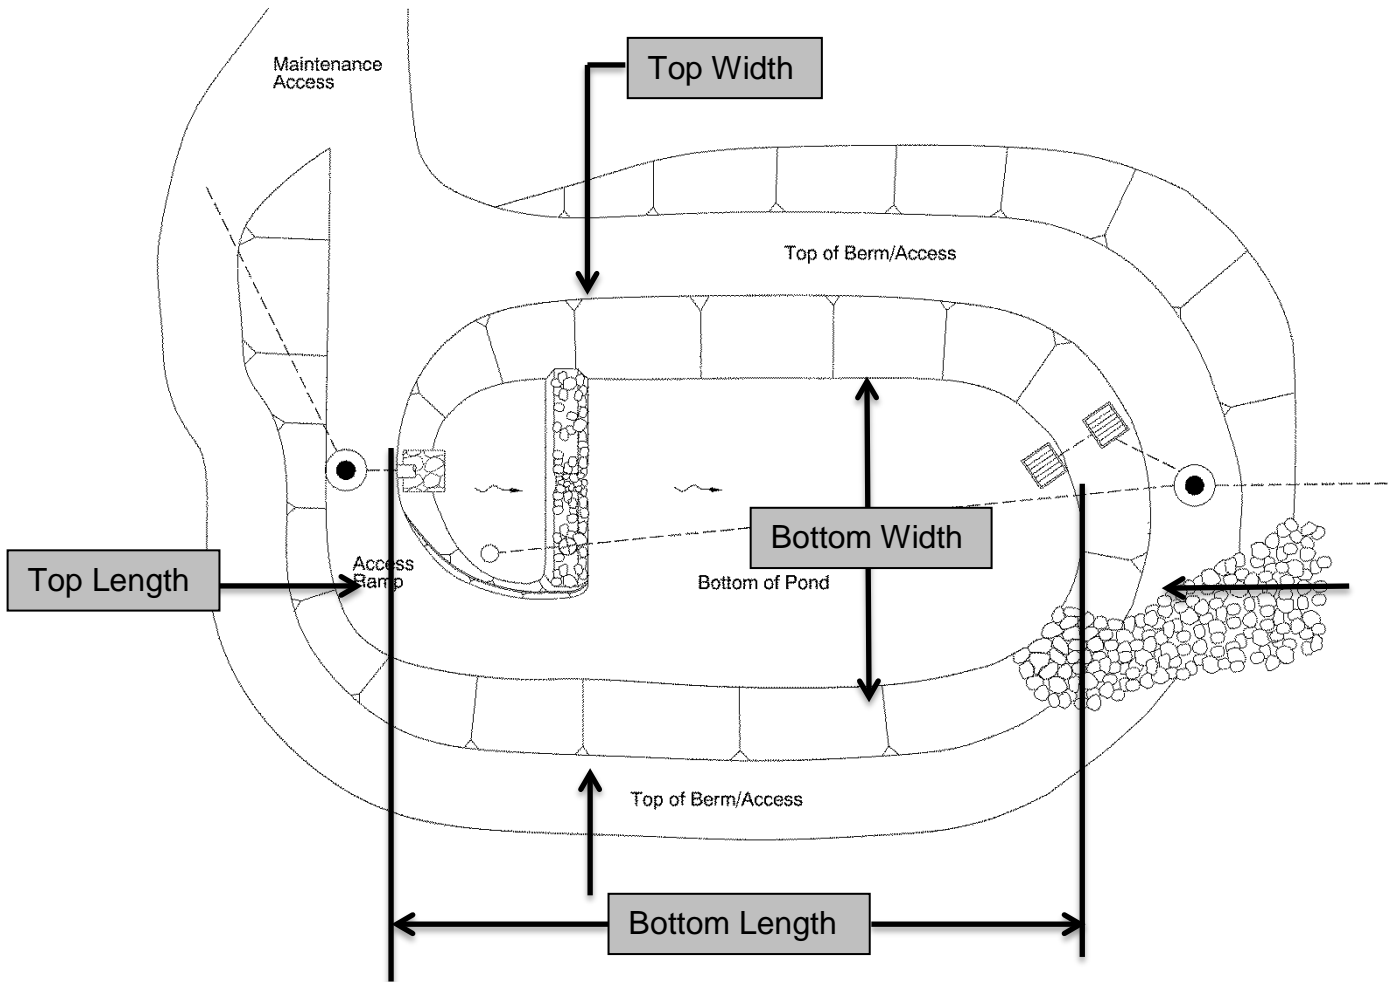


The depth of the pond is the vertical distance measured from the bottom of the pond to the top. The slope of the pond sides is presented by a vertical distance (rise) followed by the horizontal distance (run).

Depth and side slopes:

|                     |
|---------------------|
| <b>Depth (feet)</b> |
| 4                   |

|                    |   |
|--------------------|---|
| <b>Side Slope</b>  |   |
| <b>Rise (feet)</b> | 1 |
| <b>Run (feet)</b>  | 4 |

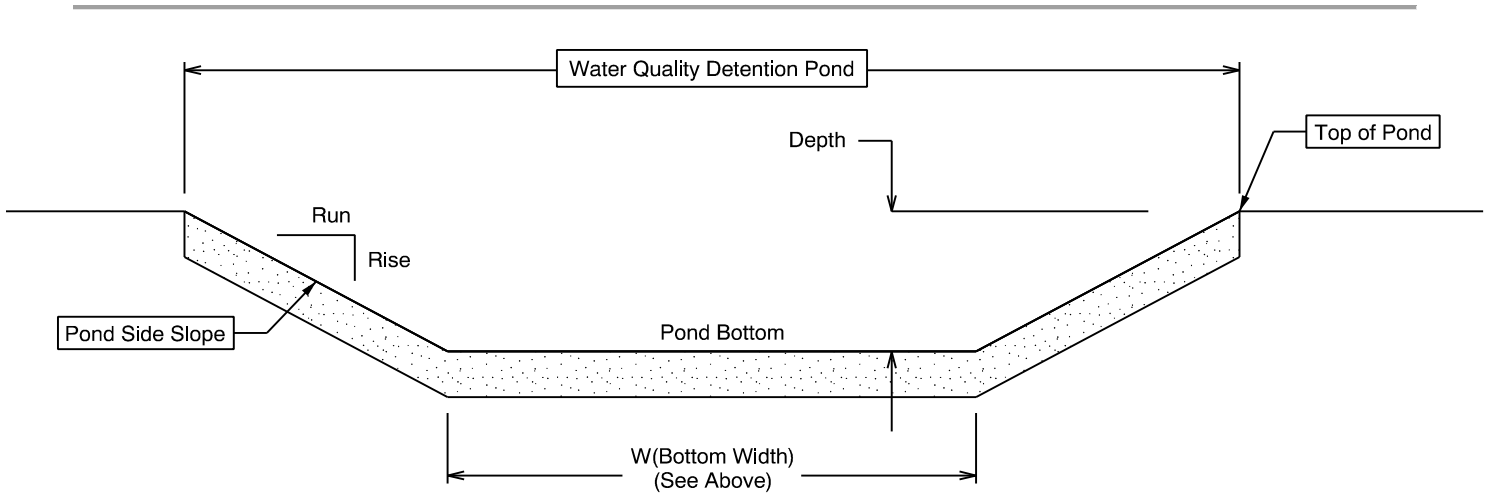

**Site Specific Information:**

Water flows from the gutter and enters the pond from a storm drain pipe and falls onto riprap before making contact with the plants and water quality soil mix. Below the 24" of water quality soil mix 3" of filter rock and 12" of granular drain rock exist. An impermeable liner lines the bottom and walls of the planter box. Finally, water exits the system through a 6" perf pipe and into the storm drain system. A clean out for the 6" pipe is shown in Appendix A.



## Facility Access

Maintenance access to the facility:

|  |   |
|--|---|
| <input type="checkbox"/> Roadside pad          | <input checked="" type="checkbox"/> Roadside shoulder |
| <input type="checkbox"/> Access road with Gate | <input type="checkbox"/> Access road without Gate     |



Figure 3: looking North

## 5. Operational Components / Maintenance Items

### Classification and Standard Operational (Op) Plan:

This facility is classified as a:

|  |   |  |   |
|--|---|--|---|
| <input type="checkbox"/> Detention Pond<br>(Op Plan A)   | <input checked="" type="checkbox"/> WQ Bioretention Pond<br>(Op Plan B) | <input type="checkbox"/> WQ Extended Detention Dry Pond<br>(Op Plan C) | <input type="checkbox"/> WQ Detention Pond/Biofiltration Swale Combo<br>(Op Plan D) |
| A standard operational plan illustrates the general facility footprint configuration and explains the purpose of each facility component. Operational plans (A,B,C,D) are provided in the Standard Operation Manual. |   |  |   |

See Appendix A for the site specific operational plan.

### Key Features/Items:

This facility is classified as a:

|   |   |
|---|---|
| <input checked="" type="checkbox"/> Dry Pond                                      | <input type="checkbox"/> Wet Pond   |
| The pond is wet during storm events and dries during periods of no precipitation. | The pond has constant presence of water year round. A portion of the pond dries during periods of no precipitation. |

This facility includes a **high flow bypass component**:

|   |   |
|---|---|
| <input checked="" type="checkbox"/> No  | <input type="checkbox"/> Yes  |
| There is no bypass component. High flows drains into and through the facility | There is a bypass component. Only low/small flows drain into the pond. High flows are diverted around the pond using a bypass component |

This facility includes a **proprietary structure(s)**:

|  |   |
|--|---|
| <input checked="" type="checkbox"/> No                             | <input type="checkbox"/> Yes (DXXXXX)   |
| There are no proprietary structures associated with this facility. | A proprietary structure is used in the operation of this facility. The proprietary structure is a/an: <b>describe</b> |

## Operational Components

The facility components table (**Table 1**) has been provided to highlight the applicable components for this facility. The component is in use when the box contains an “x” (e.g.  ).

The Standard Operation Manual for Ponds (implemented **May 2019**) outlines facility operation, typical footprint configuration, and component definitions and details. A link to the manual is attached to the feature marker in TransGIS.

<https://gis.odot.state.or.us/TransGIS/>

## Maintenance Items

Operational components marked in **Table 1** should be inspected and maintained according to Section 7. Each facility component is defined and detailed in the Standard Operation Manual using the associated ID number indicated in the table below.

| <b>Table 1: Stormwater Pond Components</b>     |                                     | <b>ID #</b> |
|--|-------------------------------------|-------------|
| <b>Upstream Manholes/Structures</b>            |                                     |             |
| Pre-treatment Manhole<br>Type: <b>describe</b> | <input type="checkbox"/>            | <b>P1</b>   |
| Water Quality Manhole<br>Type: <b>describe</b> | <input checked="" type="checkbox"/> | <b>P2</b>   |
| Flow Splitter Manhole ( <b>Weir/Orifice</b> )  | <input type="checkbox"/>            | <b>P3</b>   |
| Standard Manhole                               | <input type="checkbox"/>            | <b>P4</b>   |
| Sediment Basin/Forebay                         | <input type="checkbox"/>            | <b>P5</b>   |
| Forebay Dewatering Riser Pipe (outlet)         | <input type="checkbox"/>            | <b>P6</b>   |
| <b>Facility Inlet</b>                          |                                     |             |
| Pavement Sheet Flow                            | <input checked="" type="checkbox"/> | <b>P7</b>   |
| Inlet Pipe(s)                                  | <input checked="" type="checkbox"/> | <b>P8</b>   |
| Open Channel Inlet                             | <input type="checkbox"/>            | <b>P9</b>   |
| Riprap Pad (Energy Dissipater)                 | <input checked="" type="checkbox"/> | <b>P10</b>  |
| <b>Ground Cover</b>                            |                                     |             |
| Grass Bottom                                   | <input checked="" type="checkbox"/> | <b>P11</b>  |
| Grass Side Slopes                              | <input checked="" type="checkbox"/> | <b>P12</b>  |
| Granular Drain Rock                            | <input checked="" type="checkbox"/> | <b>P13</b>  |
| Plantings                                      | <input checked="" type="checkbox"/> | <b>P14</b>  |
| <b>Underground Components</b>                  |                                     |             |
| Geotextile Fabric: <b>Specify Type</b>         | <input type="checkbox"/>            | <b>P15</b>  |
| Impermeable Liner                              | <input checked="" type="checkbox"/> | <b>P16</b>  |
| Water Quality Mix                              | <input checked="" type="checkbox"/> | <b>P17</b>  |
| Perforated Pipe                                | <input checked="" type="checkbox"/> | <b>P18</b>  |
| Bottom Marker (ex. Porous Pavers)              | <input checked="" type="checkbox"/> | <b>P19</b>  |

| <b>Flow Spreader</b>   |  |            |
|--|--|------------|
| Anchored Board (midpoint of pond or every 50 feet along pond bottom) | <input type="checkbox"/>                     | <b>P20</b> |
| Other: <i>describe</i>   | <input type="checkbox"/>                     | <b>P21</b> |
| <b>Facility Outlet</b>   |  |            |
| Catch Basin with Grate   | <input checked="" type="checkbox"/>          | <b>P22</b> |
| Outlet Pipe(s)   | <input checked="" type="checkbox"/>          | <b>P23</b> |
| Outlet/Flow Control Structure  | <input type="checkbox"/>                     | <b>P24</b> |
| Auxiliary Outlet   | <input type="checkbox"/>                     | <b>P25</b> |
| Hazmat Control Valve: <i>Specify make/model</i>                      | <input type="checkbox"/>                     | <b>P26</b> |
| <b>Outfall Type</b>  |  |            |
| Waterbody (Creek/Lake/Ocean)   | <input checked="" type="checkbox"/> <b>C</b> | <b>P27</b> |
|  | <input type="checkbox"/> <b>L</b>            |            |
|  | <input type="checkbox"/> <b>O</b>            |            |
| Ditch  | <input type="checkbox"/>                     | <b>P28</b> |
| Storm Drain System   | <input type="checkbox"/>                     | <b>P29</b> |
| <b>Outfall Components</b>  |  |            |
| Riprap Pad   | <input type="checkbox"/>                     | <b>P30</b> |
| Riprap Bank Protection   | <input type="checkbox"/>                     | <b>P31</b> |

## 6. Maintenance

### Maintenance Frequency/Maintain Records

- a. Inspect annually. Preferably prior to the rainy season.
- b. Clean and maintain as necessary. Refer to Activity 125 in the Maintenance Guide for conditions when maintenance is needed.
- c. Keep a record of inspections, maintenance, and repairs.

### Maintenance Guide/Maintenance Actions

The Maintenance Guide outlines the standard maintenance actions for water quality facilities under Activity 125.

There are standard maintenance tables for standard ODOT designs. The maintenance tables describe the maintenance component, the defect or problem, the condition when maintenance is needed, and the recommended maintenance to correct the problem. Use the following tables to maintain ODOT Ponds:

- Table 1 (General Maintenance): Contains general maintenance and inspection guidelines that are applicable to all ODOT water quality facilities
- Table 2 (Maintenance of Stormwater Ponds): Contains maintenance information for ponds



The ODOT Maintenance Guide can be viewed at the following website:  
<http://www.oregon.gov/ODOT/HWY/OOM/pages/mguide.aspx>

The Blue Book can be viewed at the following website:  
[http://www.oregon.gov/ODOT/Maintenance/Documents/blue\\_book.pdf](http://www.oregon.gov/ODOT/Maintenance/Documents/blue_book.pdf)

## 7. Limitations

There are access limitations for this facility:

|  |   |
|--|---|
| <input type="checkbox"/> No                        | <input checked="" type="checkbox"/> Yes |
| There are no porous pavers installed in this pond. |   |

Ponds are designed to allow equipment access along the bottom if an access grid is installed. If an access grid is NOT installed, vehicles entering the pond can create depressions (tire ruts), damage vegetation, or damage structural components (e.g. flow spreaders). These conditions may result in poor treatment and drainage performance.

If no access grid then: Equipment wheels should be kept on the tops and side slopes. Mower arms may be run along the pond bottom.

## 8. Waste Material Handling

Material removed from the facility is defined as waste by the Department of Environmental Quality (DEQ). Refer to the road waste section of the ODOT Maintenance Yard Environmental Management System (EMS) Policy and Procedures Manual for disposal options:

<http://www.oregon.gov/ODOT/HWY/OOM/pages/ems.aspx>


Contact any of the following for more detailed information about management of waste materials found on site:

|                                   |                |
|-----------------------------------|----------------|
| ODOT Clean Water Unit             | (503) 986-3008 |
| ODOT Statewide Hazmat Coordinator | (503) 667-7442 |
| ODOT Region 1 Hazmat Coordinator  | (503) 731-8290 |
| ODOT Region 2 Hazmat Coordinator  | (503) 986-2647 |
| ODOT Region 3 Hazmat Coordinator  | (541) 957-3594 |
| ODOT Region 4 Hazmat Coordinator  | (541) 388-6186 |
| ODOT Region 5 Hazmat Coordinator  | (541) 963-1590 |
| ODEQ Northwest Region Office      | (503) 229-5263 |

## **A Appendix A – Site Specific Operational Plan**


### **Contents:**

**Operational Plan: DFI D00927**

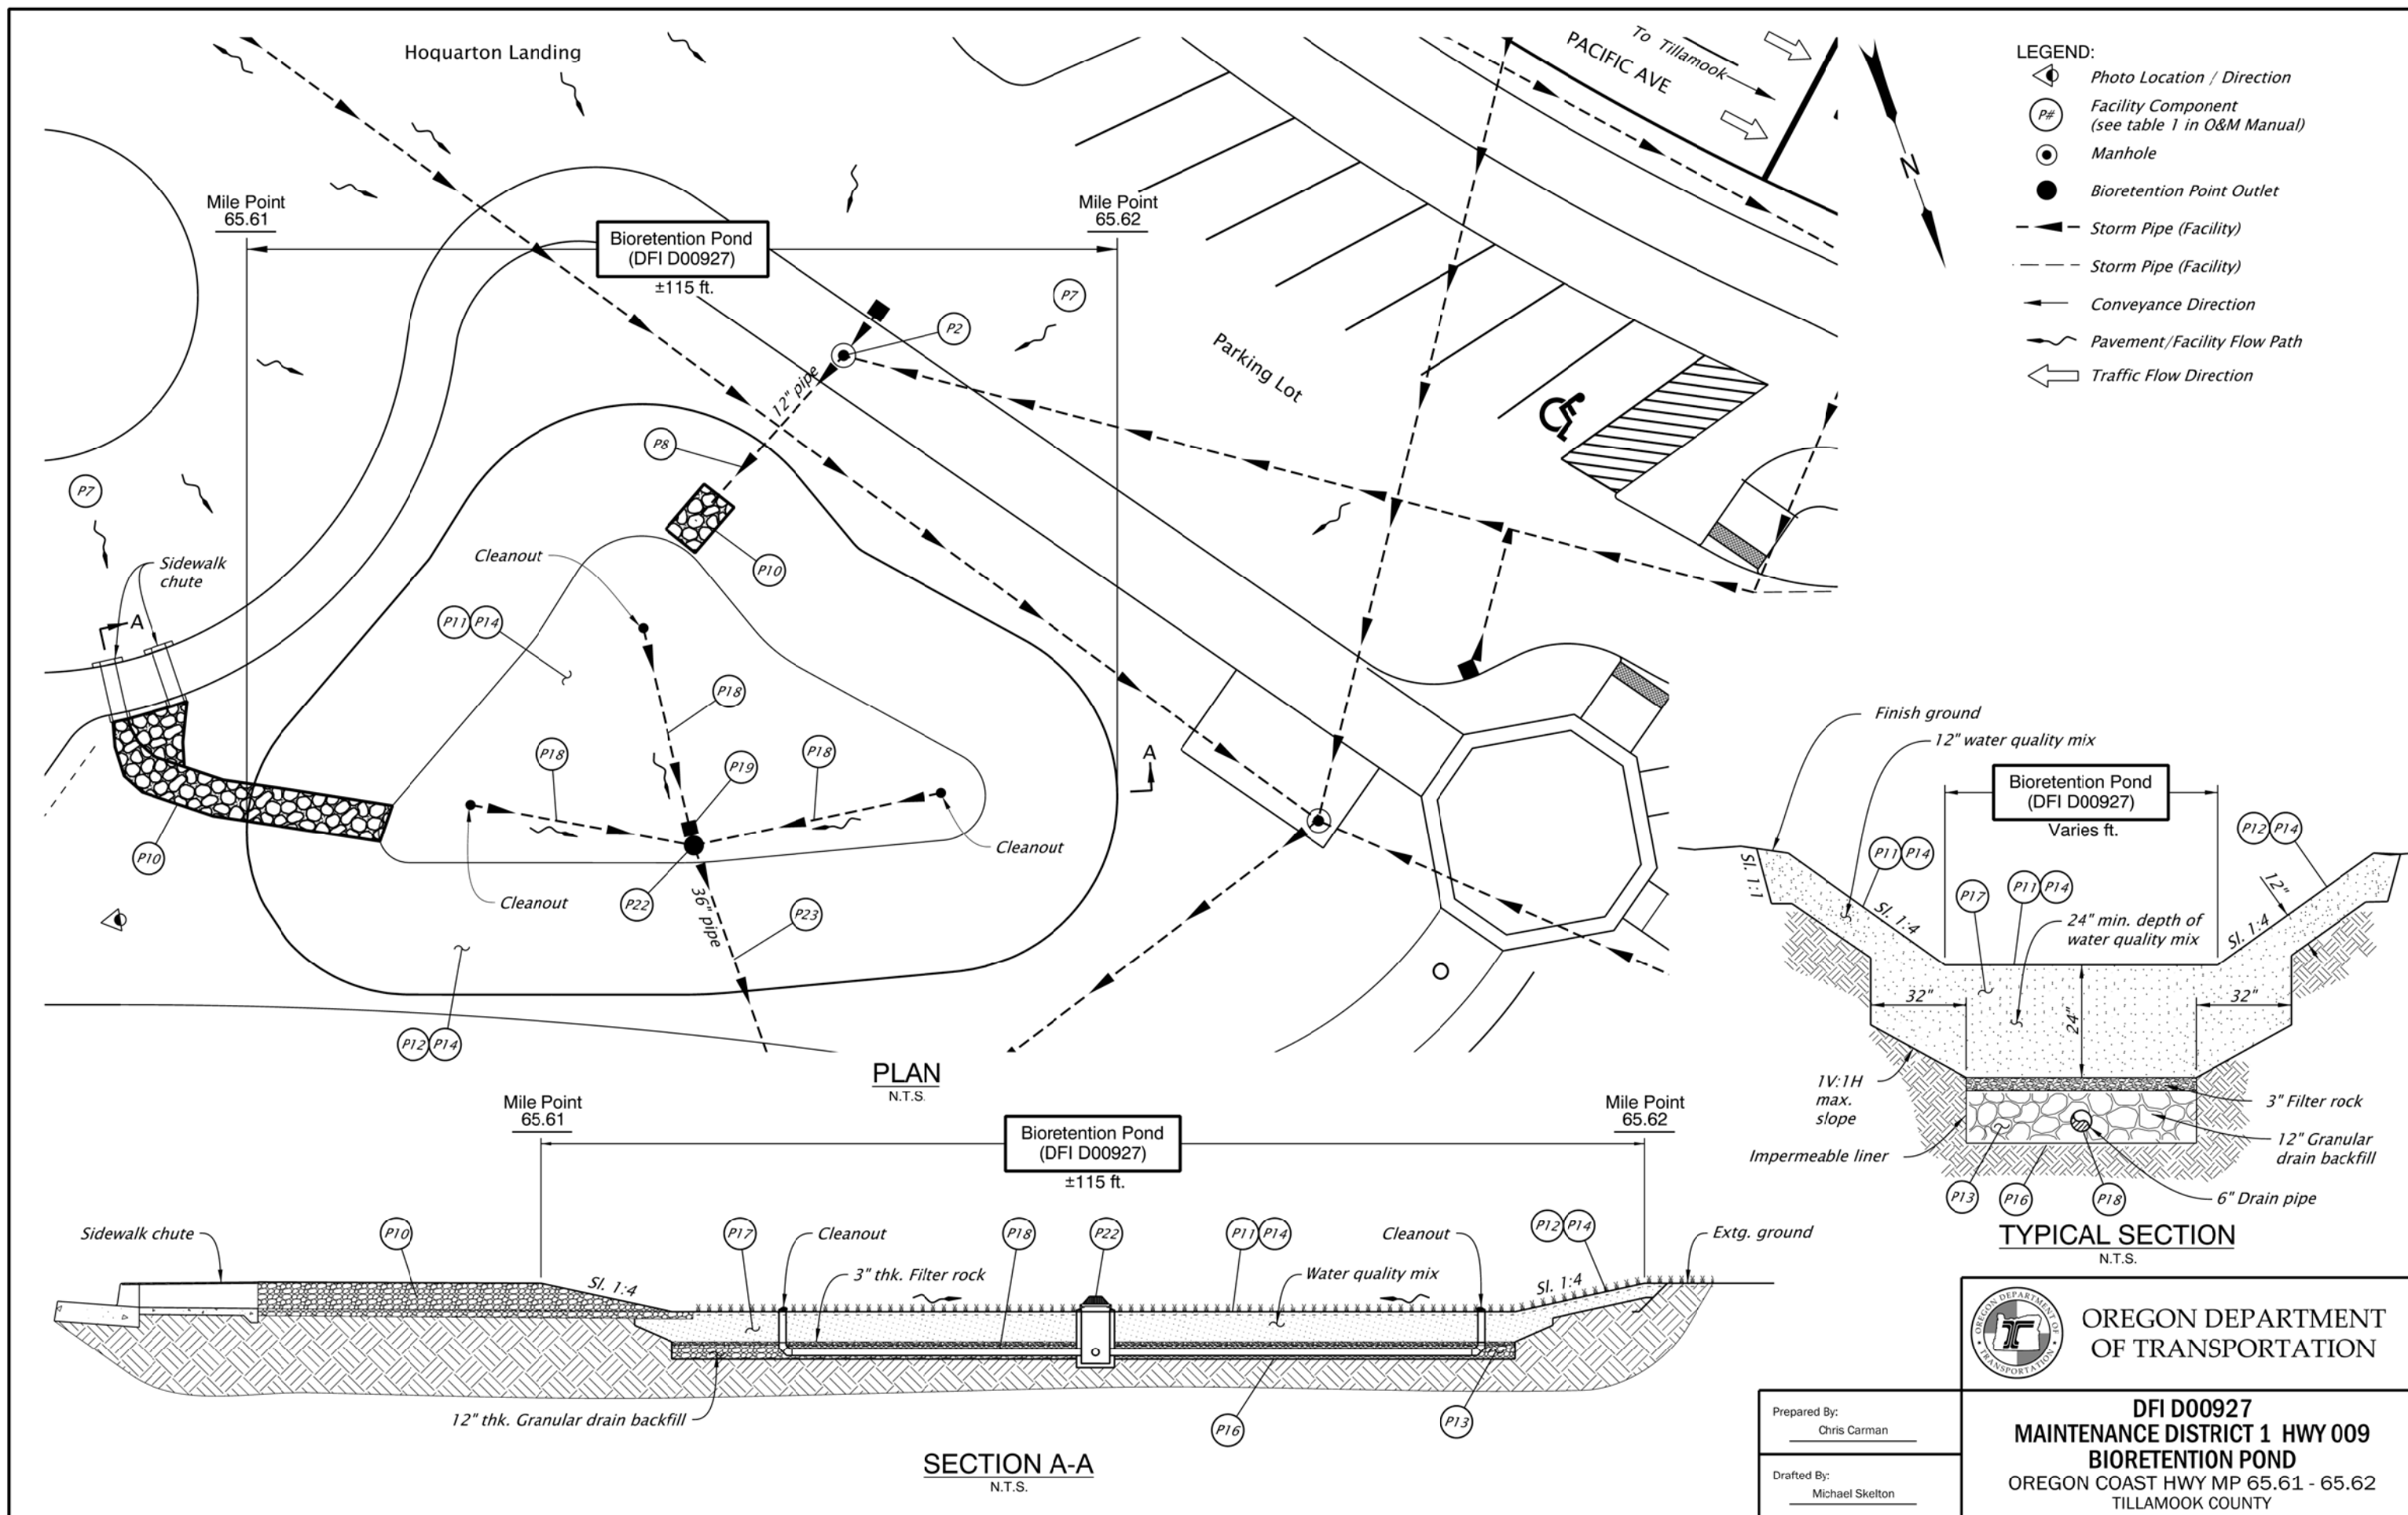

- LEGEND:**
- Photo Location / Direction
  - Facility Component (see table 1 in O&M Manual)
  - Manhole
  - Bioretention Point Outlet
  - Storm Pipe (Facility)
  - Storm Pipe (Facility)
  - Conveyance Direction
  - Pavement/Facility Flow Path
  - Traffic Flow Direction

**PLAN**  
N.T.S.

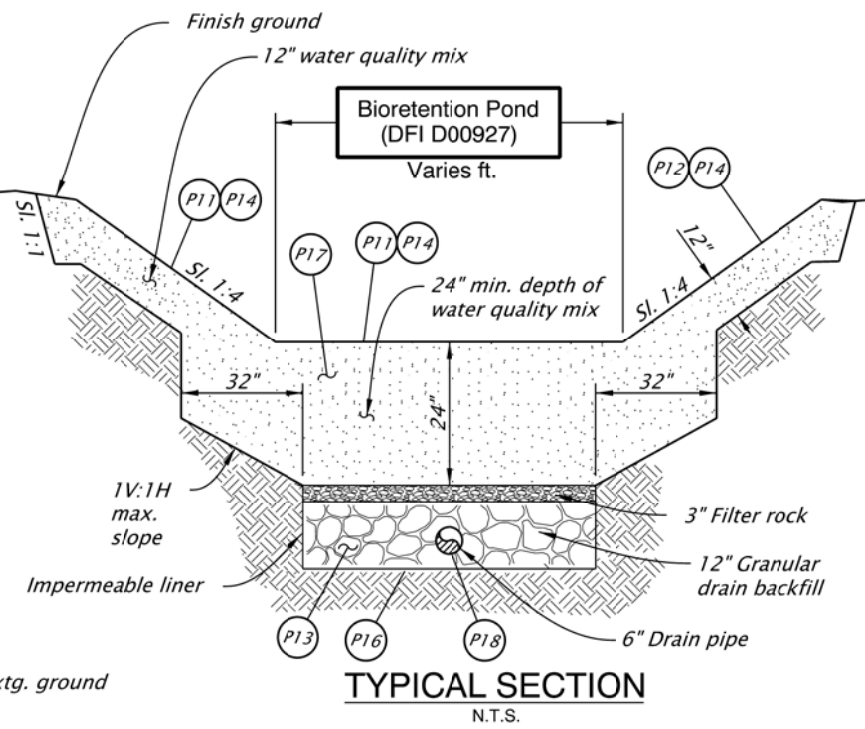

**TYPICAL SECTION**  
N.T.S.

**SECTION A-A**  
N.T.S.

OREGON DEPARTMENT OF TRANSPORTATION

Prepared By:  
Chris Carman

Drafted By:  
Michael Skelton

**DFI D00927**  
**MAINTENANCE DISTRICT 1 HWY 009**  
**BIORETENTION POND**  
OREGON COAST HWY MP 65.61 - 65.62  
TILLAMOOK COUNTY


## **B Appendix B – Project Contract Plans**

### **Contents:**

**Site Specific Subset of Project Contract Plan 49V-060**

| INDEX OF SHEETS |                       |
|-----------------|-----------------------|
| SHEET NO.       | DESCRIPTION           |
| 1               | Title Sheet           |
| 1A, 1A-2        | Index Of Sheets Cont. |
| 1A-3            | Std. Drg. Nos.        |
| 1A-5            | Index of Sheets Cont. |
| 1B              | Plan Sheet Layout     |

STATE OF OREGON  
 DEPARTMENT OF TRANSPORTATION  
 PLANS FOR PROPOSED PROJECT  
**GRADING, DRAINAGE, STRUCTURES, PAVING, SIGNING, ILLUMINATION,  
 SIGNALS, & ROADSIDE DEVELOPMENT**

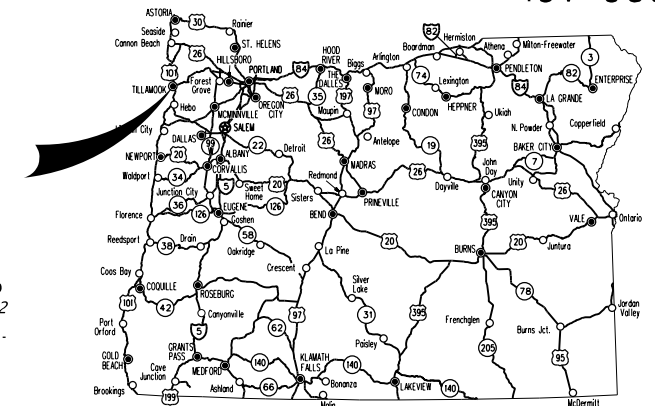


REVISED AS CONSTRUCTED  
 4/19/19 CONTRACT C14902  
 PROJ. MGR. Ian Machan

**US101 @ OR6 (TILLAMOOK) SEC.**  
**OREGON COAST HWY. & WILSON RIVER HWY.**  
 TILLAMOOK COUNTY  
 MAY 2016

Overall Length Of Project - 0.4 Miles

**ATTENTION:**  
 Oregon Law Requires You To Follow Rules  
 Adopted By The Oregon Utility Notification  
 Center. Those Rules Are Set Forth In  
 OAR 952-001-0010 Through OAR 952-001-0090.  
 You May Obtain Copies Of The Rules By Calling  
 The Center. (Note: The Telephone Number For  
 The Oregon Utility Center Is (503) 232-1987.)

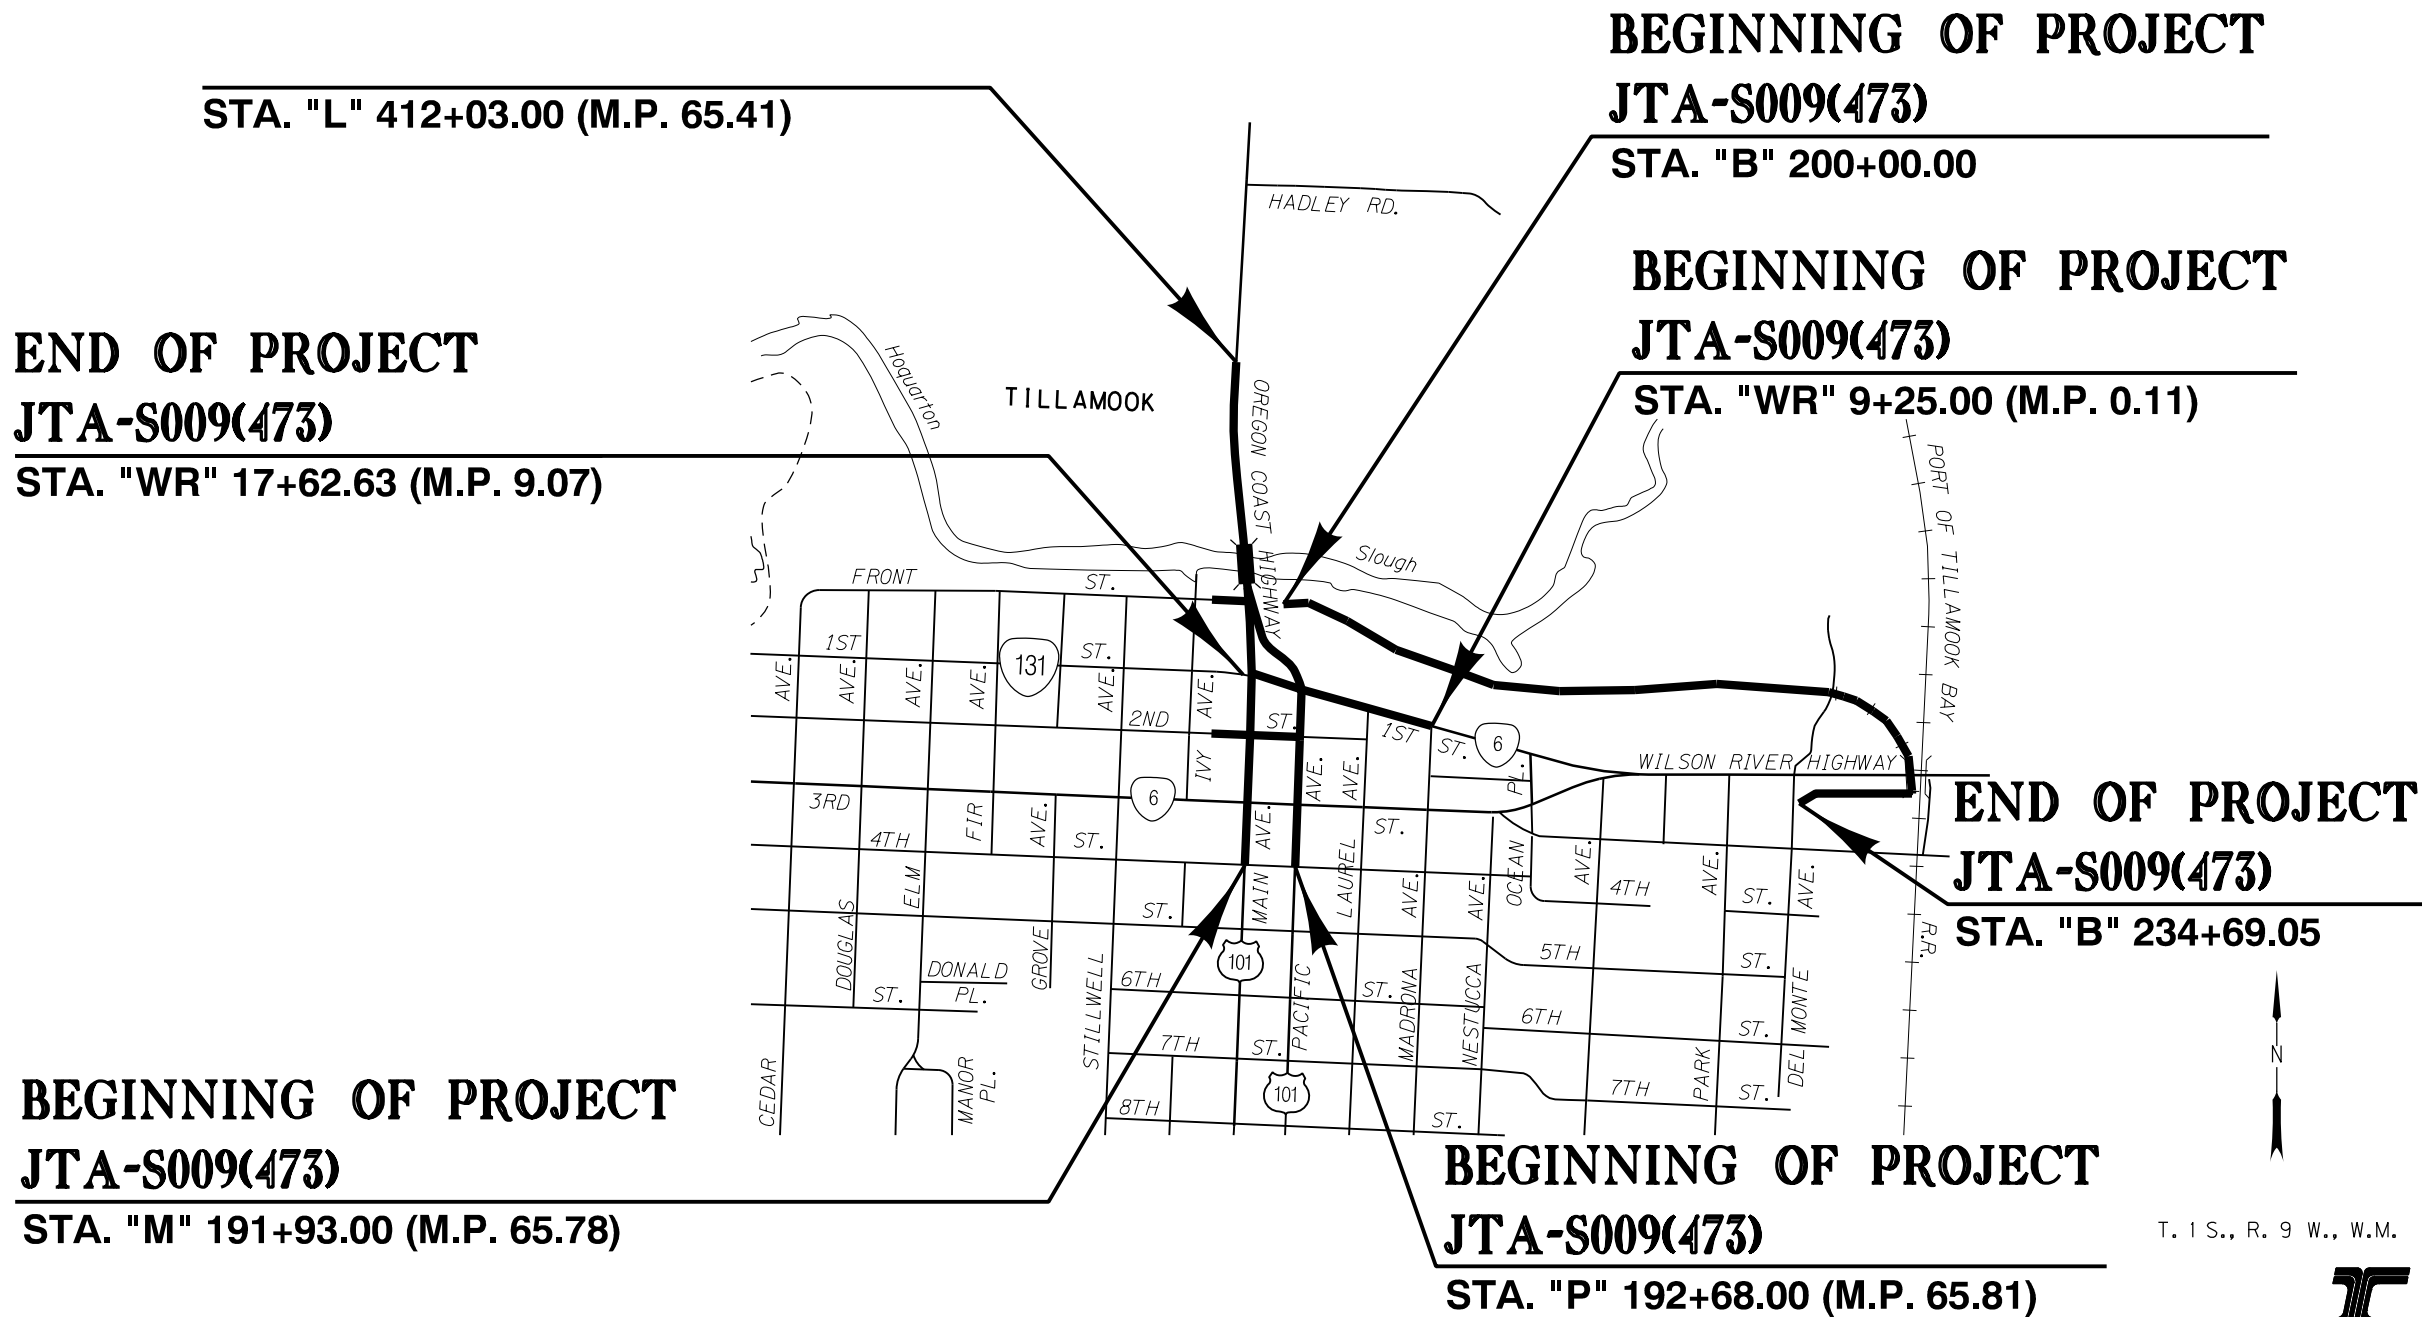

OREGON TRANSPORTATION COMMISSION

|                    |                            |
|--------------------|----------------------------|
| Tammy Baney        | CHAIR                      |
| David Lohman       | COMMISSIONER               |
| Susan Morgan       | COMMISSIONER               |
| Alando Simpson     | COMMISSIONER               |
| Sean O'Hallaren    | COMMISSIONER               |
| Matthew L. Garrett | DIRECTOR OF TRANSPORTATION |

PLANS PREPARED FOR  
 OREGON DEPARTMENT OF TRANSPORTATION

**QUINCY**  
 ENGINEERING

These plans were developed using ODOT design standards. Exceptions to these standards, if any, have been submitted and approved by the ODOT Chief Engineer or their delegated authority.


Approving Authority: \_\_\_\_\_  
 Signature & date  
 Jeff W. Olson, Principal  
 Print name and title  
 \_\_\_\_\_  
 Concurrence by ODOT Chief Engineer

|  |                |           |
|--|----------------|-----------|
| <b>US101 @ OR6 (TILLAMOOK) SEC.</b><br>OREGON COAST HWY. & WILSON RIVER HWY.<br>TILLAMOOK COUNTY |                |           |
| FEDERAL HIGHWAY ADMINISTRATION   | PROJECT NUMBER | SHEET NO. |
| OREGON DIVISION  | JTA-S009(473)  | 1         |

T. I. S., R. 9 W., W.M.





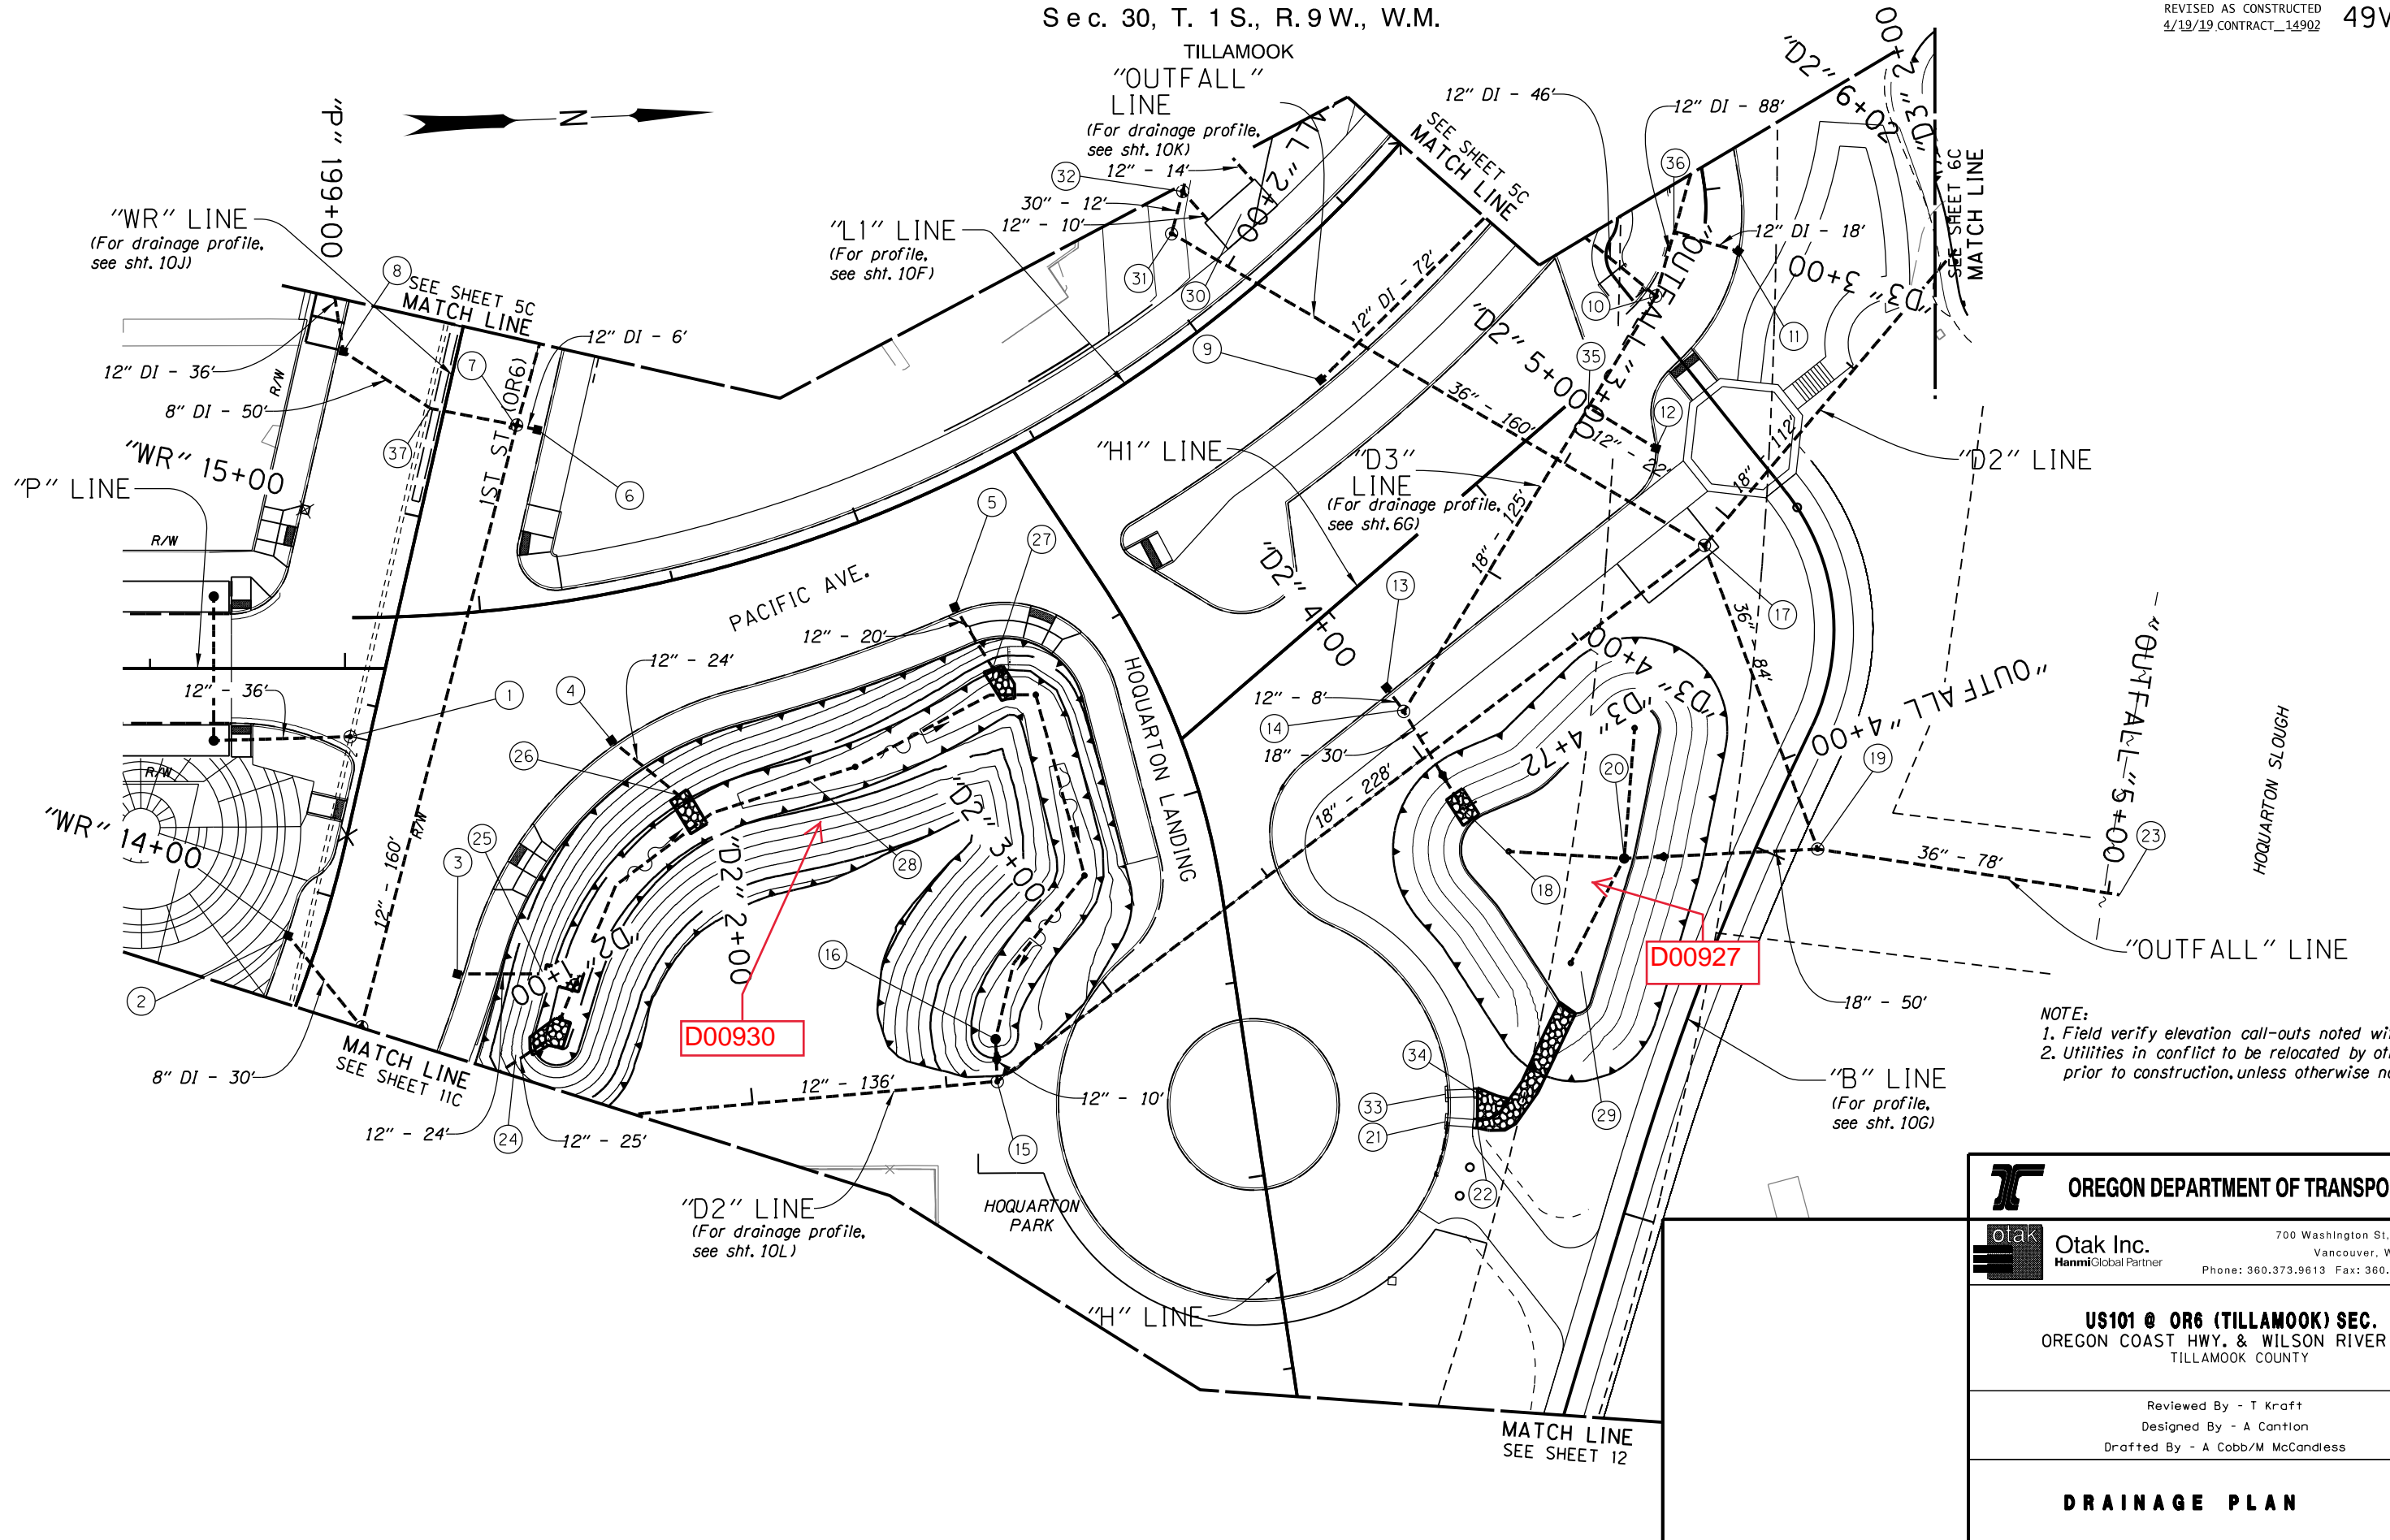




NOTE:  
 1. Field verify elevation call-outs noted with "±".  
 2. Utilities in conflict to be relocated by others prior to construction, unless otherwise noted.

|  |   |
|--|---|
|  <b>OREGON DEPARTMENT OF TRANSPORTATION</b> |   |
|  <b>Otak Inc.</b><br>HanmiGlobal Partner    | 700 Washington St, Ste. 401<br>Vancouver, WA 98660<br>Phone: 360.373.9613 Fax: 360.737.9651 |
| <b>US101 @ OR6 (TILLAMOOK) SEC.</b><br>OREGON COAST HWY. & WILSON RIVER HWY.<br>TILLAMOOK COUNTY                                 |   |
| Reviewed By - T Kraft<br>Designed By - A Cantion<br>Drafted By - A Cobb/M McCandless   |   |
| <b>DRAINAGE PLAN</b>   |   |
| SHEET NO.<br><b>10C</b>  |   |

- ① Sta. "WR" 14+41.12, 4.51' Rt.  
Const. shallow manhole  
Rim 27.39  
I.E.In= 21.08 (18" E) extg.  
I.E.In= 21.61 (12" S)  
I.E.Out= 21.08 (18" W) extg.  
Connect to extg. storm sew. pipe  
Inst. 12" storm sew. pipe - 36'  
10' depth
- ② Sta. "WR" 13+86.98, 7.84' Lt.  
Const. type G-2 inlet with sump  
Rim 27.60  
I.E.Out= 24.27 (8" NE)
- ③ Sta. "WR" 13+90.56, 36.55' Lt.  
Const. type G-2 inlet with sump  
Rim 27.00  
I.E.Out= 23.00 (12" N)
- ④ Sta. "L1" 399+27.64, 37.16' Rt.  
Const. type G-2 inlet with sump  
Rim 25.86  
I.E.Out= 21.12 (12" NE)
- ⑤ Sta. "L1" 400+13.98, 29.53' Rt.  
Const. type G-2 inlet with sump  
Rim 23.60  
I.E.Out= 19.60 (12" NE)
- ⑥ Sta. "WR" 15+28.45, 24.46' Lt.  
Const. type G-2 inlet with sump  
Rim 27.02  
I.E.Out= 23.90 (12" S)
- ⑦ Sta. "WR" 15+28.42, 19.01' Lt.  
Const. shallow manhole  
Rim 27.13  
I.E.In= 23.56 (12" N)  
I.E.In= 23.32 (12" W)  
I.E.In= 23.89 (8" S)  
I.E.Out= 23.22 (12" E)  
Connect to extg. storm sew. pipe  
Inst. 12" DI storm sew. pipe - 120'  
5' depth  
Inst. 8" DI storm sew. pipe - 50'  
5' depth
- ⑧ Sta. "WR" 15+37.00, 28.59' Rt.  
Const. type G-2 inlet with sump  
Rim 26.85  
I.E.In= 24.27 (12" W)  
I.E.Out= 24.27 (8" N)  
Inst. 12" DI storm sew. pipe - 36'  
5' depth
- ⑨ Sta. "L1" 401+16.50, 29.32' Rt.  
Const. type G-2 inlet with sump  
Rim 19.20  
I.E.Out= 15.20 (12" NW)
- ⑩ Sta. "L1" 401+89.32, 74.81' Rt.  
Const. shallow manhole  
Rim 16.41  
I.E.In= 12.85 (12" SW)  
I.E.In= 12.85 (12" W)  
I.E.Out= 12.77 (18" SE)  
Inst. 12" DI storm sew. pipe - 134'  
5' depth
- ⑪ Sta. "L1" 402+20.24, 80.71' Rt.  
Const. type G-2 inlet with sump  
Rim 15.65  
I.E.Out= 13.50 (12" SW)
- ⑫ Sta. "L1" 401+59.17, 101.25' Rt.  
Const. type G-2 inlet with sump  
Rim 16.40  
I.E.Out= 13.15 (12" SE)
- ⑬ Sta. "L1" 400+87.07, 102.29' Rt.  
Const. type G-2 inlet with sump  
Rim 18.88  
I.E.Out= 13.52 (12" NE)
- ⑭ Sta. "L1" 400+87.14, 109.31' Rt.  
Const. storm sew. pollution control manhole  
Rim 19.41  
I.E.In= 11.13 (18" NW)  
I.E.In= 13.49 (12" SW)  
I.E.Out= 11.03 (18" NE)  
Inst. 12" storm sew. pipe - 8'  
10' depth  
Inst. 18" storm sew. pipe - 125'  
10' depth
- ⑮ Sta. "L1" 399+86.75, 146.95' Rt.  
Const. std. manhole  
Rim 18.00  
I.E.In= 12.22 (12" S)  
I.E.In= 12.22 (12" W)  
I.E.Out= 8.22 (18" NW)  
Inst. 12" storm sew. pipe - 146'  
10' depth
- ⑯ Sta. "L1" 399+88.88, 136.56' Rt.  
Const. ditch inlet  
Rim 15.47  
I.E.In= 12.97 (6" W)  
I.E.Out= 12.77 (12" E)
- ⑰ Sta. "L1" 401+52.07, 127.48' Rt.  
Const. manhole, 72" dia.  
Rim 17.11  
I.E.In= 7.00 (18" SE)  
I.E.In= 6.02 (36" SW)  
I.E.In= 6.02 (18" NW)  
I.E.Out= 5.92 (36" E)  
Inst. 18" storm sew. pipe - 228'  
10' depth  
Inst. 18" storm sew. pipe - 112'  
20' depth  
Inst. 36" storm sew. pipe - 160'  
20' depth
- ⑱ Sta. "L1" 400+85.68, 139.17' Rt.  
Const. storm outfall class 50 riprap  
I.E.Out= 10.88 (18" W)  
(For details, see sht. GJ-14)  
Inst. 18" storm sew. pipe - 30'  
10' depth
- ⑲ Sta. "L1" 401+29.51, 203.86' Rt.  
Const. shallow manhole, 72" dia.  
Rim 13.00  
I.E.In= 5.84 (36" W)  
I.E.In= 7.43 (18" S)  
I.E.Out= 5.74 (36" N)  
Inst. 18" storm sew. pipe - 50'  
10' depth  
Inst. 36" storm sew. pipe - 84'  
20' depth
- ⑳ Sta. "L1" 400+03.58, 173.81' Rt.  
Const. beehive inlet  
Rim 11.55  
I.E.Out= 7.68 (18" N)  
(For details, see sht. GJ-12)
- ㉑ Sta. "H" 11+93.10, 48.16' Lt.  
Inst. concrete channel inlet without conc. splash pad  
from gutter to back of walk  
I.E. = 12.56  
(For details, see sht. GJ-13)
- ㉒ Sta. "H" 11+94.91, 56.02' Lt.  
Const. storm outfall protection alt. from back  
of walk to bottom of pond  
(For details, see sht. GJ-14)
- ㉓ Sta. "L1" 401+58.02, 266.40' Rt.  
Const. storm outfall class 100 riprap, with tidegate  
I.E.Out= 5.66 (36" S)  
(For details, see sht. GJ-14)  
Inst. 36" storm sew. pipe - 78'  
10' depth
- ㉔ Sta. "WR" 13+77.53, 57.30' Lt.  
Const. storm outfall class 50 riprap  
I.E.Out= 19.75 (12" S)  
(For details, see sht. GJ-14)  
Inst. 12" storm sew. pipe - 22'  
5' depth
- ㉕ Sta. "WR" 13+94.57, 51.69' Lt.  
Const. storm outfall class 50 riprap  
I.E.Out= 22.0 (12" SE)  
(For details, see sht. GJ-14)  
Inst. 12" storm sew. pipe - 24'  
5' depth
- ㉖ Sta. "L1" 399+37.41, 50.07' Rt.  
Const. storm outfall class 50 riprap  
I.E.Out= 21.0 (12" SE)  
(For details, see sht. GJ-14)  
Inst. 12" storm sew. pipe - 24'  
5' depth
- ㉗ Sta. "L1" 400+16.05, 43.08' Rt.  
Const. storm outfall class 50 riprap  
I.E.Out= 19.0 (12" W)  
(For details, see sht. GJ-14)  
Inst. 12" storm sew. pipe - 20'  
5' depth
- ㉘ Sta. "L1" 399+57.24 to Sta. "L1" 401+33.00, Rt.  
Const. Water Quality Swale D00930- 258'  
(For details, see sht. GJ-5)
- ㉙ Sta. "L1" 401+67.40 to Sta. "L1" 402+27.95, Rt.  
Const. Bioretention Pond D00927- 6,600 Sq. Ft.  
(For details, see sht. GJ-8)
- ㉚ Sta. "L1" 401+28.70, 16.19' Lt.  
Const. water quality structure D00929  
Rim 21.49  
I.E.In= 14.67 (12" SW)  
I.E.Out= 11.62 (12" SW)  
Inst. 12" storm sew. pipe - 14'  
10' depth  
(For details, see sht. GJ-6)
- ㉛ Sta. "L1" 401+10.82, 23.93' Lt.  
Const. large precast manhole, 72" dia.  
Rim 21.40  
I.E.In= 7.08 (30" N)  
I.E.Out= 6.25 (36" NE)  
Inst. 30" storm sew. pipe - 12'  
20' depth
- ㉜ Sta. "L1" 401+20.72, 30.44' Lt.  
Const. large precast manhole, 60" dia.  
Rim 21.08  
I.E.In = 11.52 (12" E)  
I.E.In = 7.34 (30" NW)  
I.E.Out= 7.14 (30" SE)  
Inst. 12" storm sew. pipe - 10'  
10' depth  
Inst. 30" storm sew. pipe - 72'  
20' depth
- ㉝ Sta. "H" 11+86.22, 49.37' Lt.  
Inst. concrete channel inlet without conc. splash pad  
from gutter to back of walk  
I.E. = 13.02  
(For details, see sht. GJ-13)
- ㉞ Sta. "H" 11+87.14, 57.28' Lt.  
Const. class 50 riprap from back of walk  
to storm outfall class 50 riprap at Sta. "H" 11+94.91  
(For details, see sht. GJ-14)
- ㉟ Sta. "L1" 401+55.71, 81.48' Rt.  
Inst. pipe tees, 12"  
Inst. 12" storm sew. pipe - 22'  
10' depth
- ㊱ Sta. "L1" 402+08.07, 66.30' Rt.  
Inst. pipe tees, 12"  
Inst. 12" DI storm sew. pipe - 18'  
5' depth
- ㊲ Sta. "WR" 15+27.70, 3.51' Lt.  
Inst. 22" elbow

|  |
|--|
|  <b>OREGON DEPARTMENT OF TRANSPORTATION</b>             |
|  <b>Otak Inc.</b><br><small>HanmiGlobal Partner</small> |
| 700 Washington St, Ste. 401<br>Vancouver, WA 98660<br>Phone: 360.373.9613 Fax: 360.737.9651  |
| <b>US101 @ OR6 (TILLAMOOK) SEC.</b><br>OREGON COAST HWY. & WILSON RIVER HWY.<br>TILLAMOOK COUNTY   |
| Reviewed By - T Kraft<br>Designed By - A Cantion<br>Drafted By - A Cobb/M McCandless   |
| <b>DRAINAGE NOTES</b>  |
| SHEET<br>NO.<br><b>10D</b>   |

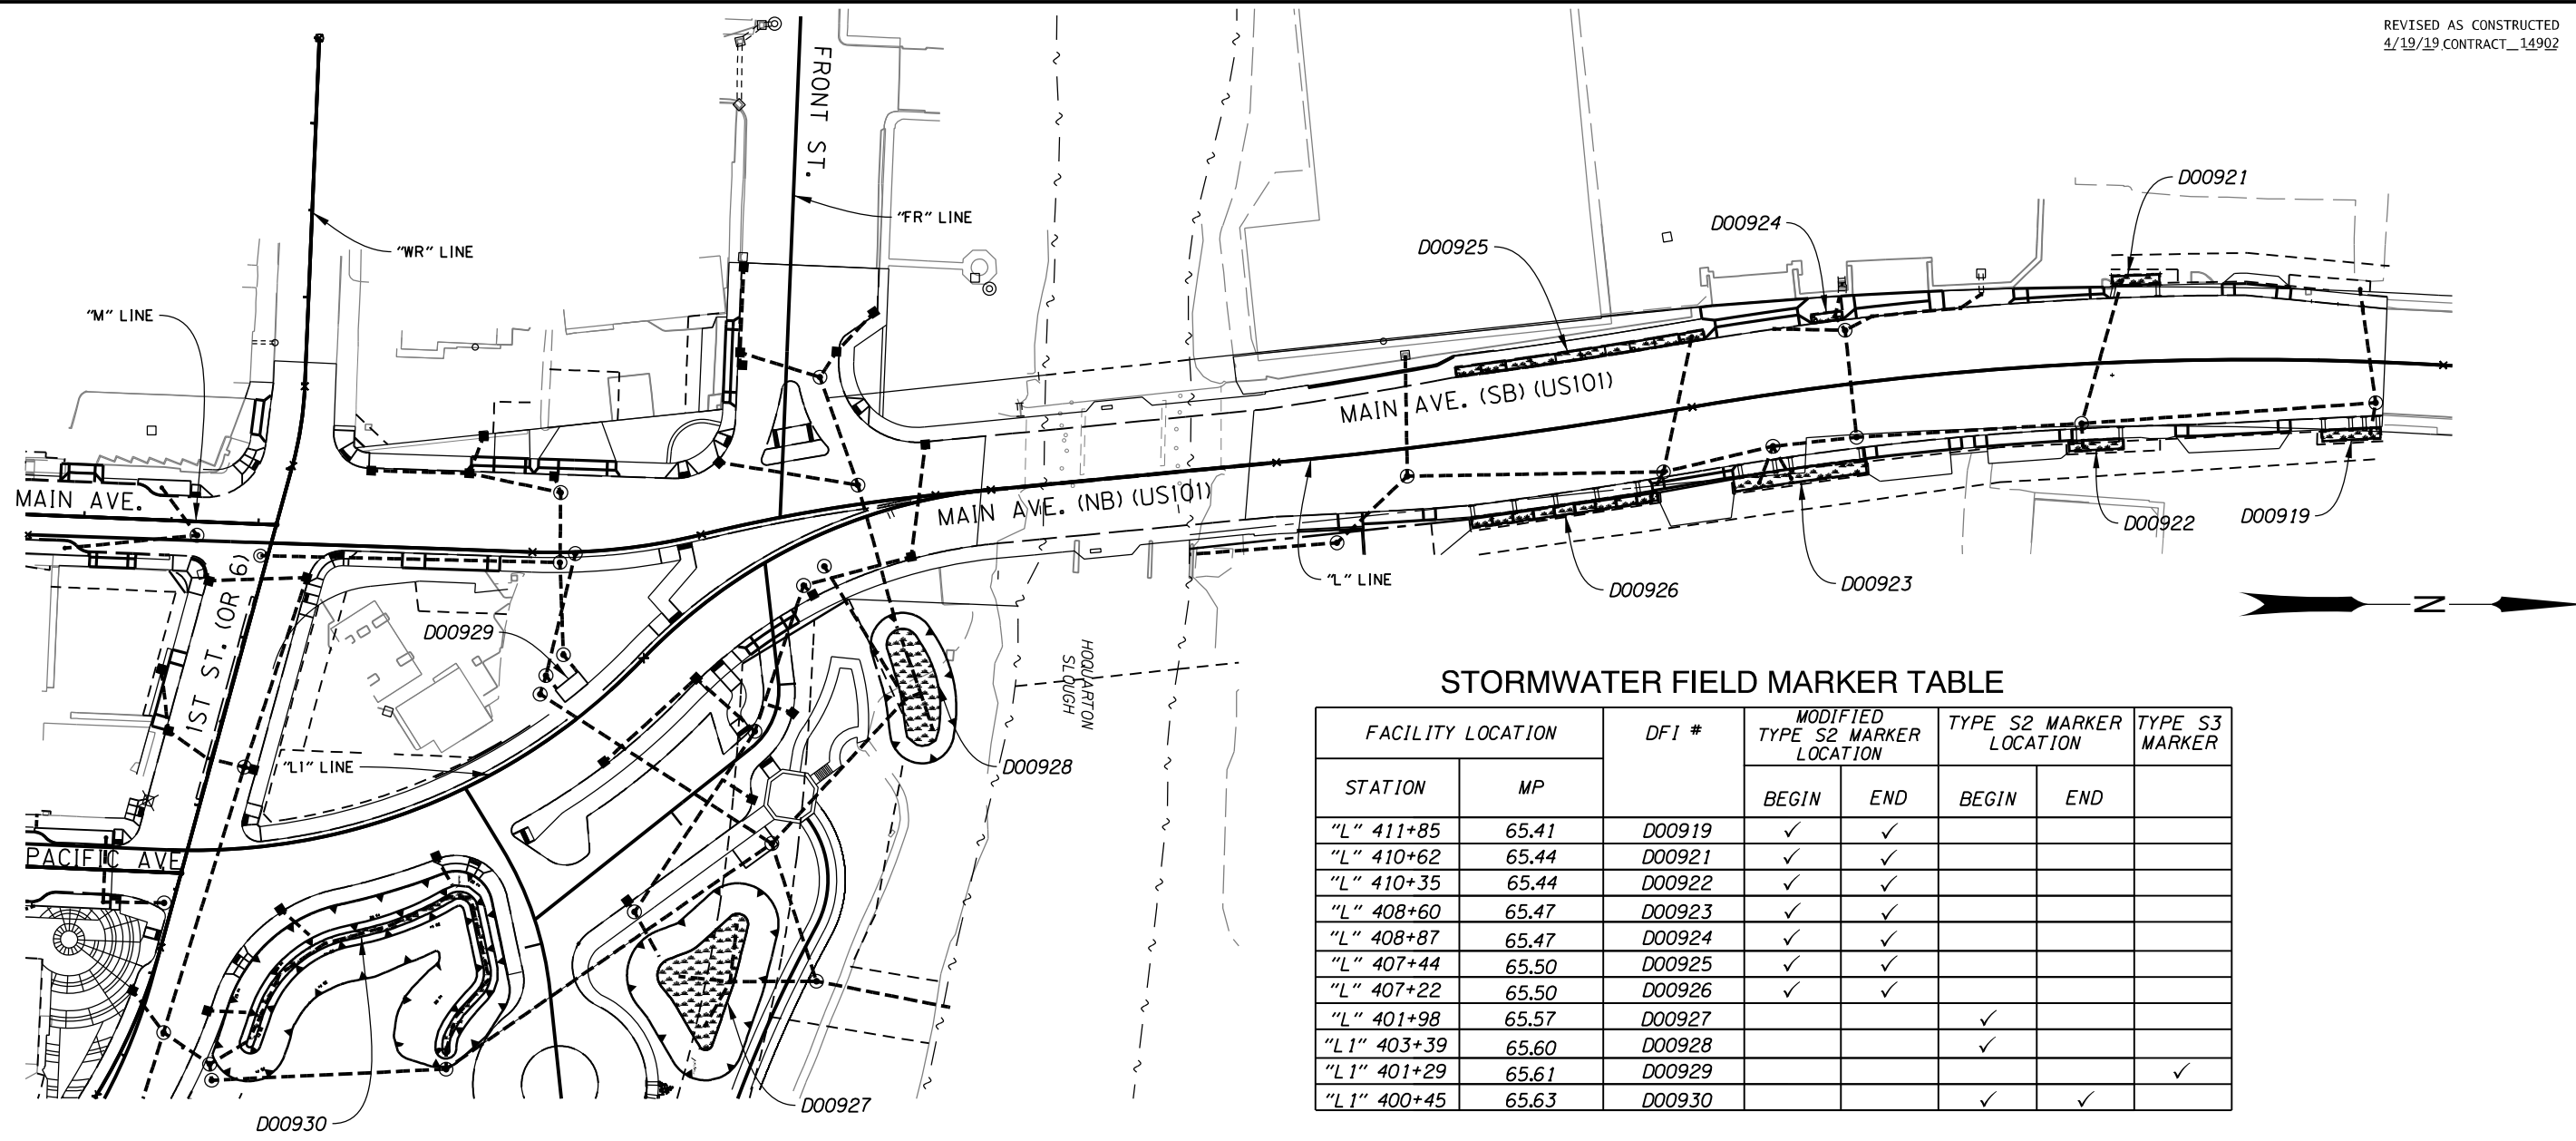

STORMWATER FIELD MARKER TABLE

| FACILITY LOCATION |       | DFI #  | MODIFIED TYPE S2 MARKER LOCATION |     | TYPE S2 MARKER LOCATION |     | TYPE S3 MARKER |
|-------------------|-------|--------|----------------------------------|-----|-------------------------|-----|----------------|
| STATION           | MP    |        | BEGIN                            | END | BEGIN                   | END |                |
| "L" 411+85        | 65.41 | D00919 | ✓                                | ✓   |                         |     |                |
| "L" 410+62        | 65.44 | D00921 | ✓                                | ✓   |                         |     |                |
| "L" 410+35        | 65.44 | D00922 | ✓                                | ✓   |                         |     |                |
| "L" 408+60        | 65.47 | D00923 | ✓                                | ✓   |                         |     |                |
| "L" 408+87        | 65.47 | D00924 | ✓                                | ✓   |                         |     |                |
| "L" 407+44        | 65.50 | D00925 | ✓                                | ✓   |                         |     |                |
| "L" 407+22        | 65.50 | D00926 | ✓                                | ✓   |                         |     |                |
| "L" 401+98        | 65.57 | D00927 |                                  |     | ✓                       |     |                |
| "L1" 403+39       | 65.60 | D00928 |                                  |     | ✓                       |     |                |
| "L1" 401+29       | 65.61 | D00929 |                                  |     |                         |     | ✓              |
| "L1" 400+45       | 65.63 | D00930 |                                  |     | ✓                       | ✓   |                |

PLAN  
No Scale

See Drg.No.RD399 for facility marker details.

OREGON DEPARTMENT OF TRANSPORTATION


Otak Inc. Hanmi Global Partner  
700 Washington St, Ste. 401  
Vancouver, WA 98660  
Phone: 360.373.9613 Fax: 360.737.9651

**US101 @ OR6 (TILLAMOOK) SEC.**  
OREGON COAST HWY. & WILSON RIVER HWY.  
TILLAMOOK COUNTY

Reviewed By - T Kraft  
Designed By - A Cantlon  
Drafted By - A Cobb

**WATER QUALITY PLAN**

SHEET NO.  
GJ-2

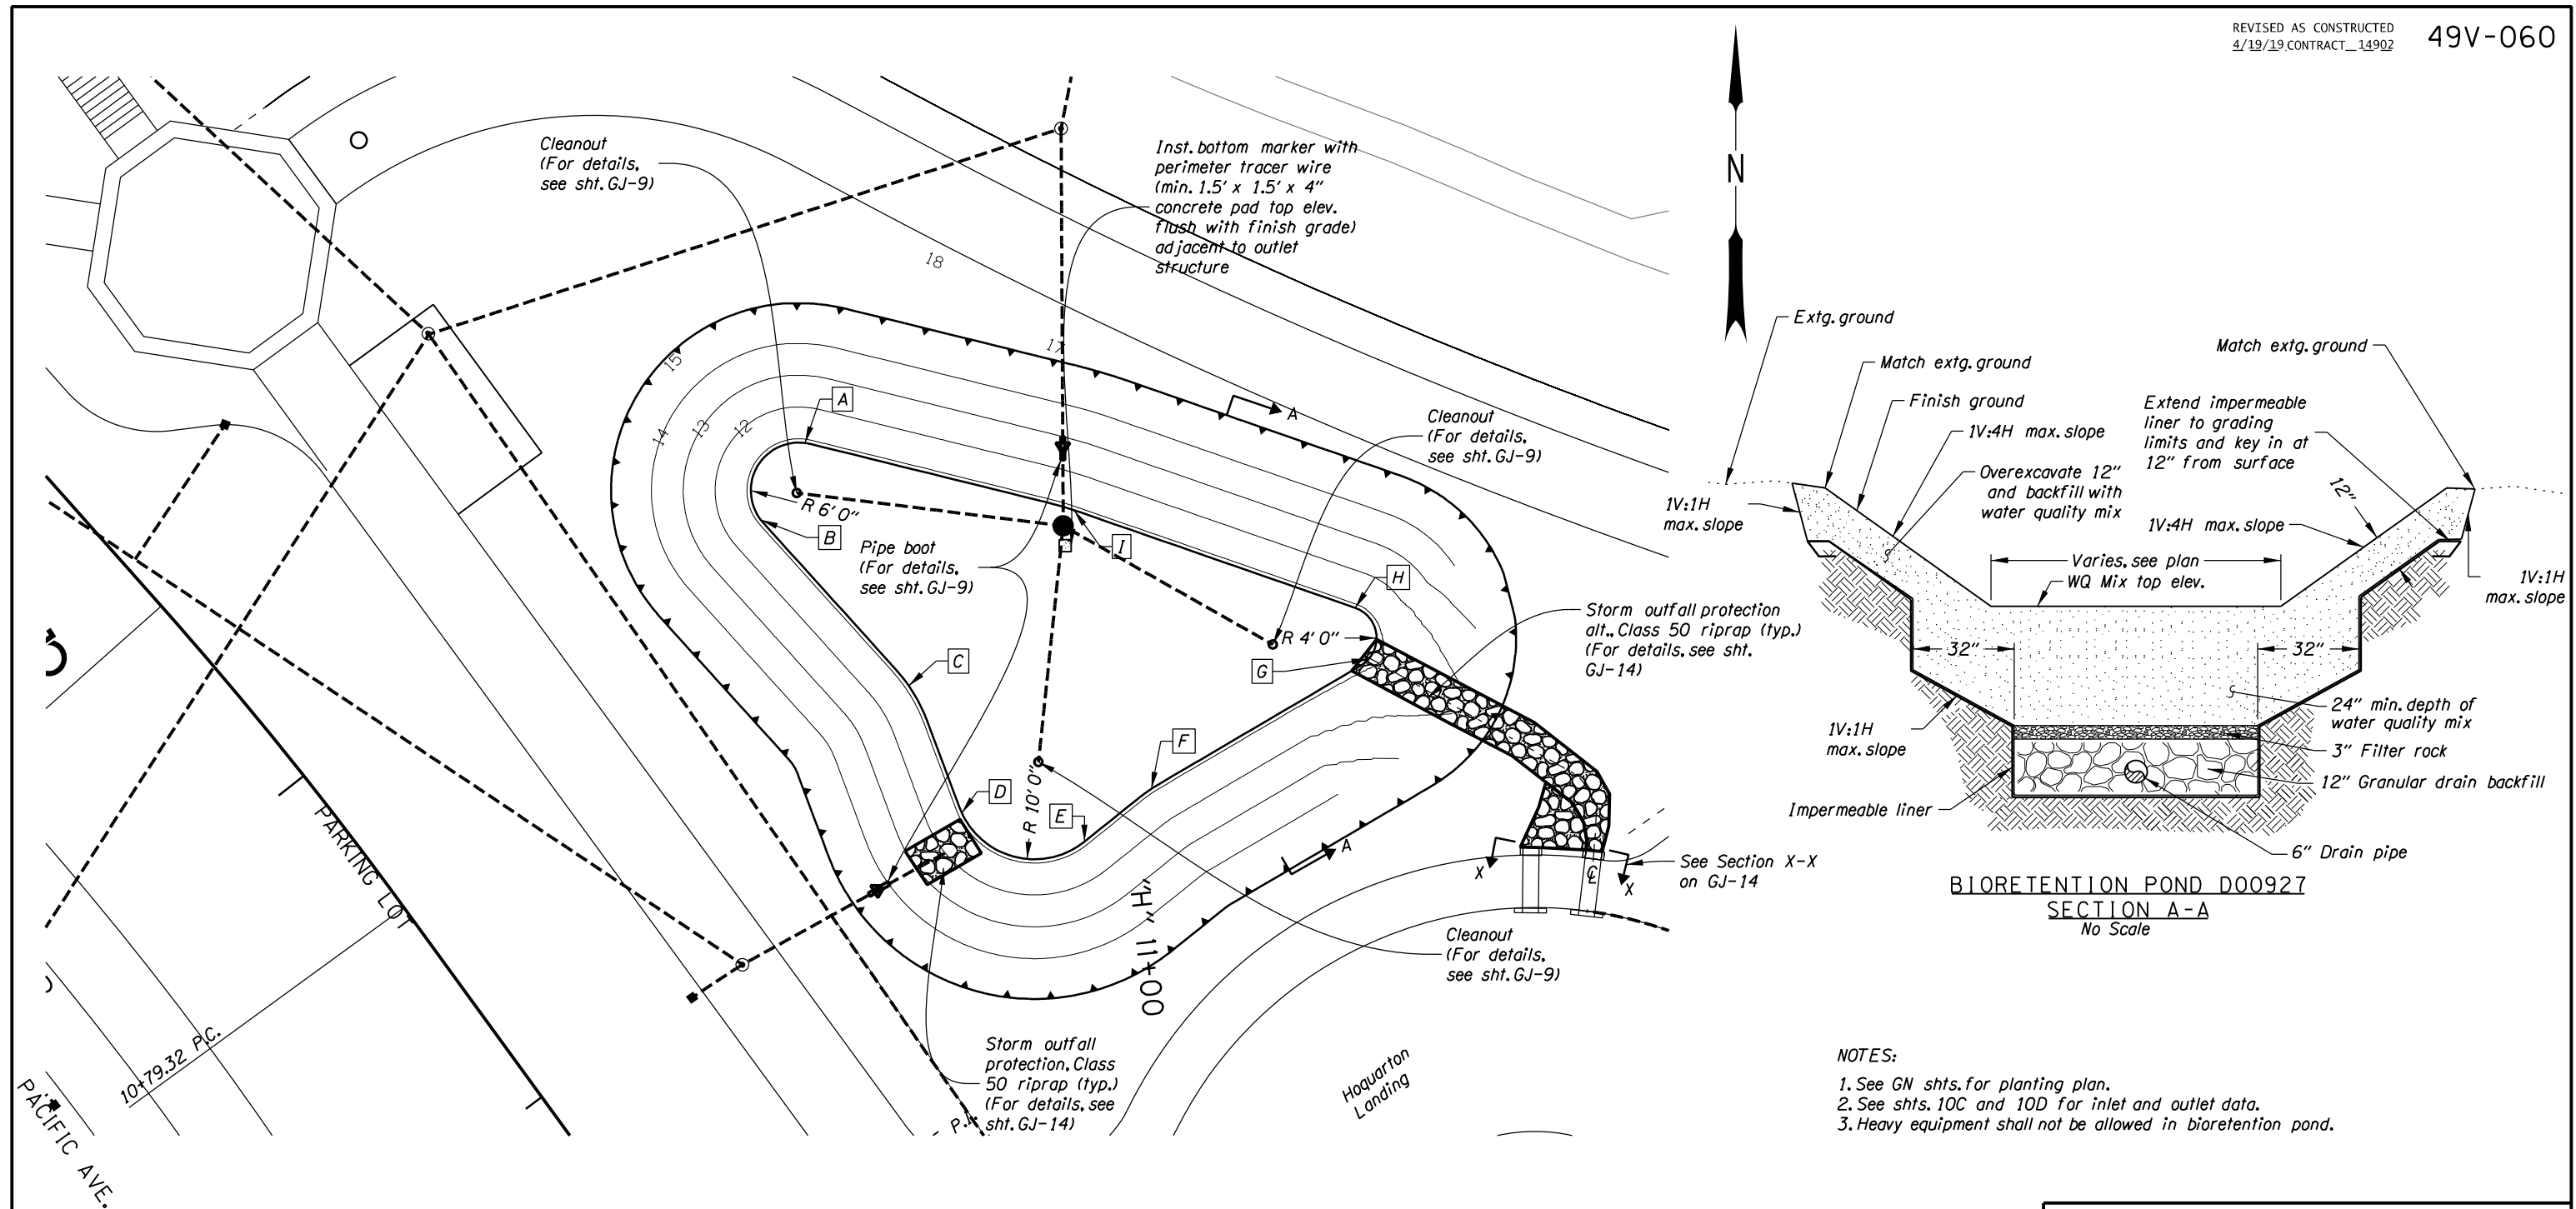

**BIORETENTION POND D00927**  
**SECTION A-A**  
No Scale






**NOTES:**

1. See GN shts. for planting plan.
2. See shts. 10C and 10D for inlet and outlet data.
3. Heavy equipment shall not be allowed in bioretention pond.


| FACILITY ID | WQ MIX TOP ELEV. |
|-------------|------------------|
| D00927      | 10.88            |

| POINT | STA., OFFSET             |
|-------|--------------------------|
| A     | "H1" 10+94.5, 75.0' RT.  |
| B     | "H1" 10+90.7, 64.7' RT.  |
| C     | "H1" 10+64.6, 67.3' RT.  |
| D     | "H1" 10+47.8, 63.3' RT.  |
| E     | "H1" 10+35.9, 73.6' RT.  |
| F     | "H1" 10+36.3, 84.3' RT.  |
| G     | "H1" 10+33.4, 115.8' RT. |
| H     | "H1" 10+39.6, 118.2' RT. |
| I     | "H1" 10+70.1, 97.0' RT.  |


|   |  |
|---|--|
| <p><b>OREGON DEPARTMENT OF TRANSPORTATION</b></p>   |  |
| <p><b>Otak Inc.</b></p> <p>700 Washington Street, Suite 401<br/>Vancouver, WA 98660<br/>Phone: (360)737-9613 Fax: (360)737-9651</p> |  |
| <p><b>US101 @ OR6 (TILLAMOOK) SEC.</b><br/>OREGON COAST HWY. &amp; WILSON RIVER HWY.<br/>TILLAMOOK COUNTY</p>                       |  |
| <p>Reviewed By - T Kraft<br/>Designed By - A Cantion<br/>Drafted By - S Reiter</p>  |  |
| <p><b>WATER QUALITY DETAILS</b></p>   |  |
| <p>SHEET NO.<br/>GJ-8</p>   |  |

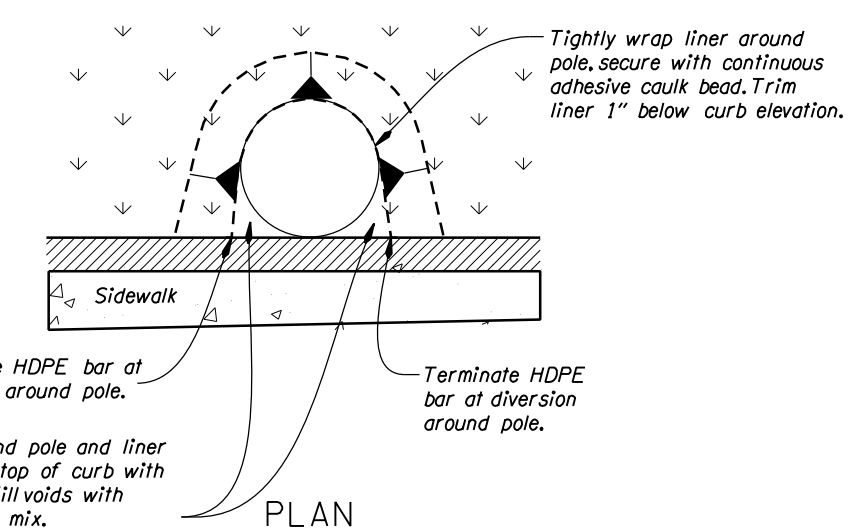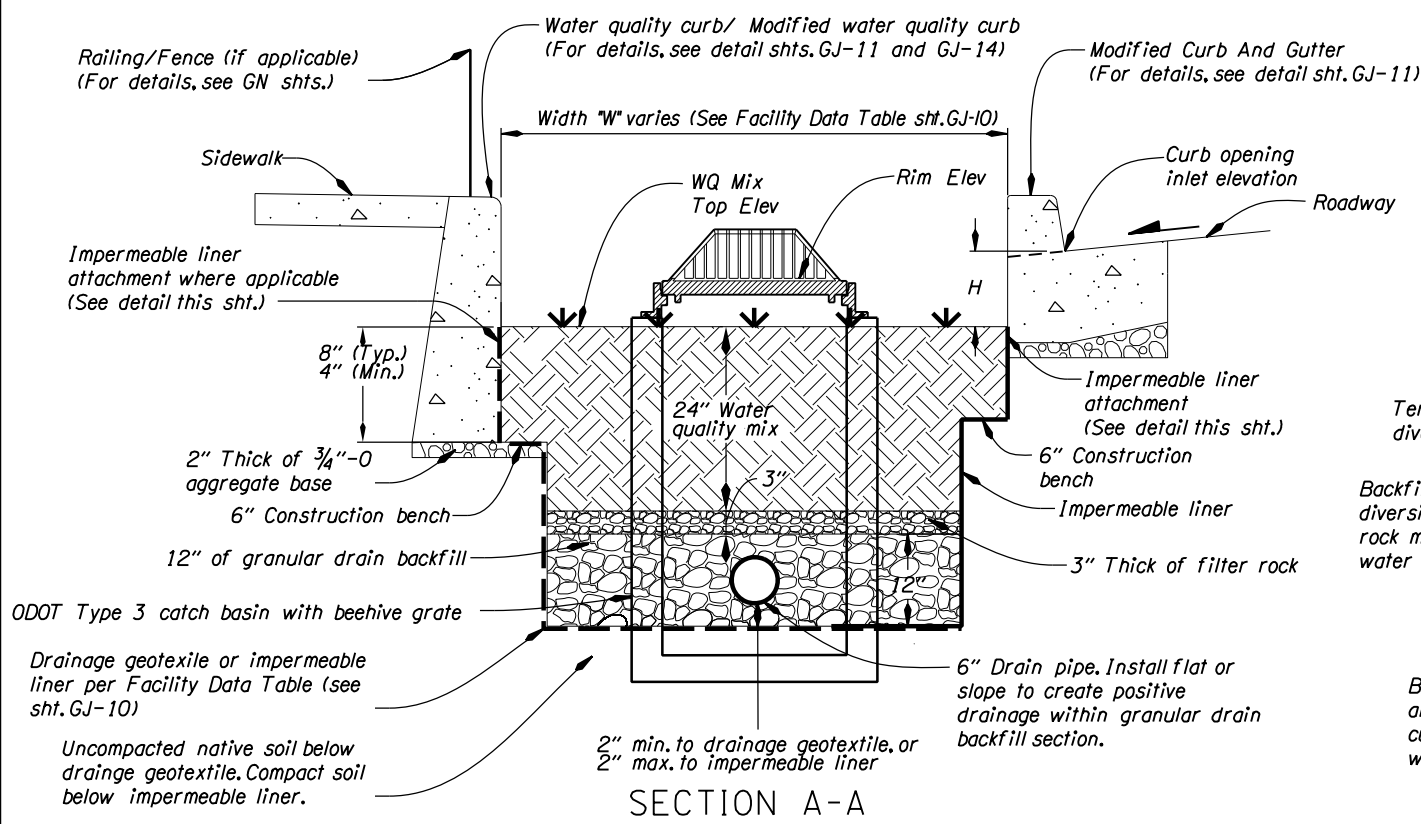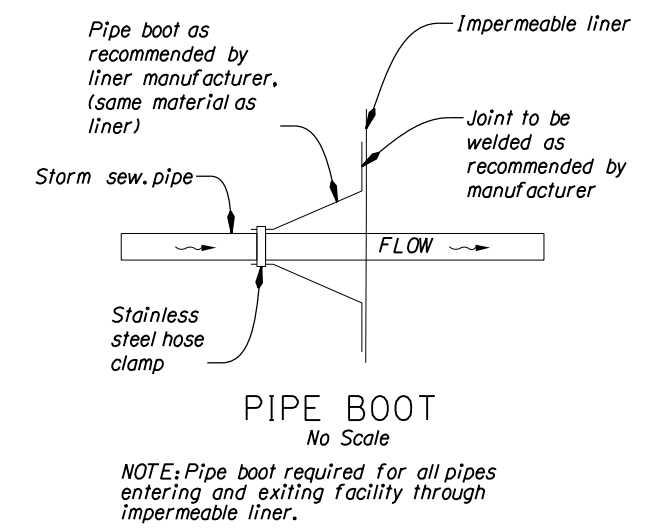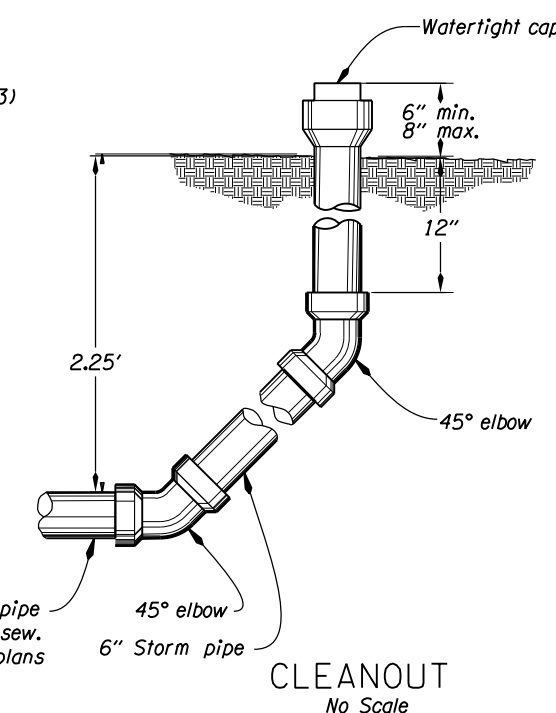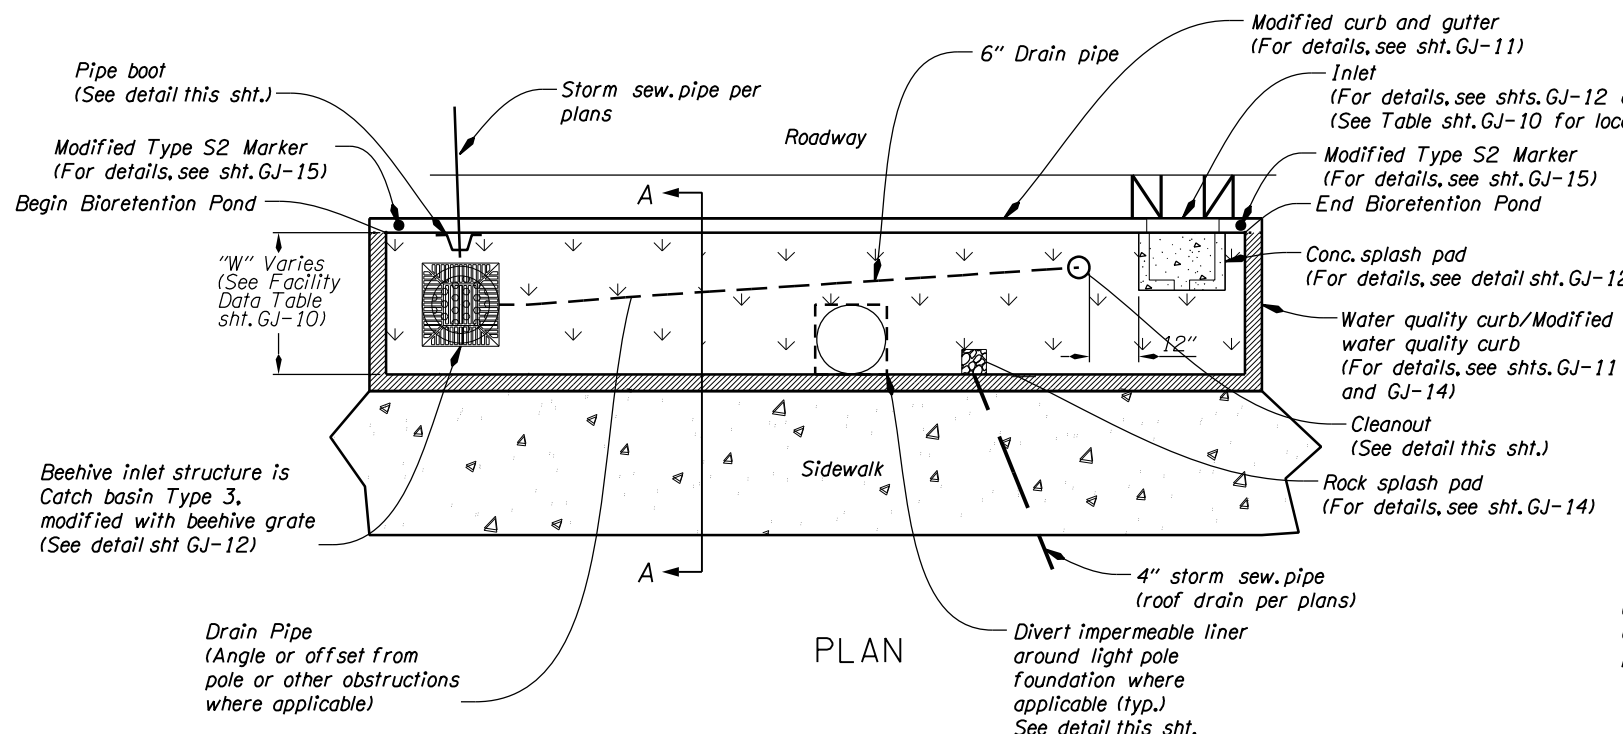

Backfill around pole and liner diversion to top of curb with rock mulch. Fill voids with water quality mix.

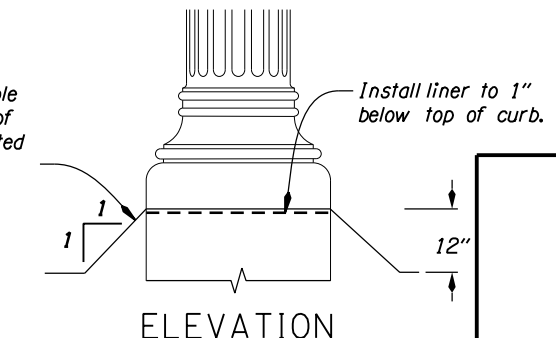

**IMPERMEABLE LINER AROUND LIGHT POLE FOUNDATION**  
No Scale

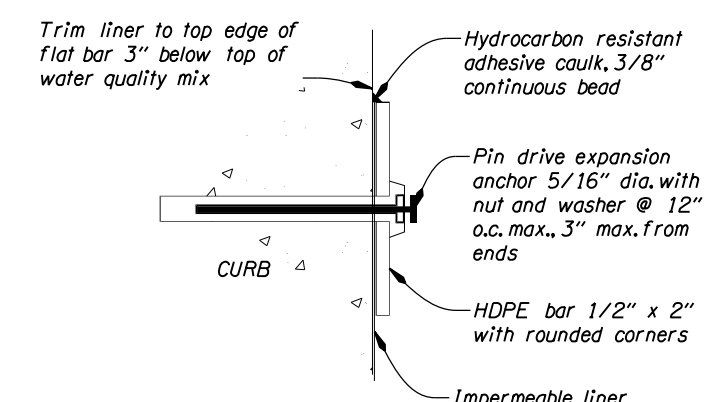


NOTES:  
1. Liner to extend from 3 in. below top of top soil to the bottom of excavation.  
2. 3 in. of concrete is required on all sides of attachment.

**GENERAL NOTES FOR ALL DETAILS:**  
1. Slope Drain Rock and Filter Rock layers to match bottom slope.  
2. Slope drain pipe towards outlet.  
3. Install Drain Rock splash pad downstream of check dam, see details sht. GJ-11.  
4. Where catch basin structure protrudes through impermeable liner, cut liner in "X" shape to create rectangular hole to match size and shape of structure. Upon installation of catch basin, fold resulting triangular shaped fabric up sides of structure, and secure to structure with adhesive caulk. Backfill holes in liner with compacted topsoil.


|   |                          |
|---|--------------------------|
|   |                          |
| <b>OREGON DEPARTMENT OF TRANSPORTATION</b><br>Otak Inc. Hanmi Global Partner<br>700 Washington St, Ste. 401<br>Vancouver, WA 98660<br>Phone: 360.373.9613 Fax: 360.737.9651 |                          |
| <b>US101 @ OR6 (TILLAMOOK) SEC.</b><br>OREGON COAST HWY. & WILSON RIVER HWY.<br>TILLAMOOK COUNTY  |                          |
| Reviewed By - T Kraft<br>Designed By - A Cantion<br>Drafted By - S Reiter   |                          |
| <b>WATER QUALITY DETAILS</b>  | SHEET NO.<br><b>GJ-9</b> |



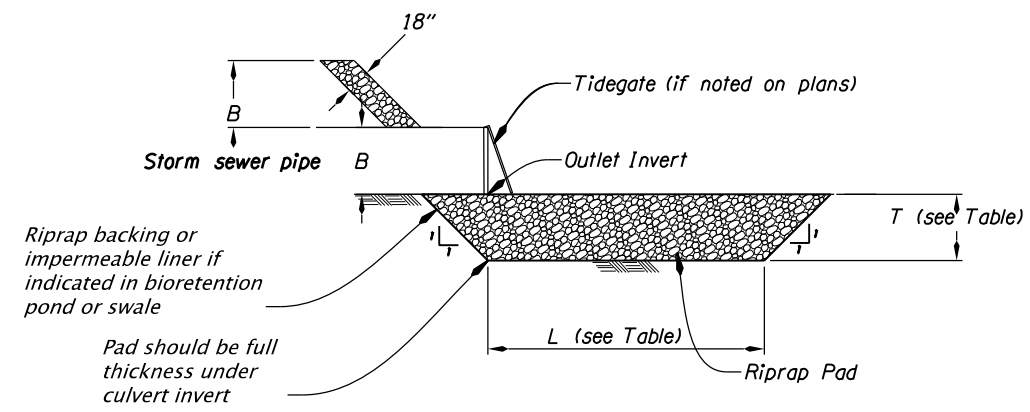

ELEVATION

B = Diameter of storm sew. pipe, ft  
L = Length of bottom of riprap pad, ft  
T = Thickness of riprap pad, ft  
W = Width of top of riprap pad, ft

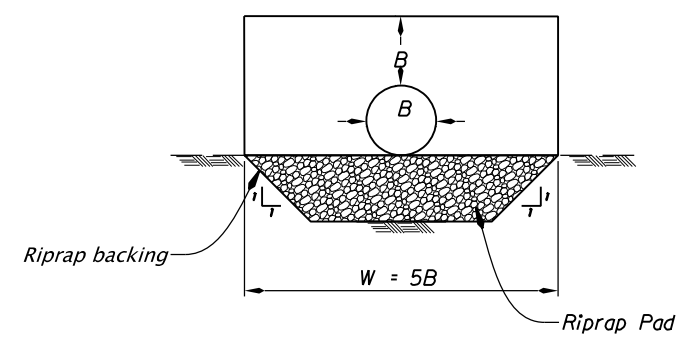


END VIEW

| TABLE        |           |        |
|--------------|-----------|--------|
| Riprap Class | L* (ft)   | T (ft) |
| 50           | 4B or 1.3 | 2.3    |
| 100          | 4B or 1.6 | 3.3    |


\* L is the greater of 4B or the listed dimension.

- NOTES:  
1. Do not excavate non-erodible rock in order to place riprap.  
2. Riprap backing under class 50 riprap shall be riprap geotextile, Type 1.


STORM OUTFALL PROTECTION  
No Scale

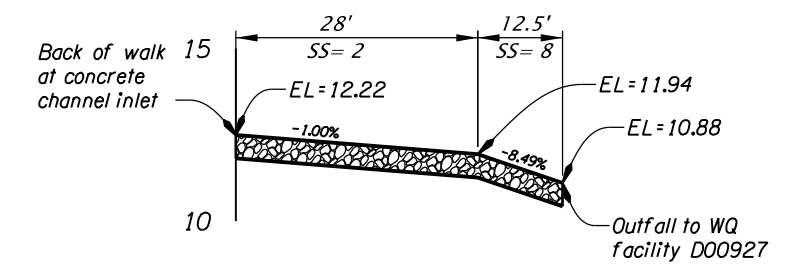

PROFILE

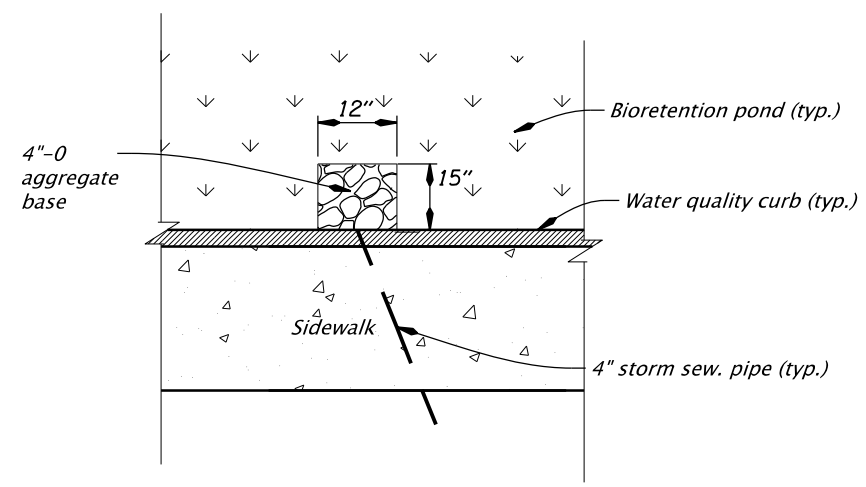


PLAN VIEW

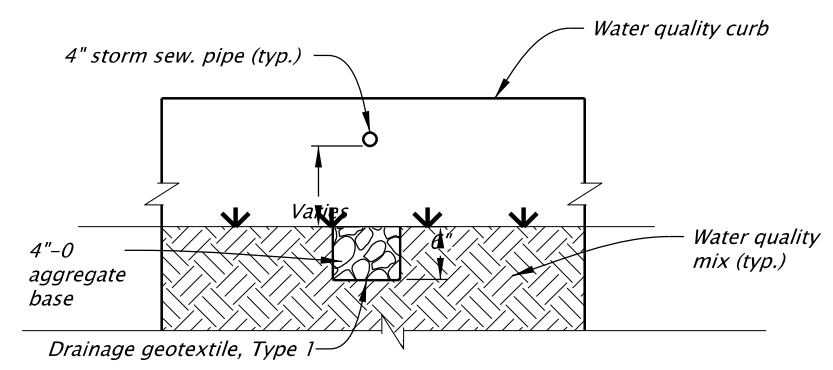


SECTION VIEW

ROCK SPLASH PAD  
No Scale

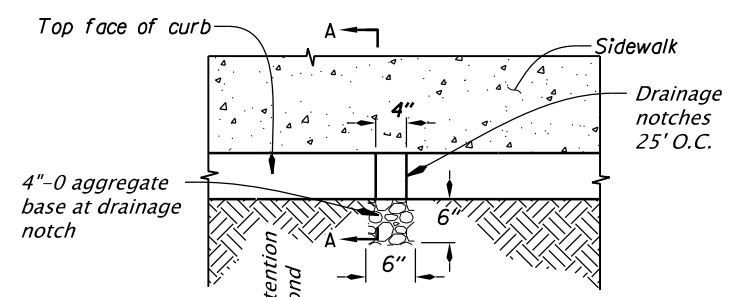


PLAN

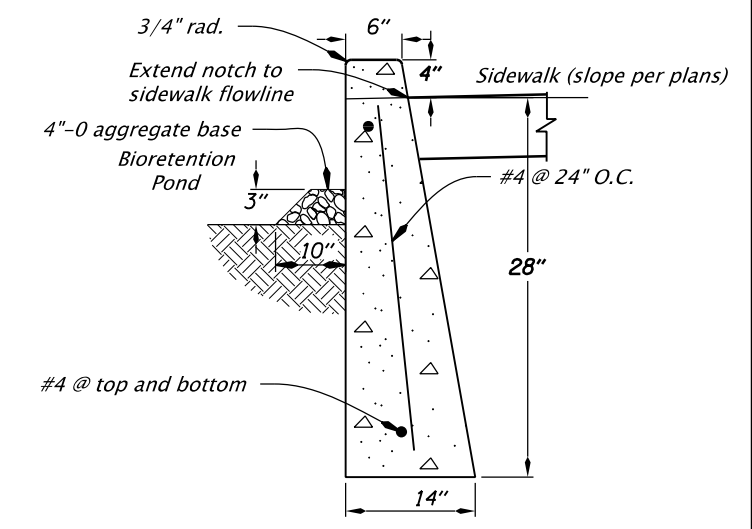

SECTION A-A

- NOTES:  
1. Provide a 3/4" reveal (dummy joint) on sides and top at 10' O.C. and provide a 1/2" expansion joint at 50' O.C.

MODIFIED WATER QUALITY CURB  
No Scale

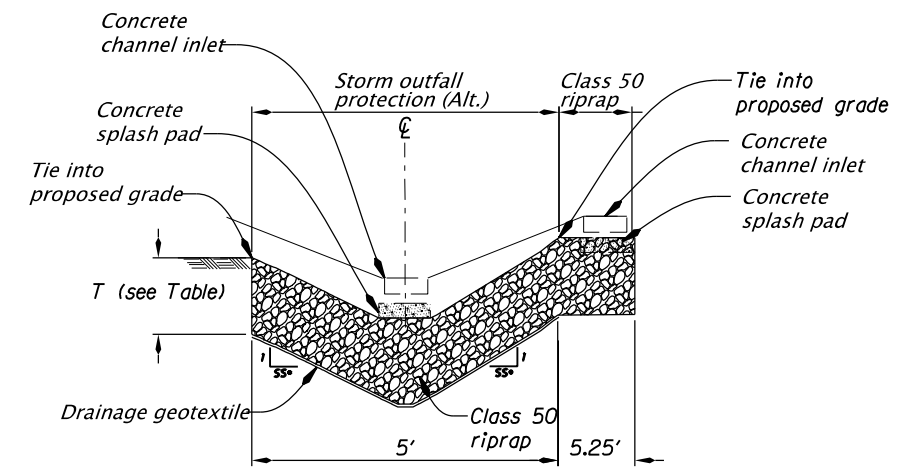


\*SS= Side slope (per profile)

SECTION X-X

STORM OUTFALL PROTECTION ALTERNATIVE  
No Scale

|  |   |
|--|---|
|  |   |
| Otak Inc.<br>Hanmi Global Partner  | 700 Washington St, Ste. 401<br>Vancouver, WA 98660<br>Phone: 360.373.9613 Fax: 360.737.9651 |
| <b>US101 @ OR6 (TILLAMOOK) SEC.</b><br>OREGON COAST HWY. & WILSON RIVER HWY.<br>TILLAMOOK COUNTY |   |
| Reviewed By - T Kraft<br>Designed By - A Cantion<br>Drafted By - S Reiter                        |   |
| <b>WATER QUALITY DETAILS</b>   |   |
| SHEET NO.<br><b>GJ-14</b>  |   |

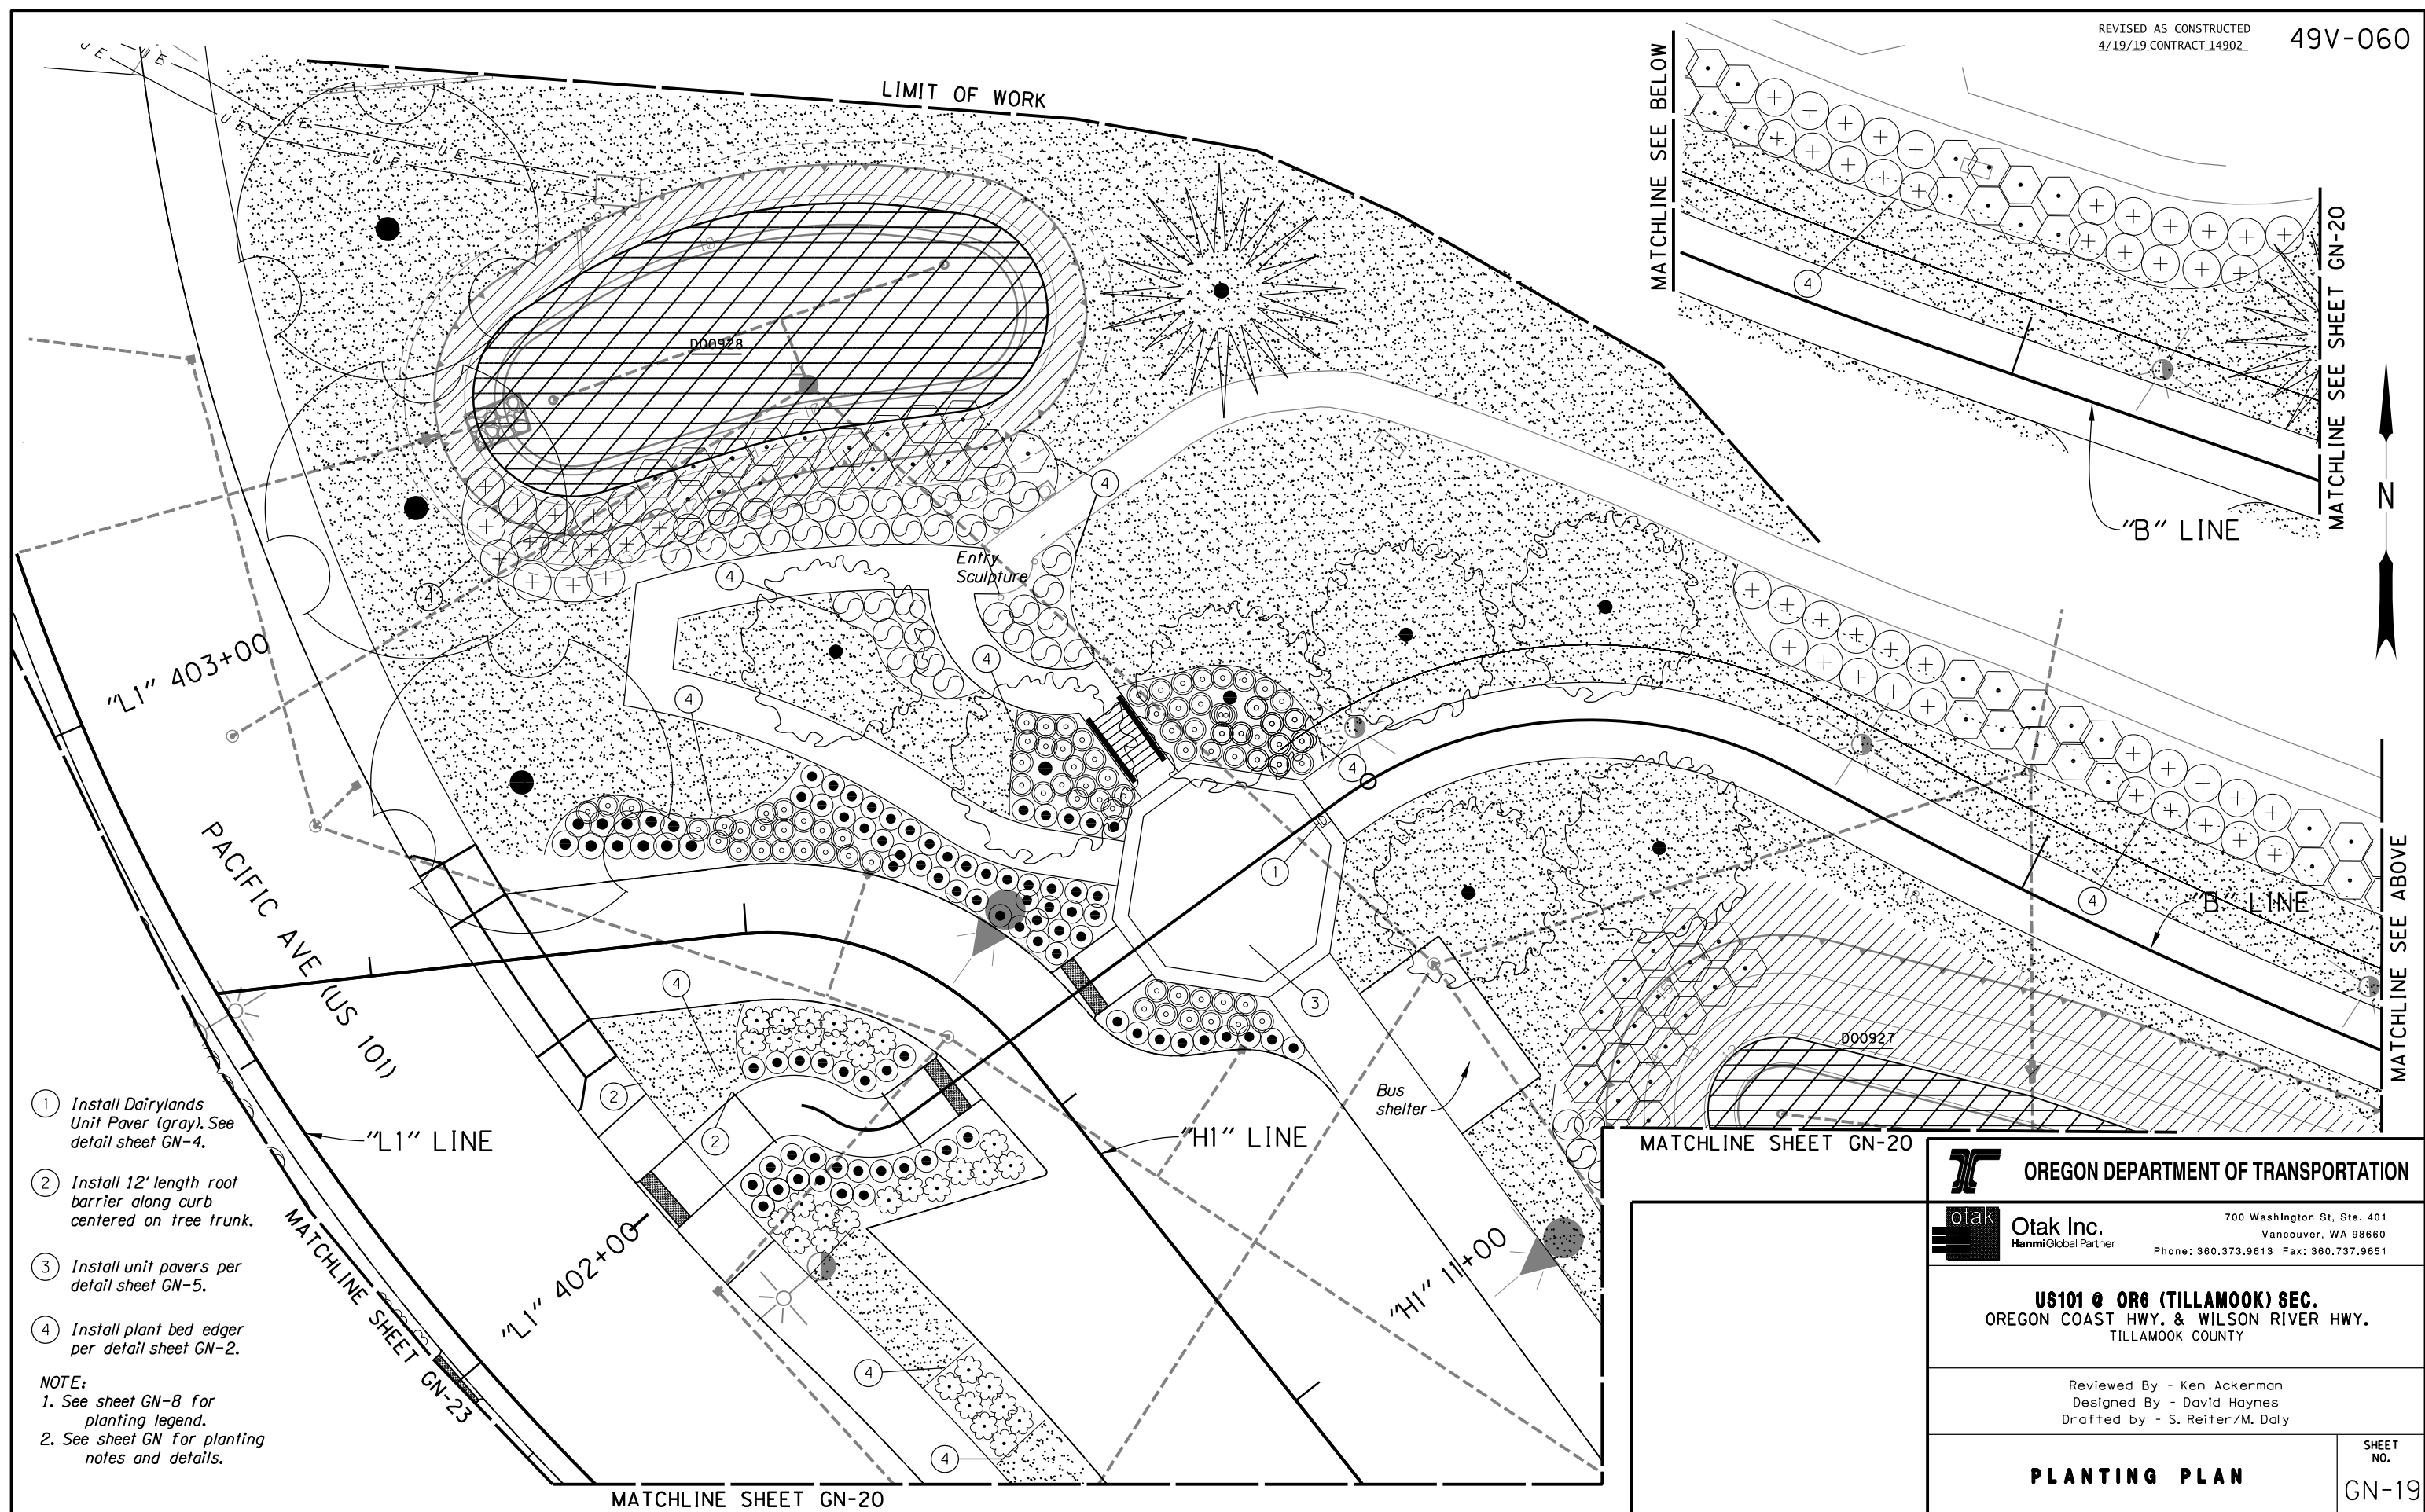

- ① Install Dairylands Unit Paver (gray). See detail sheet GN-4.
- ② Install 12' length root barrier along curb centered on tree trunk.
- ③ Install unit pavers per detail sheet GN-5.
- ④ Install plant bed edger per detail sheet GN-2.

NOTE:  
1. See sheet GN-8 for planting legend.  
2. See sheet GN for planting notes and details.

**OREGON DEPARTMENT OF TRANSPORTATION**

**otak** Otak Inc. 700 Washington St, Ste. 401  
 HanmiGlobal Partner Vancouver, WA 98660  
 Phone: 360.373.9613 Fax: 360.737.9651

**US101 @ OR6 (TILLAMOOK) SEC.**  
 OREGON COAST HWY. & WILSON RIVER HWY.  
 TILLAMOOK COUNTY

Reviewed By - Ken Ackerman  
 Designed By - David Haynes  
 Drafted by - S. Reiter/M. Daly

**PLANTING PLAN** SHEET NO. GN-19

MATCHLINE SHEET GN-19

MATCHLINE SHEET GN-19

D00927

Shared use path. See road plans.

LIMIT OF LANDSCAPE WORK

"B" LINE

"H1" LINE

Bollards.  
See Road plans.

"L1" LINE

"H" LINE

"L1" 401+00  
PACIFIC AVE (US 101)

HOQUARTON LANDING

"H1" 10+00

"H1" 11+00


MATCHLINE SHEET GN-21



NOTE:  
1. See sheet GN-8 for planting legend.  
2. See sheet GN for planting notes and details.

- ① Install 12' length root barrier along curb centered on tree trunk.
- ② Install plant bed edger per detail sheet GN-2.

 OREGON DEPARTMENT OF TRANSPORTATION

 Otak Inc. 700 Washington St, Ste. 401  
Vancouver, WA 98660  
Hanmi Global Partner Phone: 360.373.9613 Fax: 360.737.9651

**US101 @ OR6 (TILLAMOOK) SEC.**  
OREGON COAST HWY. & WILSON RIVER HWY.  
TILLAMOOK COUNTY

Reviewed By - Ken Ackerman  
Designed By - David Haynes  
Drafted by - S. Reiter/M. Daly

**PLANTING PLAN**

SHEET NO.  
GN-20