

OPERATION & MAINTENANCE MANUAL

Water Quality Bioretention Pond

Manual prepared: September 2019

DFI No. D00928

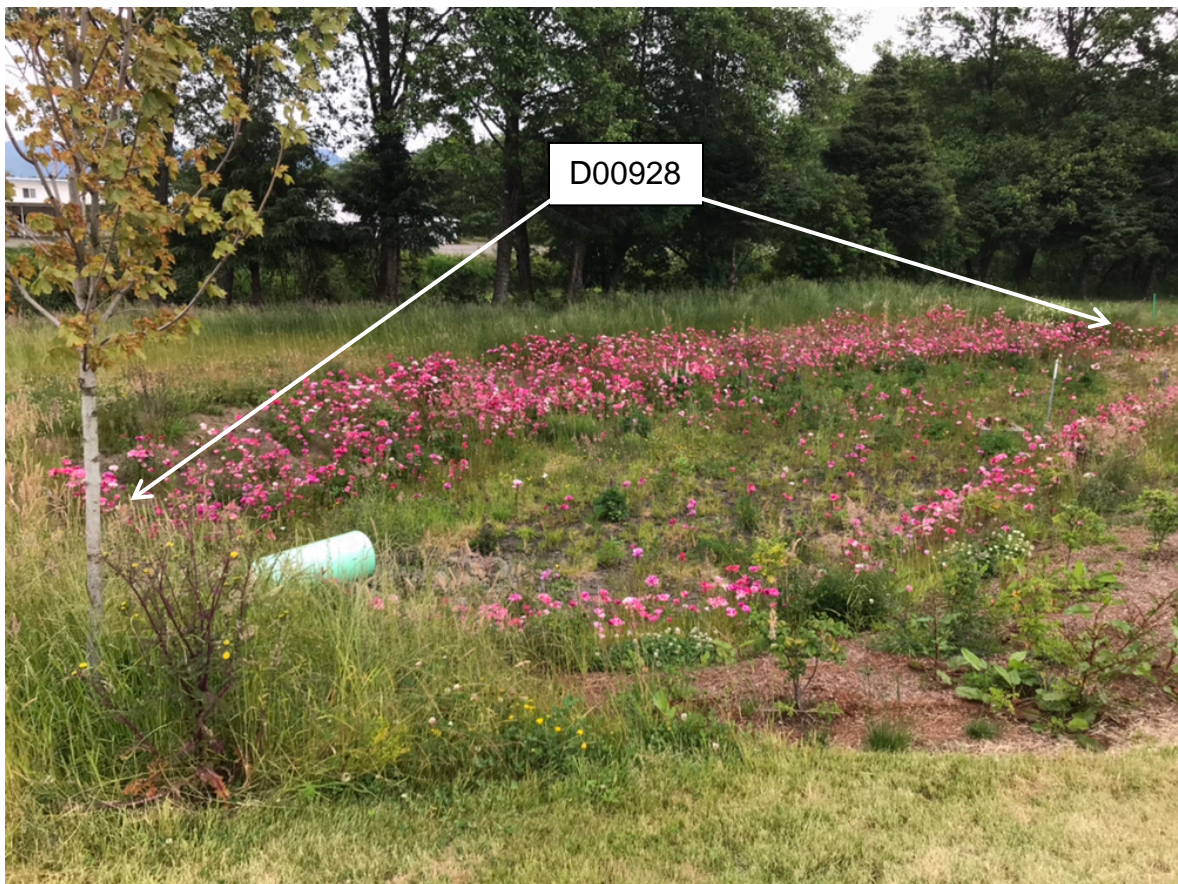


Figure 1: DFI No. D00928, looking East

1. Identification

Drainage Facility ID (DFI): D00928
Facility Type: Water Quality Bioretention Pond
Construction Drawings: (V-File Numbers) 49V-060
Location: District: 1
Highway No.: 009
Mile Post: 65.58, Left

2. Manual Purpose

The purpose of this manual is to outline inspection needs and summarize maintenance actions for stormwater ponds.

3. Facility Location

The location map below details the facility location. The highway, mile posts, side streets, access location, and stormwater flow directions are noted on the map.

Facility location type: Roadway shoulder

Flow direction: South to North




Figure 2: D00928 facility location map (Note: facilities were not constructed at the time the aerial photograph was taken. This Map will be updated)

4. Facility Summary

The pond size is based on storage volume, the bottom and top surface areas and the depth are used for this measurement.

The bottom area and top area of the pond is:

Bottom Area (sq. ft.)	Top Area (sq. ft.)
1,360	4,260

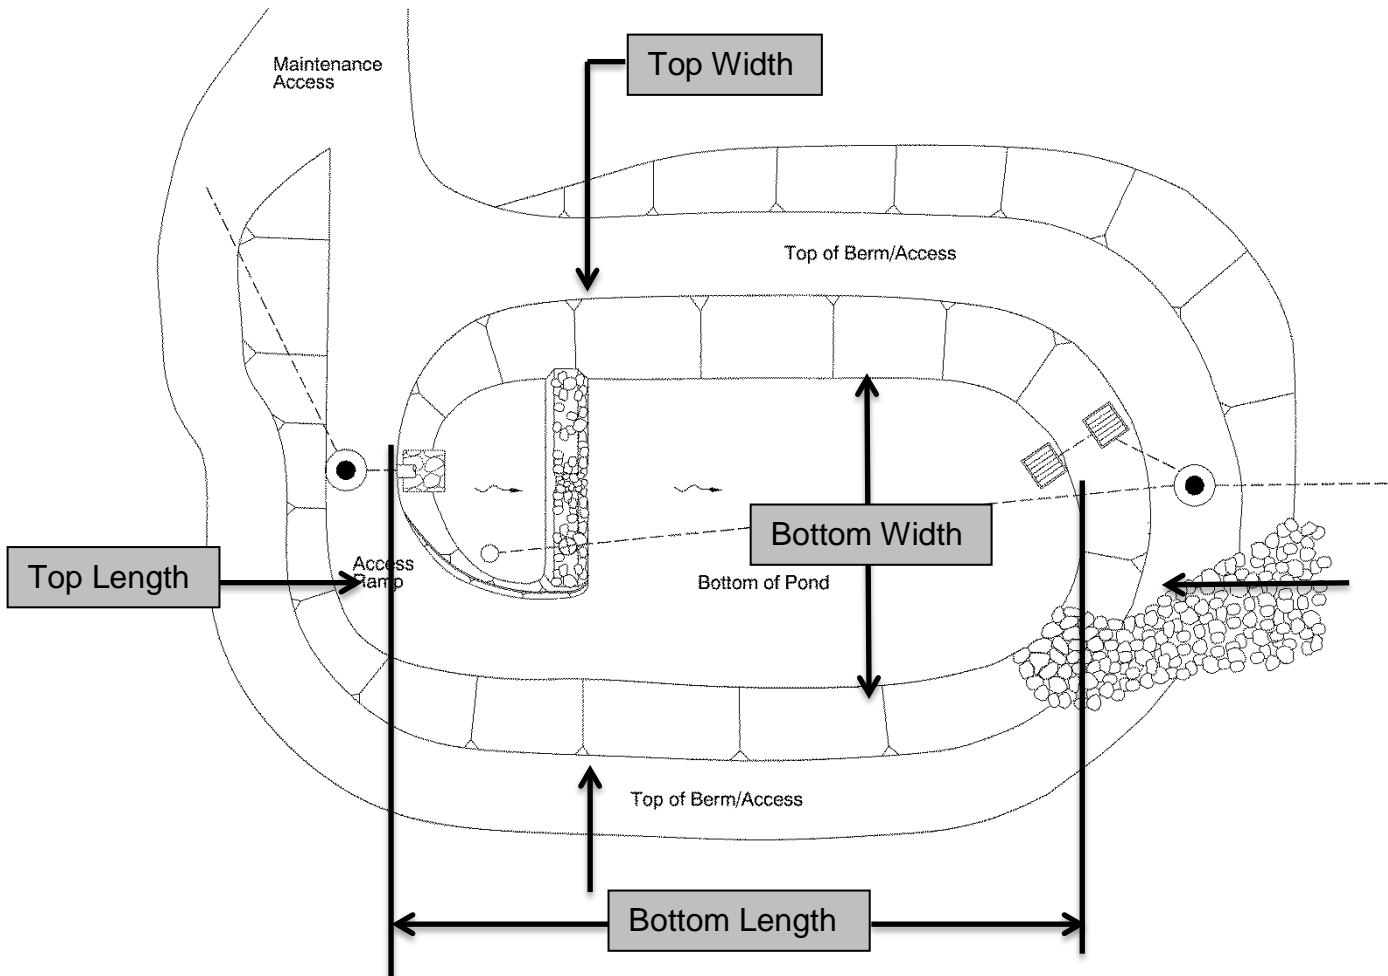


The depth of the pond is the vertical distance measured from the bottom of the pond to the top. The slope of the pond sides is presented by a vertical distance (rise) followed by the horizontal distance (run).

Depth and side slopes:

Depth (feet)
3

Side Slope	
Rise (feet)	1
Run (feet)	4

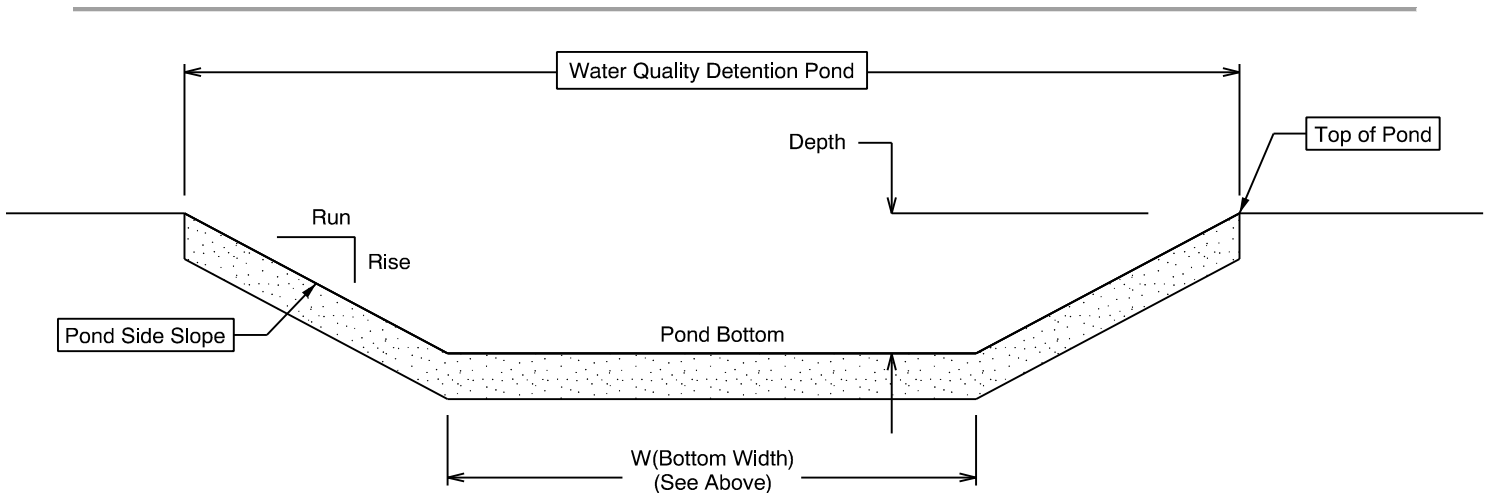

Site Specific Information:

Water flows from the gutter and enters the pond from a storm drain pipe and falls onto riprap before making contact with the plants and water quality soil mix. Below the 24" of water quality soil mix 3" of filter rock and 12" of granular drain rock exist. An impermeable liner lines the bottom and walls of the planter box. Finally, water exits the system through a 6" perf pipe and into the storm drain system. A clean out for the 6" pipe is shown in the photo below.

5. Facility Access

Maintenance access to the facility:

<input type="checkbox"/> Roadside pad	<input checked="" type="checkbox"/> Roadside shoulder
<input type="checkbox"/> Access road with Gate	<input type="checkbox"/> Access road without Gate



Figure 3: Looking Northeast

6. Operational Components / Maintenance Items

Classification and Standard Operational (Op) Plan:

This facility is classified as a:

<input type="checkbox"/> Detention Pond (Op Plan A)	<input checked="" type="checkbox"/> WQ Bioretention Pond (Op Plan B)	<input type="checkbox"/> WQ Extended Detention Dry Pond (Op Plan C)	<input type="checkbox"/> WQ Detention Pond/Biofiltration Swale Combo (Op Plan D)
A standard operational plan illustrates the general facility footprint configuration and explains the purpose of each facility component. Operational plans (A,B,C,D) are provided in the Standard Operation Manual.			

See Appendix A for the site specific operational plan.

Key Features/Items:

This facility is classified as a:

<input checked="" type="checkbox"/> Dry Pond	<input type="checkbox"/> Wet Pond
The pond is wet during storm events and dries during periods of no precipitation.	The pond has constant presence of water year round. A portion of the pond dries during periods of no precipitation.

This facility includes a **high flow bypass component**:

<input checked="" type="checkbox"/> No	<input type="checkbox"/> Yes
There is no bypass component. High flows drains into and through the facility	There is a bypass component. Only low/small flows drain into the pond. High flows are diverted around the pond using a bypass component

This facility includes a **proprietary structure(s)**:

<input checked="" type="checkbox"/> No	<input type="checkbox"/> Yes (DXXXXX)
There are no proprietary structures associated with this facility.	A proprietary structure is used in the operation of this facility. The proprietary structure is a/an: describe

Operational Components

The facility components table (**Table 1**) has been provided to highlight the applicable components for this facility. The component is in use when the box contains an “x” (e.g.).

The Standard Operation Manual for Ponds (implemented **May 2019**) outlines facility operation, typical footprint configuration, and component definitions and details. A link to the manual is attached to the feature marker in TransGIS.

<https://gis.odot.state.or.us/TransGIS/>

Maintenance Items

Operational components marked in **Table 1** should be inspected and maintained according to Section 7. Each facility component is defined and detailed in the Standard Operation Manual using the associated ID number indicated in the table below.

Table 1: Stormwater Pond Components		ID #
Upstream Manholes/Structures		
Pre-treatment Manhole Type: describe	<input type="checkbox"/>	P1
Water Quality Manhole Type: describe	<input checked="" type="checkbox"/>	P2
Flow Splitter Manhole (Weir/Orifice)	<input type="checkbox"/>	P3
Standard Manhole	<input type="checkbox"/>	P4
Sediment Basin/Forebay	<input type="checkbox"/>	P5
Forebay Dewatering Riser Pipe (outlet)	<input type="checkbox"/>	P6
Facility Inlet		
Pavement Sheet Flow	<input checked="" type="checkbox"/>	P7
Inlet Pipe(s)	<input type="checkbox"/>	P8
Open Channel Inlet	<input type="checkbox"/>	P9
Riprap Pad (Energy Dissipater)	<input checked="" type="checkbox"/>	P10
Ground Cover		
Grass Bottom	<input checked="" type="checkbox"/>	P11
Grass Side Slopes	<input checked="" type="checkbox"/>	P12
Granular Drain Rock	<input checked="" type="checkbox"/>	P13
Plantings	<input checked="" type="checkbox"/>	P14
Underground Components		
Geotextile Fabric: Specify Type	<input type="checkbox"/>	P15
Impermeable Liner	<input checked="" type="checkbox"/>	P16
Water Quality Mix	<input checked="" type="checkbox"/>	P17
Perforated Pipe	<input checked="" type="checkbox"/>	P18
Bottom Marker (ex. Porous Pavers)	<input checked="" type="checkbox"/>	P19

Flow Spreader		
Anchored Board (midpoint of pond or every 50 feet along pond bottom)	<input type="checkbox"/>	P20
Other: <i>describe</i>	<input type="checkbox"/>	P21
Facility Outlet		
Catch Basin with Grate	<input checked="" type="checkbox"/>	P22
Outlet Pipe(s)	<input checked="" type="checkbox"/>	P23
Outlet/Flow Control Structure	<input type="checkbox"/>	P24
Auxiliary Outlet	<input type="checkbox"/>	P25
Hazmat Control Valve: <i>Specify make/model</i>	<input type="checkbox"/>	P26
Outfall Type		
Waterbody (Creek/Lake/Ocean)	<input checked="" type="checkbox"/> C	P27
	<input type="checkbox"/> L	
	<input type="checkbox"/> O	
Ditch	<input type="checkbox"/>	P28
Storm Drain System	<input type="checkbox"/>	P29
Outfall Components		
Riprap Pad	<input type="checkbox"/>	P30
Riprap Bank Protection	<input type="checkbox"/>	P31

7. Maintenance

Maintenance Frequency/Maintain Records

- a. Inspect annually. Preferably prior to the rainy season.
- b. Clean and maintain as necessary. Refer to Activity 125 in the Maintenance Guide for conditions when maintenance is needed.
- c. Keep a record of inspections, maintenance, and repairs.

Maintenance Guide/Maintenance Actions

The Maintenance Guide outlines the standard maintenance actions for water quality facilities under Activity 125.

There are standard maintenance tables for standard ODOT designs. The maintenance tables describe the maintenance component, the defect or problem, the condition when maintenance is needed, and the recommended maintenance to correct the problem. Use the following tables to maintain ODOT Ponds:

- Table 1 (General Maintenance): Contains general maintenance and inspection guidelines that are applicable to all ODOT water quality facilities
- Table 2 (Maintenance of Stormwater Ponds): Contains maintenance information for ponds

The ODOT Maintenance Guide can be viewed at the following website:
<http://www.oregon.gov/ODOT/HWY/OOM/pages/mguide.aspx>

The Blue Book can be viewed at the following website:
http://www.oregon.gov/ODOT/Maintenance/Documents/blue_book.pdf

8. Limitations

There are access limitations for this facility:

<input type="checkbox"/> No	<input checked="" type="checkbox"/> Yes
There are no porous pavers installed in this pond.	

Ponds are designed to allow equipment access along the bottom if an access grid is installed. If an access grid is NOT installed, vehicles entering the pond can create depressions (tire ruts), damage vegetation, or damage structural components (e.g. flow spreaders). These conditions may result in poor treatment and drainage performance.

If no access grid then: Equipment wheels should be kept on the tops and side slopes. Mower arms may be run along the pond bottom.

9. Waste Material Handling

Material removed from the facility is defined as waste by the Department of Environmental Quality (DEQ). Refer to the road waste section of the ODOT Maintenance Yard Environmental Management System (EMS) Policy and Procedures Manual for disposal options:

<http://www.oregon.gov/ODOT/HWY/OOM/pages/ems.aspx>


Contact any of the following for more detailed information about management of waste materials found on site:

ODOT Clean Water Unit	(503) 986-3008
ODOT Statewide Hazmat Coordinator	(503) 667-7442
ODOT Region 1 Hazmat Coordinator	(503) 731-8290
ODOT Region 2 Hazmat Coordinator	(503) 986-2647
ODOT Region 3 Hazmat Coordinator	(541) 957-3594
ODOT Region 4 Hazmat Coordinator	(541) 388-6186
ODOT Region 5 Hazmat Coordinator	(541) 963-1590
ODEQ Northwest Region Office	(503) 229-5263


A Appendix A – Site Specific Operational Plan

Contents:


Operational Plan: DFI D00928

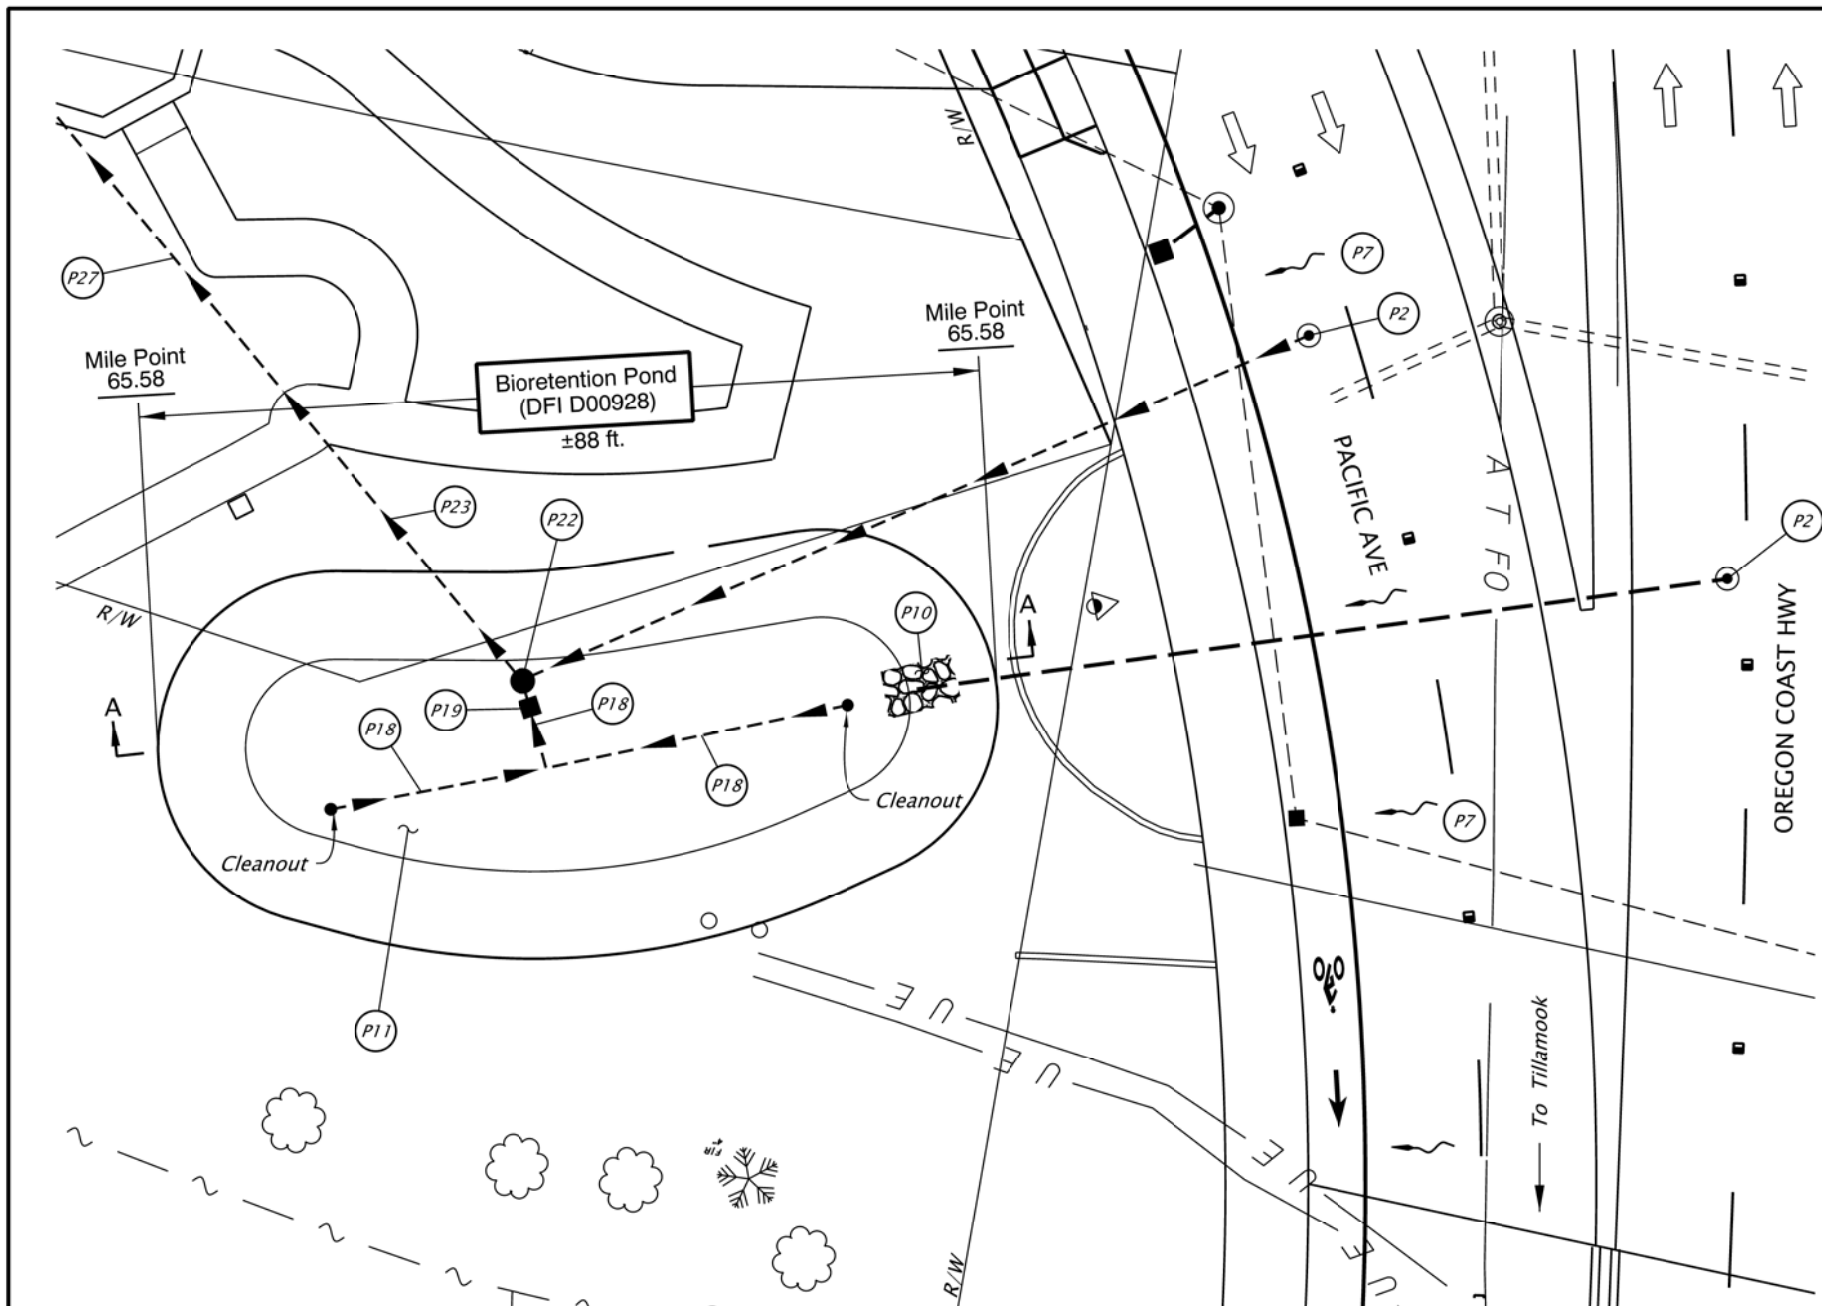

PLAN
N.T.S.

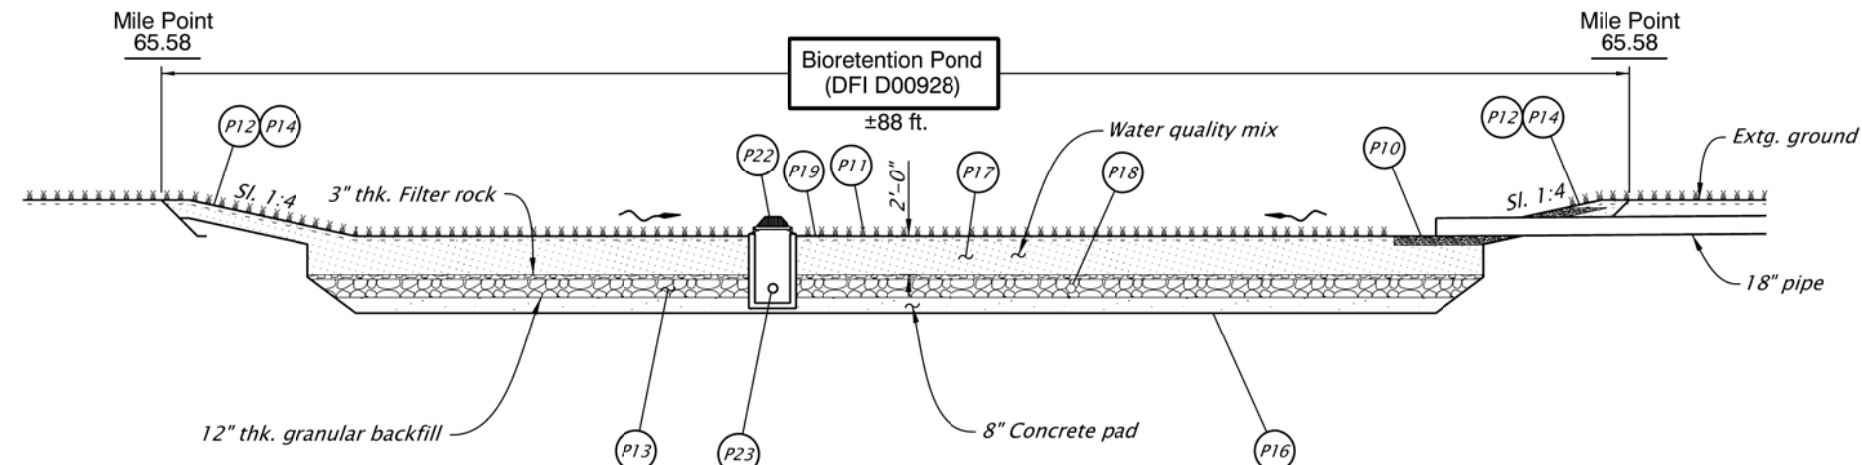

SECTION A-A
N.T.S.

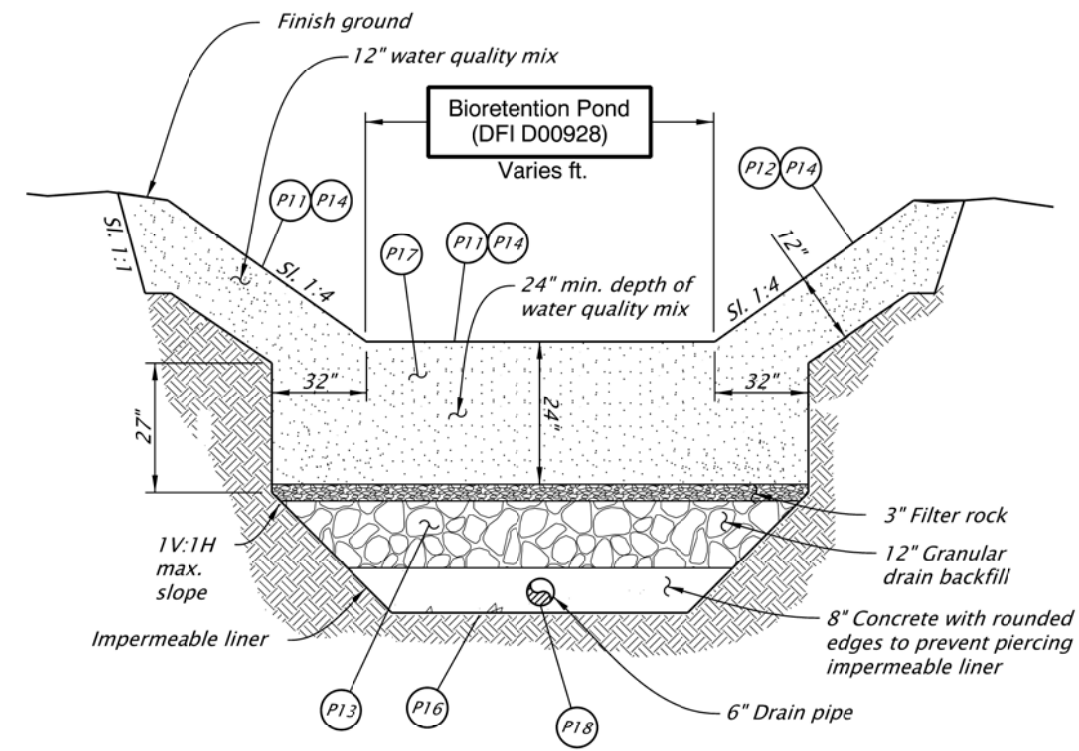

TYPICAL SECTION
N.T.S.

- LEGEND:**
- Photo Location / Direction
 - Facility Component (see table 1 in O&M Manual)
 - Manhole
 - Bioretention Point Outlet
 - Storm Pipe (Facility)
 - Storm Pipe (Facility)
 - Conveyance Direction
 - Pavement/Facility Flow Path
 - Traffic Flow Direction



Prepared By:
Chris Carman

Drafted By:
Michael Skelton

DFI D00928
MAINTENANCE DISTRICT 1 HWY 009
BIORETENTION POND
OREGON COAST HWY MP 65.58
TILLAMOOK COUNTY


B Appendix B – Project Contract Plans

Contents:

Site Specific Subset of Project Contract Plan 49V-060

INDEX OF SHEETS	
SHEET NO.	DESCRIPTION
1	Title Sheet
1A, 1A-2	Index Of Sheets Cont.
1A-3	Std. Drg. Nos.
1A-5	Index of Sheets Cont.
1B	Plan Sheet Layout

STATE OF OREGON
 DEPARTMENT OF TRANSPORTATION
 PLANS FOR PROPOSED PROJECT
**GRADING, DRAINAGE, STRUCTURES, PAVING, SIGNING, ILLUMINATION,
 SIGNALS, & ROADSIDE DEVELOPMENT**

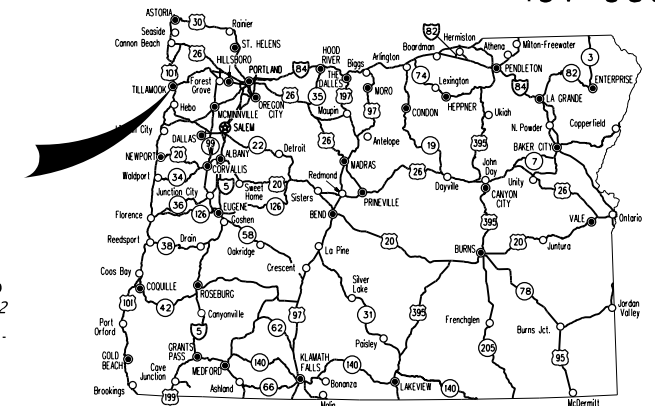

REVISED AS CONSTRUCTED
 4/19/19 CONTRACT C14902
 PROJ. MGR. Ian Machan

US101 @ OR6 (TILLAMOOK) SEC.
OREGON COAST HWY. & WILSON RIVER HWY.
 TILLAMOOK COUNTY
 MAY 2016


Overall Length Of Project - 0.4 Miles

ATTENTION:
 Oregon Law Requires You To Follow Rules Adopted By The Oregon Utility Notification Center. Those Rules Are Set Forth In OAR 952-001-0010 Through OAR 952-001-0090. You May Obtain Copies Of The Rules By Calling The Center. (Note: The Telephone Number For The Oregon Utility Center Is (503) 232-1987.)



END OF PROJECT
JTA-S009(473)
STA. "WR" 17+62.63 (M.P. 9.07)

BEGINNING OF PROJECT
JTA-S009(473)
STA. "M" 191+93.00 (M.P. 65.78)

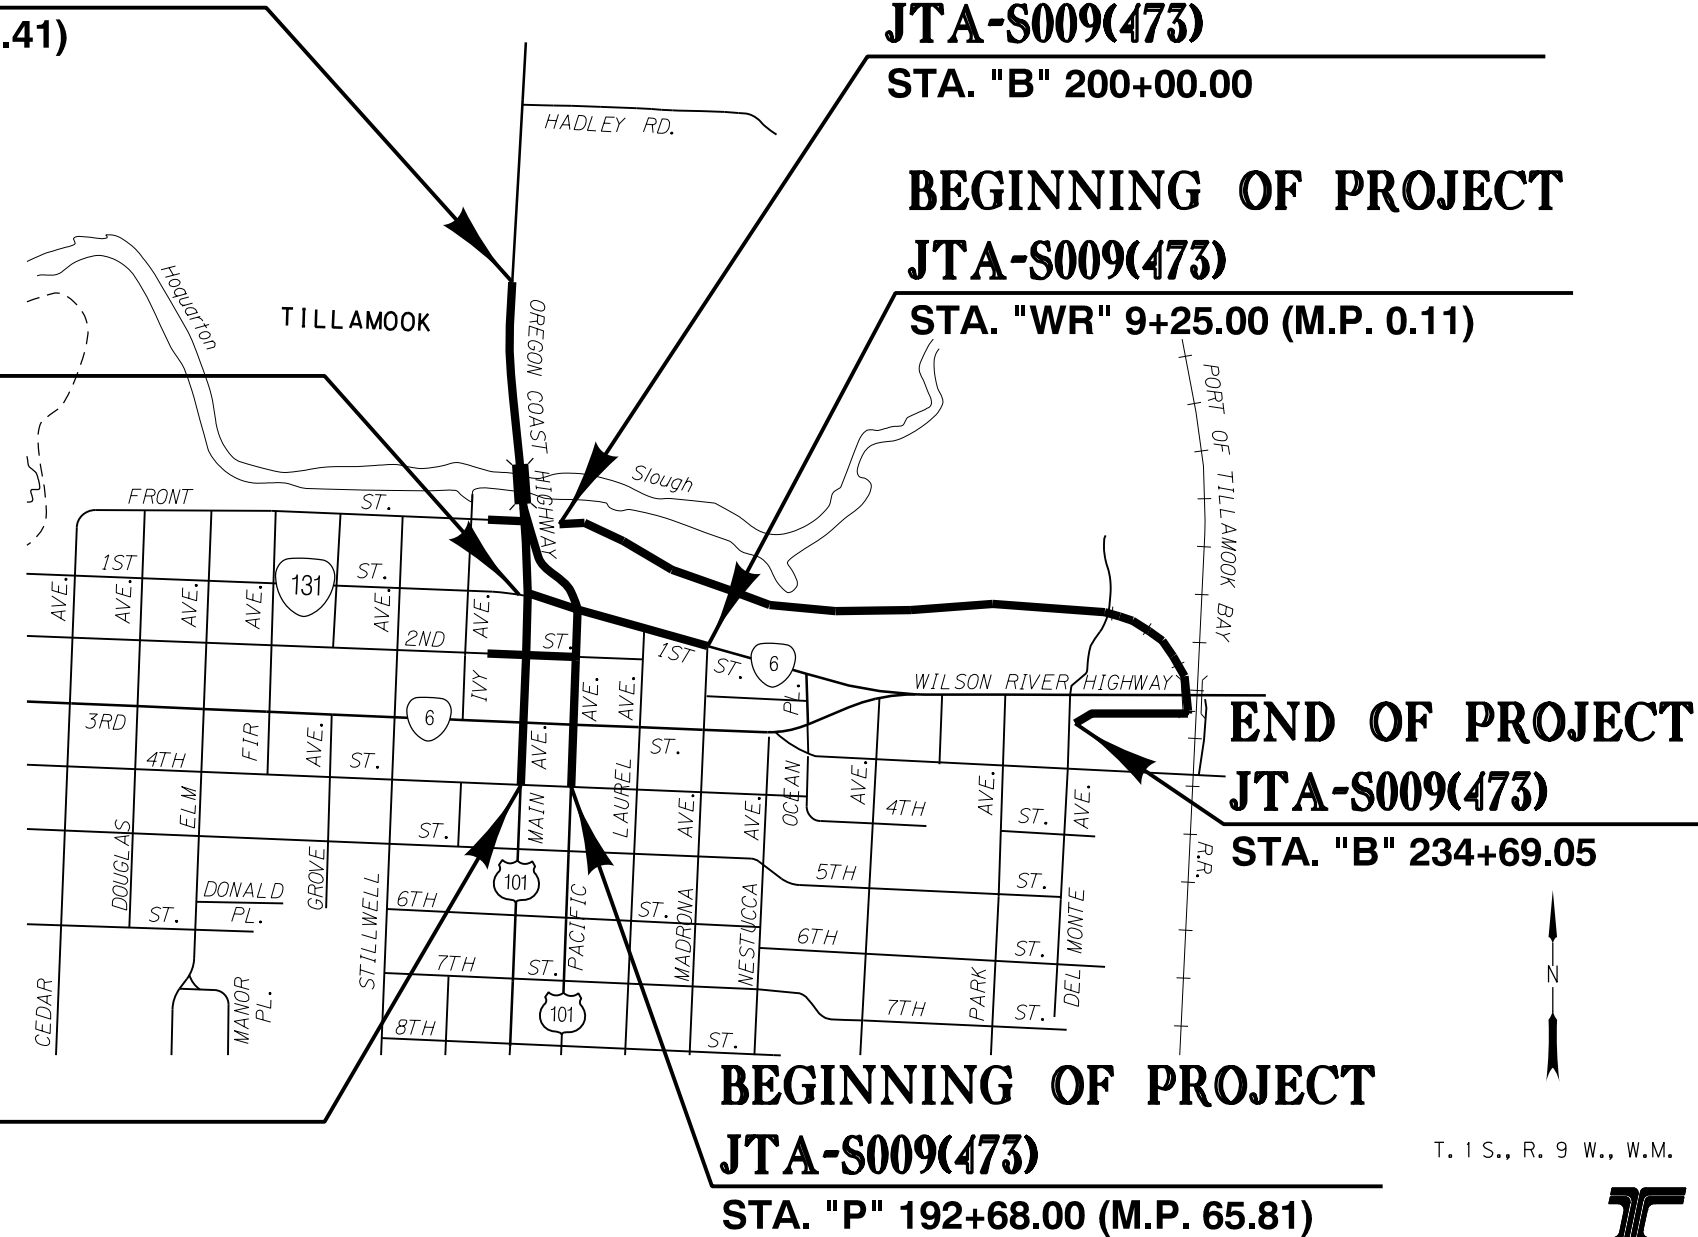

BEGINNING OF PROJECT
JTA-S009(473)

STA. "B" 200+00.00

BEGINNING OF PROJECT
JTA-S009(473)

STA. "WR" 9+25.00 (M.P. 0.11)

END OF PROJECT
JTA-S009(473)
STA. "B" 234+69.05

BEGINNING OF PROJECT
JTA-S009(473)
STA. "P" 192+68.00 (M.P. 65.81)

T. I.S., R. 9 W., W.M.



OREGON TRANSPORTATION COMMISSION
 Tammy Baney CHAIR
 David Lohman COMMISSIONER
 Susan Morgan COMMISSIONER
 Alando Simpson COMMISSIONER
 Sean O'Hallaren COMMISSIONER
 Matthew L. Garrett DIRECTOR OF TRANSPORTATION

PLANS PREPARED FOR
 OREGON DEPARTMENT OF TRANSPORTATION





These plans were developed using ODOT design standards. Exceptions to these standards, if any, have been submitted and approved by the ODOT Chief Engineer or their delegated authority.

Approving Authority: _____
 Signature & date
 Jeff W. Olson, Principal
 Print name and title

 Concurrence by ODOT Chief Engineer

US101 @ OR6 (TILLAMOOK) SEC.
 OREGON COAST HWY. & WILSON RIVER HWY.
 TILLAMOOK COUNTY

FEDERAL HIGHWAY ADMINISTRATION	PROJECT NUMBER	SHEET NO.
OREGON DIVISION	JTA-S009(473)	1

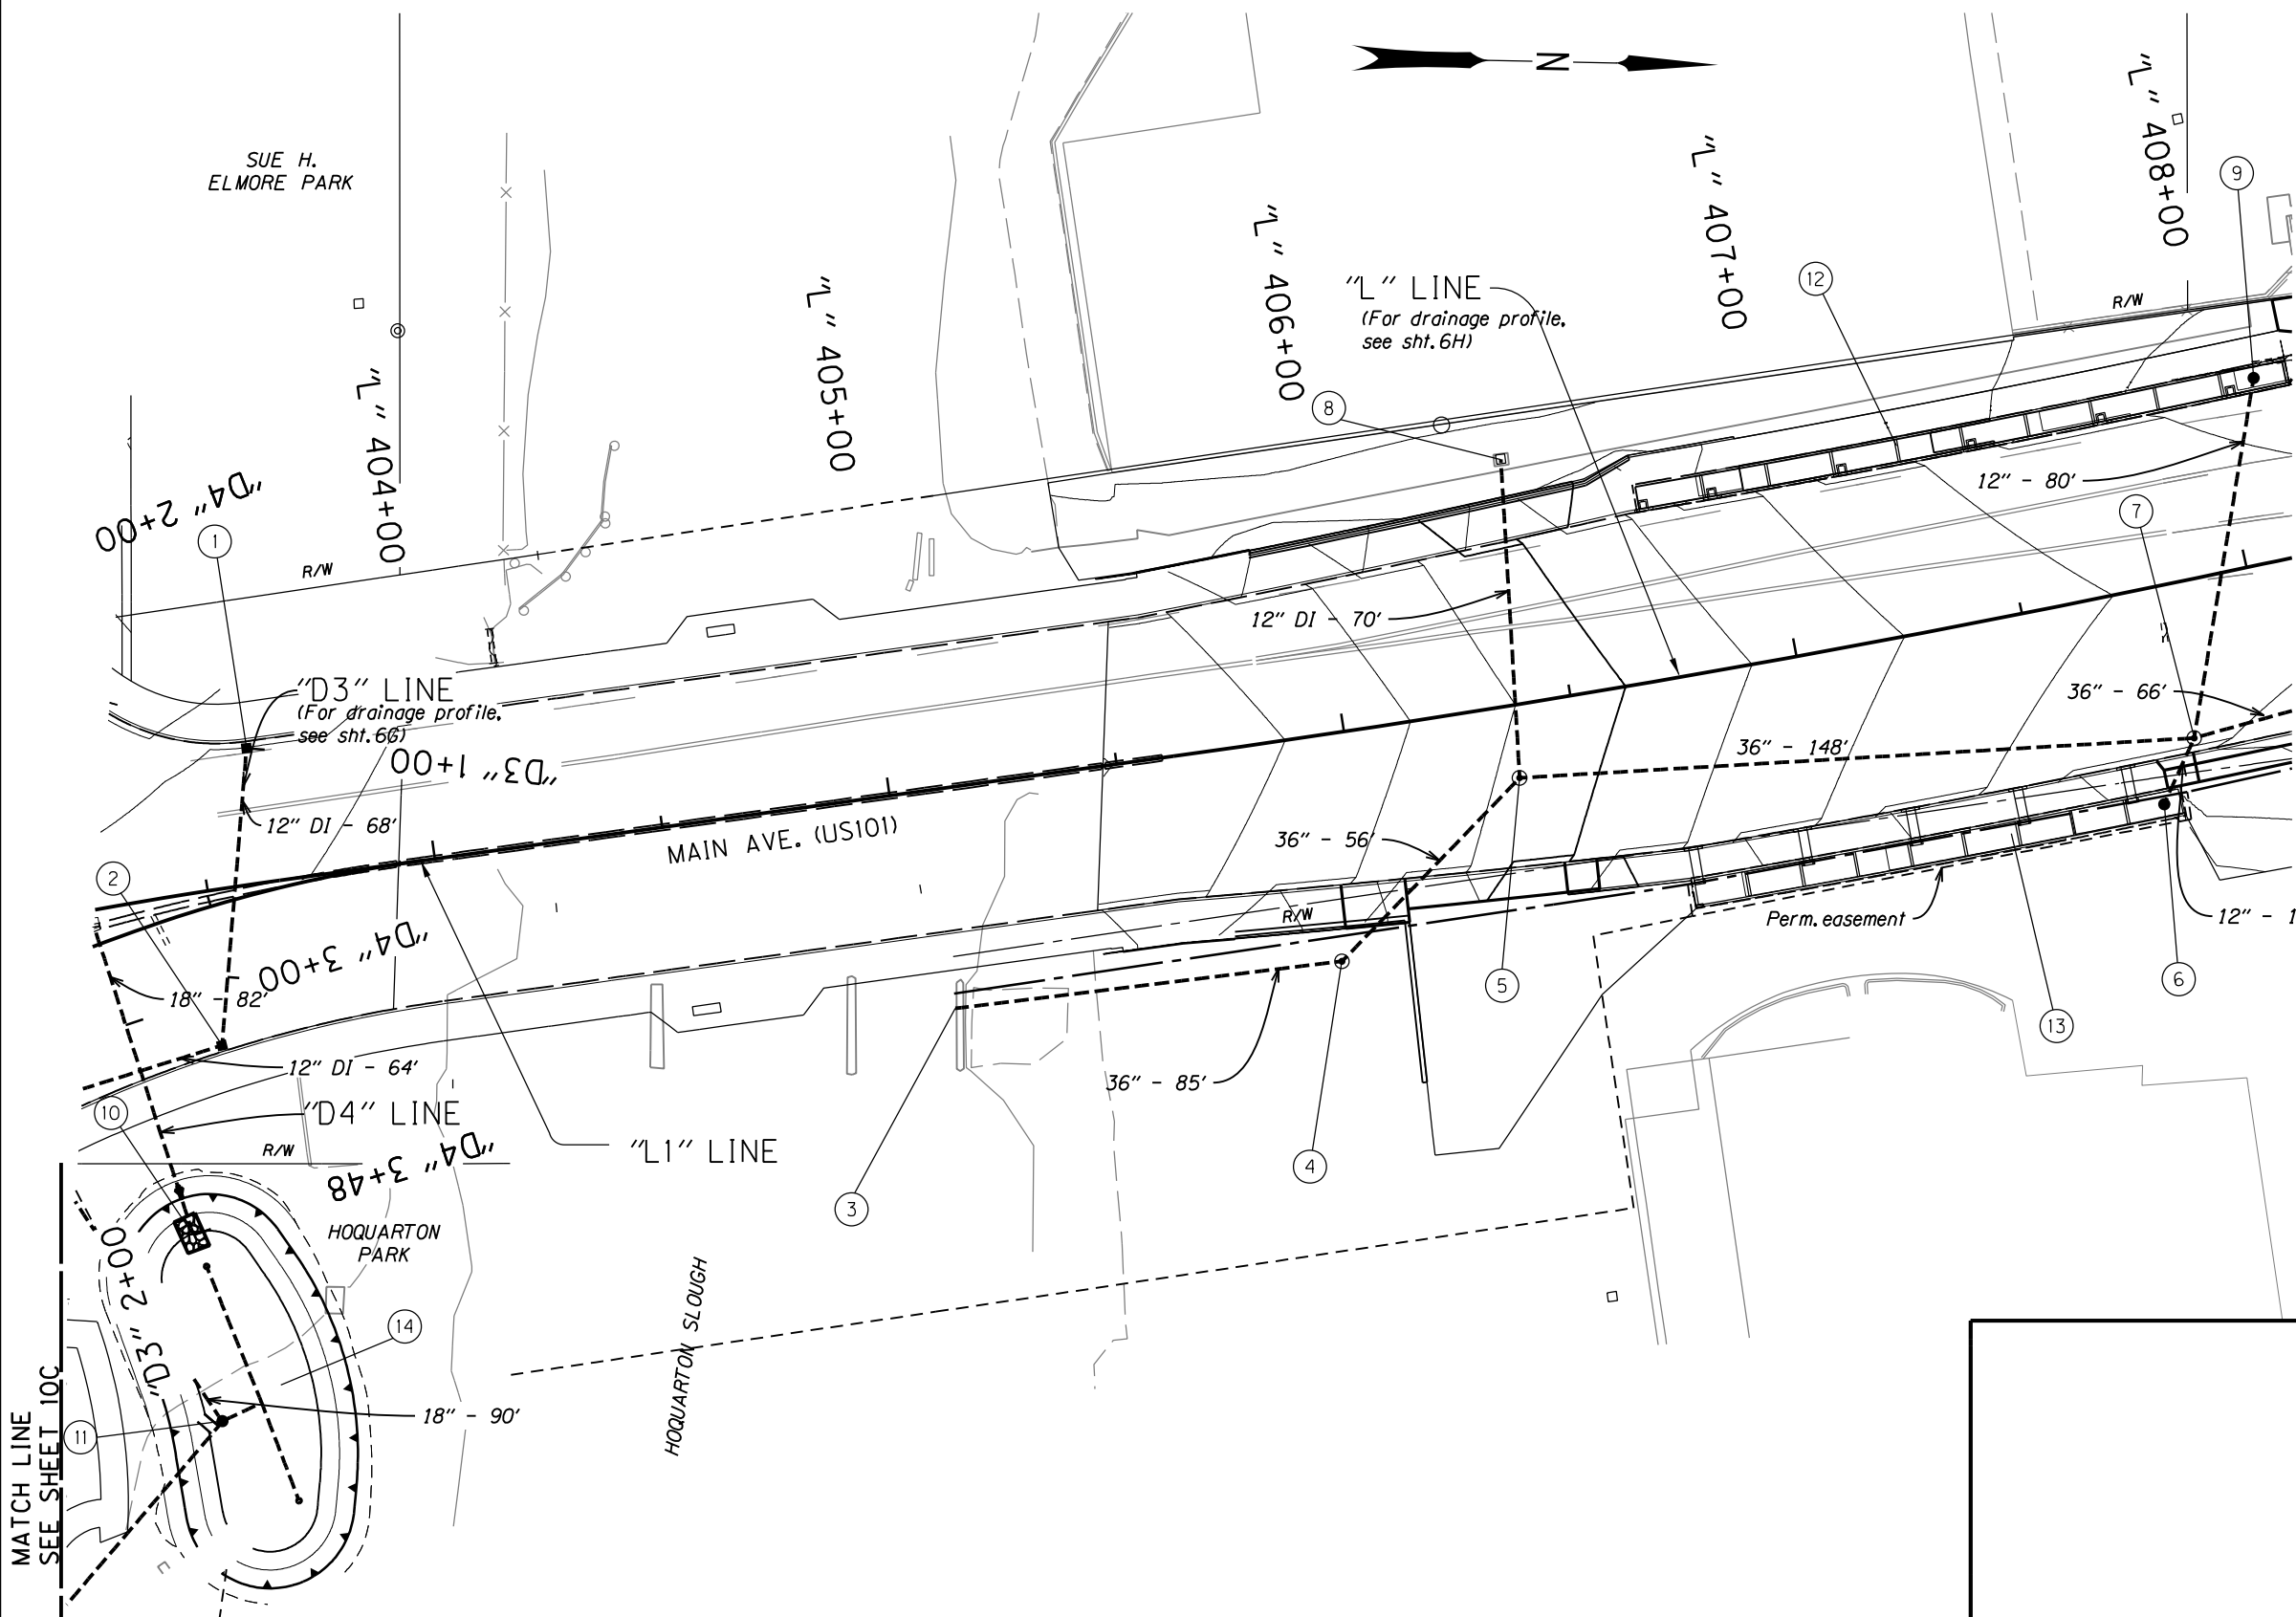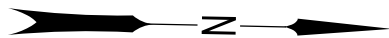

- ① Sta. "L" 403+62.74, 29.50' Lt.
Const. type G-2 inlet with sump
Rim = 17.20
I.E. Out= 14.20 (12" E)
- ② Sta. "L1" 403+43.12, 29.67' Rt.
Const. type G-2 inlet with sump
Rim = 16.90
I.E. In= 13.90 (12" W)
I.E. Out= 13.90 (12" S)
Inst. 12" DI storm sew. pipe - 68'
5' depth
- ③ Sta. "L" 405+07.85, 47.89' Rt.
Const. storm outfall class 100 riprap, with tide gate
(For details, see sht. GJ-14)
I.E. Out= 3.53 (36" N)
Inst. 36" storm sew. pipe - 85'
20' depth
- ④ Sta. "L" 405+92.33, 49.41' Rt.
Const. manhole, 72" dia.
Rim = 13.68
I.E. In= 3.74 (36" NW)
I.E. Out= 3.64 (36" S)
Inst. 36" storm sew. pipe - 56'
20' depth
- ⑤ Sta. "L" 406+36.21, 15.87' Rt.
Const. manhole, 72" dia.
Rim = 15.75
I.E. In= 7.07 (12" W)
I.E. In= 3.82 (36" N)
I.E. Out= 3.82 (36" SE)
Inst. 12" DI storm sew. pipe - 70'
10' depth
Inst. 36" storm sew. pipe - 148'
20' depth
- ⑥ Sta. "L" 407+72.07, 46.83' Rt.
Const. Beehive inlet
Rim = 10.47
I.E. Out= 6.61 (12" NW)
(For details, see sht. GJ-12)

NOTE:
 1. Field verify elevation call-outs noted with "±".
 2. Utilities in conflict to be relocated by others prior to construction, unless otherwise noted.
 3. Construction notes continued on sht. 6D.

OREGON DEPARTMENT OF TRANSPORTATION


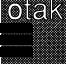
Otak Inc. 700 Washington St, Ste. 401
Vancouver, WA 98660
Hanmi Global Partner Phone: 360.373.9613 Fax: 360.737.9651


US101 @ OR6 (TILLAMOOK) SEC.
 OREGON COAST HWY. & WILSON RIVER HWY.
 TILLAMOOK COUNTY

Reviewed By - T Kraft
 Designed By - A Cantlon
 Drafted By - A Cobb/M McCandless

DRAINAGE PLAN SHEET NO. 6C

- ⑦ Sta. "L" 407+81.26, 34.00' Rt.
 Const. shallow manhole, 84" dia.
 Rim = 11.20
 I.E. In= 6.54 (12" SE)
 I.E. In= 4.14 (36" N)
 I.E. In= 5.63 (12" W)
 I.E. Out= 4.04 (36" S)
 Inst. 12" storm sew. pipe - 80'
 10' depth
 Inst. 12" storm sew. pipe - 16'
 5' depth
 Inst. 36" storm sew. pipe - 66'
 10' depth
- ⑧ Sta. "L" 406+43.36, 53.30' Lt.
 Connect to extg. storm sew. pipe
 Rim = 13.42
 I.E. In= Field verifiy (3" SE)
 I.E. In= Field verifiy (4" N)
 I.E. In= Field verifiy (4" W)
 I.E. Out= 10.20 (12" E)
- ⑨ Sta. "L" 408+10.03, 40.08' Lt.
 Const. Beehive inlet
 Rim = 10.59
 I.E. Out= 5.95 (12" E)
 (For details, see sht. GJ-12)
- ⑩ Sta. "L 1" 403+19.65, 66.43' Rt.
 Const. Storm Outfall Class 50 riprap
 (For details, see sht. GJ-14)
 I.E. Out= 10.82 (18" W)
 Inst. 18" storm sew. pipe - 82'
 10' depth
- ⑪ Sta. "L 1" 403+05.73, 106.23' Rt.
 Const. Beehive Inlet
 Rim = 10.38
 I.E. In= 6.51 (18" SW)
 I.E. Out= 6.51 (18" SE)
 Inst. 18" sew. pipe - 90'
 10' depth
 (For details, see sht. GJ-12)
- ⑫ Sta. "L" 406+71.5 to Sta. "L" 408+16.8, Lt.
 Const. Bioretention Pond D00925 - 881 Sq. Ft
 (For details, see shts. GJ thru GJ-15)
- ⑬ Sta. "L" 406+69.5 to Sta. "L" 407+75.5, Rt.
 Const. Bioretention Pond D00926 - 724 Sq. Ft.
 (For details, see shts. GJ thru GJ-15)
- ⑭ Sta. "L 1" 403+09.33 to Sta. "L 1" 403+69.12, Rt.
 Const. Bioretention Pond D00928 - 4,000 Sq. Ft.
 (For details, see sht. GJ-7)

 OREGON DEPARTMENT OF TRANSPORTATION	
 otak Hanmi Global Partner	700 Washington St, Ste. 401 Vancouver, WA 98660 Phone: 360.373.9613 Fax: 360.737.9651
US101 @ OR6 (TILLAMOOK) SEC. OREGON COAST HWY. & WILSON RIVER HWY. TILLAMOOK COUNTY	
Reviewed By - T Kraft Designed By - A Cantlon Drafted By - A Cobb/M McCandless	
DRAINAGE NOTES	SHEET NO. 6D

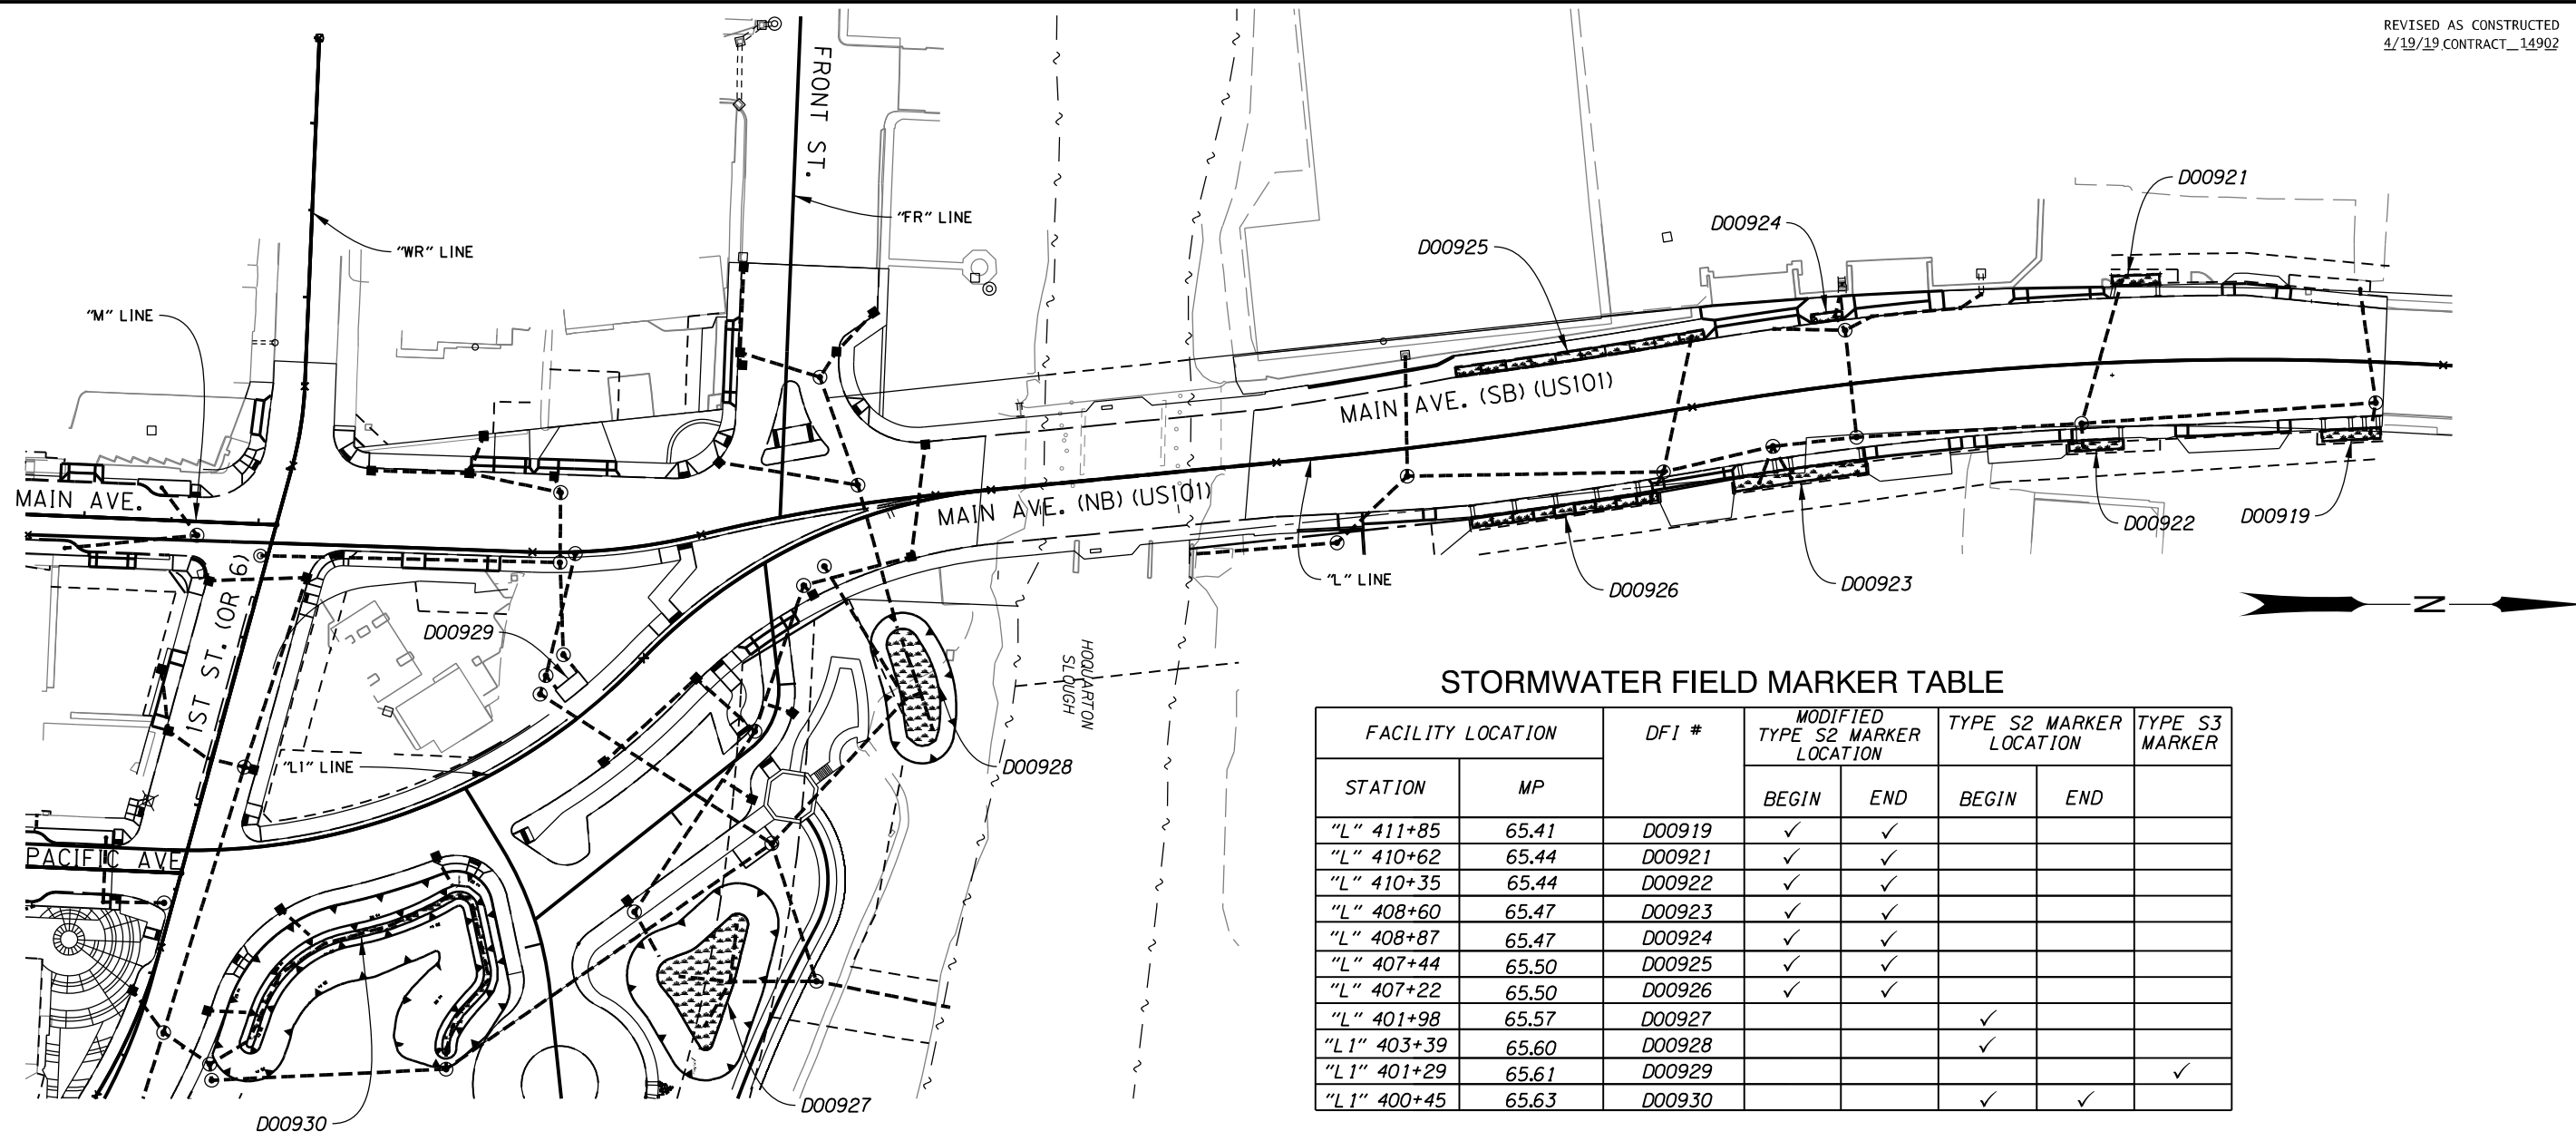

STORMWATER FIELD MARKER TABLE

FACILITY LOCATION		DFI #	MODIFIED TYPE S2 MARKER LOCATION		TYPE S2 MARKER LOCATION		TYPE S3 MARKER
STATION	MP		BEGIN	END	BEGIN	END	
"L" 411+85	65.41	D00919	✓	✓			
"L" 410+62	65.44	D00921	✓	✓			
"L" 410+35	65.44	D00922	✓	✓			
"L" 408+60	65.47	D00923	✓	✓			
"L" 408+87	65.47	D00924	✓	✓			
"L" 407+44	65.50	D00925	✓	✓			
"L" 407+22	65.50	D00926	✓	✓			
"L" 401+98	65.57	D00927			✓		
"L1" 403+39	65.60	D00928			✓		
"L1" 401+29	65.61	D00929					✓
"L1" 400+45	65.63	D00930			✓	✓	

PLAN
No Scale

See Drg.No.RD399 for facility marker details.

OREGON DEPARTMENT OF TRANSPORTATION



Otak Inc. Hanmi Global Partner
700 Washington St, Ste. 401
Vancouver, WA 98660
Phone: 360.373.9613 Fax: 360.737.9651

US101 @ OR6 (TILLAMOOK) SEC.
OREGON COAST HWY. & WILSON RIVER HWY.
TILLAMOOK COUNTY

Reviewed By - T Kraft
Designed By - A Cantlon
Drafted By - A Cobb

WATER QUALITY PLAN

SHEET NO.
GJ-2

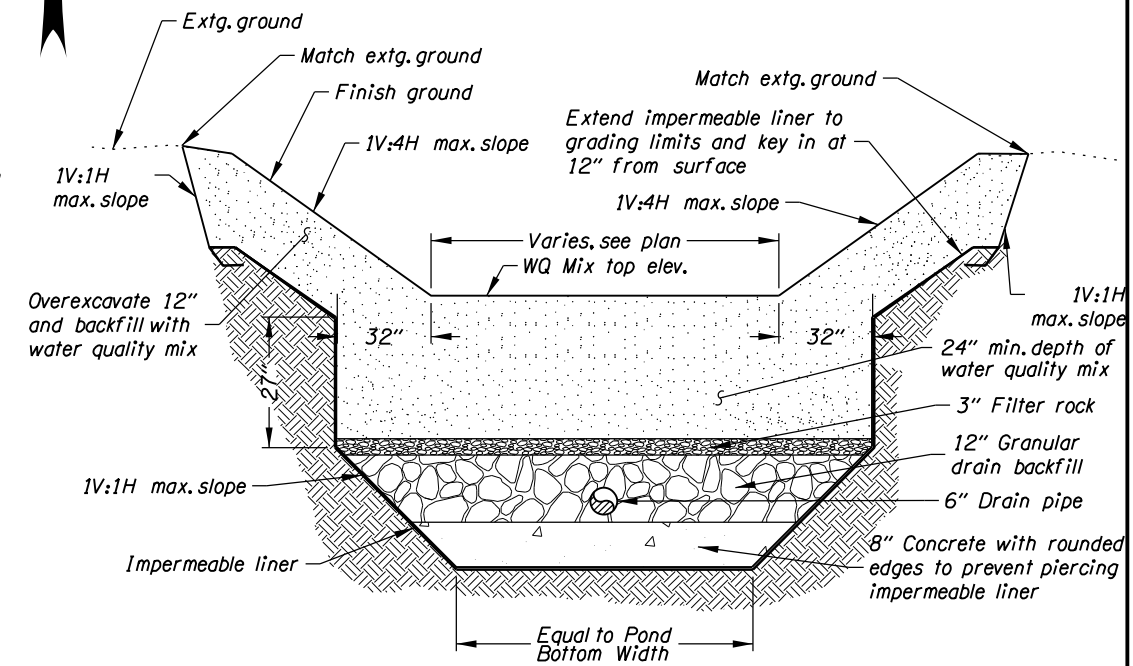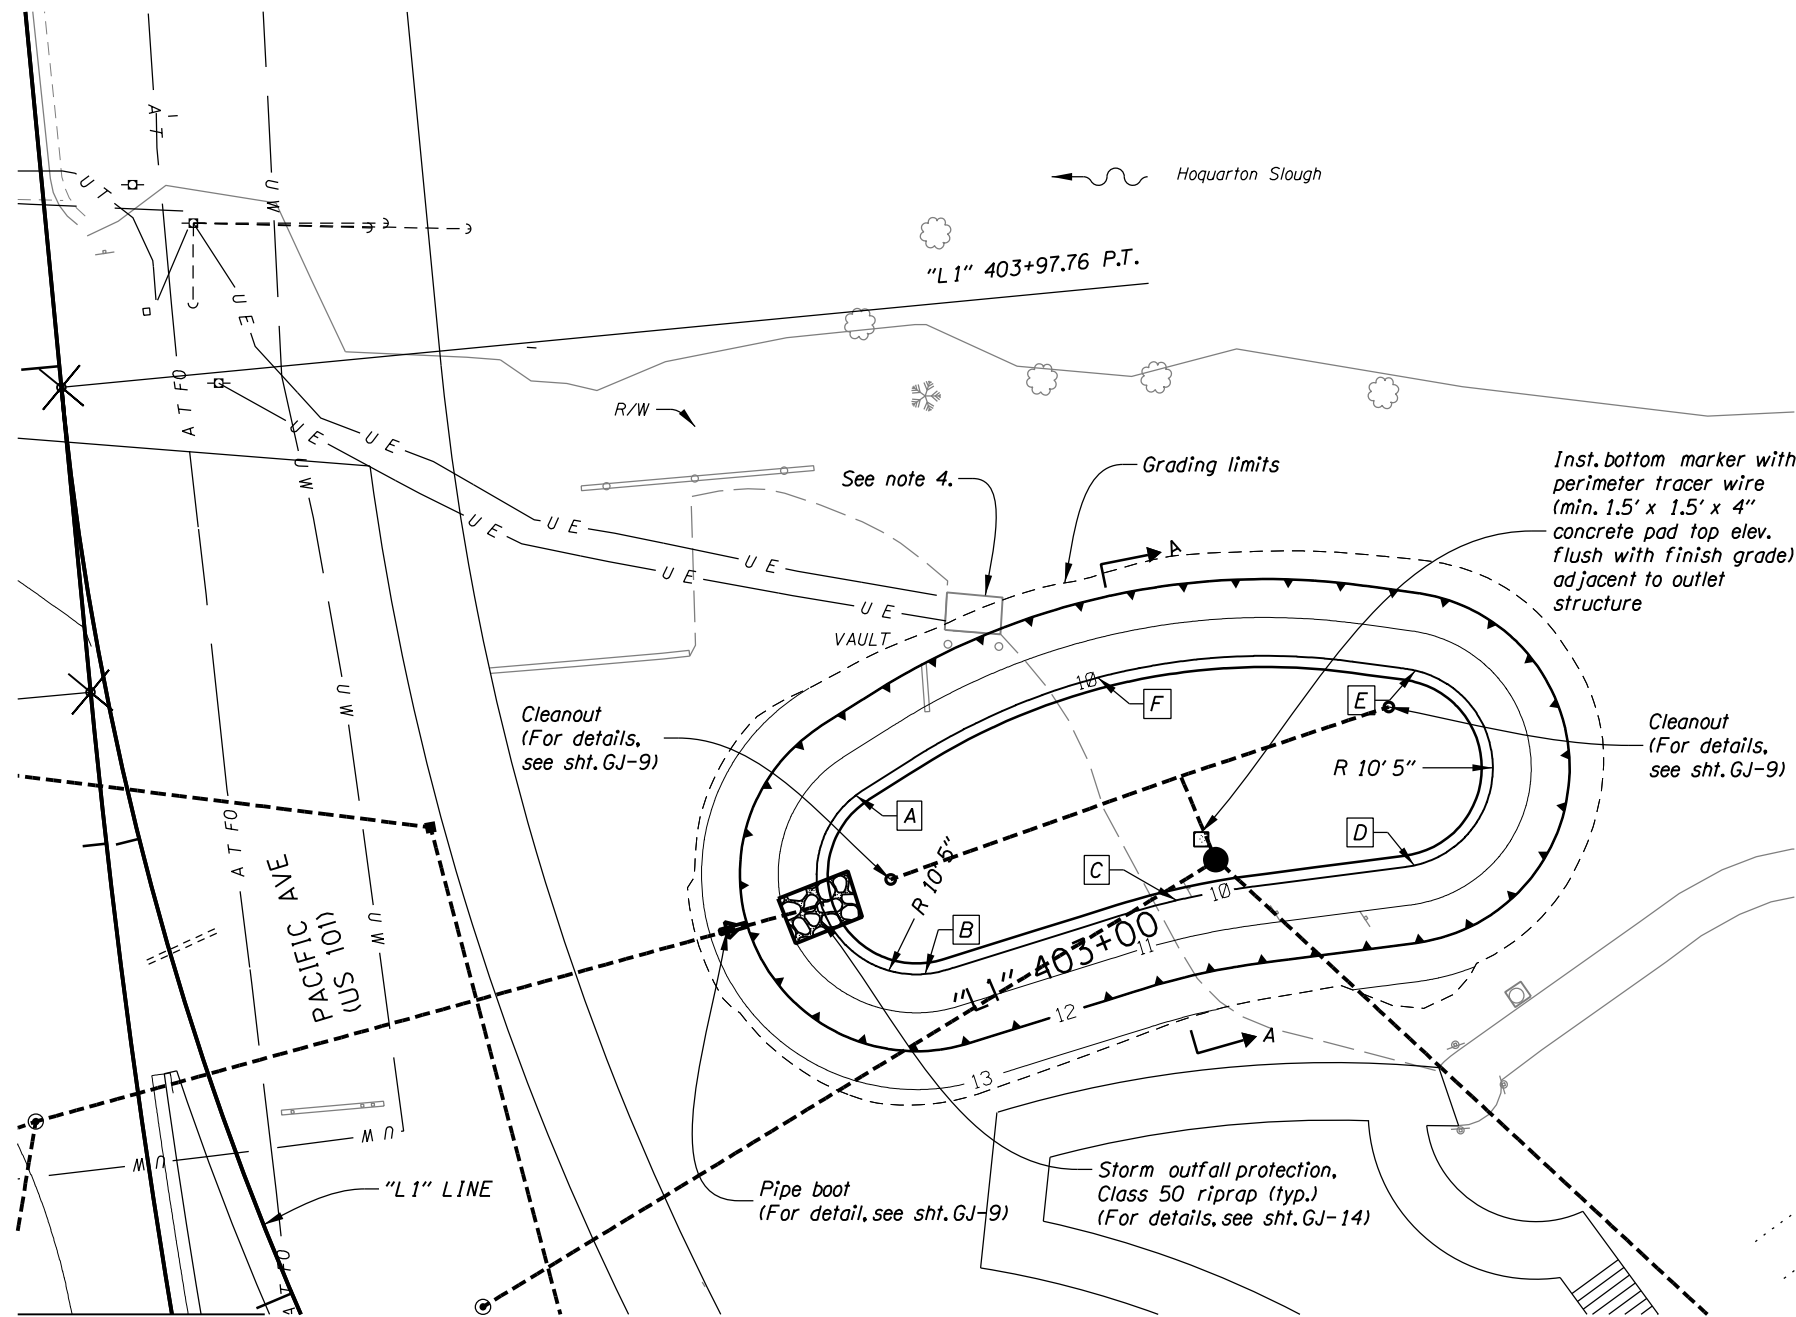

BIORETENTION POND D00928
SECTION A-A
No Scale

NOTES:

1. See GN shts. for planting plan.
2. See shts. 6C and 6D for inlet and outlet data.
3. Heavy equipment shall not be allowed in bioretention pond.
4. Electric vault to be relocated by others prior to construction.

FACILITY ID	WQ MIX TOP ELEV.
D00928	9.71

POINT	STA., OFFSET
A	"L1" 403+32.1, 73.2' RT.
B	"L1" 403+06.2, 73.2' RT.
C	"L1" 403+02.2, 100.8' RT.
D	"L1" 402+92.0, 125.0' RT.
E	"L1" 403+23.7, 132.6' RT.
F	"L1" 403+38.2, 100.8' RT.

OREGON DEPARTMENT OF TRANSPORTATION







Otak Inc. 700 Washington Street, Suite 401
Vancouver, WA 98660
Phone: (360)737-9613 Fax: (360)737-9651

US101 @ OR6 (TILLAMOOK) SEC.
OREGON COAST HWY. & WILSON RIVER HWY.
TILLAMOOK COUNTY

Reviewed By - T Kraft
Designed By - A Cantlon
Drafted By - S Reiter

WATER QUALITY DETAILS

SHEET NO.
GJ-7

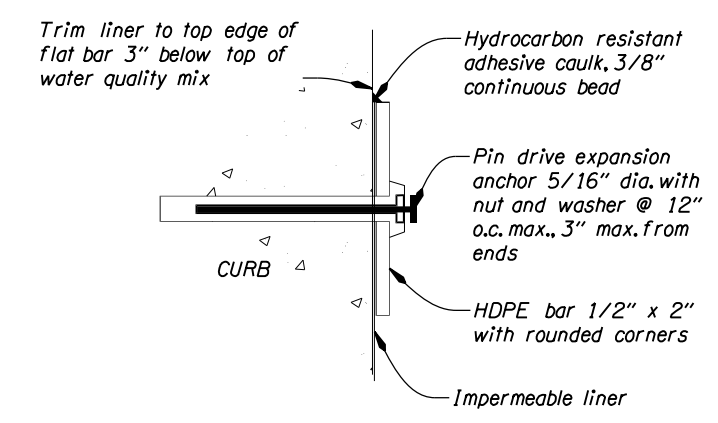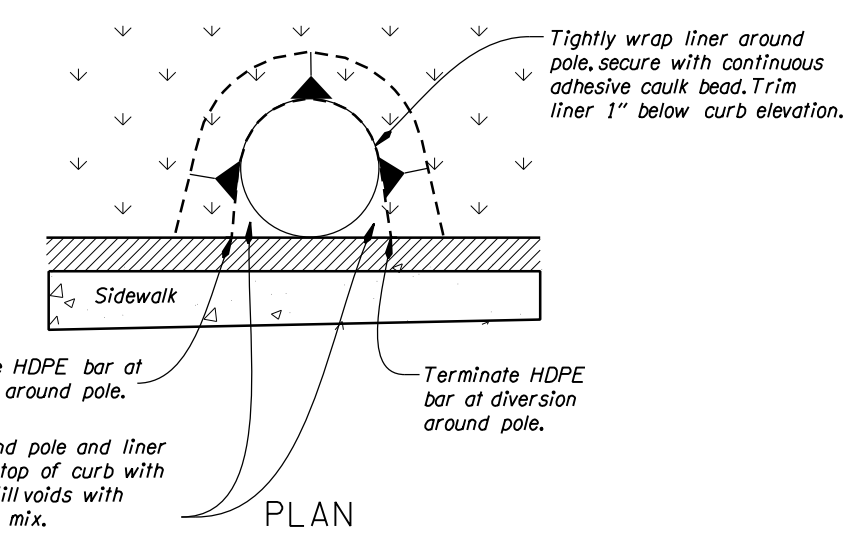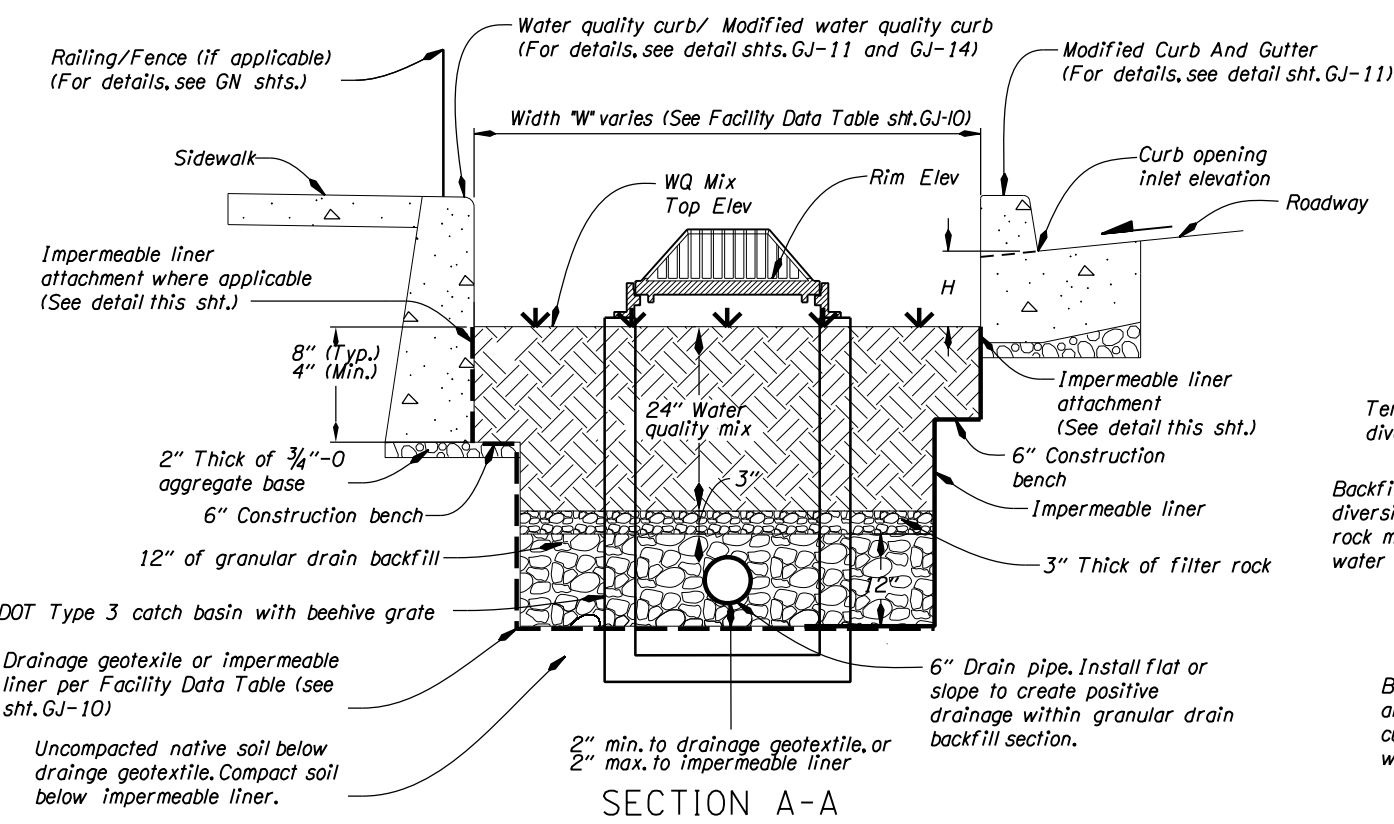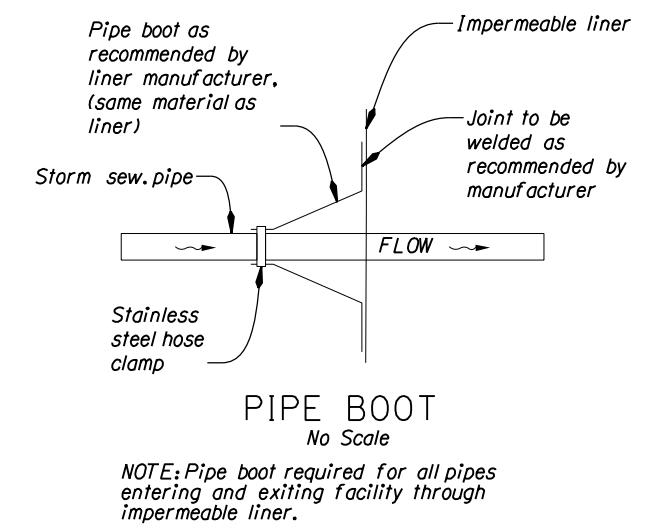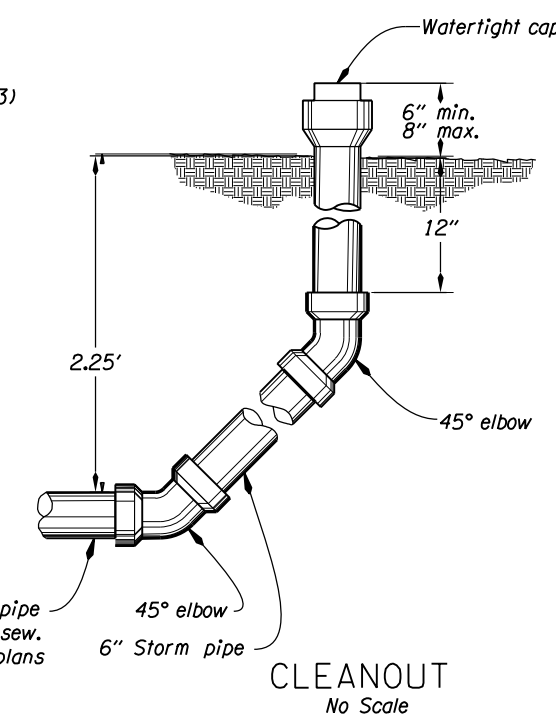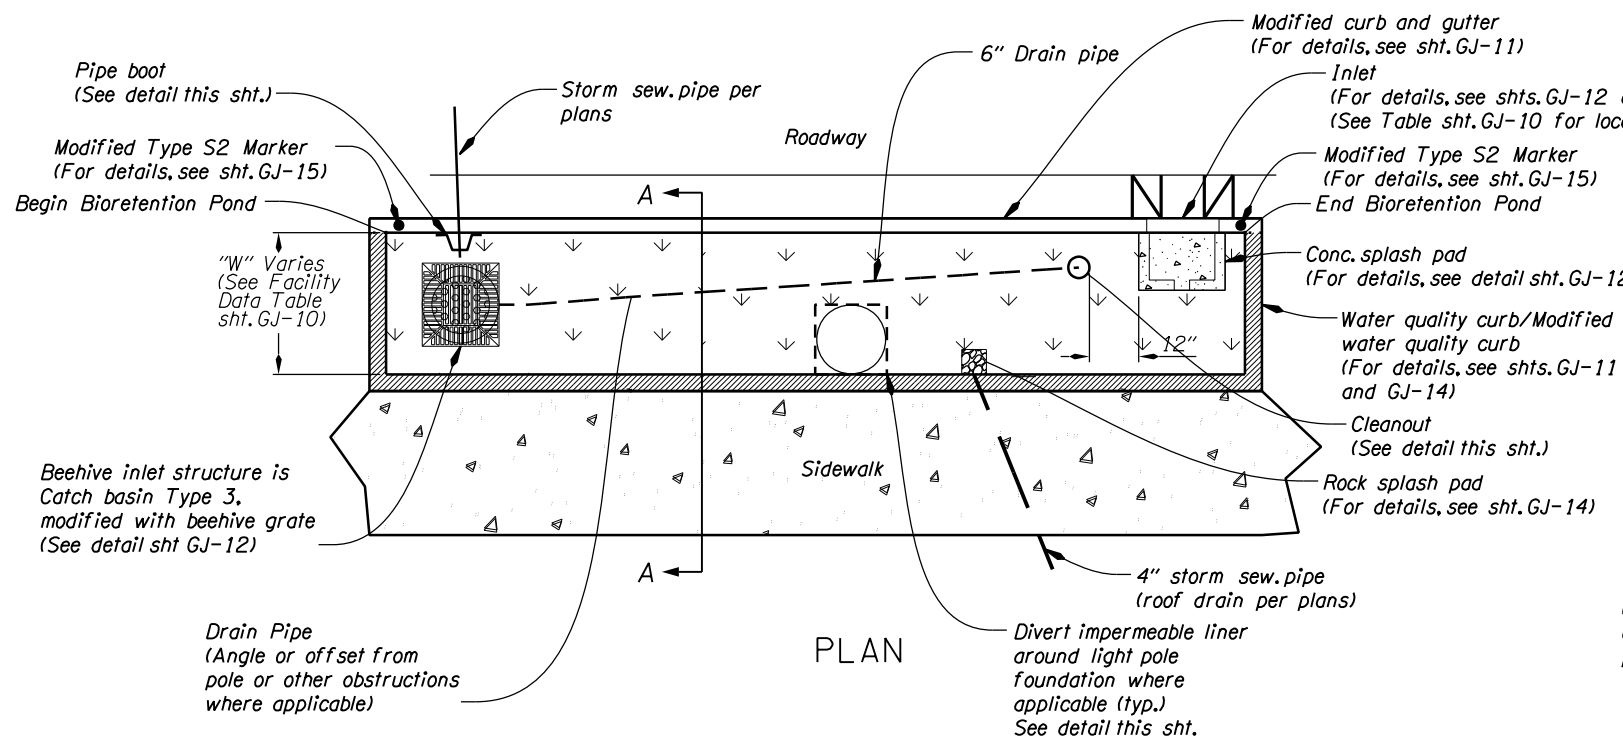


- GENERAL NOTES FOR ALL DETAILS:**
- Slope Drain Rock and Filter Rock layers to match bottom slope.
 - Slope drain pipe towards outlet.
 - Install Drain Rock splash pad downstream of check dam, see details sht. GJ-11.
 - Where catch basin structure protrudes through impermeable liner, cut liner in "X" shape to create rectangular hole to match size and shape of structure. Upon installation of catch basin, fold resulting triangular shaped fabric up sides of structure, and secure to structure with adhesive caulk. Backfill holes in liner with compacted topsoil.

IMPERMEABLE LINER AROUND LIGHT POLE FOUNDATION
No Scale


- NOTES:**
- Liner to extend from 3 in. below top of top soil to the bottom of excavation.
 - 3 in. of concrete is required on all sides of attachment.

	OREGON DEPARTMENT OF TRANSPORTATION Otak Inc. Hanmi Global Partner 700 Washington St, Ste. 401 Vancouver, WA 98660 Phone: 360.373.9613 Fax: 360.737.9651
US101 @ OR6 (TILLAMOOK) SEC. OREGON COAST HWY. & WILSON RIVER HWY. TILLAMOOK COUNTY	
Reviewed By - T Kraft Designed By - A Cantion Drafted By - S Reiter	
WATER QUALITY DETAILS	
SHEET NO. GJ-9	

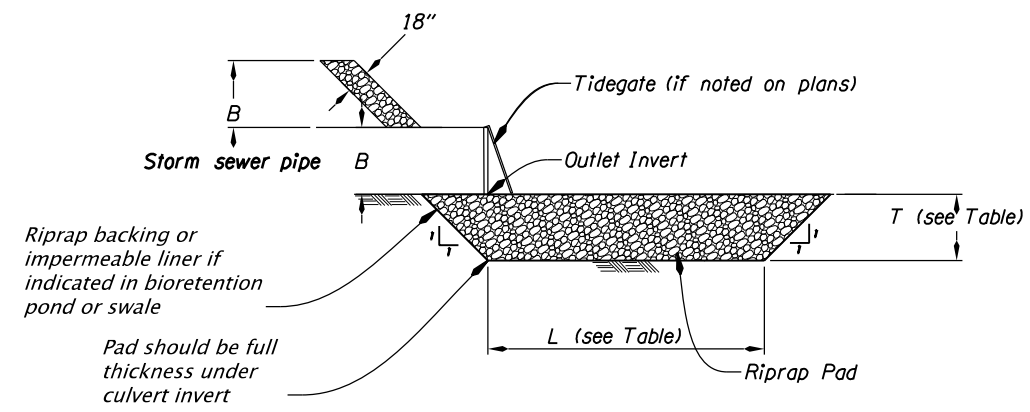


ELEVATION


B = Diameter of storm sew. pipe, ft
L = Length of bottom of riprap pad, ft
T = Thickness of riprap pad, ft
W = Width of top of riprap pad, ft

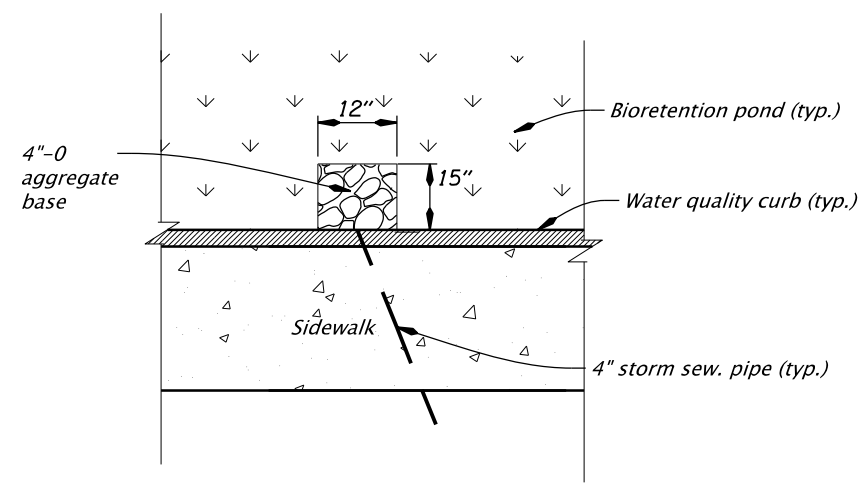


PLAN VIEW

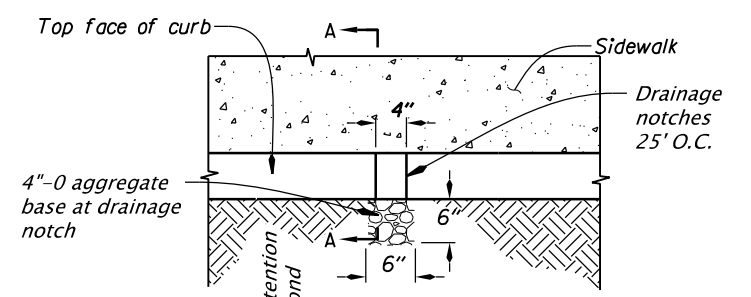


PLAN

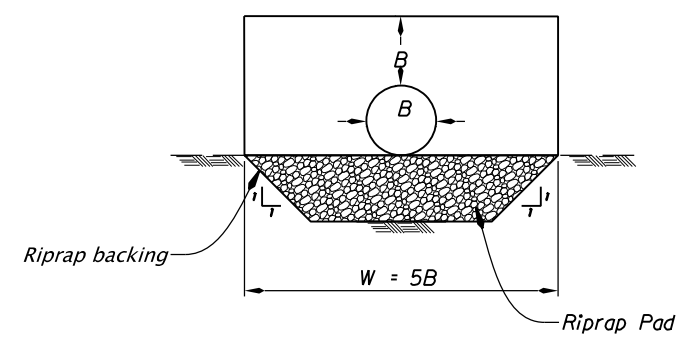

END VIEW

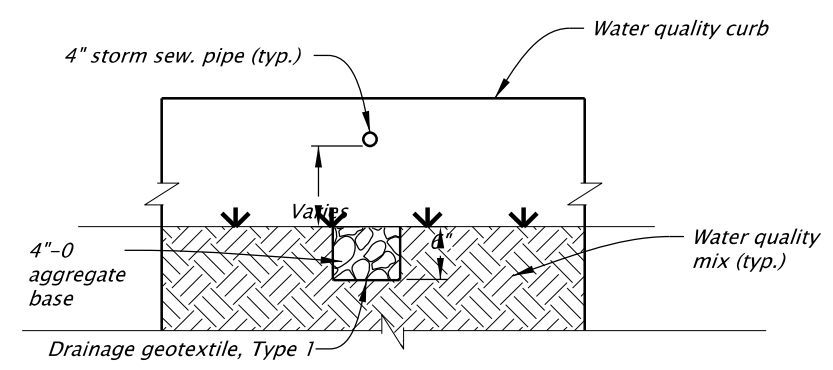

SECTION VIEW

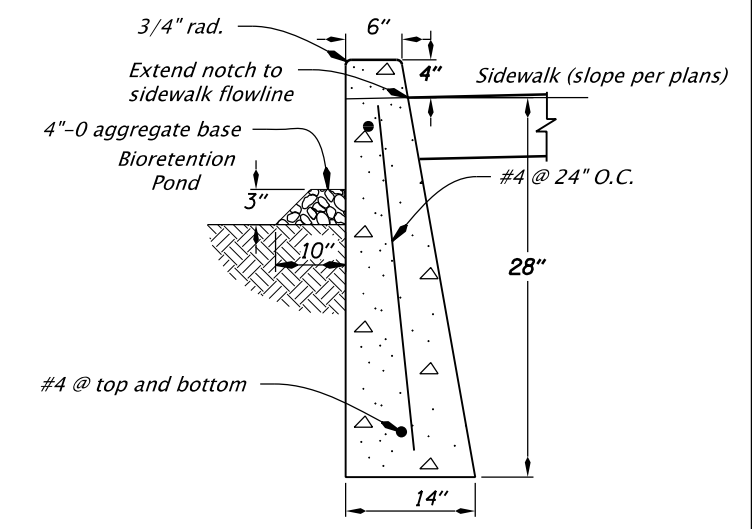

SECTION A-A

NOTES:
1. Provide a 3/4" reveal (dummy joint) on sides and top at 10' O.C. and provide a 1/2" expansion joint at 50' O.C.


MODIFIED WATER QUALITY CURB
No Scale

TABLE		
Riprap Class	L* (ft)	T (ft)
50	4B or 1.3	2.3
100	4B or 1.6	3.3


*L is the greater of 4B or the listed dimension.

NOTES:
1. Do not excavate non-erodible rock in order to place riprap.
2. Riprap backing under class 50 riprap shall be riprap geotextile, Type 1.

STORM OUTFALL PROTECTION
No Scale

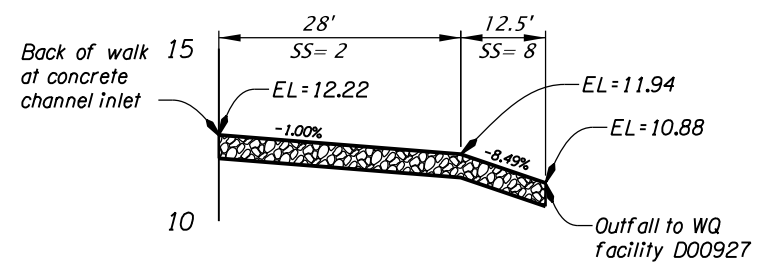


PROFILE

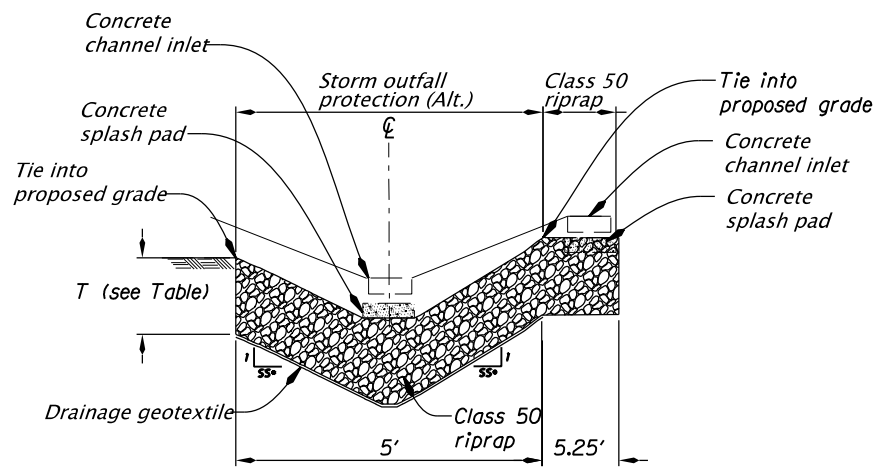

SECTION X-X

STORM OUTFALL PROTECTION ALTERNATIVE
No Scale

	Otak Inc. Hanmi Global Partner 700 Washington St, Ste. 401 Vancouver, WA 98660 Phone: 360.373.9613 Fax: 360.737.9651
US101 @ OR6 (TILLAMOOK) SEC. OREGON COAST HWY. & WILSON RIVER HWY. TILLAMOOK COUNTY	
Reviewed By - T Kraft Designed By - A Cantion Drafted By - S Reiter	
WATER QUALITY DETAILS	
SHEET NO. GJ-14	

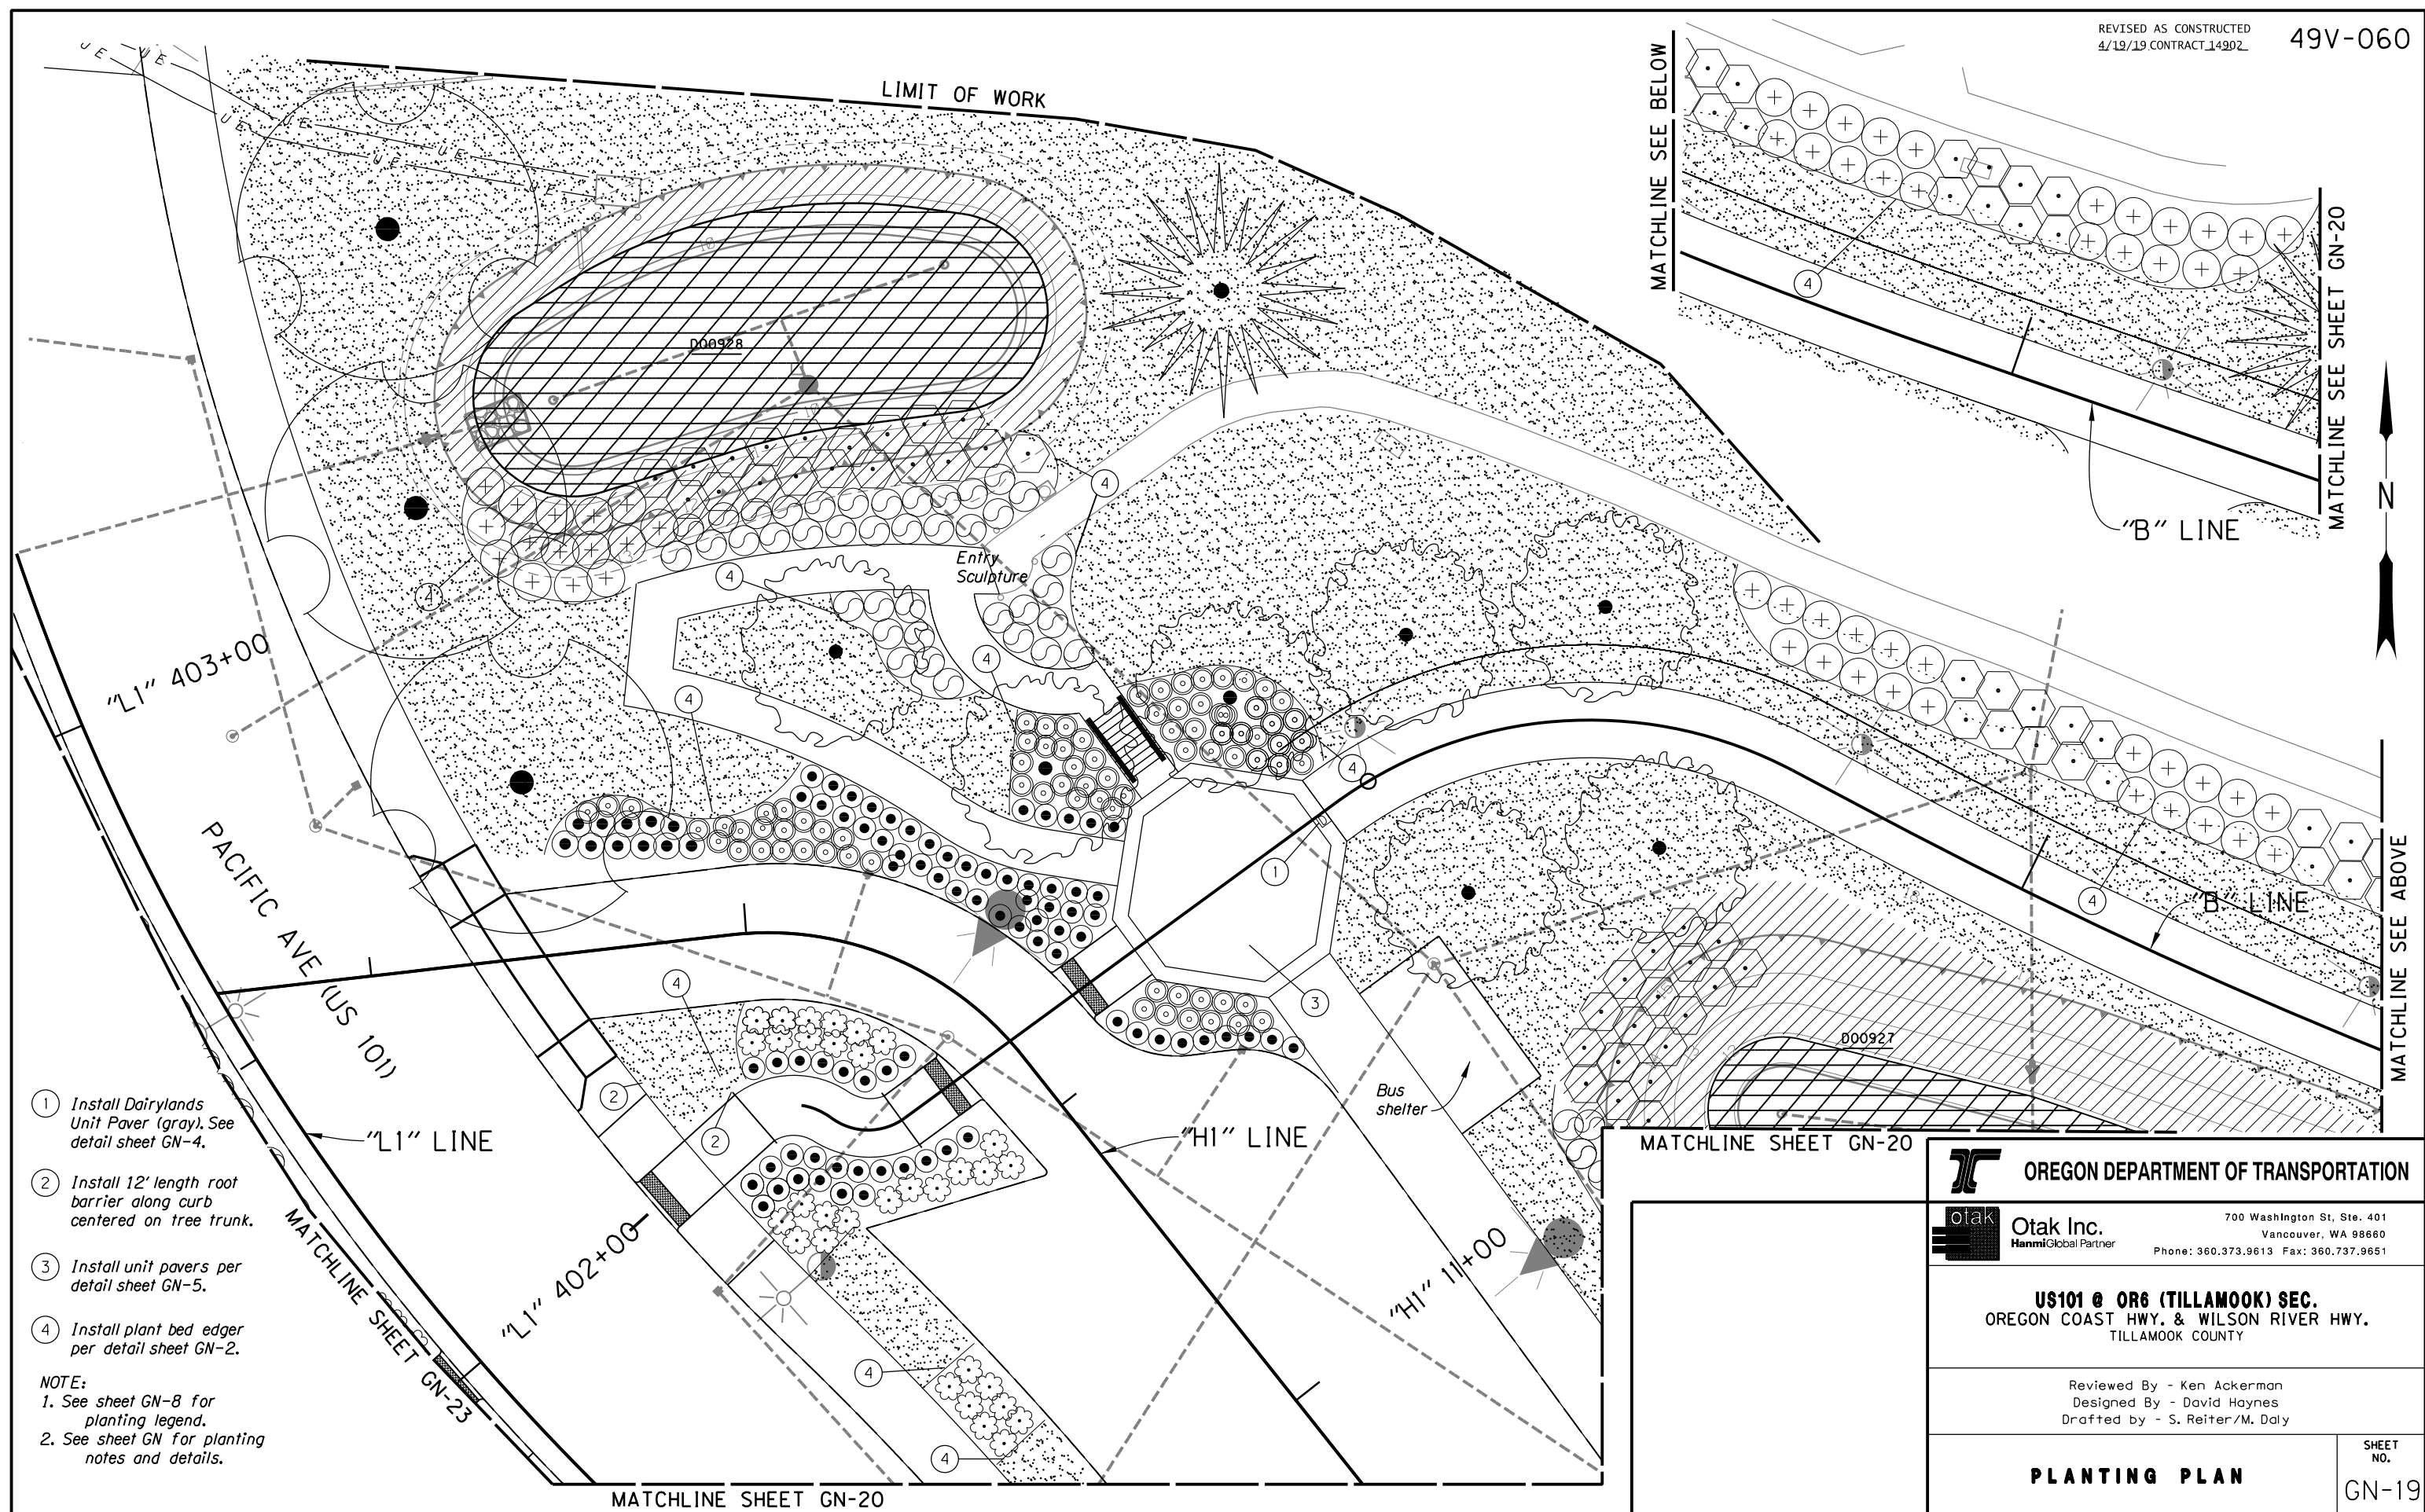

- ① Install Dairylands Unit Paver (gray). See detail sheet GN-4.
- ② Install 12' length root barrier along curb centered on tree trunk.
- ③ Install unit pavers per detail sheet GN-5.
- ④ Install plant bed edger per detail sheet GN-2.

NOTE:
1. See sheet GN-8 for planting legend.
2. See sheet GN for planting notes and details.

OREGON DEPARTMENT OF TRANSPORTATION
 Otak Inc. 700 Washington St, Ste. 401
 Vancouver, WA 98660
 Phone: 360.373.9613 Fax: 360.737.9651

US101 @ OR6 (TILLAMOOK) SEC.
 OREGON COAST HWY. & WILSON RIVER HWY.
 TILLAMOOK COUNTY

Reviewed By - Ken Ackerman
 Designed By - David Haynes
 Drafted by - S. Reiter/M. Daly

PLANTING PLAN SHEET NO. GN-19