

OPERATION & MAINTENANCE MANUAL

Water Quality Biofiltration Swale

Manual prepared: August 2019

DFI No. **D00930**



Figure 1: DFI No. D00930, looking North

Identification

Drainage Facility ID (DFI): D00930
Facility Type: Water Quality Biofiltration Swale
Construction Drawings: (V-File Numbers) 49V-060
Location: District: 1
Highway No.: 009
Mile Post: 65.64 to 65.67, Left

1. Manual Purpose

The purpose of this manual is to outline inspection needs and summarize maintenance actions.

2. Facility Location

The location map below details the facility location. The highway, mile posts, side streets, access location, and stormwater flow directions are noted on the map.

Facility location type: Roadway shoulder

Flow direction: West




Figure 2: Facility location map

3. Facility Summary

The length and width of a swale is based on the bottom dimensions.

The bottom length and bottom width of the swale is:


Bottom Length (feet)	Bottom Width (feet)
272	4

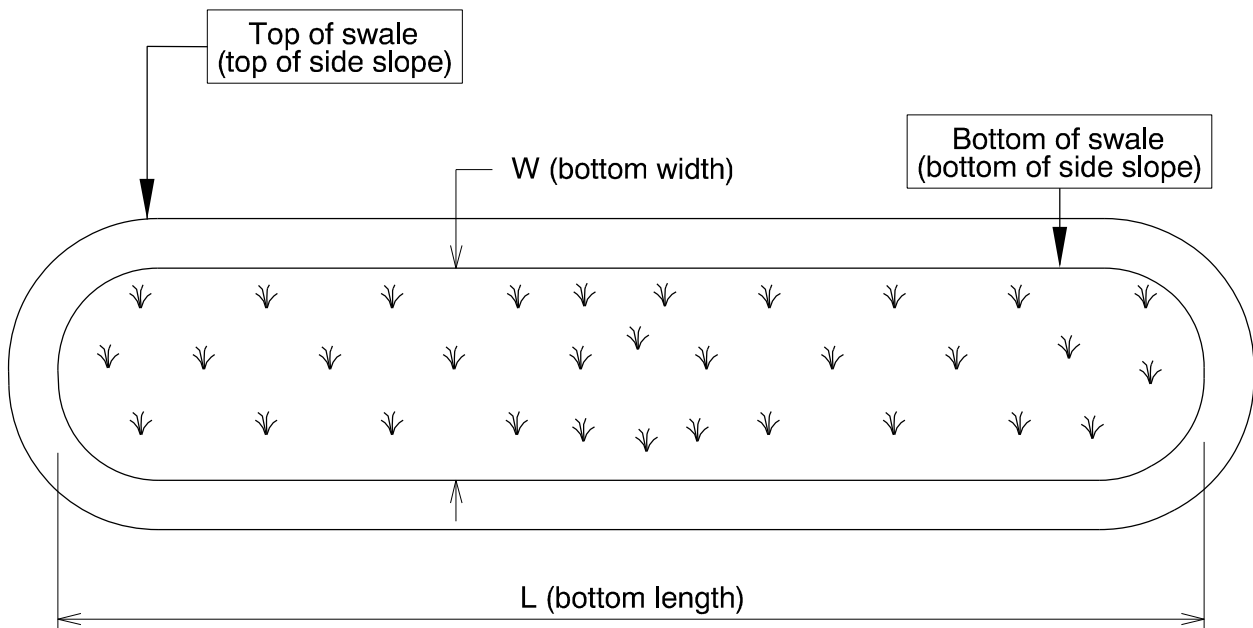

The depth of the swale is the vertical distance measured from the bottom of the swale to the top. The slope of the swale sides is presented by a vertical distance (rise) followed by the horizontal distance (run).

Depth and side slopes:

Depth (feet)	Rise (feet)	Run (feet)
7	1	4

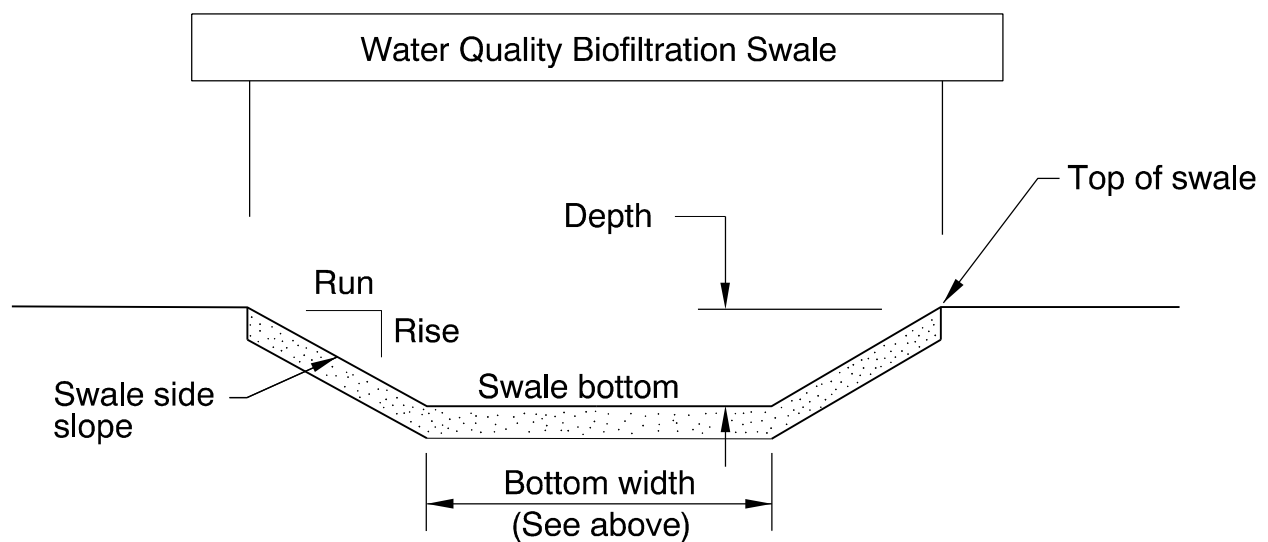

Site Specific Information:

The facility is operated as an on-line swale with piped inlets and outlets. The swale contains multiple 12-inch PVC pipes placed at the riprap pad locations to connect the existing inlets, flow spreader boards distributed along the facility and impermeable liner lines the bottom and walls of the planter box. Water enters the facility from the south and exits on the east end of the swale before entering the storm drain system again.

The stormwater then flows to the facility from the storm drain system through a manhole and then into a 12- inch diameter of a PVC storm drain pipe. After the water enters the swale, it flows into a riprap pad through a perforated pipe. The treated stormwater is collected through a catch basin and exits the swale through a storm drain pipe which directs the water into the existing stormwater conveyance system.

4. Facility Access

Maintenance access to the facility:

<input type="checkbox"/> Roadside pad	<input checked="" type="checkbox"/> Roadside shoulder
<input type="checkbox"/> Access road with Gate	<input type="checkbox"/> Access road without Gate



Figure 3: D00930, Looking Southeast

5. Operational Components / Maintenance Items

Classification

This facility is classified as an:

<input checked="" type="checkbox"/> On-line Swale	<input type="checkbox"/> Off-line Swale
A swale that does not include a high flow bypass component; flow drains into and through the facility	A swale that treats low/small flows and diverts high flows using a bypass component

Bypass Component

This facility includes a high flow bypass component:

<input checked="" type="checkbox"/> No	<input type="checkbox"/> Yes
There is no bypass component. High flows drain into and through the facility	There is a bypass component. Only low/small flows drain into the swale. High flows are diverted around the swale using a bypass component

Operational Components

A swale has many components that assist with treatment, conveyance, and reducing flow velocity to minimize erosion. The components in use can vary depending if the facility was designed to operate on-line or off-line. The facility components table (**Table 1**) has been provided to highlight the applicable components for this facility. The component is in use when the box contains an “x” (e.g.).

The Standard Operation Manual for Water Quality Biofiltration Swales (implemented March 2017) outlines facility operation, typical footprint configuration, and component definitions and details. A link to the manual is attached to the feature marker in TransGIS.

<https://gis.odot.state.or.us/TransGIS/>

Operational Plan

The applicable standard operational plan for this facility is:

<input type="checkbox"/> Operational Plan A	<input checked="" type="checkbox"/> Operational Plan B	<input type="checkbox"/> Operational Plan C
An on-line swale with roadside ditches	An on-line swale with piped inlets and outlets	An off-line swale with a piped high flow bypass
A standard operational plan illustrates the general facility footprint configuration and explains the purpose of each facility component. Operational plans (A, B, C) are provided in the Standard Operation Manual.		

See Appendix A for the site specific operational plan.

Maintenance Items

Operational components marked in **Table 1** should be inspected and maintained according to Section 7. Each facility component is defined and detailed in the Standard Operation Manual using the associated ID number indicated below.

Table 1: Swale Components		ID #
Manholes/Structures		
Pre-treatment manhole	<input type="checkbox"/>	S1
Weir type flow splitter/flow splitter manhole	<input checked="" type="checkbox"/>	S2
Orifice type flow splitter/flow splitter manhole	<input type="checkbox"/>	S3
Standard manhole	<input type="checkbox"/>	S4
Swale Inlet		
Pavement sheet flow	<input checked="" type="checkbox"/>	S5
Inlet Pipe (s)	<input checked="" type="checkbox"/>	S6
Open channel inlet	<input type="checkbox"/>	S7
Riprap pad	<input checked="" type="checkbox"/>	S8
Ground Cover		
Grass bottom	<input checked="" type="checkbox"/>	S9
Grass side slopes	<input checked="" type="checkbox"/>	S10
Granular drain rock	<input checked="" type="checkbox"/>	S11
Plantings	<input checked="" type="checkbox"/>	S12
Underground Components		
Geotextile fabric	<input checked="" type="checkbox"/>	S13
Water quality mix	<input checked="" type="checkbox"/>	S14
Perforated pipe	<input checked="" type="checkbox"/>	S15
Porous pavers (access grid)	<input checked="" type="checkbox"/>	S16
Flow Spreader		
Rock basin (used at inlet)	<input type="checkbox"/>	S17
Anchored board (midpoint of swale or every 50 feet along swale bottom)	<input checked="" type="checkbox"/>	S18
Other: describe type	<input type="checkbox"/>	S19
Swale Outlet		
Catch basin with grate	<input checked="" type="checkbox"/>	S20
Outlet Pipe (s)	<input checked="" type="checkbox"/>	S21
Open channel outlet	<input type="checkbox"/>	S22
Auxiliary Outlet: describe type	<input type="checkbox"/>	S23
Outfall Type		
Waterbody (Creek/Lake/Ocean)	<input type="checkbox"/> C	S24
	<input type="checkbox"/> L	
	<input type="checkbox"/> O	
Ditch	<input type="checkbox"/>	S25
Storm drain system	<input type="checkbox"/>	S26
Outfall Components		
Riprap pad	<input type="checkbox"/>	S27
Riprap bank protection	<input type="checkbox"/>	S28

6. Maintenance

Maintenance Frequency/Maintain Records

- a. Inspect annually. Preferably prior to the rainy season.
- b. Clean and maintain as necessary. Refer to Activity 125 for conditions when maintenance is needed.
- c. Keep a record of inspections, maintenance, and repairs.

Maintenance Guide/Maintenance Actions

The ODOT Routine Road Maintenance Water Quality and Habitat Guide (the *Blue Book*) outlines the standard maintenance actions for water quality facilities under Activity 125.

There are standard maintenance tables for standard ODOT designs. The maintenance tables describe the maintenance component, the defect or problem, the condition when maintenance is needed, and the recommended maintenance to correct the problem. Use the following tables to maintain ODOT swales:

- Table 1 (General Maintenance): Contains general maintenance and inspection guidelines that are applicable to all ODOT water quality facilities
- Table 3 (Maintenance of Water Quality or Biofiltration Swales): Contains maintenance information for swales

The *Blue Book* can be viewed at the following website:

http://www.oregon.gov/ODOT/Maintenance/Documents/blue_book.pdf

7. Limitations

Access grid installed:

<input type="checkbox"/> No	<input checked="" type="checkbox"/> Yes
There are porous pavers installed in this swale	

Swales are designed to allow equipment access along the bottom. If an access grid is **NOT** installed, vehicles entering the swale can create depressions (tire ruts), damage vegetation, and damage structural components (e.g. flow spreaders). These conditions may result in poor treatment and drainage performance.

Equipment wheels should be kept on the tops and side slopes. Mower arms may be run along the swale bottom.

8. Waste Material Handling

Material removed from the facility is defined as waste by the Department of Environmental Quality (DEQ). Refer to the roadwaste section of the ODOT Maintenance Yard Environmental Management System (EMS) Policy and Procedures Manual for disposal options:

http://www.oregon.gov/ODOT/Maintenance/Documents/ems_manual.pdf


Contact any of the following for more detailed information about management of waste materials found on site:

ODOT Clean Water Unit	(503) 986-3008
ODOT Statewide Hazmat Coordinator	(503) 667-7442
ODOT Region 1 Hazmat Coordinator	(503) 731-8290
ODOT Region 2 Hazmat Coordinator	(503) 986-2647
ODOT Region 3 Hazmat Coordinator	(541) 957-3594
ODOT Region 4 Hazmat Coordinator	(541) 388-6186
ODOT Region 5 Hazmat Coordinator	(541) 963-1590
ODEQ Northwest Region Office	(503) 229-5263

A Appendix A – Site Specific Operational Plan



Contents:

Operational Plan: DFI D00930

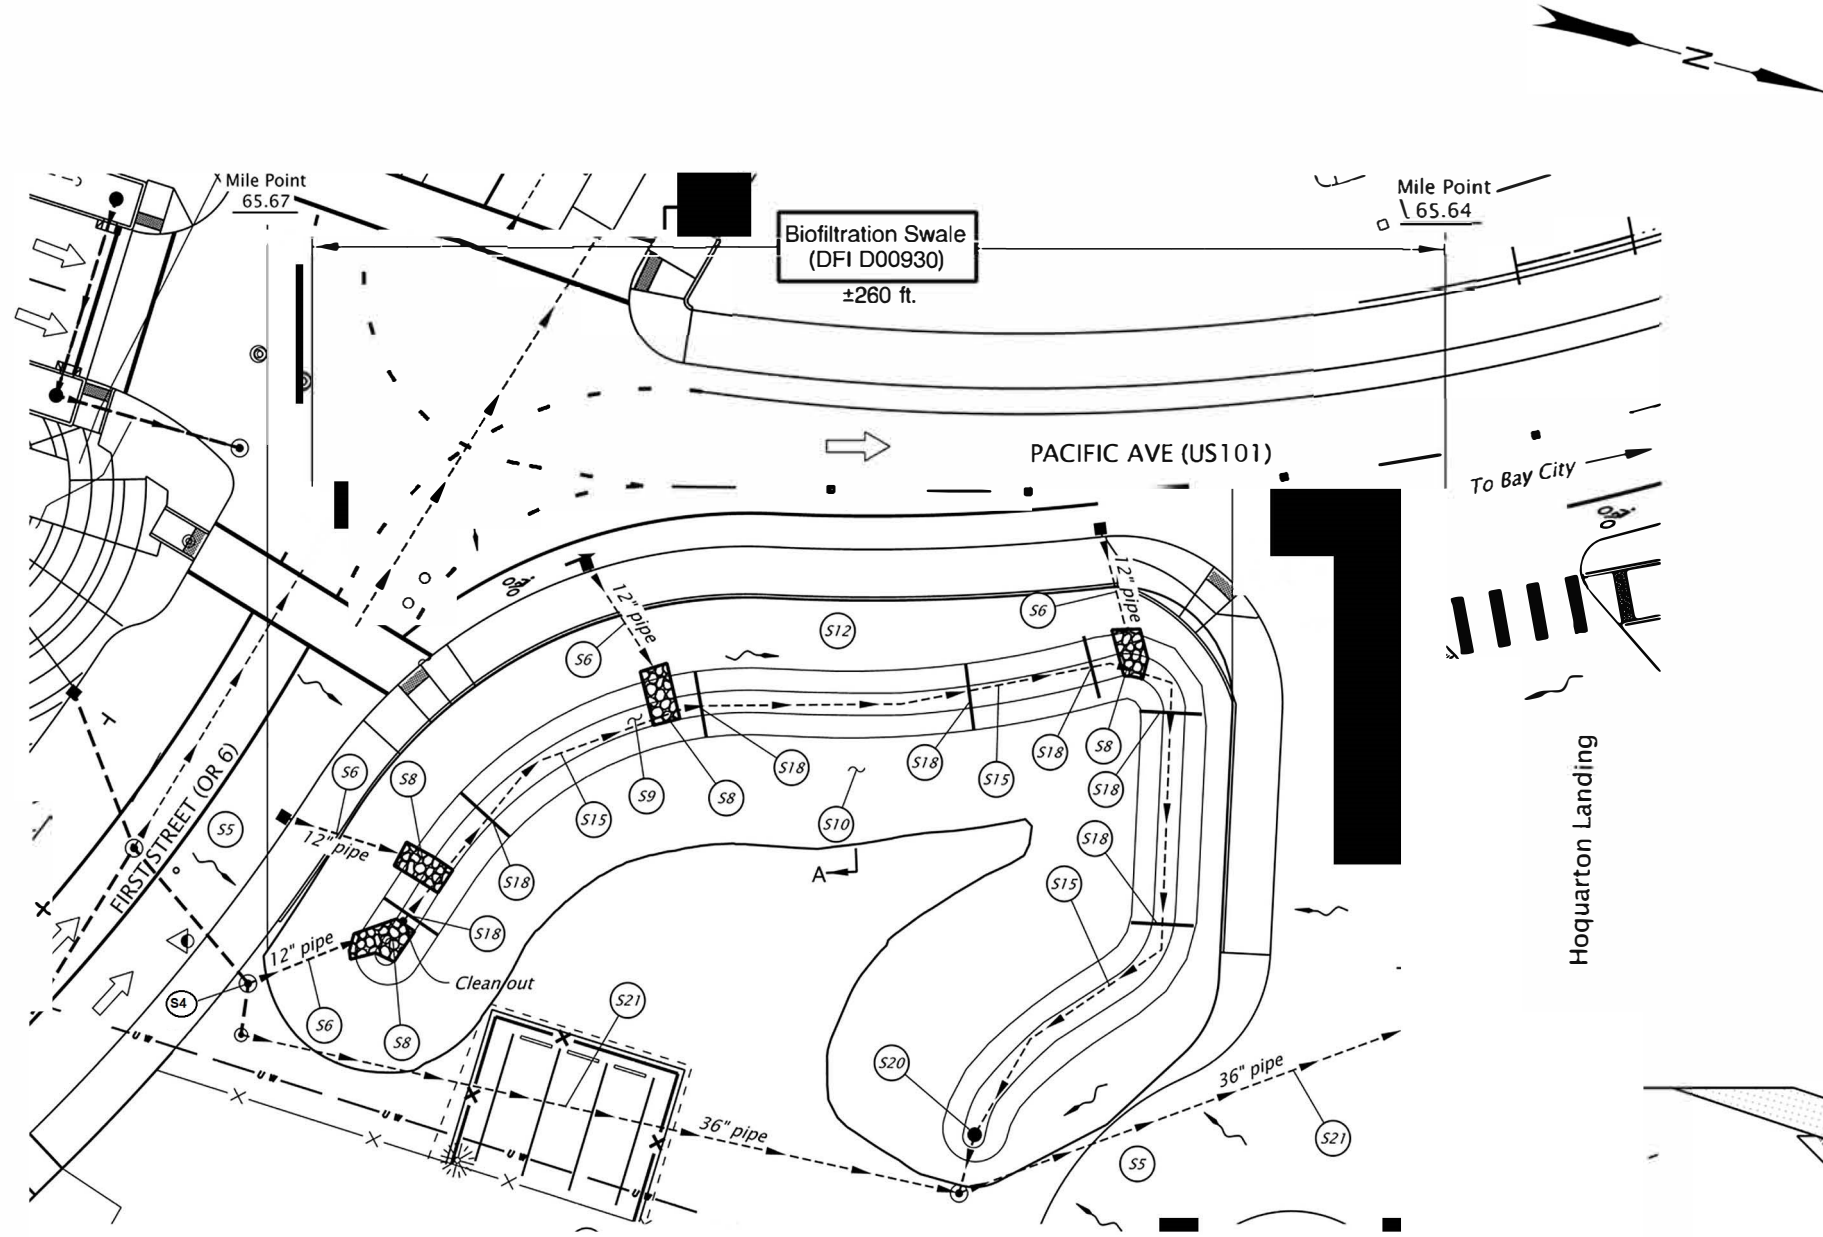

PLAN
N.T.S.

- LEGEND:**
- Photo Location / Direction
 - Facility Component (see table 1 in O&M Manual)
 - Manhole
 - Bioretention Point Outlet
 - Storm Pipe (Facility)
 - Storm Pipe (Facility)
 - Conveyance Direction
 - Pavement/Facility Flow Path
 - Traffic Flow Direction

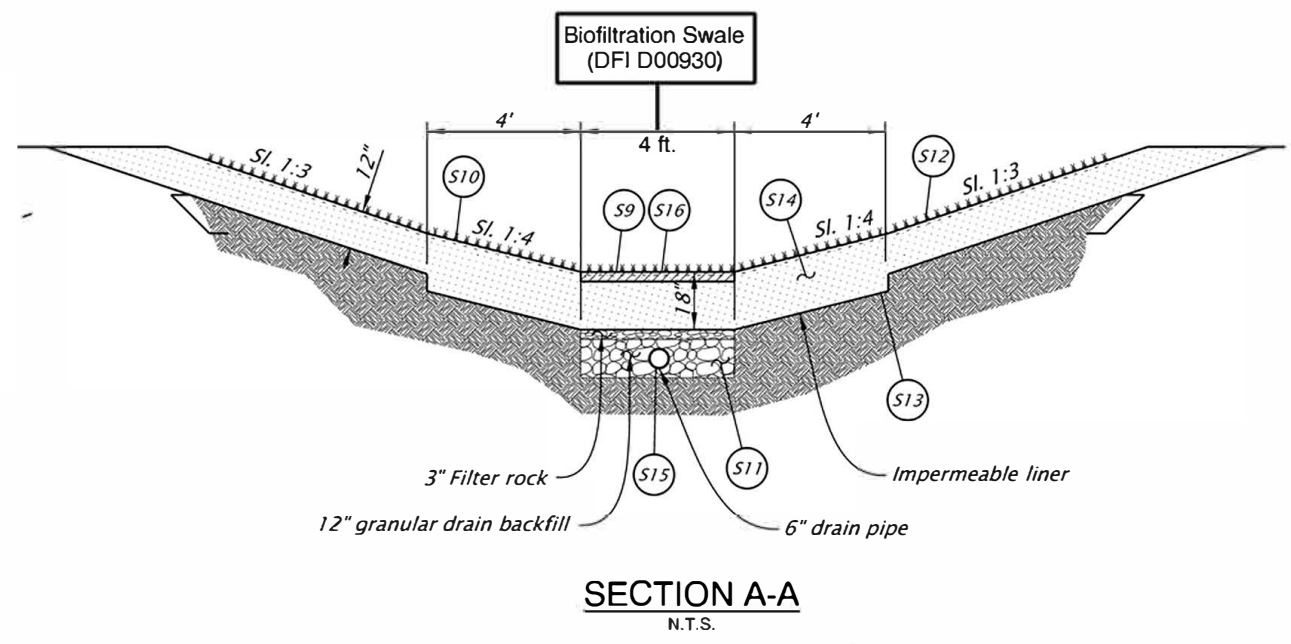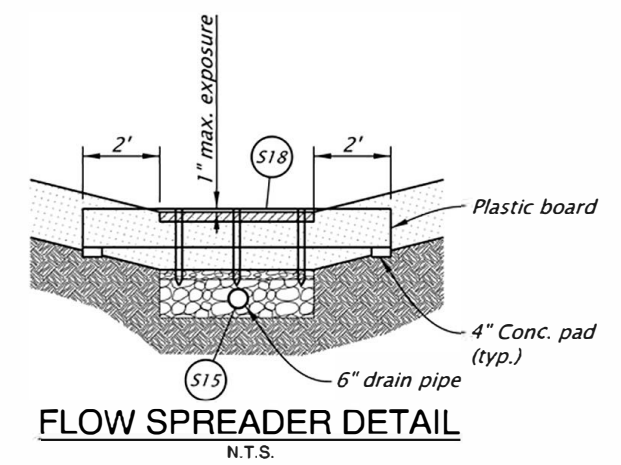

Prepared By:
Chris Carman

Drafted By:
Michael Skelton

DFI D00930
MAINTENANCE DISTRICT 1 HWY 009
BIOFILTRATION SWALE
OREGON COAST HWY MP 65.64 - 65.67
TILLAMOOK COUNTY

A Appendix A – Site Specific Operational Plan

Contents:


Operational Plan: DFI D00930

INDEX OF SHEETS	
SHEET NO.	DESCRIPTION
1	Title Sheet
1A, 1A-2	Index Of Sheets Cont.
1A-3	Std. Drg. Nos.
1A-5	Index of Sheets Cont.
1B	Plan Sheet Layout

STATE OF OREGON
 DEPARTMENT OF TRANSPORTATION
 PLANS FOR PROPOSED PROJECT
**GRADING, DRAINAGE, STRUCTURES, PAVING, SIGNING, ILLUMINATION,
 SIGNALS, & ROADSIDE DEVELOPMENT**

US101 @ OR6 (TILLAMOOK) SEC.
OREGON COAST HWY. & WILSON RIVER HWY.
 TILLAMOOK COUNTY
 MAY 2016

REVISED AS CONSTRUCTED
 4/19/19 CONTRACT C14902
 PROJ. MGR. Ian Machan

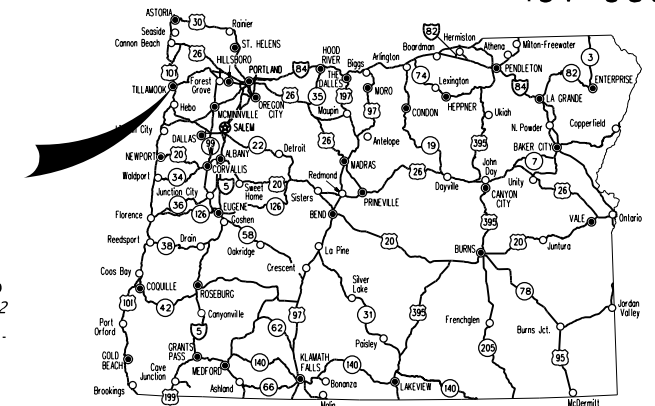


Overall Length Of Project - 0.4 Miles

ATTENTION:
 Oregon Law Requires You To Follow Rules
 Adopted By The Oregon Utility Notification
 Center. Those Rules Are Set Forth In
 OAR 952-001-0010 Through OAR 952-001-0090.
 You May Obtain Copies Of The Rules By Calling
 The Center. (Note: The Telephone Number For
 The Oregon Utility Center Is (503) 232-1987.)



END OF PROJECT
JTA-S009(473)
STA. "WR" 17+62.63 (M.P. 9.07)

BEGINNING OF PROJECT
JTA-S009(473)
STA. "M" 191+93.00 (M.P. 65.78)

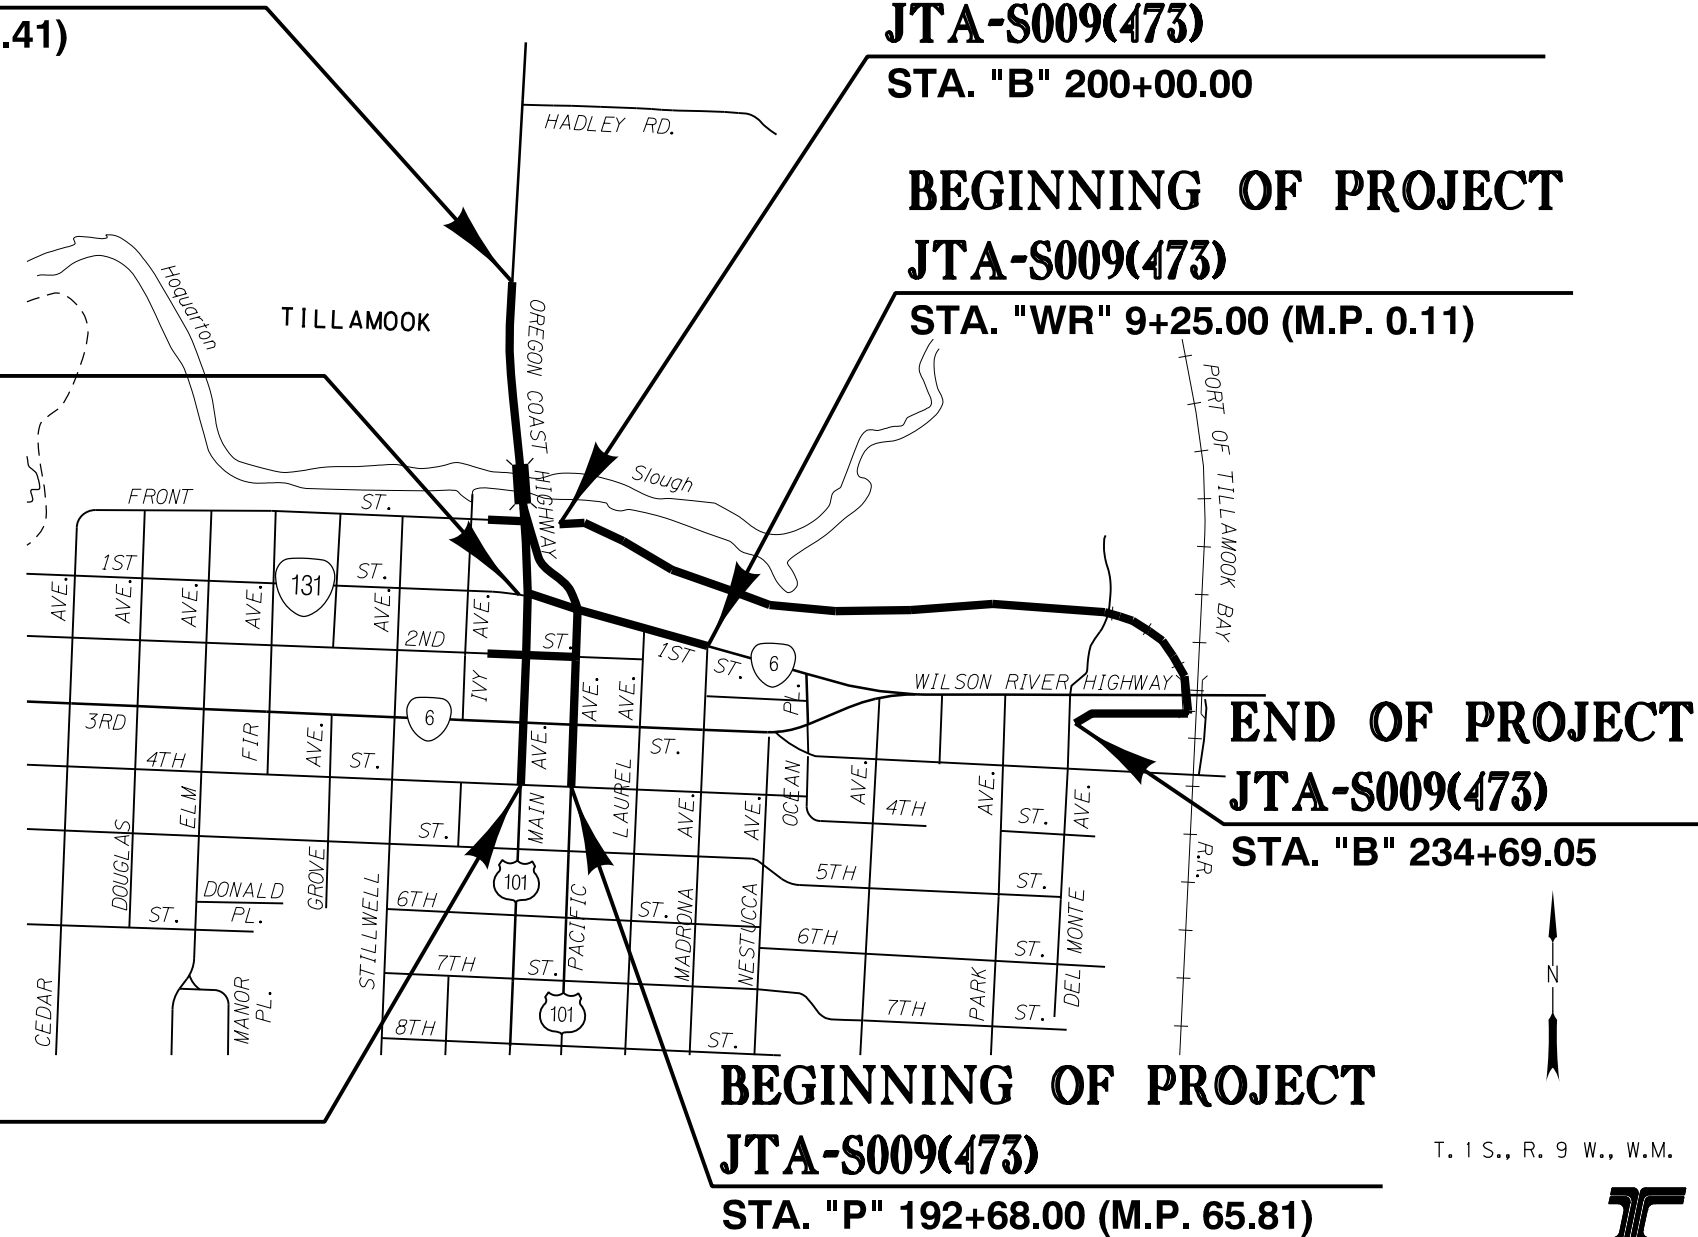

BEGINNING OF PROJECT
JTA-S009(473)
STA. "B" 200+00.00

BEGINNING OF PROJECT
JTA-S009(473)
STA. "WR" 9+25.00 (M.P. 0.11)

END OF PROJECT
JTA-S009(473)
STA. "B" 234+69.05

BEGINNING OF PROJECT
JTA-S009(473)
STA. "P" 192+68.00 (M.P. 65.81)

T. I.S., R. 9 W., W.M.



OREGON TRANSPORTATION COMMISSION

Tammy Baney	CHAIR
David Lohman	COMMISSIONER
Susan Morgan	COMMISSIONER
Alando Simpson	COMMISSIONER
Sean O'Hallaren	COMMISSIONER
Matthew L. Garrett	DIRECTOR OF TRANSPORTATION

PLANS PREPARED FOR
 OREGON DEPARTMENT OF TRANSPORTATION




These plans were developed using ODOT design standards. Exceptions to these standards, if any, have been submitted and approved by the ODOT Chief Engineer or their delegated authority.

Approving Authority: _____
 Signature & date
 Jeff W. Olson, Principal
 Print name and title

 Concurrence by ODOT Chief Engineer

US101 @ OR6 (TILLAMOOK) SEC.
 OREGON COAST HWY. & WILSON RIVER HWY.
 TILLAMOOK COUNTY

FEDERAL HIGHWAY ADMINISTRATION	PROJECT NUMBER	SHEET NO.
OREGON DIVISION	JTA-S009(473)	1

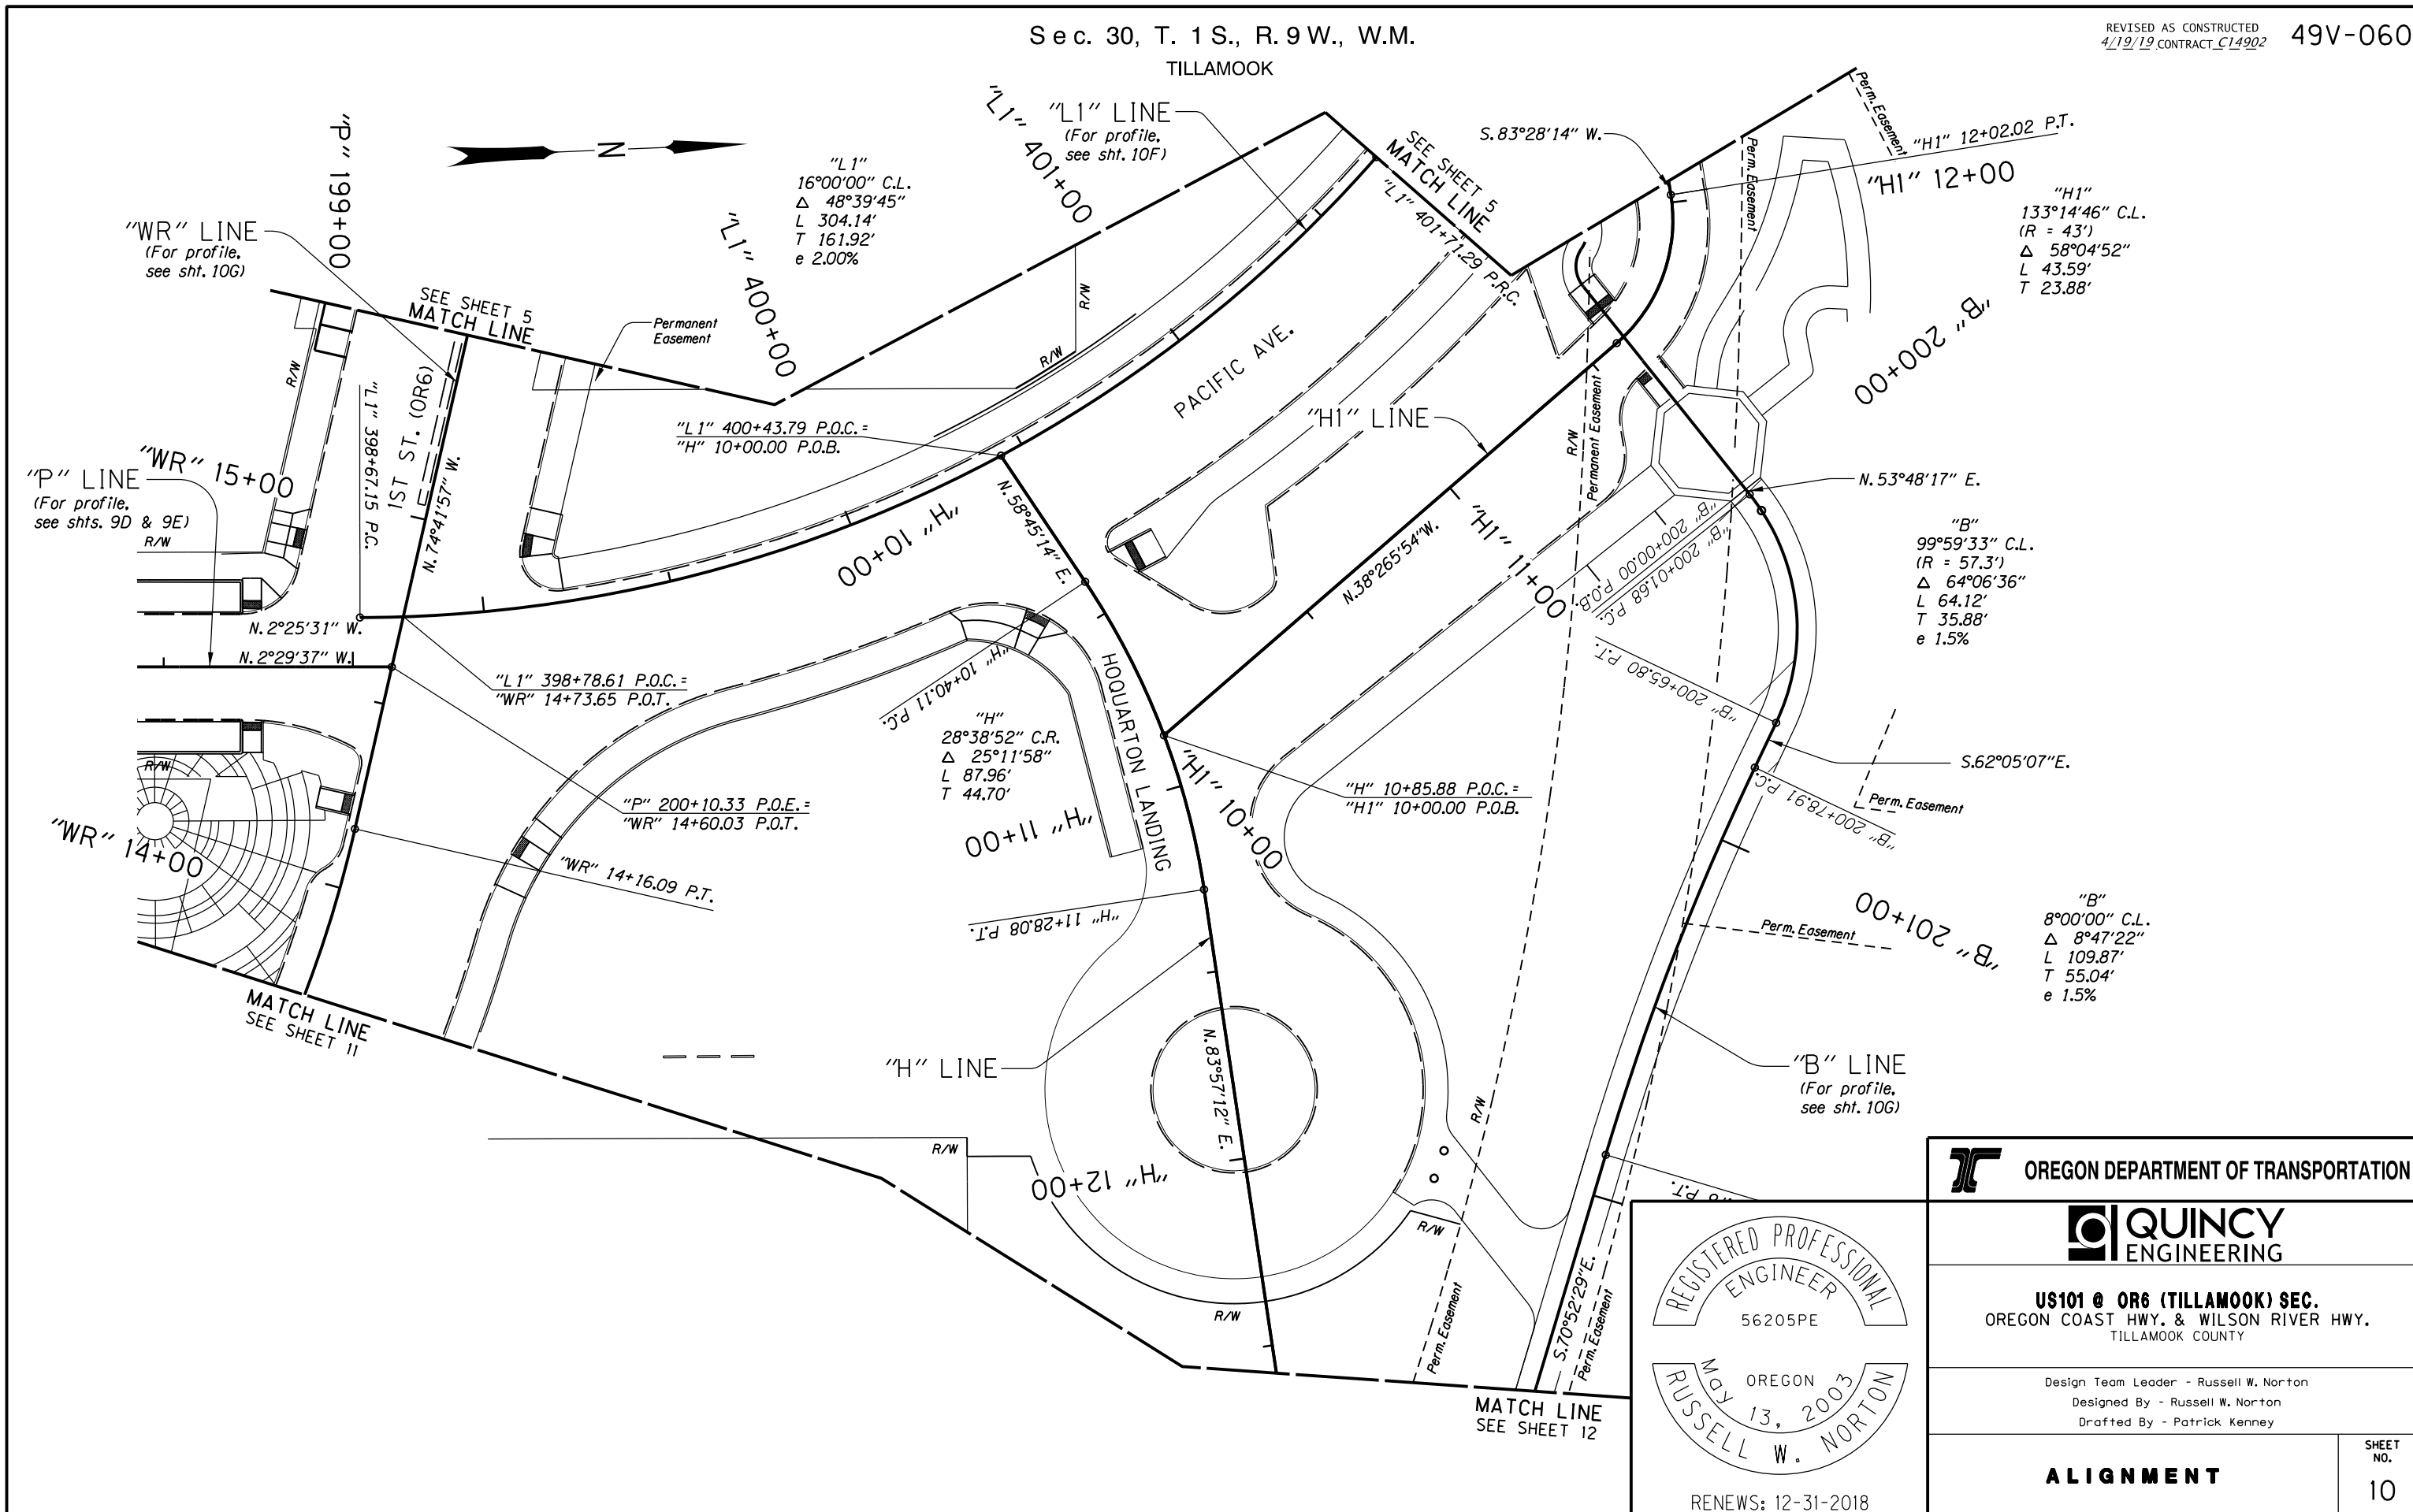


OREGON DEPARTMENT OF TRANSPORTATION	
QUINCY ENGINEERING	
US101 @ OR6 (TILLAMOOK) SEC. OREGON COAST HWY. & WILSON RIVER HWY. TILLAMOOK COUNTY	
Design Team Leader - Russell W. Norton Designed By - Russell W. Norton Drafted By - Patrick Kenney	
ALIGNMENT	SHEET NO. 10

Sec. 30, T. 1 S., R. 9 W., W.M.

TILLAMOOK

REVISED AS CONSTRUCTED
4/19/19 CONTRACT C14902

49V-060

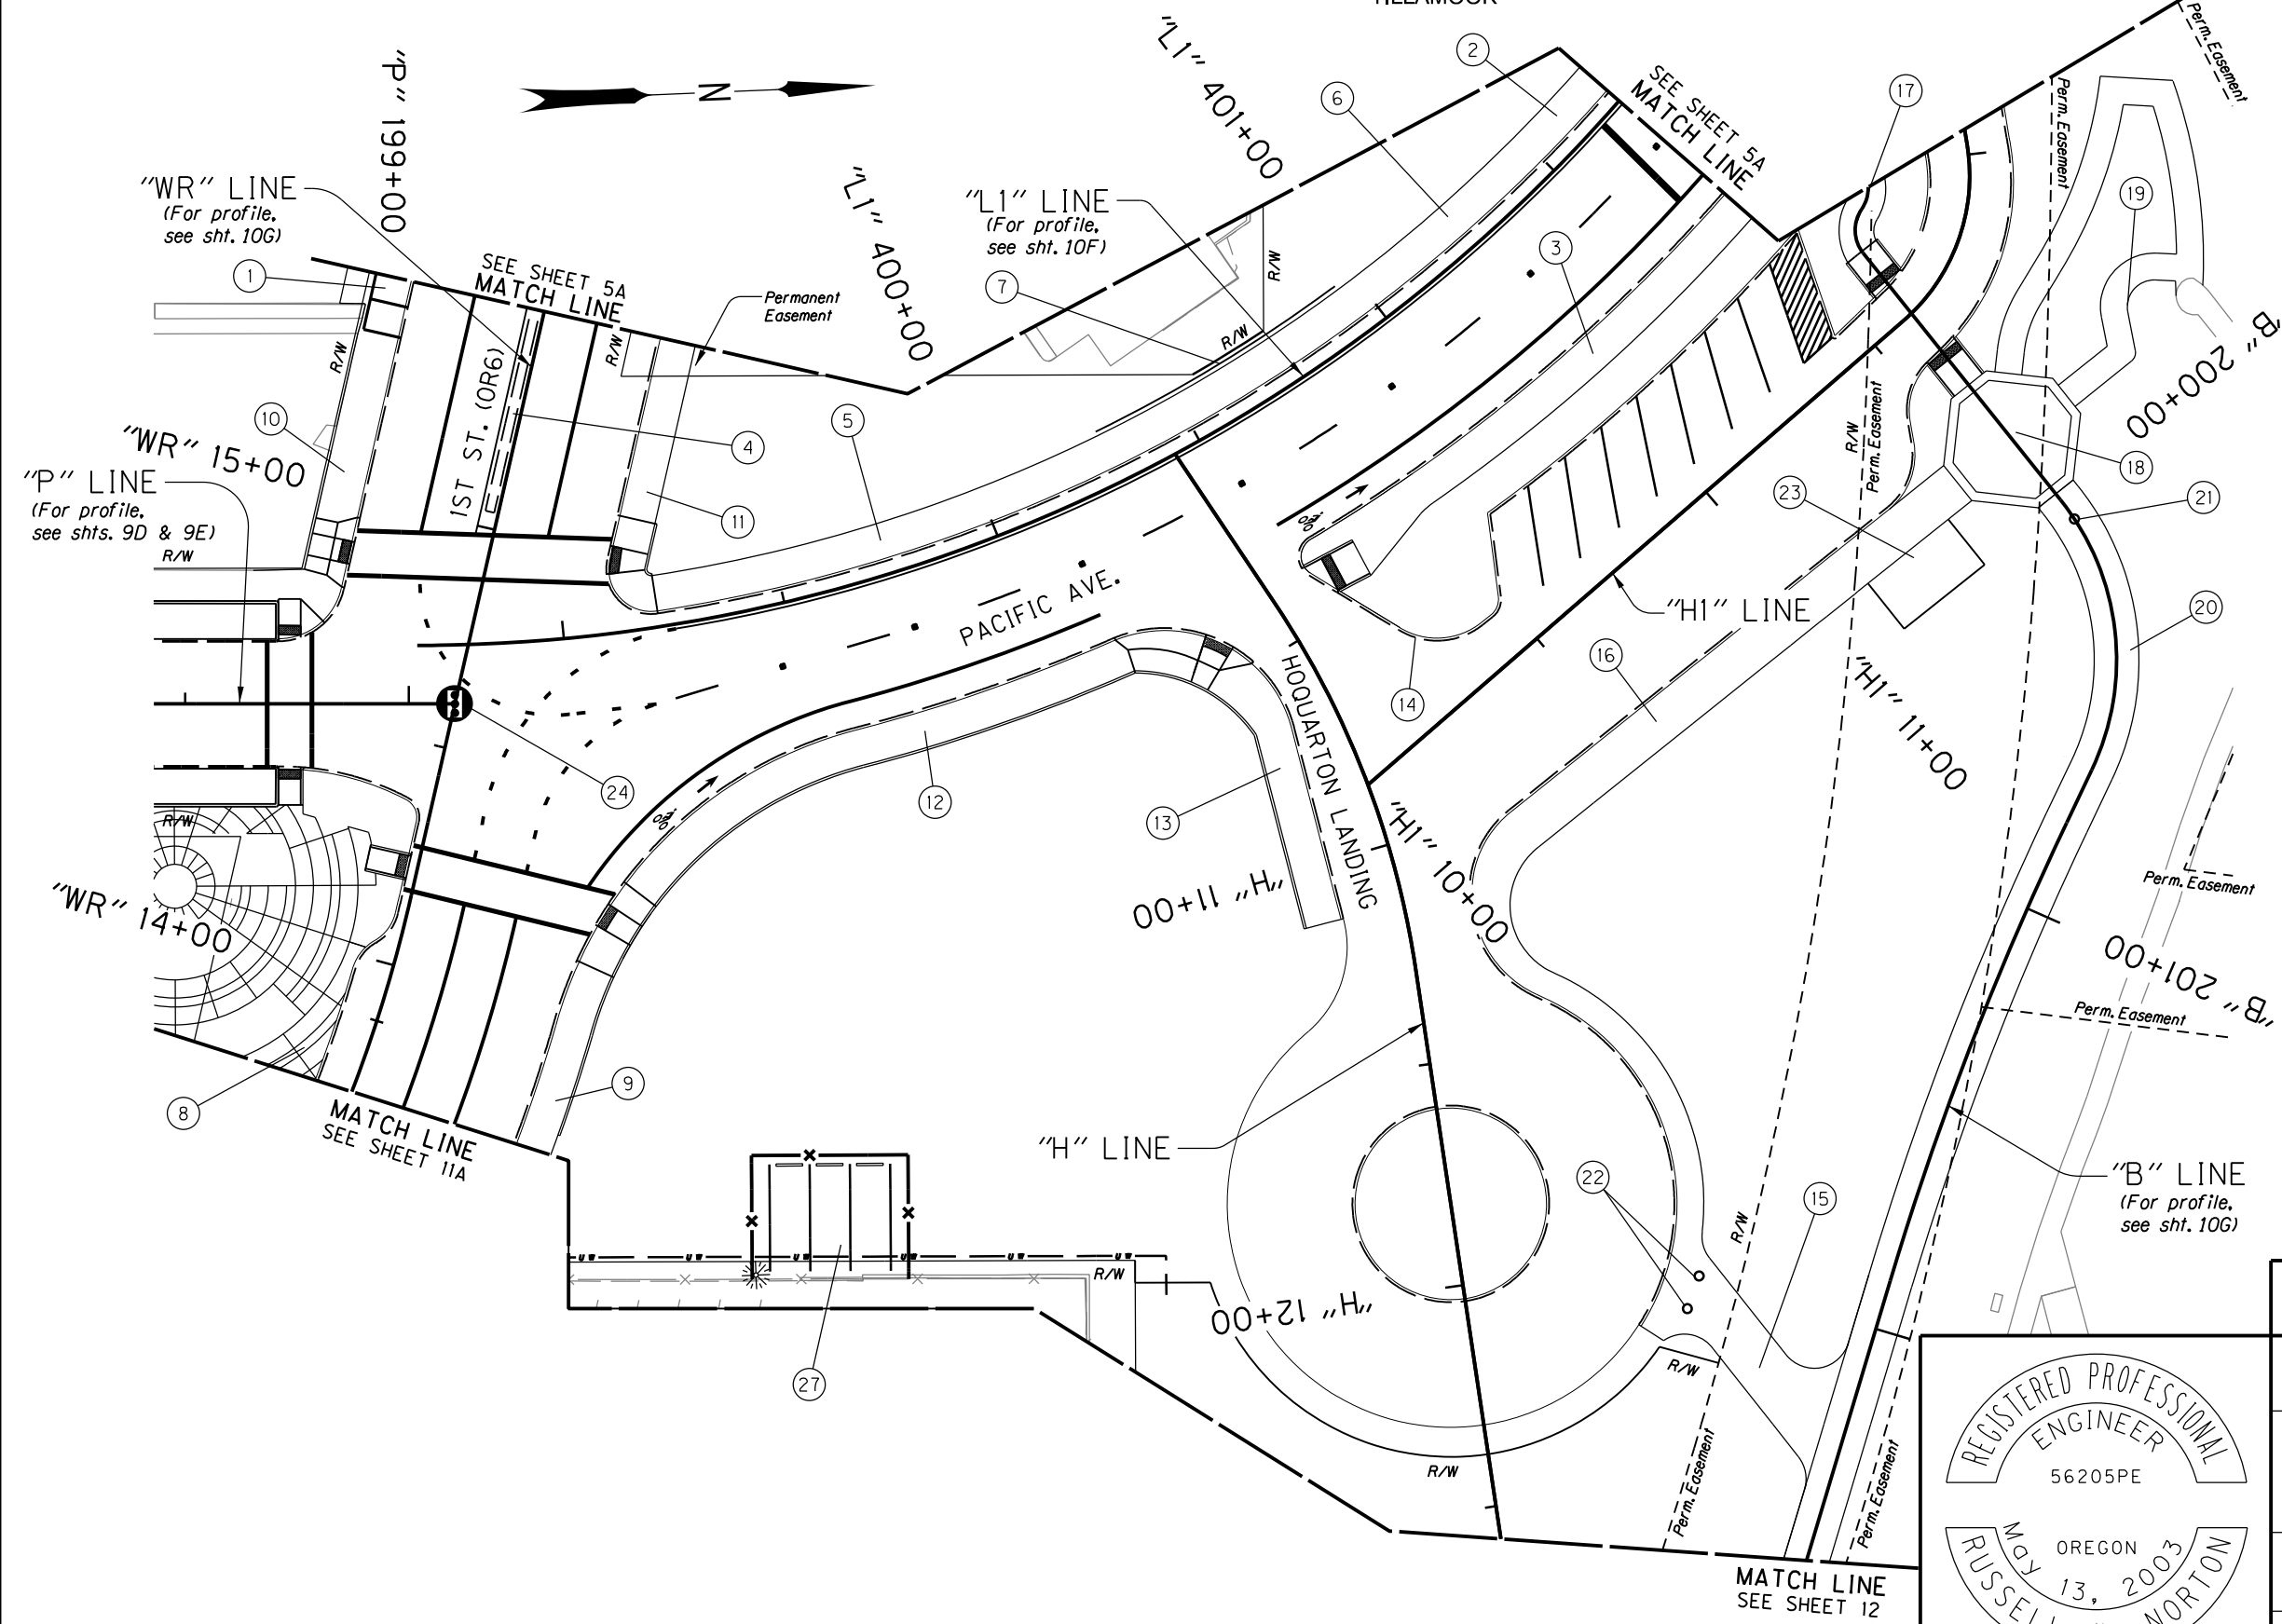

REGISTERED PROFESSIONAL
ENGINEER
56205PE
MAY 13, 2003
OREGON
RUSSELL W. NORTON
RENEWS: 12-31-2018

OREGON DEPARTMENT OF TRANSPORTATION


QUINCY ENGINEERING

US101 @ OR6 (TILLAMOOK) SEC.
OREGON COAST HWY. & WILSON RIVER HWY.
TILLAMOOK COUNTY


Design Team Leader - Russell W. Norton
Designed By - Russell W. Norton
Drafted By - Patrick Kenney

GENERAL CONSTRUCTION SHEET NO. **10A**

- ① See sht. 5B, note 4
Const. 24" curb and gutter
Const. P.C. conc. dwy., reinf., option (G)
- ② See sht. 5B, note 16
Const. 24" curb and gutter
Const. P.C. conc. walk, 4", square score pattern
- ③ See sht. 5B, note 17
Const. 24" curb and gutter
Const. P.C. conc. walk, 4", square score pattern
Const. sidewalk ramp, parallel
Const. sidewalk ramp, perpendicular
- ④ See sht. 5B, note 30
Const. type "C" traffic separator, 16"
- ⑤ Sta. "L1" 399+21.63 to Sta. "L1" 401+00.00, Lt.
Const. 24" curb and gutter
Const. P.C. conc. walk, 4", square score pattern
1,442 sq. ft.
- ⑥ Sta. "L1" 401+00 to Sta. "L1" 401+50.00, Lt.
Const. 24" mountable curb and gutter
Const. P.C. conc. walk, 4", square score pattern
391 sq. ft.
- ⑦ Structure no. 22462
Sta. "L1" 400+30 to Sta. "L1" 400+95, Lt.
Const. retaining wall A
- ⑧ Sta. "WR" 13+03.87 to Sta. "WR" 14+39.31, Lt.
Const. 24" curb and gutter
Const. P.C. conc. walk, 4", radial score pattern
3,207 sq. ft.
(For details, see GN shts.)
Const. sidewalk ramp, perpendicular (Option A) - 2
- ⑨ Sta. "WR" 13+24.38 to Sta. "WR" 14+29.36, Rt.
Const. std. curb, modified
Const. 24" curb and gutter
Const. P.C. conc. walk, 4" - 918 sq. ft.
Const. sidewalk ramp, combination (Option I)
- ⑩ Sta. "WR" 14+64.93 to Sta. "WR" 15+37.16, Lt.
Const. 24" curb and gutter
Const. P.C. conc. walk, 4", square score pattern
669 sq. ft.
Const. sidewalk ramp, combination (Option I)
Const. sidewalk ramp, per p. (Single flare)
- ⑪ Sta. "WR" 14+89.83 to Sta. "WR" 15+52.68, Rt.
Const. 24" curb and gutter
Const. P.C. conc. walk, 4", square score pattern
512 sq. ft.
Const. sidewalk ramp, diagonal parallel (Option K)
- ⑫ Sta. "L1" 399+07.22 to Sta. "L1" 400+37.50, Rt.
Const. std. curb, modified
Const. 24" curb and gutter
Const. P.C. conc. walk, 4", square score pattern
1,202 sq. ft.
Const. sidewalk ramp, combination (Option I)
- ⑬ Sta. "H" 10+47.89 to Sta. "H" 11+14.00, Rt.
Const. std. curb, modified
Const. P.C. conc. walk, 4" - 485 sq. ft.
- ⑭ Sta. "H1" 10+23.10 to Sta. "H1" 11+56.71, Lt.
Const. 24" curb and gutter
- ⑮ Sta. "H" 12+00.00 to Sta. "H" 12+14.58, Lt.
Const. 24" curb and gutter
Const. 24" mountable curb and gutter - 25'
Const. P.C. conc. walk, 6" - 1,523 sq. ft.
- ⑯ Sta. "H" 12+00.00 to Sta. "H1" 11+55.91, Rt.
Const. 24" curb and gutter
Const. P.C. conc. walk, 4" - 1,241 sq. ft.
- ⑰ Sta. "H1" 11+56.71 to Sta. "H1" 12+21.91, Lt.
Const. 24" curb and gutter
Const. P.C. conc. walk, 4" - 309 sq. ft.
Const. sidewalk ramp, perpendicular
- ⑱ Sta. "H1" 11+43.68 to Sta. "H1" 11+67.97, Rt.
Const. 24" curb and gutter
Const. P.C. conc. walk, 4" - 77 sq. ft.
Const. sidewalk ramp, perpendicular
Const. 4" conc. surfacing - 763 sq. ft.
(For details, see GN shts.)
- ⑲ Sta. "H1" 11+63.70 to Sta. "H1" 12+12.70, Rt.
Const. P.C. conc. walk, 4" - 919 sq. ft.
Const. conc. stairs - 2.3 cu. yd.
(See drg. no. RD120)
- ⑳ Sta. "B" 200+00.00 to Sta. "B" 234+65.69
Const. shared-use path - 10' width
(For details, see sht. 2A-15)
- ㉑ Sta. "B" 200+07.00
Inst. removable bollard no. 1
(For details, see GN shts.)
- ㉒ Sta. "H" 12+05.80 to Sta. "H" 12+12.64, Lt.
Inst. removable bollard no. 1 - 2
(For details, see GN shts.)
- ㉓ Sta. "H1" 11+14.00 to Sta. "H1" 11+37.00, Rt.
Const. conc. bus shelter pad
(For details, see sht. 2B-22)
- ㉔ Inst. traffic signal
(For drg. nos, see sht. 1-A)
- ㉕ Const. ACP parking pad - approx. 1,073 sq. ft.
Inst. parking bumpers - 3
Inst. CL-8 chain-link fence
w/ 3 strands barbed wire - 93'±
(See sht. 2B-27 for details)

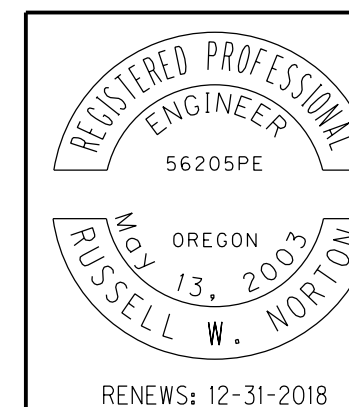

OREGON DEPARTMENT OF TRANSPORTATION	
QUINCY ENGINEERING	
US101 @ OR6 (TILLAMOOK) SEC. OREGON COAST HWY. & WILSON RIVER HWY. TILLAMOOK COUNTY	
Design Team Leader - Russell W. Norton Designed By - Russell W. Norton Drafted By - Patrick Kenney	
CONSTRUCTION NOTES	SHEET NO. 10B

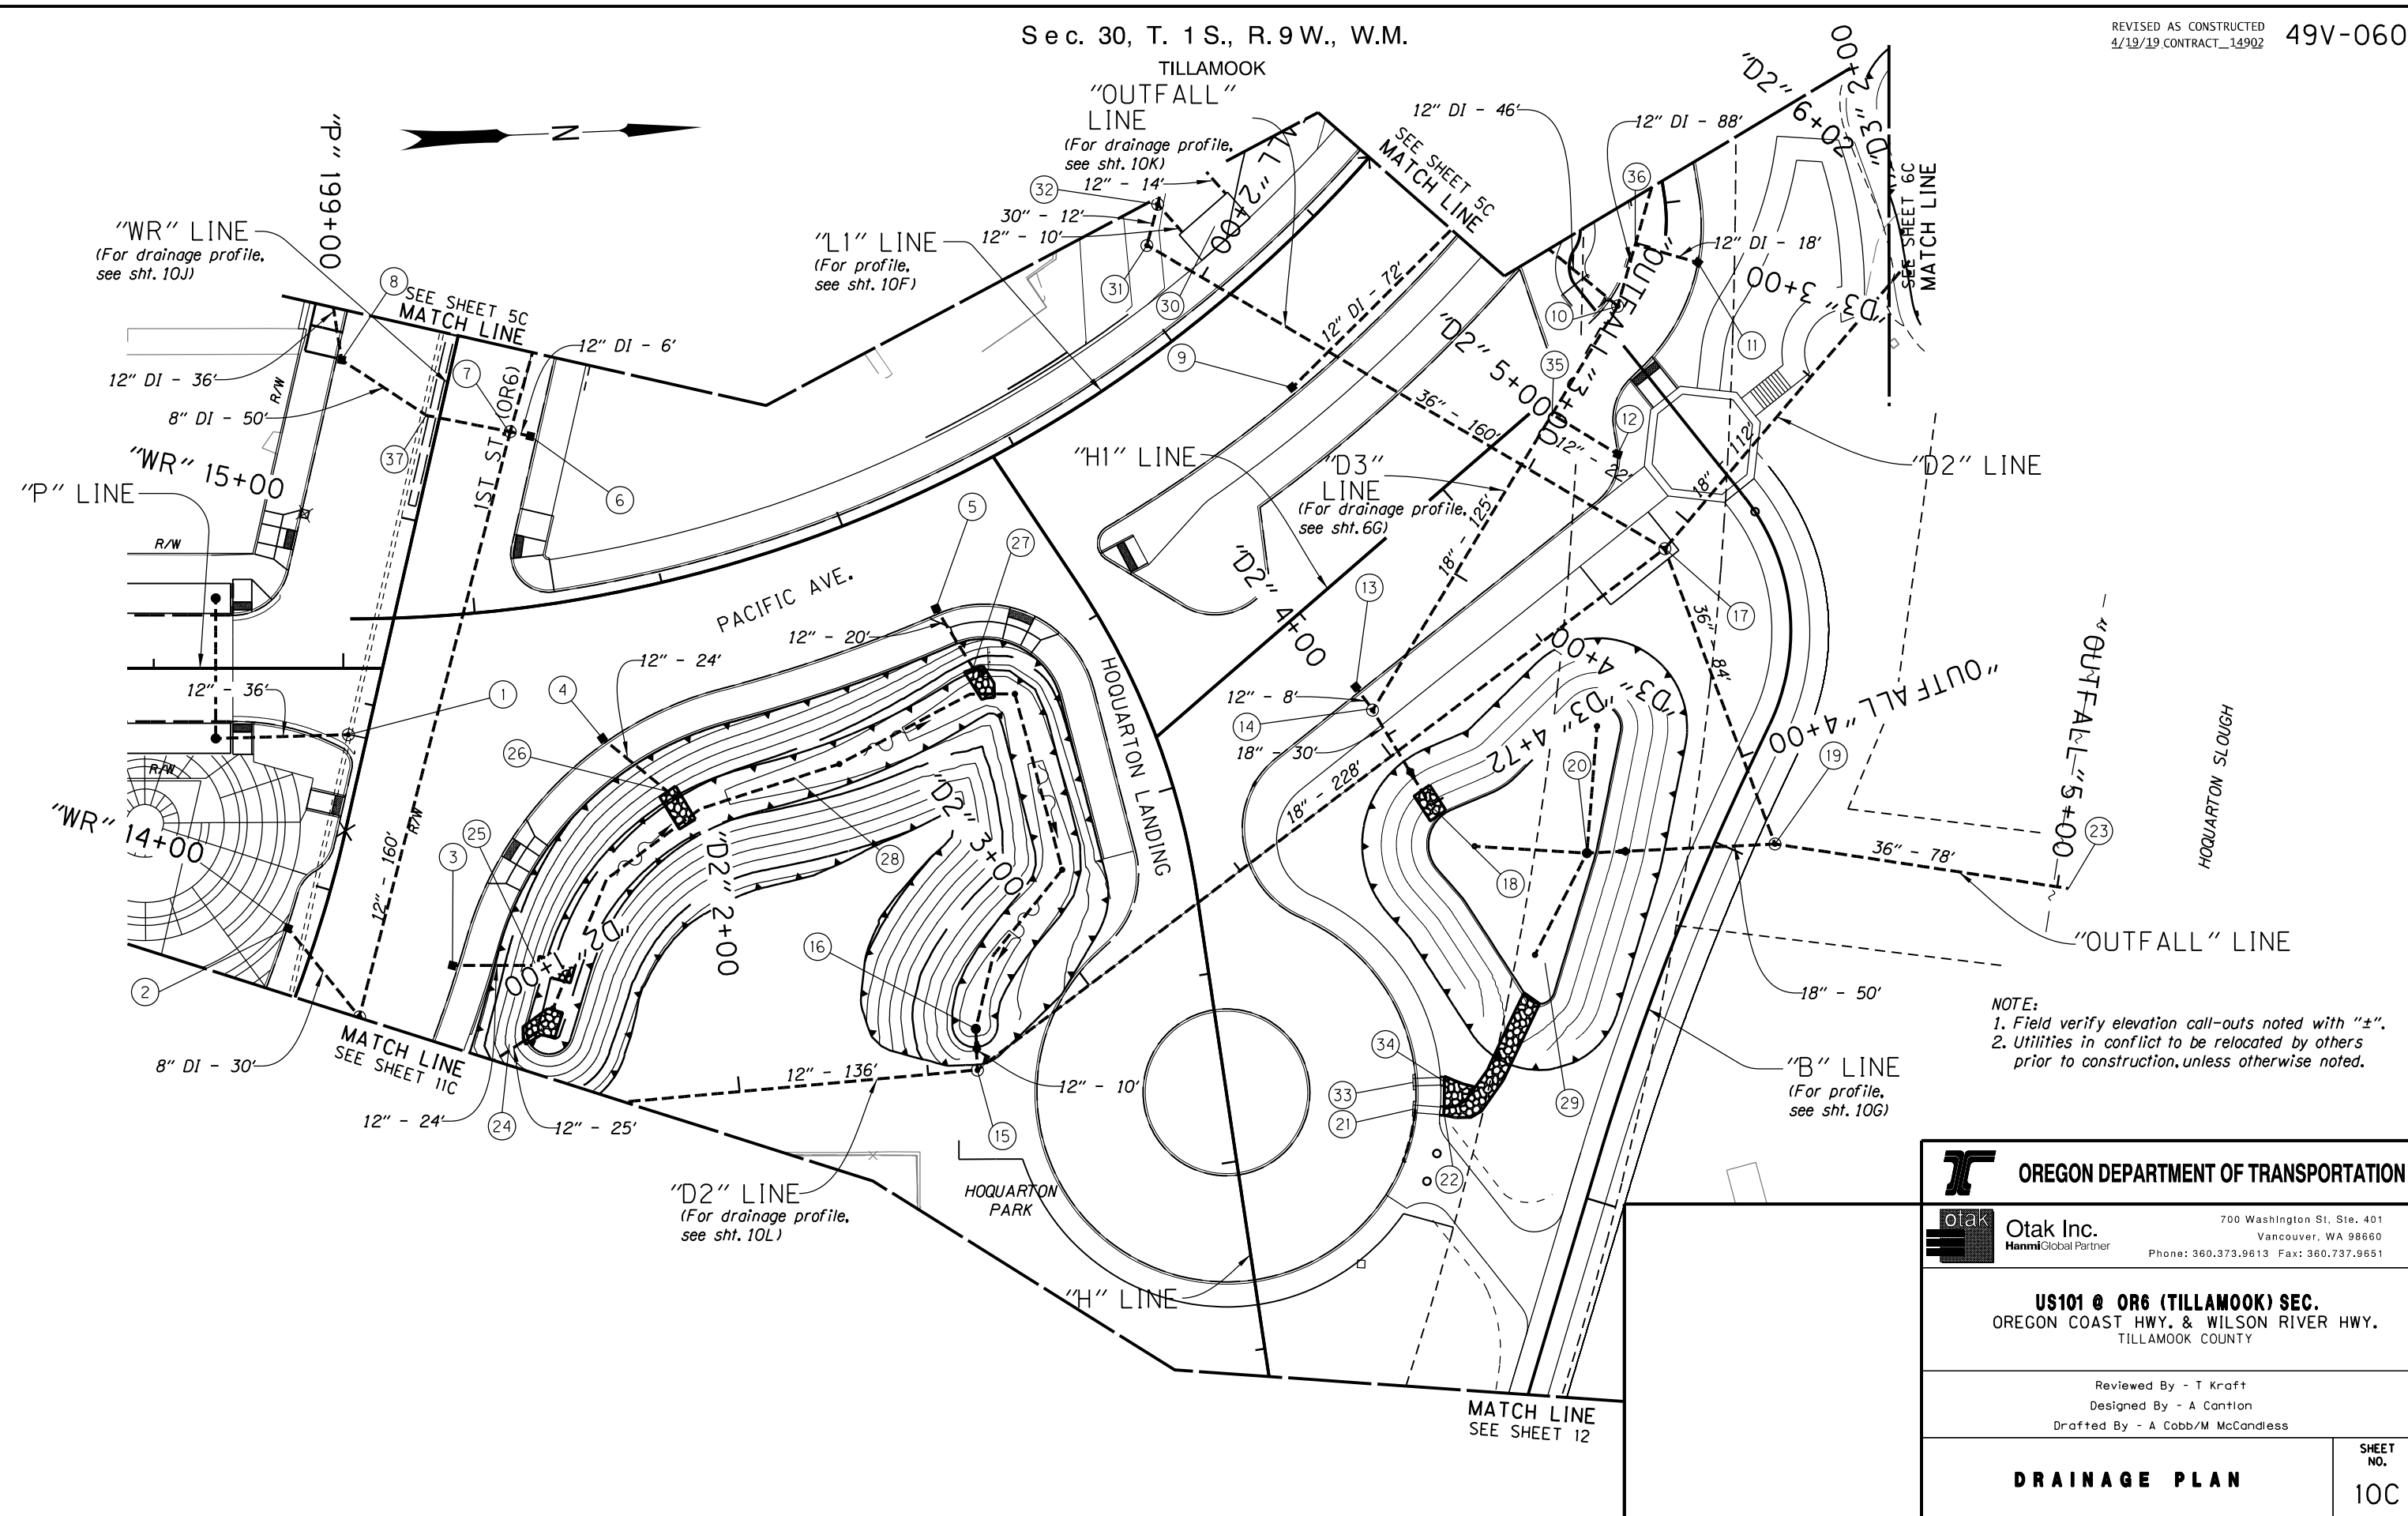

NOTE:
 1. Field verify elevation call-outs noted with "+".
 2. Utilities in conflict to be relocated by others prior to construction, unless otherwise noted.

OREGON DEPARTMENT OF TRANSPORTATION	
Otak Inc. HanmiGlobal Partner	700 Washington St, Ste. 401 Vancouver, WA 98660 Phone: 360.373.9613 Fax: 360.737.9651
US101 @ OR6 (TILLAMOOK) SEC. OREGON COAST HWY. & WILSON RIVER HWY. TILLAMOOK COUNTY	
Reviewed By - T Kraft Designed By - A Cantion Drafted By - A Cobb/M McCandless	
DRAINAGE PLAN	SHEET NO. 10C

- ① Sta. "WR" 14+41.12, 4.51' Rt.
Const. shallow manhole
Rim 27.39
I.E.In= 21.08 (18" E) extg.
I.E.In= 21.61 (12" S)
I.E.Out= 21.08 (18" W) extg.
Connect to extg. storm sew. pipe
Inst. 12" storm sew. pipe - 36'
10' depth
- ② Sta. "WR" 13+86.98, 7.84' Lt.
Const. type G-2 inlet with sump
Rim 27.60
I.E.Out= 24.27 (8" NE)
- ③ Sta. "WR" 13+90.56, 36.55' Lt.
Const. type G-2 inlet with sump
Rim 27.00
I.E.Out= 23.00 (12" N)
- ④ Sta. "L1" 399+27.64, 37.16' Rt.
Const. type G-2 inlet with sump
Rim 25.86
I.E.Out= 21.12 (12" NE)
- ⑤ Sta. "L1" 400+13.98, 29.53' Rt.
Const. type G-2 inlet with sump
Rim 23.60
I.E.Out= 19.60 (12" NE)
- ⑥ Sta. "WR" 15+28.45, 24.46' Lt.
Const. type G-2 inlet with sump
Rim 27.02
I.E.Out= 23.90 (12" S)
- ⑦ Sta. "WR" 15+28.42, 19.01' Lt.
Const. shallow manhole
Rim 27.13
I.E.In= 23.56 (12" N)
I.E.In= 23.32 (12" W)
I.E.In= 23.89 (8" S)
I.E.Out= 23.22 (12" E)
Connect to extg. storm sew. pipe
Inst. 12" DI storm sew. pipe - 120'
5' depth
Inst. 8" DI storm sew. pipe - 50'
5' depth
- ⑧ Sta. "WR" 15+37.00, 28.59' Rt.
Const. type G-2 inlet with sump
Rim 26.85
I.E.In= 24.27 (12" W)
I.E.Out= 24.27 (8" N)
Inst. 12" DI storm sew. pipe - 36'
5' depth
- ⑨ Sta. "L1" 401+16.50, 29.32' Rt.
Const. type G-2 inlet with sump
Rim 19.20
I.E.Out= 15.20 (12" NW)
- ⑩ Sta. "L1" 401+89.32, 74.81' Rt.
Const. shallow manhole
Rim 16.41
I.E.In= 12.85 (12" SW)
I.E.In= 12.85 (12" W)
I.E.Out= 12.77 (18" SE)
Inst. 12" DI storm sew. pipe - 134'
5' depth
- ⑪ Sta. "L1" 402+20.24, 80.71' Rt.
Const. type G-2 inlet with sump
Rim 15.65
I.E.Out= 13.50 (12" SW)
- ⑫ Sta. "L1" 401+59.17, 101.25' Rt.
Const. type G-2 inlet with sump
Rim 16.40
I.E.Out= 13.15 (12" SE)
- ⑬ Sta. "L1" 400+87.07, 102.29' Rt.
Const. type G-2 inlet with sump
Rim 18.88
I.E.Out= 13.52 (12" NE)
- ⑭ Sta. "L1" 400+87.14, 109.31' Rt.
Const. storm sew. pollution control manhole
Rim 19.41
I.E.In= 11.13 (18" NW)
I.E.In= 13.49 (12" SW)
I.E.Out= 11.03 (18" NE)
Inst. 12" storm sew. pipe - 8'
10' depth
Inst. 18" storm sew. pipe - 125'
10' depth
- ⑮ Sta. "L1" 399+86.75, 146.95' Rt.
Const. std. manhole
Rim 18.00
I.E.In= 12.22 (12" S)
I.E.In= 12.22 (12" W)
I.E.Out= 8.22 (18" NW)
Inst. 12" storm sew. pipe - 146'
10' depth
- ⑯ Sta. "L1" 399+88.88, 136.56' Rt.
Const. ditch inlet
Rim 15.47
I.E.In= 12.97 (6" W)
I.E.Out= 12.77 (12" E)
- ⑰ Sta. "L1" 401+52.07, 127.48' Rt.
Const. manhole, 72" dia.
Rim 17.11
I.E.In= 7.00 (18" SE)
I.E.In= 6.02 (36" SW)
I.E.In= 6.02 (18" NW)
I.E.Out= 5.92 (36" E)
Inst. 18" storm sew. pipe - 228'
10' depth
Inst. 18" storm sew. pipe - 112'
20' depth
Inst. 36" storm sew. pipe - 160'
20' depth
- ⑱ Sta. "L1" 400+85.68, 139.17' Rt.
Const. storm outfall class 50 riprap
I.E.Out= 10.88 (18" W)
(For details, see sht. GJ-14)
Inst. 18" storm sew. pipe - 30'
10' depth
- ⑲ Sta. "L1" 401+29.51, 203.86' Rt.
Const. shallow manhole, 72" dia.
Rim 13.00
I.E.In= 5.84 (36" W)
I.E.In= 7.43 (18" S)
I.E.Out= 5.74 (36" N)
Inst. 18" storm sew. pipe - 50'
10' depth
Inst. 36" storm sew. pipe - 84'
20' depth
- ⑳ Sta. "L1" 400+03.58, 173.81' Rt.
Const. beehive inlet
Rim 11.55
I.E.Out= 7.68 (18" N)
(For details, see sht. GJ-12)
- ㉑ Sta. "H" 11+93.10, 48.16' Lt.
Inst. concrete channel inlet without conc. splash pad
from gutter to back of walk
I.E.= 12.56
(For details, see sht. GJ-13)
- ㉒ Sta. "H" 11+94.91, 56.02' Lt.
Const. storm outfall protection alt. from back
of walk to bottom of pond
(For details, see sht. GJ-14)
- ㉓ Sta. "L1" 401+58.02, 266.40' Rt.
Const. storm outfall class 100 riprap, with tidegate
I.E.Out= 5.66 (36" S)
(For details, see sht. GJ-14)
Inst. 36" storm sew. pipe - 78'
10' depth
- ㉔ Sta. "WR" 13+77.53, 57.30' Lt.
Const. storm outfall class 50 riprap
I.E.Out= 19.75 (12" S)
(For details, see sht. GJ-14)
Inst. 12" storm sew. pipe - 22'
5' depth
- ㉕ Sta. "WR" 13+94.57, 51.69' Lt.
Const. storm outfall class 50 riprap
I.E.Out= 22.0 (12" SE)
(For details, see sht. GJ-14)
Inst. 12" storm sew. pipe - 24'
5' depth
- ㉖ Sta. "L1" 399+37.41, 50.07' Rt.
Const. storm outfall class 50 riprap
I.E.Out= 21.0 (12" SE)
(For details, see sht. GJ-14)
Inst. 12" storm sew. pipe - 24'
5' depth
- ㉗ Sta. "L1" 400+16.05, 43.08' Rt.
Const. storm outfall class 50 riprap
I.E.Out= 19.0 (12" W)
(For details, see sht. GJ-14)
Inst. 12" storm sew. pipe - 20'
5' depth
- ㉘ Sta. "L1" 399+57.24 to Sta. "L1" 401+33.00, Rt.
Const. Water Quality Swale D00930- 258'
(For details, see sht. GJ-5)
- ㉙ Sta. "L1" 401+67.40 to Sta. "L1" 402+27.95, Rt.
Const. Bioretention Pond D00927- 6,600 Sq. Ft.
(For details, see sht. GJ-8)
- ㉚ Sta. "L1" 401+28.70, 16.19' Lt.
Const. water quality structure D00929
Rim 21.49
I.E.In= 14.67 (12" SW)
I.E.Out= 11.62 (12" SW)
Inst. 12" storm sew. pipe - 14'
10' depth
(For details, see sht. GJ-6)
- ㉛ Sta. "L1" 401+10.82, 23.93' Lt.
Const. large precast manhole, 72" dia.
Rim 21.40
I.E.In= 7.08 (30" N)
I.E.Out= 6.25 (36" NE)
Inst. 30" storm sew. pipe - 12'
20' depth
- ㉜ Sta. "L1" 401+20.72, 30.44' Lt.
Const. large precast manhole, 60" dia.
Rim 21.08
I.E.In = 11.52 (12" E)
I.E.In = 7.34 (30" NW)
I.E.Out= 7.14 (30" SE)
Inst. 12" storm sew. pipe - 10'
10' depth
Inst. 30" storm sew. pipe - 72'
20' depth
- ㉝ Sta. "H" 11+86.22, 49.37' Lt.
Inst. concrete channel inlet without conc. splash pad
from gutter to back of walk
I.E.= 13.02
(For details, see sht. GJ-13)
- ㉞ Sta. "H" 11+87.14, 57.28' Lt.
Const. class 50 riprap from back of walk
to storm outfall class 50 riprap at Sta. "H" 11+94.91
(For details, see sht. GJ-14)
- ㉟ Sta. "L1" 401+55.71, 81.48' Rt.
Inst. pipe tees, 12"
Inst. 12" storm sew. pipe - 22'
10' depth
- ㊱ Sta. "L1" 402+08.07, 66.30' Rt.
Inst. pipe tees, 12"
Inst. 12" DI storm sew. pipe - 18'
5' depth
- ㊲ Sta. "WR" 15+27.70, 3.51' Lt.
Inst. 22" elbow





Otak Inc.
HanmiGlobal Partner
700 Washington St, Ste. 401
Vancouver, WA 98660
Phone: 360.373.9613 Fax: 360.737.9651

US101 @ OR6 (TILLAMOOK) SEC.
OREGON COAST HWY. & WILSON RIVER HWY.
TILLAMOOK COUNTY

Reviewed By - T Kraft
Designed By - A Cantion
Drafted By - A Cobb/M McCandless

DRAINAGE NOTES

SHEET
NO.
10D

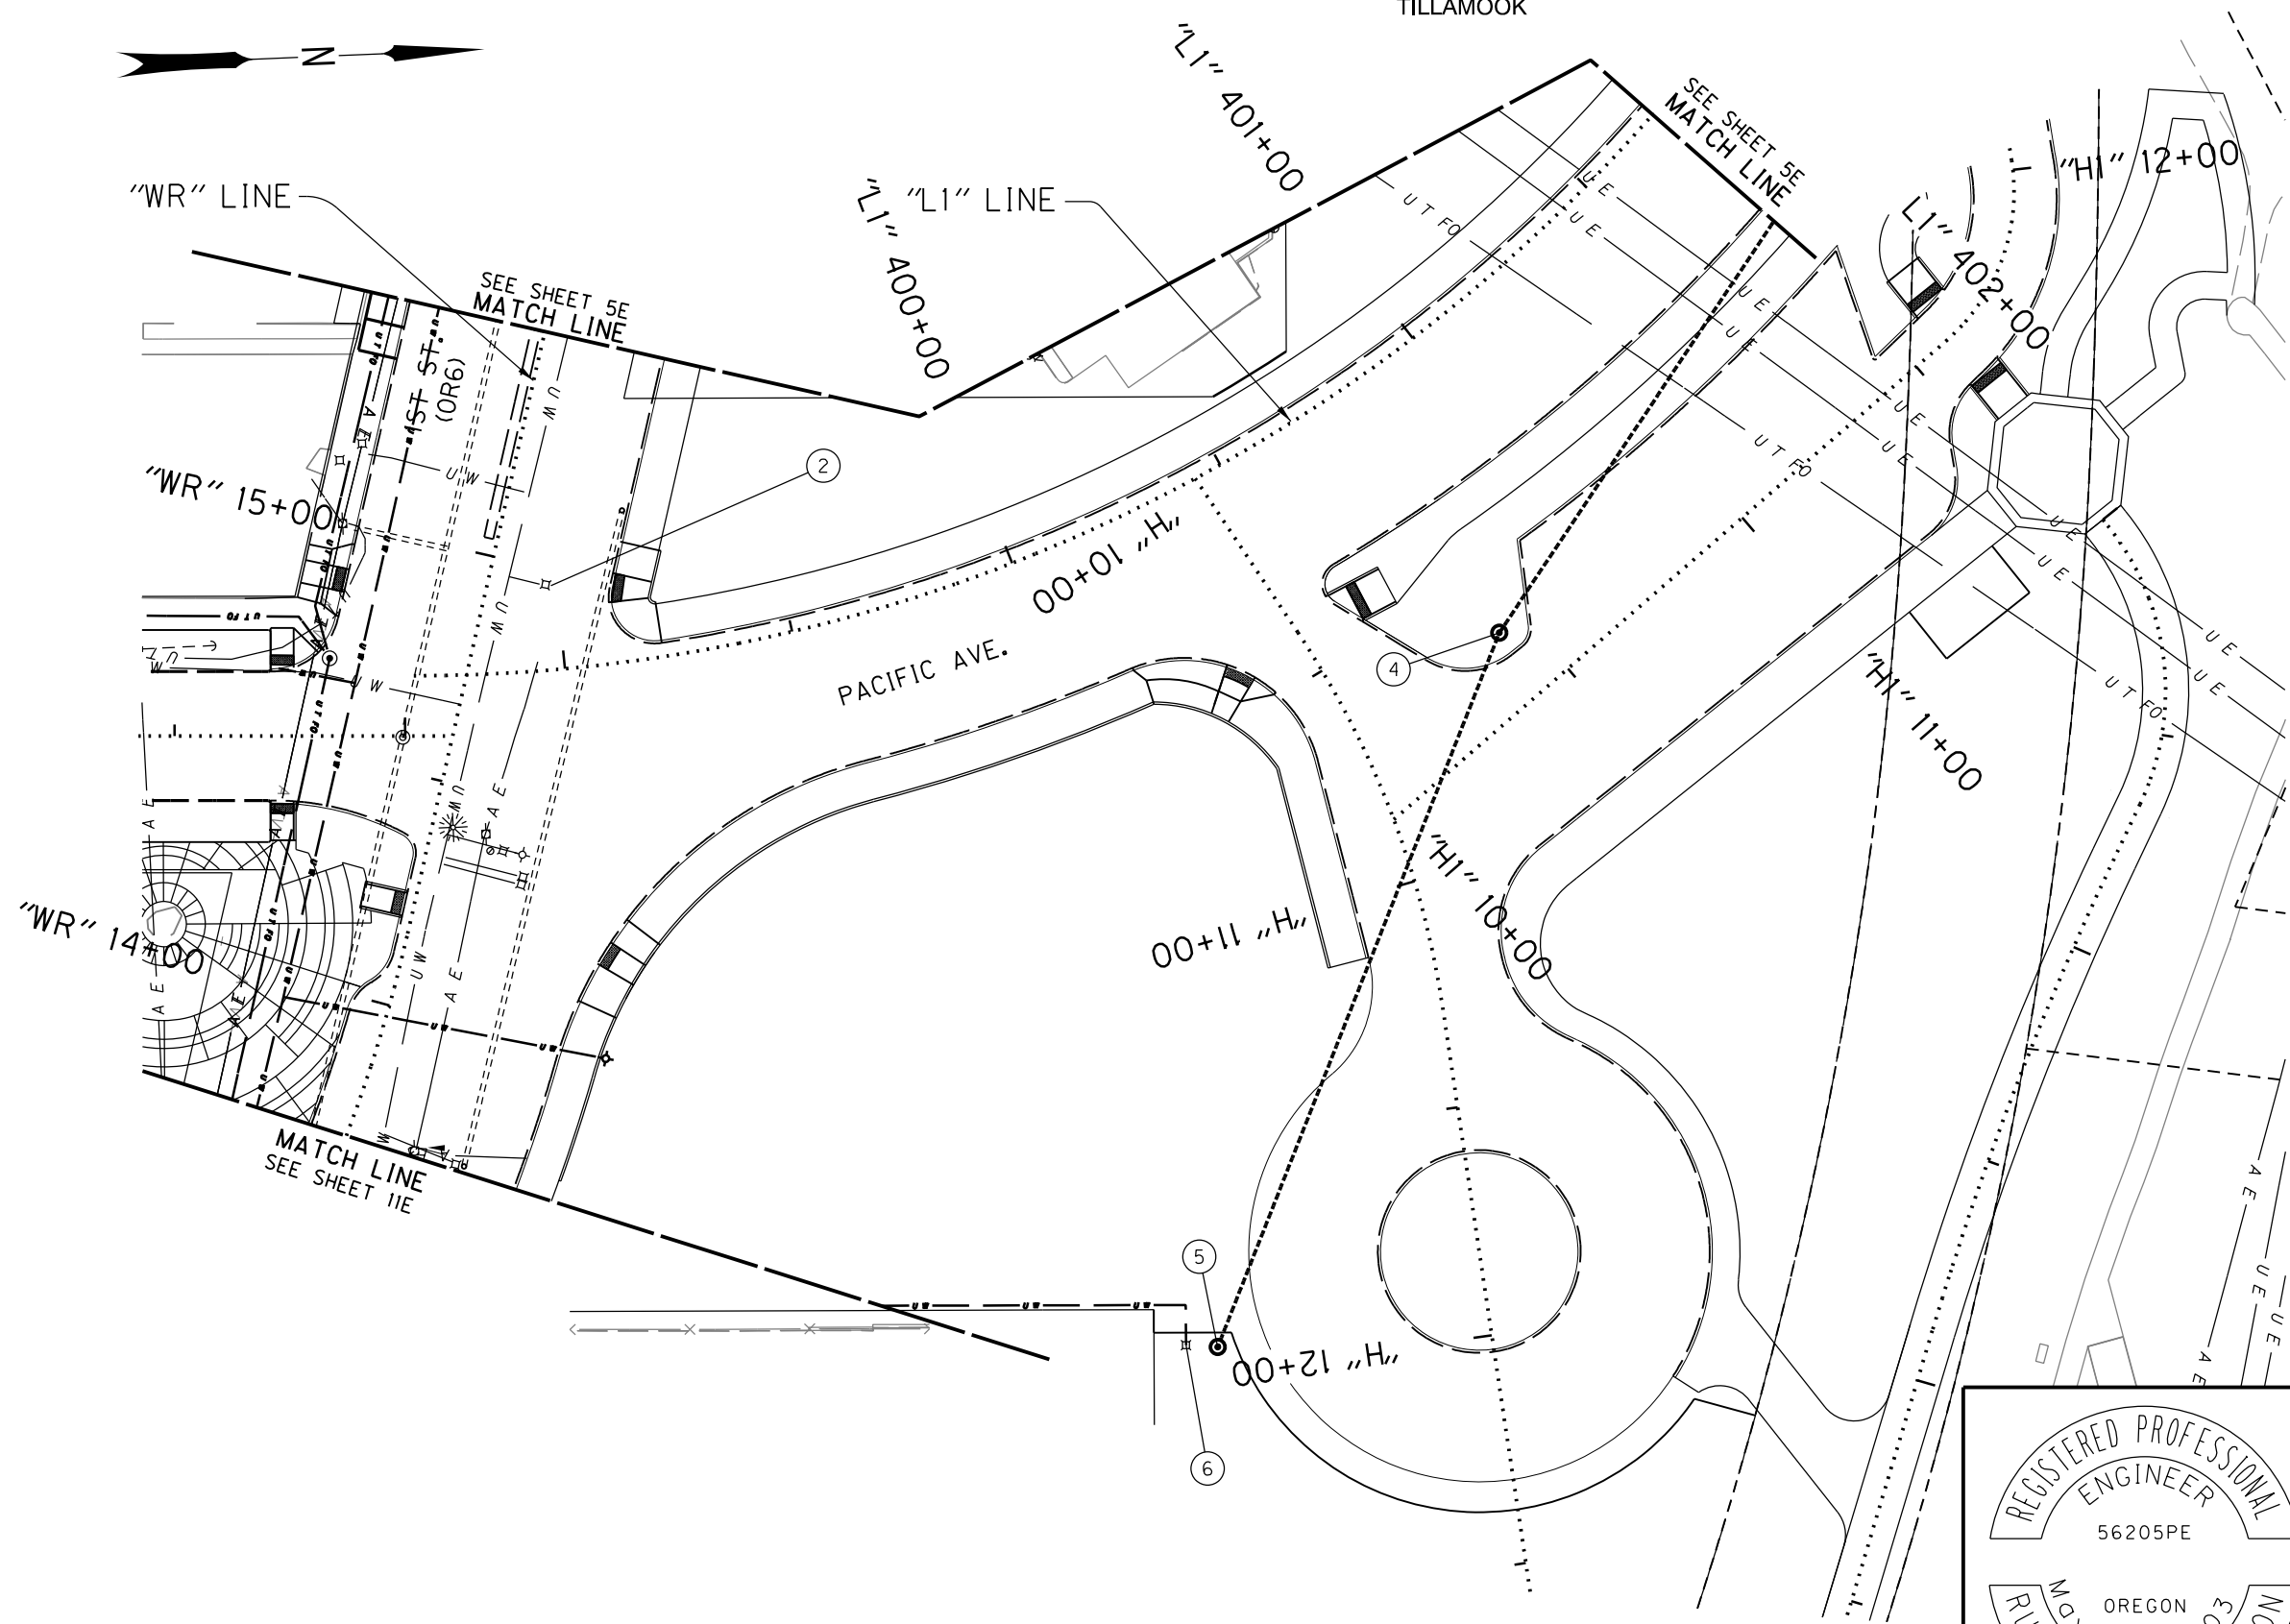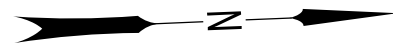

- ② Relocate water meter assembly
(See Drg. No. RD274)
- ④ Sta. "H" 10+60, Lt.
Const. san. sewer manhole, 48" dia.
Rim elev. 20.58
Connect to 8" san. sewer pipe
10' depth
Const. conc. pipe protection block
(For details, see sheet 2B-27)
Inst. 8" san. sewer pipe - 166'
10' depth
I.E. out= 10.00 (8" NW)
I.E. in= 10.02 (8" SE)
(See drg. no. RD335)
- ⑤ Sta. "H" 11+90, 60' Rt.
Const. san. sewer cleanout
Rim elev. 13.70
Connect to 8" san. sewer pipe
10' depth
I.E. out= 10.44 (8" NW)
(See drg. no. RD362)
- ⑥ Sta. "H" 11+92, 66' Rt.
Relocate 1" water meter assembly
Inst. 1" water service connection piping
(See drg. nos. RD258 & RD274)

NOTE:
 1. Protect all existing utilities shown in place unless otherwise noted.
 2. Notify the Engineer immediately if additional underground utilities are encountered.
 3. See Drainage Plans and Signal Plans for more details.

REGISTERED PROFESSIONAL
ENGINEER
56205PE
MAY 13, 2003
OREGON
RUSSELL W. NORTON
RENEWS: 12-31-2018

OREGON DEPARTMENT OF TRANSPORTATION


QUINCY ENGINEERING

US101 @ OR6 (TILLAMOOK) SEC.
OREGON COAST HWY. & WILSON RIVER HWY.
TILLAMOOK COUNTY

Design Team Leader - Russell W. Norton
Designed By - Russell W. Norton
Drafted By - Patrick Kenney

UTILITY PLAN

SHEET NO. 10E

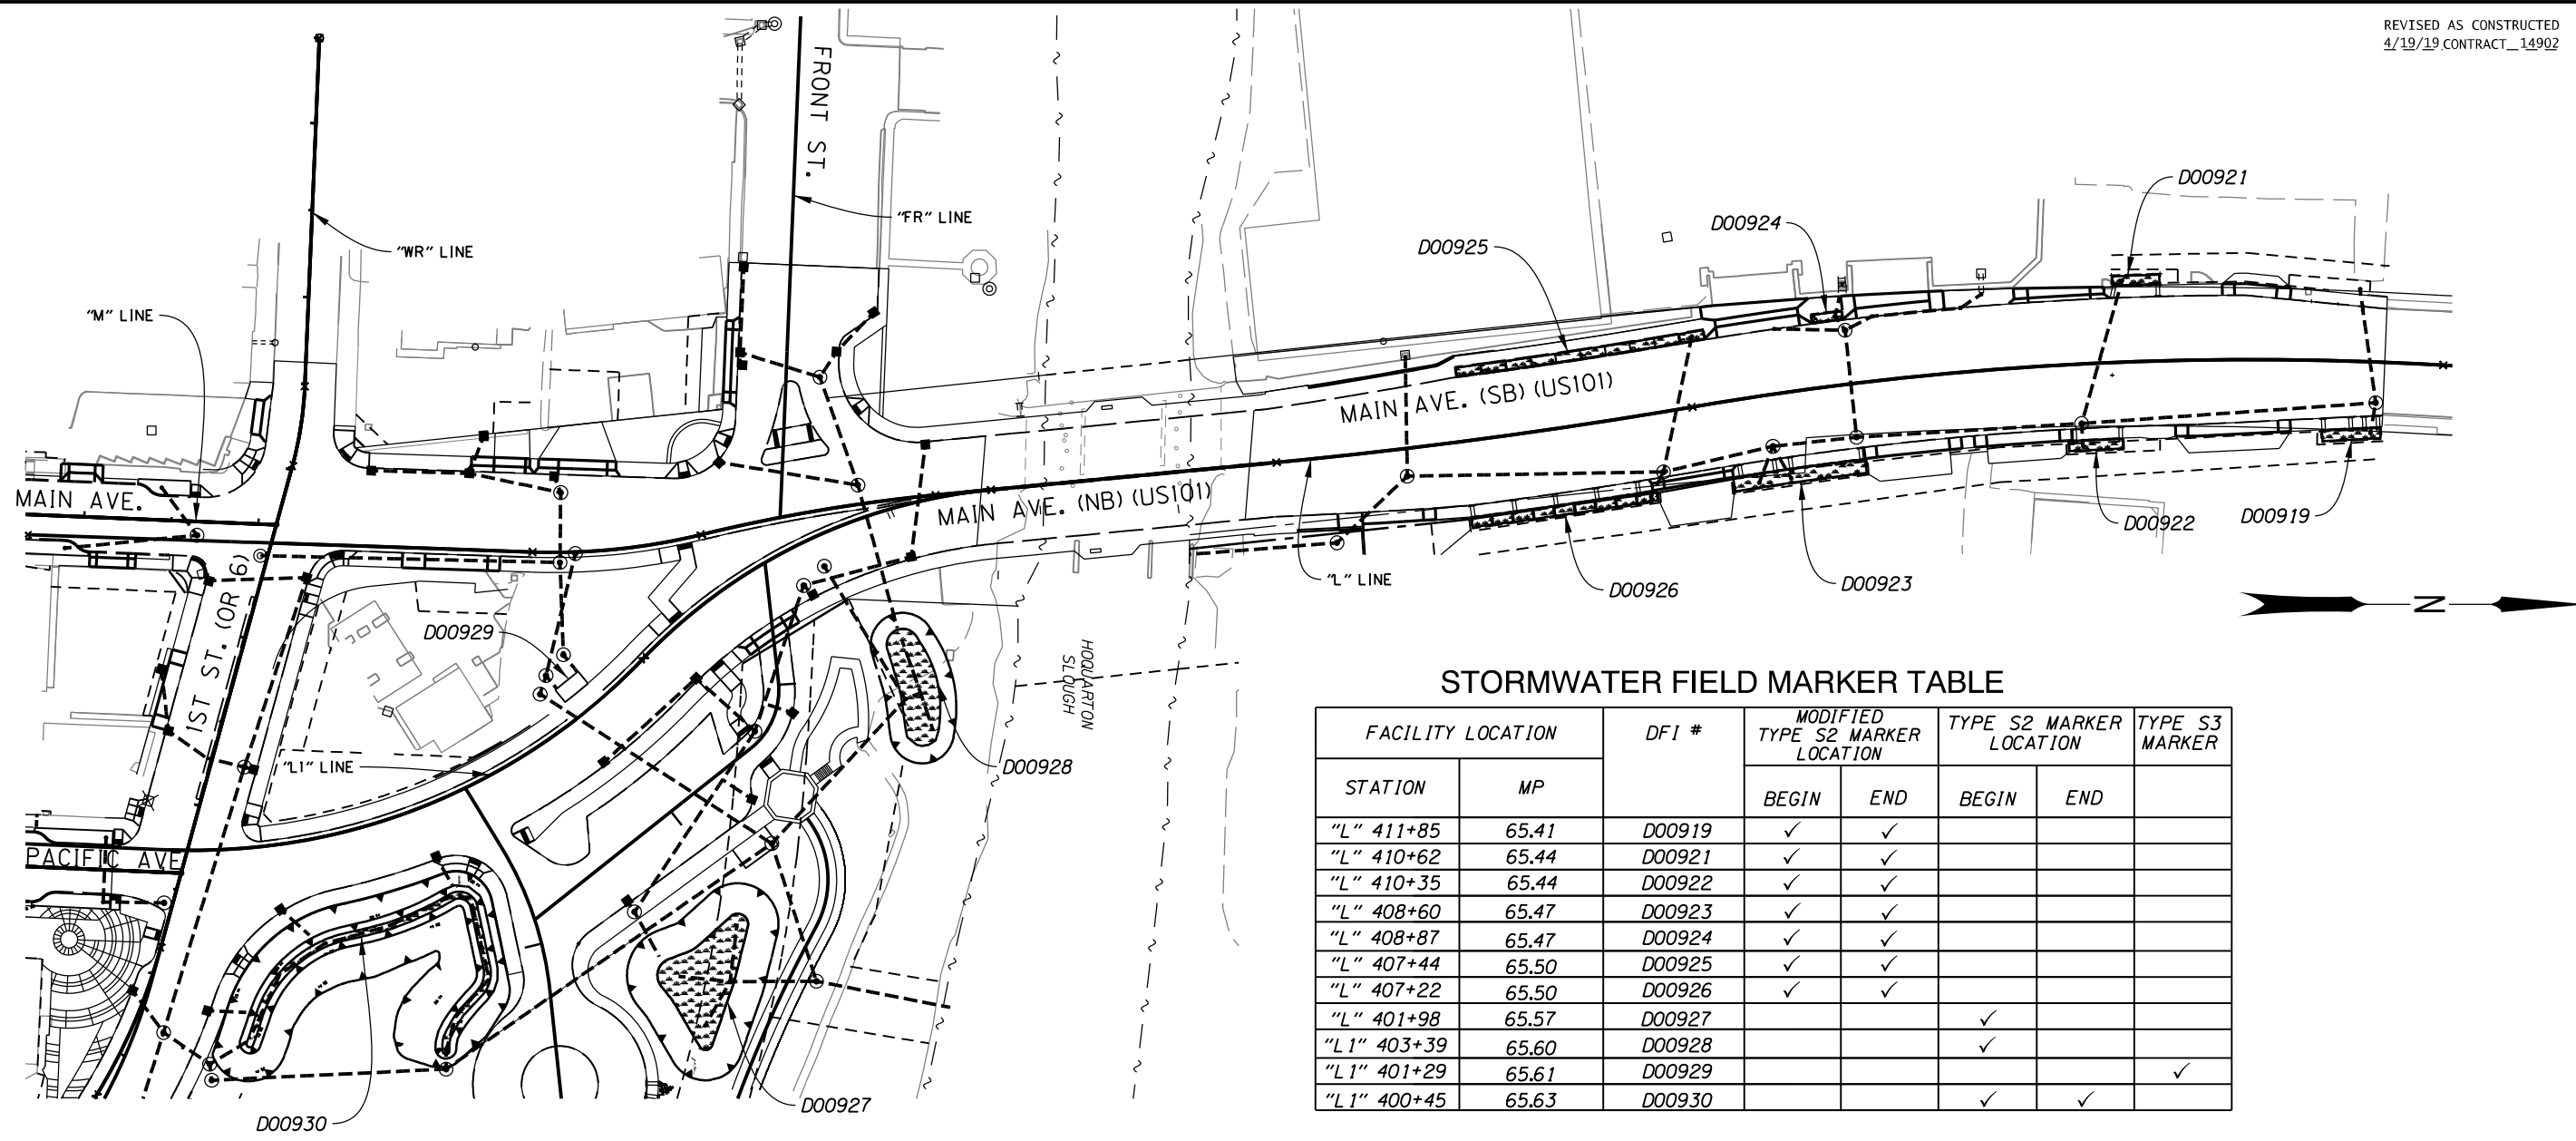

STORMWATER FIELD MARKER TABLE

FACILITY LOCATION		DFI #	MODIFIED TYPE S2 MARKER LOCATION		TYPE S2 MARKER LOCATION		TYPE S3 MARKER
STATION	MP		BEGIN	END	BEGIN	END	
"L" 411+85	65.41	D00919	✓	✓			
"L" 410+62	65.44	D00921	✓	✓			
"L" 410+35	65.44	D00922	✓	✓			
"L" 408+60	65.47	D00923	✓	✓			
"L" 408+87	65.47	D00924	✓	✓			
"L" 407+44	65.50	D00925	✓	✓			
"L" 407+22	65.50	D00926	✓	✓			
"L" 401+98	65.57	D00927			✓		
"L1" 403+39	65.60	D00928			✓		
"L1" 401+29	65.61	D00929					✓
"L1" 400+45	65.63	D00930			✓	✓	

PLAN
No Scale

See Drg.No.RD399 for facility marker details.

OREGON DEPARTMENT OF TRANSPORTATION



Otak Inc. Hanmi Global Partner
700 Washington St, Ste. 401
Vancouver, WA 98660
Phone: 360.373.9613 Fax: 360.737.9651

US101 @ OR6 (TILLAMOOK) SEC.
OREGON COAST HWY. & WILSON RIVER HWY.
TILLAMOOK COUNTY


Reviewed By - T Kraft
Designed By - A Cantlon
Drafted By - A Cobb

WATER QUALITY PLAN

SHEET NO.
GJ-2

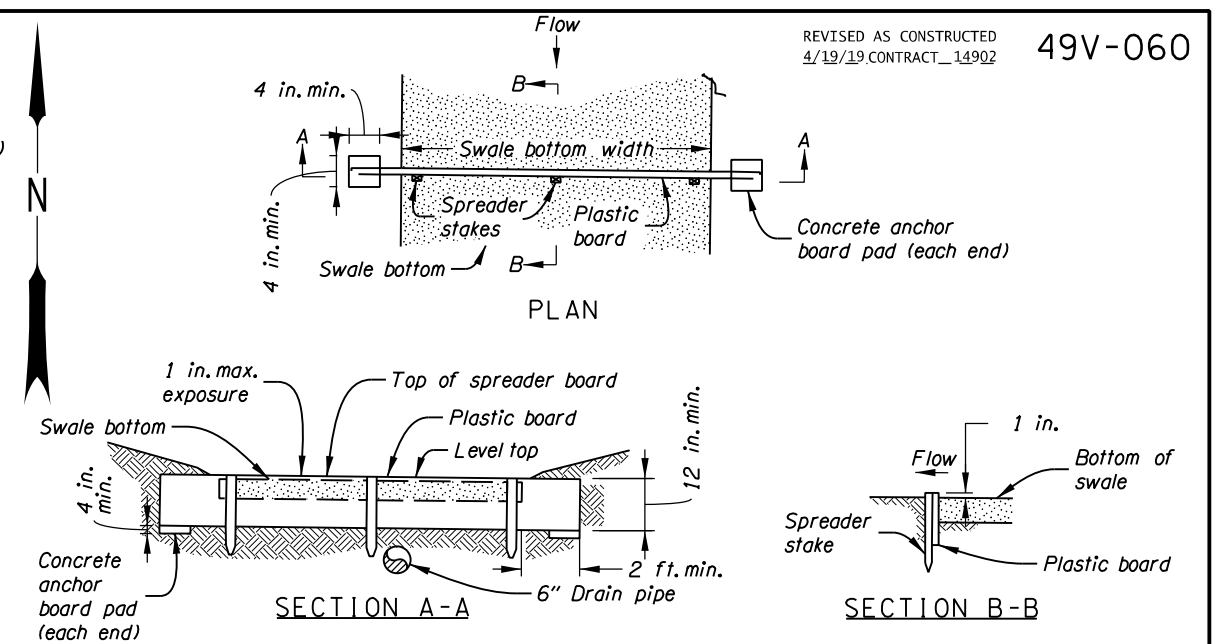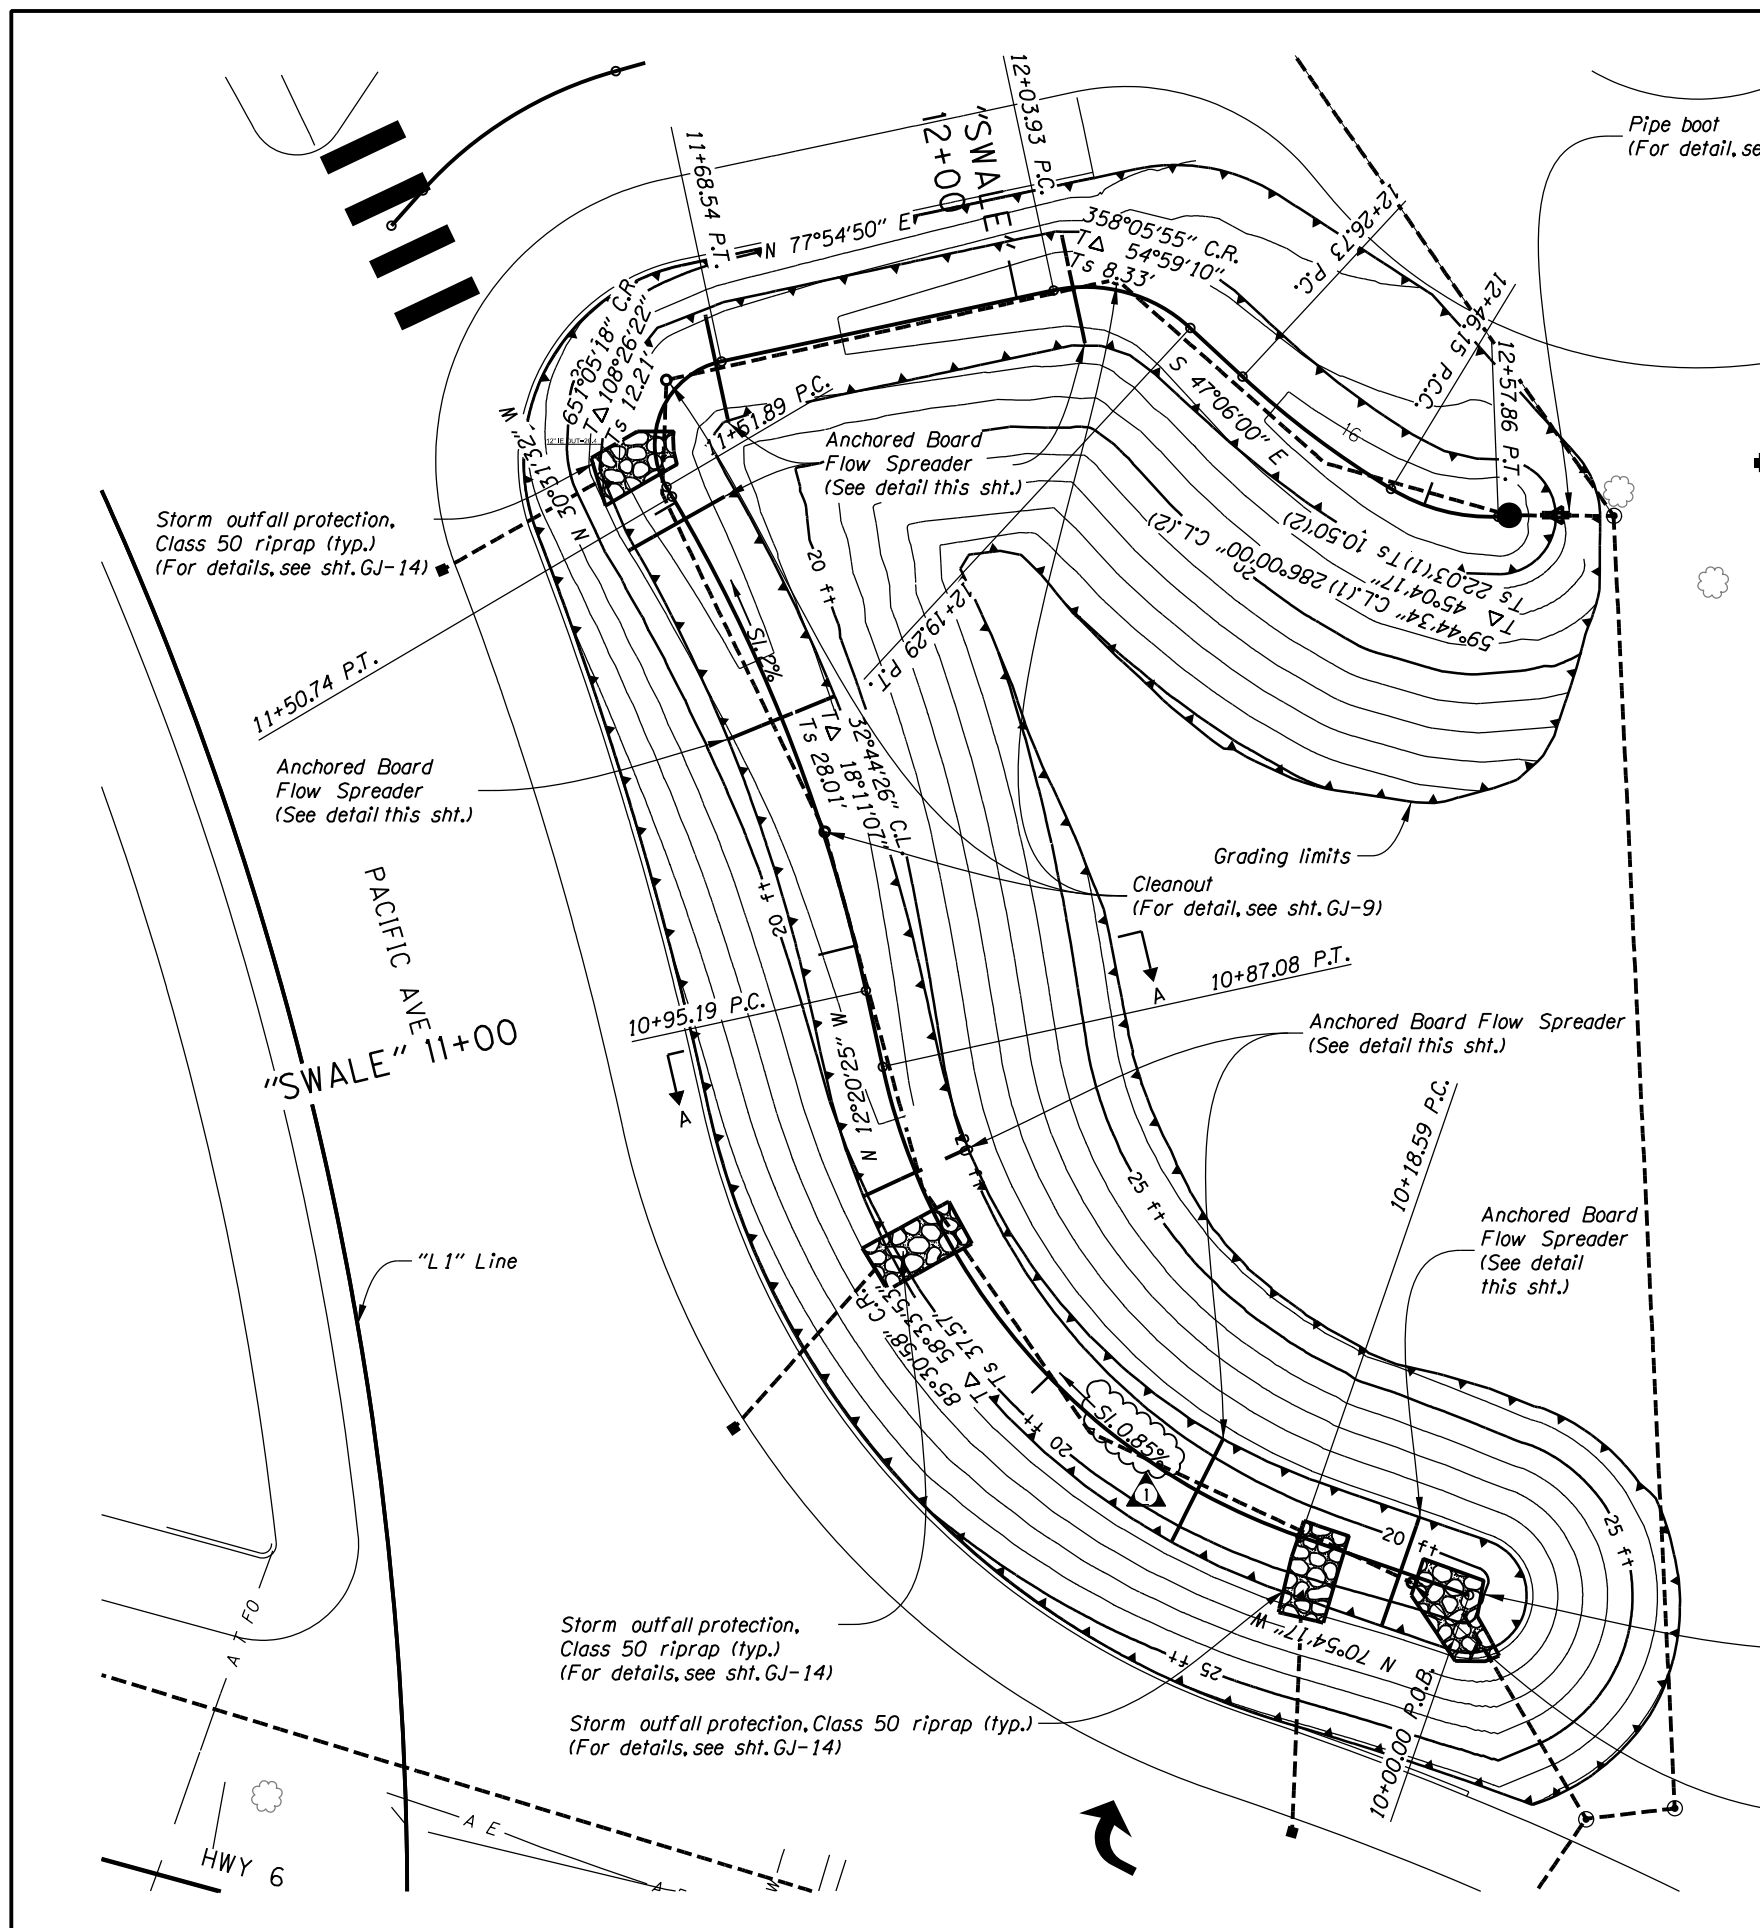

ANCHORED BOARD FLOW SPREADER

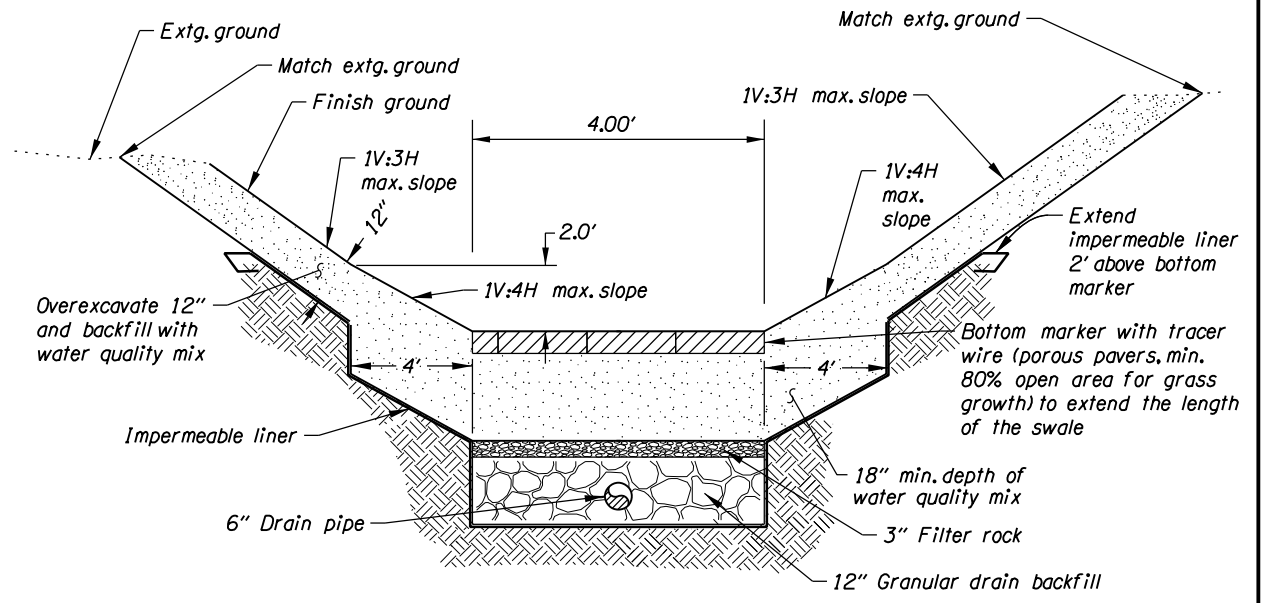

WATER QUALITY SWALE D00930
SECTION A-A
No Scale


- NOTES:
1. See GN shts. for planting plan.
 2. See shts. 10C and 10D for inlet and outlet data.
 3. Heavy equipment shall not be allowed in swale.

OREGON DEPARTMENT OF TRANSPORTATION Otak Inc. 700 Washington Street, Suite 401 Vancouver, WA 98660 Phone: (360)737-9613 Fax: (360)737-9651	
US101 @ OR6 (TILLAMOOK) SEC. OREGON COAST HWY. & WILSON RIVER HWY. TILLAMOOK COUNTY	
Reviewed By - T Kraft Designed By - A Cantion Drafted By - S Reiter	
WATER QUALITY DETAILS	
SHEET NO. GJ-5	



- ① Install 12' length root barrier along curb centered on tree trunk.
- ② Install plant bed edger per detail sheet GN-2.

NOTE:
 1. See sheet GN-8 for planting legend.
 2. See sheet GN for planting notes and details.

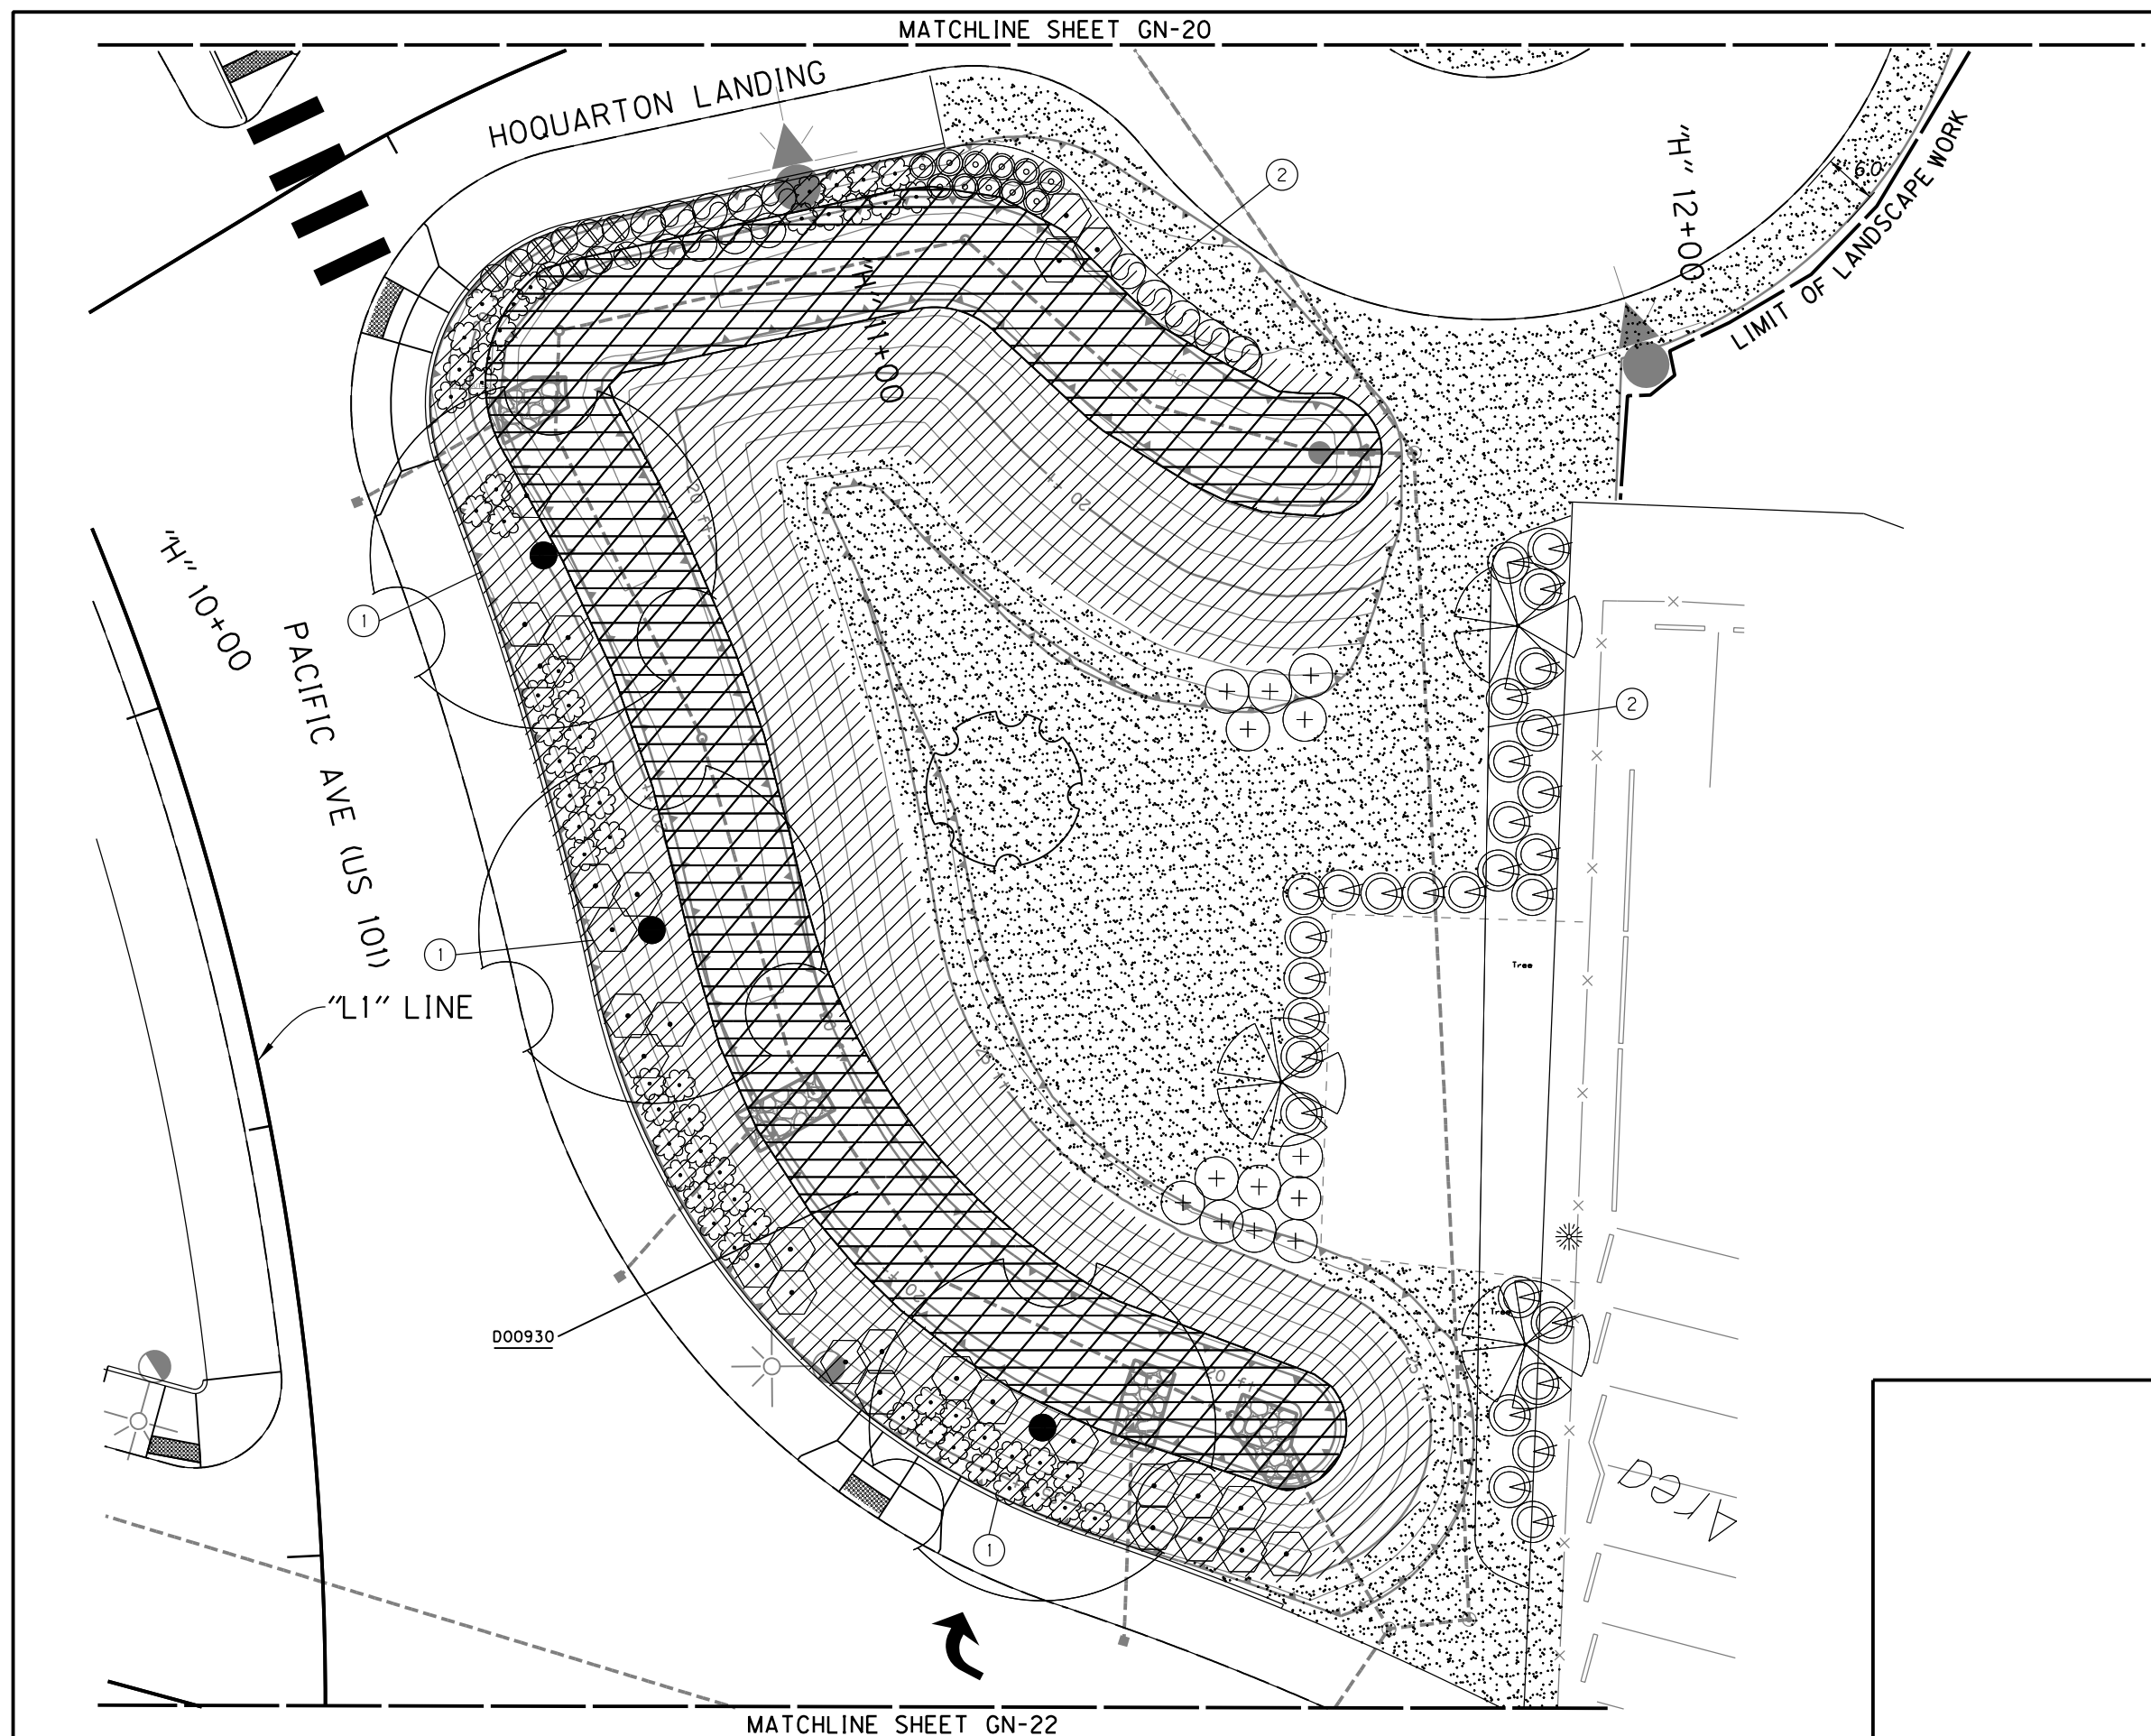

D00930

 OREGON DEPARTMENT OF TRANSPORTATION	
 Otak Inc. <small>700 Washington St, Ste. 401 Vancouver, WA 98660 Phone: 360.373.9613 Fax: 360.737.9651</small>	
US101 @ OR6 (TILLAMOOK) SEC. OREGON COAST HWY. & WILSON RIVER HWY. TILLAMOOK COUNTY	
Reviewed By - Ken Ackerman Designed By - David Haynes Drafted by - S. Reiter/M. Daly	
PLANTING PLAN	SHEET NO. GN-21