

# **OPERATIONS AND MAINTENANCE MANUAL FOR STORMWATER DETENTION AND TREATMENT FACILITIES**

**DFI No. 01201**

**Facility Type: Biofiltration Swale**

**July, 2016**

## INDEX

1. Identification
2. Contact Information
3. Construction
4. Overview
5. Haz Mat Spill Feature
6. Auxiliary Outlet(High Flow Bypass)
7. Maintenance Requirements
8. Waste Material Handling

APPENDIX A:

Operations Plan and Profile Drawing(s)

## 1. Identification

Facility Types: Water Quality Biofiltration Swale 01201

Location: Pacific Highway West 91  
Milepost 103.71

## 2. Facility Contact Information

Chris Carman, ODOT Hydraulics Engineer (503) 986-2691.

## 3. Construction

Engineer of Record: ODOT Designer - Region 2 Tech. Center,  
Chris Carman, (503) 986-2691

Facility construction: 2017

## 4. Overview

The swale is located 150 feet south of Lake Slough on the east side of Pacific Highway West. Treatment of pollutants from the highway are achieved through sedimentation and infiltration through the water quality mix shown in section B-B in the operational plan.

## 5. Facility Haz Mat Spill Feature

The swale can be used to store a volume of liquid by blocking the outlet of the swale. A barrier such as a temporary berm made of sandbags could be used to prevent liquid from draining from the swale.

## 6. Auxiliary Outlet (High Flow Bypass)

Auxiliary Outlets are provided if the primary outlet control structure can not safely pass the projected high flows. Broad-crested spillway weirs and over flow risers are the two most common auxiliary outlets used in stormwater treatment facility design. The auxiliary outlet feature is either a part of the facility or an additional storm drain feature/structure.

The auxiliary outlet feature for this facility is:

Designed into facility

Other

This facility does not contain an auxiliary outlet feature. The facility was designed to receive runoff from the road and discharge into cross pipes.

## 7. Maintenance Requirements

Routine maintenance table for non-proprietary stormwater treatment and storage/detention facilities have been incorporated into ODOT's Maintenance Guide. These tables summarize the maintenance requirements for ponds, swales, filter strips, bioslopes, and detention tanks and vaults. Special maintenance requirements in addition to the routine requirements are noted below when applicable.

The ODOT Maintenance Guide can be viewed at the following website:

[https://www.oregon.gov/ODOT/HWY/OOM/mg/02/act125\\_waterqualityfacil\\_andtables.pdf](https://www.oregon.gov/ODOT/HWY/OOM/mg/02/act125_waterqualityfacil_andtables.pdf)

The following stormwater facility maintenance table (See ODOT Maintenance Guide) should be used to maintain the facility outlined in this Operation and Maintenance Manual or follow the Maintenance requirements outlined in Appendix C when proprietary structure is selected below:

- Table 1 (general maintenance)
- Table 2 (stormwater ponds)
- Table 3 (water quality biofiltration swales)
- Table 4 (water quality filter strips)
- Table 5 (water quality bioslopes)
- Table 6 (detention tank)
- Table 7 (detention vault)
- Appendix C (proprietary structure)
- Special Maintenance requirements:


## 8. Waste Material Handling

Material removed from the facility is defined as waste by DEQ. Refer to the roadwaste section 5.18 of the ODOT Maintenance Yard Environmental Management System (EMS) Policy and Procedures Manual for disposal options:

[https://www.oregon.gov/ODOT/HWY/OOM/EMSdoc/ems\\_manual.pdf](https://www.oregon.gov/ODOT/HWY/OOM/EMSdoc/ems_manual.pdf)


Contact any of the following for more detailed information about management of waste materials found on site:

ODOT Clean Water Unit	(503) 986-3008
ODOT Statewide Hazmat Coordinator	(503) 229-5129
ODOT Region Hazmat Coordinator	(503) 986-2647
ODEQ Northwest Region Office	(503) 229-5263

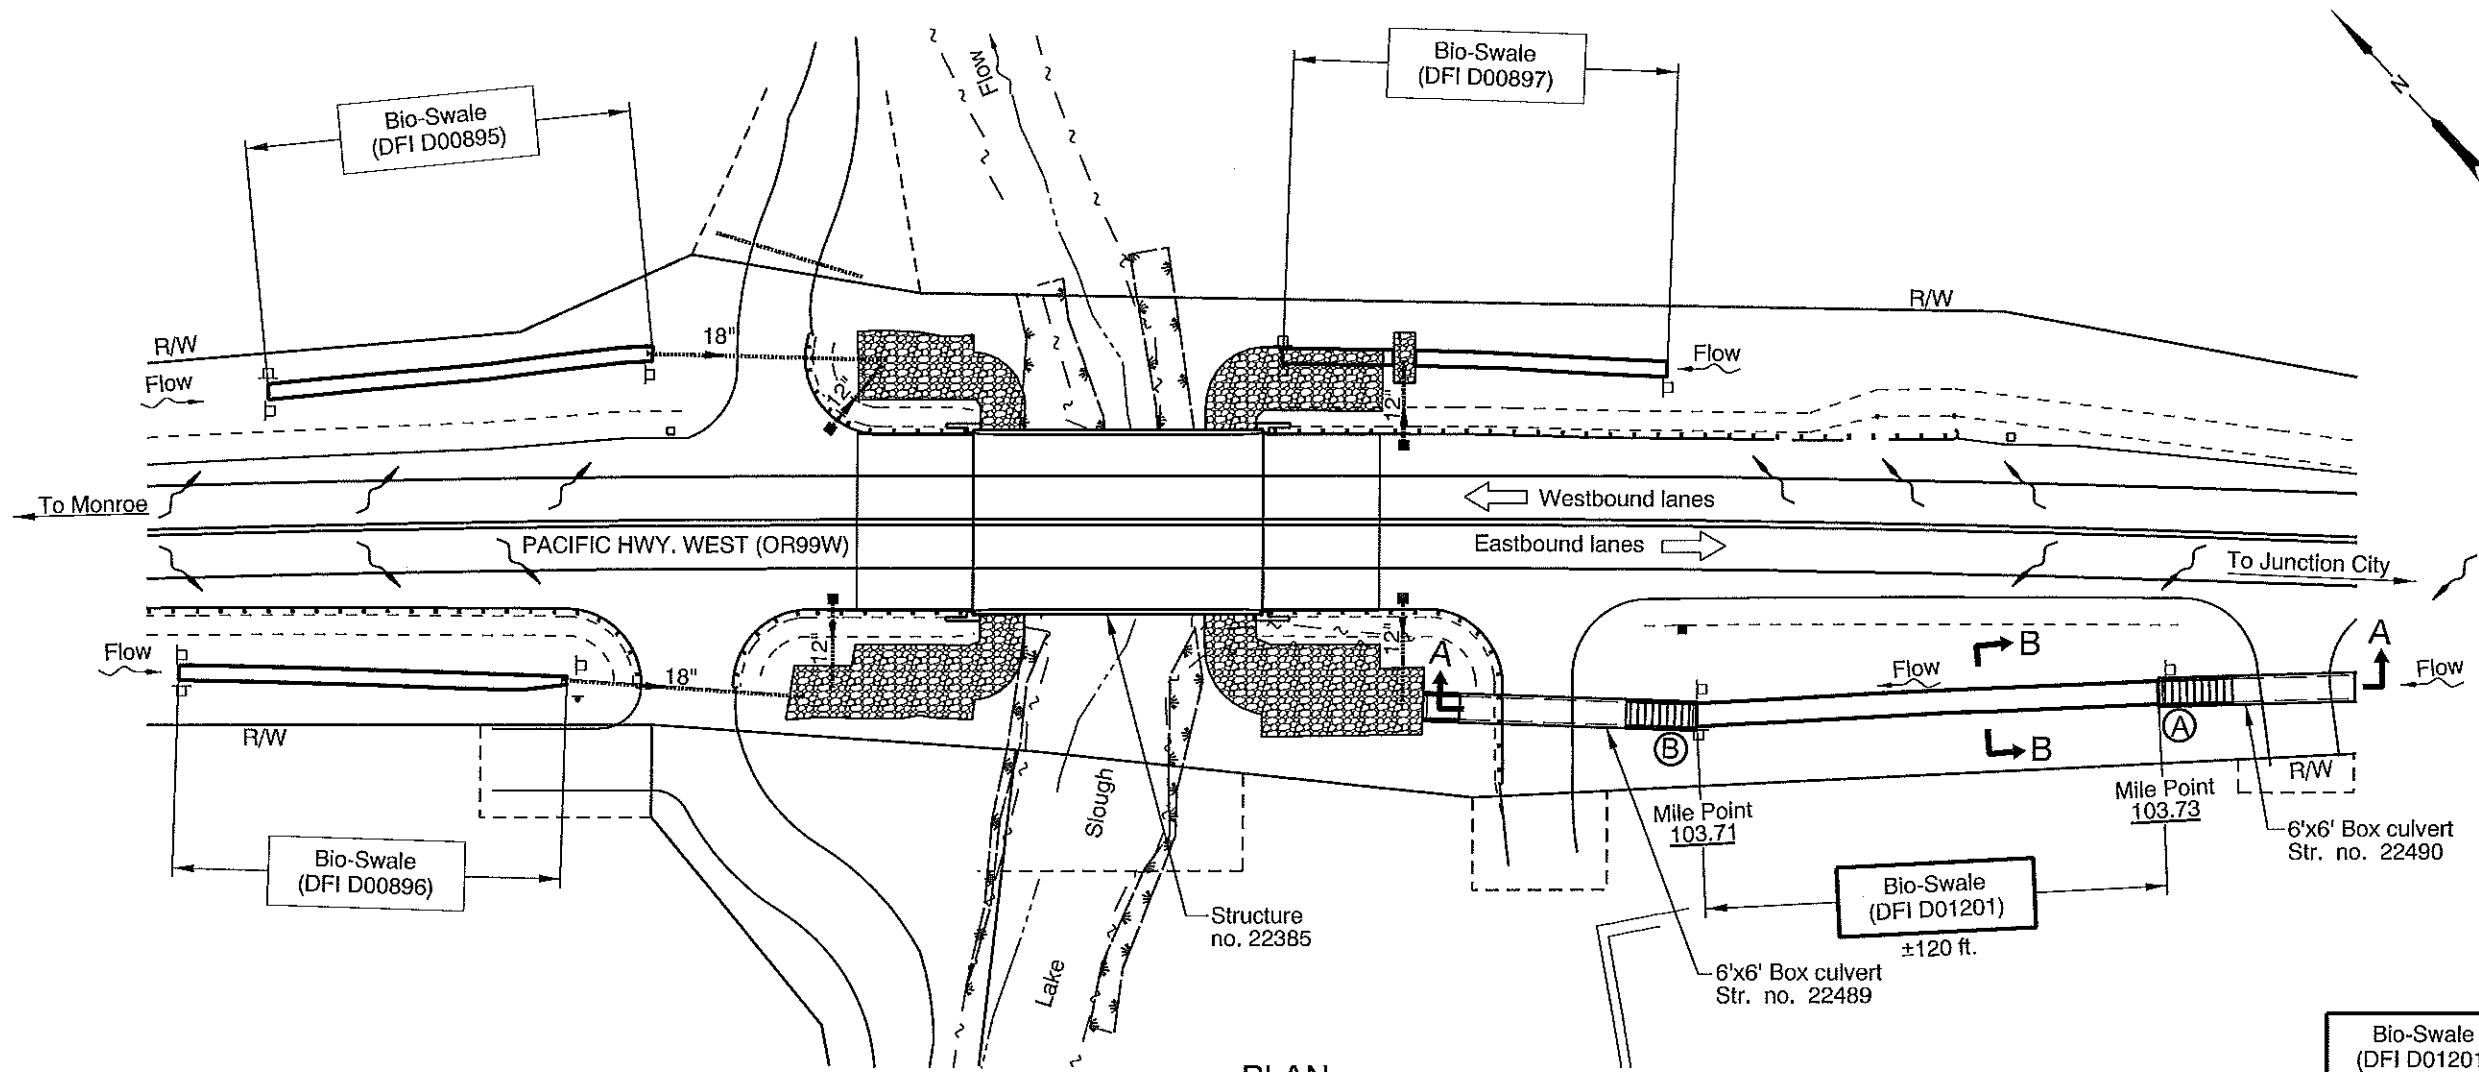


- LEGEND:**
- Photo Location / Direction
  - Swale Inlet
  - Swale Outlet
  - Storm Pipe (Facility)
  - Swale Boundary
  - Pavement / Facility Flow Path
  - Inlet

**PLAN**  
N.T.S.

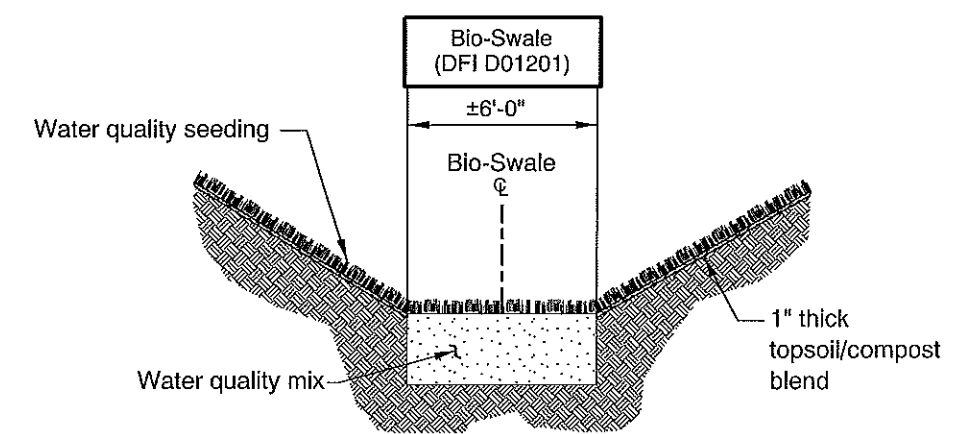

**SECTION B-B**  
N.T.S.

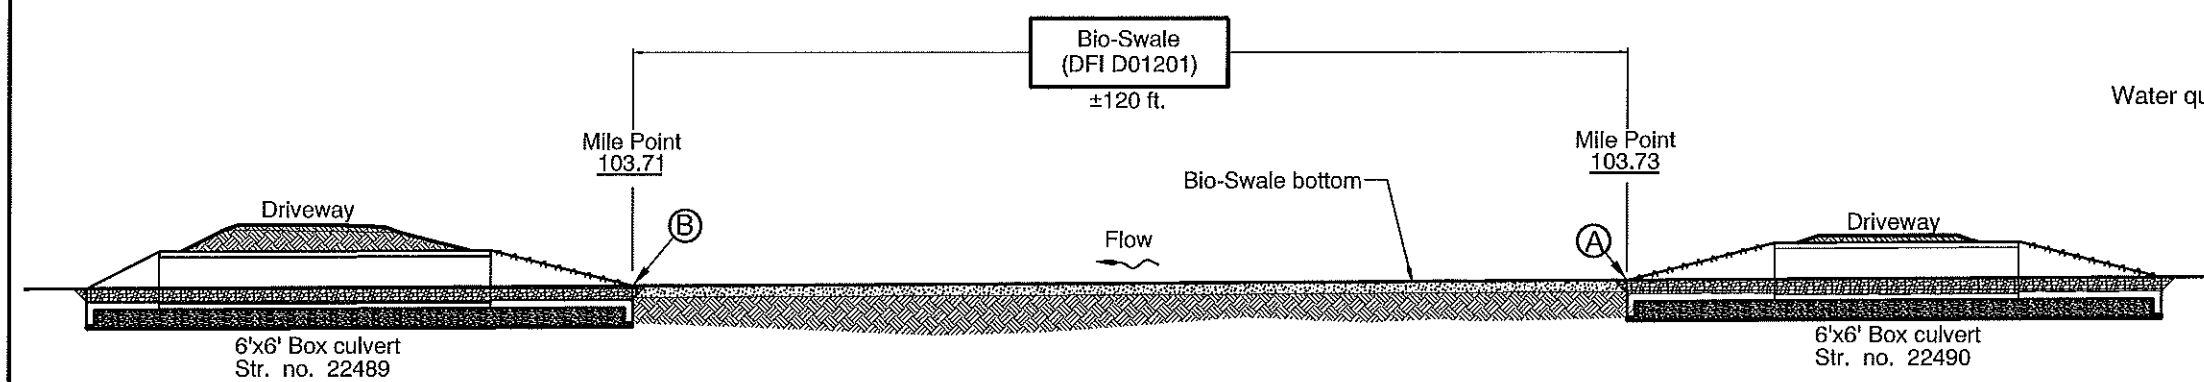


**SECTION A-A**  
N.T.S.

**OREGON DEPARTMENT OF TRANSPORTATION**

**DFI D01201**  
**MAINTENANCE DISTRICT 4 HWY 091**  
**WATER QUALITY BIOFILTRATION SWALE**  
 PACIFIC HIGHWAY WEST MP 103.71-103.73  
 BENTON COUNTY


Prepared By: Chris Carman  
 Drafted By: Sergy Chernishoff

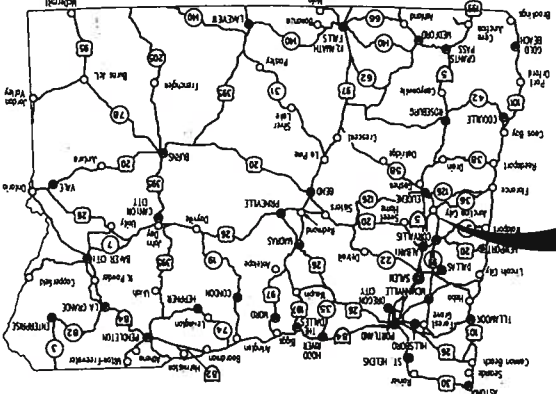

Overall Length of Project - 0.17 Miles

STATE OF OREGON  
DEPARTMENT OF TRANSPORTATION  
PLANS FOR PROPOSED PROJECT  
GRADING, STRUCTURES & PAVING  
PACIFIC HIGHWAY WEST  
BENTON COUNTY  
OCTOBER 2016

OR99W: LAKE SLOUGH BRIDGE REPLACEMENT SEC.

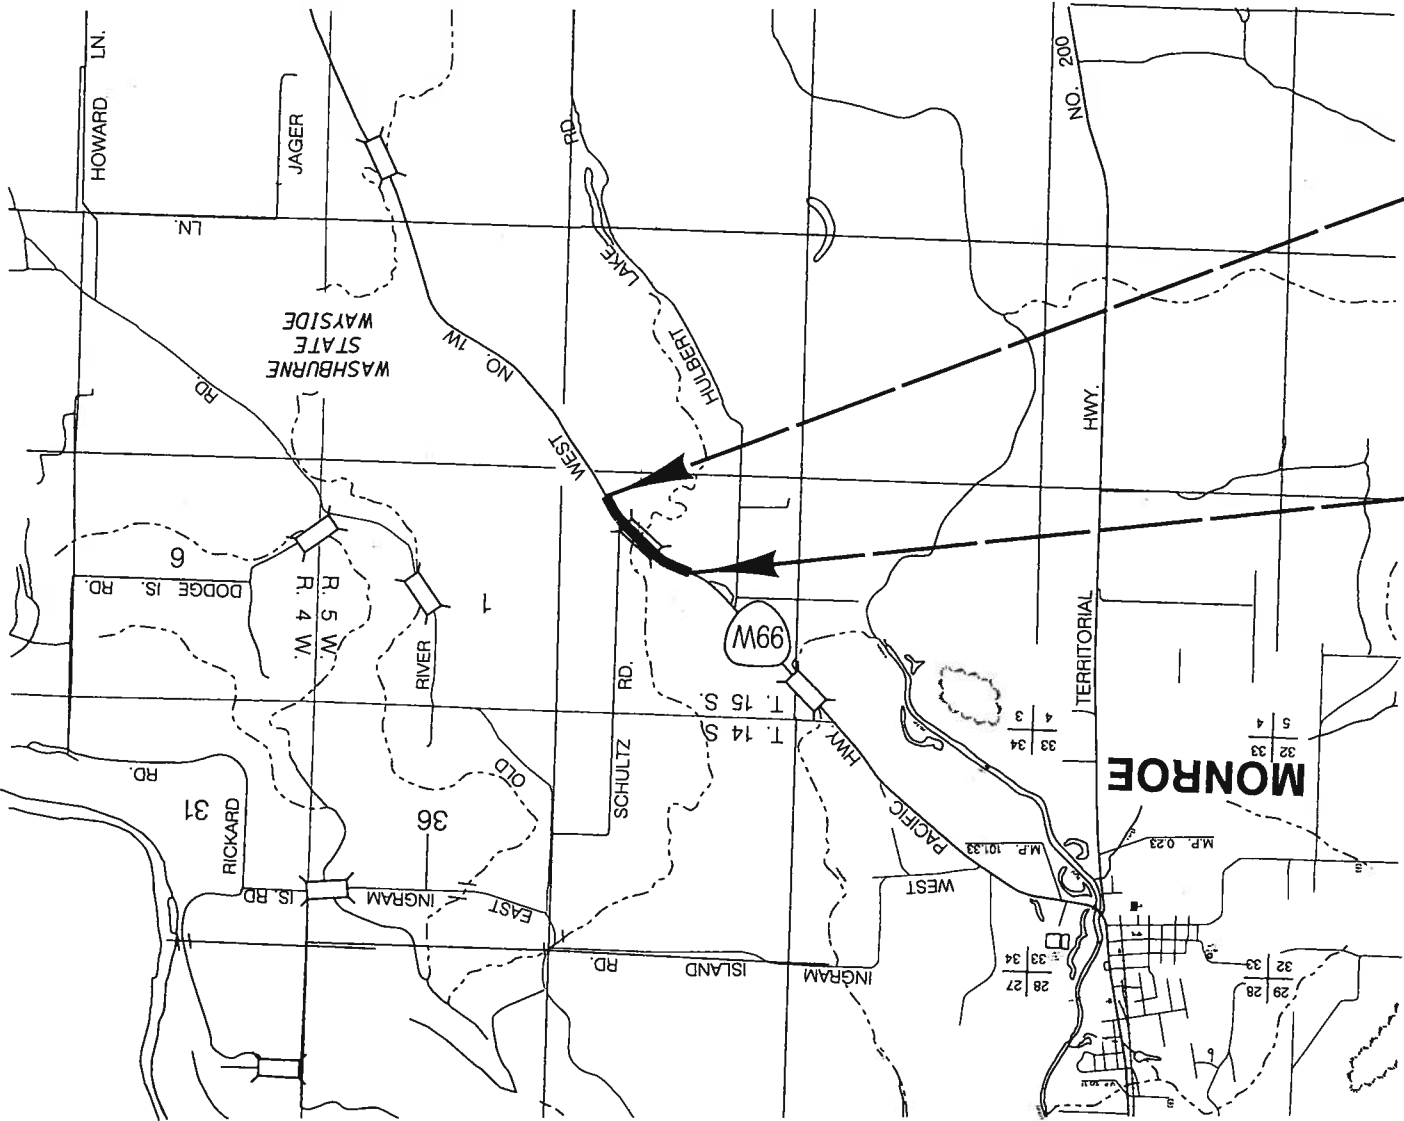


SHEET NO.	DESCRIPTION
1	Title Sheet
1A	Index Of Sheets Contd.
1A-2	Std. Drg. Nos.

NOT REVISED AS CONSTRUCTED  
STEVEN SCHULTZ, PE  
*[Signature]*  
DATE 01/22/18

STP-S091(071)  
BEGINNING OF PROJECT  
STA. "C" 30+66.46 (M.P. 103.59)

STP-S091(071)  
END OF PROJECT  
STA. "C" 39+43.62 (M.P. 103.76)

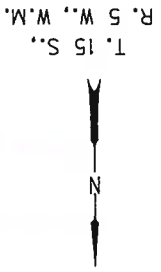

These plans were developed using ODOT design standards. Exceptions to these standards, if any, have been submitted and approved by the ODOT Chief Engineer or their delegated authority.

By: *[Signature]* 9.28.16

James E. West - R2 Tech Center Manager

Print Name and Title

Concurrence by ODOT Chief Engineer


OR99W: LAKE SLOUGH BRIDGE REPLACEMENT SEC.  
PACIFIC HIGHWAY WEST  
BENTON COUNTY

FEDERAL HIGHWAY ADMINISTRATION	OREGON DIVISION
PROJECT NUMBER	STP-S091(071)
SHEET NO.	1

LET'S ALL  
WORK TOGETHER  
TO MAKE THIS  
JOB SAFE

ATTENTION:  
Oregon Law Requires You To Follow Rules Adopted By The Oregon Utility Notification Center. Those Rules Are Set Forth In OAR 952-001-0010 Through OAR 952-001-0090. You May Obtain Copies Of The Rules By Calling The Center. (Note: The Telephone Number For The Oregon Utility Center Is (503) 232-1987.)

- ① Sta. "C" 33+05.00 to Sta. "C" 34+05.00 Lt. Const. Water Quality Biofiltration Swale no. 00895  
Gen. exc. - 22 cu. yd.  
Water quality soil mix - 22 cu. yd.
- ② Sta. "C" 32+80.00 to Sta. "C" 33+80.00 Rt. Const. Water Quality Biofiltration Swale no. 00896  
Gen. exc. - 22 cu. yd.  
Water quality soil mix - 22 cu. yd.
- ③ Sta. "C" 35+70.00 to Sta. "C" 36+70.00 Lt. Const. Water Quality Biofiltration Swale no. 00897  
Gen. exc. - 22 cu. yd.  
Water quality soil mix - 22 cu. yd.
- ④ Sta. "C" 36+79.85 to Sta. "C" 37+99.84 Lt. Const. Water Quality Biofiltration Swale no. 01201  
Gen. exc. - 43 cu. yd.  
Water quality soil mix - 43 cu. yd.
- ⑤ Inst. stormwater facility marker (See dwg. RD3399)

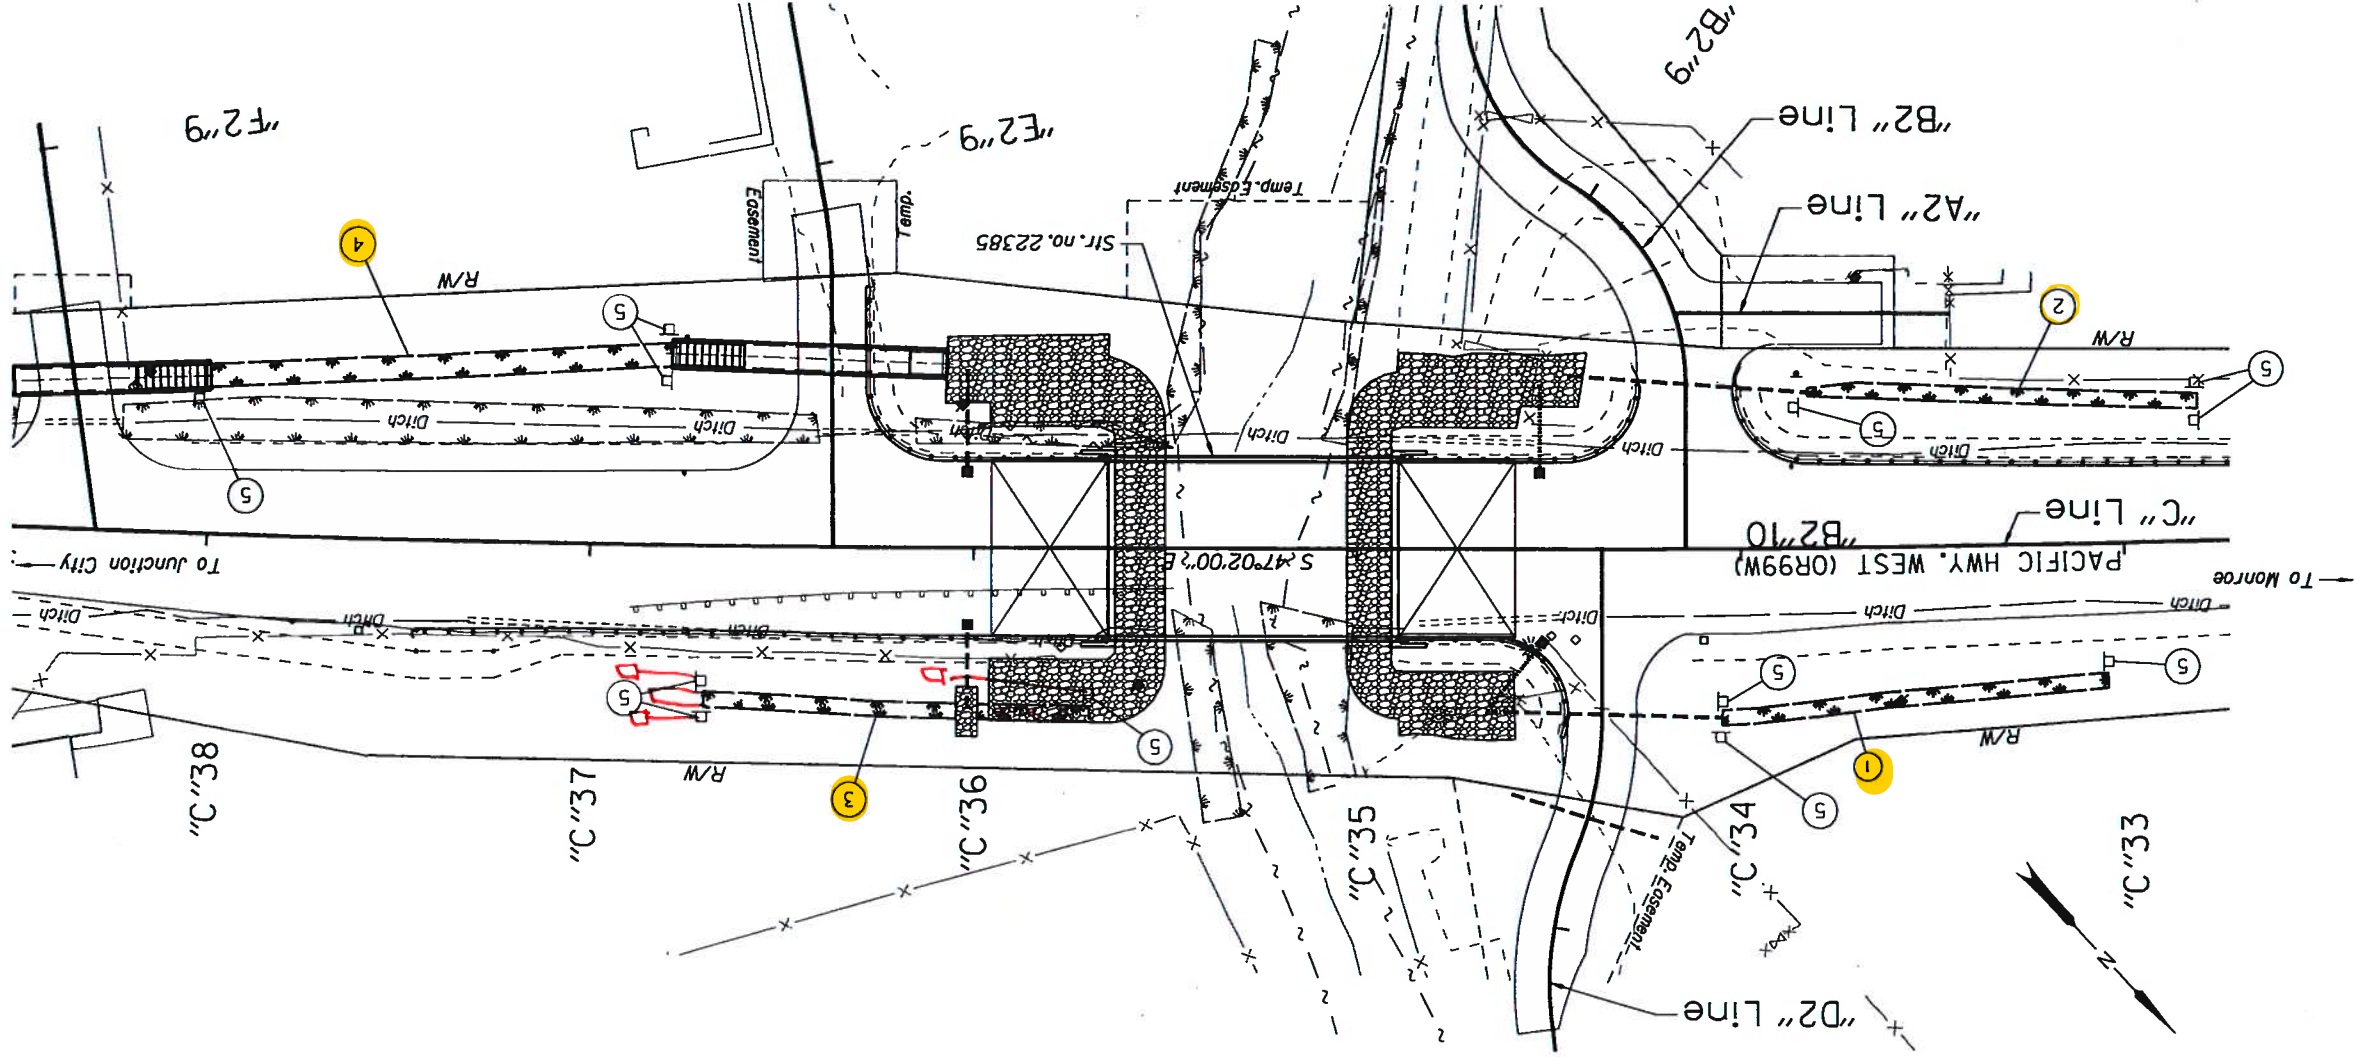


REVISED AS CONSTRUCTED

STEVEN SCHULTZ, PE

*[Signature]*

DATE 01/27/18

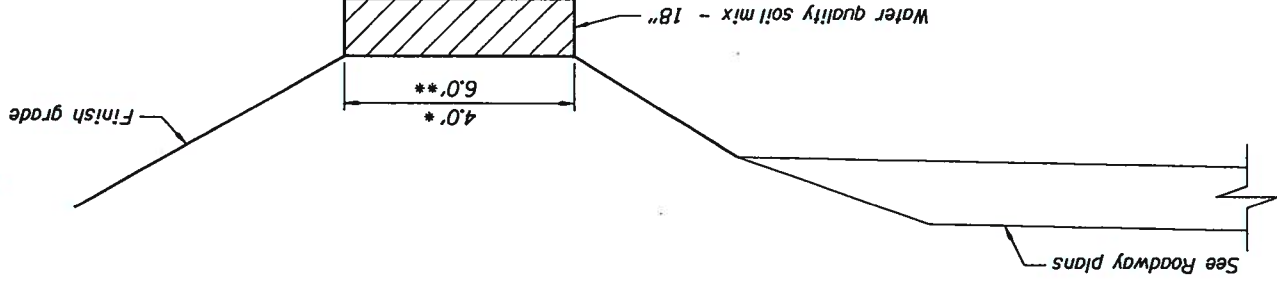

Pay Limits of Water Quality Biofiltration Swale General Excavation

\* STD. "C" 33+05.00 TO STD. "C" 34+05.00  
 "C" 32+80.00 TO "C" 33+80.00  
 "C" 35+70.00 TO "C" 36+70.00  
 "C" 36+79.85 TO "C" 37+99.84

OREGON DEPARTMENT OF TRANSPORTATION

REGION 2 TECH CENTER

OR99W: LAKE SLOUGH BRIDGE REPLACEMENT SEC.

BENTON COUNTY


Reviewed By - Bruce Carmichael

Designed By - Chris Carman

Drafted By - Julie Rentz

STORMWATER PLAN

SHEET NO. GJ

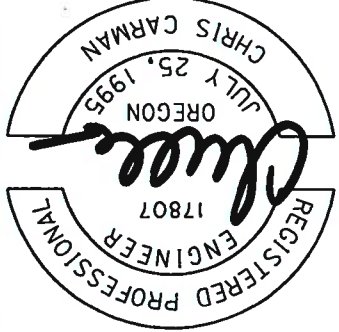

RENEWS: 12-31-2017

**OREGON DEPARTMENT OF TRANSPORTATION**

**REGION 2 TECH CENTER**

OR99W: LAKE SLOUGH BRIDGE REPLACEMENT SEC.  
BENTON COUNTY  
PACIFIC HIGHWAY WEST

Reviewed By - John Lucas  
Designed By - Sara Geddes  
Drafted By - Julie Rentz


**ROADSIDE DEVELOPMENT PLAN**

SHEET NO. GN

REGISTERED LANDSCAPE ARCHITECT

SARA GEDDES  
OREGON  
4/14/94  
316

RENEWS: 04/30/2017

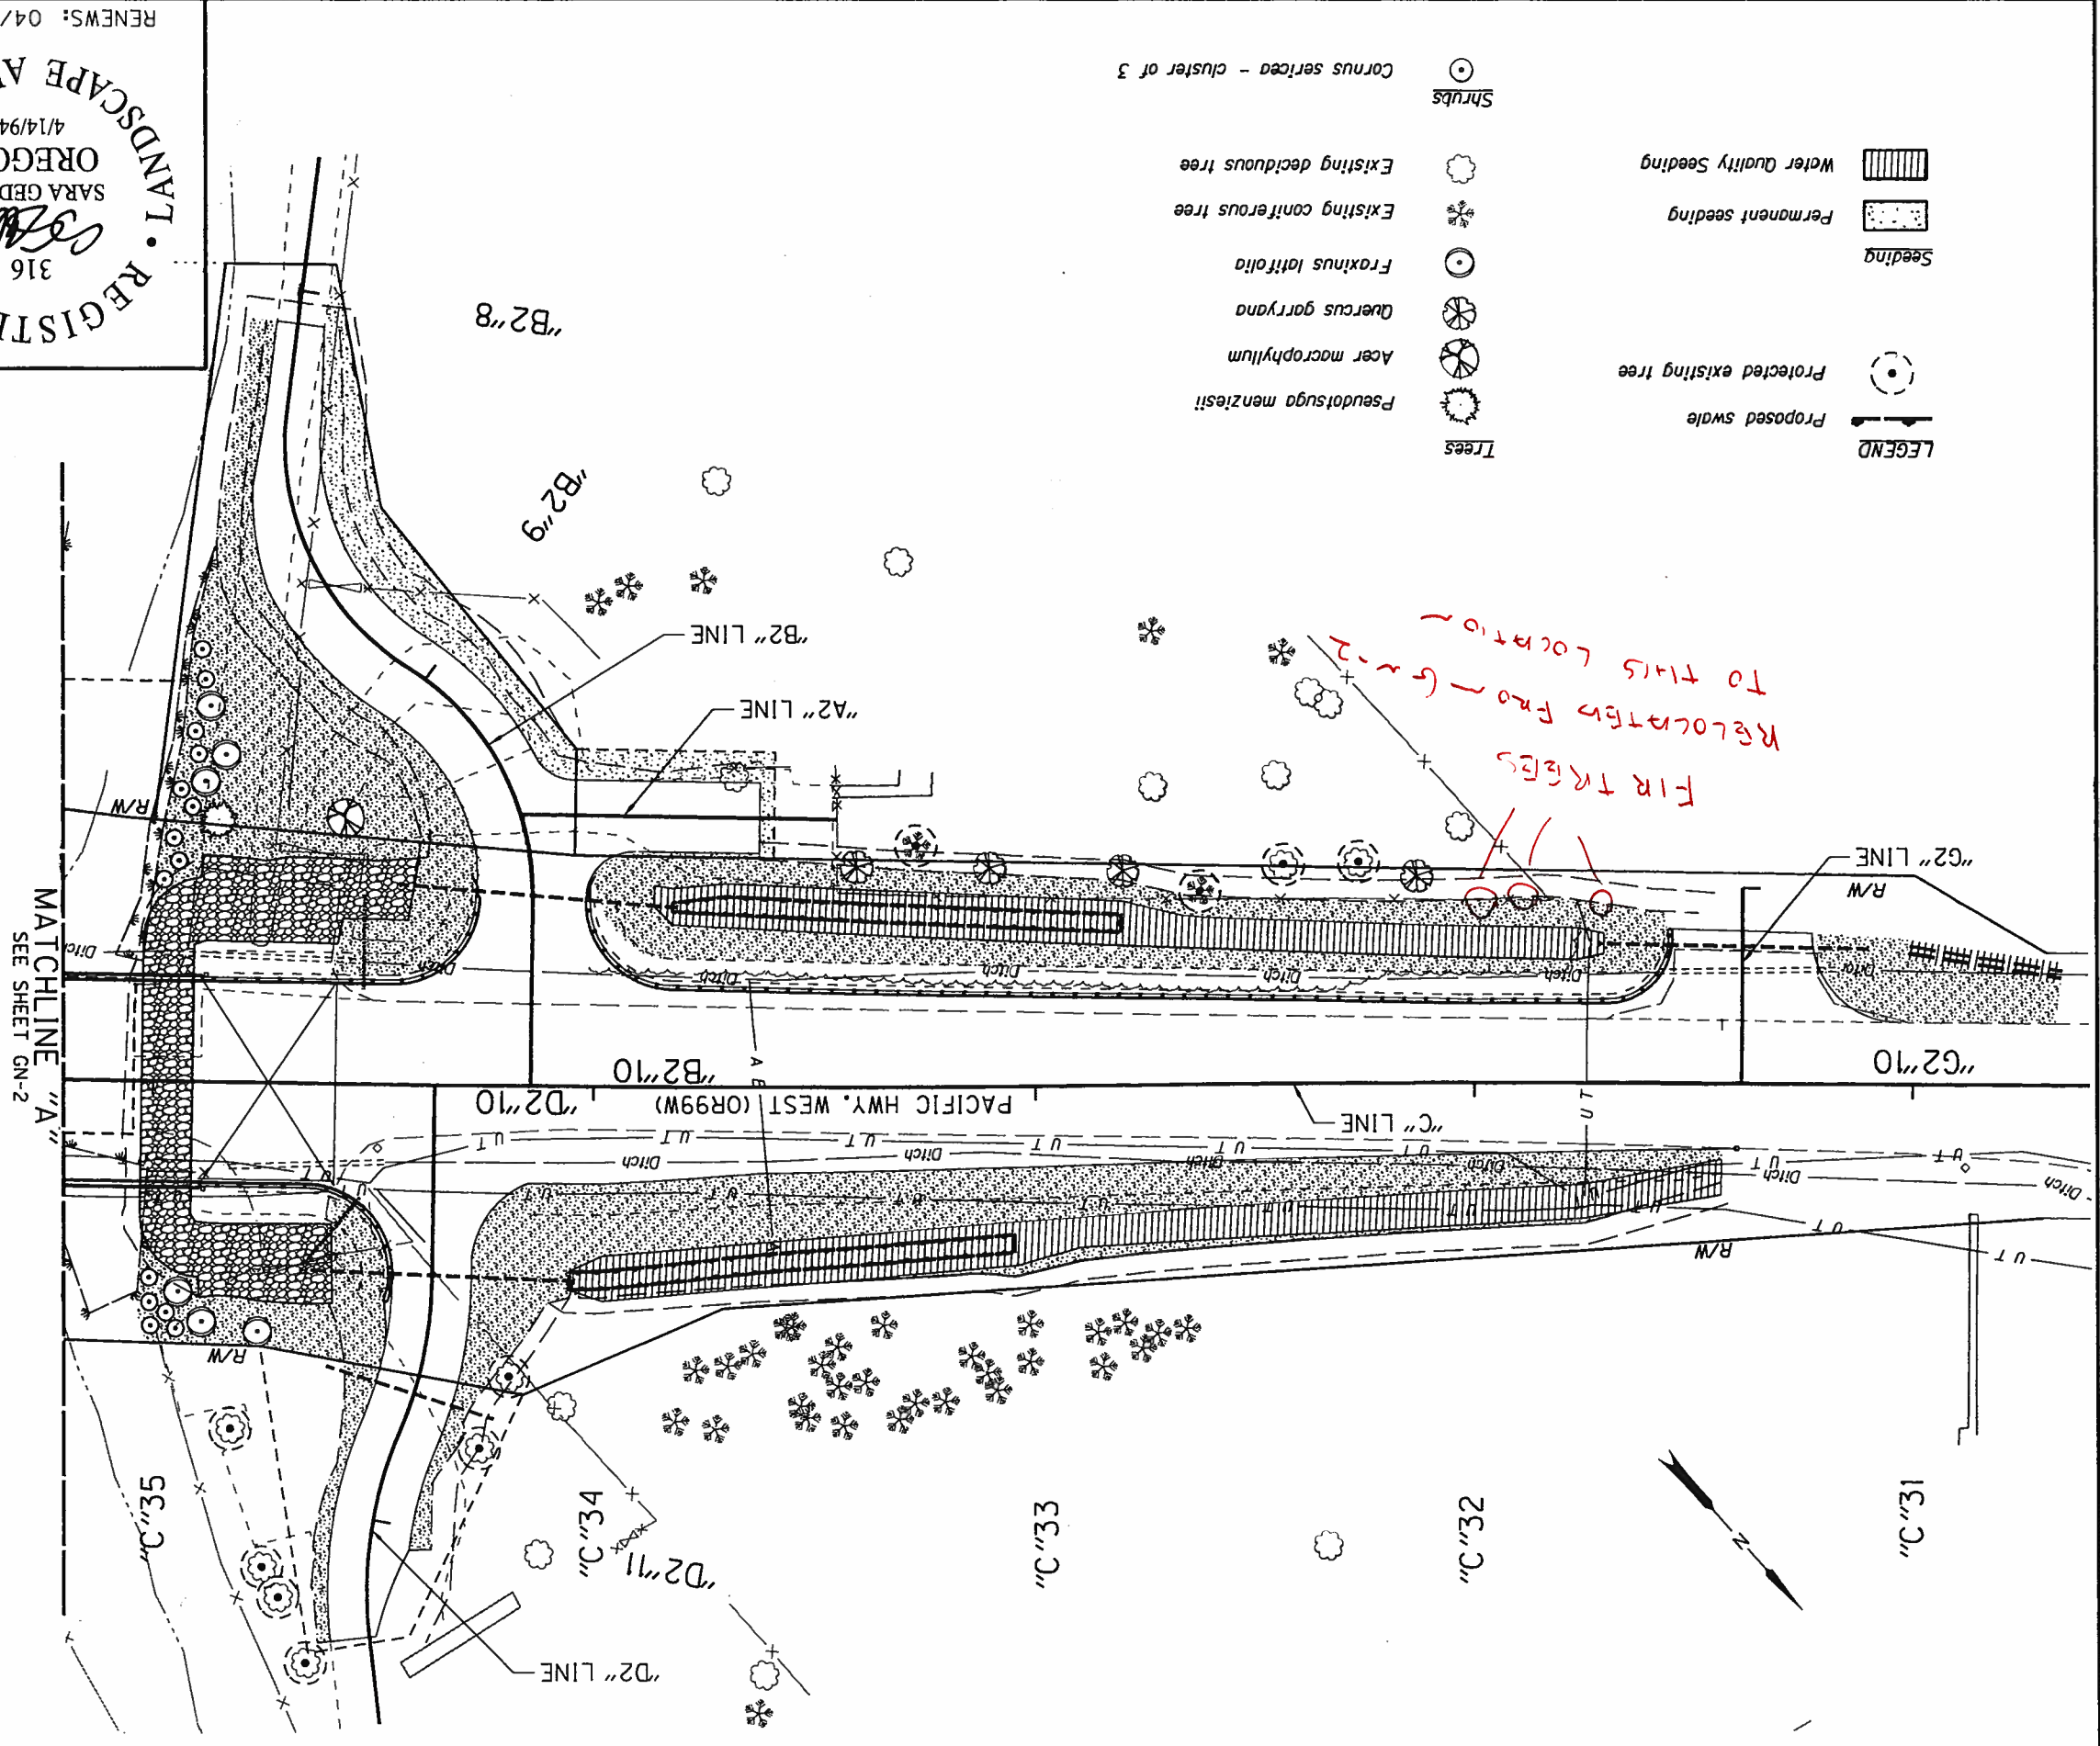

REVISAS AS CONSTRUCTED

*[Signature]*

STEVEN SCHULTZ, PE

DATE 01/22/18





OREGON DEPARTMENT OF TRANSPORTATION

REGION 2 TECH CENTER

OR99W: LAKE SLOUGH BRIDGE REPLACEMENT SEC.

PACIFIC HIGHWAY WEST BENTON COUNTY

Reviewed By - John Lucas

Designed By - Sara Geddes

Drafted By - Julie Rentz

ROADSIDE DEVELOPMENT PLAN

GN-2 SHEET NO.

REGISTERED LANDSCAPE ARCHITECT

316


SARA GEDDES OREGON

4/14/94

RENEWS: 04/30/2017

Rotation: 0° Scale: 1"=40'

\\SCDATA\2610drr\working\Projects\18565-Lake\_Slough\Plans\Julie\18565-pl.plt :: Default.lto480 8/3/2016 4:30:47 PM hwy31g

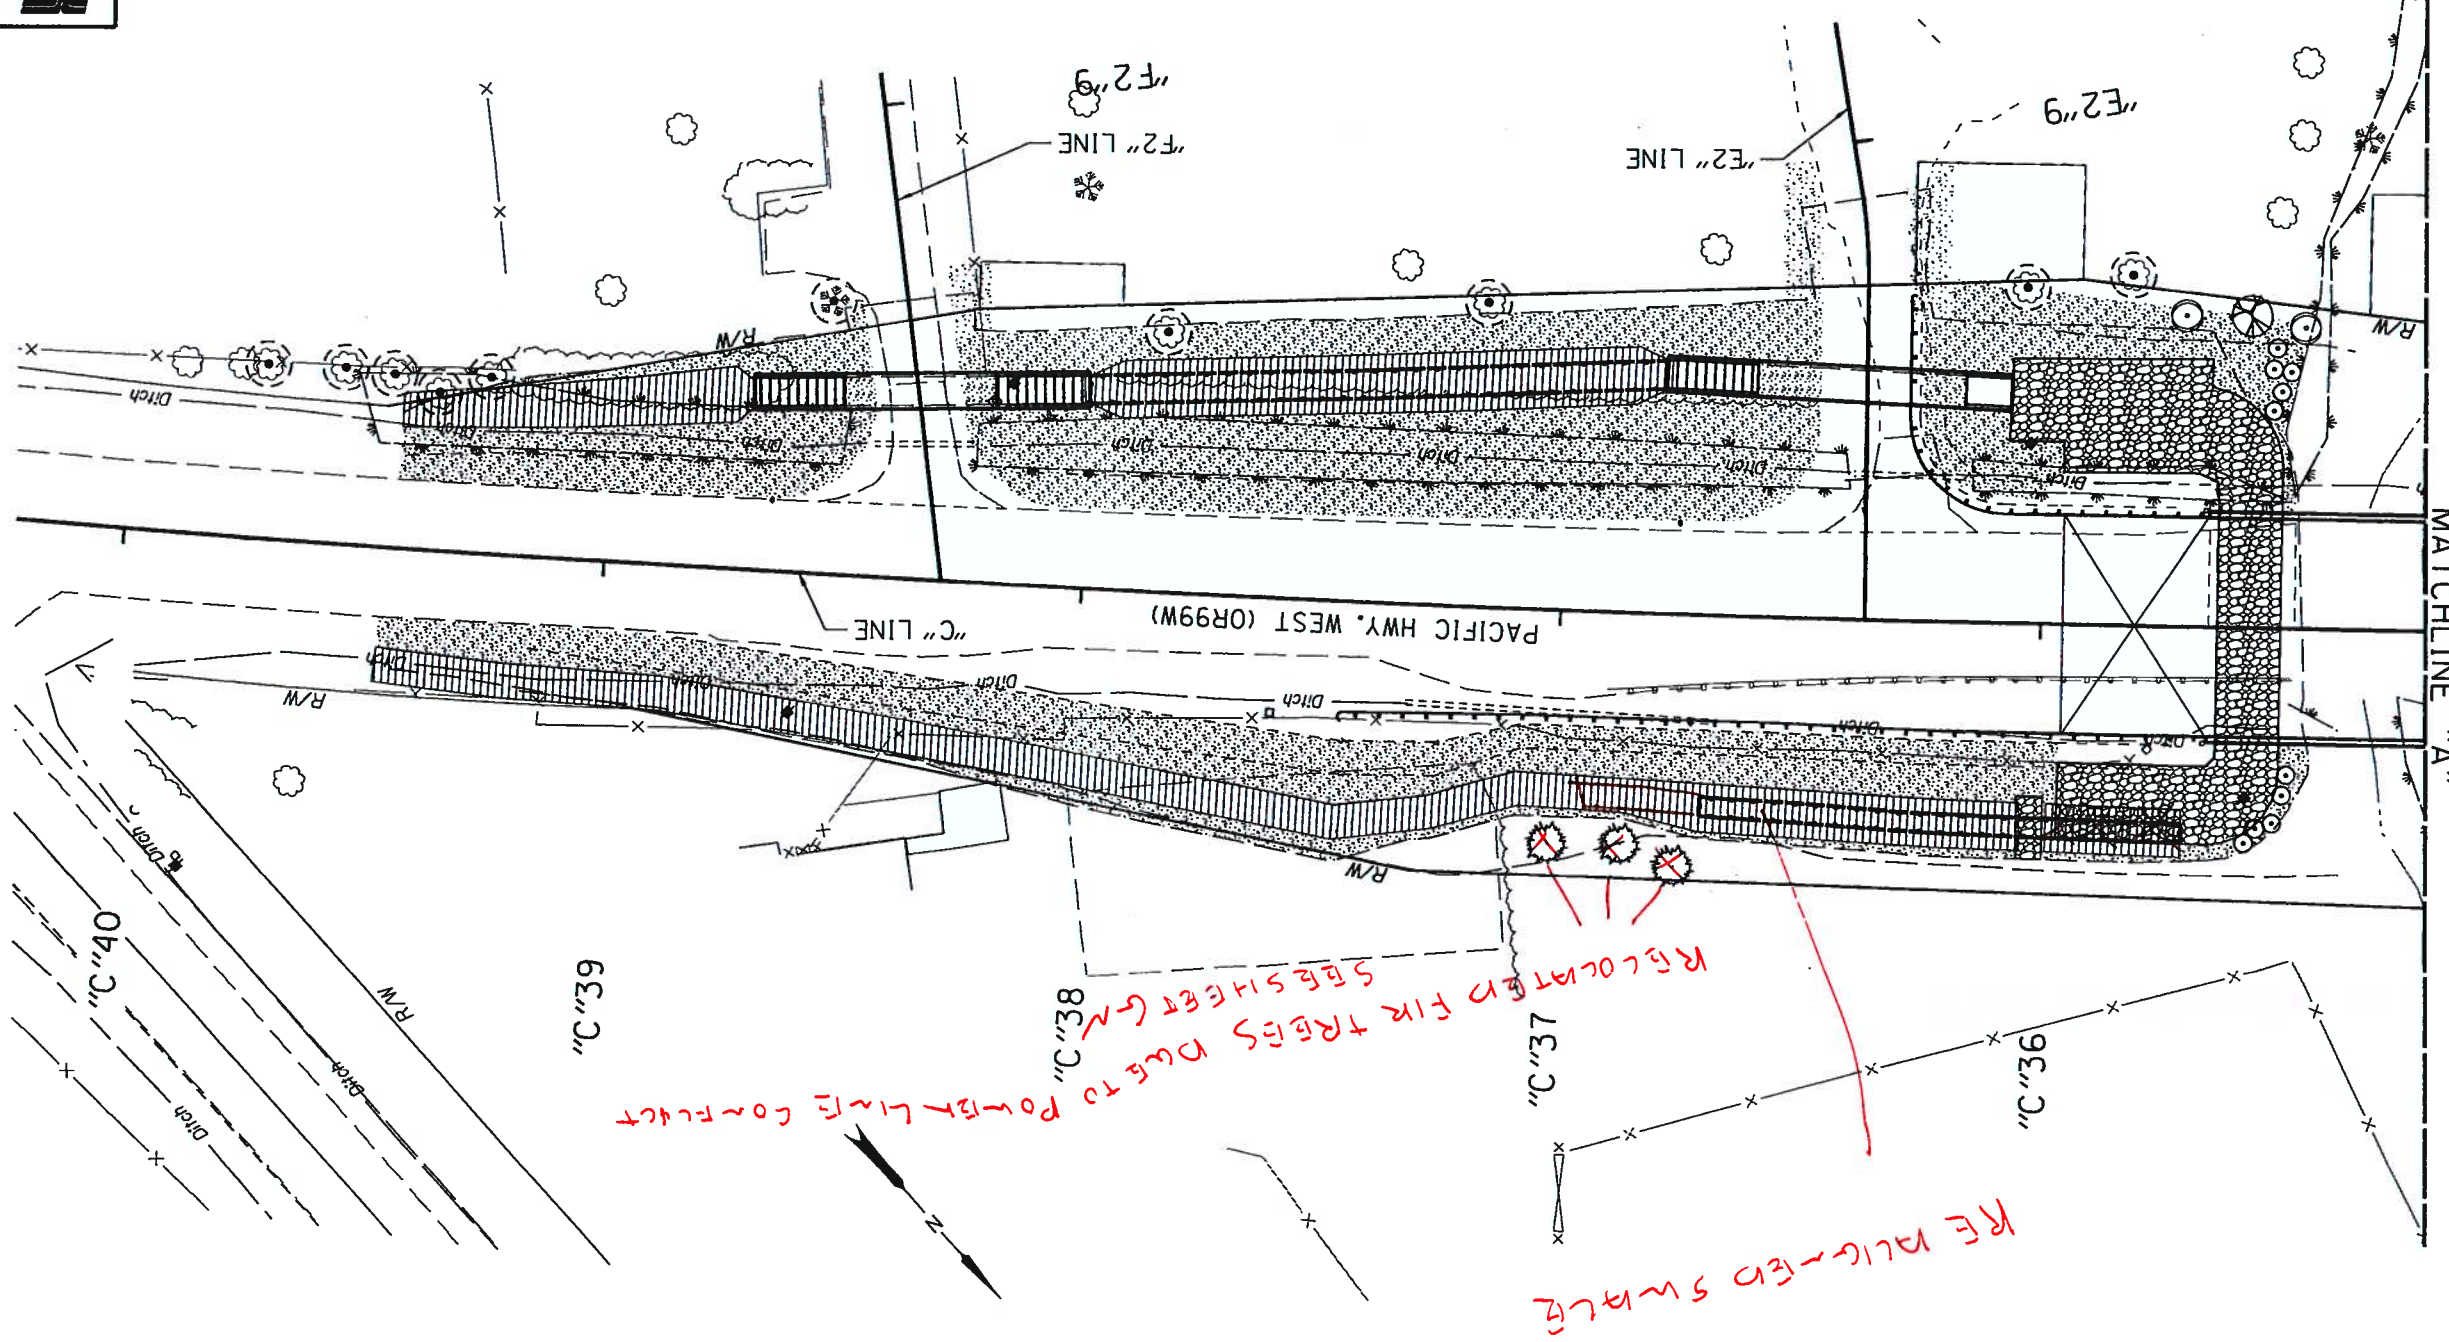

REVISAS AS CONSTRUCTED

STEVEN SCHULTZ PE

DATE 01/22/18

- LEGEND
- Proposed swale
  - Protect existing tree
  - Seeding
  - Permanent seeding
  - Water Quality Seeding
  - Trees
  - Pseudotsuga menziesii
  - Acer macrophyllum
  - Fraxinus latifolia
  - Existing coniferous tree
  - Existing deciduous tree
  - Shrubs
  - Cornus sericea - cluster of 3

PLANTING & SEEDING SCHEDULE


BOTANICAL NAME	COMMON NAME	SIZE	ROOT TYPE	PLANT CONDITION	LAYOUT/SPACING	A.S.N.S. Specifications	NOTES	TOTAL AREA (sq. ft.)	QUANTITY TOTAL
Acer macrophyllum	bigleaf maple	1" caliper	# 5 container	single trunk	as shown on plan	1.2.1	see detail		2
Cornus sericea	red twig dogwood	1/2" caliper	live stake		as shown on plan		see detail		72
Raxinus latifolia	Oregon Ash	1" caliper	# 5 container	single trunk	as shown on plan	1.2.1	see detail		8
Pseudotsuga menziesii	Douglas fir	4"	# 5 container	single trunk	as shown on plan	3.2.4	see detail		4
Quercus garryana	Oregon white oak	1" caliper	# 5 container	single trunk	as shown on plan	1.2.1	see detail		4
Total in Area									
90									
Seeding									
Permanent Seeding			pure live seed	as shown on plan and all disturbed areas	N/A		see detail	26,571	
Water Quality Seeding			pure live seed	as shown on plan	N/A		see detail	9,147	
Seeding Totals (square feet)									35,718

**REVISÉD AS CONSTRUCTED**

STEVEN SCHULTZ, PE

DATE: 01/27/18

- General Planting Notes:**
1. Ensure trees are planted beyond "Clear Zone". Verify with Project Manager prior to planting.
  2. Locate underground utility lines prior to any digging or ground disturbance.
  3. Adjust planting locations as necessary with agency approval so vegetation does not conflict with above or below-ground utilities.
  4. Adjust planting locations as necessary with agency approval to avoid conflict with utilities, traffic sight lines, signs or other appurtenances. See American Standard for Nursery Stock (2004) for plant quality minimum standards, such as size of root ball/mass, caliper of trunk, or height.
  5. All dimensions shown on plan are minimum dimensions. See Planting and Seeding Schedule for listing of plant and seed materials - names, sizes, and quantities.
  6. Plan is schematic. Planting may be adjusted to fit site conditions with prior agency approval.
  7. Where discrepancies exist between the Planting Schedule and the Plans, the Plans will prevail.
  8. Tree and shrub backfill must be free of noxious weeds, weed seed, and State listed noxious plants.
  9. Do not apply fertilizer to plants unless indicated in plans and special provisions.
  10. Lay out plant materials in groups as indicated on schedule, details, and plan sheets.
  11. Stake tree locations and obtain approval of agency prior to planting. Use color-coded stakes as necessary to identify species.
  12. Obtain agency approval of plant materials prior to planting.
  13. Provide a demonstration of tree/shrub/plug/live stake planting to agency prior to installation of plant materials.
  14. All plant material shall be thoroughly watered (saturated backfill) within 24-hours of installation regardless of rainfall events.
  15. Protect and avoid damage to root zones, limbs, and foliage of existing trees and shrubs to remain while completing work of this contract. Where indicated for protection on plans, provide orange mesh construction fencing at drip-line.
  16. Contractor shall comply with erosion control measures per Section 00280 and all applicable permits during construction.
  17. Contractor shall comply with the terms and conditions from NOAA-Fisheries under Standard Local Operating Procedures for Endangered Species (SLOPES) requiring the utmost care when construction activity is taking place in or near water.
  18. All work shall comply with Oregon Standard Specifications for Construction and Special Provisions for construction applicable to this project.

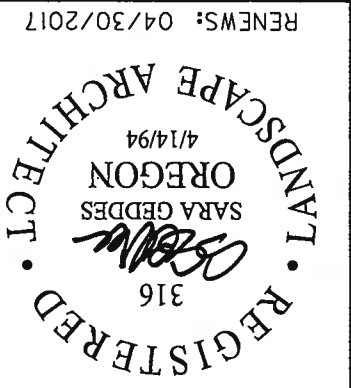

RENEWS: 04/30/2017

**OREGON DEPARTMENT OF TRANSPORTATION**

**REGION 2 TECH CENTER**

**OR99W: LAKE SLOUGH BRIDGE REPLACEMENT SEC.**  
PACIFIC HIGHWAY WEST  
BENTON COUNTY

Reviewed By -  
Designed By - Sara Geddes  
Drafted By - Sergey Chernishovff

**NOTES & SCHEDULES**

SHEET NO. GN-3