

OPERATION & MAINTENANCE MANUAL

Water Quality Biofiltration Swale

Manual prepared: March 2019

DFI No. D01225



Figure 1: DFI No. D01225, looking southeast

Identification

Drainage Facility ID (DFI): D01225
Facility Type: Water Quality Biofiltration Swale
Construction Drawings: (V-File Numbers) 43V-121
Location: District: 2B
Highway No.: 1
Mile Post: 298.82-298.86, right

1. Manual Purpose

The purpose of this manual is to outline inspection needs and summarize maintenance actions.

2. Facility Location

The location map below details the facility location. The highway, mile posts, side streets, access location, and stormwater flow directions are noted on the map.

Facility location type: Shoulder/Off ramp

Flow direction: north

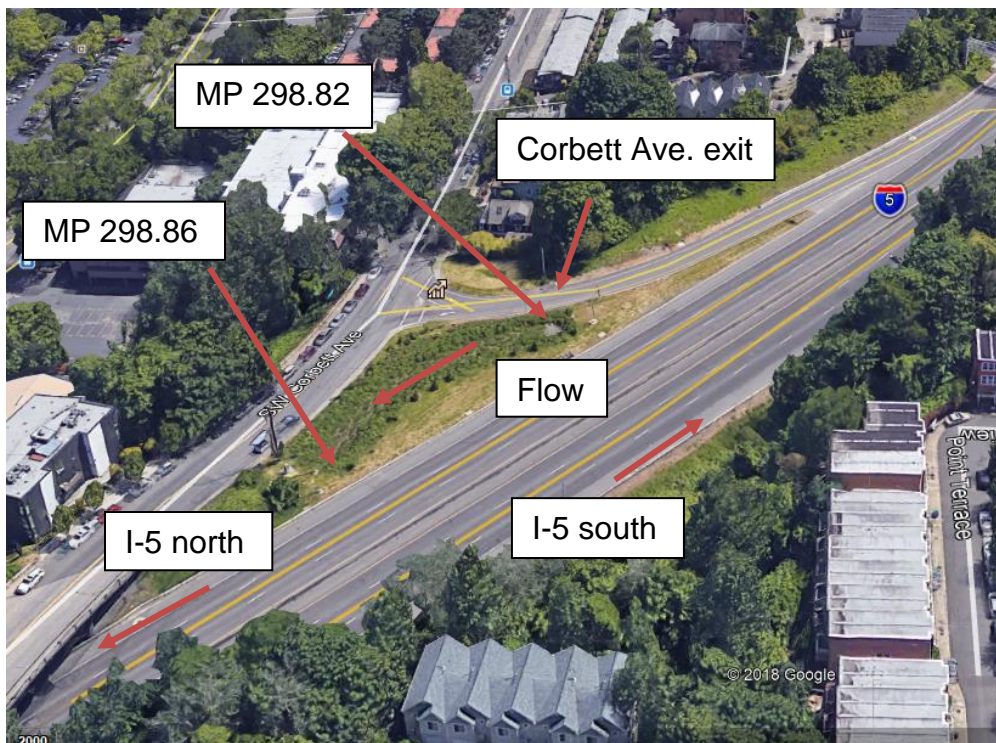



Figure 2: Facility location

3. Facility Summary

The length and width of a swale is based on the bottom dimensions.

The bottom length and bottom width of the swale is:


Bottom Length (feet)	Bottom Width (feet)
172	15

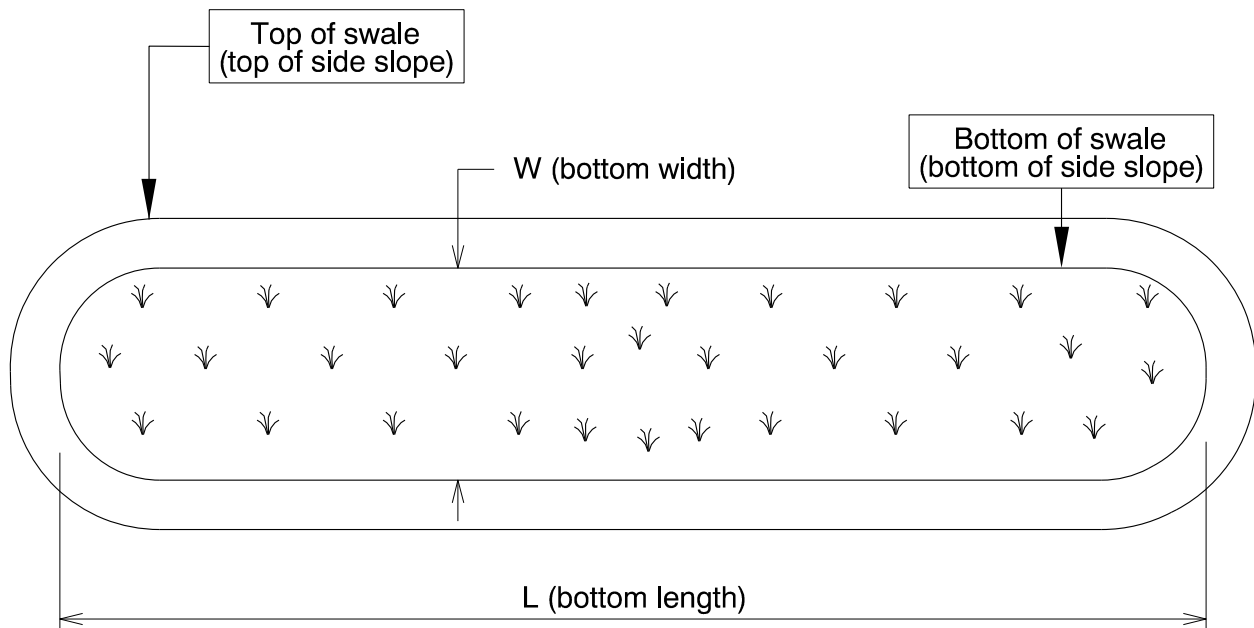

The depth of the swale is the vertical distance measured from the bottom of the swale to the top. The slope of the swale sides is presented by a vertical distance (rise) followed by the horizontal distance (run).

Depth and side slopes:

Depth (feet)	Rise (feet)	Run (feet)
3	1	3

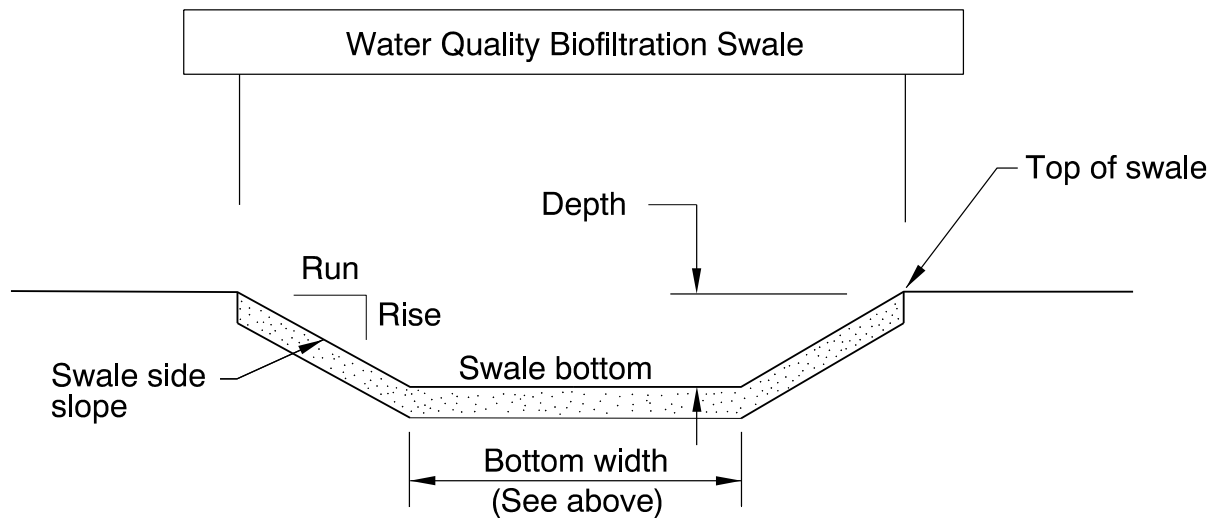

Site Specific Information: Access to the facility is a shoulder in the gore area. This area is accessible from either the shoulder on I-5 or by taking the Corbett Ave. northbound exit. The facility has a diversion manhole and a pollution control manhole upstream from the swale. There are numerous trees and plantings within the maintenance area.

4. Facility Access

Maintenance access to the facility:

<input type="checkbox"/> Roadside pad	<input checked="" type="checkbox"/> Roadside shoulder
<input type="checkbox"/> Access road with Gate	<input type="checkbox"/> Access road without Gate

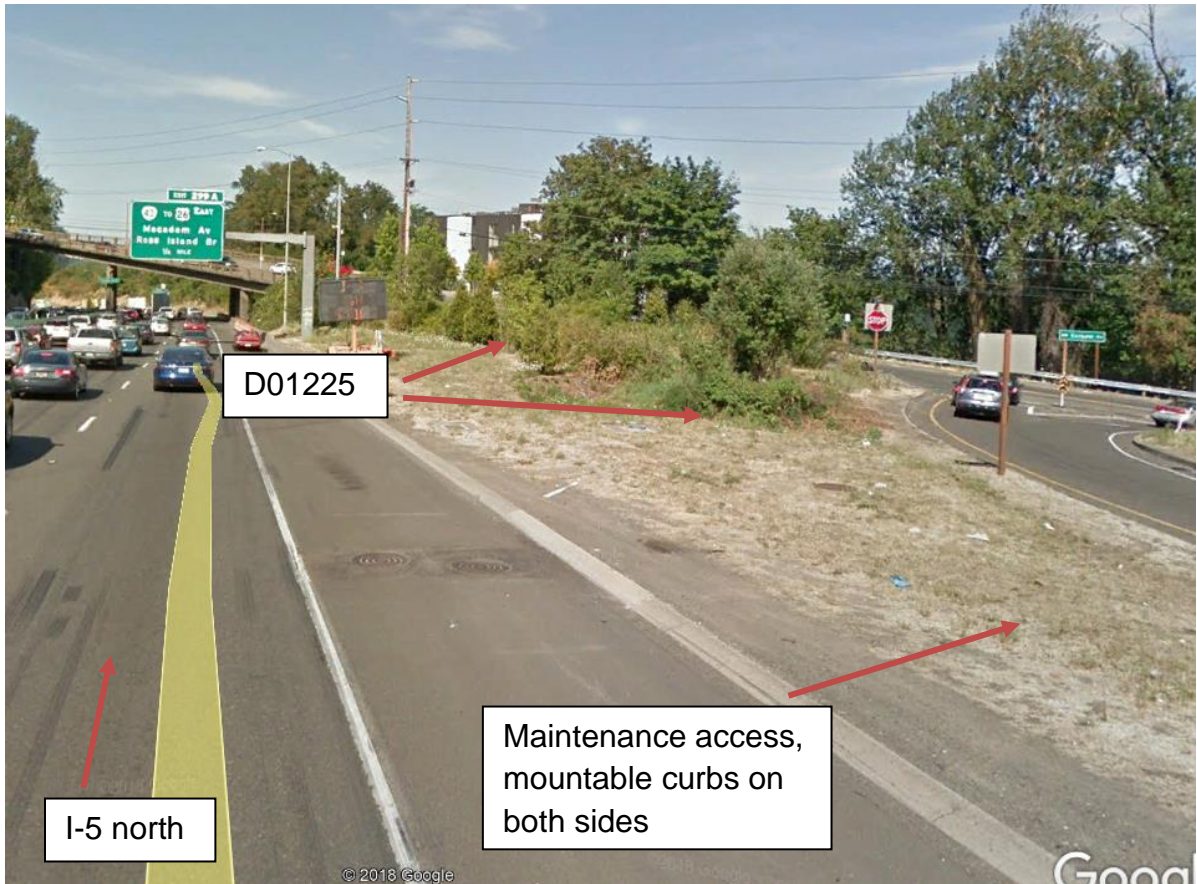


Figure 3: Maintenance access

5. Operational Components / Maintenance Items

Classification

This facility is classified as an:

<input type="checkbox"/> On-line Swale	<input checked="" type="checkbox"/> Off-line Swale
A swale that does not include a high flow bypass component; flow drains into and through the facility	A swale that treats low/small flows and diverts high flows using a bypass component

Bypass Component

This facility includes a high flow bypass component:

<input type="checkbox"/> No	<input checked="" type="checkbox"/> Yes
There is no bypass component. High flows drains into and through the facility	There is a bypass component. Only low/small flows drain into the swale. High flows are diverted around the swale using a bypass component

Operational Components

A swale has many components that assist with treatment, conveyance, and reducing flow velocity to minimize erosion. The components in use can vary depending if the facility was designed to operate on-line or off-line. The facility components table (**Table 1**) has been provided to highlight the applicable components for this facility. The component is in use when the box contains an “x” (e.g.).

The Standard Operation Manual for Water Quality Biofiltration Swales (implemented March 2017) outlines facility operation, typical footprint configuration, and component definitions and details. A link to the manual is attached to the feature marker in TransGIS.

<https://gis.odot.state.or.us/TransGIS/>

Operational Plan

The applicable standard operational plan for this facility is:

<input type="checkbox"/> Operational Plan A	<input type="checkbox"/> Operational Plan B	<input checked="" type="checkbox"/> Operational Plan C
An on-line swale with roadside ditches	An on-line swale with piped inlets and outlets	An off-line swale with a piped high flow bypass
A standard operational plan illustrates the general facility footprint configuration and explains the purpose of each facility component. Operational plans (A, B, C) are provided in the Standard Operation Manual.		

See Appendix A for the site specific operational plan.

Maintenance Items

Operational components marked in **Table 1** should be inspected and maintained according to Section 7. Each facility component is defined and detailed in the Standard Operation Manual using the associated ID number indicated below.

Table 1: Swale Components		ID #
Manholes/Structures		
Pre-treatment manhole	<input checked="" type="checkbox"/>	S1
Weir type flow splitter/flow splitter manhole	<input checked="" type="checkbox"/>	S2
Orifice type flow splitter/flow splitter manhole	<input type="checkbox"/>	S3
Standard manhole	<input type="checkbox"/>	S4
Swale Inlet		
Pavement sheet flow	<input type="checkbox"/>	S5
Inlet Pipe (s)	<input checked="" type="checkbox"/>	S6
Open channel inlet	<input type="checkbox"/>	S7
Riprap pad	<input type="checkbox"/>	S8
Ground Cover		
Grass bottom	<input checked="" type="checkbox"/>	S9
Grass side slopes	<input checked="" type="checkbox"/>	S10
Granular drain rock	<input checked="" type="checkbox"/>	S11
Plantings	<input checked="" type="checkbox"/>	S12
Underground Components		
Geotextile fabric	<input checked="" type="checkbox"/>	S13
Water quality mix	<input checked="" type="checkbox"/>	S14
Perforated pipe	<input checked="" type="checkbox"/>	S15
Porous pavers (access grid)	<input type="checkbox"/>	S16
Flow Spreader		
Rock basin (used at inlet)	<input checked="" type="checkbox"/>	S17
Anchored board (one board installed in flow spreader)	<input checked="" type="checkbox"/>	S18
Other:	<input type="checkbox"/>	S19
Swale Outlet		
Catch basin with grate	<input type="checkbox"/>	S20
Outlet Pipe (s)	<input checked="" type="checkbox"/>	S21
Open channel outlet	<input type="checkbox"/>	S22
Auxiliary Outlet:	<input type="checkbox"/>	S23
Outfall Type		
Waterbody (Creek/Lake/Ocean)	<input type="checkbox"/> C <input type="checkbox"/> L <input type="checkbox"/> O	S24
Ditch	<input type="checkbox"/>	S25
Storm drain system	<input checked="" type="checkbox"/>	S26
Outfall Components		
Riprap pad	<input type="checkbox"/>	S27
Riprap bank protection	<input type="checkbox"/>	S28

6. Maintenance

Maintenance Frequency/Maintain Records

- a. Inspect annually. Preferably prior to the rainy season.
- b. Clean and maintain as necessary. Refer to Activity 125 for conditions when maintenance is needed.
- c. Keep a record of inspections, maintenance, and repairs.

Maintenance Guide/Maintenance Actions

The ODOT Routine Road Maintenance Water Quality and Habitat Guide (the *Blue Book*) outlines the standard maintenance actions for water quality facilities under Activity 125.

There are standard maintenance tables for standard ODOT designs. The maintenance tables describe the maintenance component, the defect or problem, the condition when maintenance is needed, and the recommended maintenance to correct the problem. Use the following tables to maintain ODOT swales:

- Table 1 (General Maintenance): Contains general maintenance and inspection guidelines that are applicable to all ODOT water quality facilities
- Table 3 (Maintenance of Water Quality or Biofiltration Swales): Contains maintenance information for swales

The *Blue Book* can be viewed at the following website:

http://www.oregon.gov/ODOT/Maintenance/Documents/blue_book.pdf

7. Limitations

Access grid installed:

<input checked="" type="checkbox"/> No	<input type="checkbox"/> Yes
There are no duty porous pavers installed in this swale	

Swales are designed to allow equipment access along the bottom. If an access grid is **NOT** installed, vehicles entering the swale can create depressions (tire ruts), damage vegetation, and damage structural components (e.g. flow spreaders). These conditions may result in poor treatment and drainage performance.

Equipment wheels should be kept on the tops and side slopes. Mower arms may be run along the swale bottom.

8. Waste Material Handling

Material removed from the facility is defined as waste by the Department of Environmental Quality (DEQ). Refer to the roadwaste section of the ODOT Maintenance Yard Environmental Management System (EMS) Policy and Procedures Manual for disposal options:

http://www.oregon.gov/ODOT/Maintenance/Documents/ems_manual.pdf


Contact any of the following for more detailed information about management of waste materials found on site:

ODOT Clean Water Unit	(503) 986-3008
ODOT Statewide Hazmat Coordinator	(503) 667-7442
ODOT Region 1 Hazmat Coordinator	(503) 731-8290
ODOT Region 2 Hazmat Coordinator	(503) 986-2647
ODOT Region 3 Hazmat Coordinator	(541) 957-3594
ODOT Region 4 Hazmat Coordinator	(541) 388-6186
ODOT Region 5 Hazmat Coordinator	(541) 963-1590
ODEQ Northwest Region Office	(503) 229-5263


A Appendix A – Site Specific Operational Plan

Contents:


Operational Plan: DFI D01225

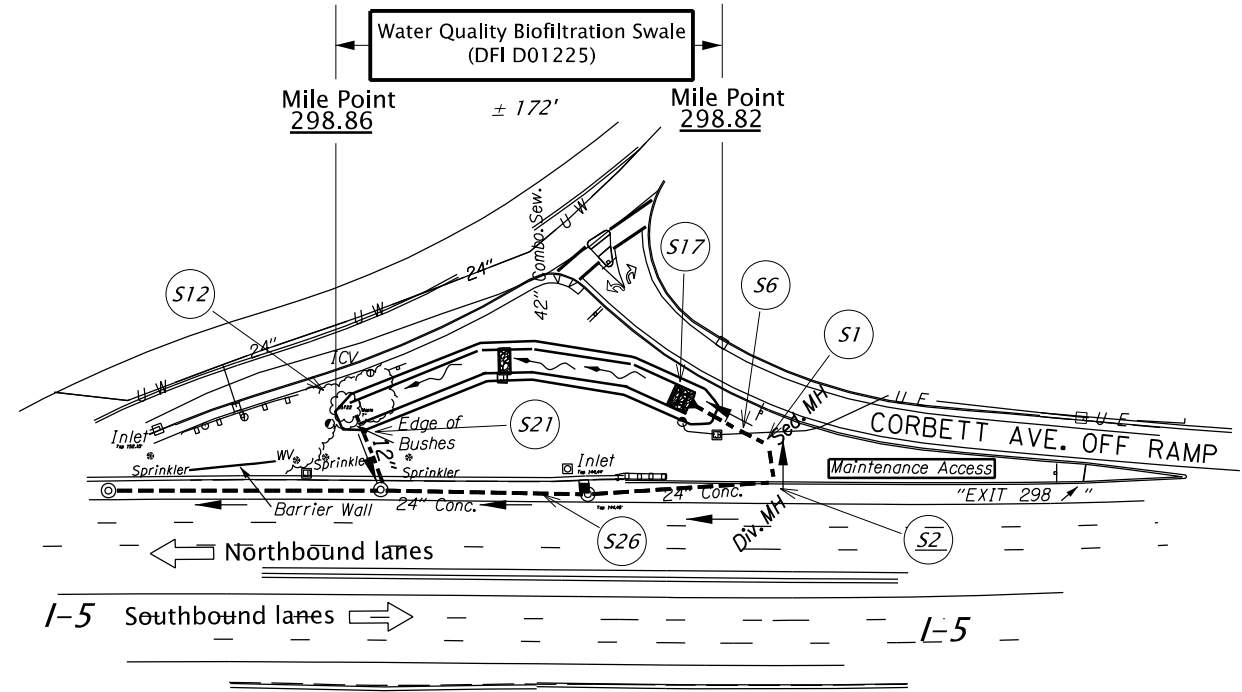

PLAN
N.T.S.

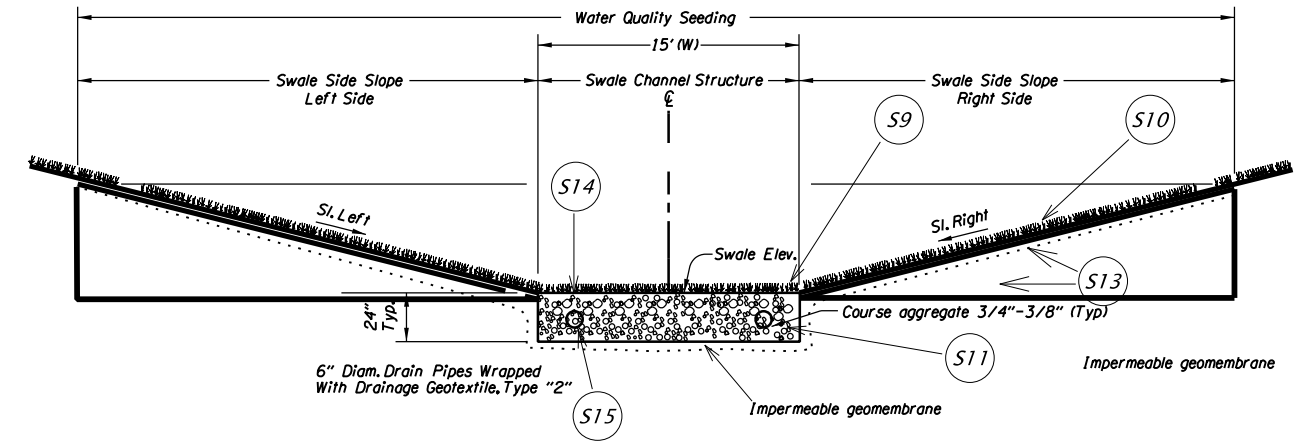


SECTION A-A
N.T.S.

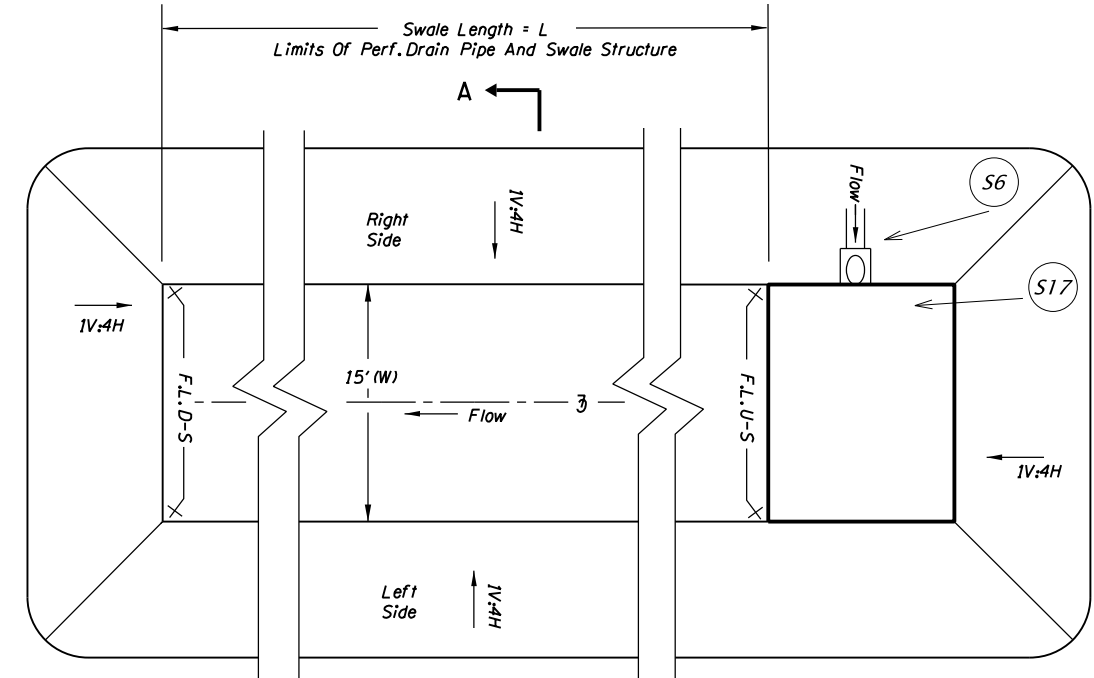

PLAN
N.T.S.

- LEGEND:**
- X# Facility Component (see table 1 in O&M Manual)
 - or ⊙ Manhole
 - or □ Inlet
 - Storm Pipe (Facility)
 - Storm Pipe
 - ← Conveyance Direction
 - Pavement / Facility Flow Path
 - ⇐ Traffic Flow Direction

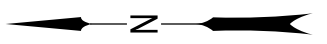


Sht. 01 of 02

Prepared By:
Laila Bush


Drafted By:
Laila Bush

DFI D01225
MAINTENANCE DISTRICT 2B HWY 1
BIOFILTRATION SWALE
 HIGHWAY MP 298.82 - 298.86
 MULTNOMAH


WATER QUALITY SWALE FLOW SPREADER

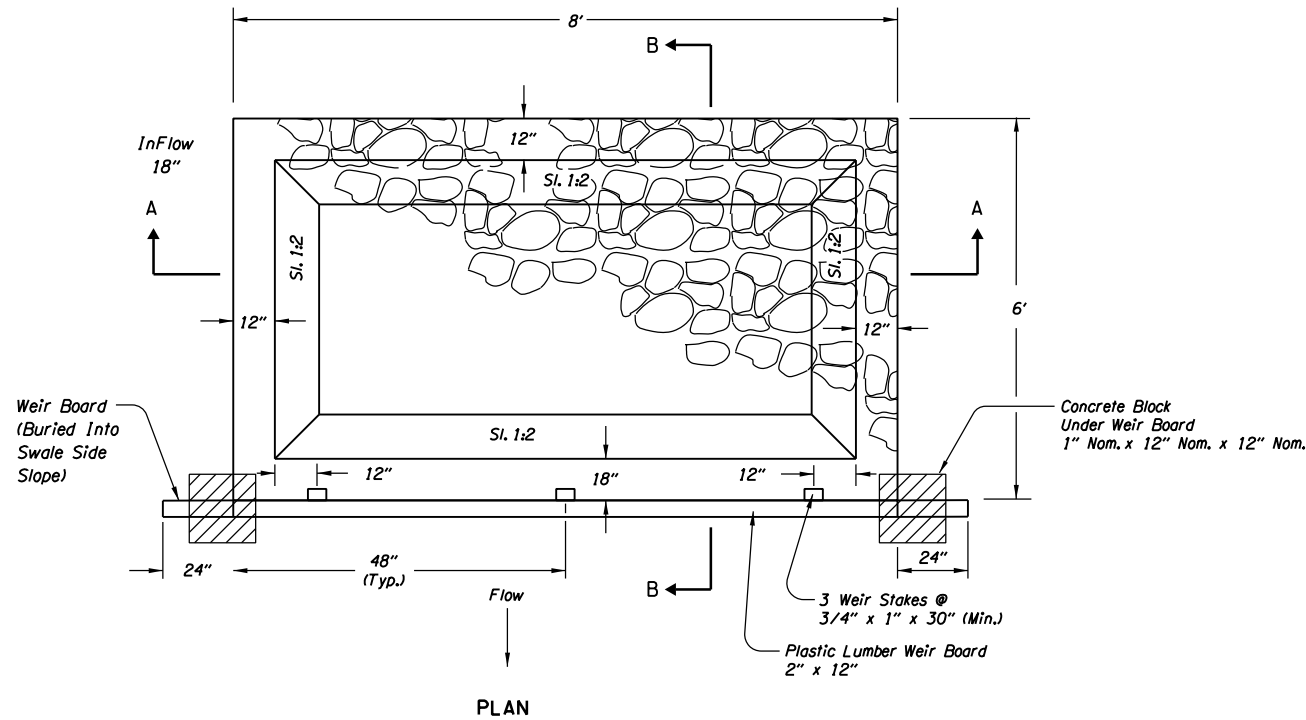

PLAN

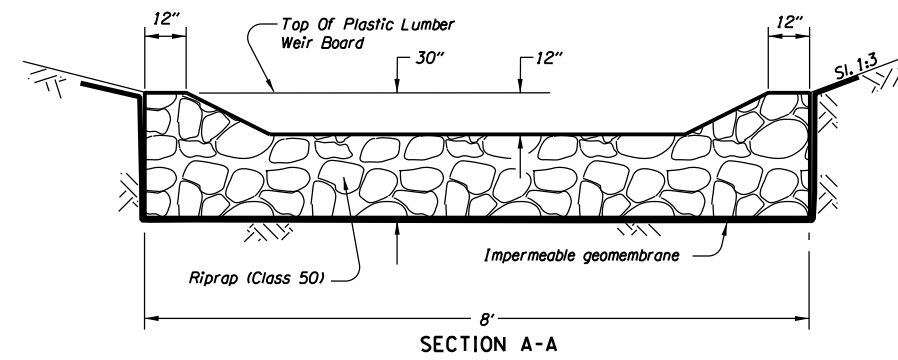


SECTION A-A

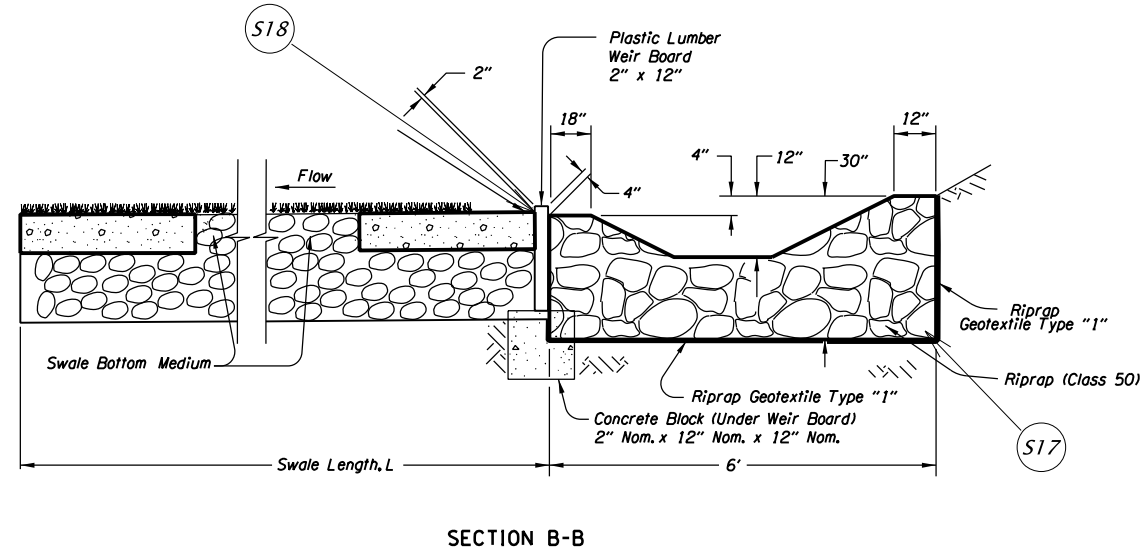


SECTION B-B


DIVERSION MANHOLE "HIGH-LOW", LOW FLOW TO SIDE

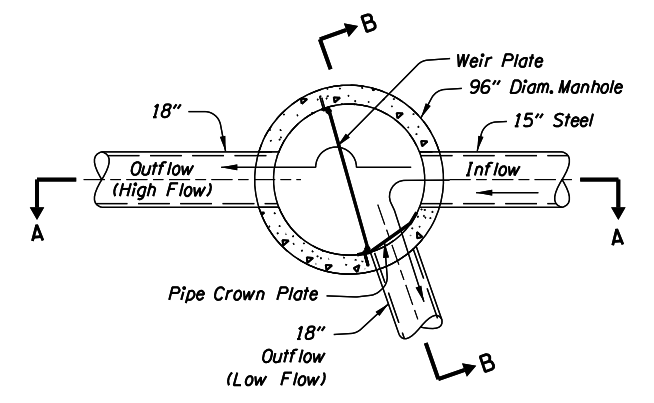

PLAN

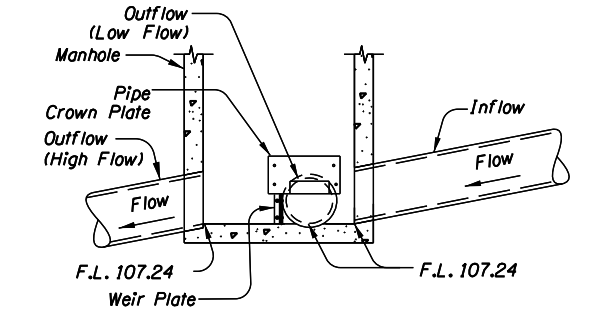


SECTION A-A

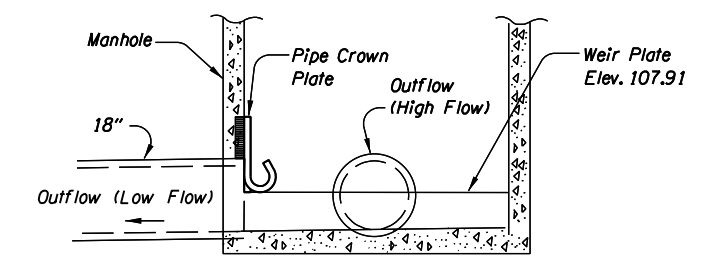

SECTION B-B

- LEGEND:**
- X# Facility Component (see table 1 in O&M Manual)
 - and ⊙ Manhole
 - and □ Inlet
 - Storm Pipe (Facility)
 - Storm Pipe
 - Conveyance Direction
 - Pavement / Facility Flow Path
 - Traffic Flow Direction

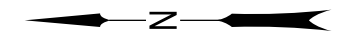

Sht. 02 of 02

Prepared By:
Laila Bush

Drafted By:
Laila Bush



OREGON DEPARTMENT OF TRANSPORTATION

DFI D01225
MAINTENANCE DISTRICT 2B HWY 1
BIOFILTRATION SWALE
 HIGHWAY MP 298.82 - 298.86
 MULTNOMAH COUNTY

B Appendix B – Project Contract Plans


Contents:

Site Specific Subset of Project Contract Plan 43V-121

INDEX OF SHEETS	
SHEET NO.	DESCRIPTION
1	Title Sheet
1A	Index Of Sheets Cont'd.
1A-2	Std. Drg. Nos.

STATE OF OREGON
 DEPARTMENT OF TRANSPORTATION
 PLANS FOR PROPOSED PROJECT
 GRADING, DRAINAGE, STRUCTURES, PAVING, SIGNING AND
 AUTOMATIC TRAFFIC RECORDER


I-5: SW IOWA STREET VIADUCT BR #08197 SEC.
 PACIFIC HIGHWAY
 MULTNOMAH COUNTY
 MAY 2010

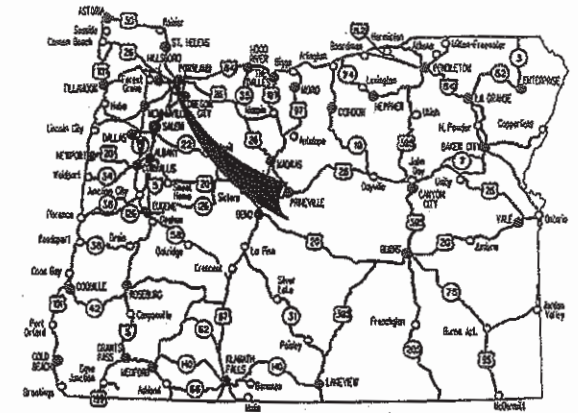

Overall Length Of Project - 0.85 Miles

No.	DATE	REVISIONS	BY
3	04-27-10	Changed bid date	LAK

ATTENTION:
 Oregon Law Requires You To Follow Rules Adopted By The Oregon Utility Notification Center. Those Rules Are Set Forth In OAR 952-001-0010 Through OAR 952-001-0090. You May Obtain Copies Of The Rules By Calling The Center. (Note: The Telephone Number For The Oregon Utility Center Is (503) 232-1987.)

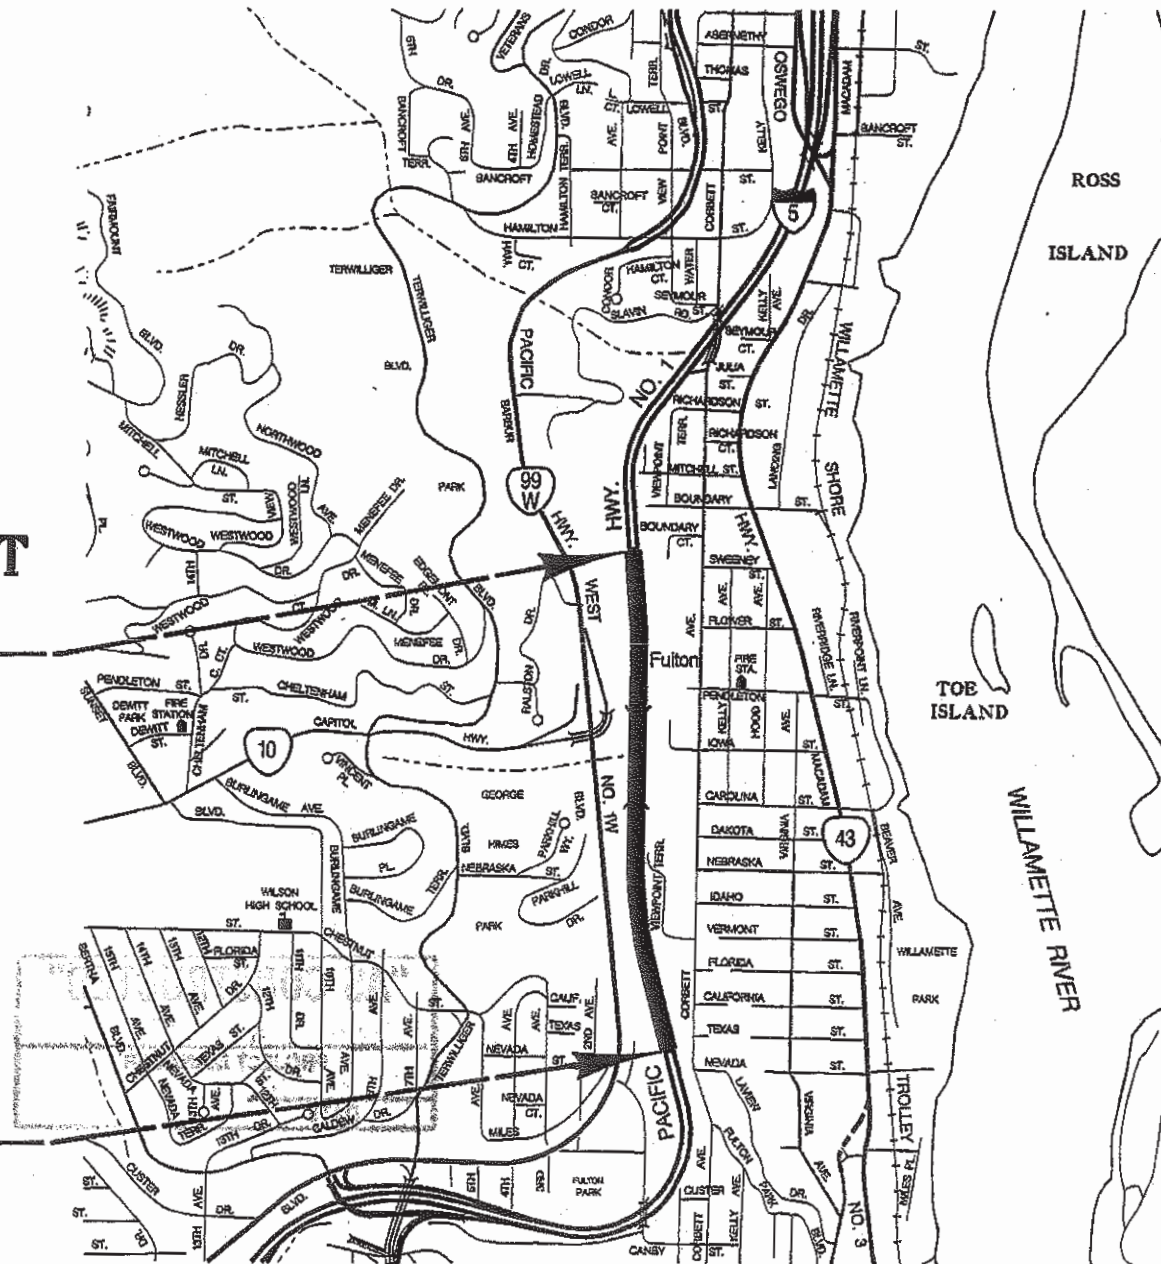

"AS CONSTRUCTED"
 Wayne A. Staller
 PROJECT MANAGER
 15 JAN 2015
 DATE

LET'S ALL
 WORK TOGETHER
 TO MAKE THIS
 JOB SAFE

BEGINNING OF PROJECT
HPP-BHF-S001(356)
STA. "I" 36+60 (M.P. 298.68)

END OF PROJECT
HPP-BHF-S001(356)
STA. "I" 82+00 (M.P. 297.83)

OREGON TRANSPORTATION COMMISSION
 Gail Achterman CHAIR
 Michael Nelson VICE-CHAIR
 Janice Wilson COMMISSIONER
 Alan Brown COMMISSIONER
 David Lohman COMMISSIONER
 Matthew L. Garrett DIRECTOR OF TRANSPORTATION

These plans were developed using ODOT design standards. Exceptions to these standards, if any, have been submitted and approved by the ODOT Chief Engineer or their delegated authority.

Approving Authority: *Naveen G. Chandra*
 Naveen G. Chandra, P.E.
 Project Delivery Manager, Region 1

Ar. M. W.
 Concurrence by ODOT Chief Engineer

I-5: SW IOWA STREET VIADUCT BR #08197 SEC.
 PACIFIC HIGHWAY
 MULTNOMAH COUNTY

FEDERAL HIGHWAY ADMINISTRATION	PROJECT NUMBER	SHEET NO.
OREGON DIVISION	HPP-BHF-S001(356)	1

Sec. 15, 22
 T. 1 S., R. 1 E., W.M.



001324-000

INDEX OF SHEETS, CONT'D.	
SHEET NO.	DESCRIPTION
2, 2A Thru 2A-15	Typical Sections
2B Thru 2B-18	Details
2C Thru 2C-30	Traffic Control Plan
2D Thru 2D-3	Pipe Data Sheet
3	Alignment & General Construction
3A	Not Used
3B	Drainage & Utilities
3C	Profile
3C-2	Drainage Profile
4	Alignment & General Construction
4A	Not Used
4B	Drainage & Utilities
4C	Profile
4C-2	Drainage Profile
5	Alignment & General Construction
5A	Temporary Drainage Plan
5A-2	Temporary Drainage Profile
5B	Drainage & Utilities
5C	Profile
5C-2	Drainage Profile
6	Alignment & General Construction
6A & 6A-2	Temporary Drainage Plan
6A-3	Temporary Drainage Profile
6B	Drainage & Utilities
6C	Drainage Profile
6C-2 & 6C-3	Drainage Profile
7	Alignment & General Construction
7A	Not Used
7B	Drainage & Utilities
7C	Profile
7C-2	Drainage Profile
GEO/HYDRO	
GA Thru GA-5	Erosion Control Plan
GA-6 Thru GA-10	Erosion Control Details
GB Thru GB-4	Plan
GB-5 Thru GB-7	Existing Landslides
GB-8 & GB-9	Legend
GB-10 Thru GB-12	Geotechnical Data, Retaining Wall 1
GB-13 Thru GB-16	Geotechnical Data, Retaining Wall 2
GB-17	Geotechnical Data, Retaining Wall 3
GB-18 Thru GB-23	Geotechnical Data, Retaining Walls 4A & 4B
GB-24	Geotechnical Data, Retaining Walls 5
GB-25 & GB-26	Geotechnical Data, Retaining Walls 6
GB-27 Thru GB-31	Geotechnical Data, Sections A-A Thru E-E
GB-32 Thru GB-38	Geotechnical Data, Sections J-J Thru Q-Q

INDEX OF SHEETS, CONT'D.		
SHEET NO.	DRAWING NO.	DESCRIPTION
RETAINING WALLS		
GC	83485	Retaining Walls 1-6 & NB Moment Slabs, Layout
GC-2	83176	Retaining Wall 1, Plan & Elevation
GC-3	83177	Retaining Wall 2, Plan & Elevation
GC-4	83178	Retaining Wall 1 & 2, General Notes
GC-5	83179	Retaining Walls 1 & 2, Typical Elev. & Section
GC-6	83180	Retaining Wall 1, Soldier Pile & Tieback, Sch. 1
GC-7	83181	Retaining Wall 1, Soldier Pile & Tieback, Sch. 2
GC-8	83182	Retaining Wall 2, Soldier Pile & Tieback, Sch. 1
GC-9	83183	Retaining Wall 2, Soldier Pile & Tieback, Sch. 2
GC-10	83184	Retaining Walls 1 & 2, Details 1
GC-11	83483	Retaining Walls 1 & 2, Details 2
GC-12	83482	Retaining Walls 1, 2 & 6, Class I Tendon
GC-13	83450	Retaining Walls 3, Plan & Elevation
GC-14	83457	Retaining Wall 4A, Plan & Elevation
GC-15	83458	Retaining Walls 3 & 4A, Details
GC-16	83459	Retaining Wall 4B, Plan & Elevation 1
GC-17	83460	Retaining Wall 4B, Plan & Elevation 2
GC-18	83461	Retaining Wall 4B, Plan & Elevation 3
GC-19	83462	Retaining Wall 4B, Plan & Elevation 4
GC-20	83463	Retaining Wall 4B, Details 1
GC-21	83464	Retaining Wall 4B, Details 2
GC-22	83468	Retaining Wall 5, Plan & Elevation
GC-23	83469	Retaining Wall 5, Details
GC-24	83472	Retaining Wall 6, Plan & Profile
GC-25	83473	Retaining Wall 6, General Notes
GC-26	83474	Retaining Wall 6, Typ. Elevation & Section
GC-27	83475	Retaining Wall 6, Soldier Piles & Tiebacks 1
GC-28	83476	Retaining Wall 6, Soldier Piles & Tiebacks 2
GC-29	83477	Retaining Wall 6, Details 1
GC-30	83478	Retaining Wall 6, Details 2
GC-31	83479	Retaining Wall 6, Wall Details at Pipe Crossing
GC-32	83480	Retaining Wall 6, Pile Splice Details
MOMENT SLABS		
GC-33	83465	Type A, Moment Slab & Barrier 1
GC-34	83466	Type A, Moment Slab & Barrier 2
GC-35	83481	Type B, Moment Slab & Barrier
GC-36	83958	Type C, Moment Slab & Barrier

INDEX OF SHEETS, CONT'D.	
SHEET NO.	DESCRIPTION
GJ	Water Quality, Plan & Notes
GJ-2	Water Quality Profiles
GJ-3 & GJ-4	Water Quality Details
GJ-5	Manhole With Type "D" Inlet Details
GJ-6	Diversion Manhole Details
GJ-7	Water Quality Facility Erosion Control Plan
GL	Extent of Surface Soil Contamination
GN, GN-2 Thru GN-7	Swale Development Plan

INDEX OF SHEETS, CONT'D.	
DRAWING NO.	DESCRIPTION
BRIDGE NO. 20788	
83129	General Layout
83130	Plan and Elevation
83131	General Notes
83132 Thru 83136	Geotechnical Data
83137	Stage I Construction Plan
83138	Stage II Construction Plan
83139	Stage III & IV Construction Plan
83140	Construction Staging Section (Bent 2)
83141	Construction Staging Section (Bent 3)
83142	Temporary Barrier Details
83143	Temporary Detour Structure & Work Platform
83144	Temporary Access Road
83145	Footing Plan 1
83146	Footing Plan 2
83147	Deck Plan
83148	Typical Deck Section
83149	Deck Details & Rebar Plan
83150	Misc. Details
83151	Bulb-T Girder Schedule
83152	Bulb-T Girder Details
83153	Additional Bulb-T Girder Details
83154	Bent 1
83155	Bent 1 Details
83156	Bearings
83157	Bent 2
83158	Bent 2 Section
83159	Bent 2 Elevation
83160	Bent 3
83161	Bent 3 Section
83162	Bent 3 Elevation
83163	Bent 4 Plan & Elevation
83164	Bent 4 Details
83165	Bent 4 Section
83166	Drilled Shaft Details
83167	Misc. Details 2
83168	Bent 1 Wingwall A
83169	Bent 1 Wingwall B
83170	Bents 2W & 4W Wingwalls C & E
83171	Bent 4 Wingwall "D"
83172	Bridge Rail West
83173	Bridge Rail East 1
83174	Bridge Rail East 2
83175	Concrete Bridge Rail Details

"AS CONSTRUCTED"
 Wayne A. Statler
 PROJECT MANAGER
 15 JAN 2015
 DATE

INDEX OF SHEETS, CONT'D.	
SHEET NO.	DESCRIPTION
PERMANENT PAVEMENT MARKINGS	
ST-ST-2 Thru ST-4	Striping Plan
PERMANENT SIGNING	
S-11794 Thru S-11796	Signing Plan
S-11797 & S-11798	Signing Details
S-11799	Post & Data Table
S-11800	Can'tilever Sign Support
ITS SIGNAGE	
ITS-944	ITS Legend, Symbols & General Notes
ITS-945 & ITS-946	<i>Replaced by SK-NB VMS</i>
ITS-947 & ITS-948	Terwilliger VMS Site Plans
ITS-949	<i>Eliminate</i>
ITS-950 & ITS-951	ITS Details
TDS-26-016A	Iowa St. ATR Site Plan & Legend
TDS-26-016B	Iowa St. ATR Details & Legend
ILLUMINATION	
I-1676	Illumination Plan, Legend & Light Pole Table
I-1677 Thru I-1681	Illumination Plan
TEMPORARY ILLUMINATION	
I-1709 Thru I-1713	Temporary Illumination Plan
AS-BUILT DRAWINGS (V-FILE 12V-106) (FOR INFORMATION ONLY)	
7 & 2G	W. MARQUAM INTCHGE.-N. TIGARD INTCHGE. SEC.

No.	DATE	REVISIONS	BY
1	04-08-10	Add as-built drawing list	LAK
		(2 as-built sheets added to the package)	

I-5: SW IOWA STREET VIADUCT BR #08187 SFC
 PACIFIC HIGHWAY
 MULTNOMAH COUNTY


FEDERAL HIGHWAY ADMINISTRATION	PROJECT NUMBER	SHEET NO.
OREGON DIVISION	HPP-BHF-S001(356)	1A

Standard Drawings located on the web at:
http://www.oregon.gov/ODOT/HWY/ENG/SERVICES/standard_drawings_home.shtml

Standard Drg. Nos.


RD140	- Rdwy. Cross Slopes Superelevated Sections	BR140, BR145	- Expansion Joints
RD150	- Slope Rounding	BR165	- Bridge End Panel Details
		BR170	- Pile Trestle For Temp. Detour Bridges
RD300	- Trench Backfill, Bedding, Pipe Zone And Mult. Installations		
RD302	- Street Cut	BR236	- Trailing End Bridge Connection Conc. Bridge Rail To Guardrail
RD312	- Subsurface Drain	BR290	- 3'-6" Type "F" Rail
RD316	- Sloped Ends For Metal Pipe		
RD318	- Sloped Ends For Concrete Pipe	BR321	- BT90 And BT96 Girders
RD320	- Paved End Slope For Culverts 60" Maximum Pipe Size	BR350	- Temp. Diaphragm Beam For Prestressed Conc. Girders
RD326	- Coupling Bands For Corrugated Metal Pipe		
RD330	- Metal Pipe Slope Anchors		
RD334	- Locator Post	BR970	- Luminaire Base On Structures With Mounting Details
RD336, RD338, RD340, RD342, RD344, RD346	- Manholes		
RD356	- Manhole Cover & Frames	TM200	- Sign Installation Details
RD358	- Manhole Slope Protectors	TM201	- Miscellaneous Sign Placement Details
RD360	- Manhole Frame Adjustment	TM204	- Flag Board Mounting Details
RD364, RD366, RD368, RD370, RD372	- Concrete Inlets	TM211, TM212	- Signing Details
RD376	- Miscellaneous Drainage Structures	TM220	- Multi-Post Installations
RD380, RD382, RD384, RD386	- Pipe Fill Height Tables	TM221, TM222	- Milepost Marker Details
		TM224	- Directional Sign Layout
		TM225	- Exit Number & Gore Signing Details
		TM231, TM232, TM233	- Mounting Details For Removable Legend
RD410	- Guardrail		
		TM500, TM502	- Pavement Marking Standard Details
RD500	- Precast Conc. Bar. Pin & Loop Assembly	TM515	- Raised Pavement Markers
RD505	- Concrete Barrier Cast-In-Place	TM520	- Durable Pavement Markings
RD510	- Concrete Barrier Terminal	TM560	- Alignment Layout
RD515	- Median Barrier Anchoring Details	TM570	- Traffic Delineators
RD516	- Securing Concrete Barrier To Roadway		
RD520	- Cast-In-Place Conc. Barrier Transition To Bridge Rail	TM601	- Multi-Post Breakaway Sign Supports
RD526	- Standard Concrete Barrier Buried In Backslope	TM602	- Triangular Base Breakaway Multi-Direction Slip Base
RD530	- Guardrail Connection To Concrete Barrier	TM622, TM623, TM624, TM625, TM626, TM627	- Monotube Cantilever Sign Support
RD535	- Concrete Barrier (Modified) Around Median Obstacle	TM629, TM630	
RD545	- Precast Tall (42") Concrete Barrier	TM635	- Slip Base & Fixed Base Luminaire Supports
RD550	- Cast-In-Place Tall Conc. Barrier Tran. To Bridge Rail	TM670	- Breakaway Sign & Luminaire Supports
RD560	- Cast-In-Place Tall Conc. Barrier Tran. To Std. Conc. Barrier	TM671	- Perm. Signing Wood Post Supports Sizing Charts
		TM677	- 3 Second Gust Wind Speed Isotach
RD610	- Asphalt Pavement Details	TM681, TM687, TM688	- Sign Mounts
			- Square Tube Sign Supports
RD700	- Curbs		
RD755	- Sidewalk Ramp Details	TM800	- Tables, Abrupt Edge And PCMS Details
RD756, RD757	- Sidewalk Ramp Placement	TM810	- Temporary Reflective Pavement Markers
		TM820	- Temporary Barricades
RD815	- Chain Link Fence	TM821	- Temporary Sign Supports
		TM830	- Temporary Concrete Barrier And Rumble Strips
		TM831	- Temporary Impact Attenuators
RD1000	- Construction Entrances	TM840, TM841	- Closure Details
RD1005	- Check Dams	TM850	- 2-Lane, 2 Way Roadways
RD1010, RD1015	- Inlet Protection	TM860, TM861, TM862	- Freeway Sections
RD1025, RD1035	- Sediment Barrier		
RD1040	- Sediment Fence		
RD1045	- Temporary Slope Drains		
RD1050	- Temporary Scour Holes		
RD1055	- Matting		
RD1060	- Tire Wash Facility		

No R/W Map

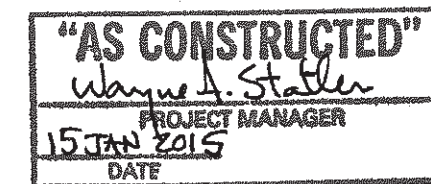

I-5: SW IOWA STREET VIADUCT BR #08197 SEC. PACIFIC HIGHWAY MULTNOMAH COUNTY		
FEDERAL HIGHWAY ADMINISTRATION	PROJECT NUMBER	SHEET NO.
OREGON DIVISION	HPP-BHF-S001(356)	1A-2


Standard Drawings located on the web at:
http://www.oregon.gov/ODOT/HWY/ENGSERVICES/standard_drawings_home.shtml

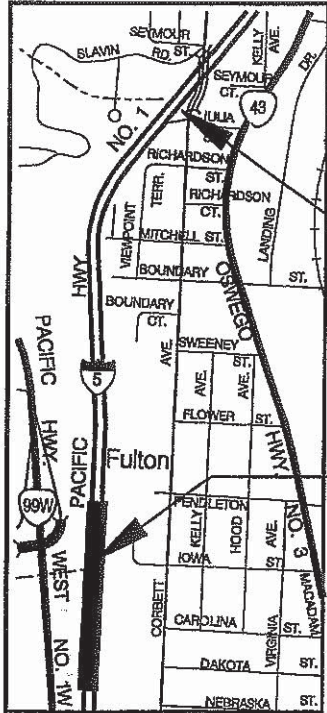


SWALE LOCATION

PROJECT LOCATION

"AS CONSTRUCTED"
 Wayne A. Staller
 PROJECT MANAGER
 17 DEC 2012
 DATE

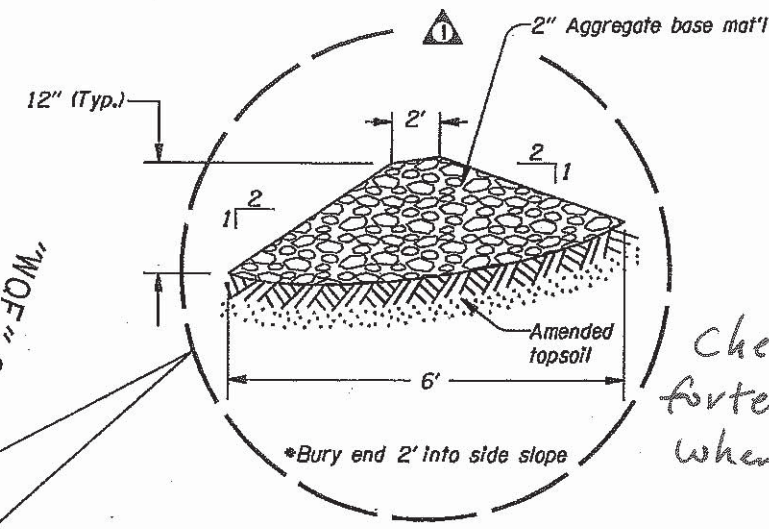

Check dams were in for temp swale only. Removed when swale completed.

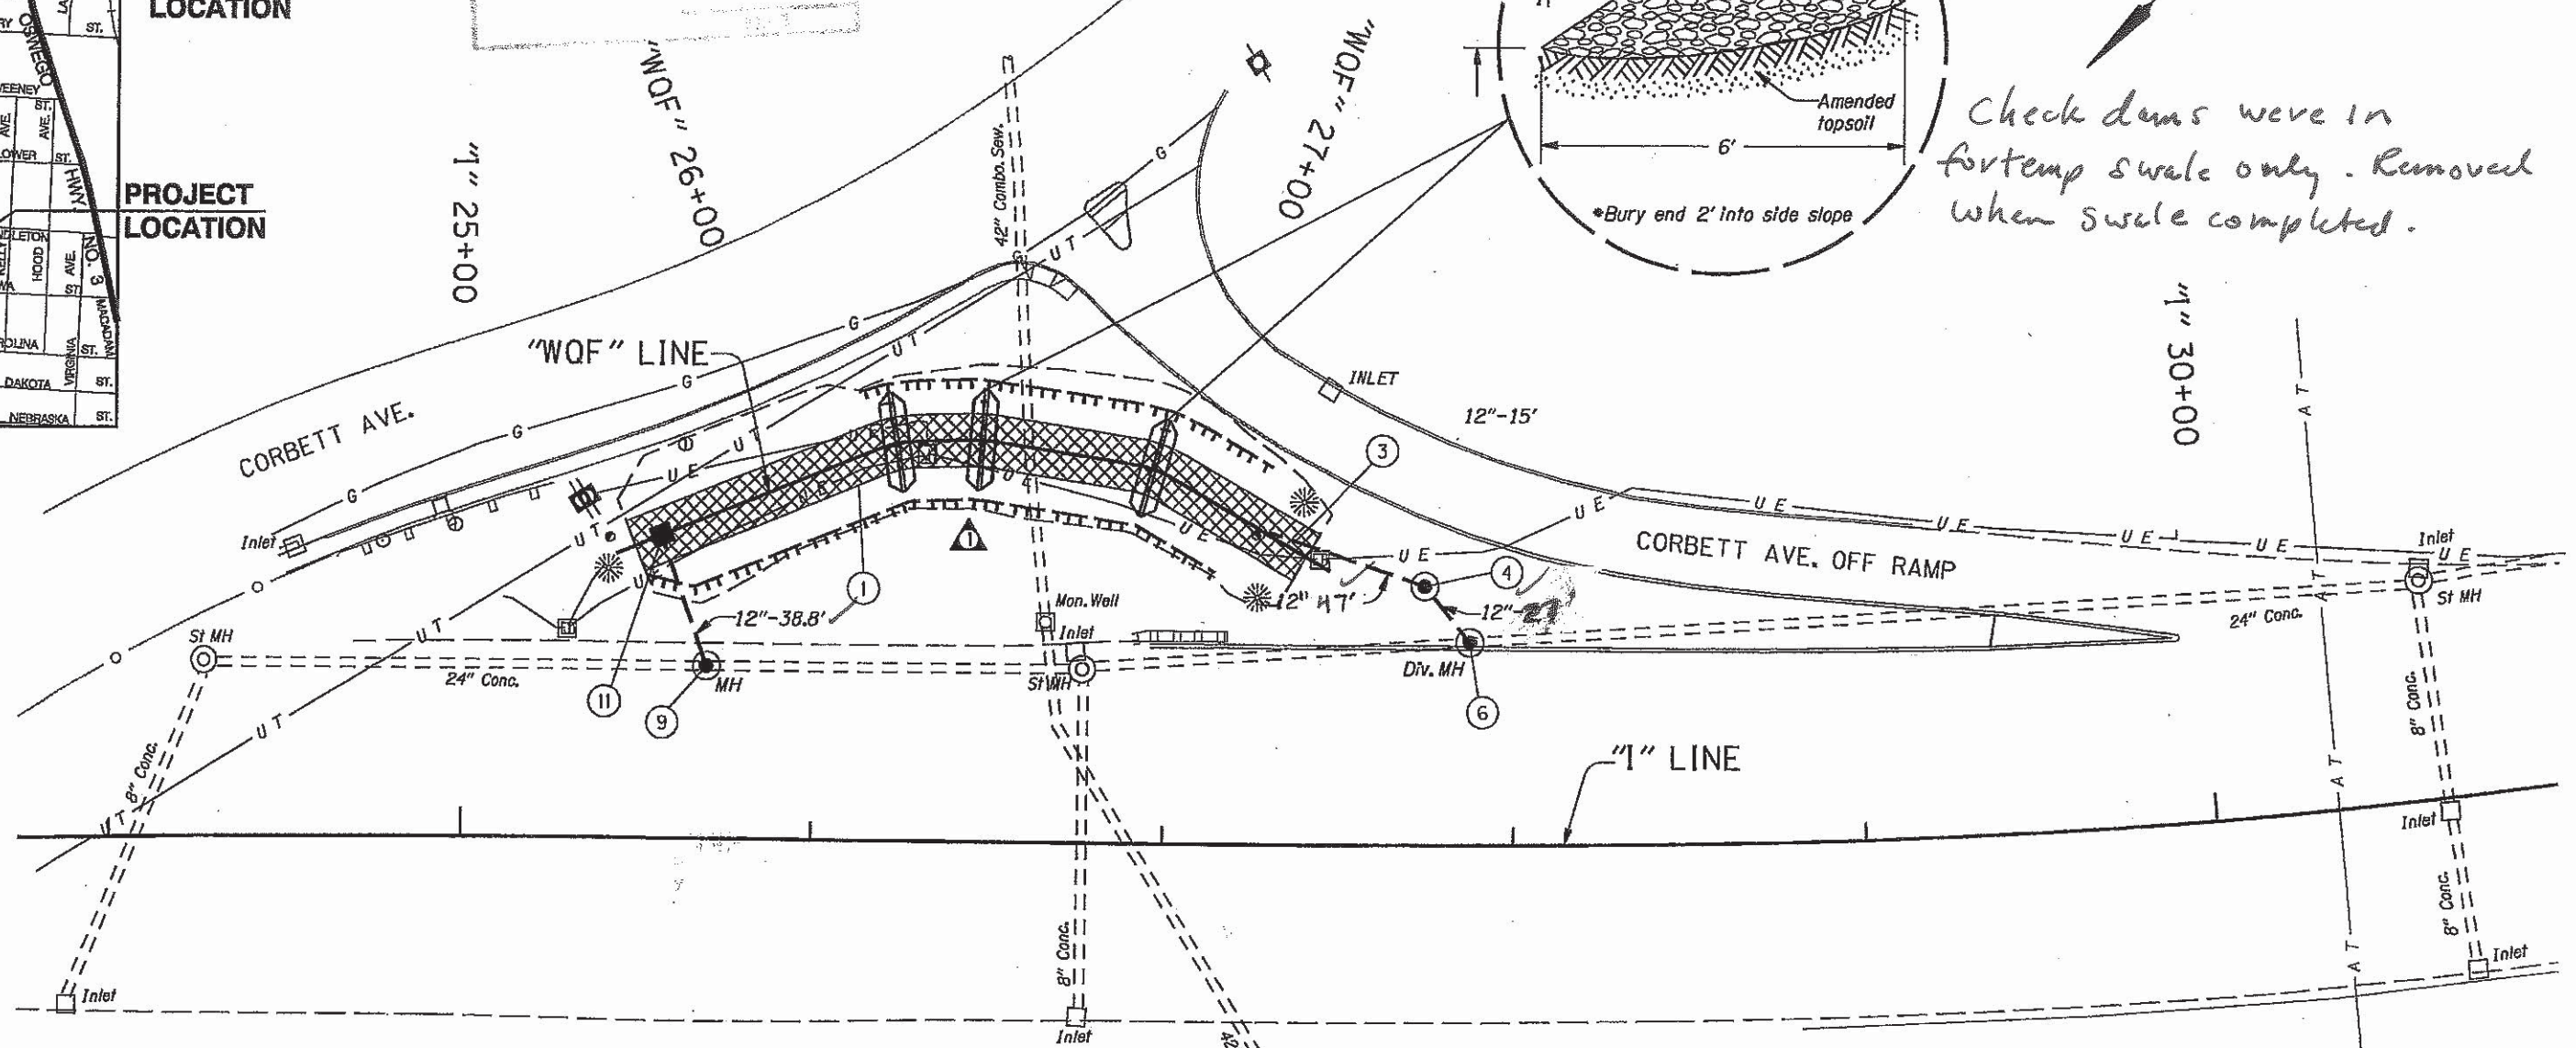


PLAN

"AS CONSTRUCTED"
 Wayne A. Staller
 PROJECT MANAGER
 15 JAN 2015
 DATE

- ③ ① Construct Swale (For details, see shts. GJ-2 & GJ-3)
- ② ②
- ③ ③ Sta. "I" 27+29.5, 88.0' Lt. Const. pipe sloped end Inst. 12" storm sew. pipe - 47' 5' depth
- ③ ④ Sta. "I" 27+74.2, 73.0' Lt. Const. pollution control manhole Inst. 12" storm sew. pipe - 27' 5' depth (See drg. no. RD340)
- ⑤ ②
- ③ ⑥ Sta. "I" 27+86.8, 56.7' Lt. Const. diversion manhole over extg. sewer
- ⑦ ②
- ⑧ ②
- ③ ⑨ Sta. "I" 25+69.7, 48.7' Lt. Const. manhole over extg. sewer Inst. 12" storm sew. pipe - 38.8' 10' depth Trench resurf. - 4 sq.yd.
- ⑩ ②
- ③ ⑪ Sta. "I" 25+56.5, 85.2' Lt. on top of Const. type "D" mod. inlet manhole

No.	DATE	REVISIONS	BY
①	09-24-10	Revised swale & drainage structures	S.B. for B.S.C.
②	09-24-10	Deleted note	S.B. for B.S.C.
③	09-24-10	Edited note	S.B. for B.S.C.

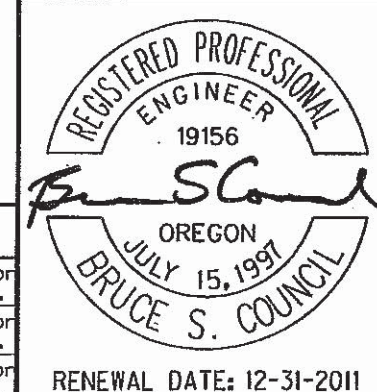

OREGON DEPARTMENT OF TRANSPORTATION


REGION 1 - Geo/Hydro/HazMat Unit

I-5: SW IOWA STREET VIADUCT BR#08107 SEC.
 PACIFIC HIGHWAY
 MULTNOMAH COUNTY

Reviewed By - Don Gunther
 Designed By - Bruce Council
 Drafted By - Charlotte Gerken


WATER QUALITY PLAN

SHEET NO. GJ

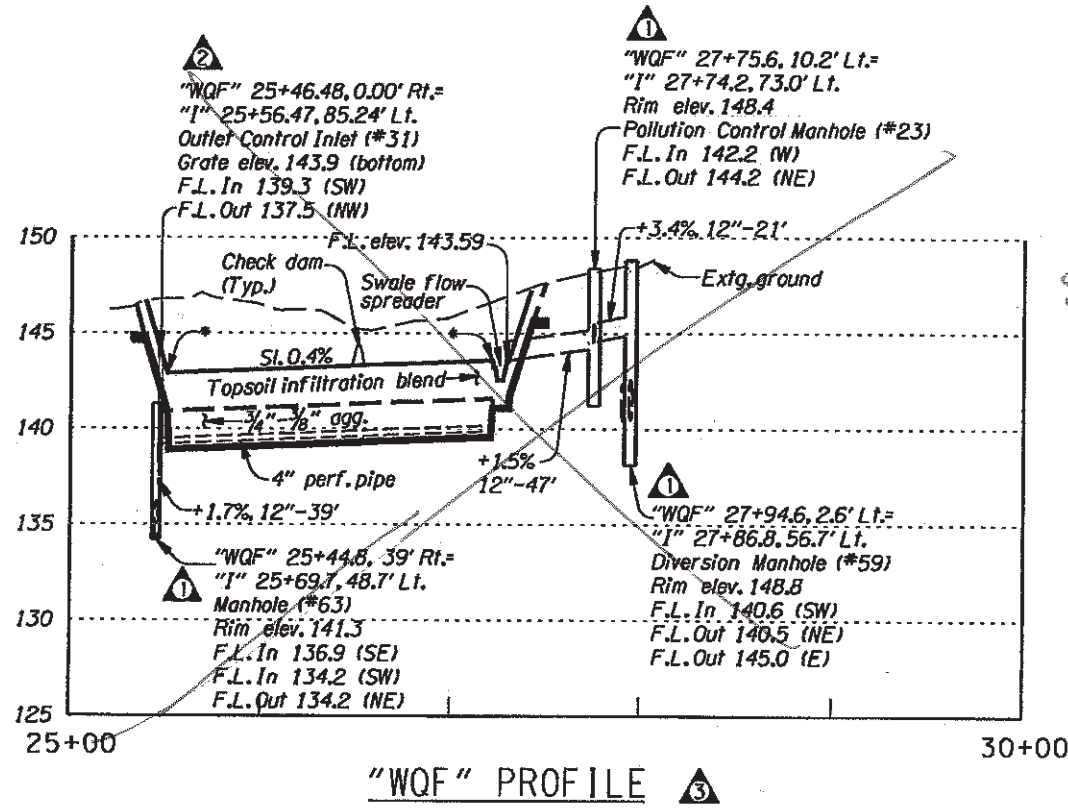

see next sheet

"AS CONSTRUCTED"
Wayne A. Staller
PROJECT MANAGER
17 DEC 2012
DATE

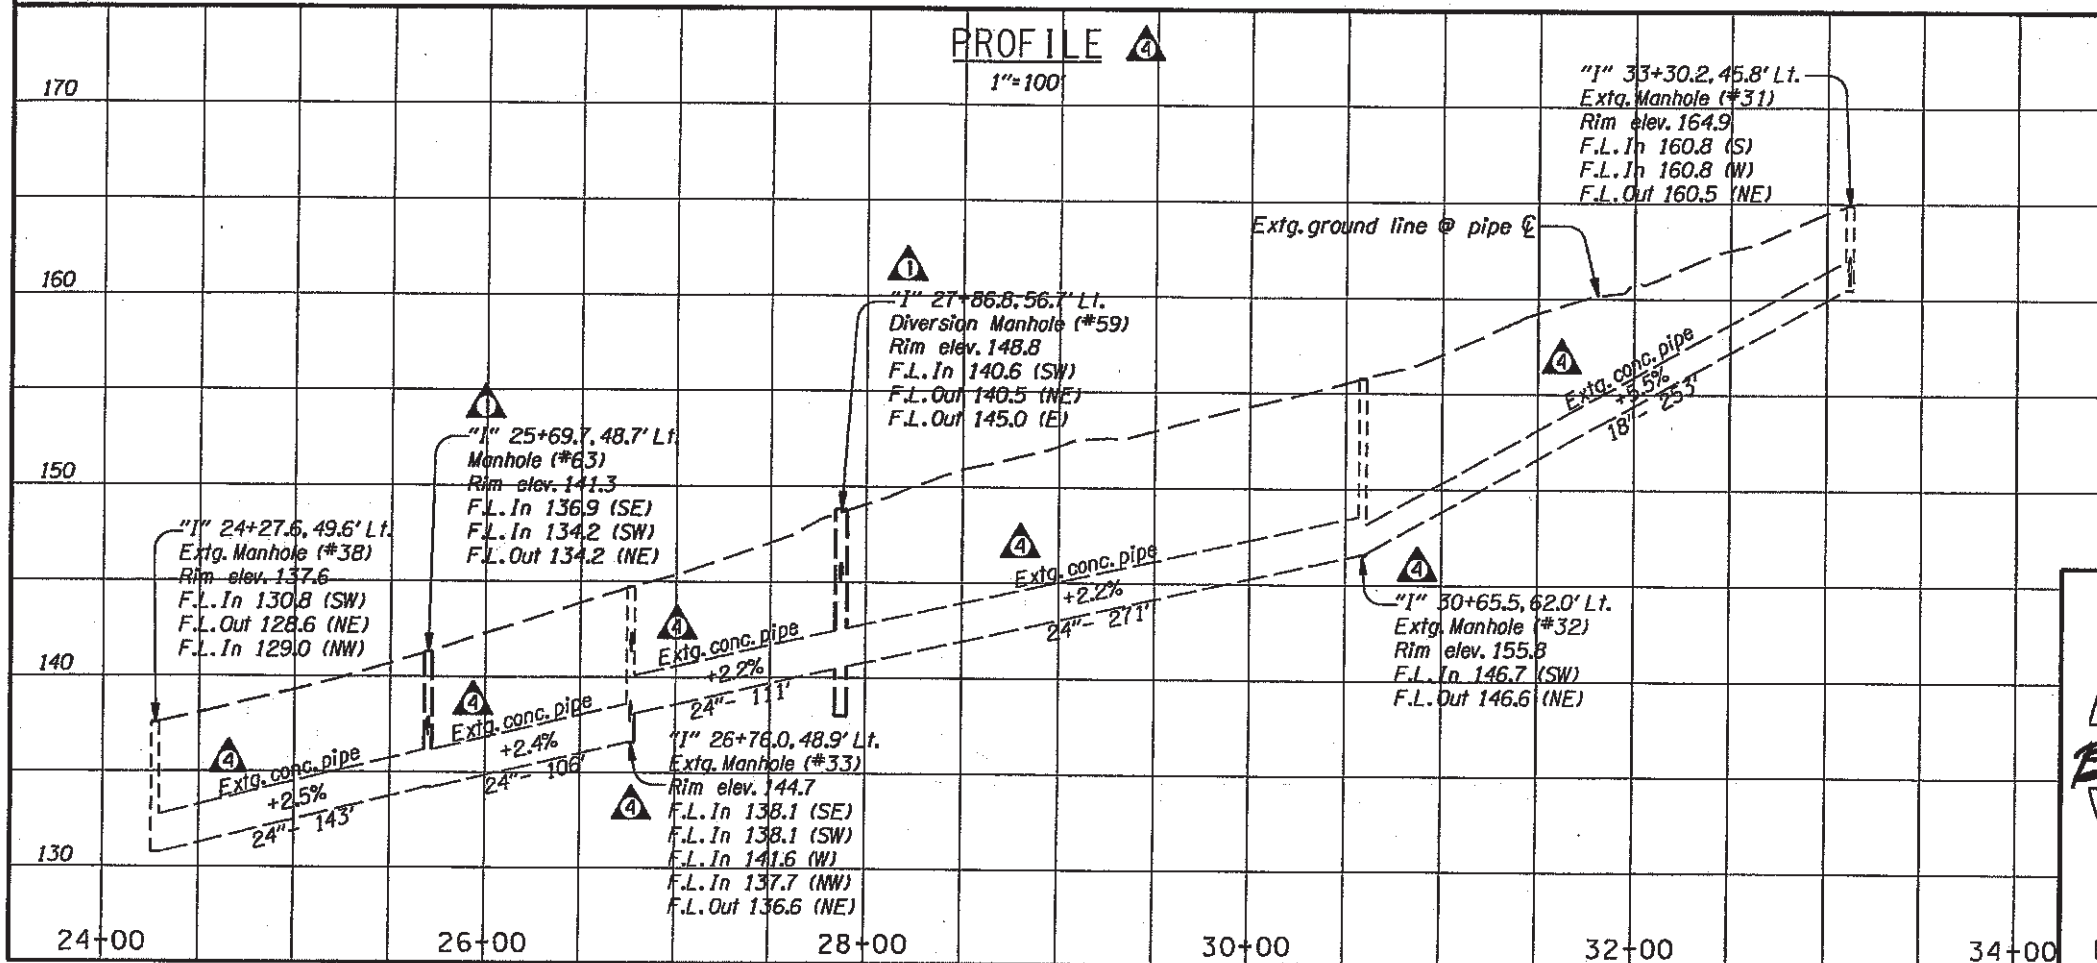

Notes:
* For elevations, see shts. GJ-3 & GJ-4.
Rim elevations are at center of MH lid.
Verify pipe flow lines prior to ordering manholes and inlets

No.	DATE	REVISIONS	BY
1	04-06-10	Adjusted manhole rim & pipe invert	B.S.C.
2	04-06-10	Adjusted inlet grate & pipe invert	B.S.C.
3	9-24-10	Revised swale & drainage structure	S.B. for B.S.C.
4	12-8-10	Edited note and profile	B.S.C.

OREGON DEPARTMENT OF TRANSPORTATION

REGION 1 - Geo/Hydro/HazMat Unit

I-5: SW IOWA STREET VIADUCT BR#08107 SEC. PACIFIC HIGHWAY MULTNOMAH COUNTY

Reviewed By - Dan Gunther
Designed By - Bruce Council
Drafted By - Charlotte Gerken

WATER QUALITY PROFILE


SHEET NO. GJ-2

REGISTERED PROFESSIONAL ENGINEER 19156
Bruce Council
OREGON JULY 15, 1997
BRUCE S. COUNCIL
RENEWAL DATE: 12-31-2011


WATER QUALITY SWALE FLOW SPREADER

43V-121

"AS CONSTRUCTED"
 Wayne A. Statler
 PROJECT MANAGER
 17 Dec 2012
 DATE

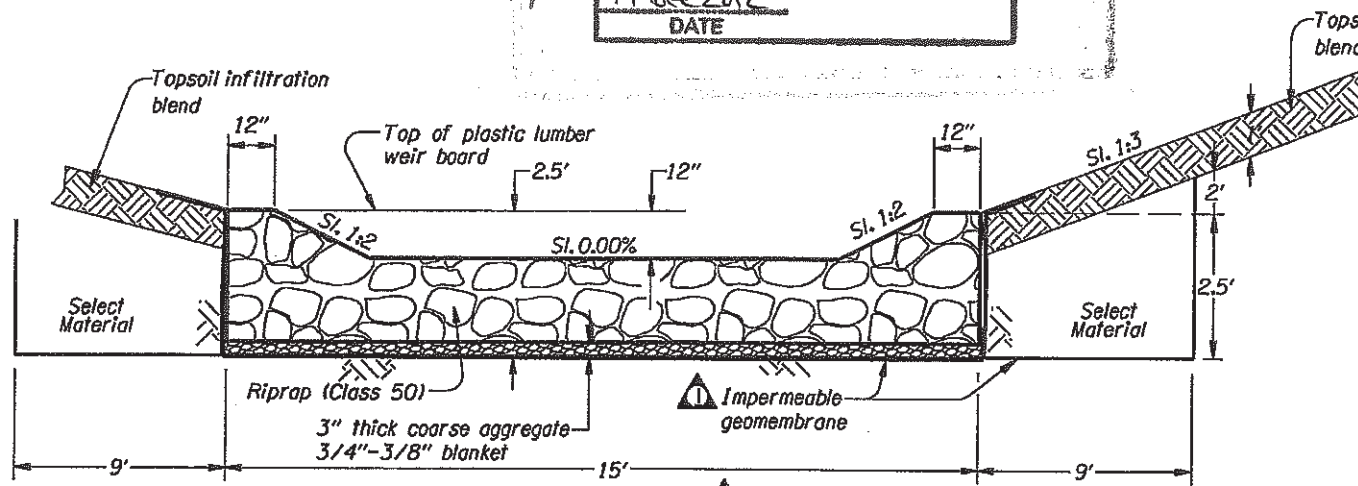


SECTION A-A

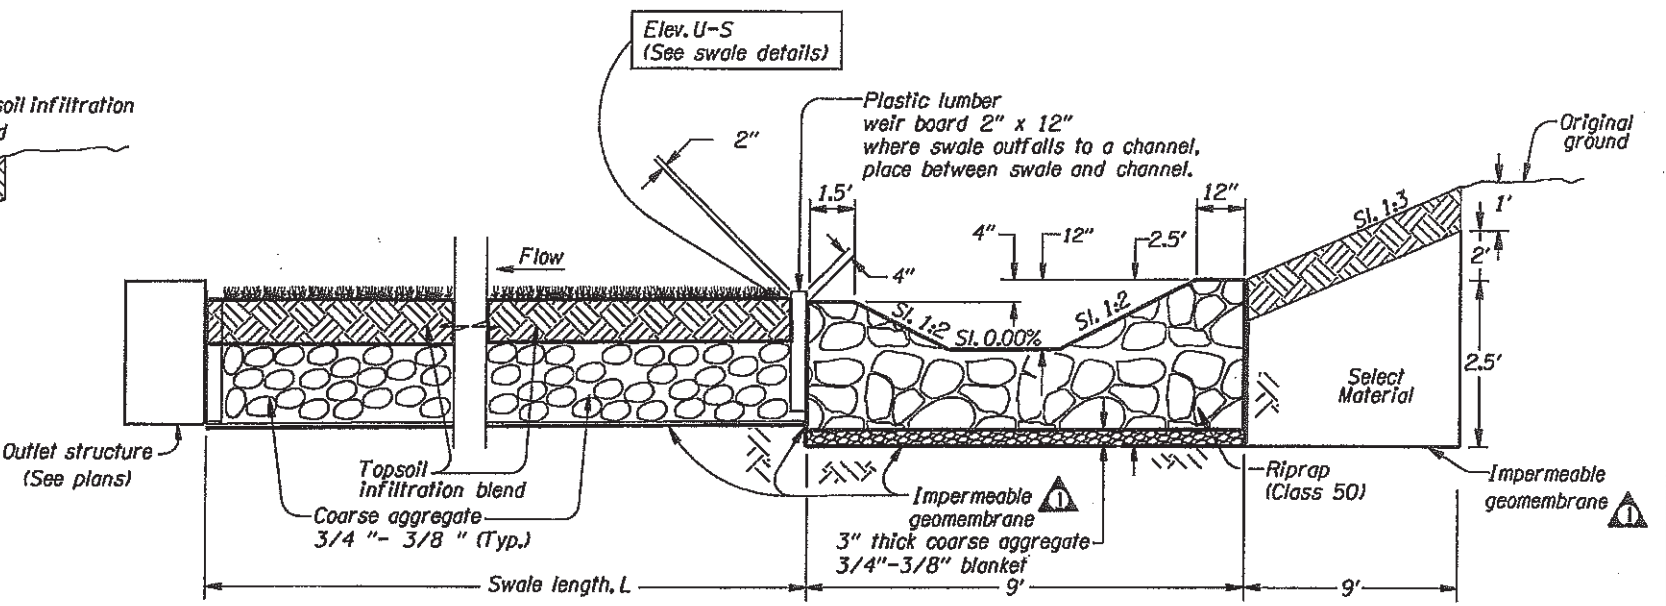


SECTION B-B

* Outfall end similar

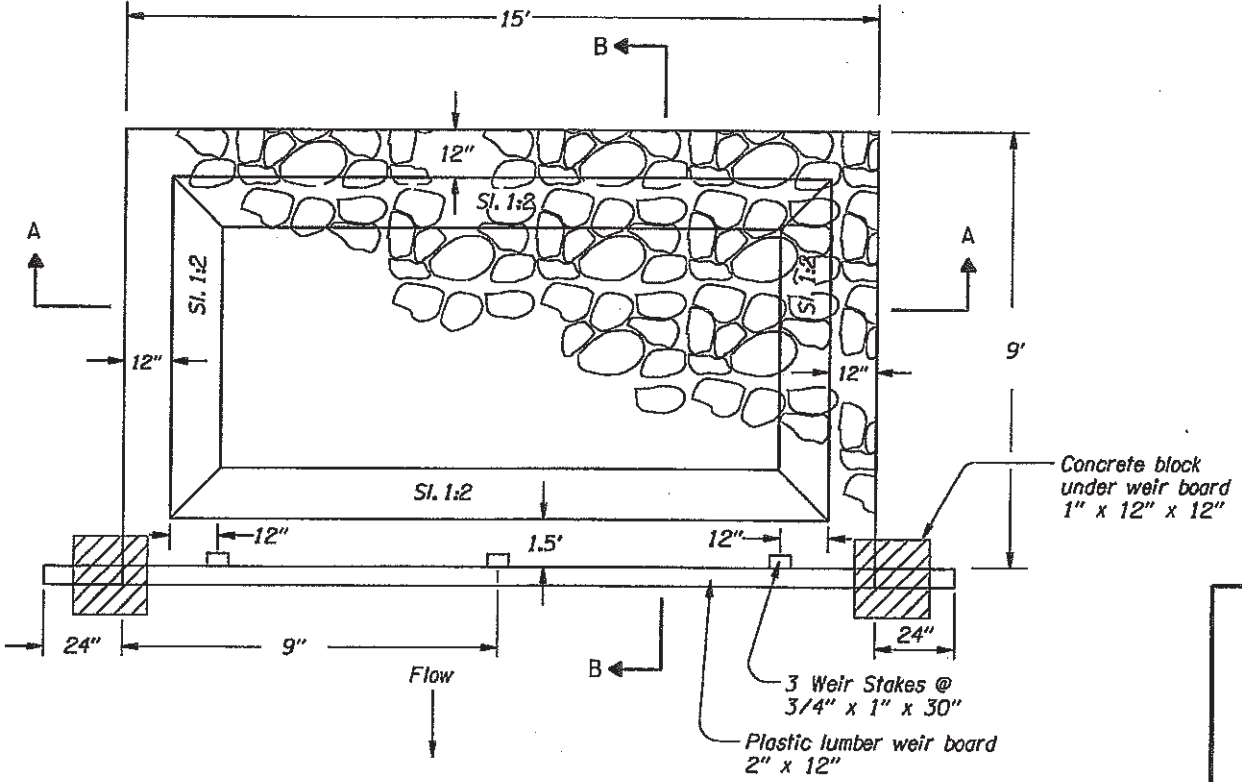

PLAN
 SWALE FLOW SPREADER

Note:
 See 01040 for topsoil infiltration blend composition

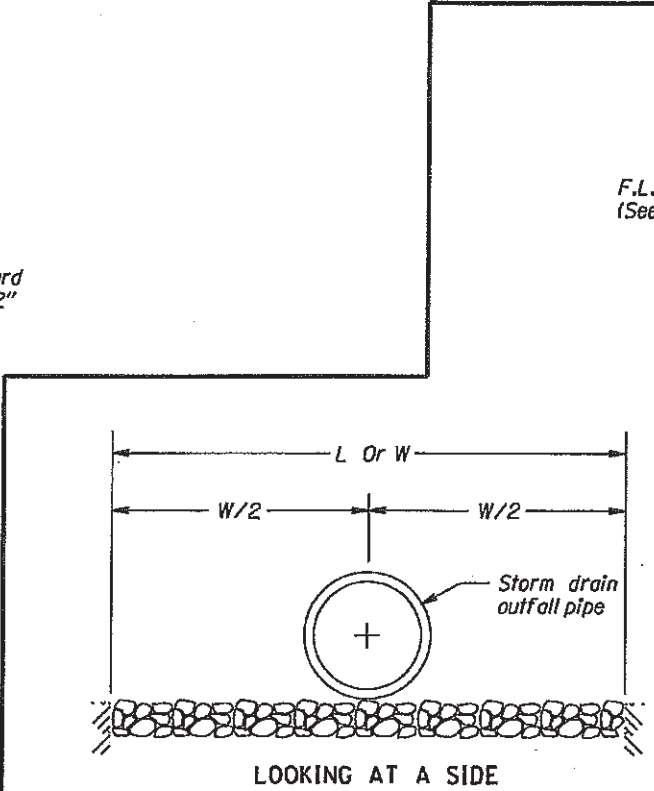

Note:
 Pipe F.L. elev. and top of
 weir board elev. are the same.

All dimensions are in feet (') unless otherwise noted.

No.	DATE	REVISIONS	BY
1	04-05-10	Added prefix geo to membrane	B.S.C.
2	11-30-10	Modified section A-A and B-B	B.S.C.



OREGON DEPARTMENT OF TRANSPORTATION

REGION 1 - Geo/Hydro/HazMat Unit

1-5: SW IOWA STREET VIADUCT BR#08197 SEC.
 PACIFIC HIGHWAY
 MULTNOMAH COUNTY

Reviewed By - Don Gunther
 Designed By - Bruce Council
 Drafted By - Charlotte Gerken

WATER QUALITY DETAILS


SHEET NO.
 GJ-3

WATER QUALITY SWALE GENERAL DETAILS
PLAN AND TYPICAL CROSS-SECTION

AS CONSTRUCTED
Wayne A. Staller
PROJECT MANAGER
17 Dec 2010
DATE

For additional Section A-A details, see also sht. GN. For inflow, outflow locations and elevations see sht. GJ.


43V-121

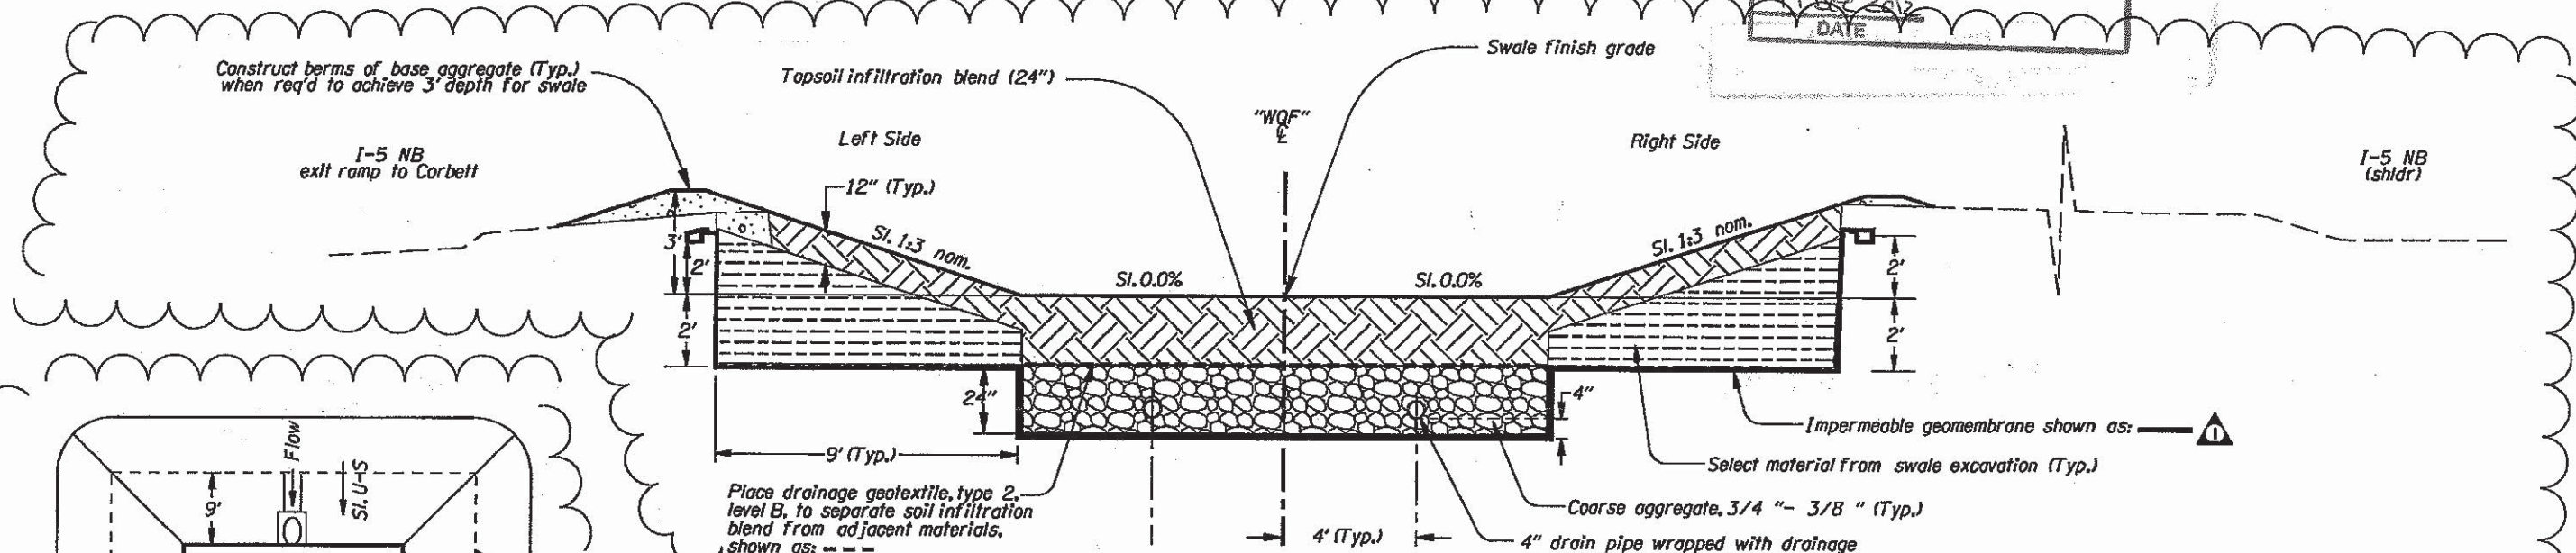


also Type 2 drain fabric was put down under impermeable geomembrane to reduce chance of puncture

SECTION A-A

Note:
See sht. GN for seeding, planting, and swale bottom medium details.

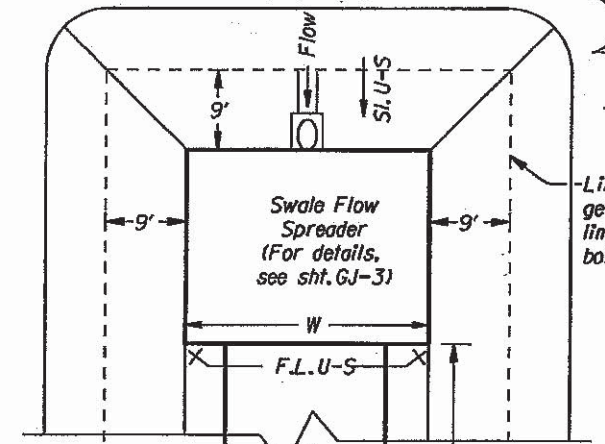

Limit of impermeable geomembrane vertical limit is 2' above swale bottom finish grade.

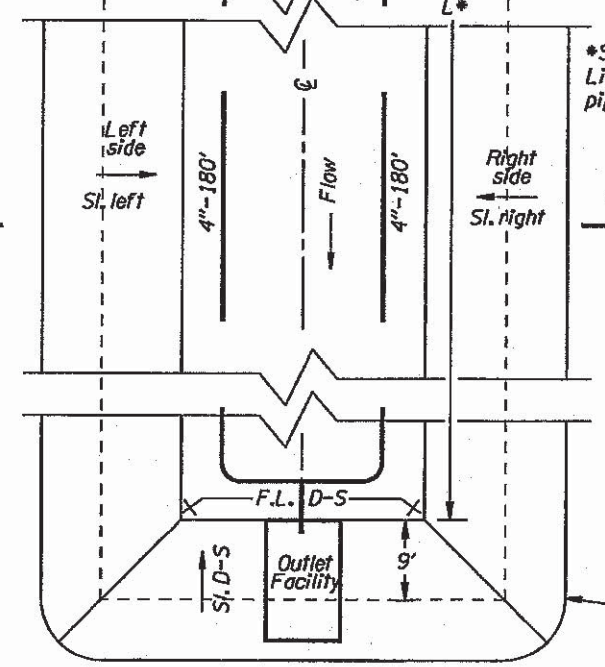

*Swale length = L
Limits of perf. drain pipe and swale structure

Freeboard limits = Pay limits for swale. (Inlets, paved end slopes and outlet facilities are not included in swale pay item.)

PLAN

Notes:
1) U-S = Upstream
2) D-S = Downstream
3) See site plans for pipe inverts at inlets

Swale ID	L (ft)	W (ft)	F.L. U-S (ft)	F.L. D-S (ft)	Long. Slope (%)	Side Slopes				Number of Underdrains	Freeboard Depth (ft)	Underdrain Tie-in Location	Swale Outlet Facility	D/S		U/S	
						U-S	D-S	Left	Right					Sta. "WQF"	Offset	Sta. "WQF"	Offset
WQF	172	15	143.6	142.9	0.4	1:3	1:3	1:3	1:3	2	3	"D" Mod. Inlet	"D" Mod. Inlet	25+50.00	0'	27+21.79	0'




No.	DATE	REVISIONS	BY
1	04-05-10	Added prefix geo to membrane	B.S.C.
2	10-31-10	Modified water quality facility	B.S.C.

Note:
For swale specifics, refer to the table on this sht.

REGISTERED PROFESSIONAL ENGINEER
19156
BRUCE S. COUNCIL
OREGON
JULY 15, 1997
RENEWAL DATE: 12-31-2011



OREGON DEPARTMENT OF TRANSPORTATION
REGION 1 - Geo/Hydro/HazMat Unit
I-5: SW IOWA STREET VIADUCT BR#08197 SEC.
PACIFIC HIGHWAY
MULTNOMAH COUNTY
Reviewed By - Dan Gunther
Designed By - Bruce Council
Drafted By - Charlotte Gerken
WATER QUALITY DETAILS
SHEET NO. GJ-4

MANHOLE W/TYPE "D" INLET DETAIL

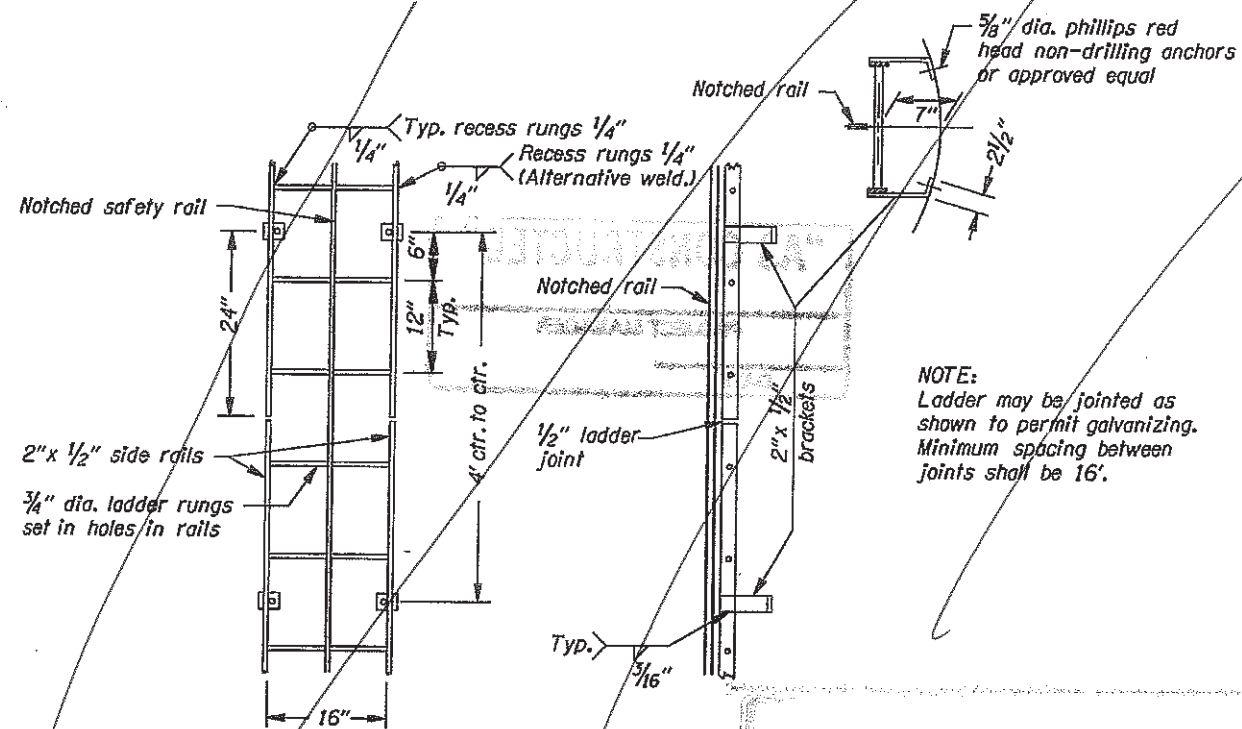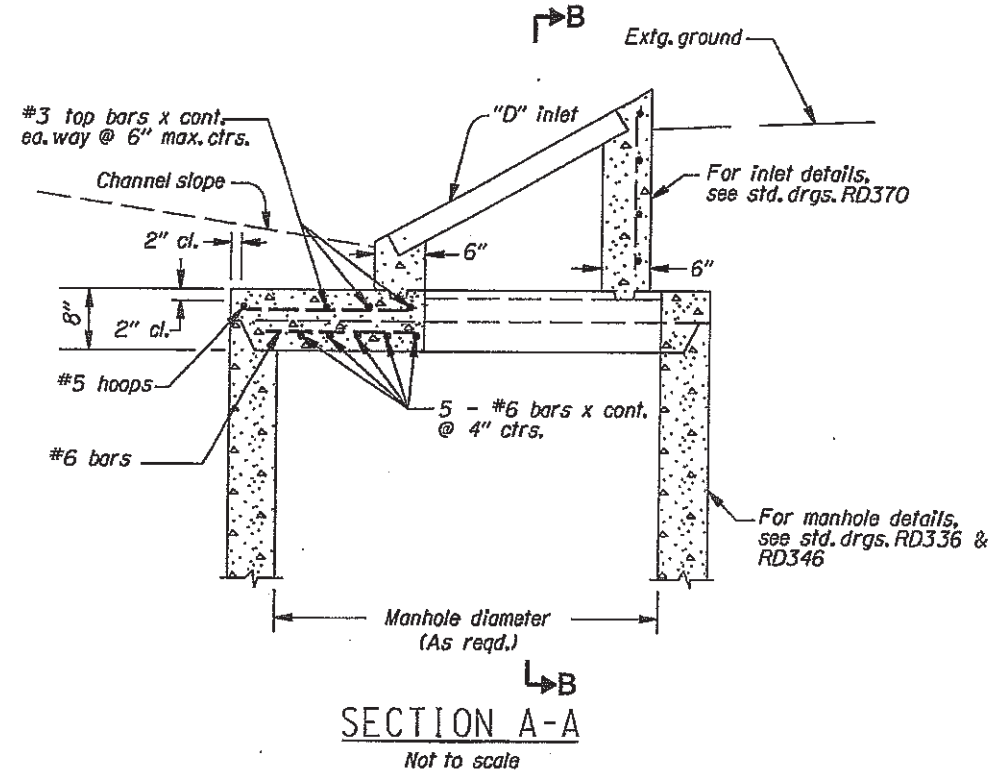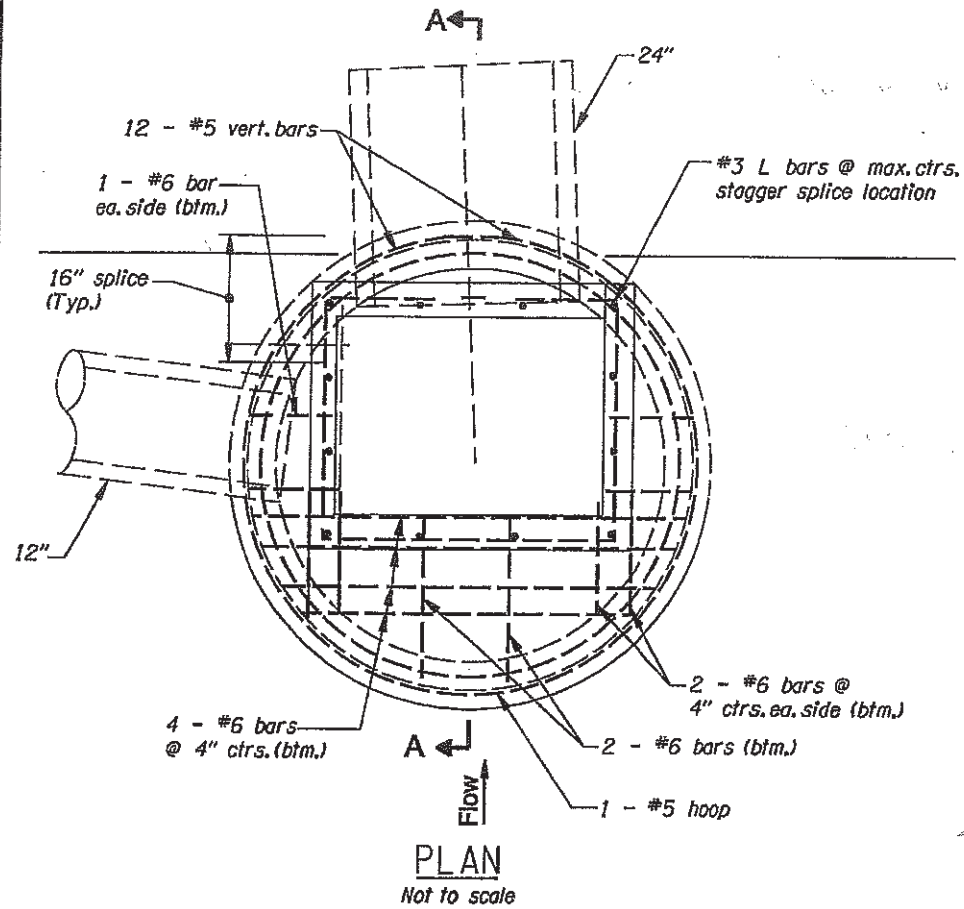

SAFETY LADDER
not used.

"AS CONSTRUCTED"
Wayne A. Staller
PROJECT MANAGER
17 Dec 2012
DATE

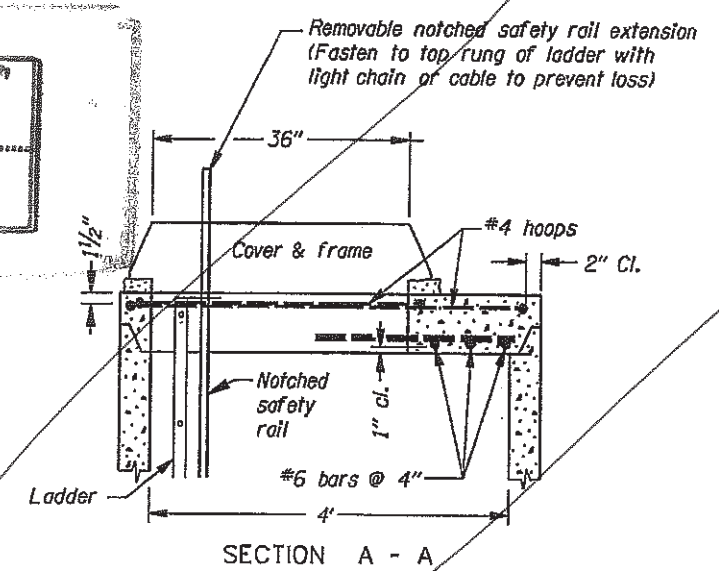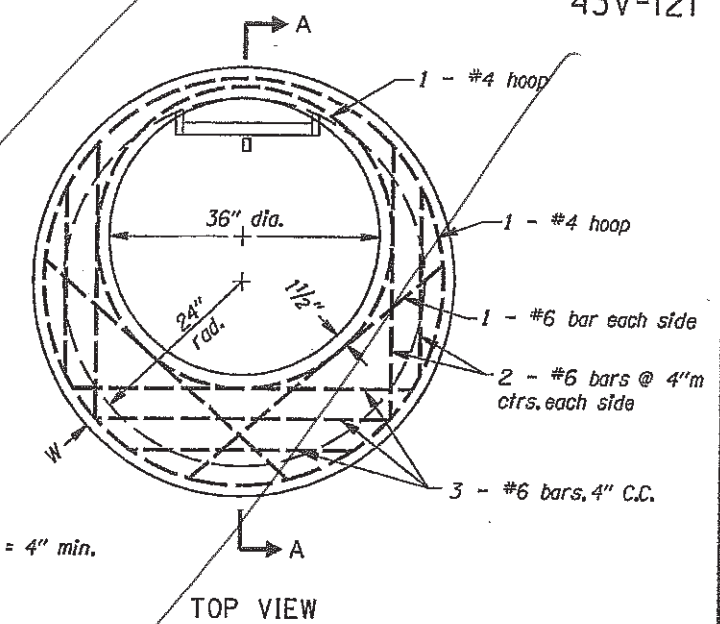

No.	DATE	REVISIONS	BY
1	12-10-10	Edited general note	B.S.C.

OREGON DEPARTMENT OF TRANSPORTATION

REGION 1 - Geo/Hydro/HazMat Unit


1-5 SW IOWA STREET VIADUCT BR#08197 SEC.
PACIFIC HIGHWAY
MULTNOMAH COUNTY

Reviewed By - Dan Gunther
Designed By - Bruce Council
Drafted By - Charlotte Gerken

DETAILS

SHEET NO.
GJ-5


REGISTERED PROFESSIONAL ENGINEER
19156
BRUCE S. COUNCIL
JULY 15, 1997
OREGON
RENEWAL DATE: 12-31-2011

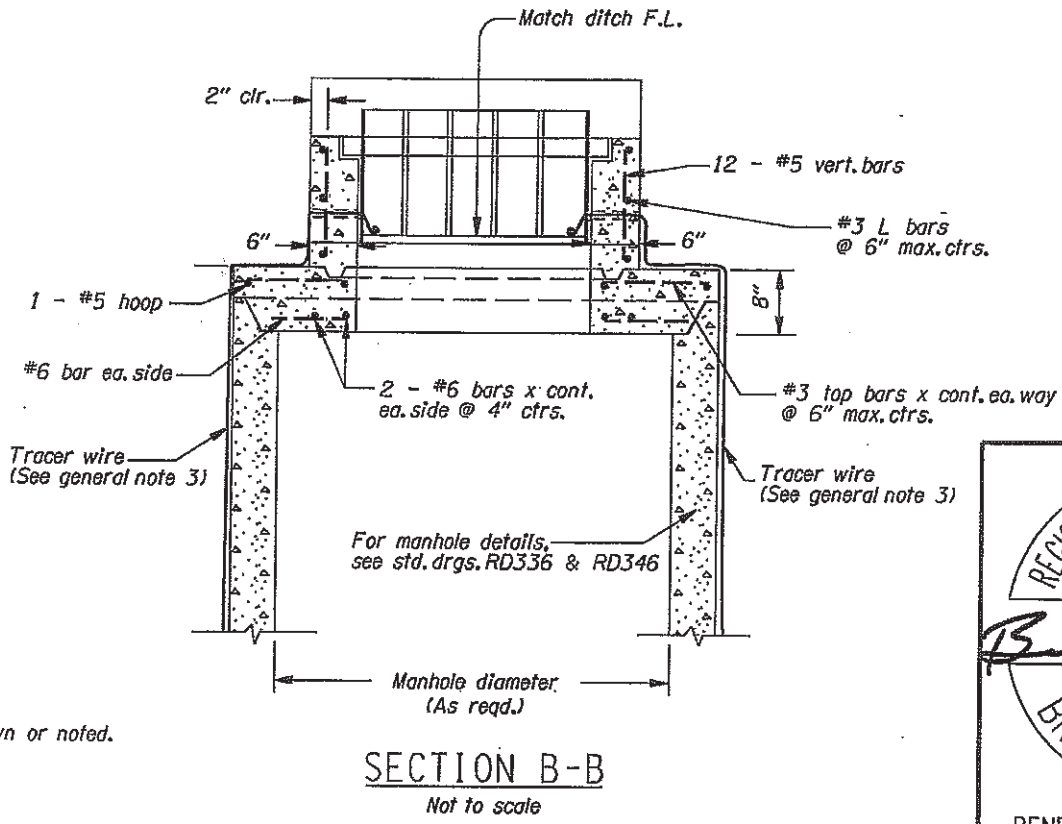


GENERAL NOTES FOR MANHOLE W/TYPE "D" INLET DETAILS:
1. All reinforcement to be placed a minimum of 2" clear of nearest face of concrete unless otherwise shown or noted.
2. See std. drg. RD336 for manhole steps details.
3. See std. drg. RD336 for tracer wire details.
4. All precast sections shall conform to the requirements of ASTM C478.

WEIR PLATE GENERAL DETAILS

- Notes:
1. When connecting to extg. pipes their sizes, types, and invert elevations are to be verified in the field.
 2. Pipe crown plate, weir plate, and support angles shall be steel and shall be at least 1/2 inch thick, min.
 3. Embed resin-bonded anchors 4 inches, min., into concrete. Use high or low strength resin from ODOT's qualified products list, suitable for wet or submerged locations.
 4. For resin-bonded anchors, use steel threaded rods.
 5. Anchors shall be 1 inch, min., inside pipe crown plate, weir plate, and support angle edges.
 6. Hole diameters in the plates and angles for the anchors and bolts shall be 1/8 inch larger than the anchor or bolt diameters.
 7. Metal plates and all hardware shall be stainless steel or hot-dipped galvanized.

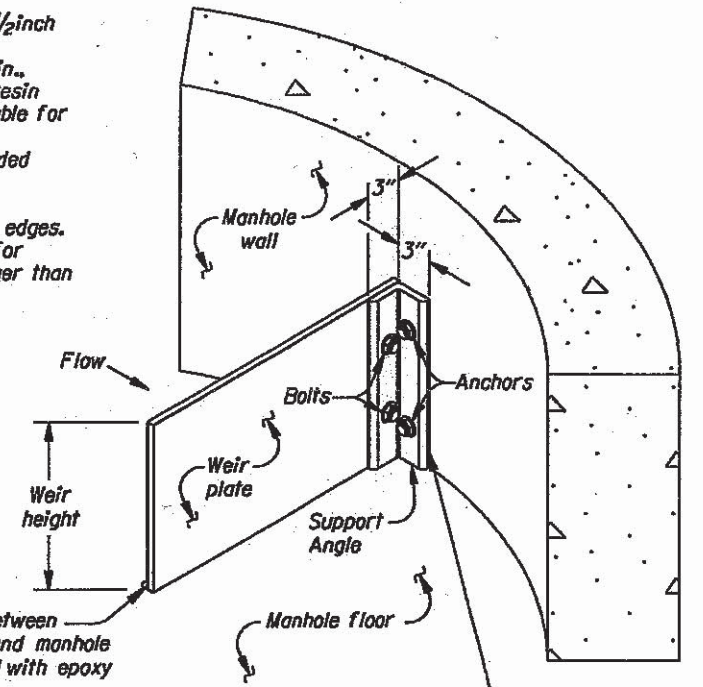


DETAIL "A"
(Typ. both ends of weir)

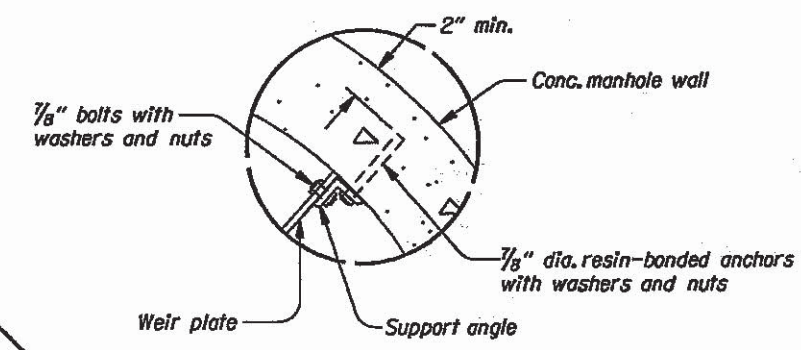


DETAIL "B"

"AS CONSTRUCTED"
Wayne A. Staller
PROJECT MANAGER
17 Dec 2012
DATE


DIVERSION MANHOLE "HIGH-LOW", LOW FLOW TO SIDE
Sta. "I" 27+86.84, 56.73' Lt.

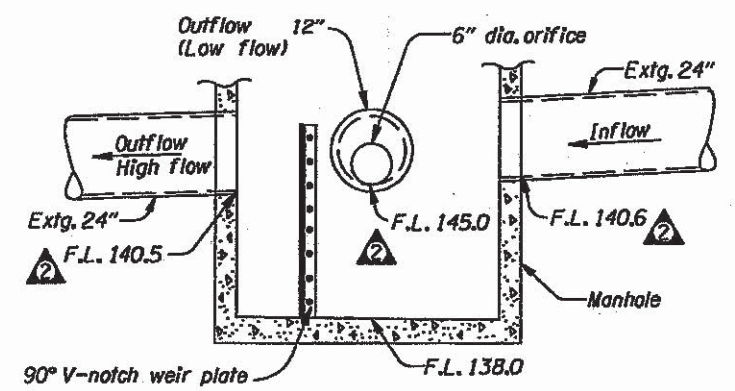

SECTION A-A
Not to scale

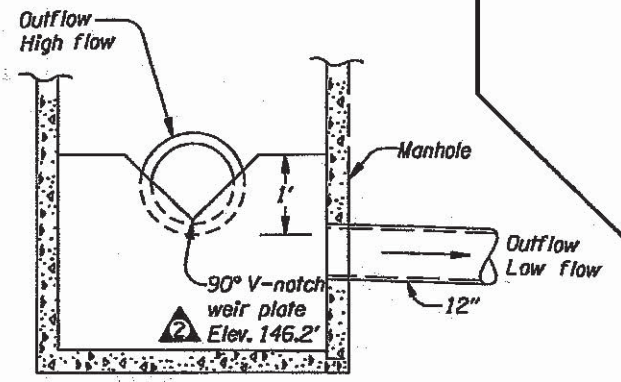


SECTION B-B
Not to scale

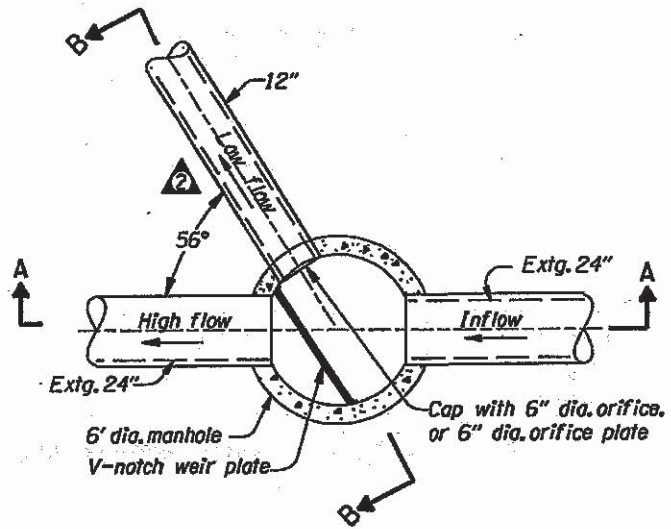

PLAN
Not to scale

No.	DATE	REVISIONS	BY
①	9-24-10	deleted diversion manhole split flow	S.B. for B.S.C.
②	9-24-10	Revised diversion manhole elevations & pipe angle	S.B. for B.S.C.

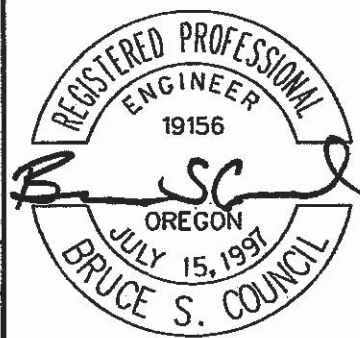

RENEWAL DATE: 12-31-2011

OREGON DEPARTMENT OF TRANSPORTATION

REGION 1 - Geo/Hydro/HazMat Unit

1-5: SW IOWA STREET VIADUCT BR#08197 SEC.
PACIFIC HIGHWAY
MULTNOMAH COUNTY

Reviewed By - Dan Gunther
Designed By - Bruce Council
Drafted By - Charlotte Gerken


DETAILS

SHEET NO. GJ-6

- ① Const. inlet protection - 2
(Type 3)
- ② Const. inlet protection - 2
(Type 4)
(See drg. no. RD1015)
- ③ See shts. GN-5 & GN-6
Inst. Erosion Control Matting
(See drg. no. RD1055)

LEGEND

- Inlet protection
- ▨ Erosion control matting

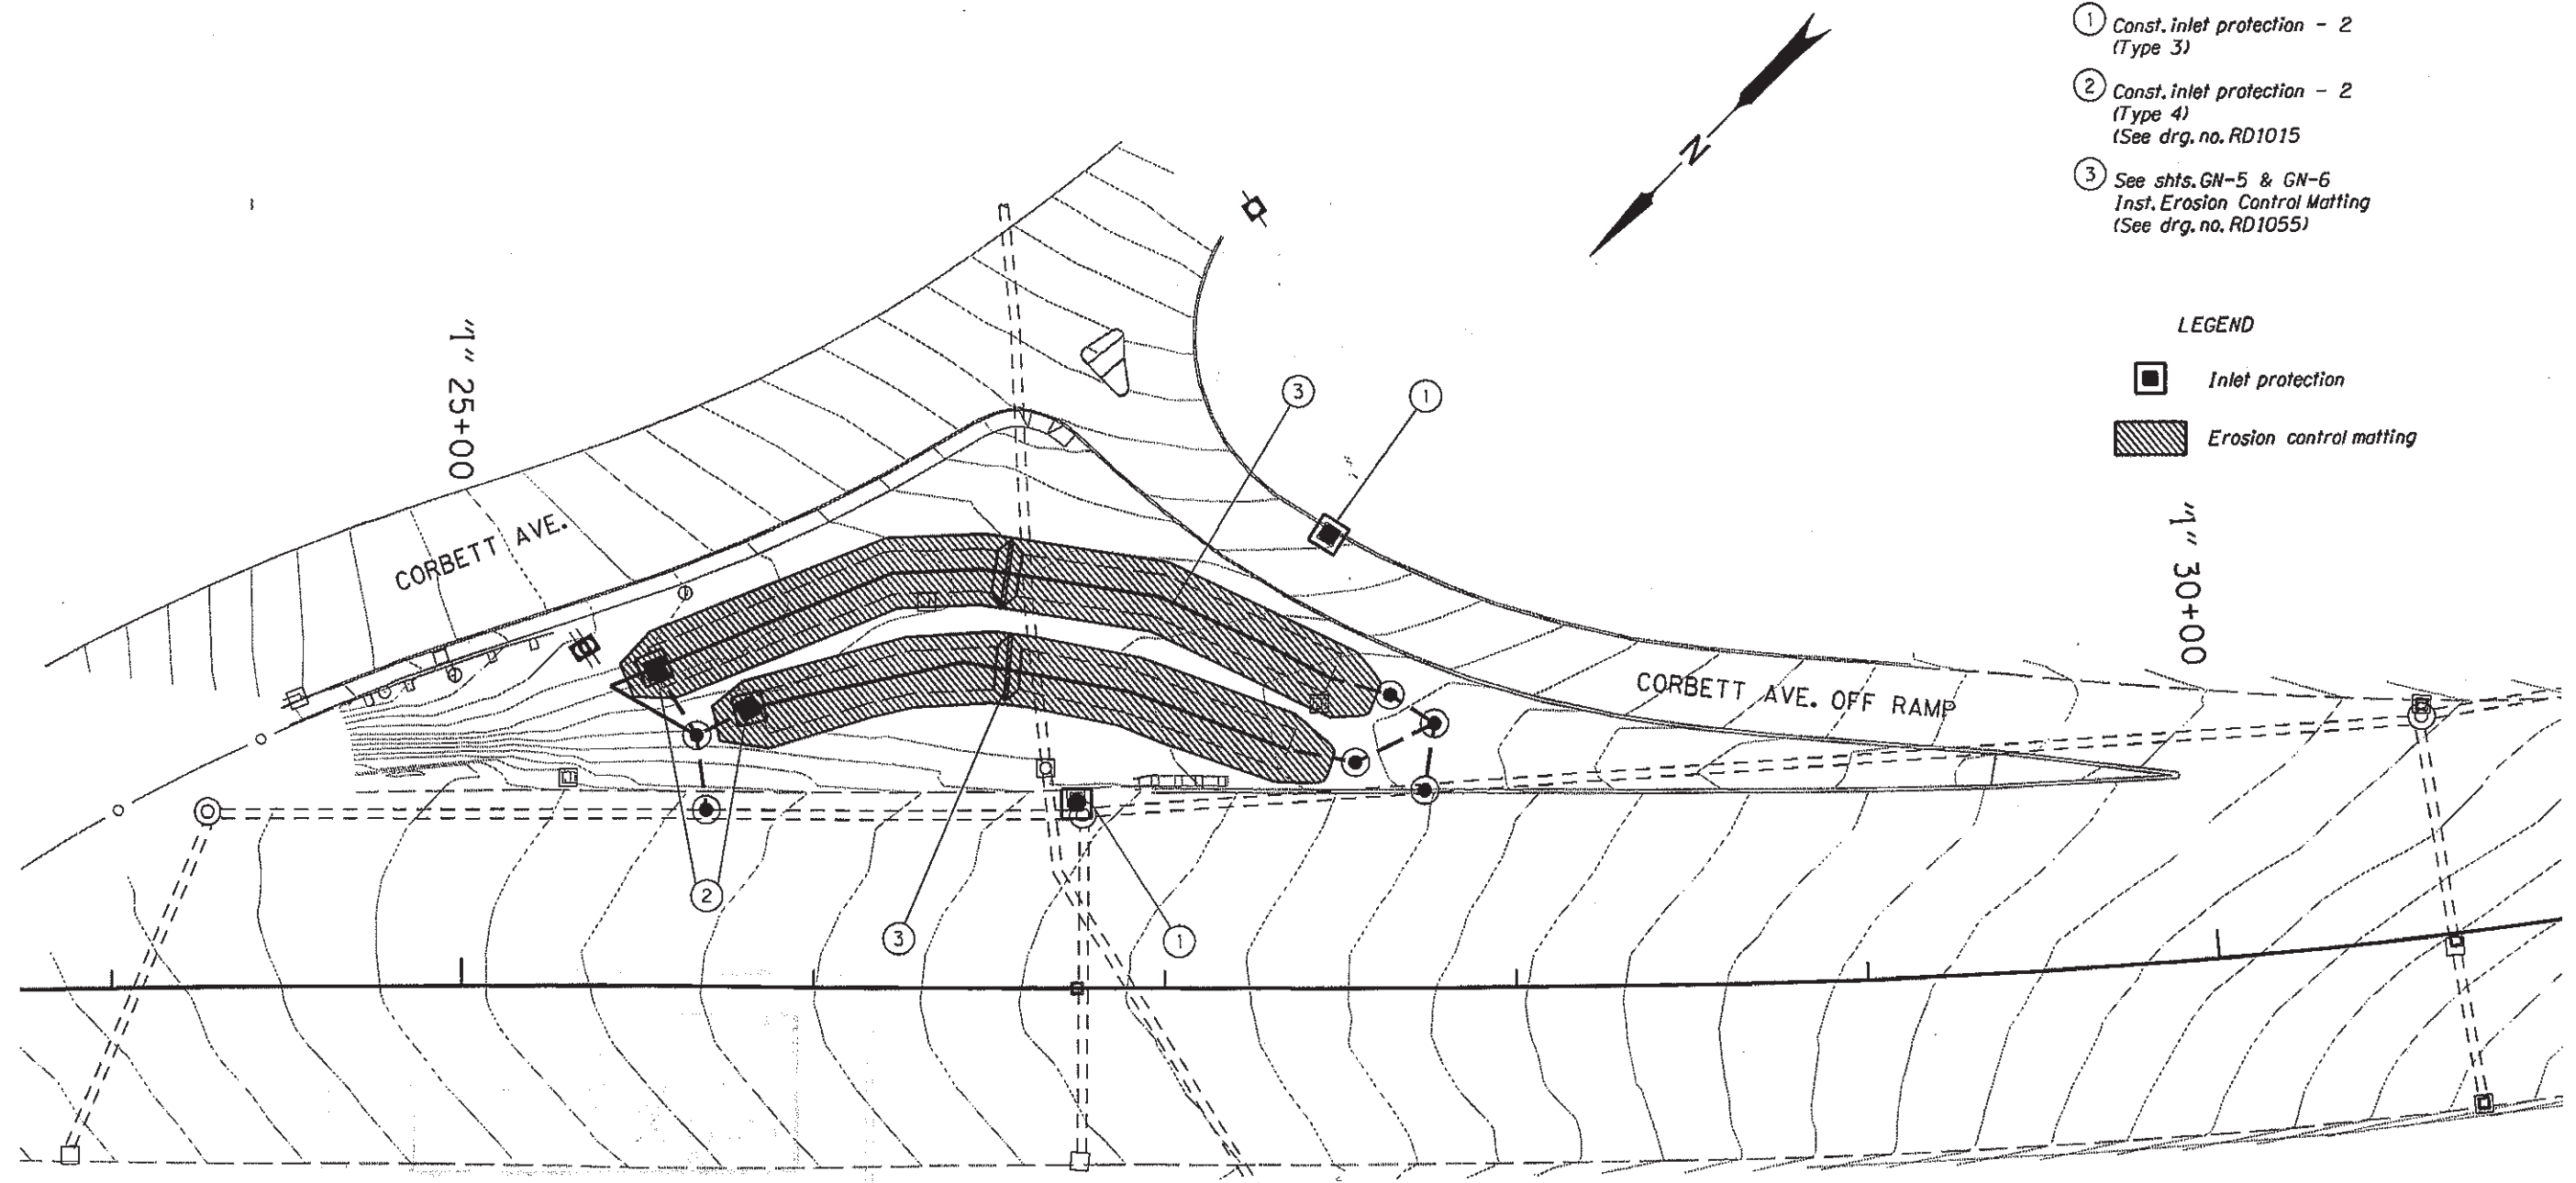

PLAN
1"=50'

"AS CONSTRUCTED"
Wayne A. Statler
PROJECT MANAGER
15 JAN 2012
DATE

REGISTERED PROFESSIONAL
ENGINEER
19156
Bruce S. Council
OREGON
JULY 15, 1997
BRUCE S. COUNCIL

RENEWAL DATE: 12-31-2011

OREGON DEPARTMENT OF TRANSPORTATION	
REGION 1 - Geo/Hydro/HazMat Unit	
I-5: SW IOWA STREET VIADUCT BR#08197 SEC. PACIFIC HIGHWAY MULTNOMAH COUNTY	
Reviewed By - Dan Gunther Designed By - Bruce Council Drafted By - Charlotte Gerken	
EROSION CONTROL PLAN	SHEET NO. GJ-7