

OPERATION & MAINTENANCE MANUAL

Water Quality Biofiltration Swale

Manual prepared: February 2019

DFI No. D01226



Figure 1: DFI No. D01226, looking southeast

Identification

Drainage Facility ID (DFI): D01226
Facility Type: Water Quality Biofiltration Swale
Construction Drawings: (V-File Numbers) 42V-190
Location: District: 2B
Highway No.: 160
Mile Post: 10.90 – 10.93, [Left side]

1. Manual Purpose

The purpose of this manual is to outline inspection needs and summarize maintenance actions.

2. Facility Location

The location map below details the facility location. The highway, mile posts, side streets, access location, and stormwater flow directions are noted on the map.

Facility location type: Roadway shoulder

Flow direction: North

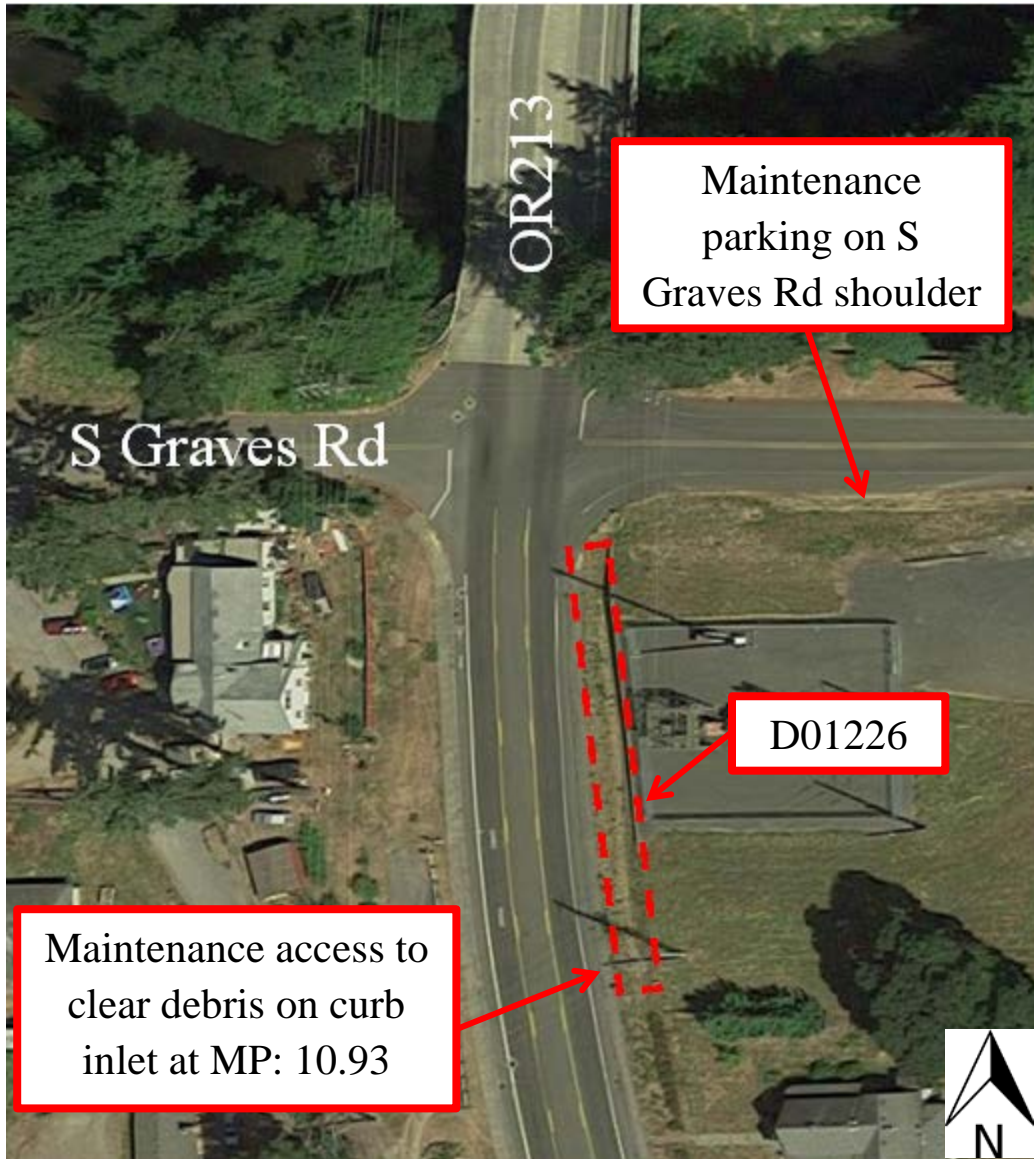



Figure 2: Facility Map

3. Facility Summary

The length and width of a swale is based on the bottom dimensions.

The bottom length and bottom width of the swale is:


Bottom Length (feet)	Bottom Width (feet)
167	3

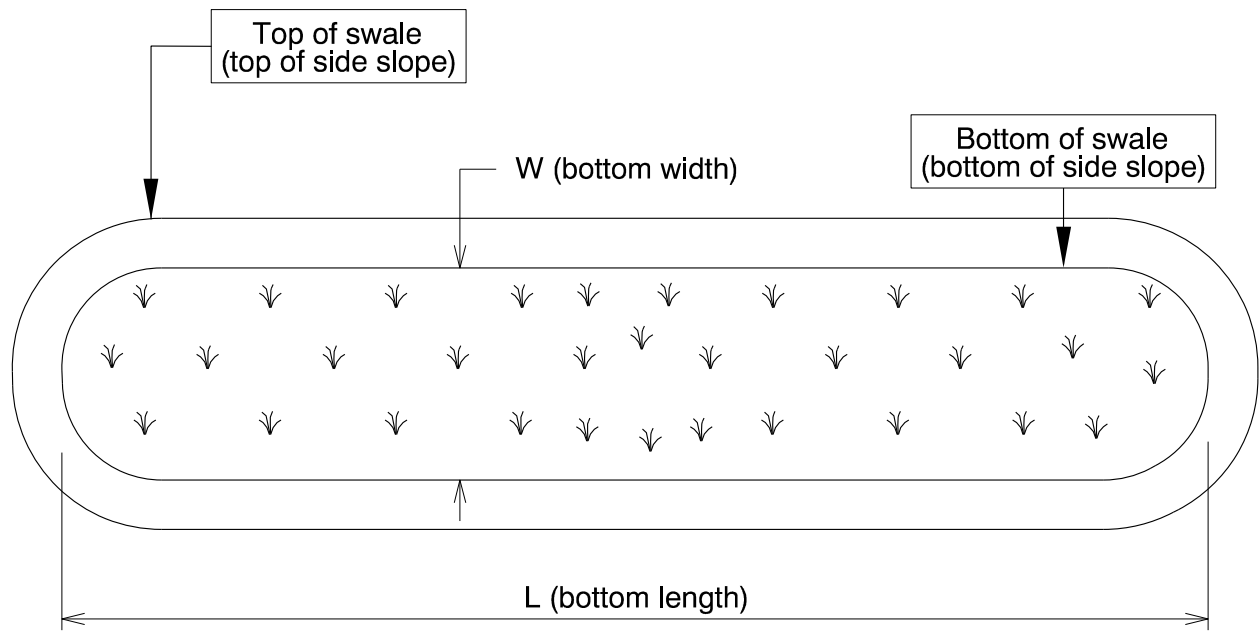

The depth of the swale is the vertical distance measured from the bottom of the swale to the top. The slope of the swale sides is presented by a vertical distance (rise) followed by the horizontal distance (run).

Depth and side slopes:

Depth (feet)	Rise (feet)	Run (feet)
1.5	1	3

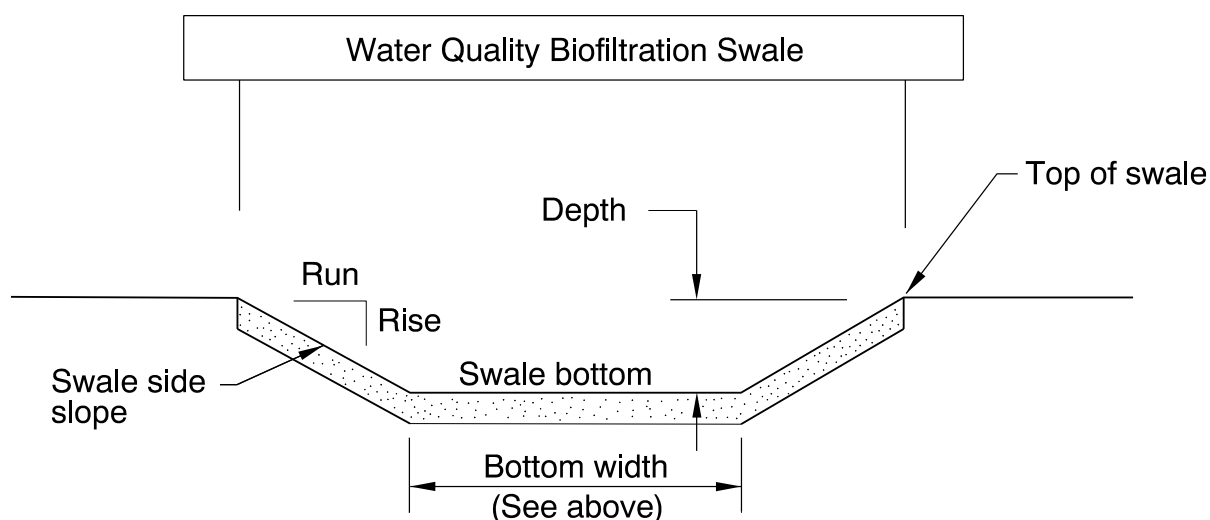

Site Specific Information: Water enters the facility via pavement sheet flow through a curb inlet. There is a rip rap pad at the beginning of the swale with an energy dissipater. The water flows to the north through the swale. The water exits the facility through a Type “D” inlet, flows through a manhole and into a storm sewer system. The shoulder on the highway next to the water quality facility is too small for vehicle access. The facility can be accessed by the roadway shoulder off of S Graves Rd. However, the curb inlet at MP: 10.93 will need to be cleared of debris, so maintenance vehicles will need to park here when vactoring the inlet. The highway shoulder is not wide enough for a vehicle to park, so closing a lane will be necessary. The swale and its alignment can be found in Appendix B under “PGE_SW” on page GJ-6.

4. Facility Access

Maintenance access to the facility:

<input type="checkbox"/> Roadside pad	<input checked="" type="checkbox"/> Roadside shoulder
<input type="checkbox"/> Access road with Gate	<input type="checkbox"/> Access road without Gate



Figure 2: Maintenance parking for facility



Figure 4: Maintenance access for clearing curb inlet to swale, looking northeast

5. Operational Components / Maintenance Items

Classification

This facility is classified as an:

<input checked="" type="checkbox"/> On-line Swale	<input type="checkbox"/> Off-line Swale
A swale that does not include a high flow bypass component; flow drains into and through the facility	A swale that treats low/small flows and diverts high flows using a bypass component

Bypass Component

This facility includes a high flow bypass component:

<input checked="" type="checkbox"/> No	<input type="checkbox"/> Yes
There is no bypass component. High flows drain into and through the facility	There is a bypass component. Only low/small flows drain into the swale. High flows are diverted around the swale using a bypass component

Operational Components

A swale has many components that assist with treatment, conveyance, and reducing flow velocity to minimize erosion. The components in use can vary depending if the facility was designed to operate on-line or off-line. The facility components table (**Table 1**) has been provided to highlight the applicable components for this facility. The component is in use when the box contains an “x” (e.g.).

The Standard Operation Manual for Water Quality Biofiltration Swales (implemented March 2017) outlines facility operation, typical footprint configuration, and component definitions and details. A link to the manual is attached to the feature marker in TransGIS.

<https://gis.odot.state.or.us/TransGIS/>

Operational Plan

The applicable standard operational plan for this facility is:

<input type="checkbox"/> Operational Plan A	<input checked="" type="checkbox"/> Operational Plan B	<input type="checkbox"/> Operational Plan C
An on-line swale with roadside ditches	An on-line swale with piped inlets and outlets	An off-line swale with a piped high flow bypass
A standard operational plan illustrates the general facility footprint configuration and explains the purpose of each facility component. Operational plans (A, B, C) are provided in the Standard Operation Manual.		

See Appendix A for the site specific operational plan.

Maintenance Items

Operational components marked in **Table 1** should be inspected and maintained according to Section 7. Each facility component is defined and detailed in the Standard Operation Manual using the associated ID number indicated below.

Table 1: Swale Components		ID #
Manholes/Structures		
Pre-treatment manhole	<input type="checkbox"/>	S1
Weir type flow splitter/flow splitter manhole	<input type="checkbox"/>	S2
Orifice type flow splitter/flow splitter manhole	<input type="checkbox"/>	S3
Standard manhole	<input checked="" type="checkbox"/>	S4
Swale Inlet		
Pavement sheet flow	<input checked="" type="checkbox"/>	S5
Curb Inlet	<input checked="" type="checkbox"/>	S6
Open channel inlet	<input type="checkbox"/>	S7
Riprap pad	<input checked="" type="checkbox"/>	S8
Ground Cover		
Grass bottom	<input checked="" type="checkbox"/>	S9
Grass side slopes	<input checked="" type="checkbox"/>	S10
Granular drain rock	<input type="checkbox"/>	S11
Plantings	<input type="checkbox"/>	S12
Underground Components		
Geotextile fabric	<input checked="" type="checkbox"/>	S13
Amended Soils	<input checked="" type="checkbox"/>	S14
Perforated pipe	<input checked="" type="checkbox"/>	S15
Porous pavers (access grid)	<input type="checkbox"/>	S16
Flow Spreader		
Rock basin (used at inlet)	<input type="checkbox"/>	S17
Anchored board (midpoint of swale or every 50 feet along swale bottom)	<input type="checkbox"/>	S18
Other: describe type	<input type="checkbox"/>	S19
Swale Outlet		
Catch basin with grate (Type "D" Inlet)	<input checked="" type="checkbox"/>	S20
Outlet Pipe (s)	<input checked="" type="checkbox"/>	S21
Open channel outlet	<input type="checkbox"/>	S22
Auxiliary Outlet: describe type	<input type="checkbox"/>	S23
Outfall Type		
Waterbody (Creek/Lake/Ocean)	<input type="checkbox"/> C	S24
	<input type="checkbox"/> L	
	<input type="checkbox"/> O	
Ditch	<input checked="" type="checkbox"/>	S25
Storm drain system	<input checked="" type="checkbox"/>	S26
Outfall Components		
Riprap pad	<input type="checkbox"/>	S27
Riprap bank protection	<input type="checkbox"/>	S28

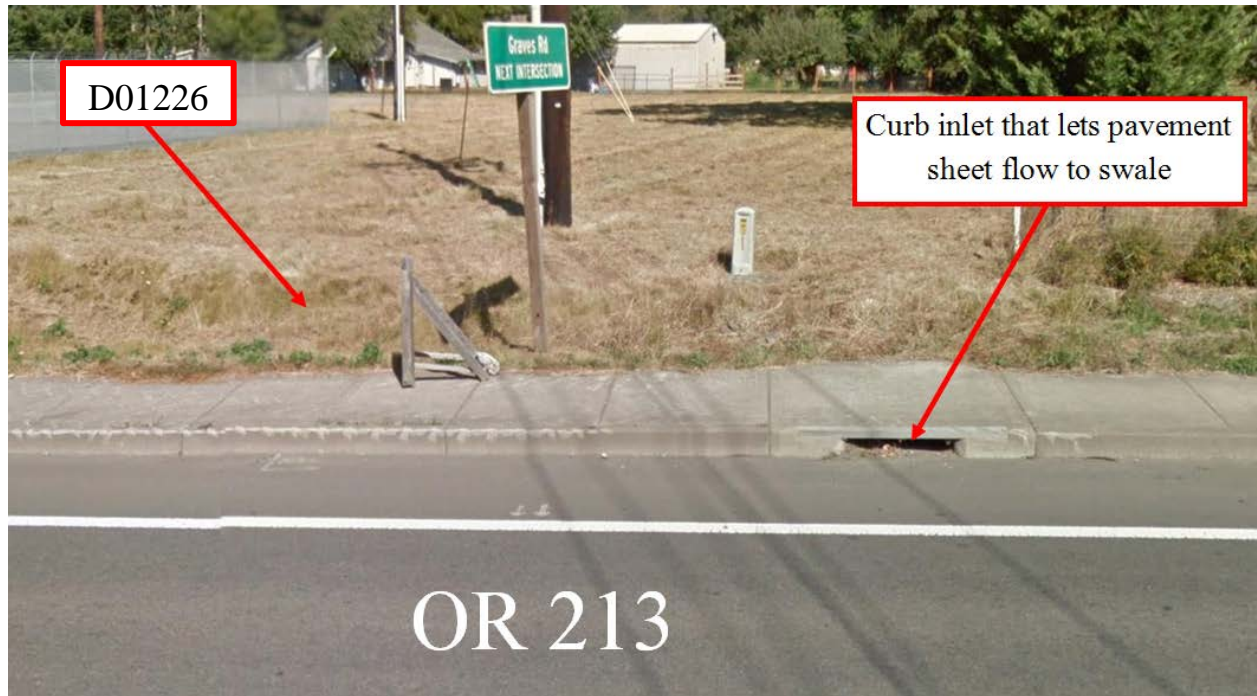


Figure 5: Water flows into the facility by pavement sheet flow

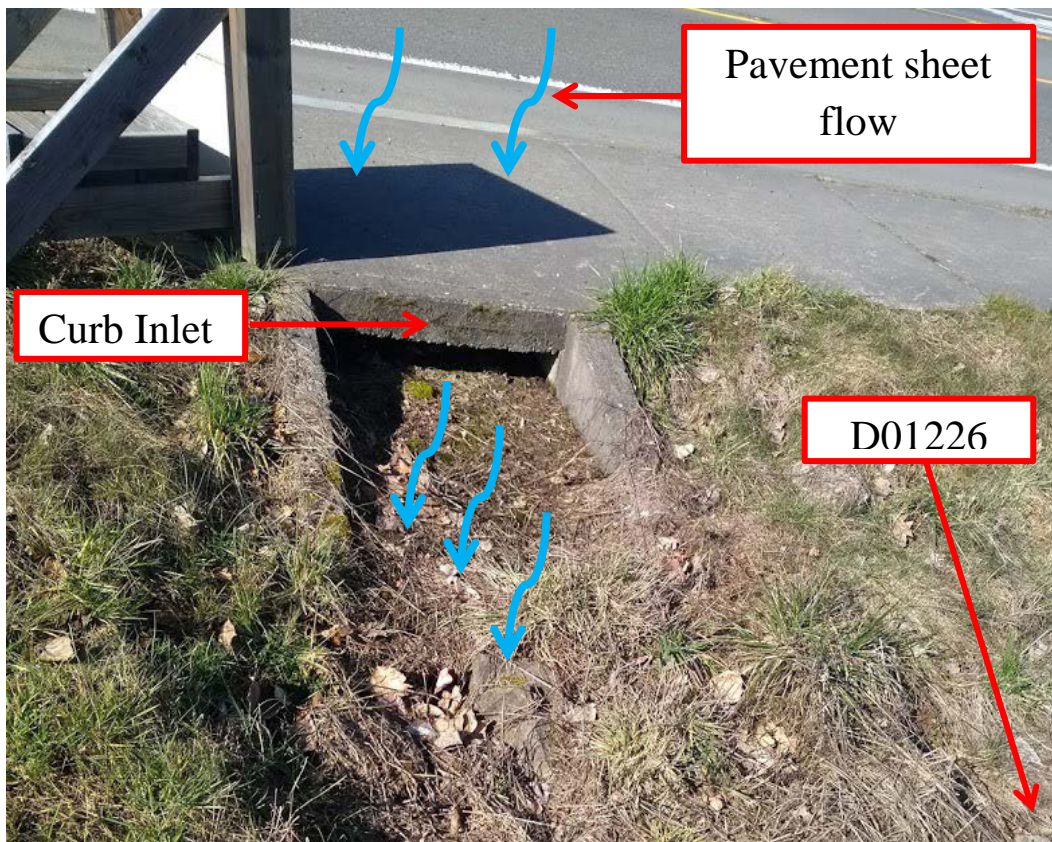


Figure 6: Curb Inlet



Figure 7: Swale Inlet



Figure 8: Swale Outlet

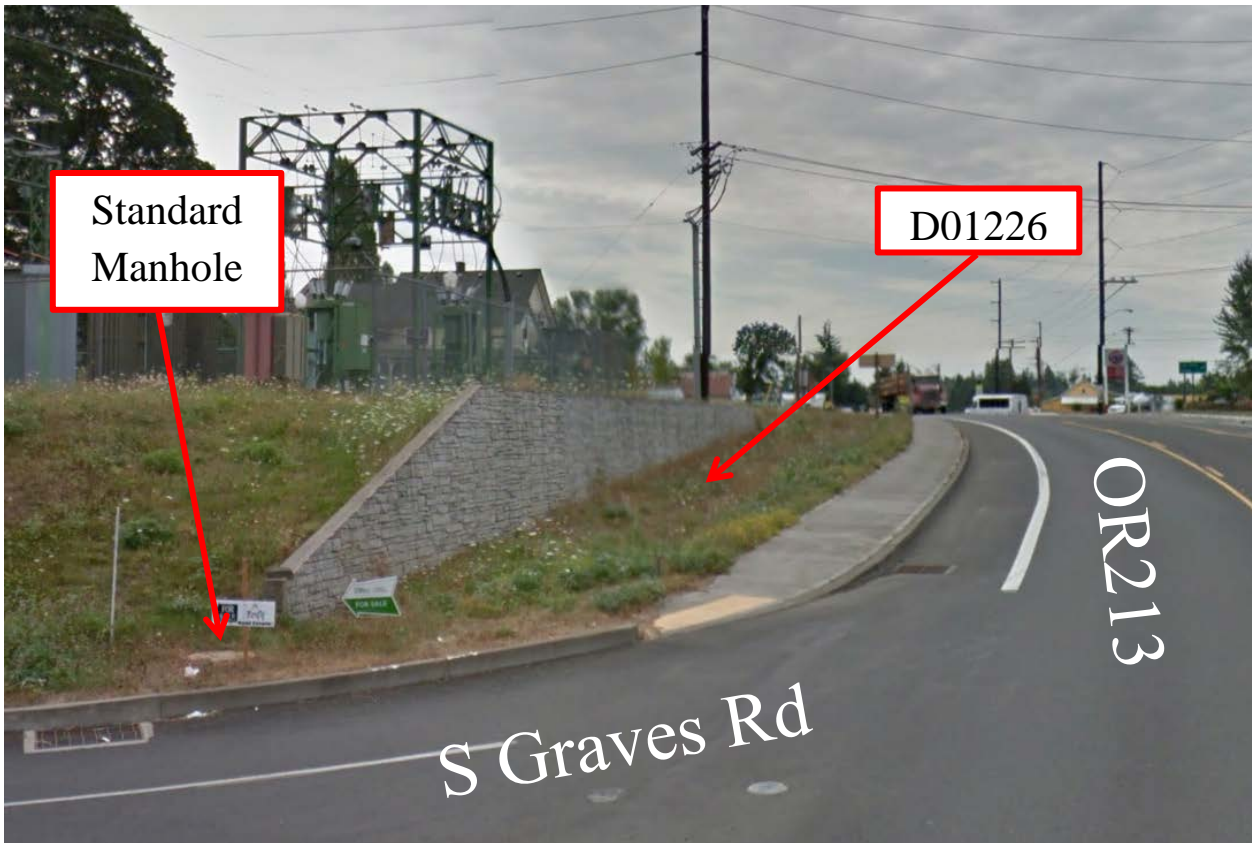


Figure 9: Water flows through manhole and into storm drain system

6. Maintenance

Maintenance Frequency/Maintain Records

- a. Inspect annually. Preferably prior to the rainy season.
- b. Clean and maintain as necessary. Refer to Activity 125 for conditions when maintenance is needed.
- c. Keep a record of inspections, maintenance, and repairs.

Maintenance Guide/Maintenance Actions

The ODOT Routine Road Maintenance Water Quality and Habitat Guide (the *Blue Book*) outlines the standard maintenance actions for water quality facilities under Activity 125.

There are standard maintenance tables for standard ODOT designs. The maintenance tables describe the maintenance component, the defect or problem, the condition when maintenance is needed, and the recommended maintenance to correct the problem. Use the following tables to maintain ODOT swales:

- Table 1 (General Maintenance): Contains general maintenance and inspection guidelines that are applicable to all ODOT water quality facilities
- Table 3 (Maintenance of Water Quality or Biofiltration Swales): Contains maintenance information for swales

The *Blue Book* can be viewed at the following website:

http://www.oregon.gov/ODOT/Maintenance/Documents/blue_book.pdf

7. Limitations

Access grid installed:

<input checked="" type="checkbox"/> No	<input type="checkbox"/> Yes
There are no porous pavers installed in this swale	

Swales are designed to allow equipment access along the bottom. If an access grid is **NOT** installed, vehicles entering the swale can create depressions (tire ruts), damage vegetation, and damage structural components (e.g. flow spreaders). These conditions may result in poor treatment and drainage performance.

Equipment wheels should be kept on the tops and side slopes. Mower arms may be run along the swale bottom.

8. Waste Material Handling

Material removed from the facility is defined as waste by the Department of Environmental Quality (DEQ). Refer to the roadwaste section of the ODOT Maintenance Yard Environmental Management System (EMS) Policy and Procedures Manual for disposal options:

http://www.oregon.gov/ODOT/Maintenance/Documents/ems_manual.pdf

Contact any of the following for more detailed information about management of waste materials found on site:

ODOT Clean Water Unit	(503) 986-3008
ODOT Statewide Hazmat Coordinator	(503) 667-7442
ODOT Region 1 Hazmat Coordinator	(503) 731-8290
ODOT Region 2 Hazmat Coordinator	(503) 986-2647
ODOT Region 3 Hazmat Coordinator	(541) 957-3594
ODOT Region 4 Hazmat Coordinator	(541) 388-6186


ODOT Region 5 Hazmat Coordinator
ODEQ Northwest Region Office

(541) 963-1590
(503) 229-5263

A Appendix A – Site Specific Operational Plan

Contents:


Operational Plan: DFI D01226

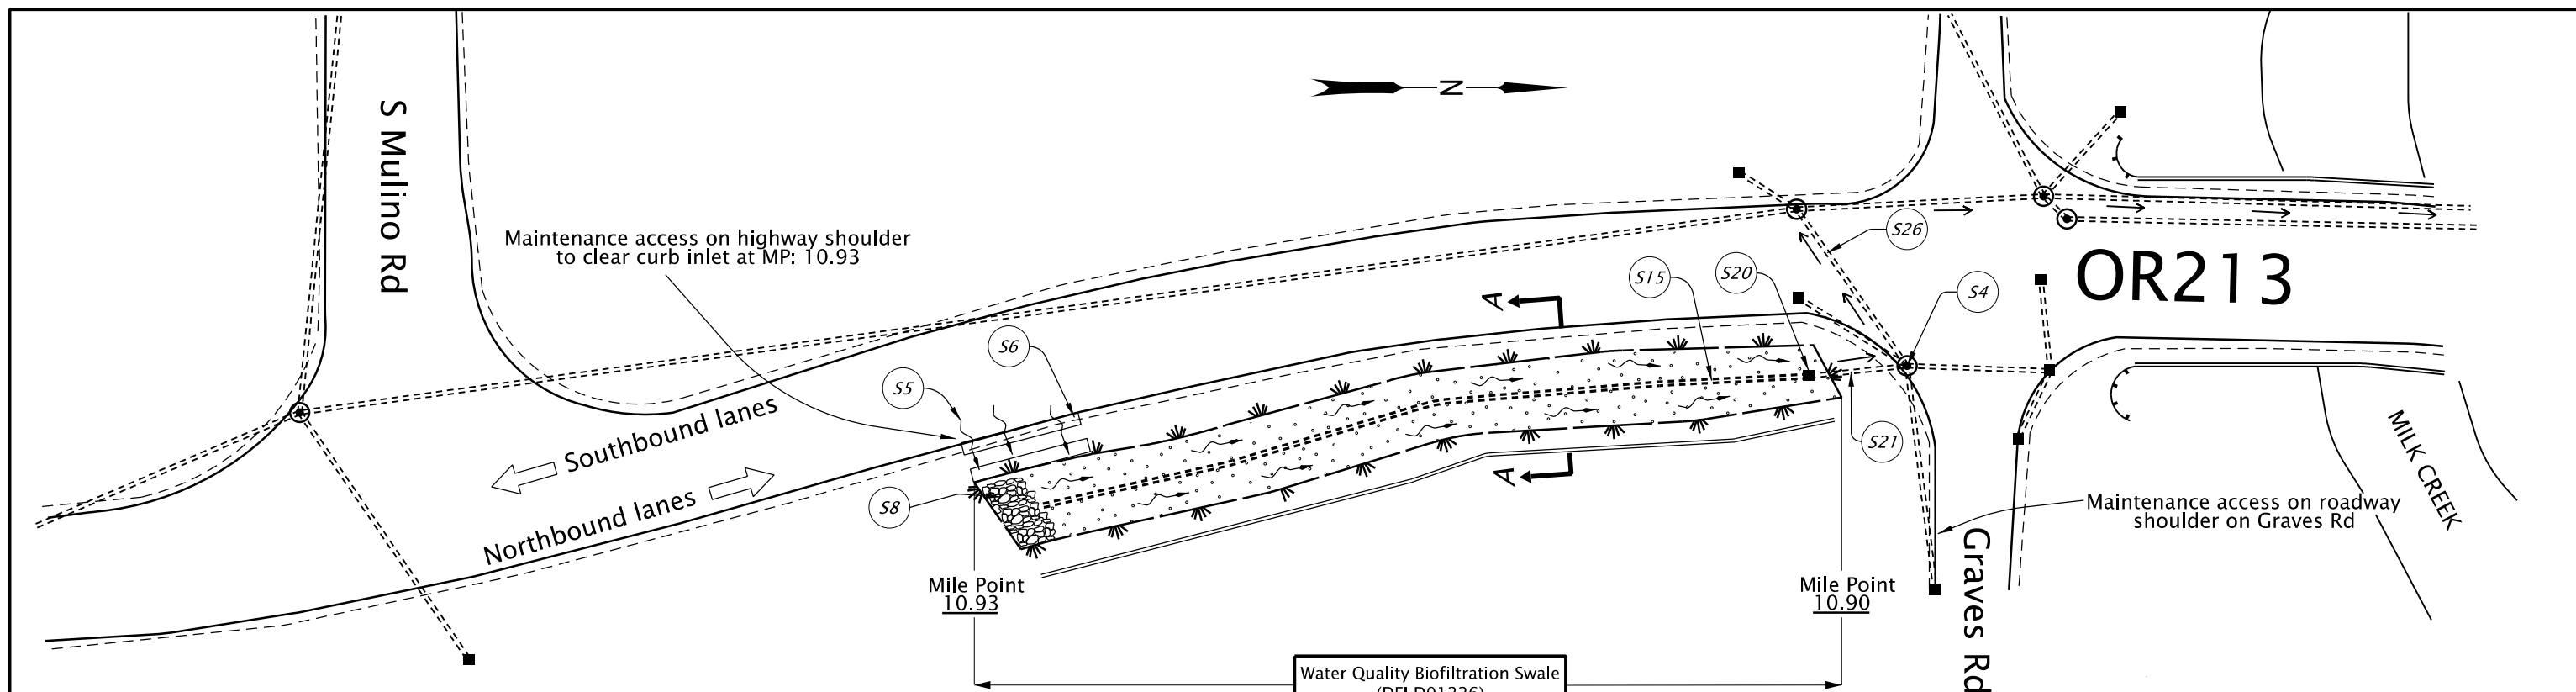


Water Quality Biofiltration Swale
(DFI D01226)

± 167'

PLAN
N.T.S.

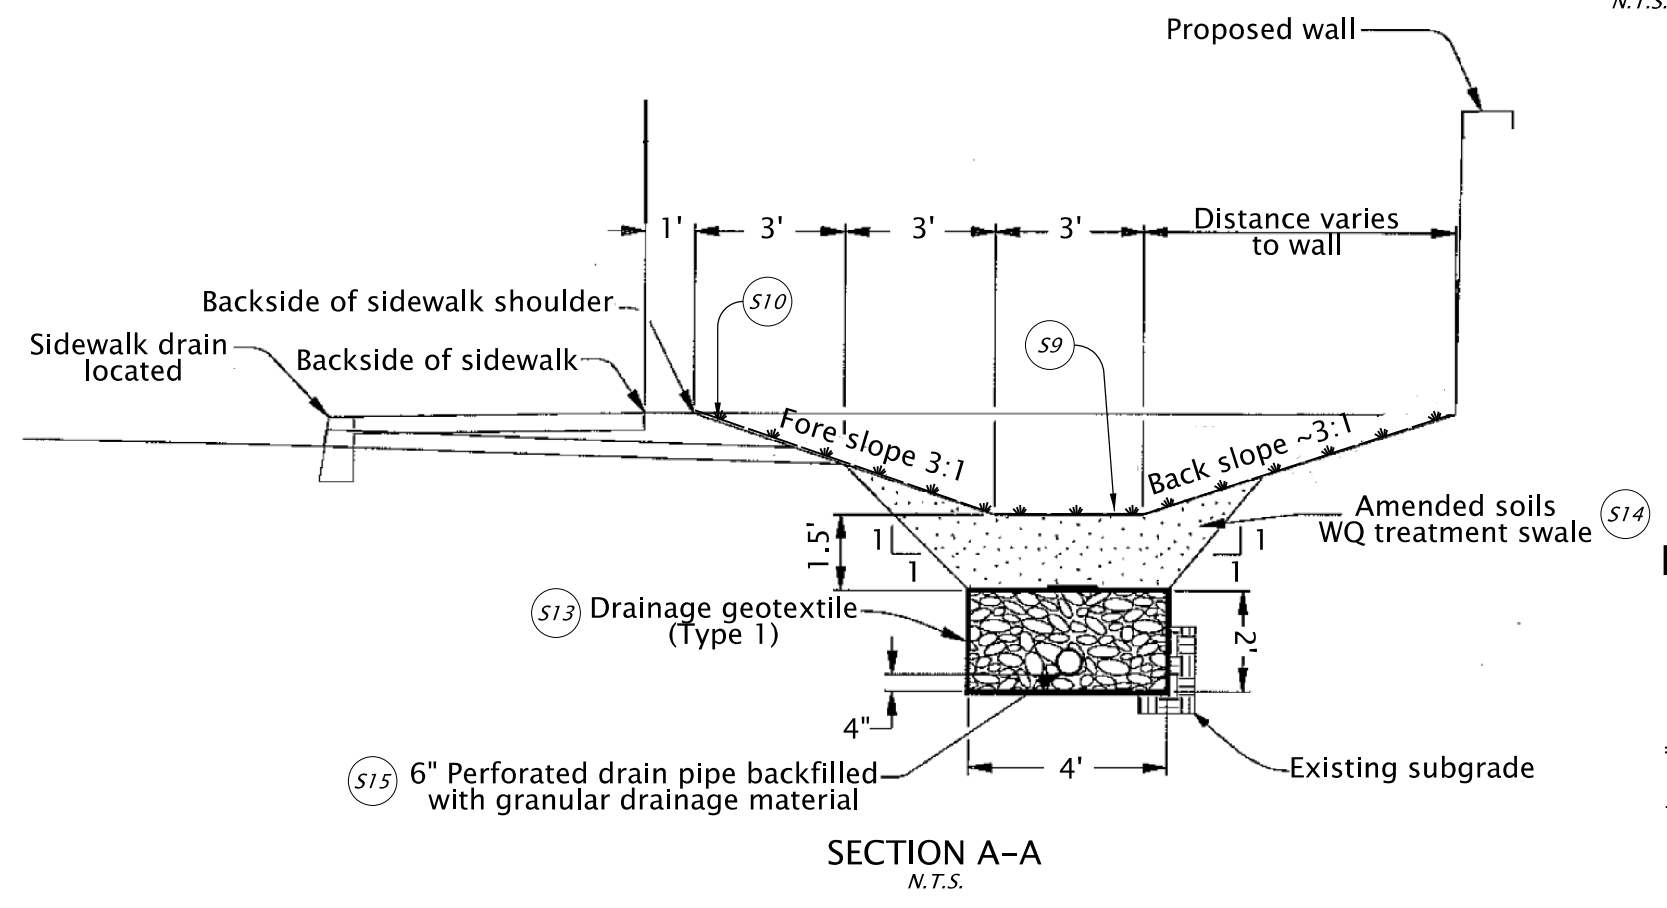

SECTION A-A
N.T.S.

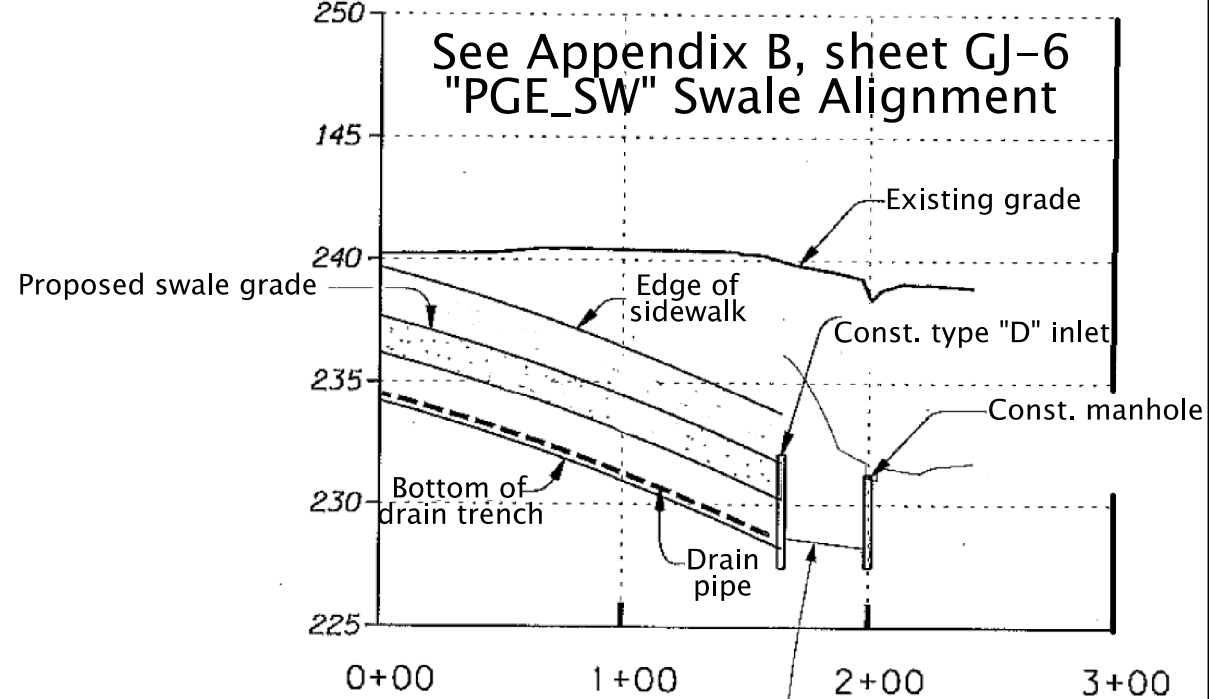

See Appendix B, sheet GJ-6
"PGE_SW" Swale Alignment

PROFILE
N.T.S.

LEGEND:

- ⊙ Manhole
- Inlet
- ===== Pipe
- Water Conveyance Direction
- ~ Water Flow Direction
- ⇨ Traffic Flow Direction



OREGON DEPARTMENT
OF TRANSPORTATION

Sht. 01 of 01

Prepared By:
Katrlna Sepulveda

Drafted By:
Katrlna Sepulveda

DFI D01226
MAINTENANCE DISTRICT 2B HWY 160
Water Quality Biofiltration Swale
Cascade Highway MP 10.90 - 10.93
Clackamas County

B Appendix B – Project Contract Plans

Contents:

Site Specific Subset of Project Contract Plan 42V-190

Partial Plan Set

Contract Plans

42V-190

INDEX OF SHEETS	
SHEET NO.	DESCRIPTION
1	Title Sheet
1A & 1A-2	Index Of Sheets Cont'd. & Std. Drg. Nos.

STATE OF OREGON DEPARTMENT OF TRANSPORTATION

PLANS FOR PROPOSED PROJECT


GRADING, DRAINAGE, STRUCTURE, PAVING, AND SIGNING

OR213:CASCADE HWY S (MILK CR BR) MULINO SEC. CASCADE HIGHWAY SOUTH

CLACKAMAS COUNTY
NOVEMBER 2009


NOT REVISED AS CONSTRUCTED
21 SEP 2012 CONTRACT 14146
PROJ.MGR. MARJORIE WEST

Marjorie West

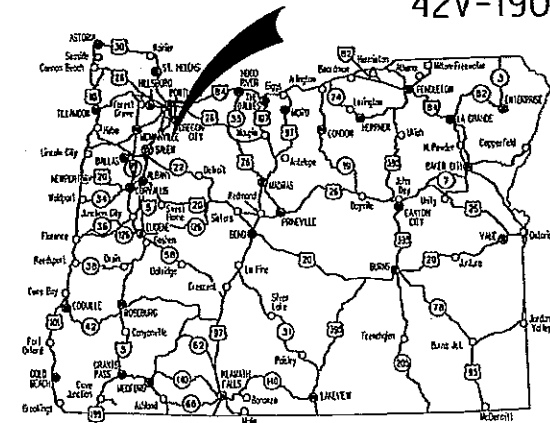


Overall Length Of Project - 0.86 Miles

ATTENTION:
Oregon Law Requires You To Follow Rules Adopted By The Oregon Utility Notification Center. Those Rules Are Set Forth In OAR 952-001-0010 Through OAR 952-001-0090. You May Obtain Copies Of The Rules By Calling The Center. (Note: The Telephone Number For The Oregon Utility Center Is (503) 232-1987.)

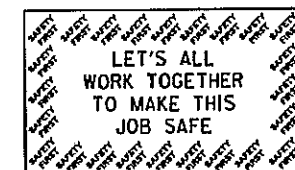

**BEGINNING OF PROJECT
X-BRF-NTSA-S160(045)
STA. "C" 262+20 (M.P. 11.18)**

**BEGINNING OF CONTRACT PROJECT
STA. "C" 252+55 (M.P. 11.36)**

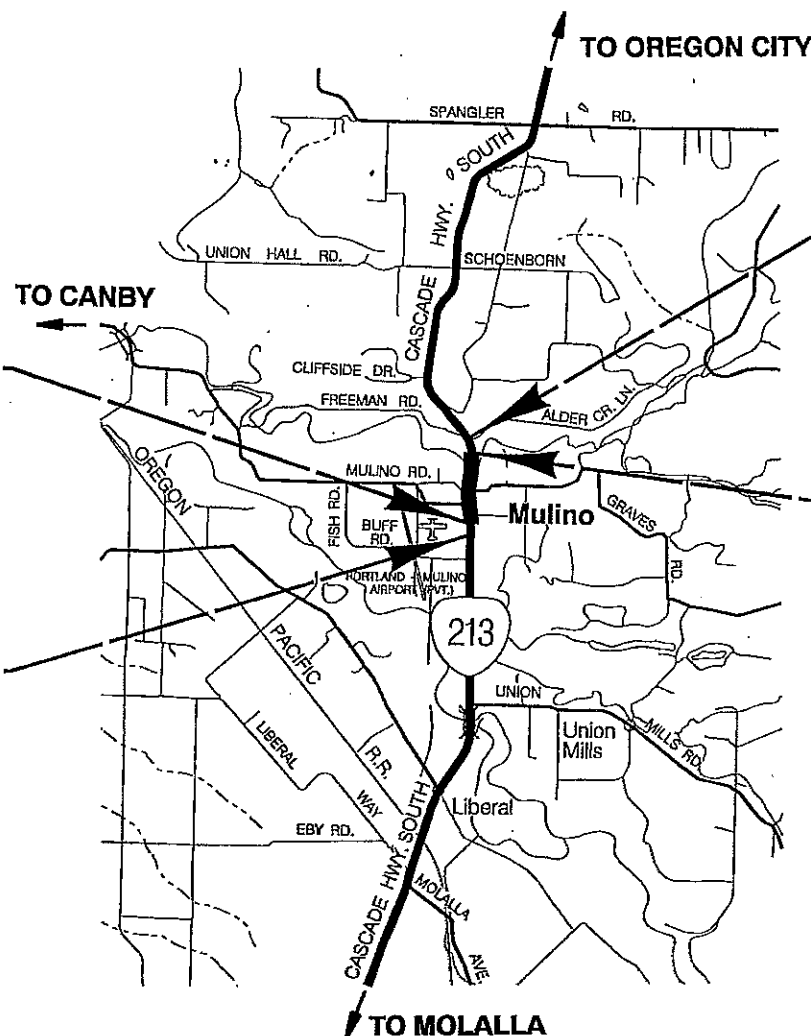

**END OF CONTRACT PROJECT
STA. "C" 294+00 (M.P. 10.50)**

**END OF PROJECT
X-BRF-NTSA-S160(045)
STA. "C" 289+06.0 (M.P. 10.59)**

OREGON TRANSPORTATION COMMISSION

- | | |
|--------------------|----------------------------|
| Gail Achterman | CHAIR |
| Michael Nelson | VICE-CHAIR |
| Janice Wilson | COMMISSIONER |
| Alan Brown | COMMISSIONER |
| David Lohman | COMMISSIONER |
| Matthew L. Garrett | DIRECTOR OF TRANSPORTATION |

These plans were developed using ODOT design standards. Exceptions to these standards, if any, have been submitted and approved by the ODOT Chief Engineer or their delegated authority.

Approving Authority: *Naveen G. Chandra*
Naveen G. Chandra, P.E.
Project Delivery Manager, Region 1

B. Johnson
Concurrence by ODOT Chief Engineer

**OR213:CASCADE HWY S (MILK CR BR)
MULINO SEC.
CASCADE HIGHWAY SOUTH
CLACKAMAS COUNTY**

FEDERAL HIGHWAY ADMINISTRATION	PROJECT NUMBER	SHEET NO.
OREGON DIVISION	X-BRF-NTSA-S160(045)	1

T. 4 S., R. 2 E., W.M.



PECO 5 000


INDEX OF SHEETS, CONT'D.	
SHEET NO.	DESCRIPTION
2, 2A, 2A-2 Thru 2A-10	Typical Sections
2B, 2B-2 Thru 2B-7	Details
2C	Traffic Control Detail
2C-2	Detour Plan
2C-3 Thru 2C-12	Traffic Control Plans
2D, 2D-2 & 2D-3	Pipe Data Sheet
3	Alignment & General Construction
3A	Profile
3B	Drainage & Utilities
3C	Drainage Profile
3D	Right of Way
4	Alignment & General Construction
4A	Profile
4B	Drainage & Utilities
4C	Drainage Profile
4D	Right of Way
5	Alignment & General Construction
5A	Profile
5B	Drainage & Utilities
5C	Drainage Profile
5D	Right of Way
6	Alignment & General Construction
6A	Profile
6B	Drainage & Utilities
6C	Drainage Profile
6D	Right of Way
GEO/HYDRO	
GA, GA-2 Thru GA-4	Erosion Control Plans
GB & GB-2	Geotechnical Data
GC, GC-2 Thru GC-4	Retaining Wall, Plan, Profile & Detail
GG	Temporary Water Management
GH	Bridge Scour Countermeasure
GJ, GJ-2 Thru GJ-5	Pipe Profiles
GJ-6 Thru GJ-11	Water Quality Plan, Profile & Detail
GN, GN-2 Thru GN-19	Roadside Development Plan
PERMANENT PAVEMENT MARKINGS	
ST Thru ST-4	Striping Plan

Standard Drg. Nos.

- RD100 - Mailbox Support
- RD101 - Mailbox Installation
- RD250 - Thrust Blocking
- RD254 - Hydrant Installation
- RD270 - Combination Air-Release Air Vacuum Valve Assembly
- RD274 - 3/4" - 2" Water Service Connection
- RD300 - Trench Backfill, Bedding, Pipe Zone And Mult. Installations
- RD302 - Street Cut
- RD316 - Sloped Ends For Metal Pipe
- RD318 - Sloped Ends For Concrete Pipe
- RD326 - Coupling Bands For Corrugated Metal Pipe
- RD330 - Metal Pipe Slope Anchors
- RD336, RD342, RD344, RD346 - Manholes
- RD356 - Manhole Cover & Frames
- RD360 - Manhole Frame Adjustment
- RD364, RD366, RD368, RD370 - Concrete Inlets
- RD380, RD384, - Pipe Fill Height Tables
- RD386, RD388, RD390
- RD400, RD405, RD410, RD415, - Guardrail
- RD420, RD425, RD435, RD450
- RD500 - Precast Concrete Barrier Pin And Loop Assembly
- RD515 - Median Barrier Anchoring Details
- RD530 - Guardrail Transition To Concrete Barrier
- RD545 - Precast Tall (42") Concrete Barrier
- RD610 - Asphalt Pavement Details
- RD700 - Curbs
- RD715 - Approaches & Non-Sidewalk Dwys.
- RD720 - Sidewalks
- RD735 - Curb Line Sidewalk Dwys. Or Alleys
- RD755 - Sidewalk Ramp Details
- RD756, RD757 - Sidewalk Ramp Placement
- RD759 - Truncated Dome Detectable Warning Surface Details And Locations
- RD770, RD771 - Pedestrian Handrail
- RDB10 - Barbed And Woven Wire Fences
- RDB15 - Chain Link Fence
- RD1005 - Check Dams
- RD1010, RD1015, RD1020 - Inlet Protection
- RD1025, RD1030, RD1035 - Sediment Barrier
- RD1040 - Sediment Fence
- RD1045 - Temporary Slope Drains
- RD1055 - Matting

- BR139, BR141, BR145 - Expansion Joints
- BR165 - Bridge End Panel Details
- BR200 - Concrete Bridge Rail Type F
- BR203 - Transition Conc. Br. Rail To Guard Rail
- BR233 - Thrie-Beam Rail
- BR250 - Pedestrian Rail
- BR270 - Rail Transition Details Flex Beam Rail To Three Tube Rail
- BR273 - Thrie Beam Rail Retrofit For Curb And Parapet Rail
- BR286 - Retrofit For Steel Handrail With Sidewalk
- BR321 - BT90 And BT96 Girders
- BR350 - Temp. Diaphragm Beam For Prestressed Conc. Girders
- BR705 - Standard Retaining Walls Front Face Battered 1" Per Ft.
- TM200 - Sign Installation Details
- TM201 - Miscellaneous Sign Placement Details
- TM204 - Flag Board Mounting Details
- TM211, TM212 - Signing Details
- TM221, TM222 - Milepost Marker Details
- TM223, TM224 - Directional Sign Layout
- TM492 - Ramp Meter Layout And Details
- TM500, TM501, TM502, TM503 - Pavement Marking Standard Details
- TM515 - Raised Pavement Markers
- TM517 - Recessed Pavement Markers
- TM520, TM521 - Durable Pavement Markings
- TM525 - Turn Arrow Marking Details
- TM530 - Intersection Pavement Markings
- TM539 - Median And Left Turn Channelization Details
- TM560, TM561 - Alignment Layout
- TM570 - Traffic Delineators
- TM576 - Traffic Delineator Installation
- TM602 - Triangular Base Breakaway Multi-Direction Slip Base
- TM670 - Perm. Signing Wood Post Supports Sizing Charts
- TM671 - 3 Second Gust Wind Speed Isotach
- TM676 - Sign Attachments
- TM677 - Sign Mounts
- TM681, TM687, TM688 - Square Tube Sign Supports
- TM800 - Tables, Abrupt Edge And PCMS Details
- TM820 - Temporary Barricades
- TM821 - Temporary Sign Supports
- TM830 - Temporary Concrete Barrier And Rumble Strips
- TM831 - Temporary Impact Attenuators
- TM840, TM841, TM842 - Closure Details
- TM850 - 2-Lane, 2 Way Roadways
- TM851 - Non-Freeway Multi-Lane Sections
- TM870 - Bridge Construction


R/W Map No. 6B-32-9 And 5B-8-13

REVISED AS CONSTRUCTED
 21 SEP 2012 CONTRACT 14146
 PROJ. MGR. MARJORIE WEST


OR213-CASCADE HWY S (MILK CR BR)
 MULINO SEC.
 CASCADE HIGHWAY SOUTH
 CLACKAMAS COUNTY

FEDERAL HIGHWAY ADMINISTRATION	PROJECT NUMBER	SHEET NO.
OREGON DIVISION	X-BRF-NTSA-S16010451	1A

Standard Drawings located on the web at:
http://www.oregon.gov/ODOT/HWY/ENG/SERVICES/standard_drawings_home.shtml

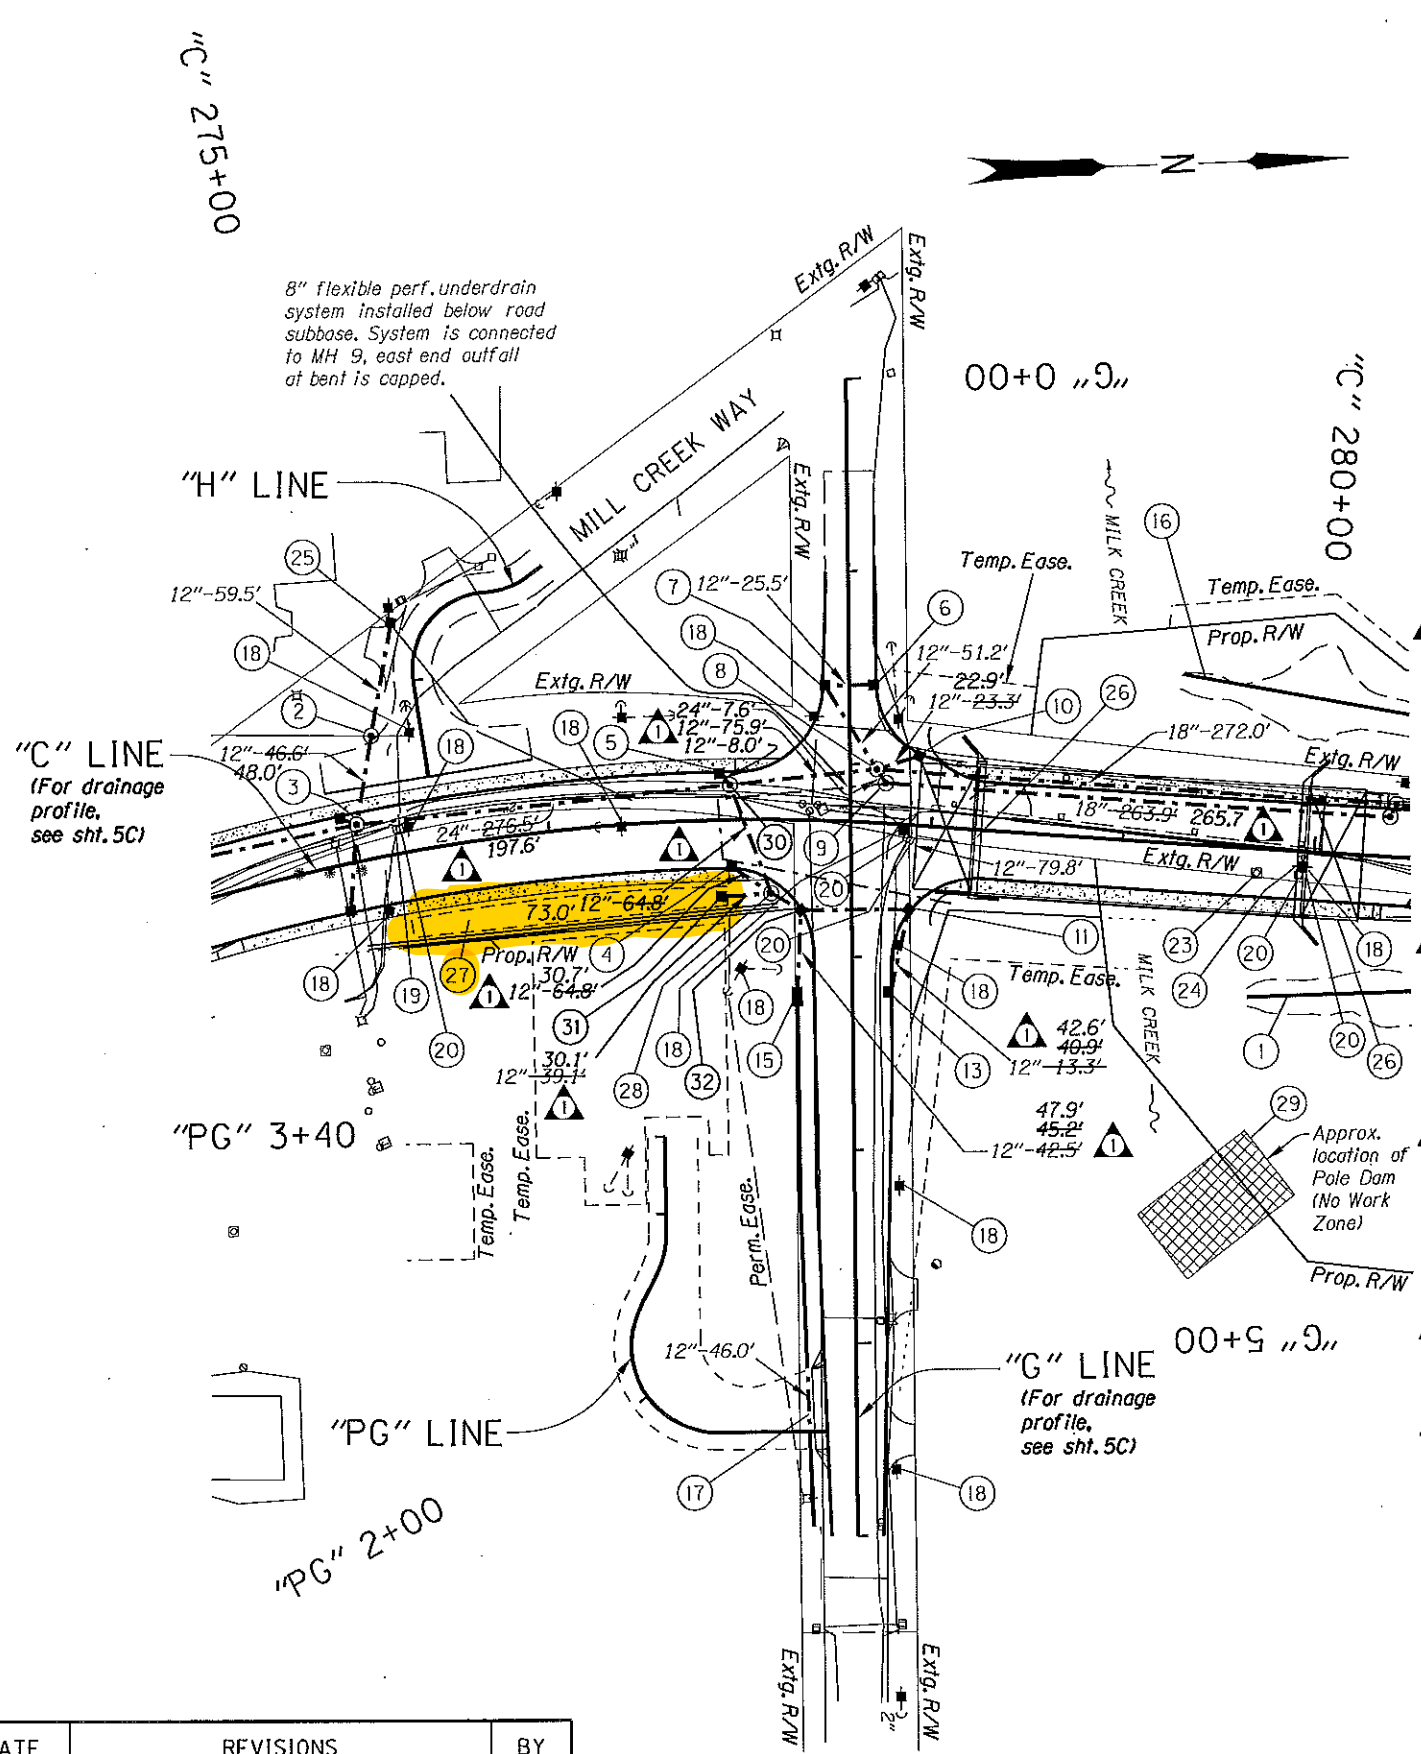

- 17 Sta. "G" 5+10.9, 25.7' Rt. to Sta. "G" 5+56.9, 24.2' Rt. 22.2' Inst. 12" culv. pipe - 46.8' 48.5' 5' depth (For details, see sht. GJ-4)
- 18 Relocate power pole - 11 (By others)
- 19 Relocate TV riser (By others)
- 20 Relocate phone riser - 5 (By others)
- 21 Note deleted
- 22 Note deleted
- 23 Relocate stream gauge (By others)
- 24 Relocate phone pole (By others)
- 25 Sta. "C" 275+36.7, 118.9 Rt. Lt. Const. "M-E" inlet (For details, see sht. GJ-3)
- 26 Inst. casings - 4 (Incidental to end panel) (See bridge drgs.)
- 27 Sta. "C" 275+21, 30.5' Rt. to Sta. "C" 276+90, 31.5' Rt. Const. water quality swale (For details, see sht. GJ-6)
- 28 Sta. "C" 277+30.6, 39.7' Rt. +22.2, 39.8' Rt. Const. manhole Inst. 12" sew. pipe - 39.1' 70.2' 5' depth (For details, see sht. GJ-6)
- 29 See sht. GN-10
- 30 Sta. "C" 276+96.2, 19.6' Lt. Const. manhole 72" dia. Inst. 12" sew. pipe - 72.8' 5' depth Inst. 24" sew. pipe - 197.6' 5' depth (For details, see sht. GJ & GJ-4)
- 31 Sta. "C" 276+90.6, 39.7' Rt. Const. type "D" inlet (For details, see sht. GJ-6 & GJ-12)
- 32 Sta. "G" 2+72.2, 26.7' Rt. Const. "G2" inlet Inst. 12" sew. pipe - 103.1' 5' depth (For details, see sht. GJ-4 & GJ-5)
- 8 Sta. "C" 277+70.0, 27.7' Lt. Const. manhole, sedimentation 72" dia. w/ 4' sump Inst. temp. outfall pipe (For details, see sht. GG) Inst. 12" sew. pipe - +56.9' 74.5' 5' depth Inst. 24" sew. pipe - -273.5' 75.9' 20' depth Trench resurf. - 120 sq.yd. (For details, see shts. GJ, GJ-3 & GJ-4)
- 9 Sta. "C" 277+75.0, 20.7' Lt. +73.2, 20.7' Lt. Const. manhole Inst. 24" sew. pipe - -8.6' 7.6' 5' depth (For details, see sht. GJ)
- 10 Sta. "C" 277+90.8, Lt. Const. type "CG-2" inlet Inst. 12" sew. pipe - 79.8' 5' depth (For details, see sht. GJ-4)
- 11 Sta. "C" 277+90.3, Rt. Const. type "CG-2" inlet 42.6' Inst. 12" sew. pipe - -35.3' 40.9' 5' depth (For details, see sht. GJ-4 & GJ-5)
- 12 Sta. "G" 3+11.0, 29.2' Lt. Const. manhole Inst. 12" sew. pipe - 71.5' 5' depth (For details, see shts. GJ-4 & GJ-5)
- 13 Sta. "G" 3+18.22, Lt. Const. type "CG-2" inlet (For details, see sht. GJ-5)
- 14 Sta. "G" 3+10.5, 29.0' Rt. Const. manhole Inst. 12" sew. pipe - 40.7' 5' depth (For details, see sht. GJ-4)
- 15 Sta. "G" 3+20.1, 29.0' Rt. Const. type "M-E" inlet (For details, see sht. GJ-4)
- 16 Sta. "C" 279+25.0, 87.5' Lt. to Sta. "C" 282+24.3, 50.2' Lt. Const. ditch Ditch exc. - 45 cu.yd.
- 1 Sta. "C" 279+73.0, 82.7' Rt. to Sta. "C" 284+30, 34.4' Rt. Const. ditch - 295' Ditch exc. - 18 cu.yd.
- 2 Sta. "C" 275+17.4, 62.8' Lt. 52.8' Const. manhole Inst. 12" sew. pipe - 59.5' 5' depth Connect To Existing Trench resurf. - 20 sq.yd. (For details, see sht. GJ-3)
- 3 Sta. "C" 275+01.9, 19.1' Lt. Const. manhole 72" dia. Inst. 24" sew. pipe - 369.7' 20' depth Inst. 12" sew. pipe - 100.4' 5' depth Trench resurf. - 225 sq.yd. (For details, see shts. GJ & GJ-3)
- 4 Sta. "C" 276+95.1, Rt. Const. "CG-2" inlet (For details, see sht. GJ-4)
- 5 Sta. "C" 276+89.7, Lt. Const. "CG-2" inlet Inst. 12" sew. pipe - 48.5' 5' depth Trench resurf. - 3 sq.yd. (For details, see sht. GJ-4)
- 6 Sta. "G" 1+59, Lt. Sta. "C" 277+67.4, Lt. Const. "CG-2" inlet (For details, see sht. GJ-4)
- 7 Sta. "G" 1+59, Rt. Sta. "C" 277+41.2, Lt. Const. "CG-2" inlet 26.8' Inst. 12" sew. pipe - 25.5' 10' 5" depth (For details, see sht. GJ-4)

REVISED AS CONSTRUCTED
 21 SEP 2012 CONTRACT 14146
 PROJ.MGR. MARJORIE WEST
Marjorie West

OREGON DEPARTMENT OF TRANSPORTATION

REGION 1 - ROADWAY ENGINEERING SECTION

OR213: CASCADE HWY S (MILK CR BR) MULINO SEC.
 CASCADE HIGHWAY SOUTH
 CLACKAMAS COUNTY

Design Team Leader - Lawrence Kretzler
 Designed By - Timothy Fredette
 Drafted By - Jaiid Heydarpour

DRAINAGE AND UTILITIES

SHEET NO. **5B**

REGISTERED PROFESSIONAL ENGINEER 17837

OREGON JULY 25, 1995



TIMOTHY P. FREDETTE

RENEWAL DATE: 12-31-2009

No.	DATE	REVISIONS	BY
1	07-16-10	Drainage Adjustments	D.N.A.

Plug and abandon extg. pipe shown thus:

REVISED AS CONSTRUCTED
 21 SEP 2012 CONTRACT 14146
 PROJ.MGR. MARJORIE WEST
Marjorie West

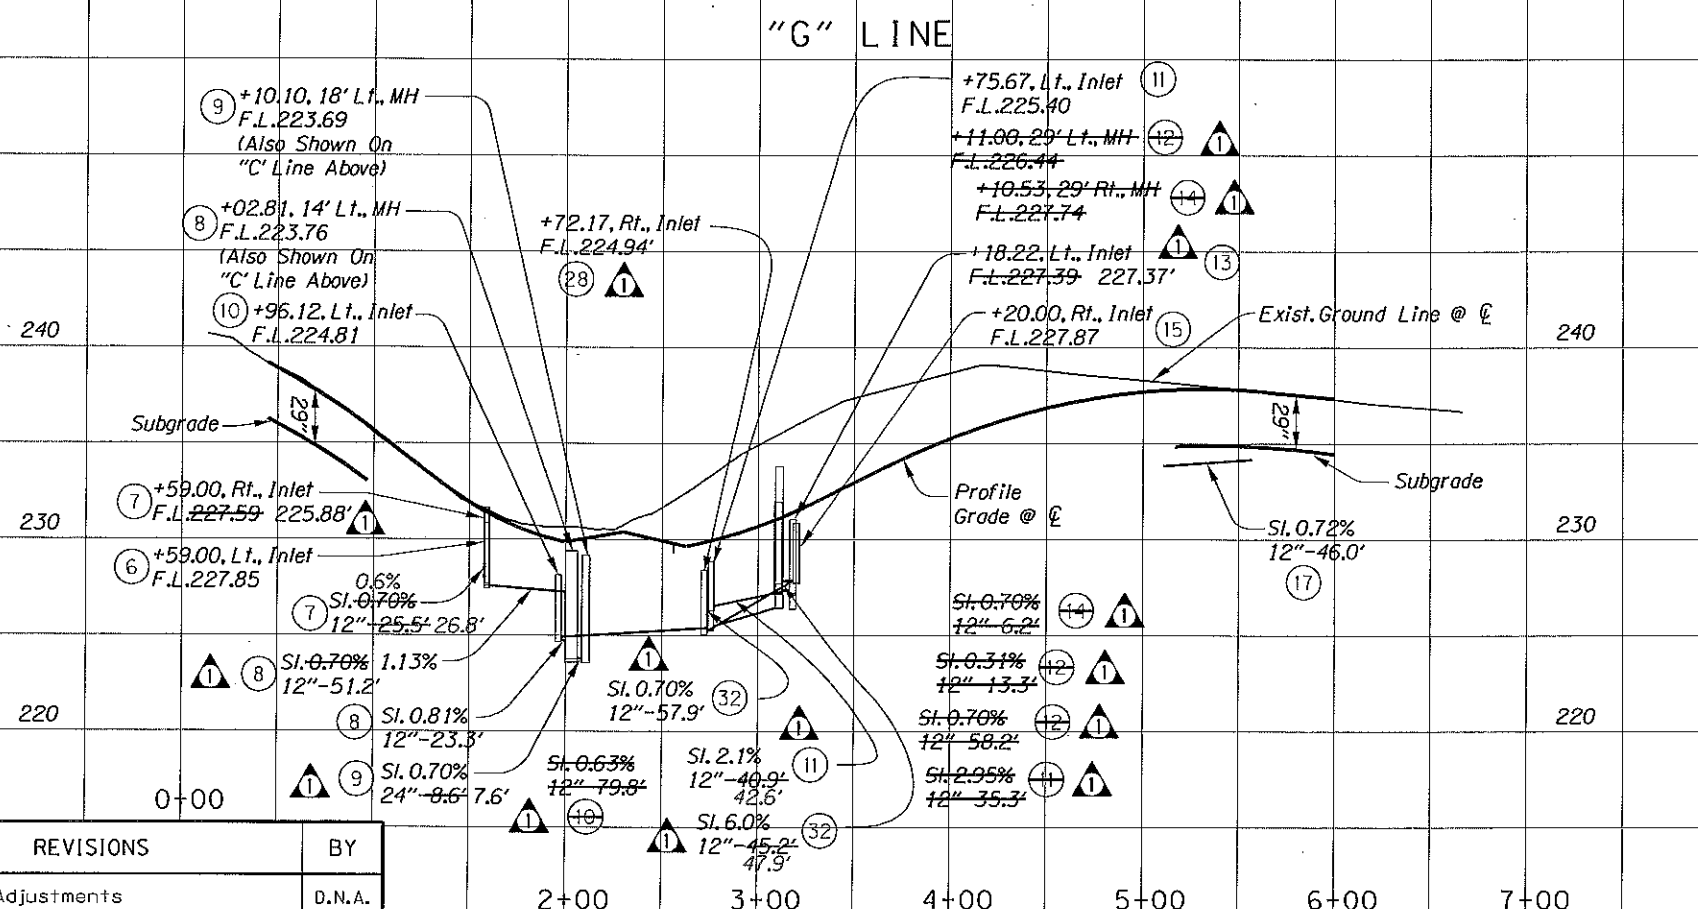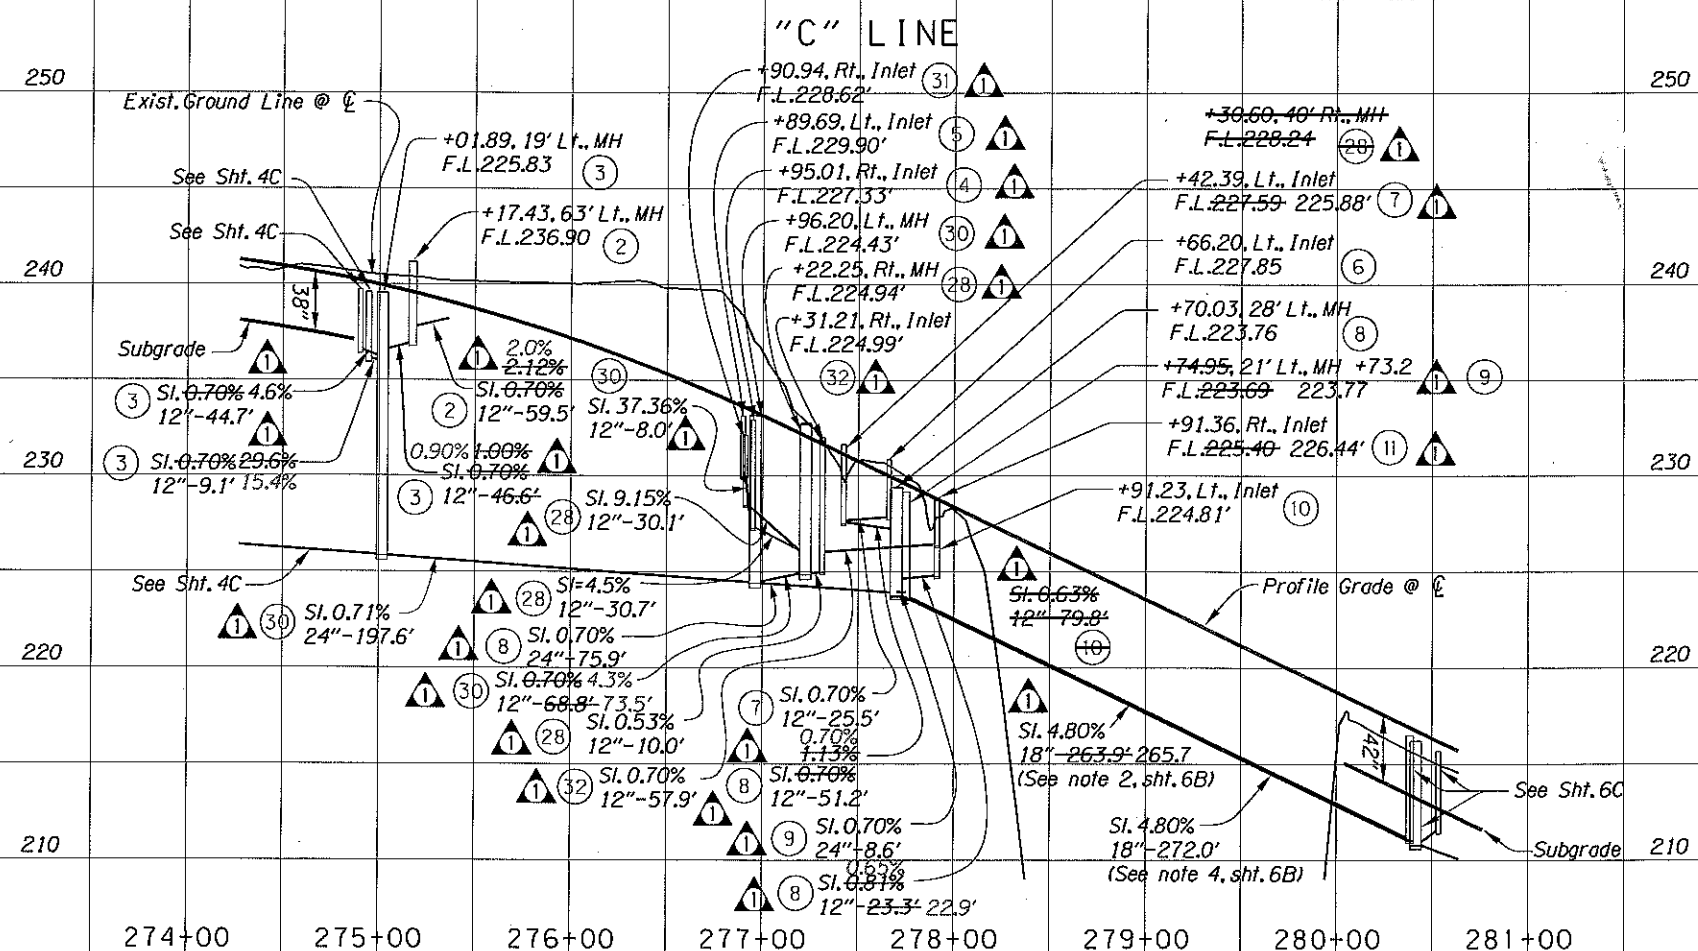

No.	DATE	REVISIONS	BY
1	07-16-10	Drainage Adjustments	D.N.A.

REGISTERED PROFESSIONAL
 ENGINEER
 17837
 OREGON
 JULY 25, 1995
 TIMOTHY P. FREDETTE
 RENEWAL DATE: 12-31-2009

OREGON DEPARTMENT OF TRANSPORTATION

REGION 1 - ROADWAY ENGINEERING SECTION


OR213:CASCADE HWY S (MILK CR BR)
 MULINO SEC.
 CASCADE HIGHWAY SOUTH
 CLACKAMAS COUNTY

Design Team Leader - Lawrence Kretzler
 Designed By - Timothy Fredette
 Drafted By - Jalal Heydarpour


DRAINAGE PROFILE

SHEET NO. 5C

REVISED AS CONSTRUCTED
 21 SEP 2012 CONTRACT 14146
 PROJ.MGR. MARJORIE WEST
Maymuth

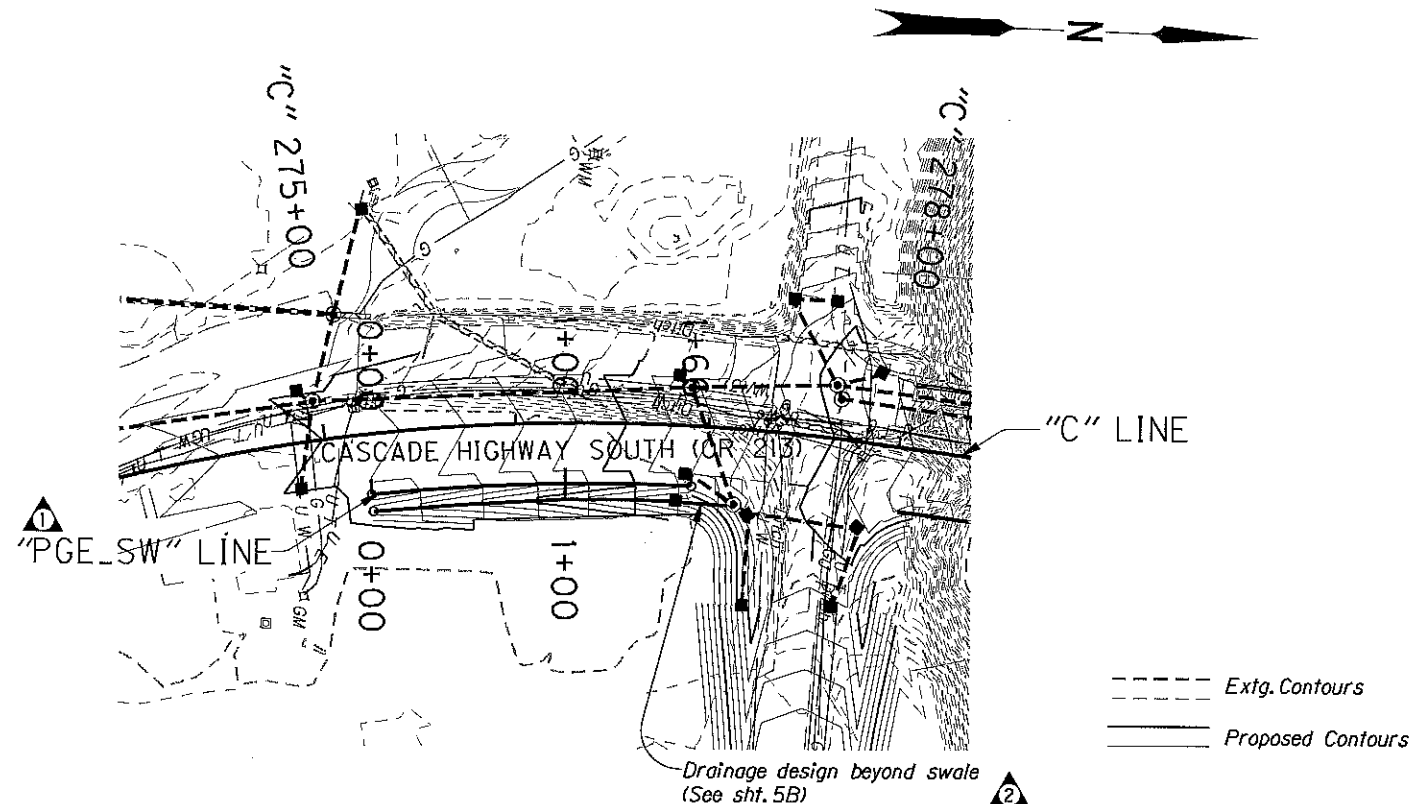


DFI D01226: MP: 10.90 - 10.93 (Left side)

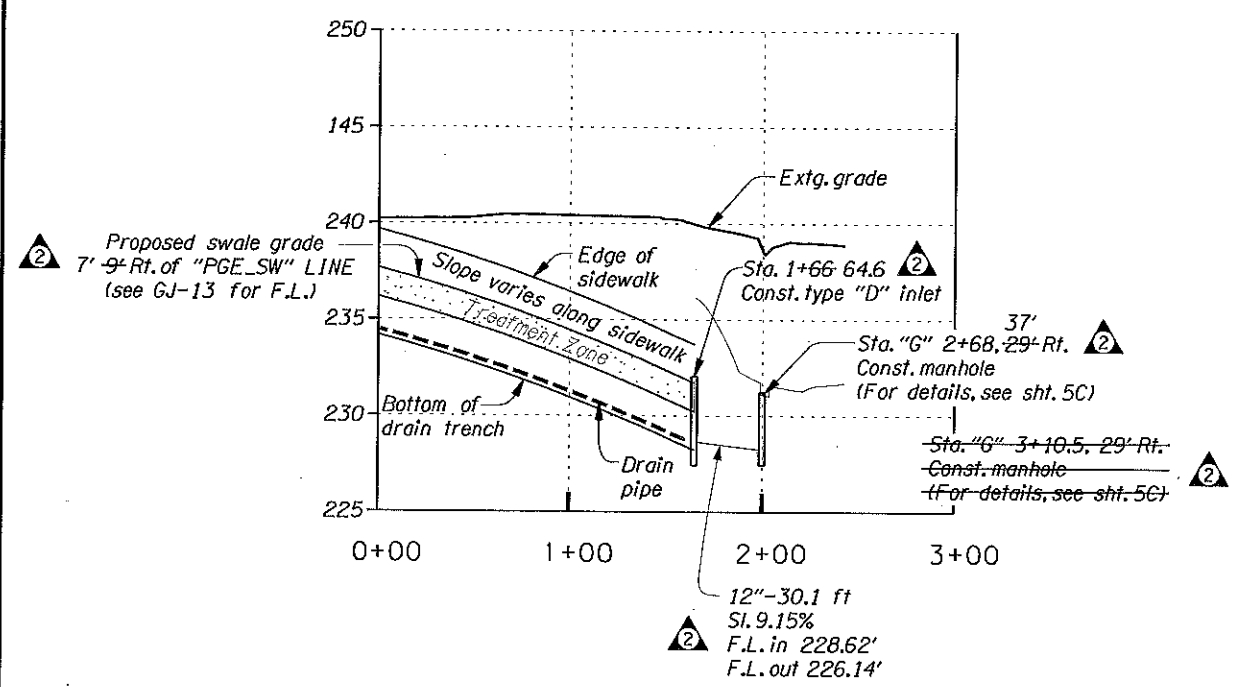


Note:
 For details beyond type "D" inlet, see sht. 5C, drainage profile.

① "PGE_SW" SWALE PROFILE
 Horiz. Scale: 1"=100'
 Vert. Scale: 1"=10'

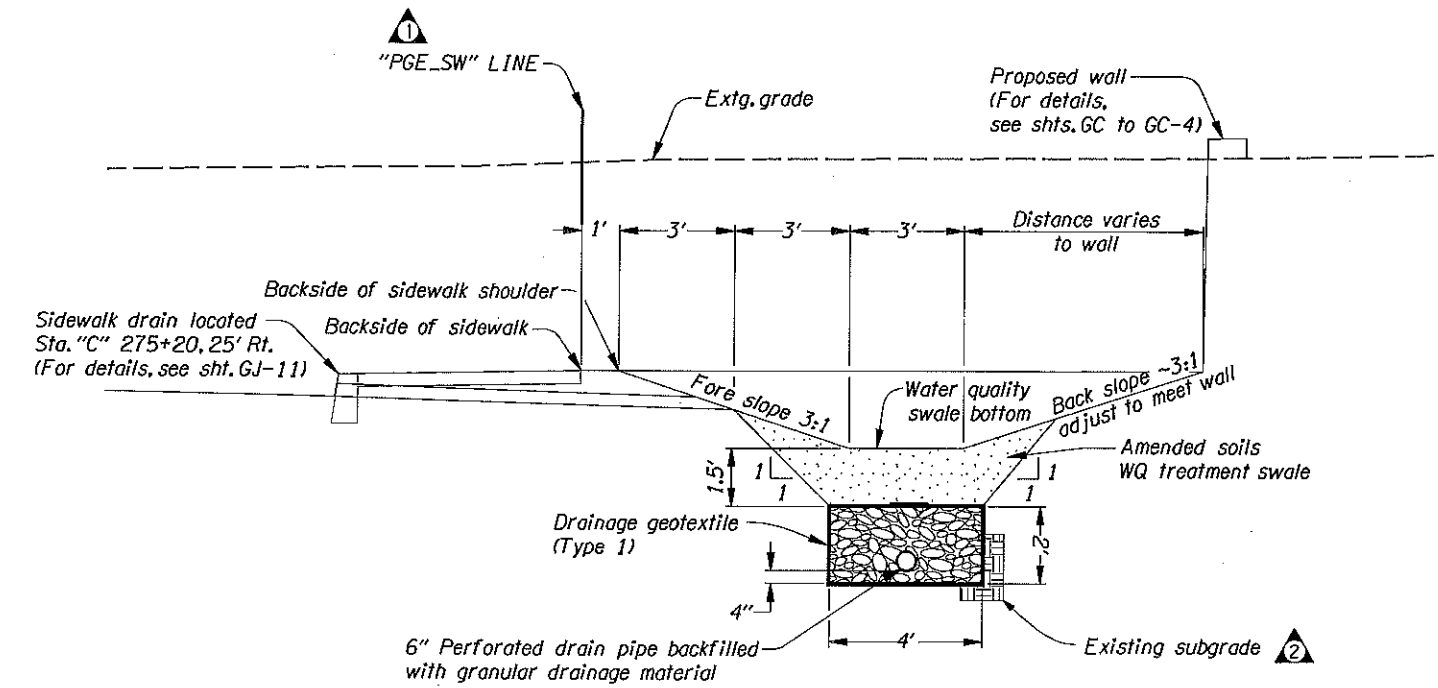

DETAIL
 Not to scale

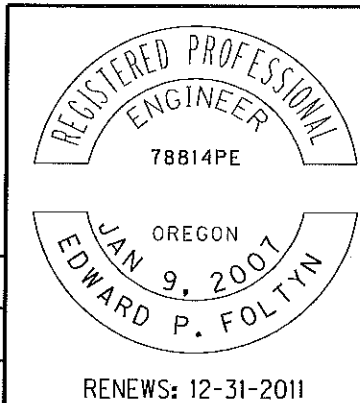

No.	DATE	REVISIONS	BY
①	02-04-10	Changed "PGE" Line to "PGE_SW" Line	E.P.F
②	07-01-10	Drainage Adjustments	D.N.A

OREGON DEPARTMENT OF TRANSPORTATION

REGION 1 - Geo/Hydro/HazMat Unit






OR213: CASCADE HWY S. (MILK CR BR) MULINO SEC.
 CASCADE HIGHWAY SOUTH
 CLACKAMAS COUNTY

Reviewed By - Bruce Council
 Designed By - Ed Foltyn
 Drafted By - Charlotte Gerken

**WATER QUALITY PLAN
 PROFILE & DETAIL**


SHEET NO. GJ-6

SIDEWALK DRAIN DETAIL STA. 275+20, RT. 25'

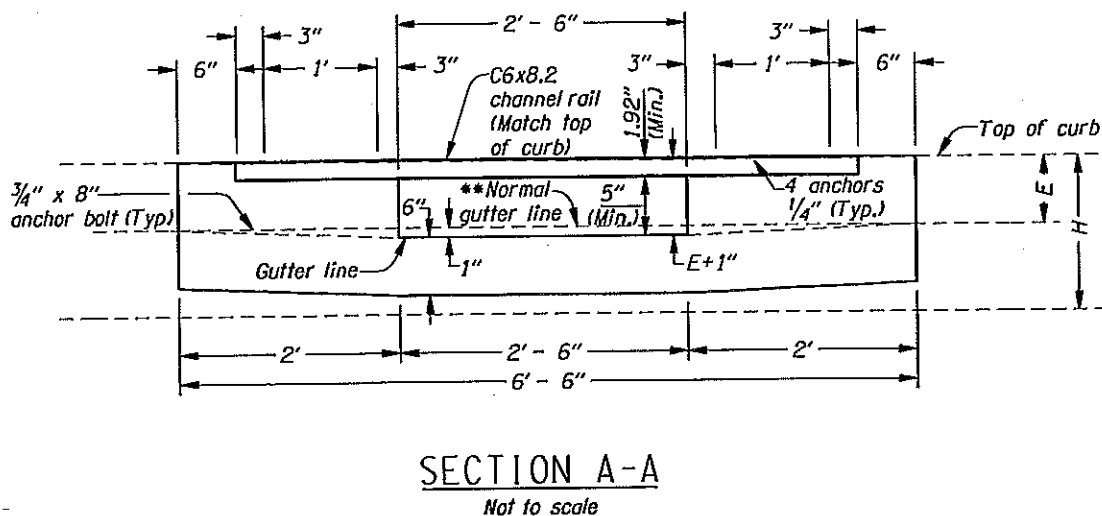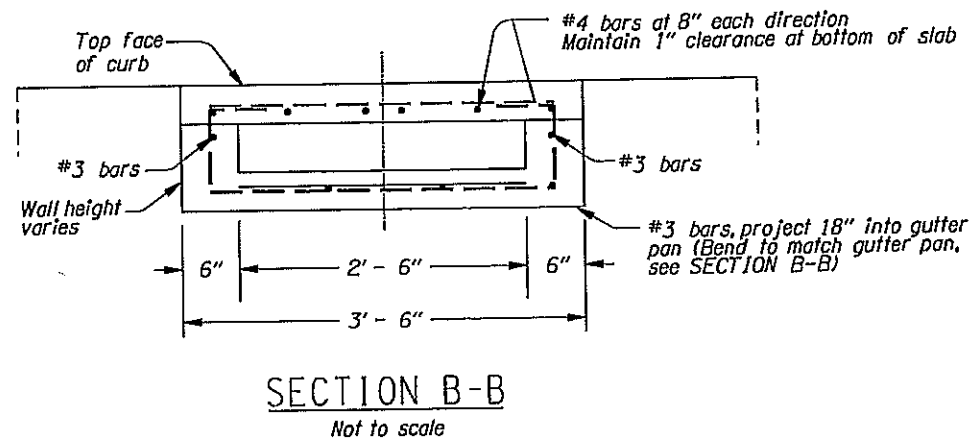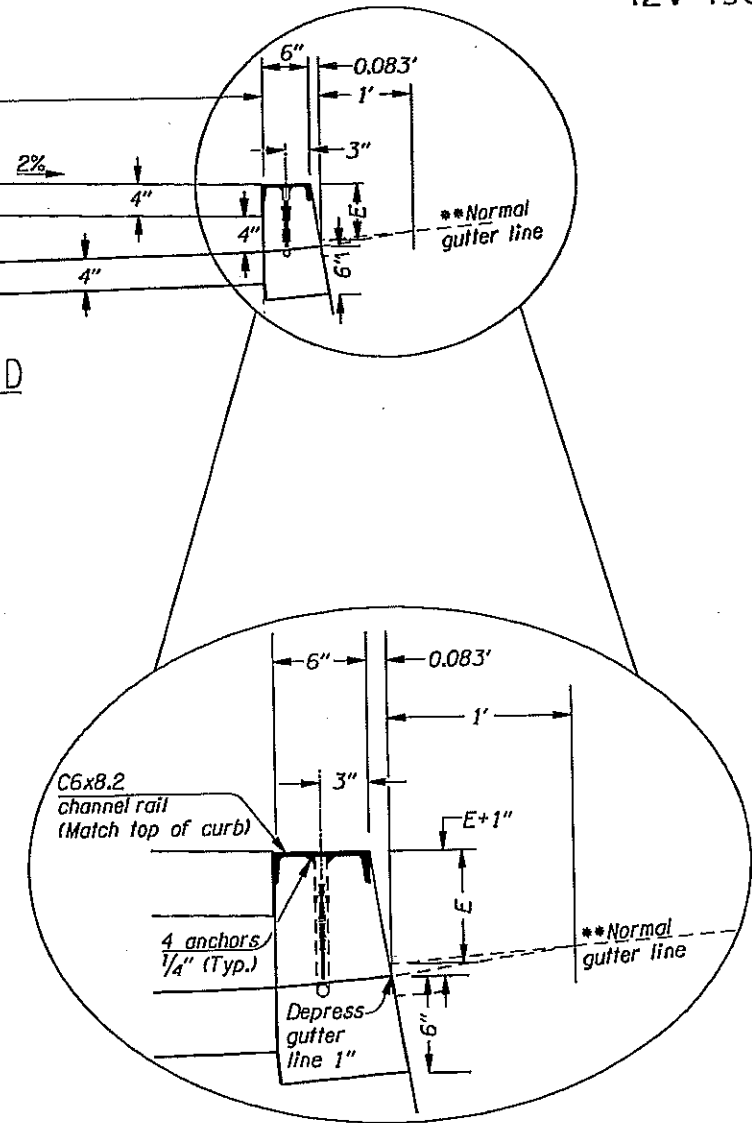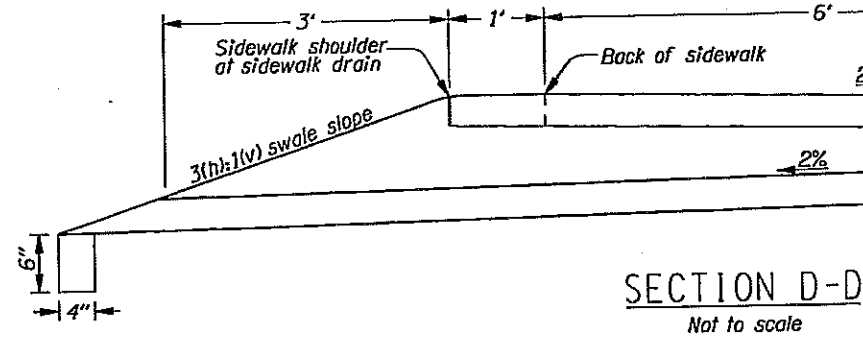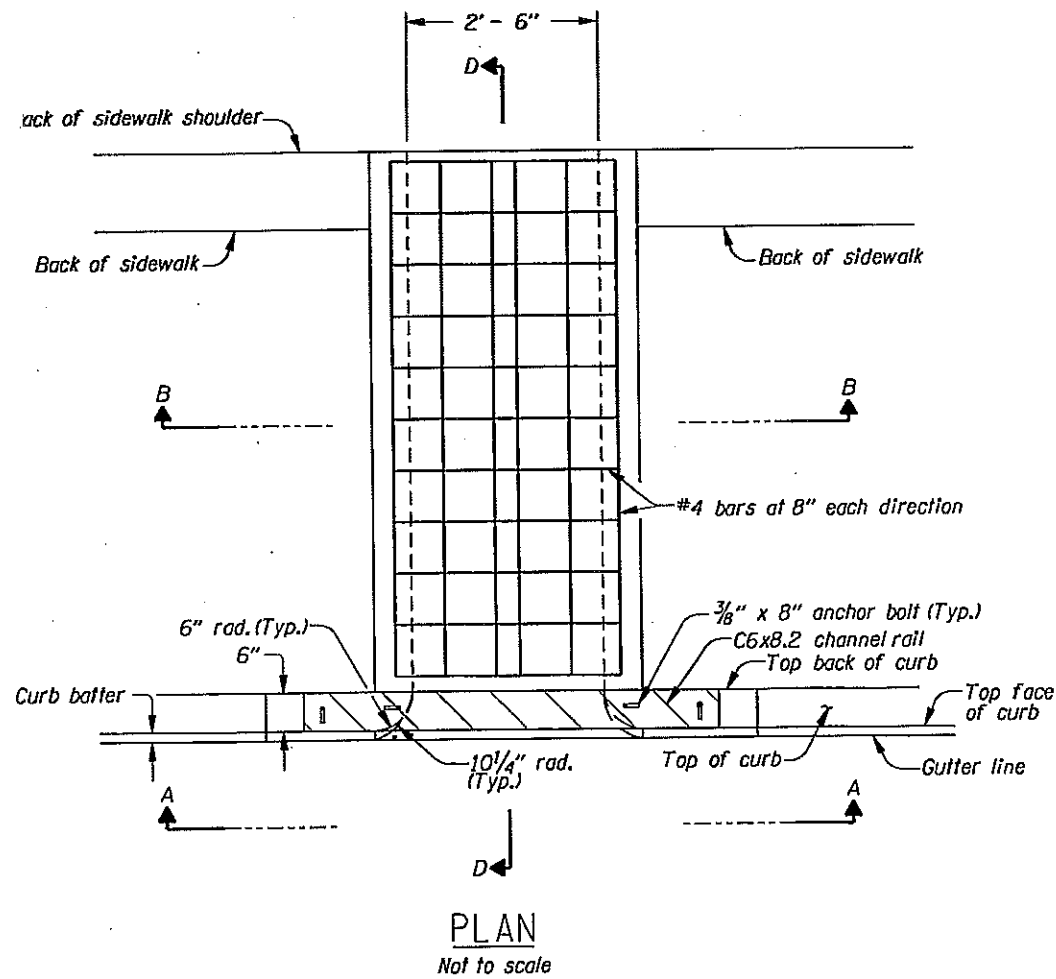

REVISED AS CONSTRUCTED
21 SEP 2012 CONTRACT 14146
PROJ.MGR. MARJORIE WEST
Marjorie West

**See general note 4

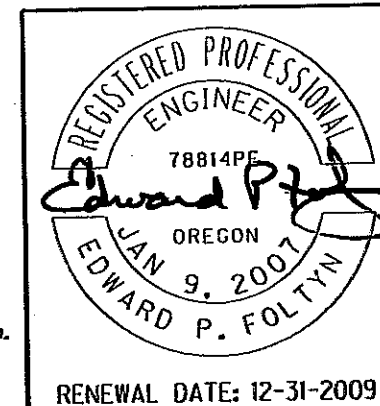

RENEWAL DATE: 12-31-2009

<p>OREGON DEPARTMENT OF TRANSPORTATION</p>	
<p>REGION 1 - Geo/Hydro/HazMat Unit</p>	
<p>OR213: CASCADE HWY S. (MILK CR BR) MULINO SEC. CASCADE HIGHWAY SOUTH CLACKAMAS COUNTY</p>	
<p>Reviewed By - Bruce Council Designed By - Ed Foltyn Drafted By - Charlotte Garken</p>	
<p>WATER QUALITY DETAILS</p>	<p>SHEET NO. GJ-11</p>



GENERAL NOTES FOR ALL DETAILS:

1. This structure shall be Commercial Grade Concrete.
2. Hot-dip galvanize C6x8.2 channel and anchor bolts after fabrication.
3. Curb exposure "E" = 6" to 9". Vary as shown on project plans or as directed.
4. Curb height "H" varies. See std. drg. no. RD700 and project plans for curb details.
5. Width to match adjacent gutter pan, if present.
6. For outfall, see project plans.
7. For profile and cross slope, see project plans.
8. All metal reinforcement shall be 2" clear of nearest face of conc., unless otherwise shown.
9. Vary anchor bolt length and reinforcing bar placement as required by curb exposure E (see note 4 above)

WATER QUALITY SWALE GENERAL DETAILS
PLAN AND TYPICAL CROSS-SECTION

REVISED AS CONSTRUCTED
 21 SEP 2012 CONTRACT 14146
 PROJ.MGR. MARJORIE WEST
Marjorie West

For additional Section A-A details, see also sht. GN. For inflow, outflow locations and elevations see sht. GJ.

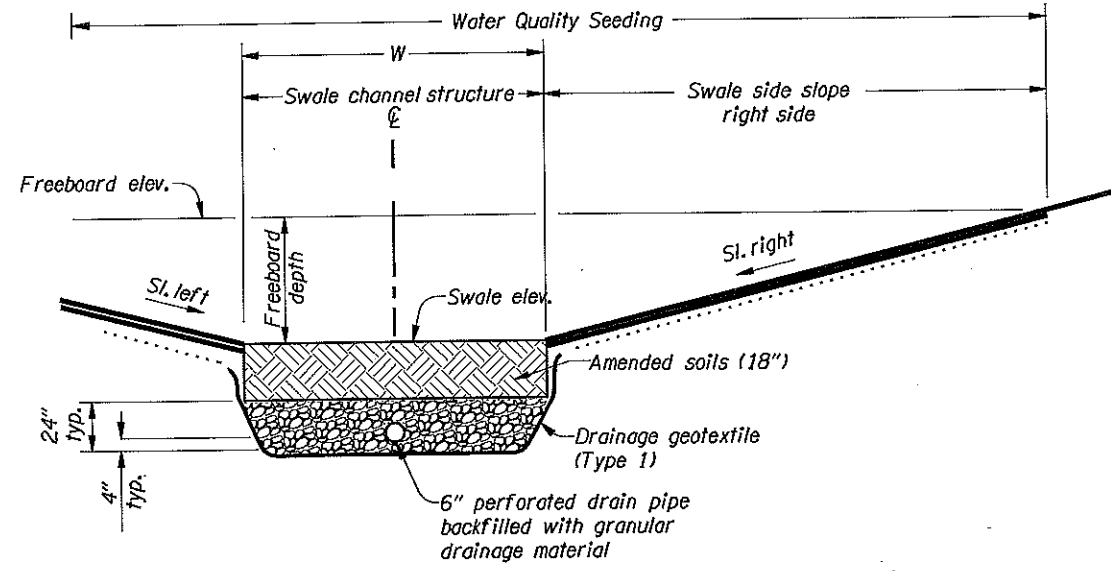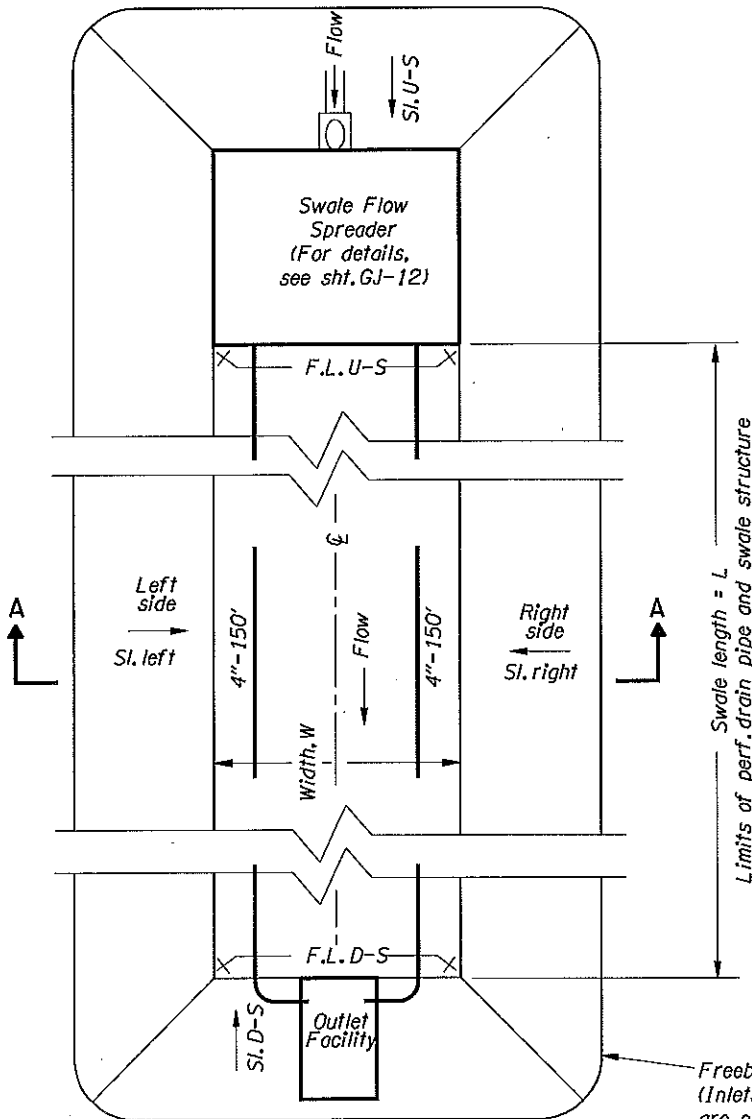

Note:
 See sht. GN for seeding, planting, and swale bottom medium details.

SECTION A-A

Freeboard limits = Pay limits for swale.
 (Inlets, paved end slopes and outlet facilities are not included in swale pay item.)


Note:
 For swale specifics, refer to the table on this sht.

PLAN

Swale ID	L (ft)	W (ft)	F.L. U-S (ft)	F.L. D-S (ft)	Long. slope (%)	Side slopes (H:V)				Number of underdrain segments	Freeboard depth (ft)	Underdrain tie-in location	Swale outlet facility
						U-S	D-S	Left	Right				
"PGE_SW" Swale	164.6 161	3	237.68	231.86	Varies (follows sidewalk slope)	3:1	3:1	3:1	3:1	1		"D" mod. inlet	"D" mod. inlet
"W_SW" Swale	299.3 354.3	7	198.18 198.46	196.69 196.75	0.50% 0.483%	3:1	NA	4:1	2:1	NA	1	NA	Free outlet, (Class 50) loose riprap
"E_SW" Swale	427.3 240.9	7	200.55 200.23	195.00 199.34	Varies 0.369%	3:1	NA	2:1	4:1	NA	1	NA	Free outlet, (Class 50) loose riprap
"S1" Swale	295	4.5	224	200.78	1.092%	3:1	2:1	Vert. (barrier)	3:1	1	1	"D" mod. inlet	"D" mod. inlet

Notes:
 1) U-S = Upstream
 2) D-S = Downstream
 3) See site plans for pipe inverts at inlets

No.	DATE	REVISIONS	BY
①	02-04-10	Added this entire sheet	E.P.F
②	07-01-10	Drainage Adjustments	D.N.A

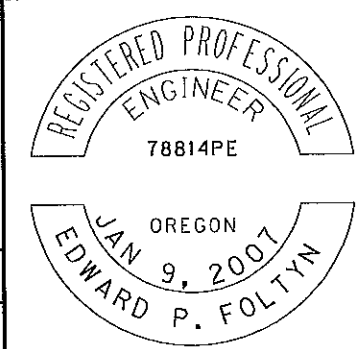

RENEWS: 12-31-2011

OREGON DEPARTMENT OF TRANSPORTATION

REGION 1 - Geo/Hydro/HazMat Unit

OR213: CASCADE HWY S. (MILK CR BR) MULINO SEC.
 CASCADE HIGHWAY SOUTH
 CLACKAMAS COUNTY

Reviewed By - Bruce Council
 Designed By - Ed Foltyn
 Drafted By - Charlotte Gerken

WATER QUALITY DETAILS

SHEET NO. GJ-13