

OPERATION & MAINTENANCE MANUAL

Water Quality Biofiltration Swale

Manual prepared: March 2019

DFI No. D01227



Figure 1: DFI No. D01227, looking southwest

Identification

Drainage Facility ID (DFI): D01227
Facility Type: Water Quality Biofiltration Swale
Construction Drawings: (V-File Numbers) 42V-190
Location: District: 2B
Highway No.: 160
Mile Post: 10.76 – 10.82 (Right side)

1. Manual Purpose

The purpose of this manual is to outline inspection needs and summarize maintenance actions.

2. Facility Location

The location map below details the facility location. The highway, mile posts, side streets, access location, and stormwater flow directions are noted on the map.

Facility location type: Roadway shoulder

Flow direction: south

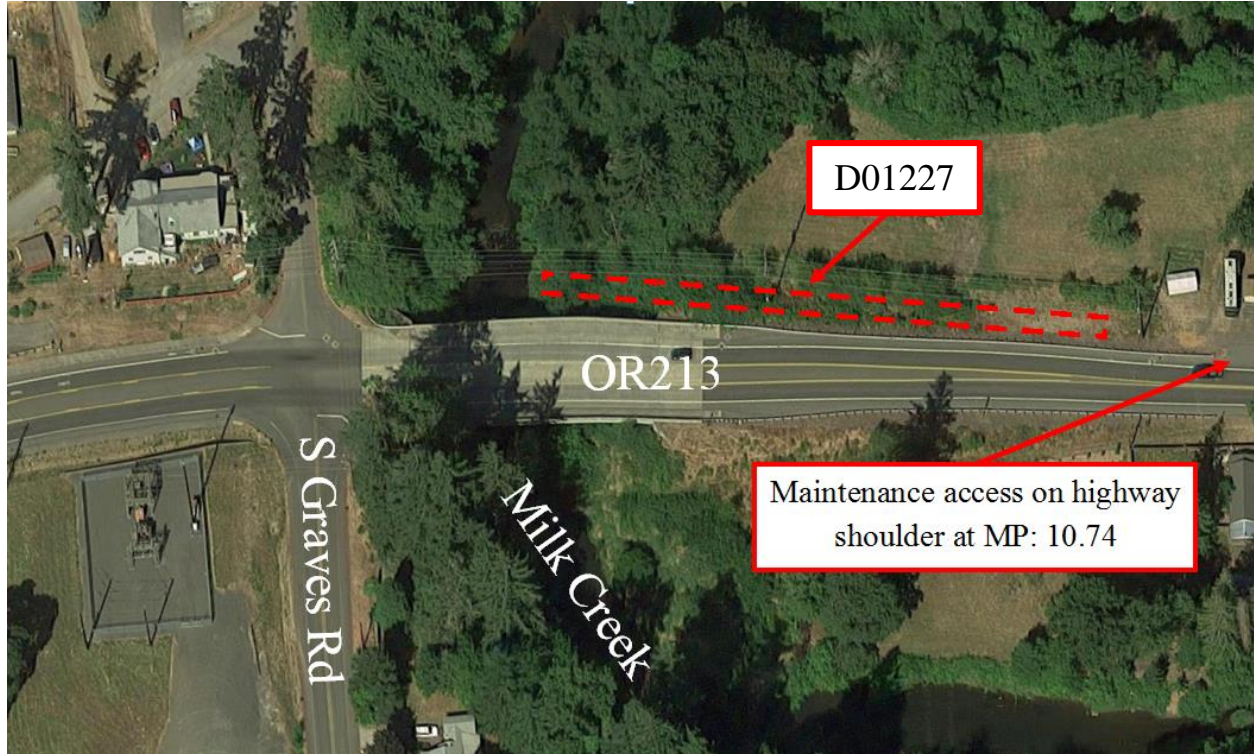



Figure 2: Facility location map

3. Facility Summary

The length and width of a swale is based on the bottom dimensions.

The bottom length and bottom width of the swale is:


Bottom Length (feet)	Bottom Width (feet)
299.29	7

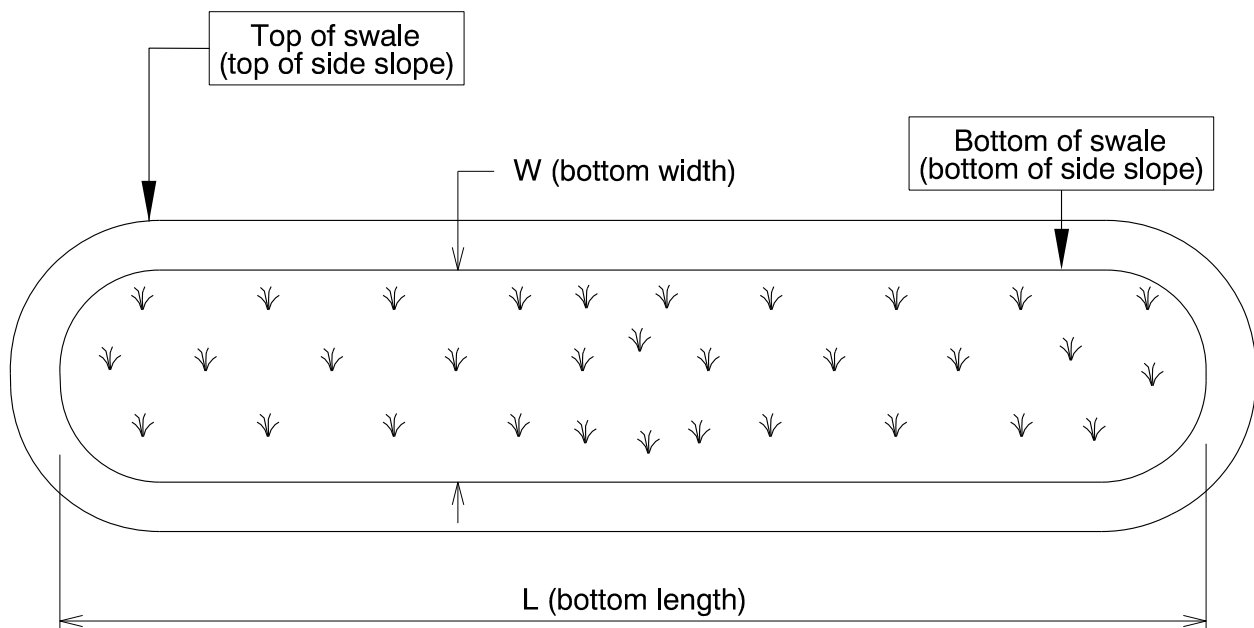

The depth of the swale is the vertical distance measured from the bottom of the swale to the top. The slope of the swale sides is presented by a vertical distance (rise) followed by the horizontal distance (run).

Depth and side slopes:

	Foreslope		Backslope	
Depth (feet)	Rise (feet)	Run (feet)	Rise (feet)	Run (feet)
1.5	1	4	1	2

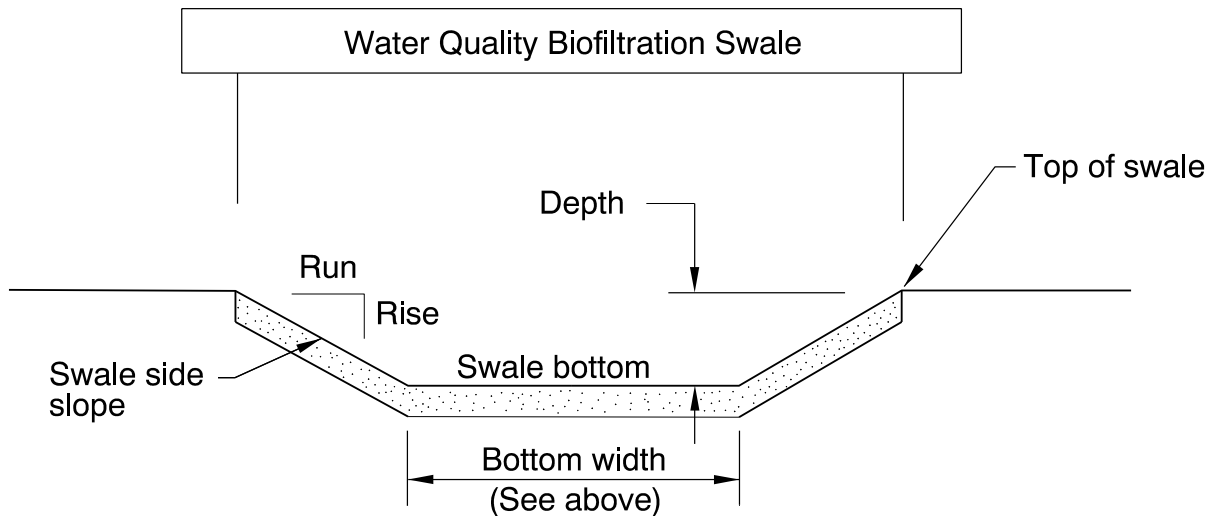

Site Specific Information: The water entering this water quality facility flows through a nearby manhole then a piped inlet. The water flows through the facility to the south and outlets into Milk Creek. The water quality facility is blocked from direct access by a guardrail. Maintenance parking and access is available at MP: 10.74 on the highway shoulder. This water quality facility can be found in Appendix B, sheet GJ-7 on “W_SW” Swale alignment.

4. Facility Access

Maintenance access to the facility:

<input type="checkbox"/> Roadside pad	<input checked="" type="checkbox"/> Roadside shoulder
<input type="checkbox"/> Access road with Gate	<input type="checkbox"/> Access road without Gate

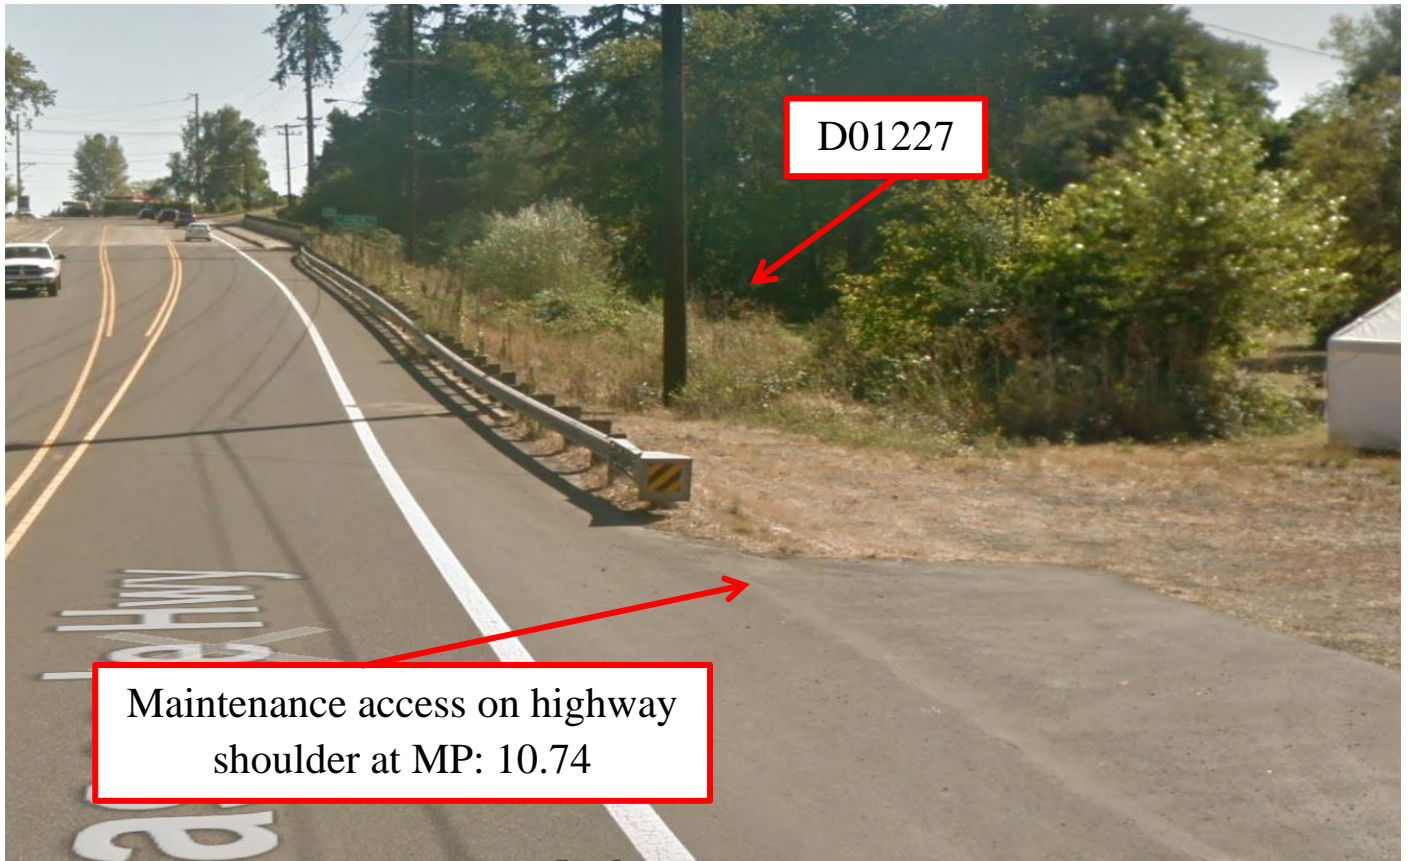


Figure 3: Maintenance access

5. Operational Components / Maintenance Items

Classification

This facility is classified as an:

<input checked="" type="checkbox"/> On-line Swale	<input type="checkbox"/> Off-line Swale
A swale that does not include a high flow bypass component; flow drains into and through the facility	A swale that treats low/small flows and diverts high flows using a bypass component

Bypass Component

This facility includes a high flow bypass component:

<input checked="" type="checkbox"/> No	<input type="checkbox"/> Yes
There is no bypass component. High flows drain into and through the facility	There is a bypass component. Only low/small flows drain into the swale. High flows are diverted around the swale using a bypass component

Operational Components

A swale has many components that assist with treatment, conveyance, and reducing flow velocity to minimize erosion. The components in use can vary depending if the facility was designed to operate on-line or off-line. The facility components table (**Table 1**) has been provided to highlight the applicable components for this facility. The component is in use when the box contains an “x” (e.g.).

The Standard Operation Manual for Water Quality Biofiltration Swales (implemented March 2017) outlines facility operation, typical footprint configuration, and component definitions and details. A link to the manual is attached to the feature marker in TransGIS.

<https://gis.odot.state.or.us/TransGIS/>

Operational Plan

The applicable standard operational plan for this facility is:

<input type="checkbox"/> Operational Plan A	<input checked="" type="checkbox"/> Operational Plan B	<input type="checkbox"/> Operational Plan C
An on-line swale with roadside ditches	An on-line swale with piped inlets and outlets	An off-line swale with a piped high flow bypass
A standard operational plan illustrates the general facility footprint configuration and explains the purpose of each facility component. Operational plans (A, B, C) are provided in the Standard Operation Manual.		

See Appendix A for the site specific operational plan.

Maintenance Items

Operational components marked in **Table 1** should be inspected and maintained according to Section 7. Each facility component is defined and detailed in the Standard Operation Manual using the associated ID number indicated below.

Table 1: Swale Components		ID #
Manholes/Structures		
Pre-treatment manhole	<input type="checkbox"/>	S1
Weir type flow splitter/flow splitter manhole	<input type="checkbox"/>	S2
Orifice type flow splitter/flow splitter manhole	<input type="checkbox"/>	S3
Standard manhole	<input checked="" type="checkbox"/>	S4
Swale Inlet		
Pavement sheet flow	<input type="checkbox"/>	S5
Inlet Pipe (s)	<input checked="" type="checkbox"/>	S6
Open channel inlet	<input type="checkbox"/>	S7
Riprap pad	<input type="checkbox"/>	S8
Ground Cover		
Grass bottom	<input checked="" type="checkbox"/>	S9
Grass side slopes	<input checked="" type="checkbox"/>	S10
Granular drain rock	<input type="checkbox"/>	S11
Compost Blanket with Seed	<input checked="" type="checkbox"/>	S12
Underground Components		
Geotextile fabric	<input type="checkbox"/>	S13
Water quality mix	<input type="checkbox"/>	S14
Perforated pipe	<input type="checkbox"/>	S15
Porous pavers (access grid)	<input type="checkbox"/>	S16
Flow Spreader		
Rock basin (used at inlet)	<input type="checkbox"/>	S17
Anchored board (midpoint of swale or every 50 feet along swale bottom)	<input type="checkbox"/>	S18
Other: describe type	<input type="checkbox"/>	S19
Swale Outlet		
Catch basin with grate	<input type="checkbox"/>	S20
Outlet Pipe (s)	<input type="checkbox"/>	S21
Open channel outlet	<input checked="" type="checkbox"/>	S22
Auxiliary Outlet: describe type	<input type="checkbox"/>	S23
Outfall Type		
Waterbody (Milk Creek)	<input checked="" type="checkbox"/> C <input type="checkbox"/> L <input type="checkbox"/> O	S24
Ditch	<input type="checkbox"/>	S25
Storm drain system	<input type="checkbox"/>	S26
Outfall Components		
Loose rip rap	<input checked="" type="checkbox"/>	S27
Riprap bank protection	<input type="checkbox"/>	S28

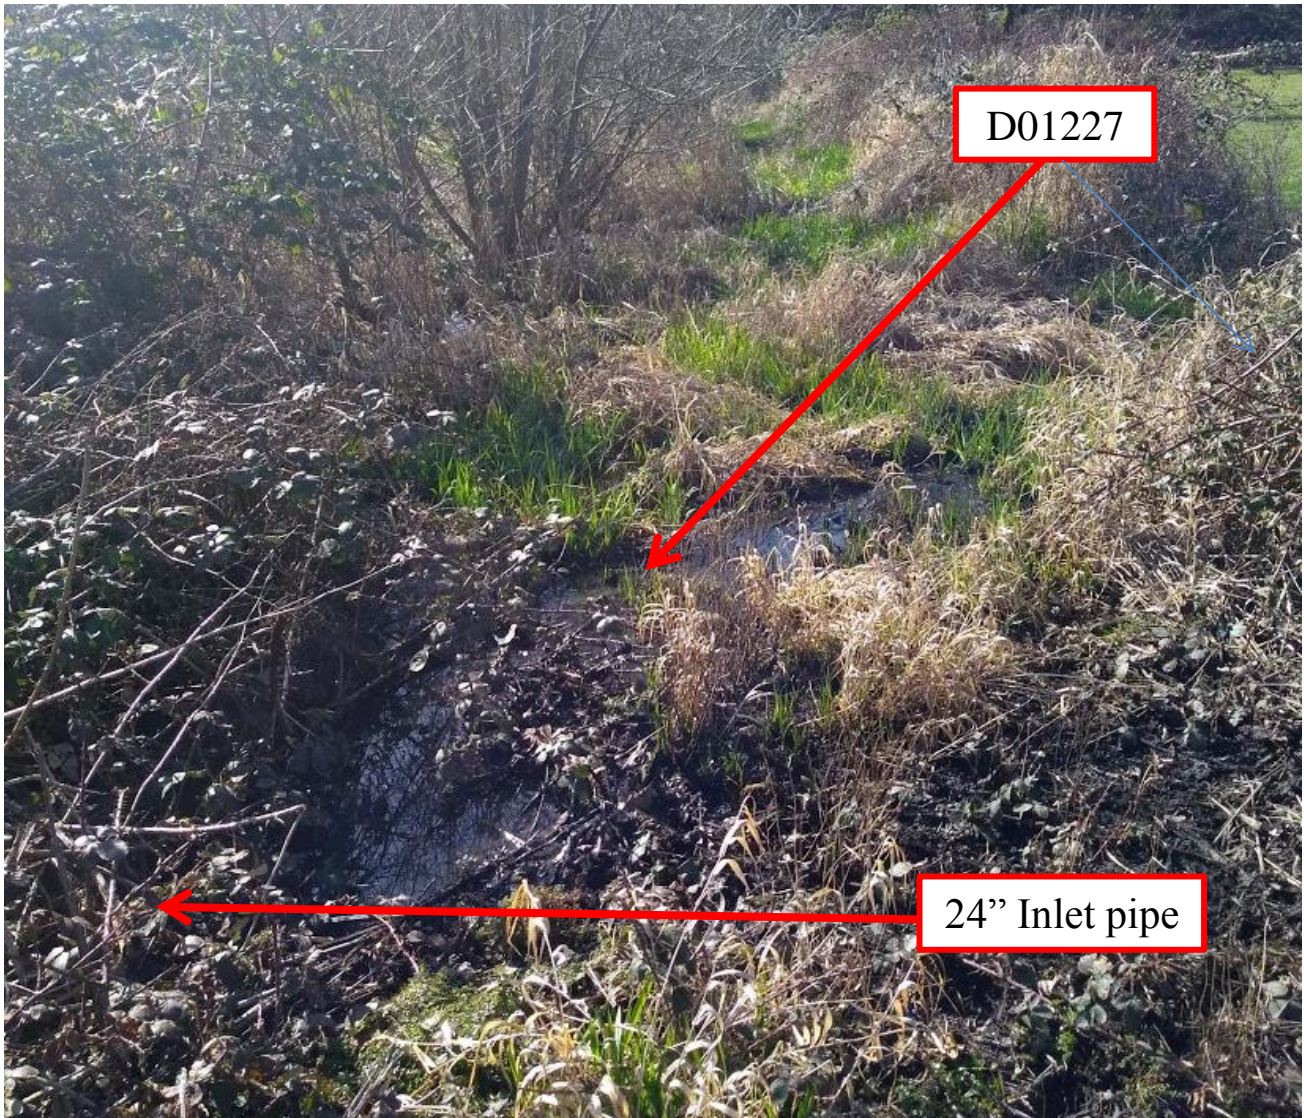


Figure 4: Swale Inlet



Figure 5: Standard Manhole that leads to water quality facility

6. Maintenance

Maintenance Frequency/Maintain Records

- a. Inspect annually. Preferably prior to the rainy season.
- b. Clean and maintain as necessary. Refer to Activity 125 for conditions when maintenance is needed.
- c. Keep a record of inspections, maintenance, and repairs.

Maintenance Guide/Maintenance Actions

The ODOT Routine Road Maintenance Water Quality and Habitat Guide (the *Blue Book*) outlines the standard maintenance actions for water quality facilities under Activity 125.

There are standard maintenance tables for standard ODOT designs. The maintenance tables describe the maintenance component, the defect or problem, the condition when maintenance is needed, and the recommended maintenance to correct the problem. Use the following tables to maintain ODOT swales:

- Table 1 (General Maintenance): Contains general maintenance and inspection guidelines that are applicable to all ODOT water quality facilities
- Table 3 (Maintenance of Water Quality or Biofiltration Swales): Contains maintenance information for swales

The *Blue Book* can be viewed at the following website:

http://www.oregon.gov/ODOT/Maintenance/Documents/blue_book.pdf

7. Limitations

Access grid installed:

<input checked="" type="checkbox"/> No	<input type="checkbox"/> Yes
There are no porous pavers installed in this swale	

Swales are designed to allow equipment access along the bottom. If an access grid is **NOT** installed, vehicles entering the swale can create depressions (tire ruts), damage vegetation, and damage structural components (e.g. flow spreaders). These conditions may result in poor treatment and drainage performance.

Equipment wheels should be kept on the tops and side slopes. Mower arms may be run along the swale bottom.

8. Waste Material Handling

Material removed from the facility is defined as waste by the Department of Environmental Quality (DEQ). Refer to the roadwaste section of the ODOT Maintenance Yard Environmental Management System (EMS) Policy and Procedures Manual for disposal options:

http://www.oregon.gov/ODOT/Maintenance/Documents/ems_manual.pdf




Contact any of the following for more detailed information about management of waste materials found on site:

ODOT Clean Water Unit	(503) 986-3008
ODOT Statewide Hazmat Coordinator	(503) 667-7442
ODOT Region 1 Hazmat Coordinator	(503) 731-8290
ODOT Region 2 Hazmat Coordinator	(503) 986-2647
ODOT Region 3 Hazmat Coordinator	(541) 957-3594
ODOT Region 4 Hazmat Coordinator	(541) 388-6186
ODOT Region 5 Hazmat Coordinator	(541) 963-1590
ODEQ Northwest Region Office	(503) 229-5263

A Appendix A – Site Specific Operational Plan

Contents:

Operational Plan: DFI D01227

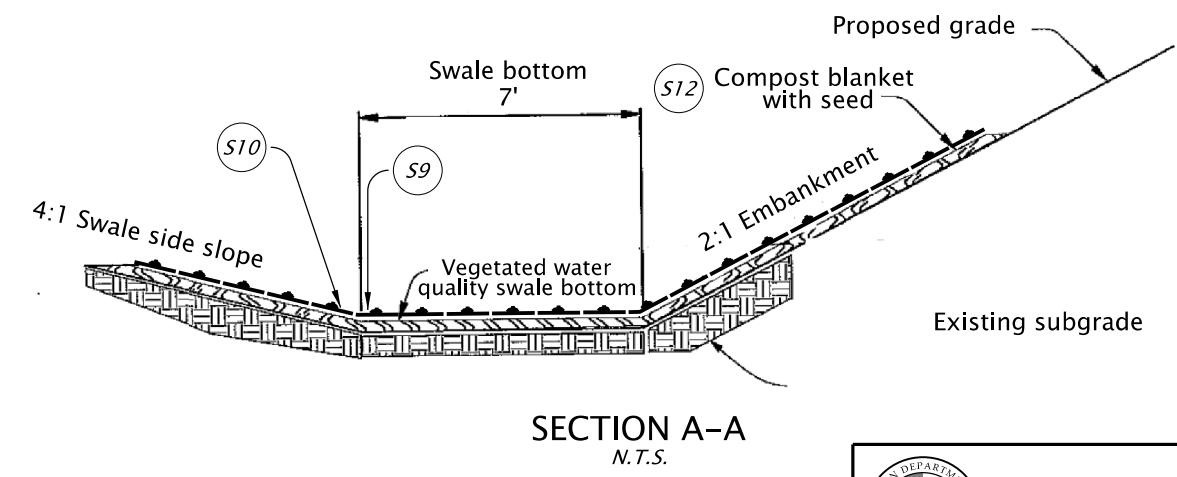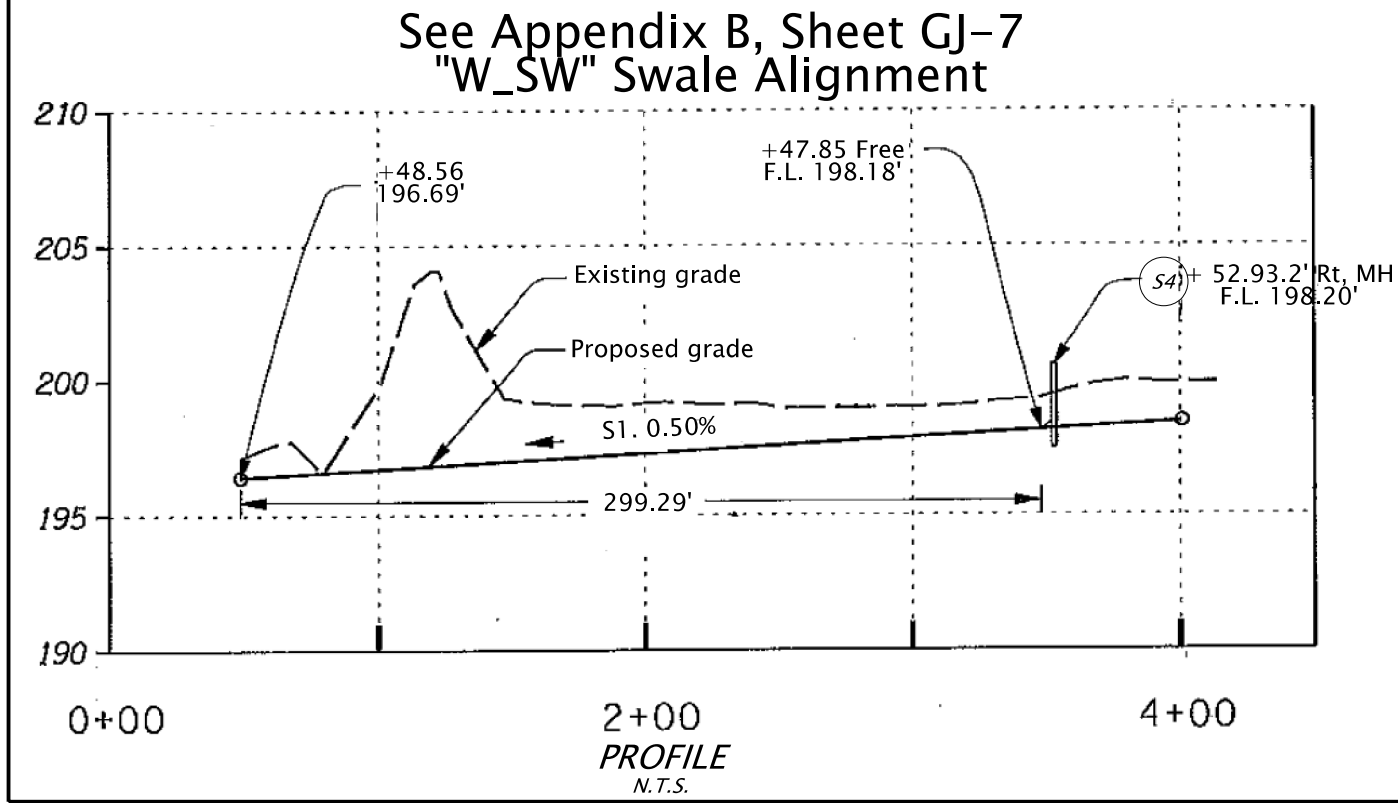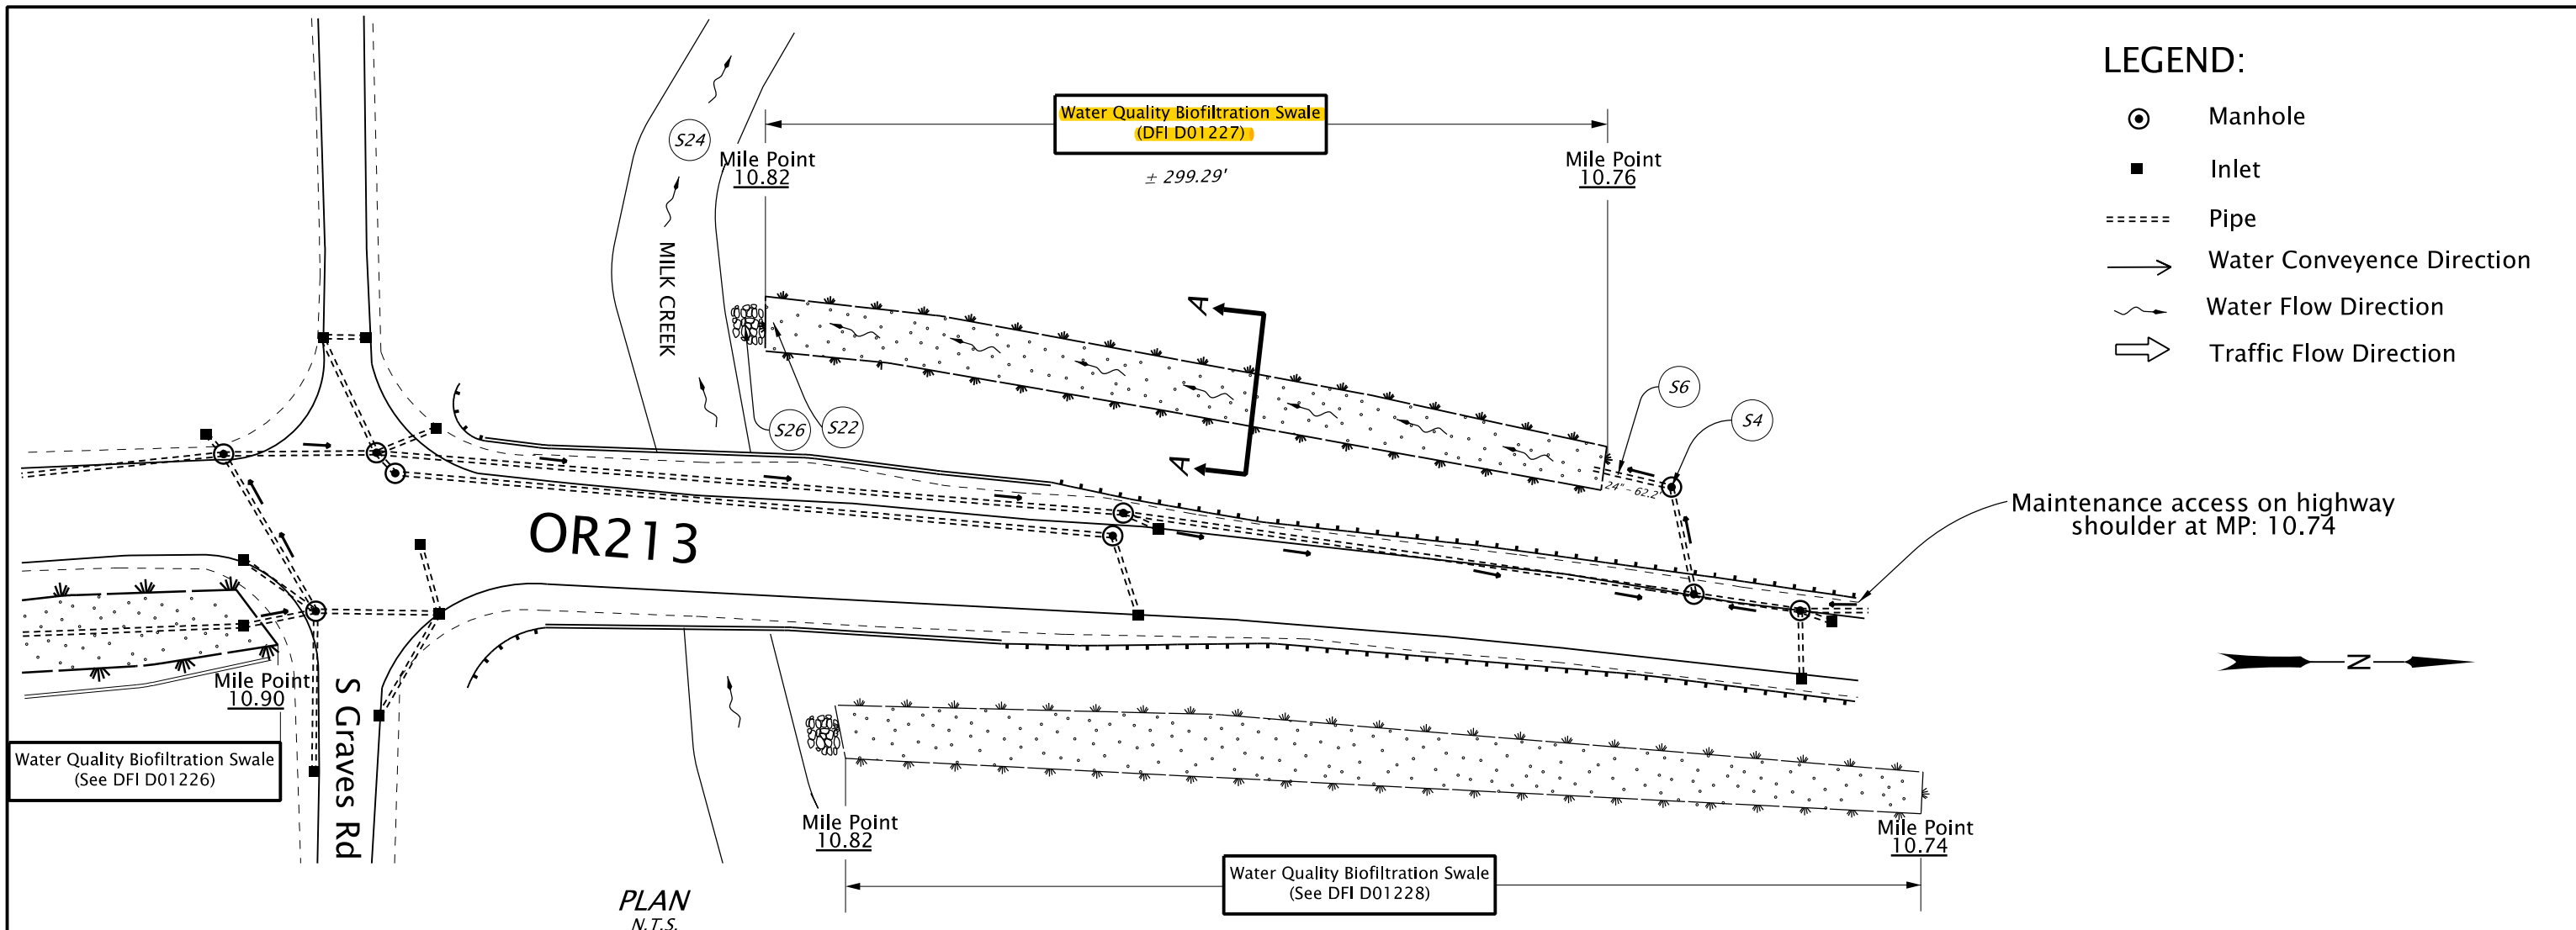

- LEGEND:**
- ⊙ Manhole
 - Inlet
 - ===== Pipe
 - Water Conveyance Direction
 - ~ Water Flow Direction
 - ⇨ Traffic Flow Direction



Sht. 01 of 01

Prepared By: Katrina Sepulveda

Drafted By: Katrina Sepulveda

DFI D01227
MAINTENANCE DISTRICT 2B HWY 160
Water Quality Biofiltration Swale
 Cascade Highway MP 10.76 - 10.82
 Clackamas County

B Appendix B – Project Contract Plans

Contents:

Site Specific Subset of Project Contract Plan 42V-190

INDEX OF SHEETS	
SHEET NO.	DESCRIPTION
1	Title Sheet
1A & 1A-2	Index Of Sheets Cont'd. & Std. Drg. Nos.

STATE OF OREGON
DEPARTMENT OF TRANSPORTATION
PLANS FOR PROPOSED PROJECT


GRADING, DRAINAGE, STRUCTURE, PAVING, AND SIGNING

OR213:CASCADE HWY S (MILK CR BR) MULINO SEC.
CASCADE HIGHWAY SOUTH

CLACKAMAS COUNTY
NOVEMBER 2009

NOT REVISED AS CONSTRUCTED
21 SEP 2012 CONTRACT 14146
PROJ.MGR. MARJORIE WEST

Marjorie West

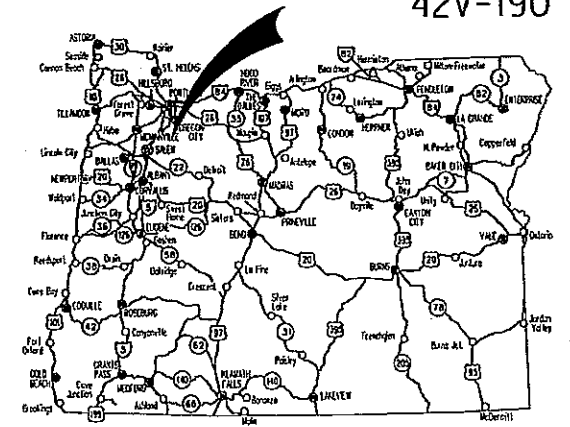


Overall Length Of Project - 0.86 Miles

ATTENTION:
Oregon Law Requires You To Follow Rules Adopted By The Oregon Utility Notification Center. Those Rules Are Set Forth In OAR 952-001-0010 Through OAR 952-001-0090. You May Obtain Copies Of The Rules By Calling The Center. (Note: The Telephone Number For The Oregon Utility Center Is (503) 232-1987.)



BEGINNING OF PROJECT
X-BRF-NTSA-S160(045)
STA. "C" 262+20 (M.P. 11.18)

BEGINNING OF CONTRACT PROJECT
STA. "C" 252+55 (M.P. 11.36)

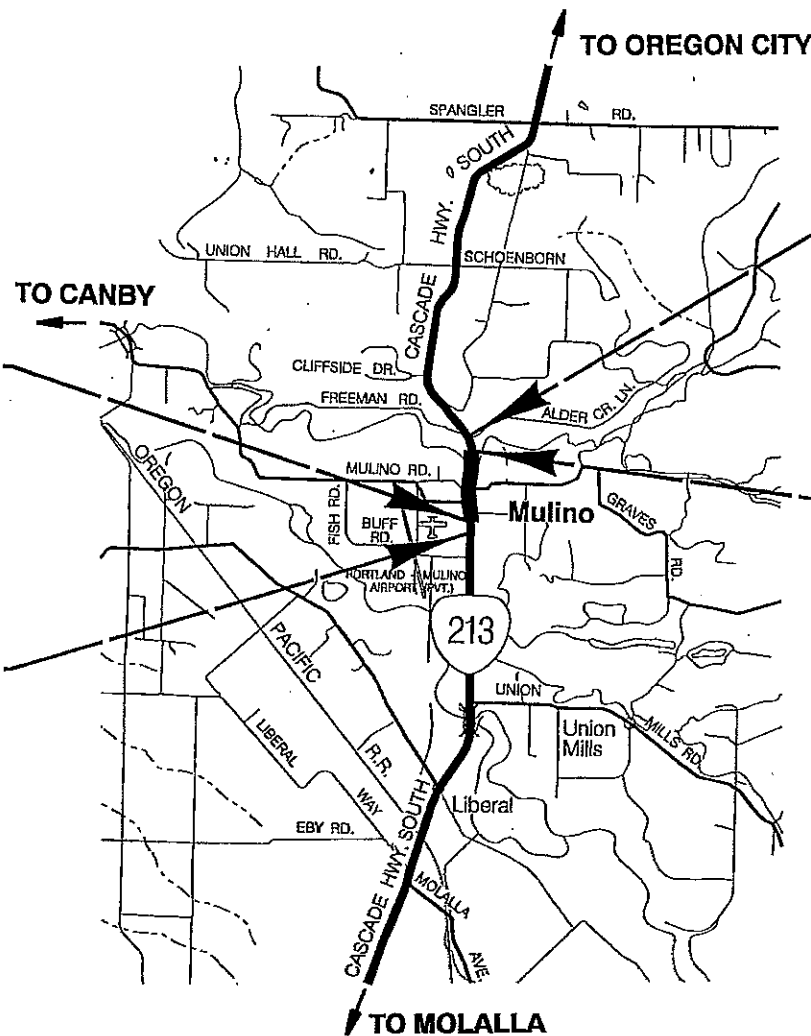

END OF CONTRACT PROJECT
STA. "C" 294+00 (M.P. 10.50)

END OF PROJECT
X-BRF-NTSA-S160(045)
STA. "C" 289+06.0 (M.P. 10.59)

OREGON TRANSPORTATION COMMISSION

- | | |
|--------------------|----------------------------|
| Gail Achterman | CHAIR |
| Michael Nelson | VICE-CHAIR |
| Janice Wilson | COMMISSIONER |
| Alan Brown | COMMISSIONER |
| David Lohman | COMMISSIONER |
| Matthew L. Garrett | DIRECTOR OF TRANSPORTATION |

These plans were developed using ODOT design standards. Exceptions to these standards, if any, have been submitted and approved by the ODOT Chief Engineer or their delegated authority.

Approving Authority: *Naveen G. Chandra*
Naveen G. Chandra, P.E.
Project Delivery Manager, Region 1

B. Johnson
Concurrence by ODOT Chief Engineer

OR213:CASCADE HWY S (MILK CR BR)
MULINO SEC.
CASCADE HIGHWAY SOUTH
CLACKAMAS COUNTY

FEDERAL HIGHWAY ADMINISTRATION	PROJECT NUMBER	SHEET NO.
OREGON DIVISION	X-BRF-NTSA-S160(045)	1

T. 4 S., R. 2 E., W.M.




PECO 5 000

Standard Drg. Nos.

INDEX OF SHEETS, CONT'D.	
SHEET NO.	DESCRIPTION
2, 2A, 2A-2 Thru 2A-10	Typical Sections
2B, 2B-2 Thru 2B-7	Details
2C	Traffic Control Detail
2C-2	Detour Plan
2C-3 Thru 2C-12	Traffic Control Plans
2D, 2D-2 & 2D-3	Pipe Data Sheet
3	Alignment & General Construction
3A	Profile
3B	Drainage & Utilities
3C	Drainage Profile
3D	Right of Way
4	Alignment & General Construction
4A	Profile
4B	Drainage & Utilities
4C	Drainage Profile
4D	Right of Way
5	Alignment & General Construction
5A	Profile
5B	Drainage & Utilities
5C	Drainage Profile
5D	Right of Way
6	Alignment & General Construction
6A	Profile
6B	Drainage & Utilities
6C	Drainage Profile
6D	Right of Way
GEO/HYDRO	
GA, GA-2 Thru GA-4	Erosion Control Plans
GB & GB-2	Geotechnical Data
GC, GC-2 Thru GC-4	Retaining Wall, Plan, Profile & Detail
GG	Temporary Water Management
GH	Bridge Scour Countermeasure
GJ, GJ-2 Thru GJ-5	Pipe Profiles
GJ-6 Thru GJ-11	Water Quality Plan, Profile & Detail
GN, GN-2 Thru GN-19	Roadside Development Plan
PERMANENT PAVEMENT MARKINGS	
ST Thru ST-4	Striping Plan

RD100	- Mailbox Support	BR139, BR141, BR145	- Expansion Joints
RD101	- Mailbox Installation	BR165	- Bridge End Panel Details
RD250	- Thrust Blocking	BR200	- Concrete Bridge Rail Type F
RD254	- Hydrant Installation	BR203	- Transition Conc. Br. Rail To Guard Rail
RD270	- Combination Air-Release Air Vacuum Valve Assembly	BR233	- Thrie-Beam Rail
RD274	- 3/4" - 2" Water Service Connection	BR250	- Pedestrian Rail
RD300	- Trench Backfill, Bedding, Pipe Zone And Mult. Installations	BR270	- Rail Transition Details Flex Beam Rail To Three Tube Rail
RD302	- Street Cut	BR273	- Thrie Beam Rail Retrofit For Curb And Parapet Rail
RD316	- Sloped Ends For Metal Pipe	BR286	- Retrofit For Steel Handrail With Sidewalk
RD318	- Sloped Ends For Concrete Pipe	BR321	- BT90 And BT96 Girders
RD326	- Coupling Bands For Corrugated Metal Pipe	BR350	- Temp. Diaphragm Beam For Prestressed Conc. Girders
RD330	- Metal Pipe Slope Anchors	BR705	- Standard Retaining Walls Front Face Battered 1" Per Ft.
RD336, RD342, RD344, RD346	- Manholes	TM200	- Sign Installation Details
RD356	- Manhole Cover & Frames	TM201	- Miscellaneous Sign Placement Details
RD360	- Manhole Frame Adjustment	TM204	- Flag Board Mounting Details
RD364, RD366, RD368, RD370	- Concrete Inlets	TM211, TM212	- Signing Details
RD380, RD384,	- Pipe Fill Height Tables	TM221, TM222	- Milepost Marker Details
RD386, RD388, RD390	- Guardrail	TM223, TM224	- Directional Sign Layout
RD400, RD405, RD410, RD415,	- Precast Concrete Barrier Pin And Loop Assembly	TM492	- Ramp Meter Layout And Details
RD420, RD425, RD435, RD450	- Median Barrier Anchoring Details	TM500, TM501, TM502, TM503	- Pavement Marking Standard Details
RD500	- Guardrail Transition To Concrete Barrier	TM515	- Raised Pavement Markers
RD515	- Precast Tall (42") Concrete Barrier	TM517	- Recessed Pavement Markers
RD530	- Asphalt Pavement Details	TM520, TM521	- Durable Pavement Markings
RD545	- Curbs	TM525	- Turn Arrow Marking Details
RD610	- Approaches & Non-Sidewalk Dwys.	TM530	- Intersection Pavement Markings
RD700	- Sidewalks	TM539	- Median And Left Turn Channelization Details
RD715	- Curb Line Sidewalk Dwys. Or Alleys	TM560, TM561	- Alignment Layout
RD720	- Sidewalk Ramp Details	TM570	- Traffic Delineators
RD735	- Sidewalk Ramp Placement	TM576	- Traffic Delineator Installation
RD755	- Truncated Dome Detectable Warning Surface Details And Locations	TM602	- Triangular Base Breakaway Multi-Direction Slip Base
RD756, RD757	- Pedestrian Handrail	TM670	- Perm. Signing Wood Post Supports Sizing Charts
RD759	- Barbed And Woven Wire Fences	TM671	- 3 Second Gust Wind Speed Isotach
RD770, RD771	- Chain Link Fence	TM676	- Sign Attachments
RD810	- Check Dams	TM677	- Sign Mounts
RD815	- Inlet Protection	TM681, TM687, TM688	- Square Tube Sign Supports
RD1005	- Sediment Barrier	TM800	- Tables, Abrupt Edge And PCMS Details
RD1010, RD1015, RD1020	- Sediment Fence	TM820	- Temporary Barricades
RD1025, RD1030, RD1035	- Temporary Slope Drains	TM821	- Temporary Sign Supports
RD1040	- Matting	TM830	- Temporary Concrete Barrier And Rumble Strips
RD1045		TM831	- Temporary Impact Attenuators
RD1055		TM840, TM841, TM842	- Closure Details
		TM850	- 2-Lane, 2 Way Roadways
		TM851	- Non-Freeway Multi-Lane Sections
		TM870	- Bridge Construction


R/W Map No. 6B-32-9 And 5B-8-13

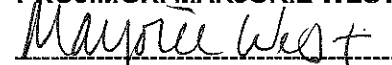REVISED AS CONSTRUCTED
 21 SEP 2012 CONTRACT 14146
 PROJ. MGR. MARJORIE WEST


OR213-CASCADE HWY S (MILK CR BR)
 MULINO SEC.
 CASCADE HIGHWAY SOUTH
 CLACKAMAS COUNTY

FEDERAL HIGHWAY ADMINISTRATION	PROJECT NUMBER	SHEET NO.
OREGON DIVISION	X-BRF-NTSA-S16010451	1A

Standard Drawings located on the web at:
http://www.oregon.gov/ODOT/HWY/ENGSERVICES/standard_drawings_home.shtml

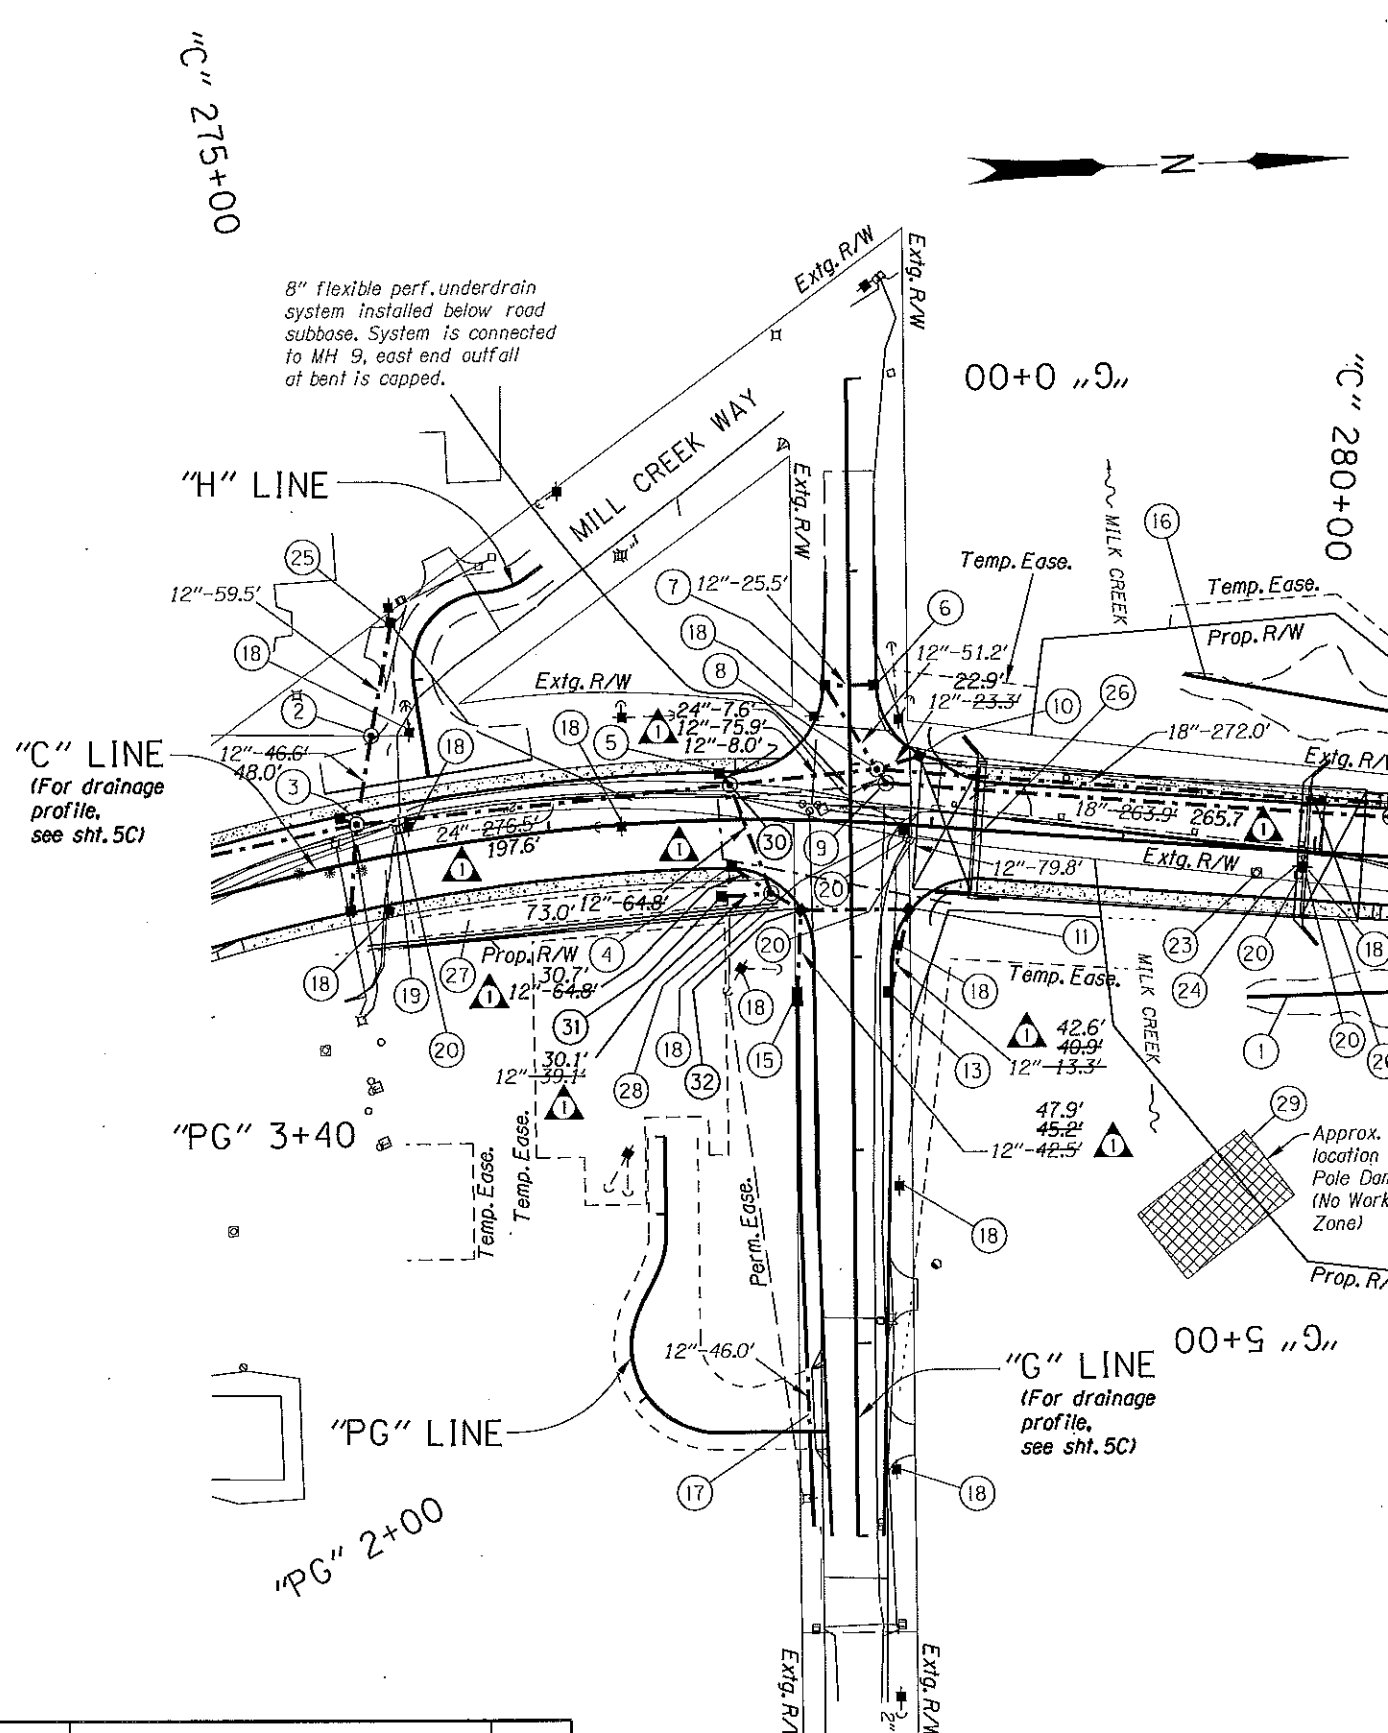

- 17 Sta. "G" 5+10.9, 25.7' Rt. to Sta. "G" 5+56.9, 24.2' Rt. 22.2' Inst. 12" culv. pipe - 46.8' 48.5' 5' depth (For details, see sht. GJ-4)
- 18 Relocate power pole - 11 (By others)
- 19 Relocate TV riser (By others)
- 20 Relocate phone riser - 5 (By others)
- 21 Note deleted
- 22 Note deleted
- 23 Relocate stream gauge (By others)
- 24 Relocate phone pole (By others)
- 25 Sta. "C" 275+36.7, 118.9 Rt. Lt. Const. "M-E" inlet (For details, see sht. GJ-3)
- 26 Inst. casings - 4 (Incidental to end panel) (See bridge drgs.)
- 27 Sta. "C" 275+21, 30.5' Rt. to Sta. "C" 276+90, 31.5' Rt. Const. water quality swale (For details, see sht. GJ-6)
- 28 Sta. "C" 277+30.6, 39.7' Rt. Const. manhole Inst. 12" sew. pipe - 39.1' 70.2' 5' depth (For details, see sht. GJ-6)
- 29 See sht. GN-10
- 30 Sta. "C" 276+96.2, 19.6' Lt. Const. manhole 72" dia. Inst. 12" sew. pipe - 72.8' 5' depth Inst. 24" sew. pipe - 197.6' 5' depth (For details, see sht. GJ & GJ-4)
- 31 Sta. "C" 276+90.6, 39.7' Rt. Const. type "D" inlet (For details, see sht. GJ-6 & GJ-12)
- 32 Sta. "G" 2+72.2, 26.7' Rt. Const. "G2" inlet Inst. 12" sew. pipe - 103.1' 5' depth (For details, see sht. GJ-4 & GJ-5)
- 8 Sta. "C" 277+70.0, 27.7' Lt. Const. manhole, sedimentation 72" dia. w/ 4' sump Inst. temp. outfall pipe (For details, see sht. GG) Inst. 12" sew. pipe - 156.9' 74.5' 5' depth Inst. 24" sew. pipe - 273.5' 75.9' 20' depth Trench resurf. - 120 sq.yd. (For details, see shts. GJ, GJ-3 & GJ-4)
- 9 Sta. "C" 277+75.0, 20.7' Lt. Const. manhole Inst. 24" sew. pipe - 8.6' 7.6' 5' depth (For details, see sht. GJ)
- 10 Sta. "C" 277+90.8, Lt. Const. type "CG-2" inlet Inst. 12" sew. pipe - 79.8' 5' depth (For details, see sht. GJ-4)
- 11 Sta. "C" 277+90.3, Rt. Const. type "CG-2" inlet 42.6' Inst. 12" sew. pipe - 35.3' 40.9' 5' depth (For details, see sht. GJ-4 & GJ-5)
- 12 Sta. "G" 3+11.0, 29.2' Lt. Const. manhole Inst. 12" sew. pipe - 71.5' 5' depth (For details, see shts. GJ 4 & GJ 5)
- 13 Sta. "G" 3+18.22, Lt. Const. type "CG-2" inlet (For details, see sht. GJ-5)
- 14 Sta. "G" 3+10.5, 29.0' Rt. Const. manhole Inst. 12" sew. pipe - 40.7' 5' depth (For details, see sht. GJ-4)
- 15 Sta. "G" 3+20.1, 29.0' Rt. Const. type "M-E" inlet (For details, see sht. GJ-4)
- 16 Sta. "C" 279+25.0, 87.5' Lt. to Sta. "C" 282+24.3, 50.2' Lt. Const. ditch Ditch exc. - 45 cu.yd.
- 1 Sta. "C" 279+73.0, 82.7' Rt. to Sta. "C" 284+30, 34.4' Rt. Const. ditch - 295' Ditch exc. - 18 cu.yd.
- 2 Sta. "C" 275+17.4, 62.8' Lt. Const. manhole Inst. 12" sew. pipe - 59.5' 5' depth Connect To Existing Trench resurf. - 20 sq.yd. (For details, see sht. GJ-3)
- 3 Sta. "C" 275+01.9, 19.1' Lt. Const. manhole 72" dia. Inst. 24" sew. pipe - 369.7' 20' depth Inst. 12" sew. pipe - 100.4' 5' depth Trench resurf. - 225 sq.yd. (For details, see shts. GJ & GJ-3)
- 4 Sta. "C" 276+95.1, Rt. Const. "CG-2" inlet (For details, see sht. GJ-4)
- 5 Sta. "C" 276+89.7, Lt. Const. "CG-2" inlet Inst. 12" sew. pipe - 48.5' 5' depth Trench resurf. - 3 sq.yd. (For details, see sht. GJ-4)
- 6 Sta. "G" 1+59, Lt. Sta. "C" 277+67.4, Lt. Const. "CG-2" inlet (For details, see sht. GJ-4)
- 7 Sta. "G" 1+59, Rt. Sta. "C" 277+41.2, Lt. Const. "CG-2" inlet 26.8' Inst. 12" sew. pipe - 25.5' 10' 5" depth (For details, see sht. GJ-4)

REVISED AS CONSTRUCTED
 21 SEP 2012 CONTRACT 14146
 PROJ.MGR. MARJORIE WEST
Marjorie West

OREGON DEPARTMENT OF TRANSPORTATION

REGION 1 - ROADWAY ENGINEERING SECTION

OR213: CASCADE HWY S (MILK CR BR) MULINO SEC.
 CASCADE HIGHWAY SOUTH
 CLACKAMAS COUNTY

Design Team Leader - Lawrence Kretzler
 Designed By - Timothy Fredette
 Drafted By - Jaiid Heydarpour

DRAINAGE AND UTILITIES

SHEET NO. **5B**

REGISTERED PROFESSIONAL
 ENGINEER
 17837



OREGON
 JULY 25, 1995
 TIMOTHY P. FREDETTE

RENEWAL DATE: 12-31-2009

No.	DATE	REVISIONS	BY
1	07-16-10	Drainage Adjustments	D.N.A.

Plug and abandon extg. pipe shown thus:

REVISED AS CONSTRUCTED
 21 SEP 2012 CONTRACT 14146
 PROJ.MGR. MARJORIE WEST
Marjorie West

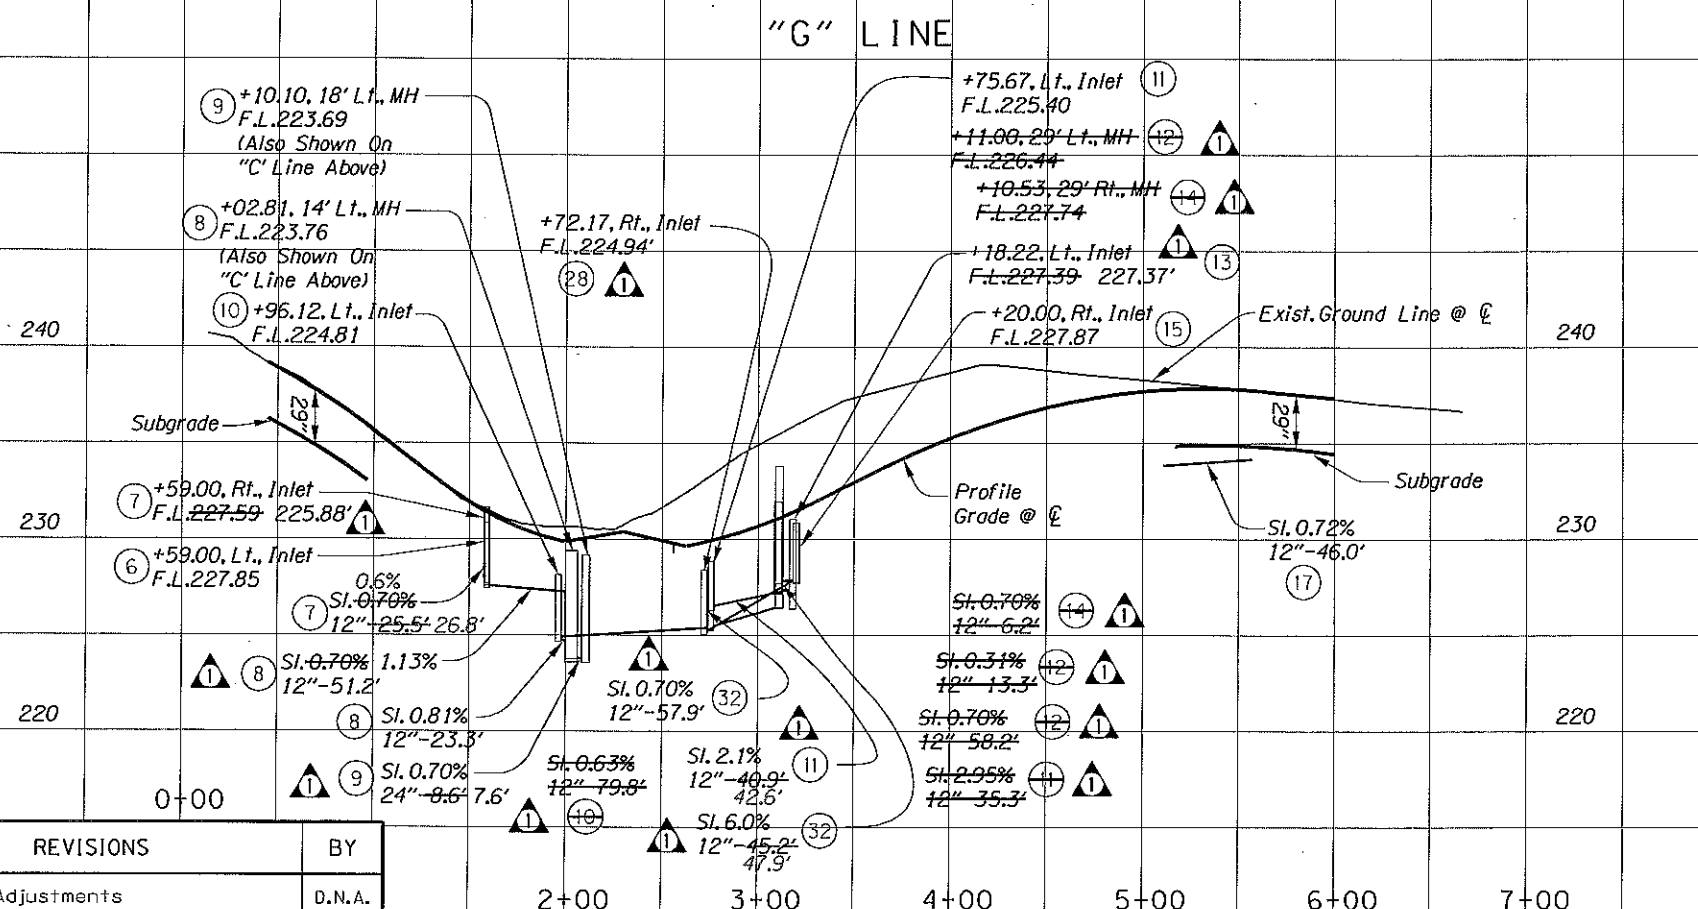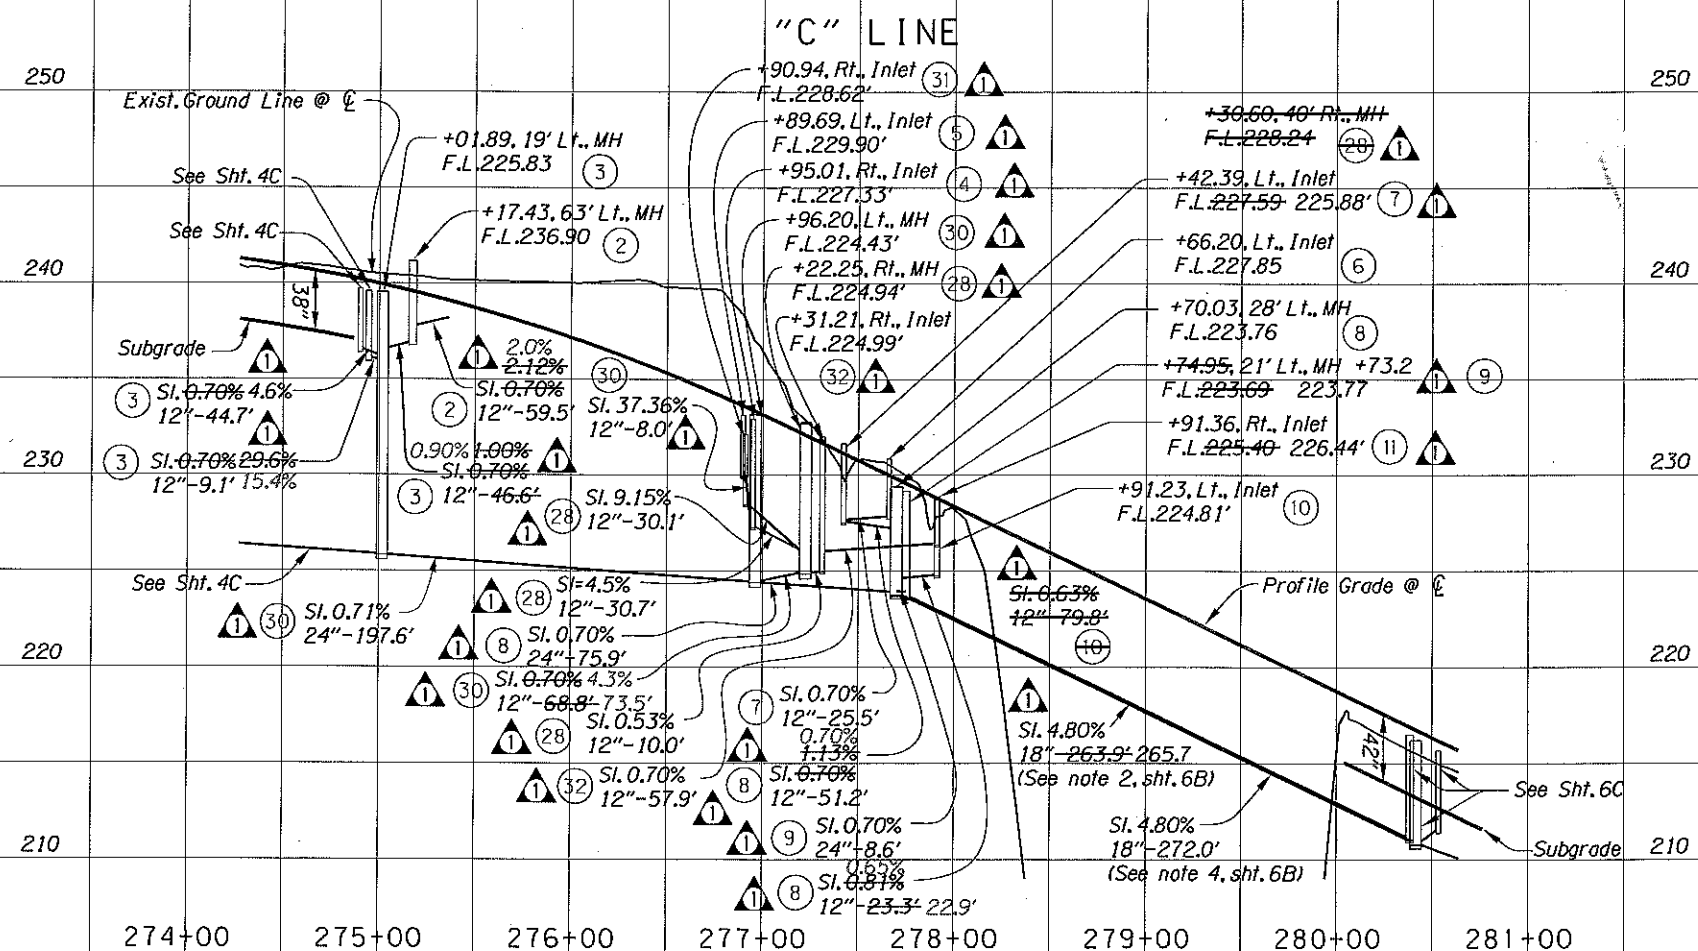

No.	DATE	REVISIONS	BY
1	07-16-10	Drainage Adjustments	D.N.A.

REGISTERED PROFESSIONAL
 ENGINEER
 17837
 OREGON
 JULY 25, 1995
 TIMOTHY P. FREDETTE
 RENEWAL DATE: 12-31-2009

OREGON DEPARTMENT OF TRANSPORTATION

REGION 1 - ROADWAY ENGINEERING SECTION



OR213:CASCADE HWY S (MILK CR BR)
 MULINO SEC.
 CASCADE HIGHWAY SOUTH
 CLACKAMAS COUNTY

Design Team Leader - Lawrence Kretzler
 Designed By - Timothy Fredette
 Drafted By - Jalal Heydarpour

DRAINAGE PROFILE

SHEET NO. 5C

REVISED AS CONSTRUCTED
 21 SEP 2012 CONTRACT 14146
 PROJ.MGR. MARJORIE WEST
Marjorie West

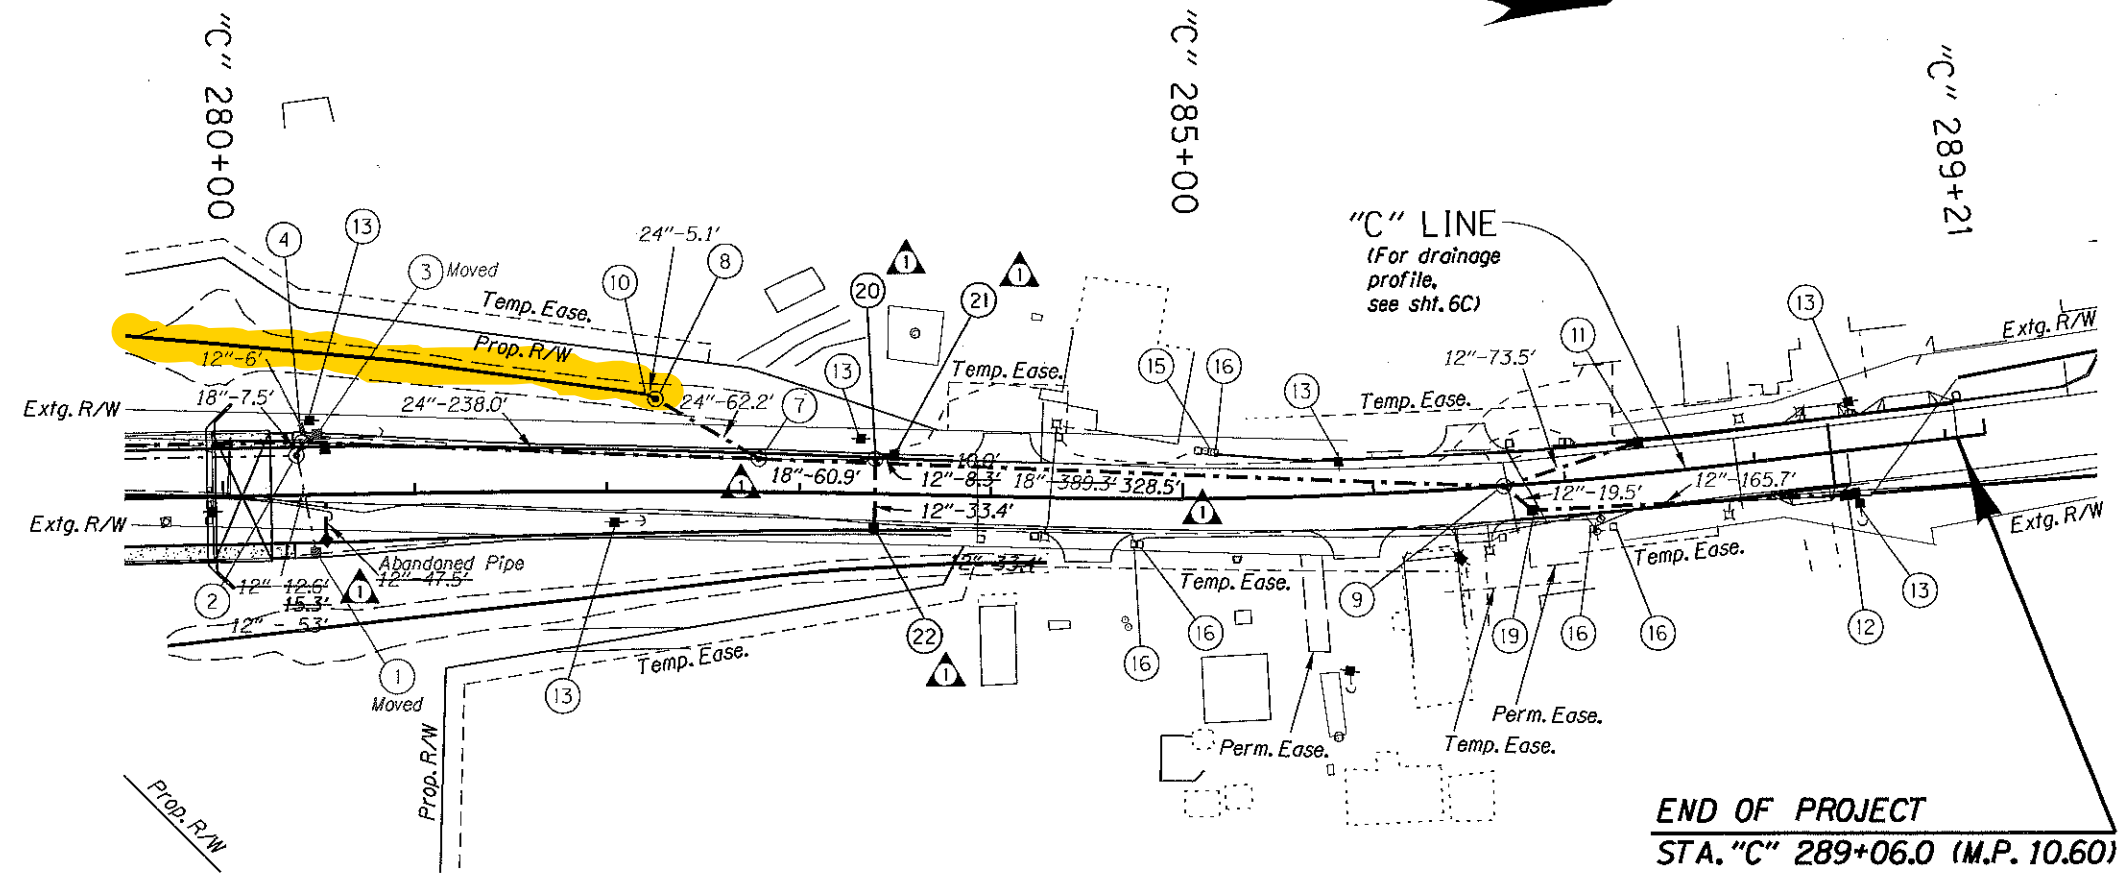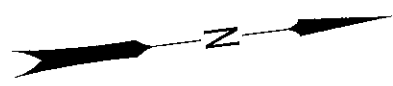

- ① Sta. "C" 280+53.5; Rt.
Const. type "CG-2" inlet
(For details, see sht. GJ-4)
- ① ② Sta. "C" 280+38.6, 20.7' Lt.
Const. manhole
Inst. 12" sew. pipe - 15.3' 53'
5' depth
Inst. 18" sew. pipe - 263.9' 265.7'
(170' pipe on structure)
(For details, see sht. GJ and bridge shts. 82340 & 82345)
(Pipe hangers & inserts are incidental to pipe on structure)
- ③ Sta. "C" 280+53.6; Lt.
Const. type "CG-2" inlet
Inst. 12" sew. pipe - 47.5'
5' depth
Trench resurf. - 9 sqyd.
(For details, see sht. GJ-4)
(See drg. no. RD346)
- ① ④ Sta. "C" 280+41.6, 27.6' Lt.
Const. manhole 72" dia.
Inst. 18" sew. pipe - 7.5'
5' depth
Inst. 12" sew. pipe - 12.6' 12.6' 5' depth
Inst. 18" sew. pipe - 272.0' 272.0' 5' depth
(170' pipe on structure)
(For details, see shts. GJ, GJ-3 & GJ-4 and bridge shts. 82340 & 82345)
(Pipe hangers & inserts are incidental to pipe on structure)
- ① ⑤ Sta. "C" 282+72.6; Rt.
Const. type "CG-2" inlet
(For details, see sht. GJ-4)
- ① ⑥ Sta. "C" 282+70.0; Lt.
Const. type "CG-2" inlet
(For details, see sht. GJ-4)
- ① ⑦ Sta. "C" 282+78.7, 17.4' Lt.
Const. manhole 72" dia.
Inst. 24" sew. pipe - 238.0'
5' depth
Inst. 18" sew. pipe - 389.3' 60.9'
10' depth
Inst. 12" sew. pipe - 46.0'
5' depth
Trench resurf. - 330 sqyd. 80 sqyd.
(For details, see shts. GJ & GJ-4)

- ① ②⑩ Sta. "C" 283+39.4, 14.4' Lt.
Inst. 18" sew. pipe - 328.5'
5' depth
Trench resurf. - 120 sqyd.
(For details, see sht. GJ & GJ-4)
- ① ②⑪ Sta. "C" 287+40.0; Lt.
Const. type "CG-2" inlet
(For details, see sht. GJ-4)
- ① ②⑫ Sta. "C" 287+40.0; Lt.
Const. type "CG-2" inlet
(For details, see sht. GJ-4)
- ⑧ Sta. "C" 282+25.0, 48.1' Lt.
Const. manhole 62.5'
Inst. 24" sew. pipe - 62.2'
5' depth
(For details, see sht. GJ)
- ⑨ Sta. "C" 286+68.2; CL.
Const. manhole
Inst. 12" sew. pipe - 93.0'
5' depth
Trench resurf. - 31 sqyd.
(For details, see sht. GJ)
- ⑩ Sta. "C" 282+20.0, 48.7' Lt.
Inst. 24" sew. pipe - 5.1'
5' depth
(For details, see sht. GJ)
- ⑪ Sta. "C" 287+40.0; Lt.
Const. type "CG-2" inlet
(For details, see sht. GJ-4)
- ⑫ Sta. "C" 288+46.9, 22.9' Rt.
Const. type "M-E" inlet
(For details, see sht. GJ-4)
- ⑬ Relocate power pole - 6
(By others)
- ⑭ Note deleted
- ⑮ Relocate TV riser
(By others)
- ⑯ Relocate phone riser - 5
(By others)
- ⑰ Note deleted
- ⑱ Note deleted
- ⑲ Sta. "C" 286+82.2; Rt.
Const. type "CG-2" inlet
Inst. 12" sew. pipe - 165.7'
5' depth
Trench resurf. - 20 sqyd.
(For details, see sht. GJ-4)

Plug and abandon extg. pipe shown thus:

OREGON DEPARTMENT OF TRANSPORTATION

REGION 1 - ROADWAY ENGINEERING SECTION
 OR213: CASCADE HWY S (MILK CR BR)
 MULINO SEC.
 CASCADE HIGHWAY SOUTH
 CLACKAMAS COUNTY


Design Team Leader - Lawrence Krettler
 Designed By - Timothy Fredette
 Drafted By - Jalal Heydarpour

REGISTERED PROFESSIONAL
 ENGINEER
 17837
 OREGON
 JULY 25, 1995
 TIMOTHY P. FREDETTE
 RENEWAL DATE: 12-31-2009


DRAINAGE AND UTILITIES
 SHEET NO. 6B

No.	DATE	REVISIONS	BY
①	07-16-10	Drainage Adjustments	D.N.A.

REVISED AS CONSTRUCTED
 21 SEP 2012 CONTRACT 14146
 PROJ.MGR. MARJORIE WEST
Marjorie West

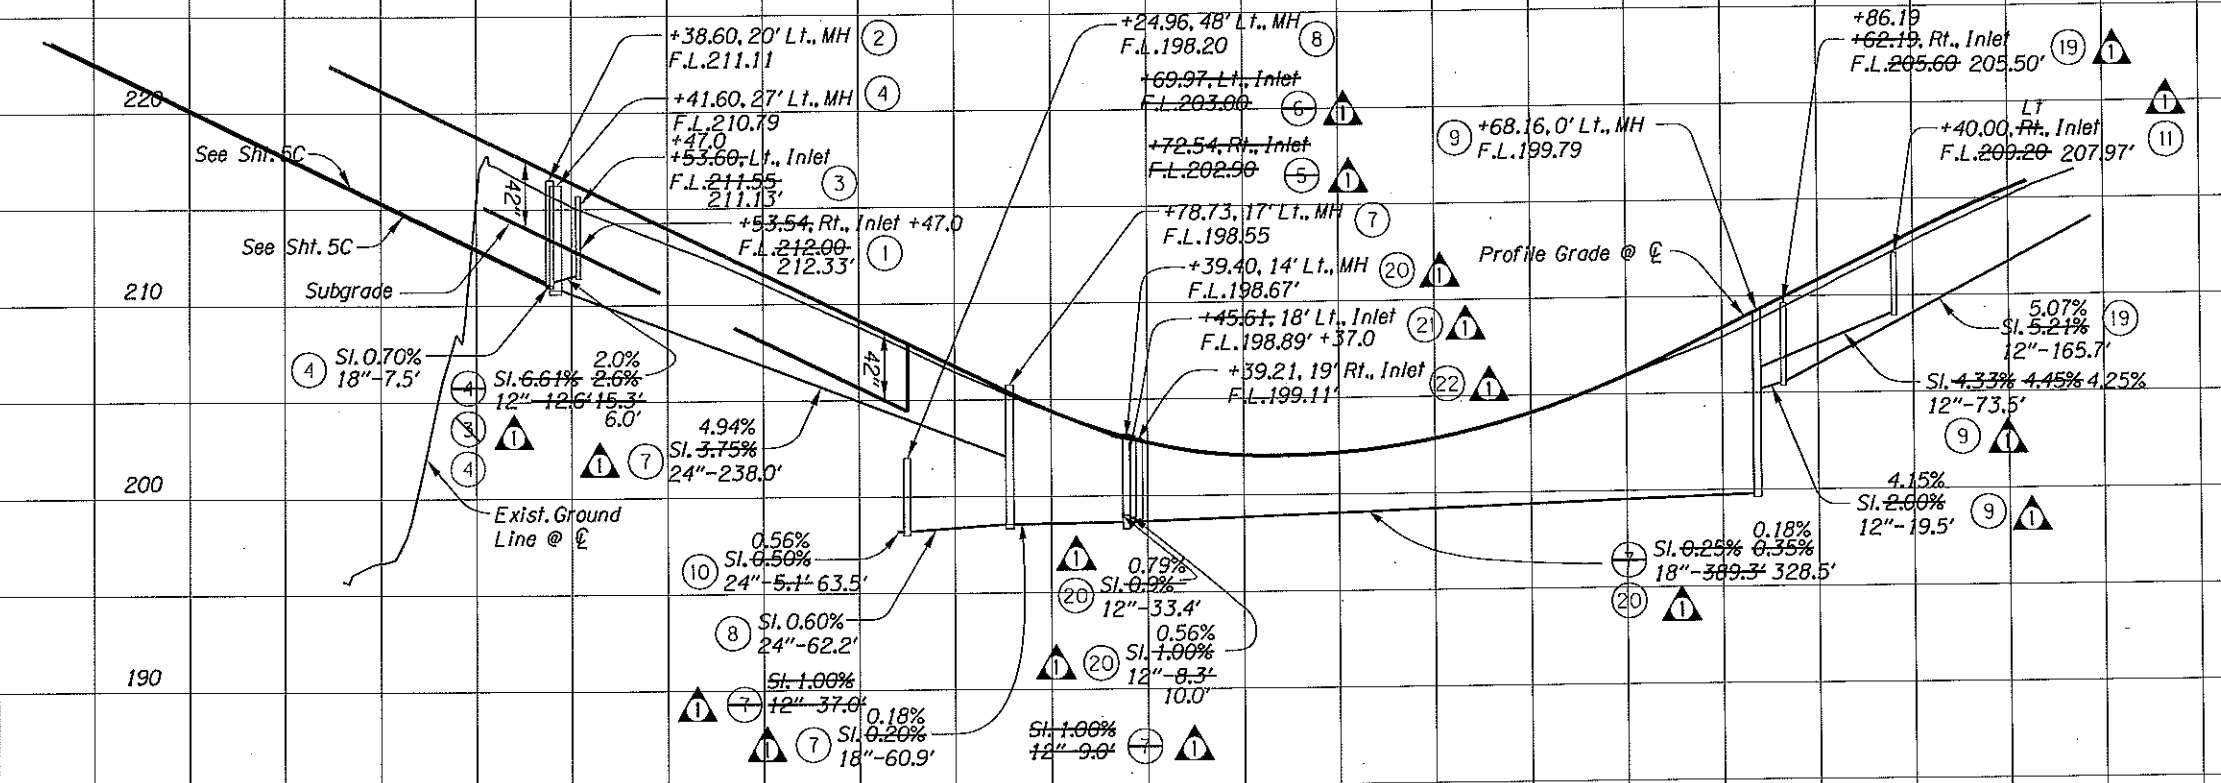

(X) Construction Note Number, Sht. 6B

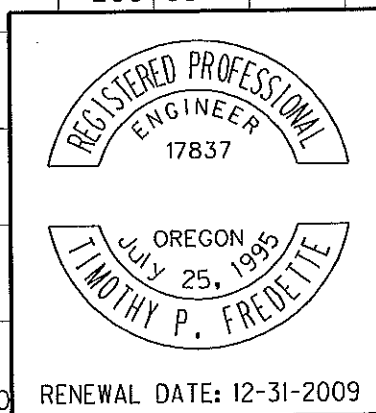

OREGON DEPARTMENT OF TRANSPORTATION

REGION 1 - ROADWAY ENGINEERING SECTION

OR213: CASCADE HWY S (MILK CR BR)
 MULINO SEC.
 CASCADE HIGHWAY SOUTH
 CLACKAMAS COUNTY

Design Team Leader - Lawrence Kretler
 Designed By - Timothy Fredette
 Drafted By - Jalal Heydarpour


DRAINAGE PROFILE

SHEET NO. 6C

RENEWAL DATE: 12-31-2009

No.	DATE	REVISIONS	BY
1	07-16-10	Drainage Adjustments	D.N.A.


281+00 282+00 283+00 284+00 285+00 286+00 287+00

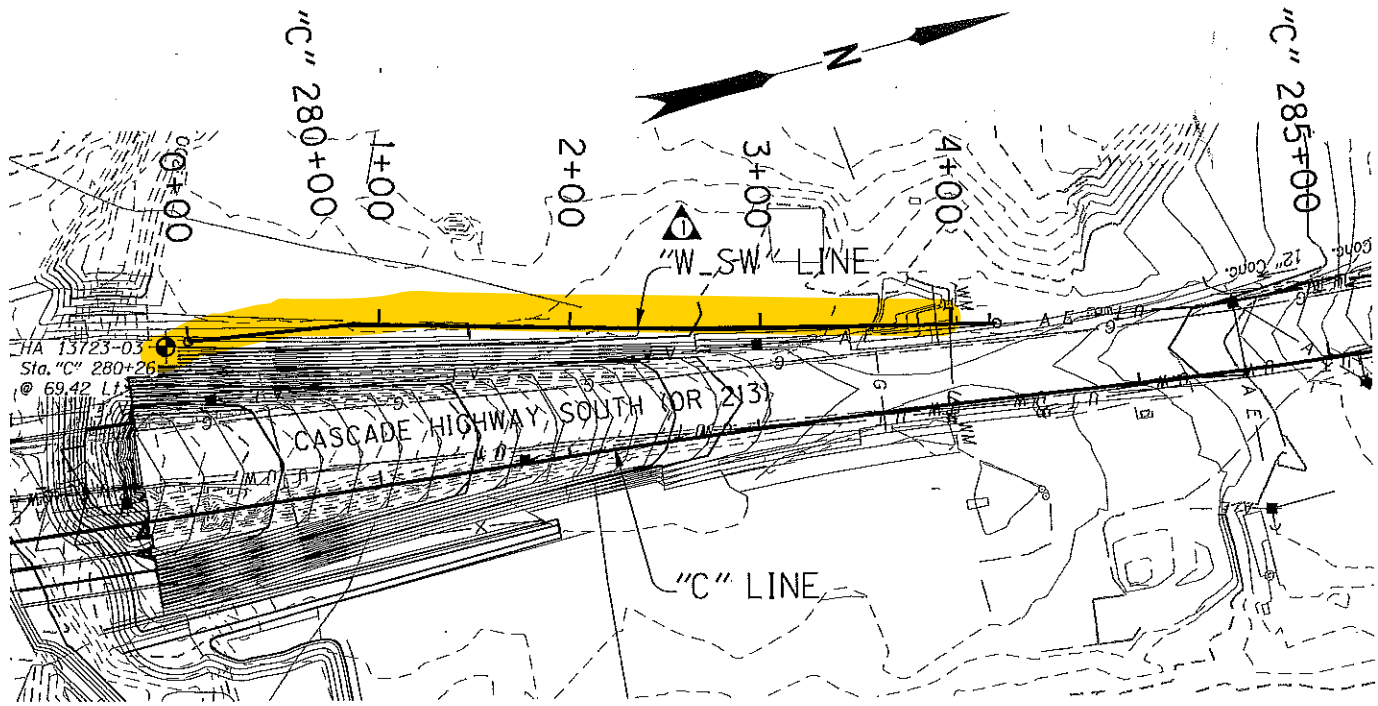


PLAN
Scale: 1"=100'

--- Extg. Contours
— Proposed Contours

REVISED AS CONSTRUCTED
21 SEP 2012 CONTRACT 14146
PROJ.MGR. MARJORIE WEST
[Signature]

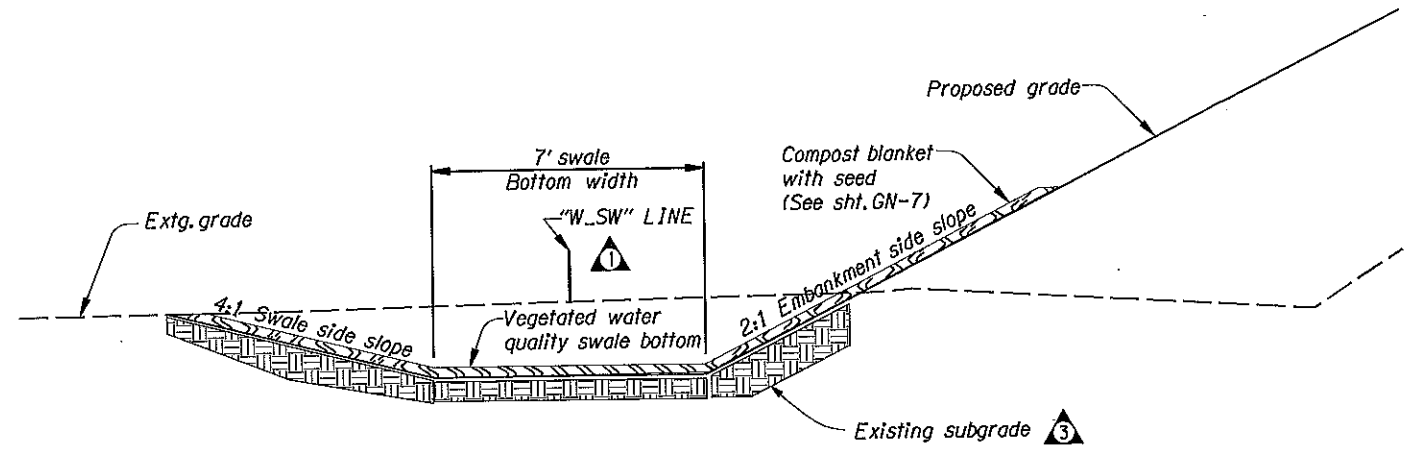

DETAIL
Not to scale

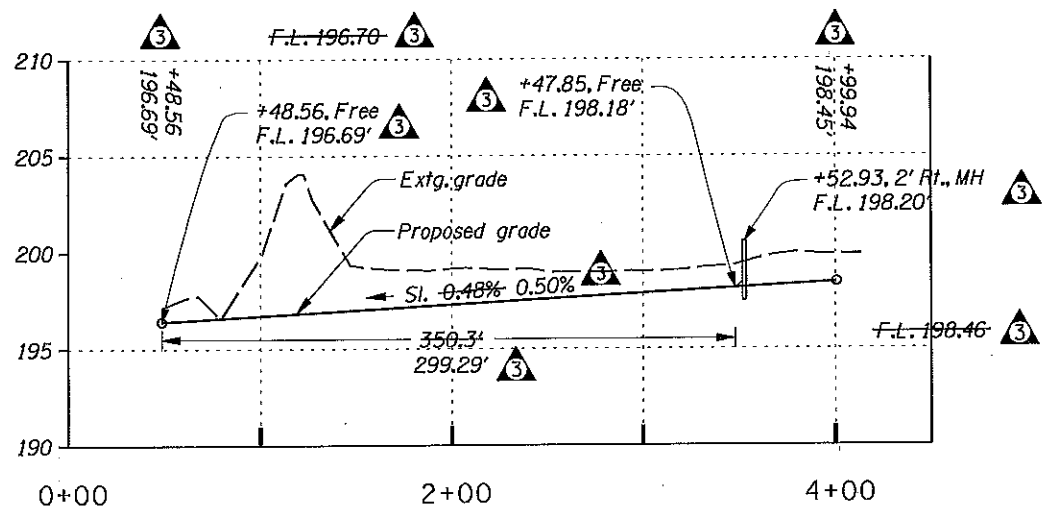

"W_SW" SWALE PROFILE

Horz. Scale: 1"=100'
Vert. Scale: 1"=10'

HA 13723-03 = Hand auger

Drill logs for test borings shown on this drawing are available upon request. Contractor shall refer to geotechnical reports and drill logs and information contained therein.

OREGON DEPARTMENT OF TRANSPORTATION

REGION 1 - Geo/Hydro/HazMat Unit

OR213: CASCADE HWY S. (MILK CR BR) MULINO SEC.
CASCADE HIGHWAY SOUTH
CLACKAMAS COUNTY

Reviewed By - Bruce Council
Designed By - Ed Foltyn
Drafted By - Charlotte Gerken

**WATER QUALITY PLAN,
PROFILE & DETAIL**

SHEET NO. GJ-7



REGISTERED PROFESSIONAL ENGINEER
78814PE
JAN 9, 2007
EDWARD P. FOLTYN
OREGON
RENEWS: 12-31-2011

No.	DATE	REVISIONS	BY
1	02-04-10	Changed "W" Line to "W_SW" Line	E.P.F
2	02-04-10	Added swale length and inverts	E.P.F
3	07-01-10	Drainage Adjustments	D.N.A

WATER QUALITY SWALE GENERAL DETAILS
PLAN AND TYPICAL CROSS-SECTION

REVISED AS CONSTRUCTED
 21 SEP 2012 CONTRACT 14146
 PROJ.MGR. MARJORIE WEST
Marjorie West

For additional Section A-A details, see also sht.GN. For inflow, outflow locations and elevations see sht.GJ.

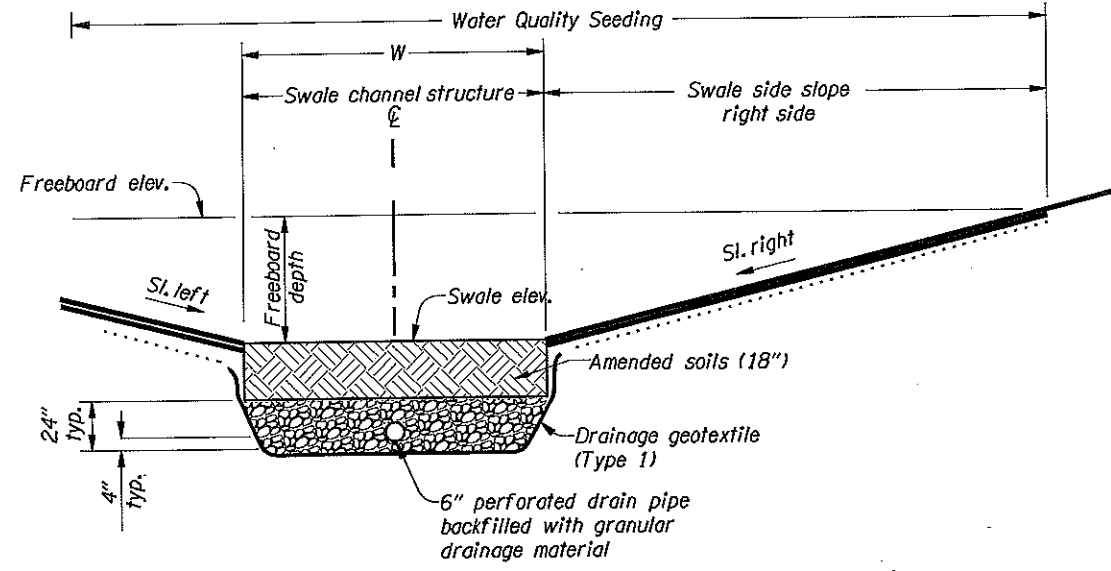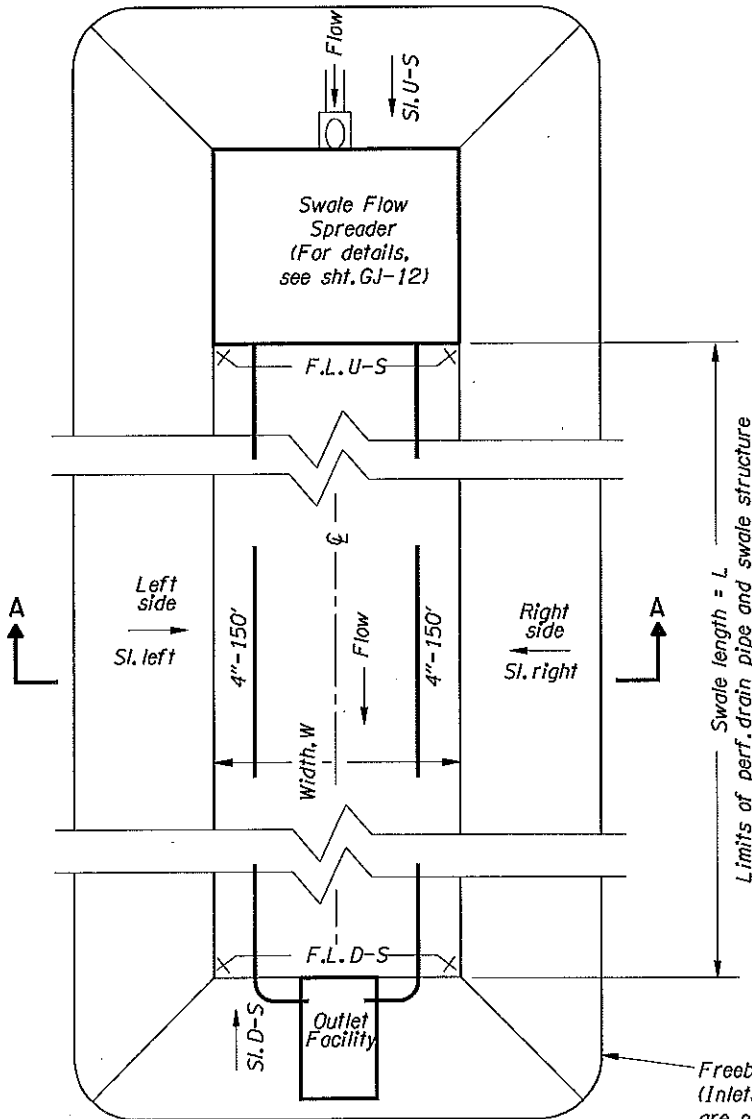

Note:
 See sht. GN for seeding, planting, and swale bottom medium details.

SECTION A-A

Freeboard limits = Pay limits for swale. (Inlets, paved end slopes and outlet facilities are not included in swale pay item.)


Note:
 For swale specifics, refer to the table on this sht.

PLAN

Swale ID	L (ft)	W (ft)	F.L. U-S (ft)	F.L. D-S (ft)	Long. slope (%)	Side slopes (H:V)				Number of underdrain segments	Freeboard depth (ft)	Underdrain tie-in location	Swale outlet facility
						U-S	D-S	Left	Right				
"PGE_SW" Swale	164.6 161	3	237.68	231.86	Varies (follows sidewalk slope)	3:1	3:1	3:1	3:1	1		"D" mod. inlet	"D" mod. inlet
"W_SW" Swale	299.3 354.3	7	198.18 198.46	196.69 196.75	0.50% 0.483%	3:1	NA	4:1	2:1	NA	1	NA	Free outlet, (Class 50) loose riprap
"E_SW" Swale	427.3 240.9	7	200.55 200.23	195.00 199.34	Varies 0.369%	3:1	NA	2:1	4:1	NA	1	NA	Free outlet, (Class 50) loose riprap
"S1" Swale	295	4.5	224	200.78	1.092%	3:1	2:1	Vert. (barrier)	3:1	1	1	"D" mod. inlet	"D" mod. inlet

Notes:
 1) U-S = Upstream
 2) D-S = Downstream
 3) See site plans for pipe inverts at inlets

No.	DATE	REVISIONS	BY
①	02-04-10	Added this entire sheet	E.P.F
②	07-01-10	Drainage Adjustments	D.N.A

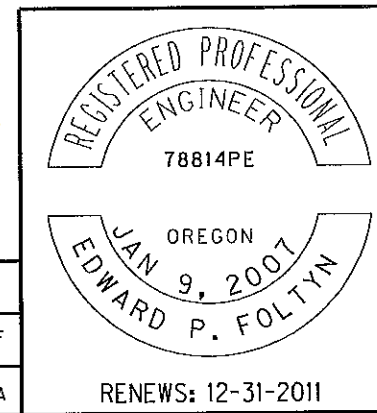

OREGON DEPARTMENT OF TRANSPORTATION

REGION 1 - Geo/Hydro/HazMat Unit



OR213: CASCADE HWY S. (MILK CR BR) MULINO SEC.
 CASCADE HIGHWAY SOUTH
 CLACKAMAS COUNTY

Reviewed By - Bruce Council
 Designed By - Ed Foltyn
 Drafted By - Charlotte Gerken

WATER QUALITY DETAILS

SHEET NO. GJ-13

ROADSIDE RESTORATION
PLANTING DETAILS

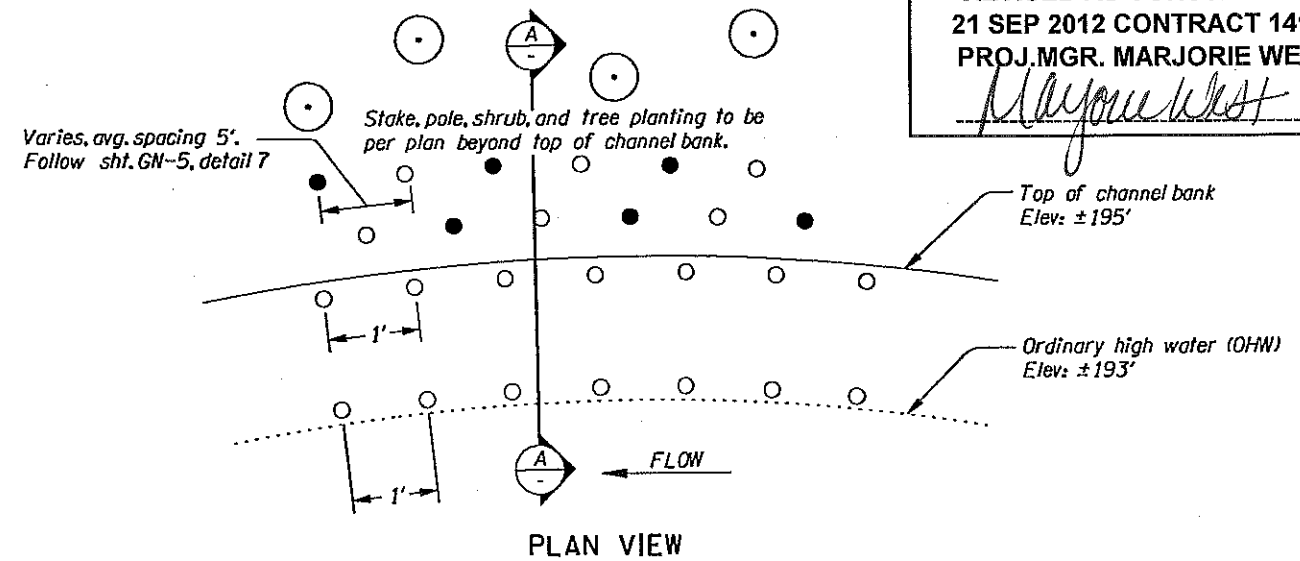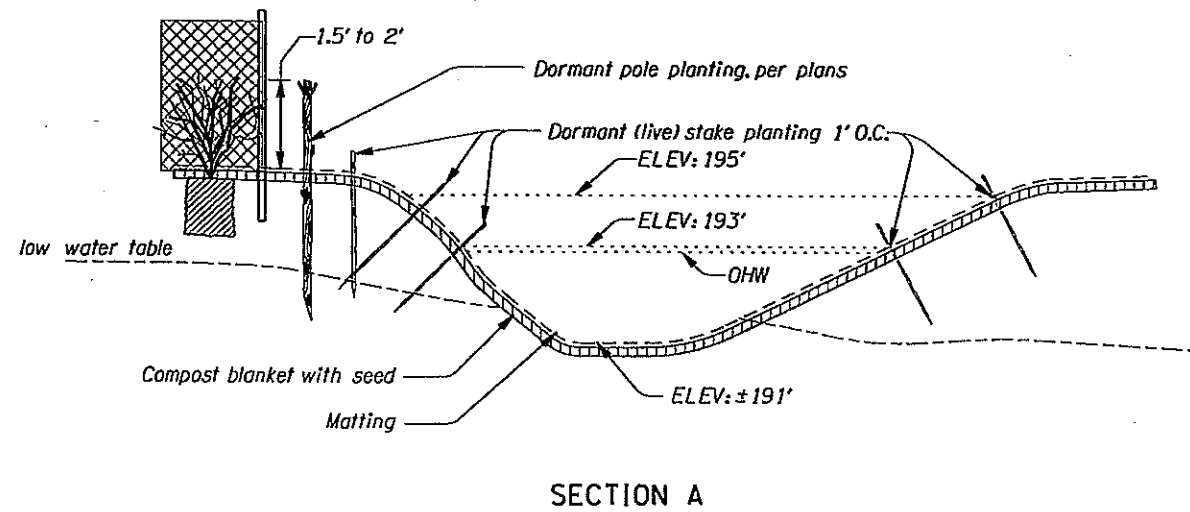


REVISED AS CONSTRUCTED
21 SEP 2012 CONTRACT 14146
PROJ.MGR. MARJORIE WEST
Marjorie West

8 STREAMBANK/CHANNEL STAKE & POLE PLANTING
Not To Scale

NOTES:

1. Staking to follow contours per planting plan for work at elev. ±195' and ±193'
2. See sht. GN-8, detail 11 for tree revetment & rock criteria. See grading plan for approximate placement, to be field coordinated with Agency.

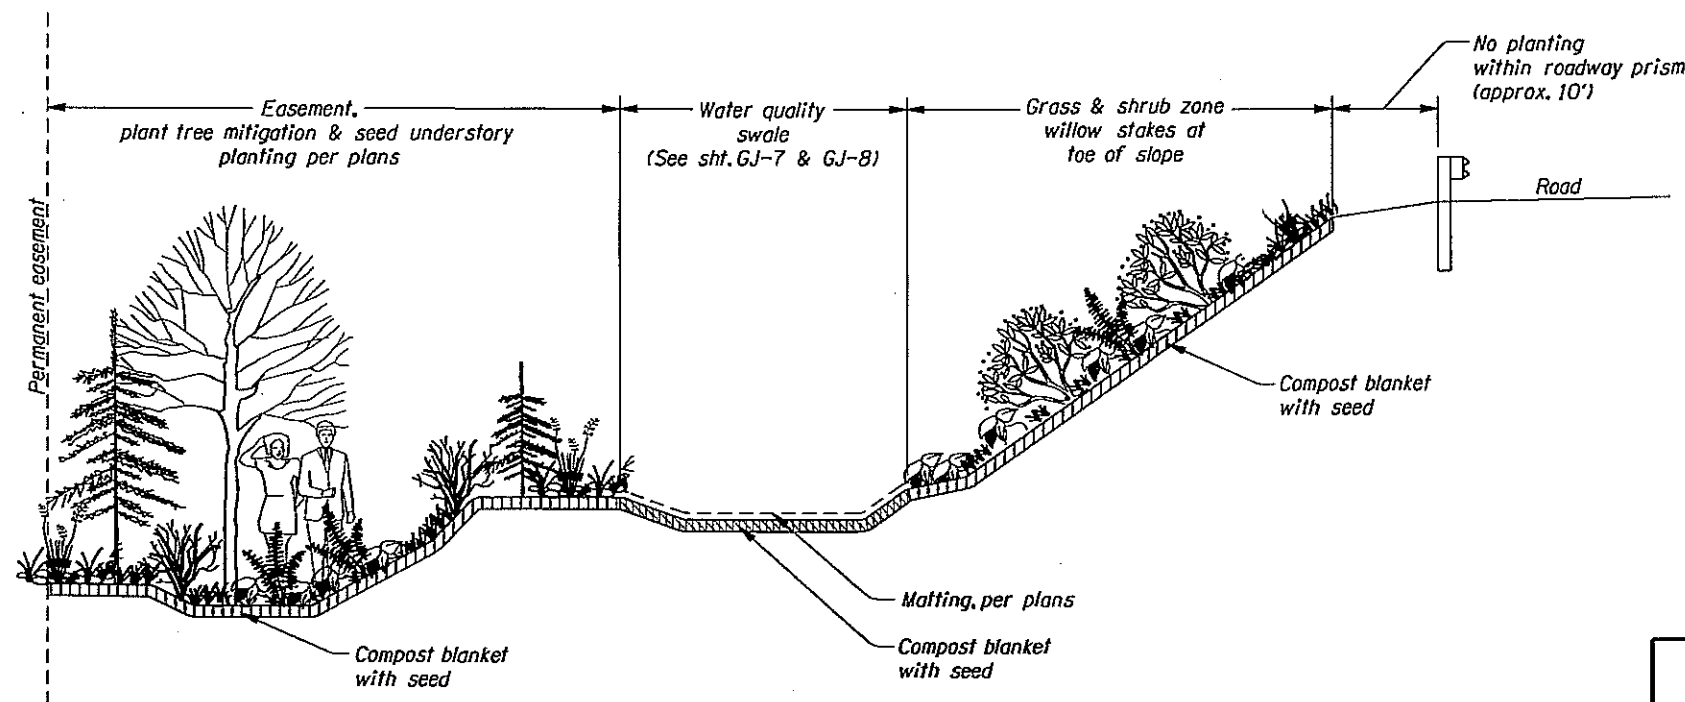

9 TYPICAL ROADSIDE DEVELOPMENT SECTION AT ROAD EMBANKMENT
AREA EAST & WEST SIDES OF ROAD (OR213)
Not To Scale



OREGON DEPARTMENT OF TRANSPORTATION	
REGION 1 - ROADWAY ENGINEERING SECTION	
OR213-CASCADE HWY S (MILK CR BR) MULINO SEC. CASCADE HIGHWAY SOUTH CLACKAMAS COUNTY	
Design Team Leader - Lawrence Kretzler Designed By - Magnus Bernhardt Drafted By - Marco Singer	
ROADSIDE DEVELOPMENT DETAILS	SHEET NO. GN-7