

# OPERATION & MAINTENANCE MANUAL

## Water Quality Biofiltration Swale

Manual prepared: March 2021

DFI No. D01239



Figure 1: DFI No. D01239, looking Southwest

## Identification

Drainage Facility ID (DFI): D01239  
Facility Type: Water Quality Biofiltration Swale  
Construction Drawings: (V-File Numbers) 53V-013  
Location: District: 08  
Highway No.: OR140 (270)  
Mile Post: 1.483 to 1.503, Left

### 1. Manual Purpose

The purpose of this manual is to outline inspection needs and summarize maintenance actions.

### 2. Facility Location

The location map below details the facility location. The highway, mile posts, side streets, access location, and stormwater flow directions are noted on the map.

Facility location type: Roadway shoulder

Flow direction: West

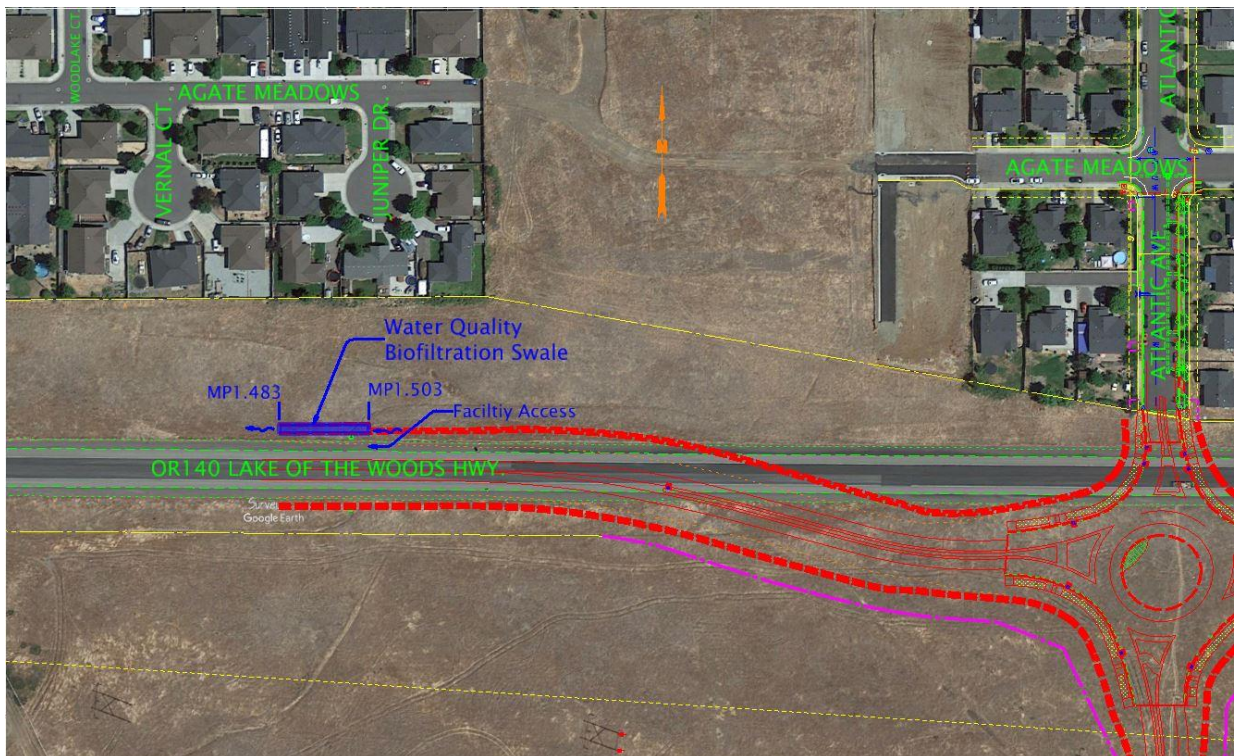



Figure 2: Facility Location Map

### 3. Facility Summary

The length and width of a swale is based on the bottom dimensions.

The bottom length and bottom width of the swale is:


Bottom Length (feet)	Bottom Width (feet)
105	10

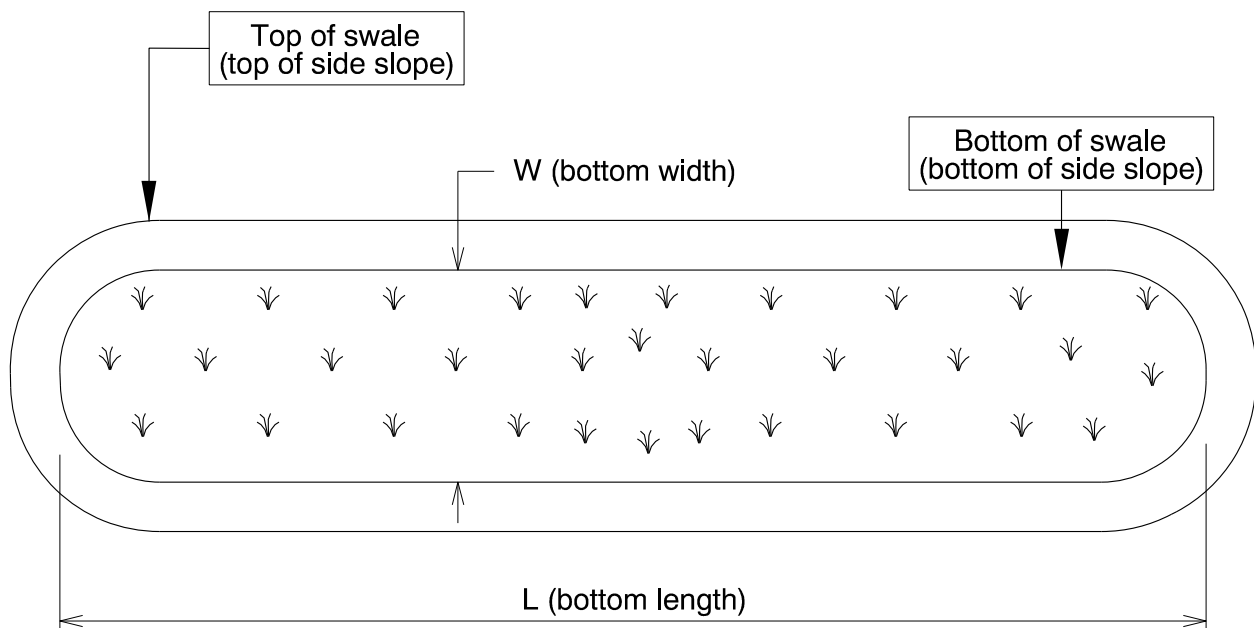

The depth of the swale is the vertical distance measured from the bottom of the swale to the top. The slope of the swale sides is presented by a vertical distance (rise) followed by the horizontal distance (run).

Depth and side slopes:

Depth (feet)	Rise (feet)	Run (feet)
2.6	1	4

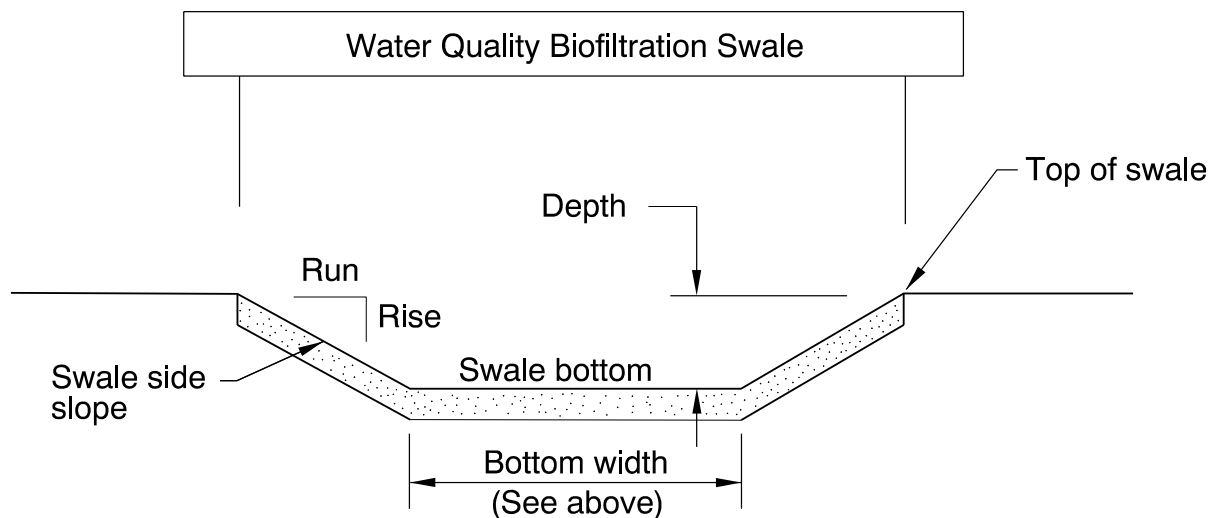

**Site Specific Information:** This is an on-line biofiltration swale with an inlet pipe and inlet ditch, anchored board flow spreaders, and an outlet ditch.

## 4. Facility Access

Maintenance access to the facility:

<input type="checkbox"/> Roadside pad	<input checked="" type="checkbox"/> Roadside shoulder
<input type="checkbox"/> Access road with Gate	<input type="checkbox"/> Access road without Gate



Figure 3: Swale Access

## 5. Operational Components / Maintenance Items

### Classification

This facility is classified as an:

<input checked="" type="checkbox"/> <b>On-line Swale</b>	<input type="checkbox"/> <b>Off-line Swale</b>
A swale that does not include a high flow bypass component; flow drains into and through the facility	A swale that treats low/small flows and diverts high flows using a bypass component

## Bypass Component

This facility includes a high flow bypass component:

<input checked="" type="checkbox"/> No	<input type="checkbox"/> Yes
There is no bypass component. High flows drain into and through the facility	There is a bypass component. Only low/small flows drain into the swale. High flows are diverted around the swale using a bypass component

## Operational Components

A swale has many components that assist with treatment, conveyance, and reducing flow velocity to minimize erosion. The components in use can vary depending if the facility was designed to operate on-line or off-line. The facility components table (**Table 1**) has been provided to highlight the applicable components for this facility. The component is in use when the box contains an “x” (e.g.  ).

The Standard Operation Manual for Water Quality Biofiltration Swales (implemented March 2017) outlines facility operation, typical footprint configuration, and component definitions and details. A link to the manual is attached to the feature marker in TransGIS.

<https://gis.odot.state.or.us/TransGIS/>

## Operational Plan

The applicable standard operational plan for this facility is:

<input checked="" type="checkbox"/> Operational Plan A	<input type="checkbox"/> Operational Plan B	<input type="checkbox"/> Operational Plan C
An on-line swale with roadside ditches	An on-line swale with piped inlets and outlets	An off-line swale with a piped high flow bypass
A standard operational plan illustrates the general facility footprint configuration and explains the purpose of each facility component. Operational plans (A, B, C) are provided in the Standard Operation Manual.		

See Appendix A for the site specific operational plan.

## Maintenance Items

Operational components marked in **Table 1** should be inspected and maintained according to Section 7. Each facility component is defined and detailed in the Standard Operation Manual using the associated ID number indicated below.

<b>Table 1: Swale Components</b>		<b>ID #</b>
<b>Manholes/Structures</b>		
Pre-treatment manhole	<input type="checkbox"/>	<b>S1</b>
Weir type flow splitter/flow splitter manhole	<input type="checkbox"/>	<b>S2</b>
Orifice type flow splitter/flow splitter manhole	<input type="checkbox"/>	<b>S3</b>
Standard manhole	<input type="checkbox"/>	<b>S4</b>
<b>Swale Inlet</b>		
Pavement sheet flow	<input type="checkbox"/>	<b>S5</b>
Inlet Pipe (s)	<input type="checkbox"/>	<b>S6</b>
Open channel inlet	<input checked="" type="checkbox"/>	<b>S7</b>
Riprap pad	<input type="checkbox"/>	<b>S8</b>
<b>Ground Cover</b>		
Grass bottom	<input checked="" type="checkbox"/>	<b>S9</b>
Grass side slopes	<input checked="" type="checkbox"/>	<b>S10</b>
Granular drain rock	<input checked="" type="checkbox"/>	<b>S11</b>
Plantings	<input checked="" type="checkbox"/>	<b>S12</b>
<b>Underground Components</b>		
Matting, Type F	<input checked="" type="checkbox"/>	<b>S13</b>
Water quality mix	<input checked="" type="checkbox"/>	<b>S14</b>
Perforated pipe	<input type="checkbox"/>	<b>S15</b>
Porous pavers (heavy duty access grid)	<input checked="" type="checkbox"/>	<b>S16</b>
<b>Flow Spreader</b>		
Rock basin (used at inlet)	<input type="checkbox"/>	<b>S17</b>
Anchored board (midpoint of swale or every 50 feet along swale bottom)	<input checked="" type="checkbox"/>	<b>S18</b>
Other:	<input type="checkbox"/>	<b>S19</b>
<b>Swale Outlet</b>		
Catch basin with grate	<input type="checkbox"/>	<b>S20</b>
Outlet Pipe (s)	<input type="checkbox"/>	<b>S21</b>
Open channel outlet	<input checked="" type="checkbox"/>	<b>S22</b>
Auxiliary Outlet:	<input type="checkbox"/>	<b>S23</b>
<b>Outfall Type</b>		
Waterbody (Creek/Lake/Ocean)	<input type="checkbox"/> <b>C</b> <input type="checkbox"/> <b>L</b> <input type="checkbox"/> <b>O</b>	<b>S24</b>
Ditch	<input checked="" type="checkbox"/>	<b>S25</b>
Storm drain system	<input type="checkbox"/>	<b>S26</b>
<b>Outfall Components</b>		
Riprap pad	<input type="checkbox"/>	<b>S27</b>
Riprap bank protection	<input type="checkbox"/>	<b>S28</b>

## 6. Maintenance

### Maintenance Frequency/Maintain Records

- a. Inspect annually. Preferably prior to the rainy season.
- b. Clean and maintain as necessary. Refer to Activity 125 for conditions when maintenance is needed.
- c. Keep a record of inspections, maintenance, and repairs.

### Maintenance Guide/Maintenance Actions

The ODOT Routine Road Maintenance Water Quality and Habitat Guide (the *Blue Book*) outlines the standard maintenance actions for water quality facilities under Activity 125.

There are standard maintenance tables for standard ODOT designs. The maintenance tables describe the maintenance component, the defect or problem, the condition when maintenance is needed, and the recommended maintenance to correct the problem. Use the following tables to maintain ODOT swales:

- Table 1 (General Maintenance): Contains general maintenance and inspection guidelines that are applicable to all ODOT water quality facilities
- Table 3 (Maintenance of Water Quality or Biofiltration Swales): Contains maintenance information for swales

The *Blue Book* can be viewed at the following website:

[http://www.oregon.gov/ODOT/Maintenance/Documents/blue\\_book.pdf](http://www.oregon.gov/ODOT/Maintenance/Documents/blue_book.pdf)

## 7. Limitations

Access grid installed:

<input type="checkbox"/> No	<input checked="" type="checkbox"/> Yes
There are heavy porous pavers installed in this swale	

Swales are designed to allow equipment access along the bottom. If an access grid is **NOT** installed, vehicles entering the swale can create depressions (tire ruts), damage vegetation, and damage structural components (e.g. flow spreaders). These conditions may result in poor treatment and drainage performance.

Equipment wheels should be kept on the tops and side slopes. Mower arms may be run along the swale bottom.



## 8. Waste Material Handling

Material removed from the facility is defined as waste by the Department of Environmental Quality (DEQ). Refer to the roadwaste section of the ODOT Maintenance Yard Environmental Management System (EMS) Policy and Procedures Manual for disposal options:

[http://www.oregon.gov/ODOT/Maintenance/Documents/ems\\_manual.pdf](http://www.oregon.gov/ODOT/Maintenance/Documents/ems_manual.pdf)

Contact any of the following for more detailed information about management of waste materials found on site:


ODOT Clean Water Unit	(503) 986-3008
ODOT Statewide Hazmat Coordinator	(503) 667-7442
ODOT Region 1 Hazmat Coordinator	(503) 731-8290
ODOT Region 2 Hazmat Coordinator	(503) 986-2647
ODOT Region 3 Hazmat Coordinator	(541) 957-3594
ODOT Region 4 Hazmat Coordinator	(541) 388-6186
ODOT Region 5 Hazmat Coordinator	(541) 963-1590
ODEQ Northwest Region Office	(503) 229-5263

## **A Appendix A – Site Specific Operational Plan**

### **Contents:**


**Operational Plan: DFI D01239**

# OR 140 LAKE OF THE WOODS HWY & ATLANTIC AVE

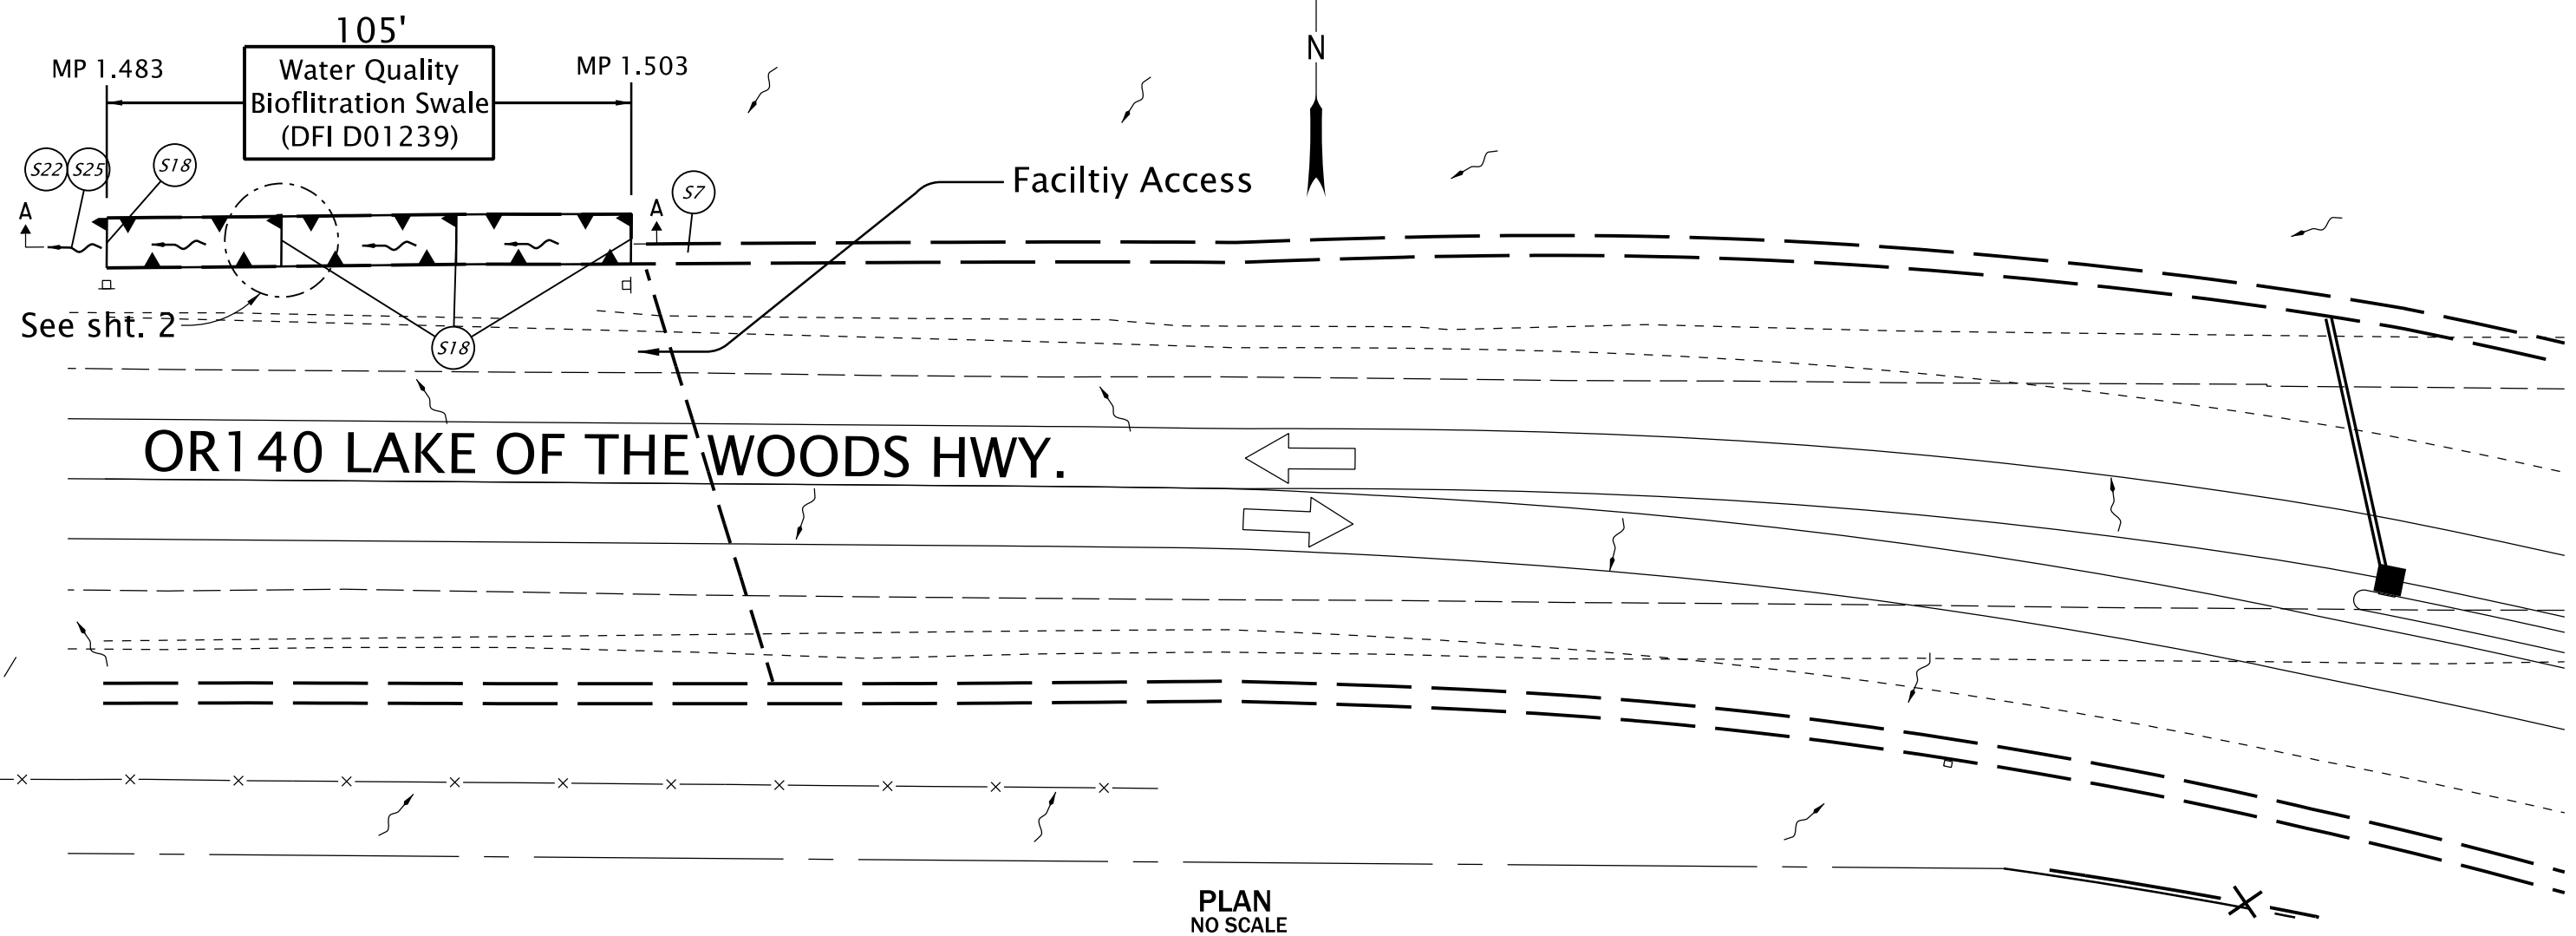

PLAN  
NO SCALE

- LEGEND:**
- Facility component (see table 1 in O&M Manual)
  - Manhole
  - Inlet
  - Storm pipe (facility)
  - Storm pipe
  - Conveyance direction
  - Pavement / facility flow path
  - Traffic flow direction
  - Ditch
  - Fence
  - Swale Bottom

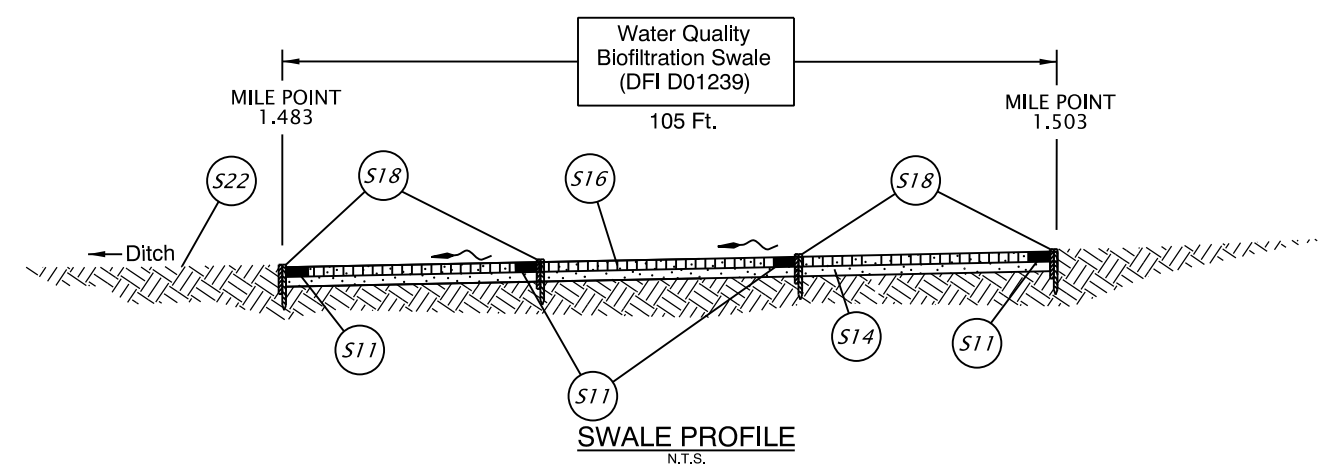

SWALE PROFILE  
N.T.S.  
SECTION A-A




Sht. 1 of 2


Prepared By:  
Richard Carson

Drafted By:  
Richard Carson


**DFI D01239**  
**MAINTENANCE DISTRICT 8 HWY 270**  
**WATER QUALITY BIOFILTRATION SWALE**  
HIGHWAY MP 1.483-1.503  
JACKSON COUNTY

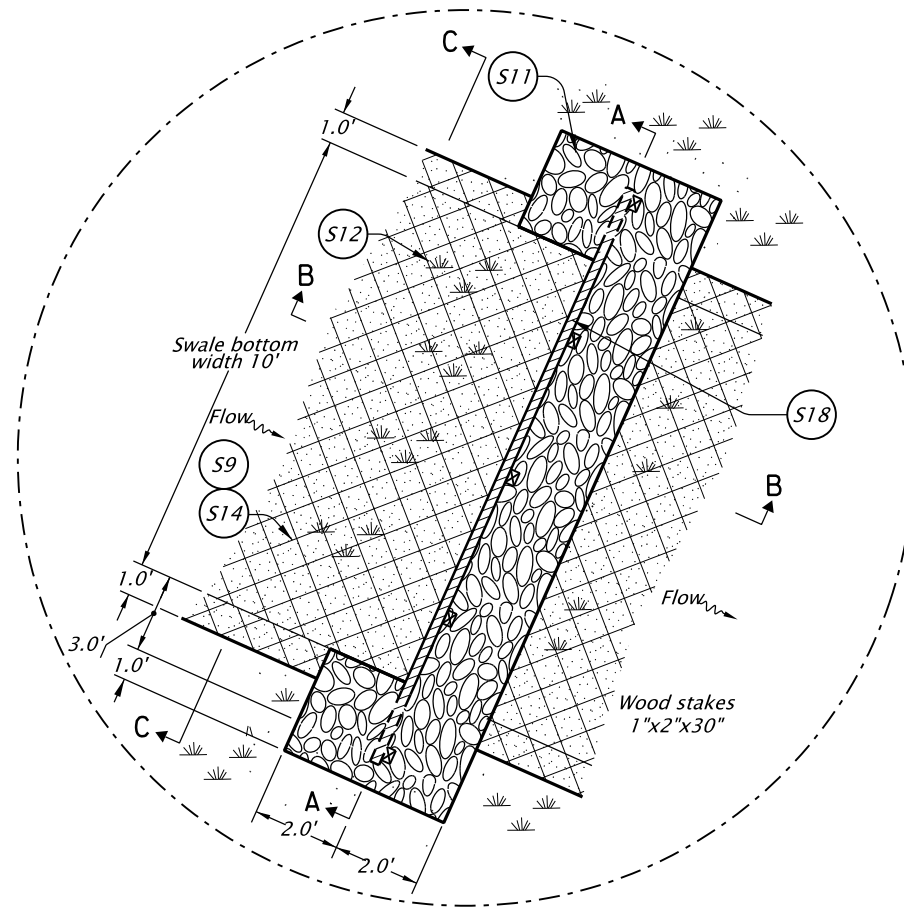


SWALE PLAN VIEW

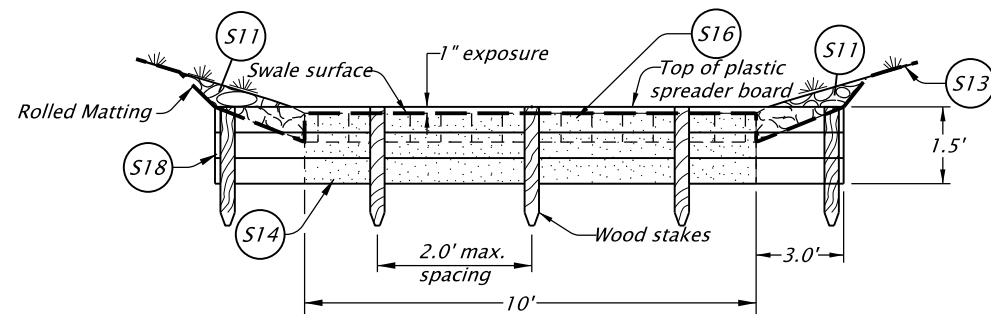

SECTION A-A  
(not to scale)

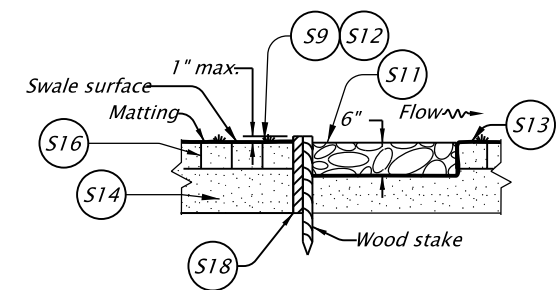

SECTION B-B  
(not to scale)

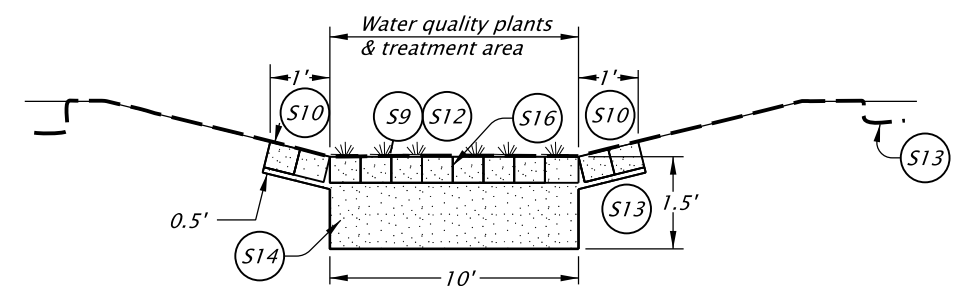

SECTION C-C  
(not to scale)



OREGON DEPARTMENT OF TRANSPORTATION

Sht. 2 of 2

Prepared By:  
Richard Carson

Drafted By:  
Richard Carson

**DFI D01239**  
**MAINTENANCE DISTRICT 8 HWY 270**  
**WATER QUALITY BIOFILTRATION SWALE**  
HIGHWAY MP 1.483-1.503  
JACKSON COUNTY


## **B Appendix B – Project Contract Plans**

### **Contents:**

**Site Specific Subset of Project Contract Plan 53V-013**

INDEX OF SHEETS	
SHEET NO.	DESCRIPTION
A01	Title Sheet
A02	Index Of Sheets Cont'd. & Std. Dwg. Nos.

STATE OF OREGON  
 DEPARTMENT OF TRANSPORTATION  
 PLANS FOR PROPOSED PROJECT  
 GRADING, DRAINAGE, PAVING, CURB RAMPS, SIGNING, ILLUMINATION & SIGNALS

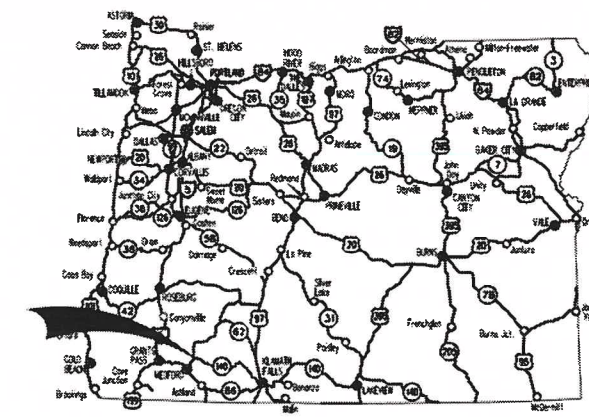

Overall Length Of Project - 0.38 Miles


**ATTENTION:**  
 Oregon Law Requires You To Follow Rules Adopted By The Oregon Utility Notification Center. Those Rules Are Set Forth In OAR 952-001-0001 Through OAR 952-001-0090. You May Obtain Copies Of The Rules By Calling The Center (Note: The Telephone Number For The Oregon Utility Notification Center Is (503) 232-1987).

NOT REVISED AS CONSTRUCTED

*Tony Simpson* 11-18-2020  
 PROJECT INSPECTOR DATE  
*Greg Kitchin* 12-4-2020

**OR140: ATLANTIC AVE.  
 INTERSECTION IMPROVEMENTS PROJECT  
 LAKE OF THE WOODS HIGHWAY**

JACKSON COUNTY  
 MARCH 2020

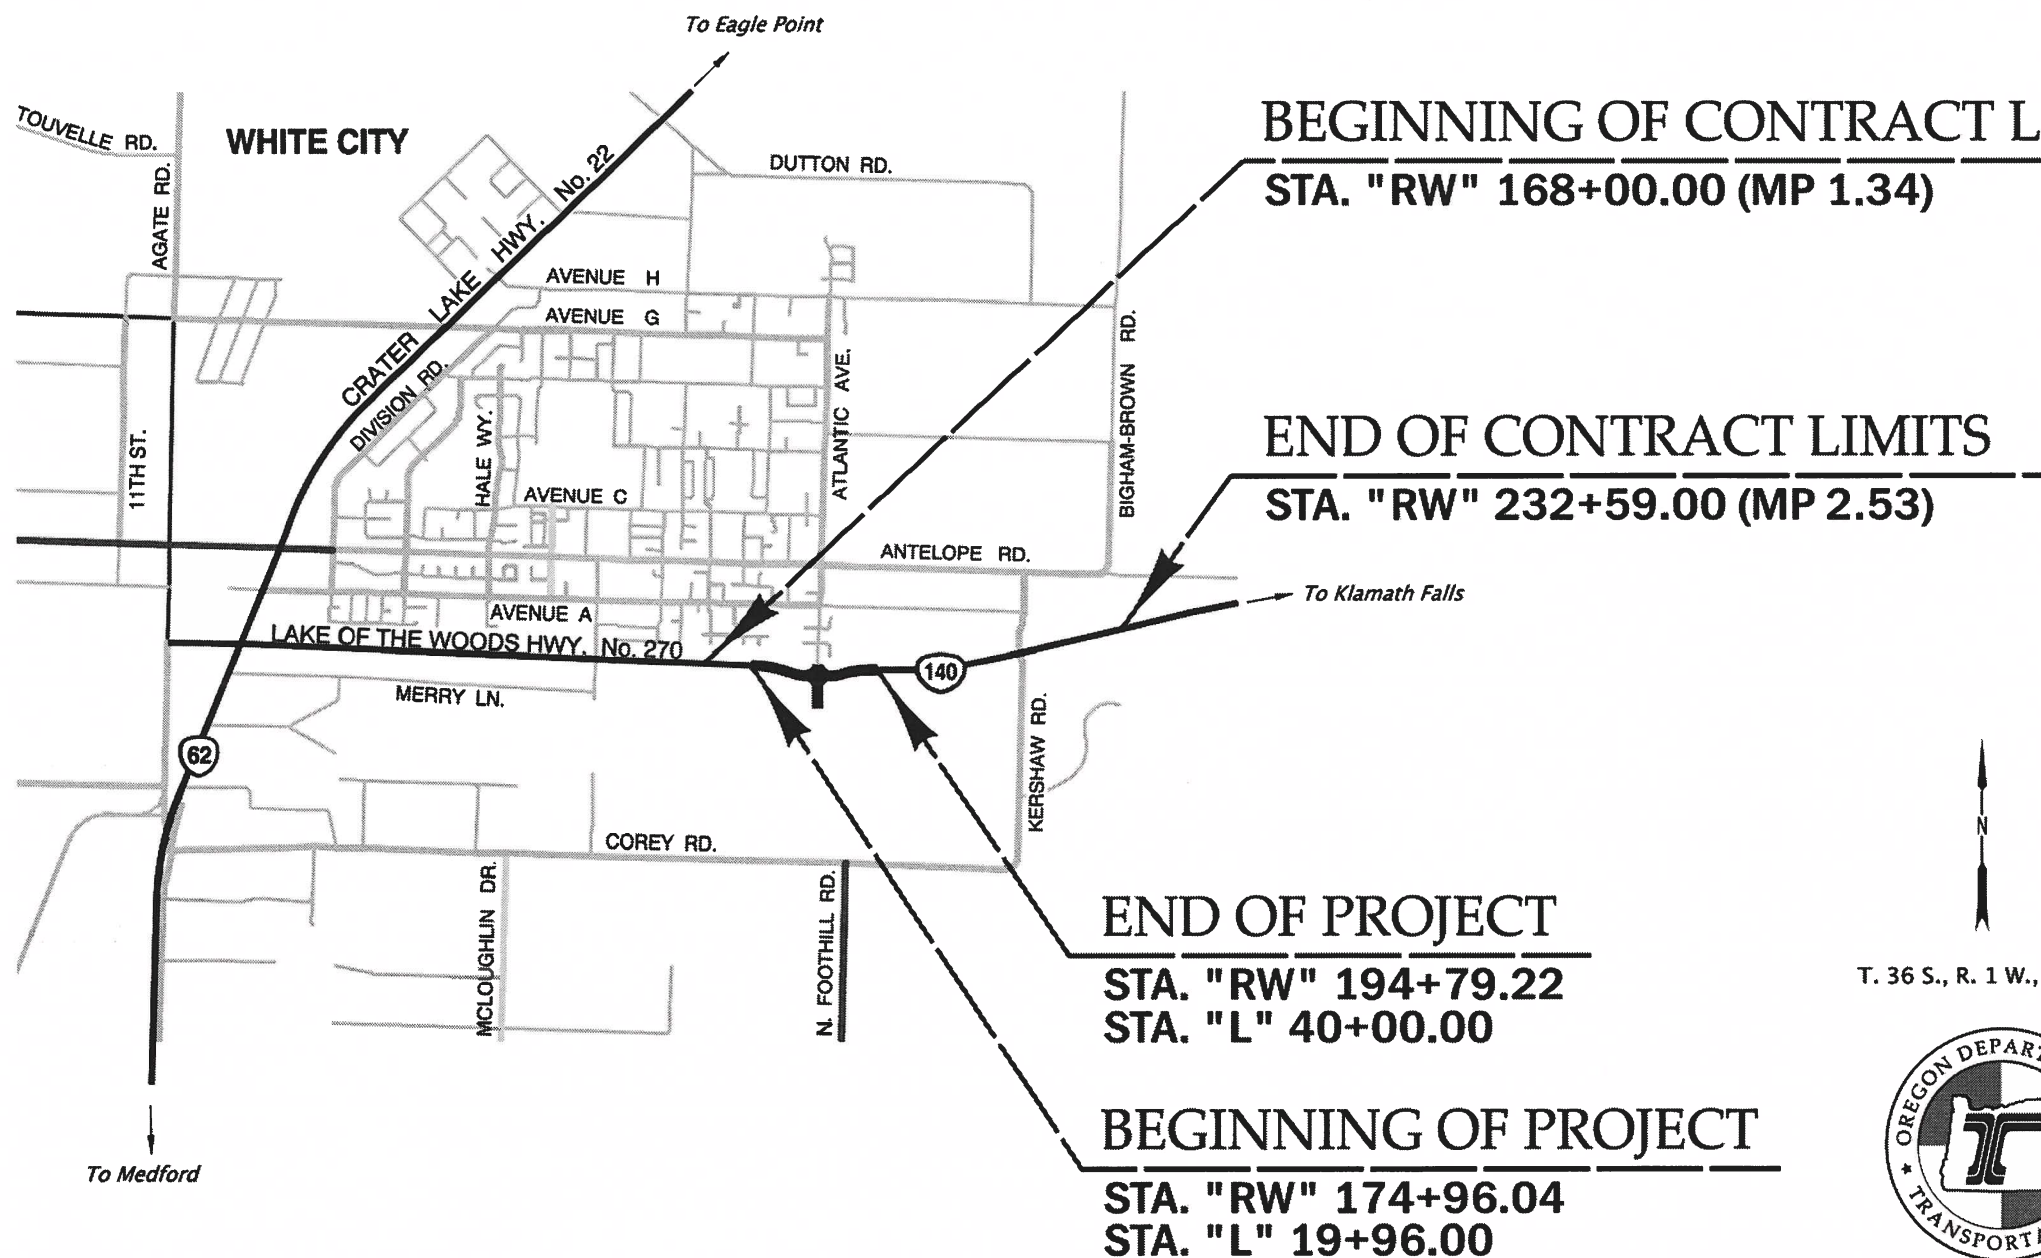

**BEGINNING OF CONTRACT LIMITS**  
 STA. "RW" 168+00.00 (MP 1.34)

**END OF CONTRACT LIMITS**  
 STA. "RW" 232+59.00 (MP 2.53)

**END OF PROJECT**  
 STA. "RW" 194+79.22  
 STA. "L" 40+00.00

**BEGINNING OF PROJECT**  
 STA. "RW" 174+96.04  
 STA. "L" 19+96.00



OREGON TRANSPORTATION COMMISSION

- Robert Van Brocklin CHAIR
- Alando Simpson COMMISSIONER
- Martin Callery COMMISSIONER
- Julie Brown COMMISSIONER
- Sharon Smith COMMISSIONER
- Kristopher W. Strickler DIRECTOR OF TRANSPORTATION

These plans were developed using ODOT design standards. Exceptions to these standards, if any, have been submitted and approved by the ODOT Chief Engineer or their delegated authority.

Approving Authority: M. Thompson, PE Jan 29 2020 9:46 AM

Signature & date

Mark Thompson, Reg. 3 Tech. Ctr. Mgr.

Print name and title

Steven B Cooley Feb 5 2020 4:54 PM

Concurrence by ODOT Chief Engineer

T. 36 S., R. 1 W., W.M.



**OR140: ATLANTIC AVE.  
 INTERSECTION IMPROVEMENTS PROJECT  
 LAKE OF THE WOODS HIGHWAY  
 JACKSON COUNTY**

FEDERAL HIGHWAY ADMINISTRATION	PROJECT NUMBER	SHEET NO.
OREGON DIVISION	STATE	A01

PE002846-000

INDEX OF SHEETS, CONT.	
SHEET NO.	DESCRIPTION
A03, A04	Survey Control Data

ROADWAY DETAILS	
SHEET NO.	DESCRIPTION
BA01 thru BA07	Typical Sections
BB01 thru BB12	Details
BC01 thru BC17	Curb Ramp Details
BD01	Pipe Data

ROADWAY CONSTRUCTION	
SHEET NO.	DESCRIPTION
C01	Alignment
C01A	General Construction
C01B	General Construction Notes
C01C	Drainage and Utilities
C01D	Drainage and Utilities Notes
C01E, C01F	Profile
C02	Alignment
C02A	General Construction
C02B	Drainage and Utilities
C02C	Profile

TRAFFIC CONTROL	
SHEET NO.	DESCRIPTION
EA01	Traffic Control Plan (TPAR)
EB01 thru EB03	Traffic Control Plan (Stage I)
EC01 thru EC06	Traffic Control Plan (Stage II)
ED01 thru ED03	Traffic Control Plan (Stage III)
EE01, EE02	Traffic Control Plan (Stage IV)
EF01, EF02	Traffic Control Plan (Stage V)

ROADSIDE DEVELOPMENT / EROSION CONTROL	
SHEET NO.	DESCRIPTION
FA01	Roundabout Details
FA02	Roundabout Planting Plan
FB01, FB02	Erosion Control & Sediment Control

HYDRAULIC	
SHEET NO.	DESCRIPTION
HA01	Drainage And Utilities
HA02	Stormwater Detail

SIGNS	
SHEET NO.	DESCRIPTION
LA01 thru LA05	Signing Plan
LB01 thru LB03	Signing Details
LC01 thru LC04	Sign and Post Data Table

SIGNALS	
SHEET NO.	DESCRIPTION
M01 thru M05	Flashing Beacon Plan
M06	Details

ILLUMINATION	
SHEET NO.	DESCRIPTION
P01	Illumination Plan
P02 thru P04	Illumination Details

PERMANENT PAVEMENT MARKINGS	
SHEET NO.	DESCRIPTION
QA01 thru QA05	Pavement Marking Details
QB01 thru QB05	Pavement Marking Plan

Standard Dwg. Nos.

- RD140 - Roadway Cross Slopes Superelevated Sections
- RD150 - Slope Rounding
- RD170 - Roundabout And Truck Apron Curb Placement
- RD300 - Trench Backfill, Bedding, Pipe Zone And Multiple Installations
- RD316 - Sloped Ends For Metal Pipe
- RD318 - Sloped Ends For Concrete Pipe
- RD319 - Miscellaneous Culvert Details
- RD325 - Coupling Bands For Corrugated Metal Pipe
- RD326 - Coupling Bands For Corrugated Metal Pipe
- RD327 - Coupling Bands For Corrugated Metal Pipe
- RD335 - Standard Storm Sewer Manhole
- RD336 - Standard Manhole Details
- RD339 - Pipe To Structure Connections
- RD344 - Standard Manhole Base Section
- RD345 - Pipe To Manhole Connections
- RD348 - Manhole With Inlet
- RD363 - Gutter Transition At Inlet
- RD364 - Concrete Inlets Type G-1, G-2, G-2M & G-2MA
- RD365 - Frames & Grates For Concrete Inlets
- RD380 - Fill Height Tables For Aluminum & Steel Corrugated Pipe
- RD382 - Fill Height Tables For Aluminum & Steel Arch Pipe
- RD384 - Fill Height Tables For Aluminum & Steel Spiral Rib Pipe
- RD386 - Fill Height Tables For Circular Concrete Pipe
- RD388 - Fill Height Tables For PVC Pipe
- RD390 - Fill Height Table For Corrugated HDPE Pipe
- RD393 - Fill Height Tables For Polypropylene Pipe
- RD398 - Culvert ID Marker
- RD610 - Asphalt Concrete Pavement (ACP) Details
- RD615 - Asphalt Concrete Pavement (ACP) Details
- RD700 - Curbs
- RD705 - Islands
- RD706 - Traffic Separators And Transitions
- RD707 - Island Nose Treatments
- RD710 - Accessible Route Islands
- RD720 - Curb Line Sidewalks
- RD721 - Separated Sidewalks
- RD722 - Sidewalk Joints
- RD755 - Curb Ramp Details
- RD758 - Detectable Warning Surface Details & Placement Locations
- RD759 - Detectable Warning Surface Details & Placement Locations
- RD810 - Barbed And Woven Wire Fences
- RD1000 - Construction Entrances
- RD1005 - Check Dams Type 1, 3, And 4
- RD1010 - Inlet Protection Type 2, 3, 6, 7, 10 And 11
- RD1055 - Slope and Channel Matting

- TM200 - Sign Installation Details
- TM201 - Miscellaneous Sign Placement Details
- TM212 - Signing Details Oregon Route Signs
- TM221 - Signing Details Milepost Markers
- TM222 - Installation Details Milepost Marker Posts
- TM223 - Conventional Roads Directional Sign Layout Street Name Signs
- TM230 - Mounting Details For Removable Legend 4" Through 8" Letters & Numbers
- TM233 - Mounting Details For Removable Legend Various Arrow Sizes

- TM467 - Pedestrian Signal And Pedestrian Push Button Details
- TM471 - Trenching & Conduit Installation
- TM472 - Traffic Signal Junction Boxes/Hand Holes
- TM482 - Controller Cabinet & Service Cabinet Foundation Details
- TM485 - Service Cabinet Wiring Details
- TM500 - Pavement Marking Standard Detail Blocks
- TM501 - Pavement Marking Standard Detail Blocks
- TM502 - Pavement Marking Standard Detail Blocks
- TM503 - Pavement Marking Standard Detail Blocks
- TM515 - Pavement Markers
- TM521 - Durable & High Performance Pavement Markings Surface & Groove Installed Non-Profiled
- TM530 - Intersection Pavement Markings (Crosswalk, Stop Bar & Bike Lane Stencil)
- TM531 - Turn Arrow Marking Details
- TM539 - Median and Left Turn Channelization Details
- TM560 - Alignment Layout: General
- TM561 - Alignment Layout: Left Turn Lane, Centerline & Medians
- TM570 - Traffic Delineators
- TM571 - Traffic Delineators Steel Post Details
- TM576 - Traffic Delineator Installation For Non-Freeways
- TM602 - Triangular Base Breakaway Multi-Directional Slip Base Design
- TM629 - Slip Base And Fixed Base Luminaire Supports General Details And Design Criteria
- TM630 - Slip Base And Fixed Base Luminaire Supports Base Plate & Footing Details
- TM670 - Wood Post Sign Supports
- TM671 - 3 Second Gust Wind Speed Map
- TM675 - Extruded Aluminum Panels
- TM676 - Sign Attachments
- TM677 - Sign Mounts
- TM678 - Secondary Sign Mounting Details
- TM681 - Perforated Steel Square Tube (PSST) Sign Support Installation
- TM687 - Perforated Steel Square Tube (PSST) Anchor Foundation
- TM688 - Perforated Steel Square Tube (PSST) Slip Base Foundation

- TM800 - Tables, Abrupt Edge And PCMS Details
- TM810 - Temporary Pavement Markings
- TM820 - Temporary Barricades
- TM821 - Temporary Sign Supports
- TM822 - Temporary Sign Supports
- TM830 - Temporary Concrete Barrier And Rumble Strip Details
- TM831 - Temporary Impact Attenuators
- TM833 - Temporary Impact Attenuators
- TM841 - Intersection Work Zone Details
- TM844 - Temporary Pedestrian Access Routing
- TM850 - 2-Lane, 2-Way Roadways



NOT REVISED AS CONSTRUCTED

Tony Simpson 11-18-2020  
PROJECT INSPECTOR DATE





OR140: ATLANTIC AVE. INTERSECTION IMPROVEMENTS PROJECT LAKE OF THE WOODS HIGHWAY JACKSON COUNTY		
FEDERAL HIGHWAY ADMINISTRATION	PROJECT NUMBER	SHEET NO.
OREGON DIVISION	SEE SHEET A01	A02

Standard Drawings located on the web at:  
<http://www.oregon.gov/ODOT/Engineering/Pages/Standards.aspx>

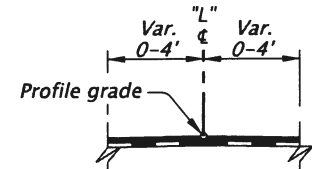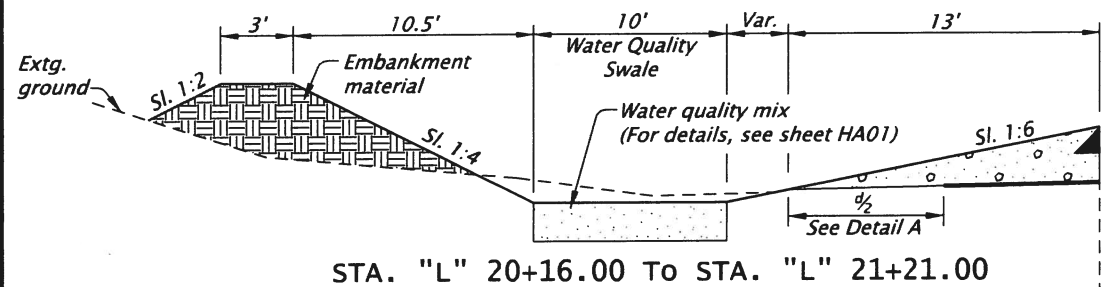


STA. "L" 36+06.70 To STA. "L" 39+32.71

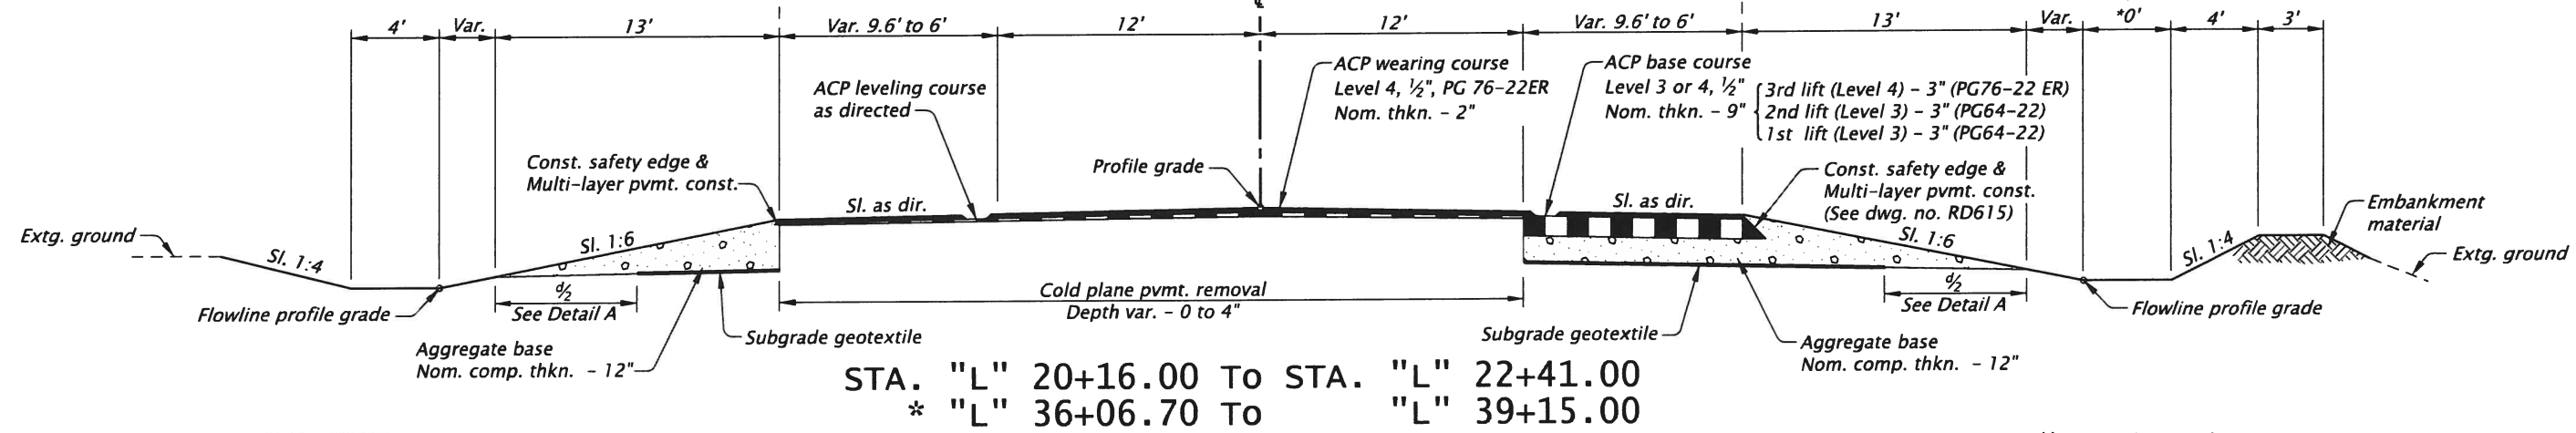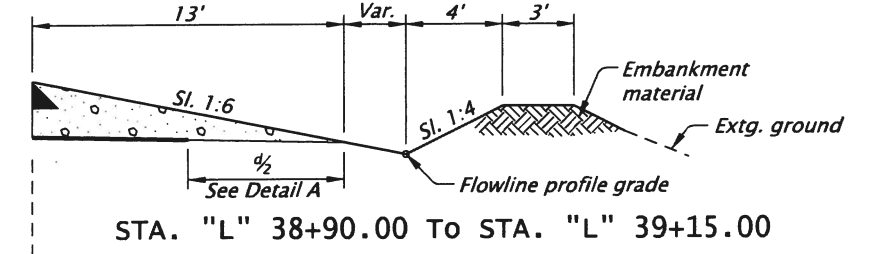



STA. "L" 20+16.00 To STA. "L" 22+41.00  
 \* "L" 36+06.70 To "L" 39+15.00

REVISED AS CONSTRUCTED


*Tony Simpson* 11-18-2020  
 PROJECT INSPECTOR DATE

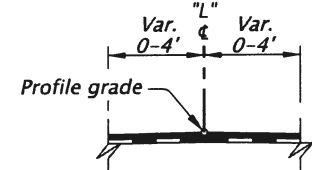


STA. "L" 22+41.27 To STA. "L" 24+41.00

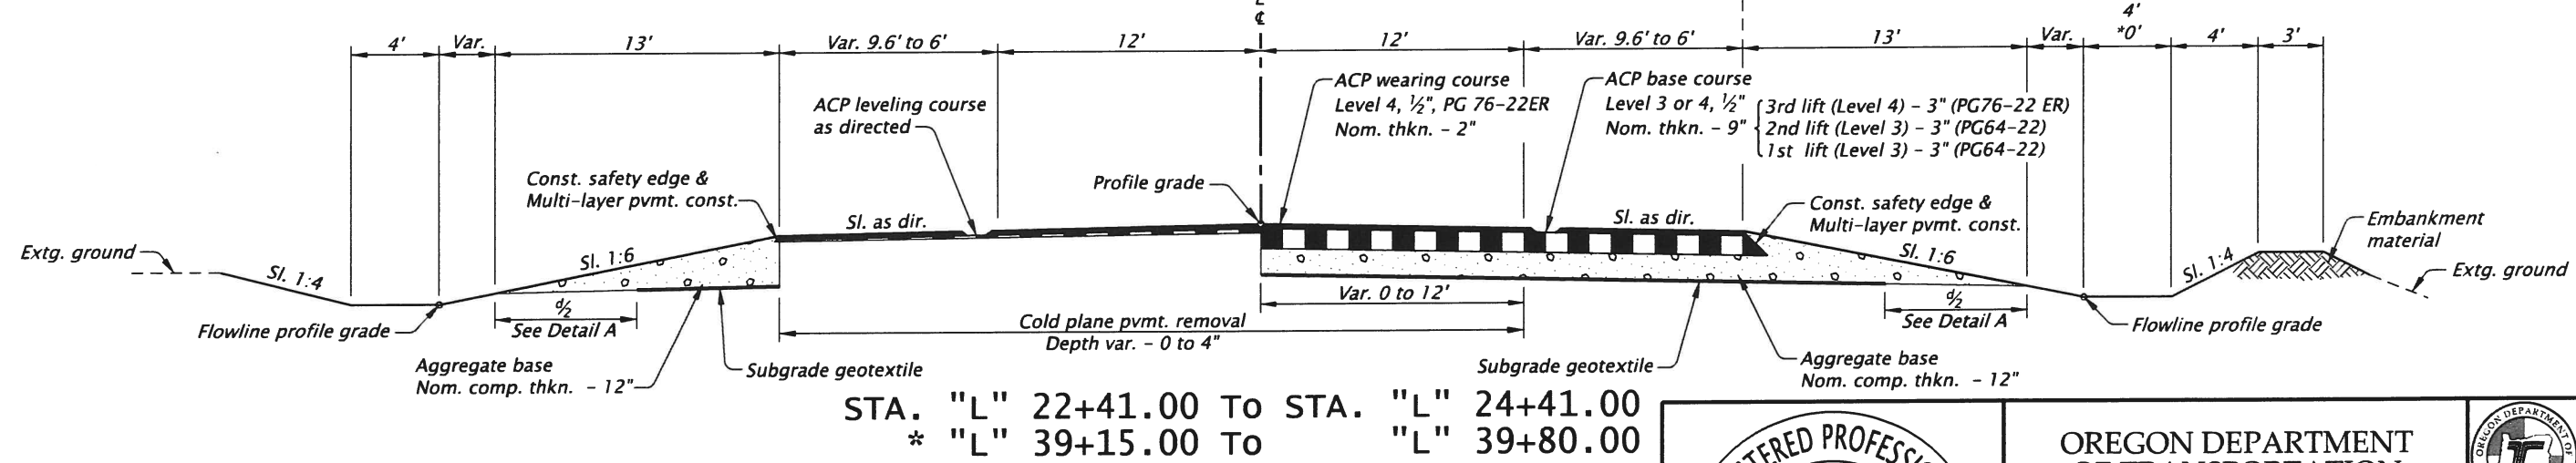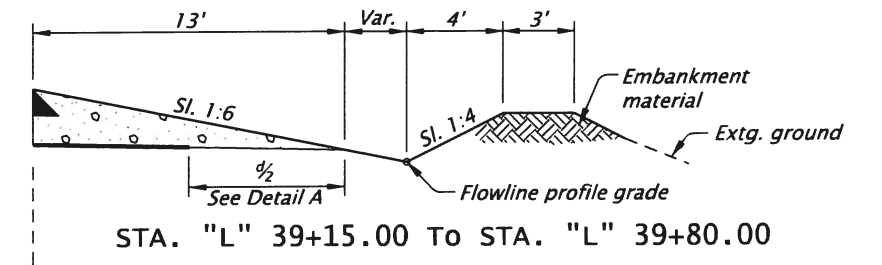

STA. "L" 22+41.00 To STA. "L" 24+41.00  
 \* "L" 39+15.00 To "L" 39+80.00

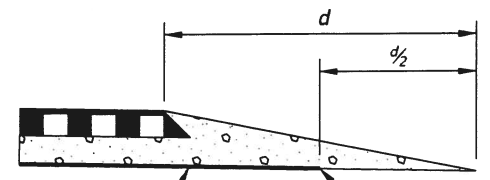

DETAIL A

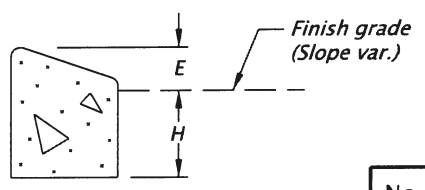

DETAIL B

NOTE:  
 1. Side-slopes are shown as vert. to horiz.  
 2. For standard superelevation, see dwg. no. RD140.  
 3. For slope rounding, see dwg. no. RD150.  
 4. Lane dimensions are shown perpendicular to median gutter line alignments.

No.	DATE	REVISIONS	BY
1	05-26-20	Revised	C.Z.

REGISTERED PROFESSIONAL ENGINEER  
 63243PE  
 Digitally Signed Jun 30 2020 12:50 PM  
 OREGON  
 JULY 9, 2001  
 CHRIS ROSS ZELMER

OREGON DEPARTMENT OF TRANSPORTATION

OR140: ATLANTIC AVE. INTERSECTION IMPROVEMENTS PROJECT  
 LAKE OF THE WOODS HIGHWAY JACKSON COUNTY

Designer: Brian Sheadel Reviewer: Chris Zelmer  
 Drafter: David Knox Checker: Rich Coffel

TYPICAL SECTIONS SHEET NO. BAO2






Sec. 21, T. 36 S., R. 1 W., W.M.

BEGINNING OF PROJECT  
STA. "L" 19+96.00

D01239

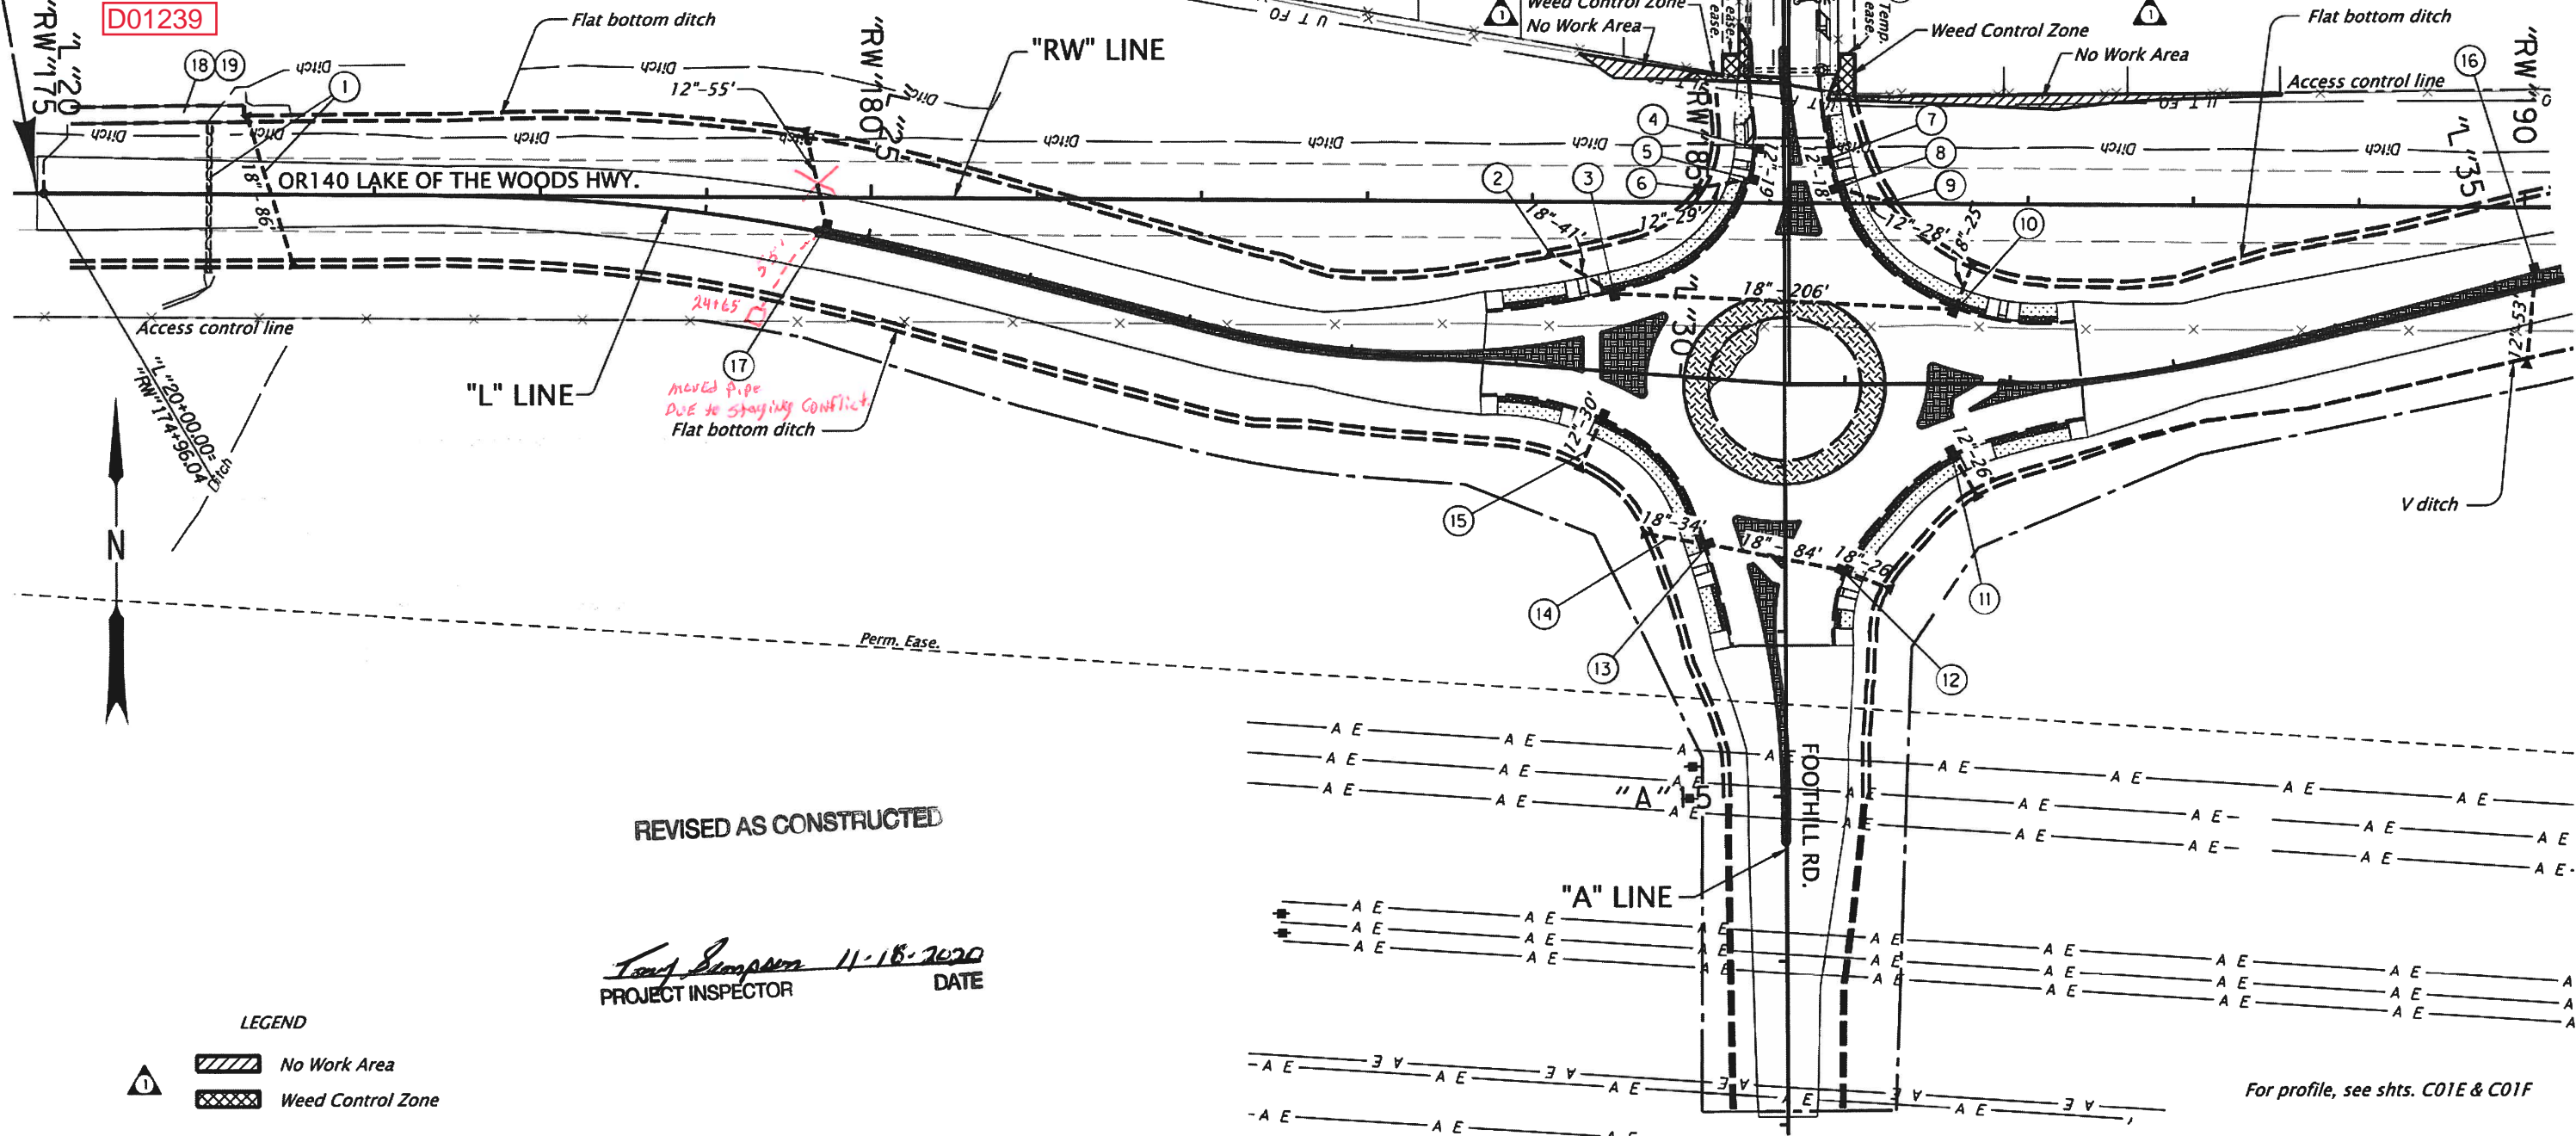

REVISED AS CONSTRUCTED

*Tom Simpson* 11-18-2020  
PROJECT INSPECTOR DATE

- LEGEND
- No Work Area
  - Weed Control Zone

Culvert Location Station	Structure Number	DFI Number	Type 1 Marker		Type 2 Marker	
			Inlet	Outlet	Inlet	Outlet
"L" 21+50 Lt. & "L" 21+24 Rt.	N/A	N/A	✓	✓		
"L" 35+09 Rt.	N/A	N/A		✓		
"L" 24+53 Lt.	N/A	N/A		✓		

See Std. Dwg. RD398

No.	DATE	REVISIONS	BY
1	03-03-20	Added: No Work Area and Weed Control Zone	C.Z.

REGISTERED PROFESSIONAL ENGINEER  
63243PE  
Digitally Signed Mar 4 2020 9:01 AM  
OREGON  
JULY 9, 2001  
CHRIS ROSS ZELMER  
RENEWES: 06-30-2020

OREGON DEPARTMENT OF TRANSPORTATION

OR140: ATLANTIC AVE.  
INTERSECTION IMPROVEMENTS PROJECT  
LAKE OF THE WOODS HIGHWAY  
JACKSON COUNTY

Designer: Brian Sheadel  
Reviewer: Chris Zelmer  
Drafters: Judy Hardin  
Checker: Rich Coffel

DRAINAGE & UTILITIES

SHEET NO. C01C

- ① Sta. "L" 21+50.0, 39.5' Rt. to Sta. "L" 21+24.0, 43.3' Lt.  
Remove extg. pipe - 90'  
Inst. 18" culv. pipe - 86'  
5' depth  
Const. sloped end - 2  
Const. paved end slope, Lt. & Rt.  
Inst. culvert ID marker, Type 1 - 2  
(See dwg. nos. RD300, RD316, RD318, RD319, RD325, RD326, RD327, RD380, RD382, RD384, RD386, RD388, RD390, RD393, & RD398)
- ② Sta. "L" 29+56.0, 48.7' Lt. to Sta. "L" 29+19.5, 66.6' Lt.  
Inst. 18" storm sew. pipe - 41'  
5' depth  
Const. sloped end  
Const. paved end slope, Lt.
- ③ Sta. "L" 29+56.0, 48.7' Lt.  
Const. manhole with type G-1 inlet  
Inst. 18" storm sew. pipe - 206'  
5' depth  
(See dwg. nos. RD335, RD336, RD339, RD344, RD345, RD348, RD363, RD364 & RD365)
- ④ Sta. "A" 18+94.0, 17.9' Lt.  
Const. type G-1 inlet
- ⑤ Sta. "A" 18+75.0, 20.9' Lt.  
Const. type G-1 inlet  
Inst. 12" storm sew. pipe - 19'  
5' depth
- ⑥ Sta. "A" 18+75.0, 20.9' Lt. to Sta. "A" 18+70.4, 48.5' Lt.  
Inst. 12" storm sew. pipe - 29'  
5' depth  
Const. sloped end  
Const. paved end slope, Lt.
- ⑦ Sta. "A" 18+87.0, 28.5' Rt.  
Const. type G-1 inlet
- ⑧ Sta. "A" 18+69.0, 33.1' Rt.  
Const. type G-1 inlet  
Inst. 12" storm sew. pipe - 18'  
5' depth
- ⑨ Sta. "A" 18+69.0, 30.1' Rt. to Sta. "A" 18+62.0, 59.4' Rt.  
Inst. 12" storm sew. pipe - 28'  
5' depth  
Const. sloped end  
Const. paved end slope, Rt.

- ⑩ Sta. "L" 31+75.3, 68.4' Lt. to Sta. "L" 31+66.0, 46.2' Lt.  
Const. manhole with type G-1 inlet  
Inst. 18" storm sew. pipe - 25'  
5' depth  
Const. sloped end  
Const. paved end slope, Lt.
- ⑪ Sta. "A" 17+08.0, 101.6' Rt. to Sta. "A" 16+85.3, 113.8' Rt.  
Const. type G-1 inlet  
Inst. 12" storm sew. pipe - 26'  
5' depth  
Const. sloped end  
Const. paved end slope, Rt.
- ⑫ Sta. "A" 16+27.5, 59.2' Rt. to Sta. "A" 16+37.0, 34.1' Rt.  
Const. type G-1 inlet  
Inst. 18" storm sew. pipe - 26'  
5' depth  
Const. sloped end  
Const. paved end slope, Rt.
- ⑬ Sta. "A" 16+53.0, 46.5' Lt.  
Const. type G-1 inlet  
Inst. 18" storm sew. pipe - 84'  
5' depth
- ⑭ Sta. "A" 16+53.0, 46.5' Lt. to Sta. "A" 16+59.1, 81.3' Lt.  
Inst. 18" storm sew. pipe - 34'  
5' depth  
Const. sloped end  
Const. paved end slope, Lt.
- ⑮ Sta. "A" 17+31.0, 110.5' Lt. to Sta. "A" 17+03.5, 122.3' Lt.  
Const. type G-1 inlet  
Inst. 12" storm sew. pipe - 30'  
5' depth  
Const. sloped end  
Const. paved end slope, Lt.
- ⑯ Sta. "L" 35+25.3, 7.5' Lt. to Sta. "L" 35+08.9, 42.2' Rt.  
Const. type G-1 inlet  
Inst. 12" storm sew. pipe - 53'  
5' depth  
Const. sloped end  
Const. paved end slope, Rt.  
Inst. culvert ID marker, Type 1


- L 24165 Rt
- ⑰ Sta. "L" 24+74.0, 2.8' Lt. to Sta. "L" 24+52.6, 54.6' Lt.  
Const. type G-1 inlet  
Inst. 12" storm sew. pipe - 55'  
5' depth  
Const. sloped end  
Const. paved end slope, Lt.  
Inst. culvert ID marker, Type 1

- ⑱ Sta. "L" 21+20.7 to Sta. "L" 20+16.0, Lt.  
Const. water quality swale, D01239  
Const. wetland plugs - 2100 ea.  
(For details, see shts. HA01 & HA02)

- ⑲ Inst. field facility markers, Type S2 - 2  
(For details, see sht. HA02)
- ⑳ Adjust box

REVISED AS CONSTRUCTED

*Tony Sampson* 11.18.2020  
PROJECT INSPECTOR DATE

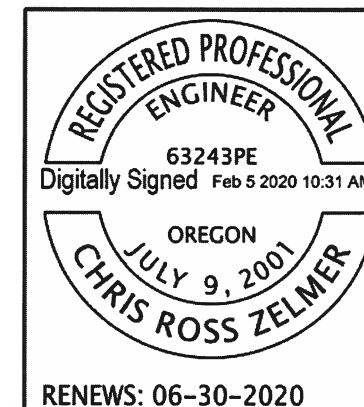

OREGON DEPARTMENT OF TRANSPORTATION



OR140: ATLANTIC AVE.  
INTERSECTION IMPROVEMENTS PROJECT  
LAKE OF THE WOODS HIGHWAY  
JACKSON COUNTY

Designer: Brian Sheadel      Reviewer: Chris Zelmer  
Drafter: Judy Hardin      Checker: Rich Coffel

DRAINAGE & UTILITY NOTES


SHEET NO.  
C01D

RENEWS: 06-30-2020

FINAL ELECTRONIC DOCUMENT  
AVAILABLE UPON REQUEST

Rotation: 0° Scale: 1"=100'

"L" LINE

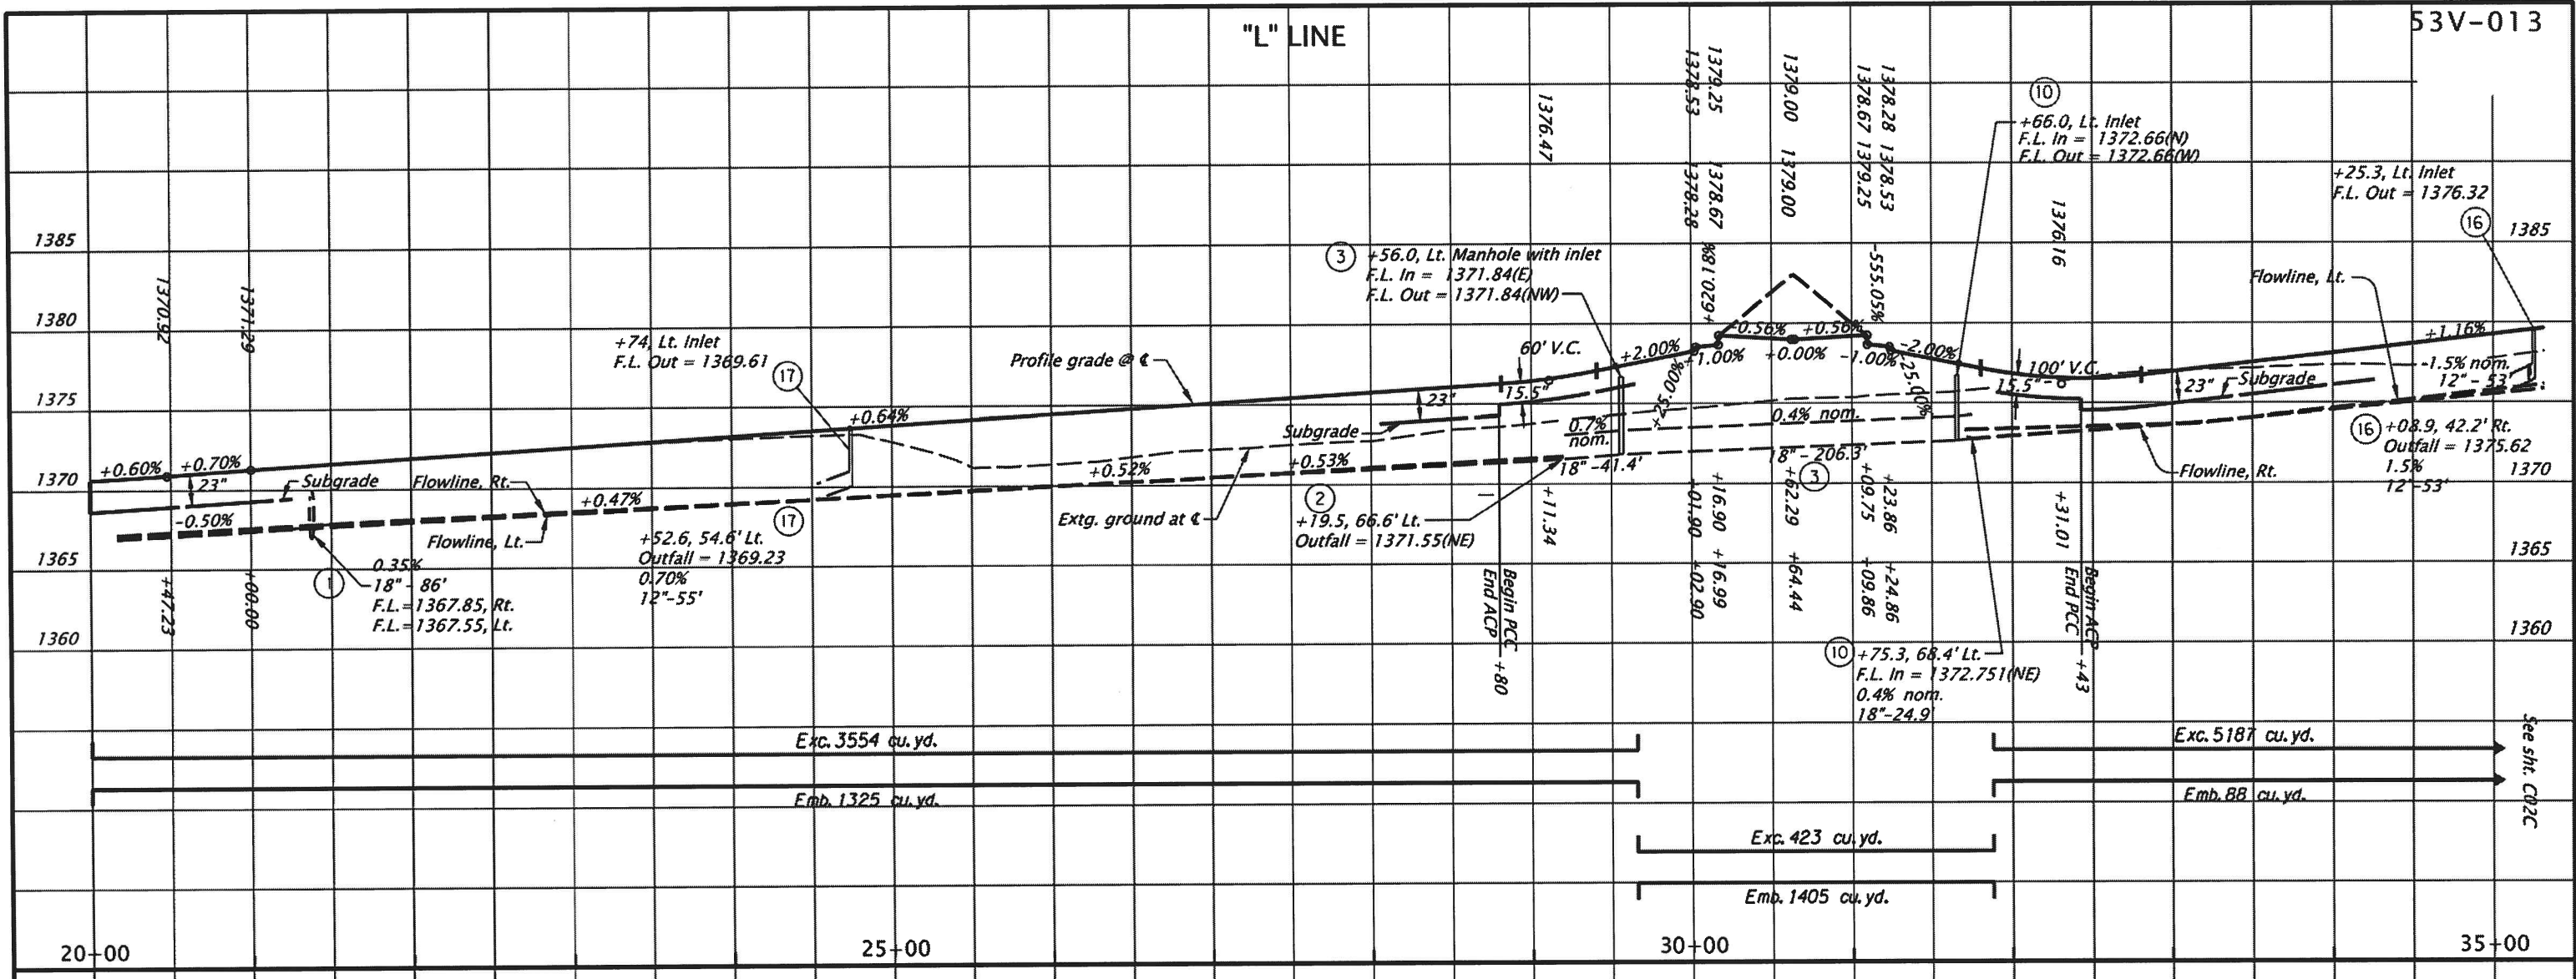

Exc. 3554 cu. yd.

Emb. 1325 cu. yd.

Exc. 5187 cu. yd.

Emb. 88 cu. yd.


Exc. 423 cu. yd.

Emb. 1405 cu. yd.

REVISED AS CONSTRUCTED

*Tony Simpson* 11-18-2020  
PROJECT INSPECTOR DATE

- Notes:  
 1. All pipe slopes provided are nominal.  
 2. See Drainage and Utility Note Sheet C01D for corresponding note number.

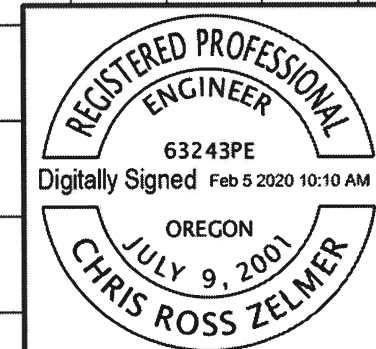

OREGON DEPARTMENT OF TRANSPORTATION

OR140: ATLANTIC AVE.  
 INTERSECTION IMPROVEMENTS PROJECT  
 LAKE OF THE WOODS HIGHWAY  
 JACKSON COUNTY

Designer: Brian Sheadel Reviewer: Chris Zelmer  
 Drafter: Judy Hardin Checker: Rich Coffel




RENEWS: 06-30-2020

PROFILE SHEET NO. C01E

Sec. 21 & 22, T. 36 S., R. 1 W., W.M.

REVISED AS CONSTRUCTED

*Tony Simpson* 11-18-2020  
PROJECT INSPECTOR DATE

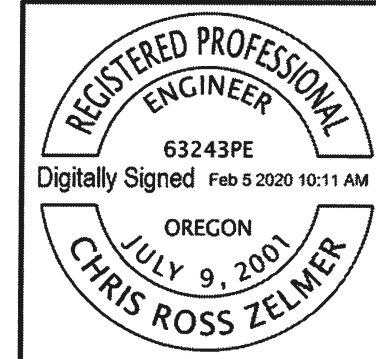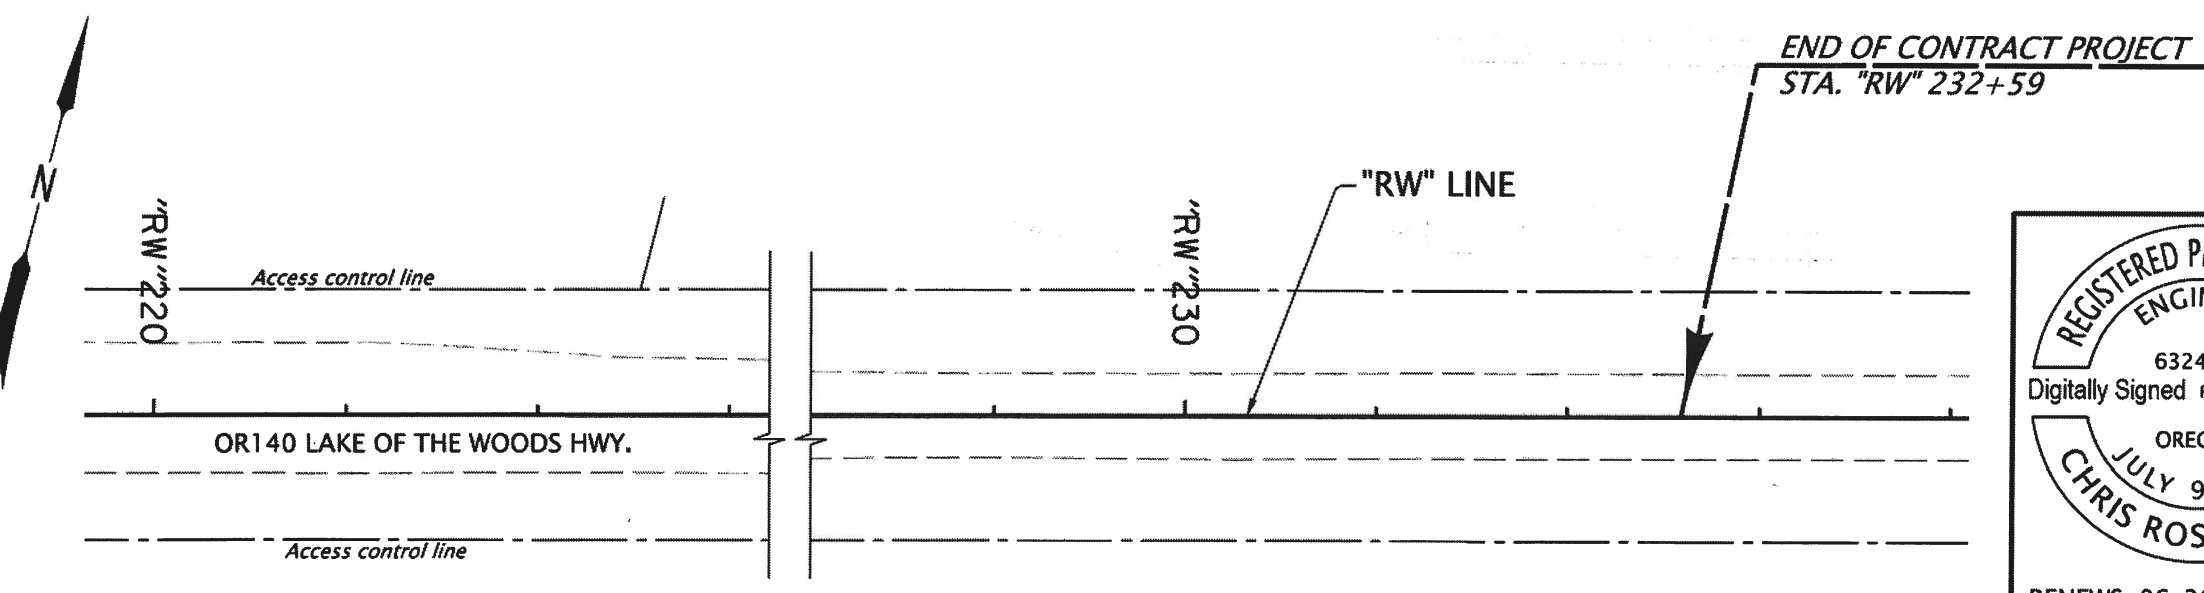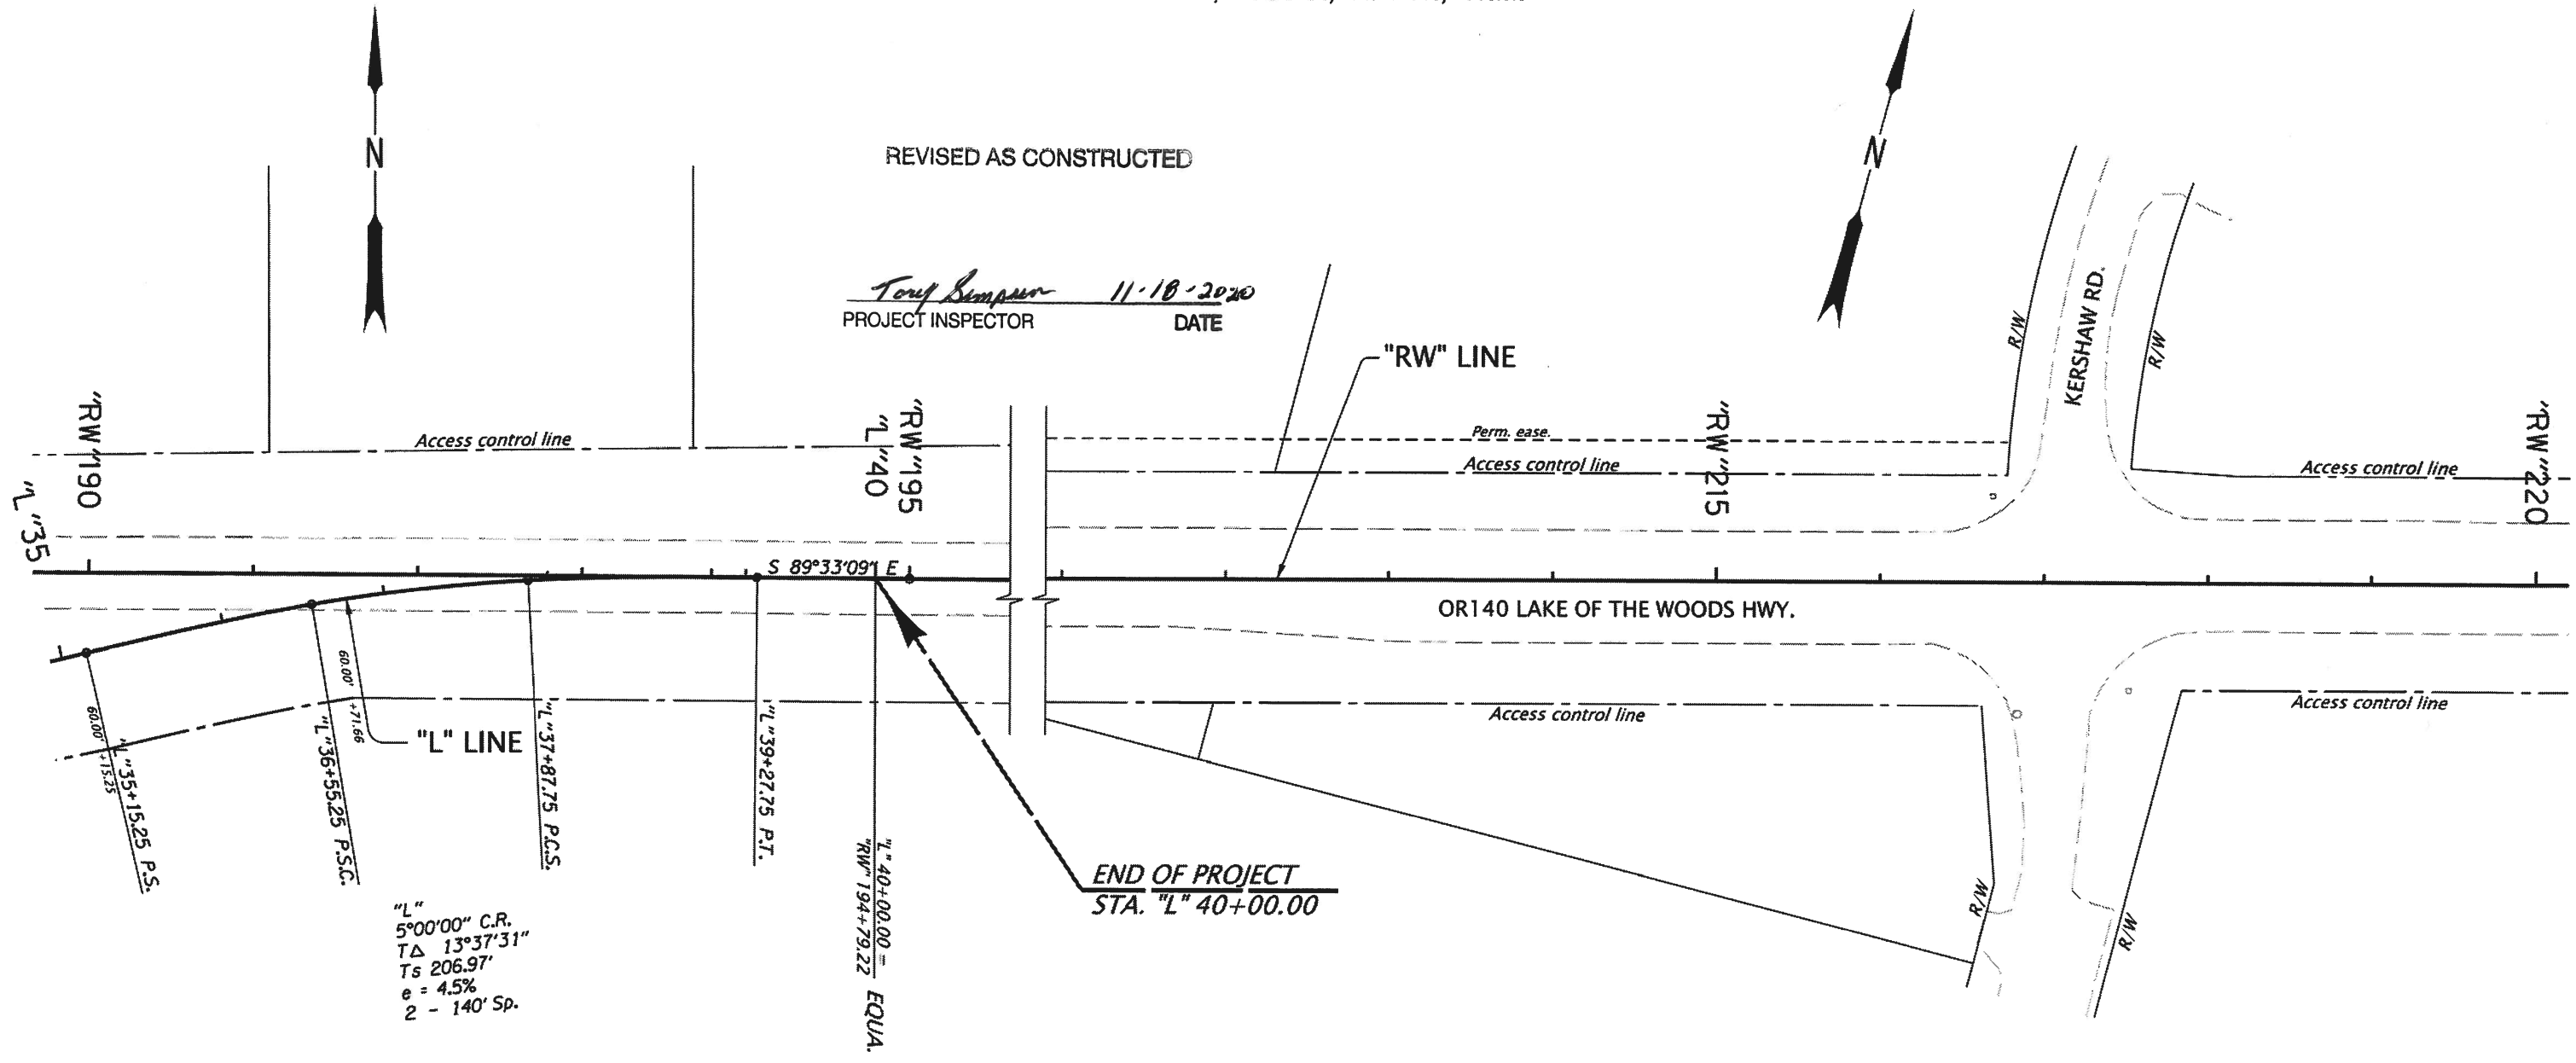

OREGON DEPARTMENT OF TRANSPORTATION		
<b>OR140: ATLANTIC AVE. INTERSECTION IMPROVEMENTS PROJECT</b> LAKE OF THE WOODS HIGHWAY JACKSON COUNTY		
Designer: Brian Sheadel	Reviewer: Chris Zelmer	ALIGNMENT SHEET NO. C02
Drafter: Judy Hardin	Checker: Rich Coffel	

RENEWS: 06-30-2020


FINAL ELECTRONIC DOCUMENT AVAILABLE UPON REQUEST

Rotation: 0° Scale: 1"=100'

REVISED AS CONSTRUCTED

*Tony Simpson* 11-18-2020  
PROJECT INSPECTOR DATE


- ① Sta. "RW" 214+43.24, 6.12' Rt. to Sta. "RW" 220+01.62, 6.69' Lt. Const. conc. traffic separator (Type B) (For details, see sht. BB05) (See dwg. no. RD706)
- ② See sht. C01B, note 15 Const. Type II fence Connect to extg. fence

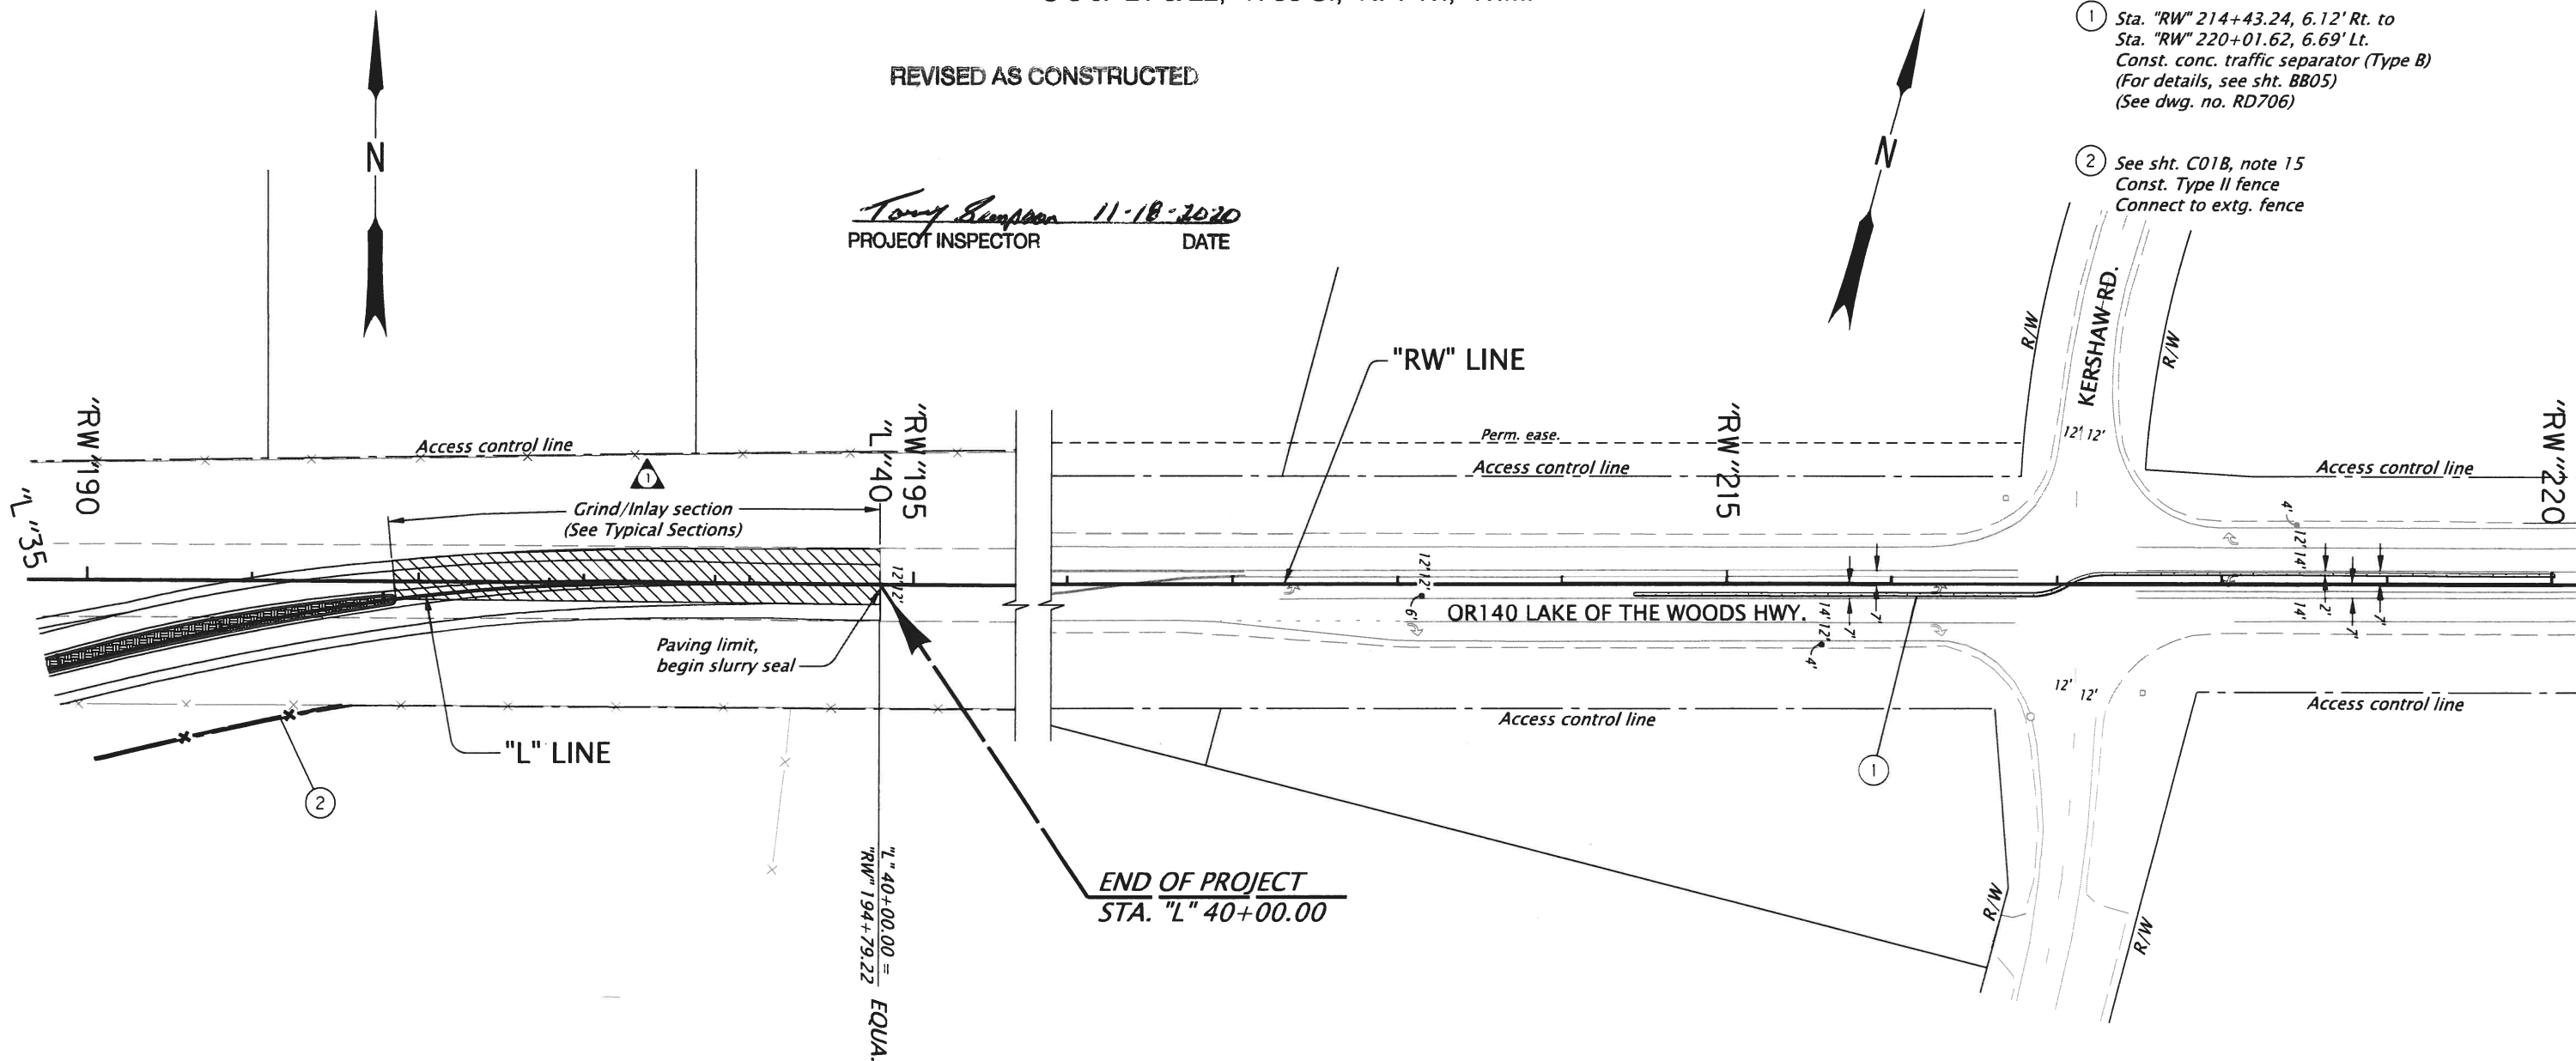

END OF PROJECT  
STA. "L" 40+00.00

END OF CONTRACT PROJECT  
STA. "RW" 232+59

Grind/Inlay section

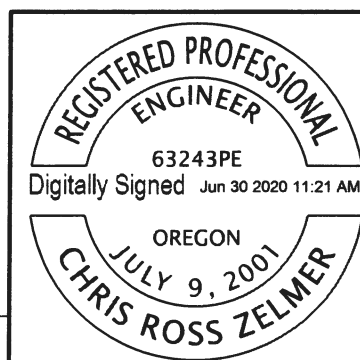

OREGON DEPARTMENT OF TRANSPORTATION

OR140: ATLANTIC AVE. INTERSECTION IMPROVEMENTS PROJECT  
LAKE OF THE WOODS HIGHWAY  
JACKSON COUNTY

Designer: Brian Sheadel Reviewer: Chris Zelmer  
Drafter: Judy Hardin Checker: Rich Coffel

GENERAL CONSTRUCTION SHEET NO. C02A

No.	DATE	REVISIONS	BY
①	05-26-20	Added Grind/Inlay section	C.Z.

RENEWS: 06-30-2020

FINAL ELECTRONIC DOCUMENT AVAILABLE UPON REQUEST


Rotation: 0° Scale: 1"=100'

Sec. 21 & 22, T. 36 S., R. 1 W., W.M.

REVISED AS CONSTRUCTED



*Tony Simpson* 11-18-2020  
PROJECT INSPECTOR DATE

- ① See sht. C01D, note 16
- Const. inlet
- Inst. storm sew. pipe
- Const. sloped end
- Inst. culvert ID marker

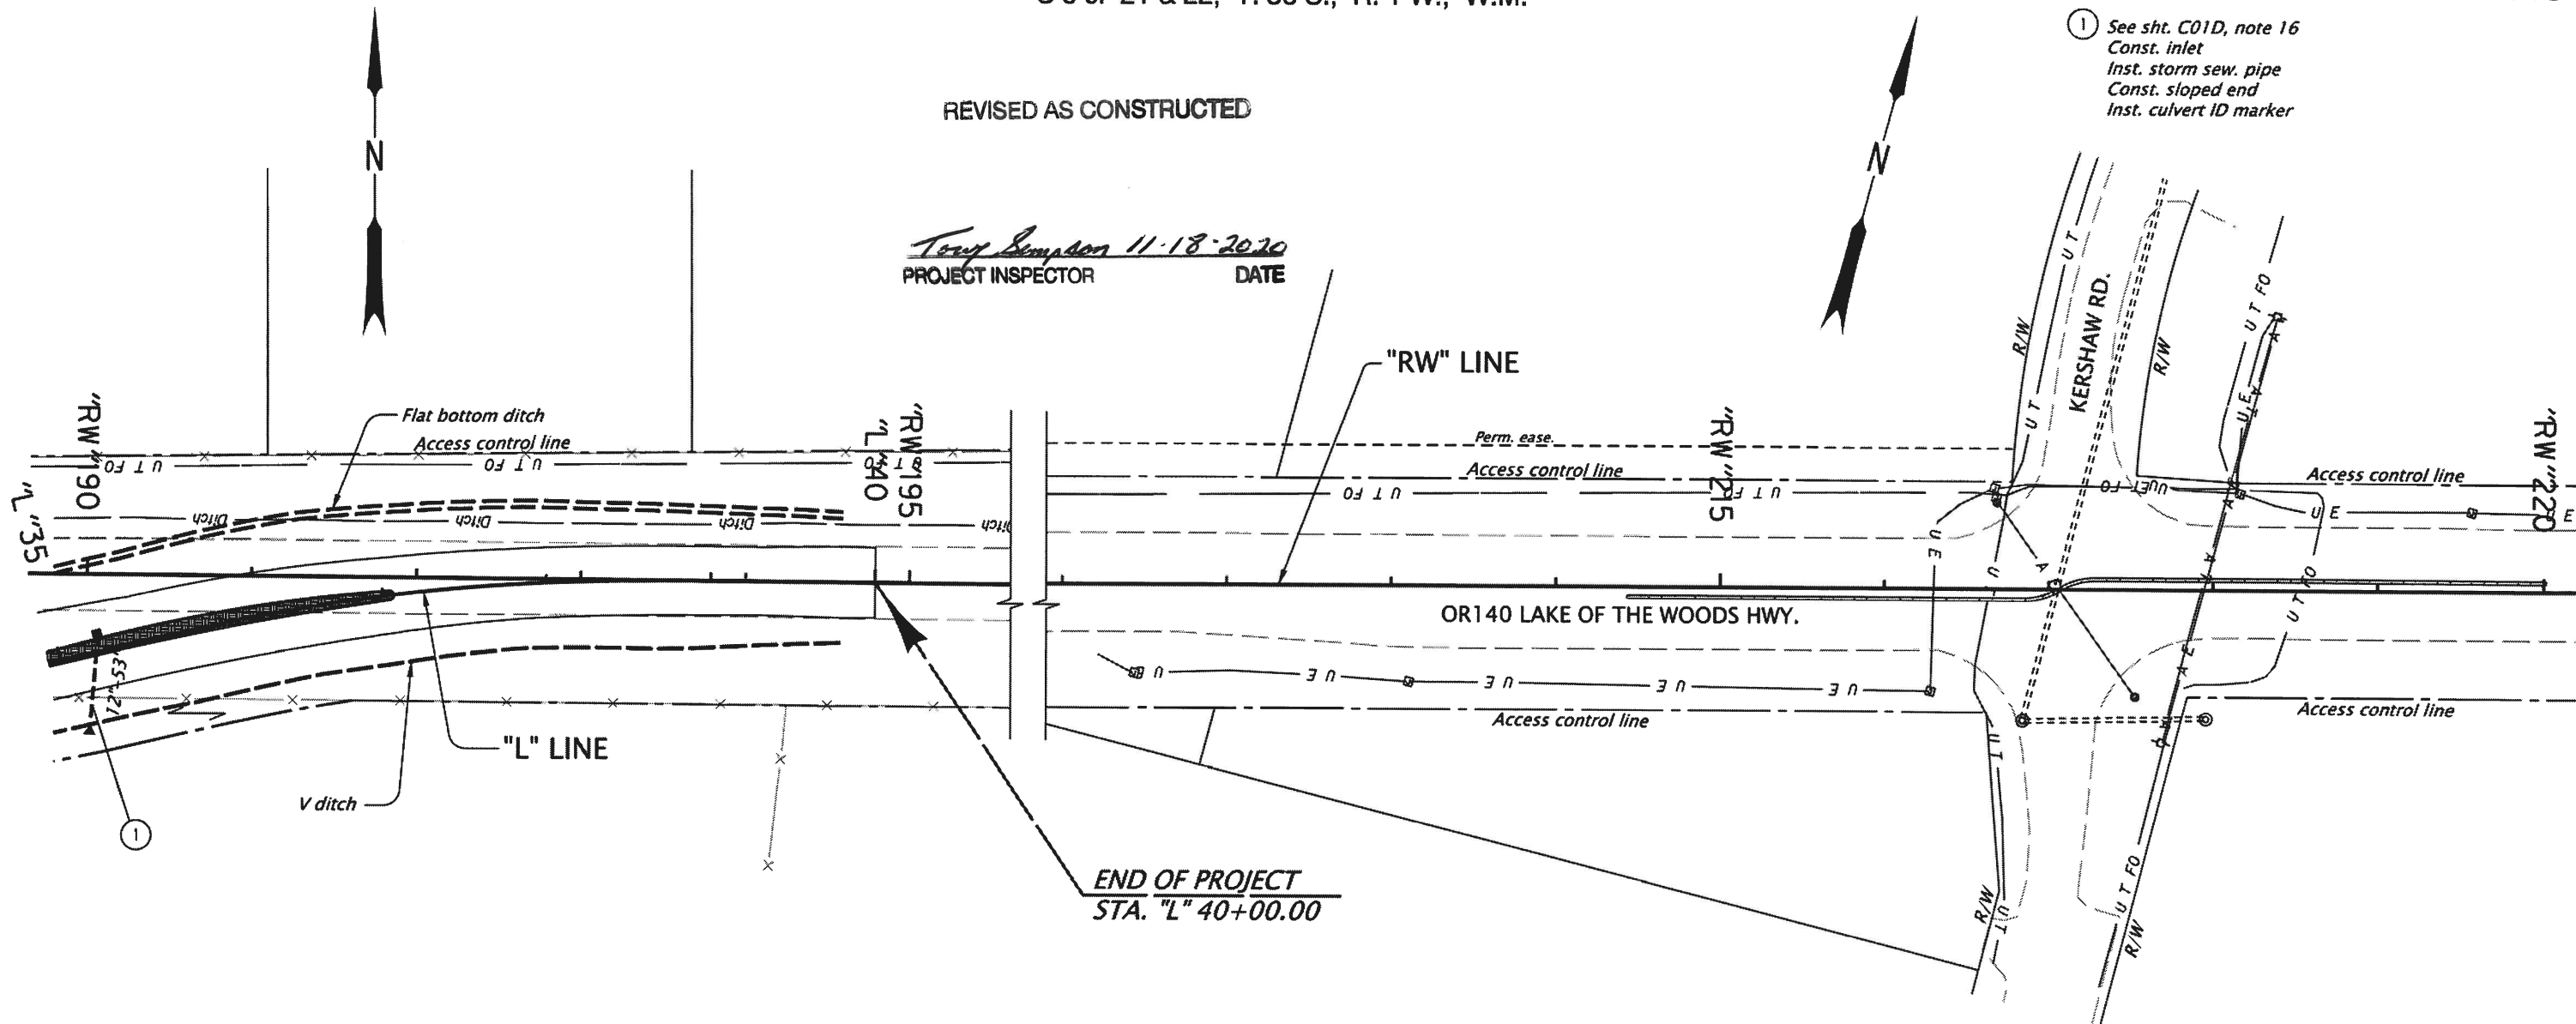


END OF PROJECT  
STA. "L" 40+00.00

END OF CONTRACT PROJECT  
STA. "RW" 232+59

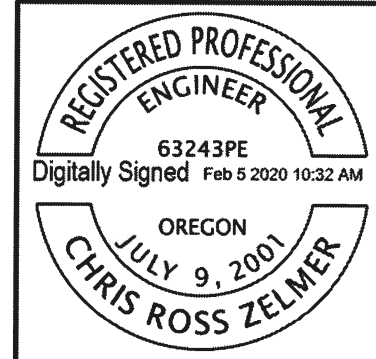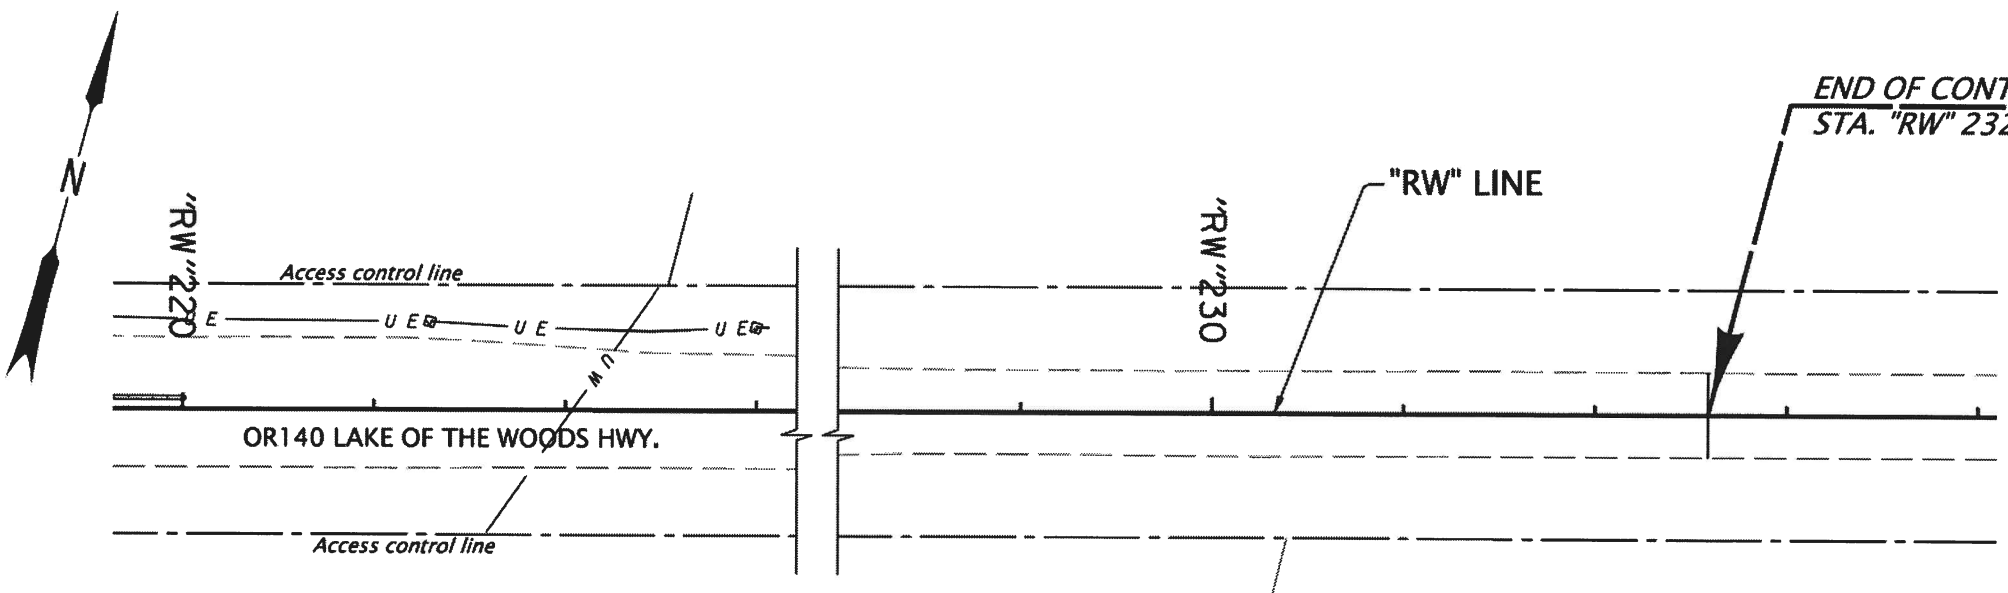


RENEWS: 06-30-2020

FINAL ELECTRONIC DOCUMENT  
AVAILABLE UPON REQUEST

 OREGON DEPARTMENT OF TRANSPORTATION	
OR140: ATLANTIC AVE. INTERSECTION IMPROVEMENTS PROJECT LAKE OF THE WOODS HIGHWAY JACKSON COUNTY	
Designer: Brian Sheadel Drafter: Judy Hardin	Reviewer: Chris Zelmer Checker: Rich Coffel
DRAINAGE & UTILITIES	
SHEET NO. C02B	

"L" LINE

53V-013

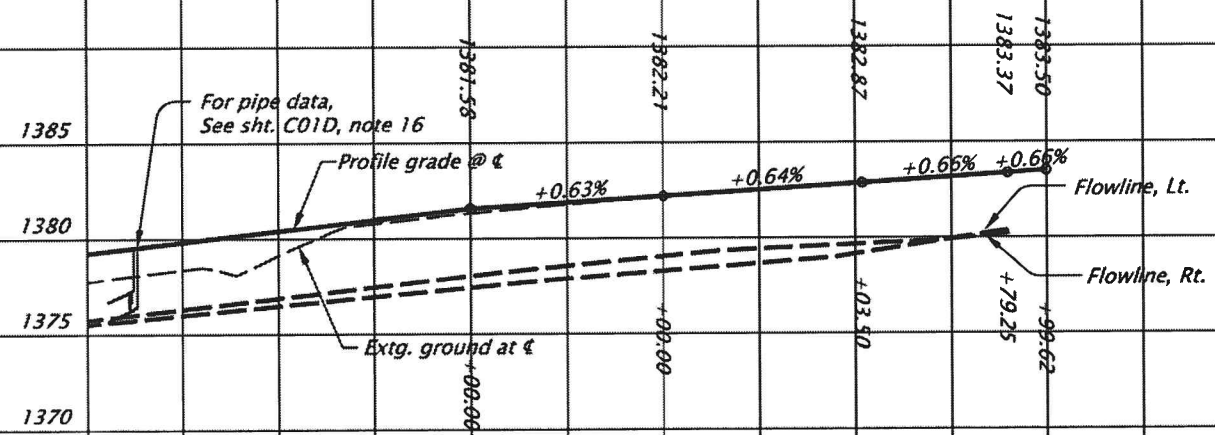

REVISED AS CONSTRUCTED


*Tony Simpson* 11-18-2020  
PROJECT INSPECTOR DATE

Exc. (For quantities, see sht. C01E)

Emb. (For quantities, see sht. C01E)

35+00

40+00

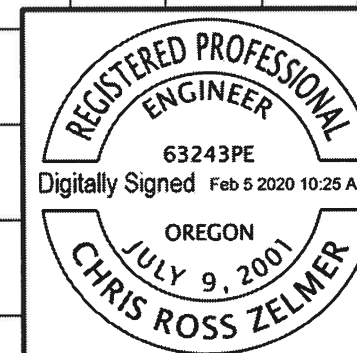

RENEWS: 06-30-2020

FINAL ELECTRONIC DOCUMENT  
AVAILABLE UPON REQUEST

OREGON DEPARTMENT OF TRANSPORTATION



OR140: ATLANTIC AVE.  
INTERSECTION IMPROVEMENTS PROJECT  
LAKE OF THE WOODS HIGHWAY  
JACKSON COUNTY

Designer: Brian Sheadel  
Drafter: Judy Hardin





Reviewer: Chris Zelmer  
Checker: Rich Coffel

PROFILE

SHEET NO.  
C02C



WATER QUALITY SWALE DETAILS

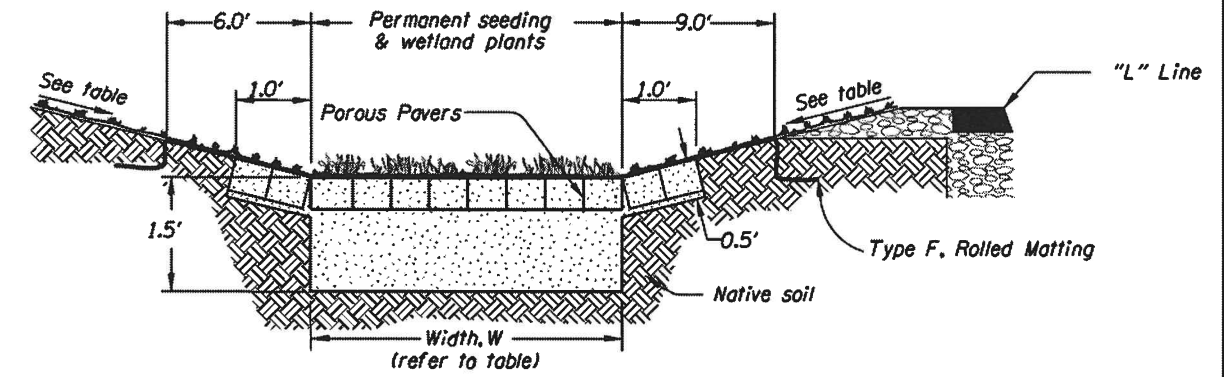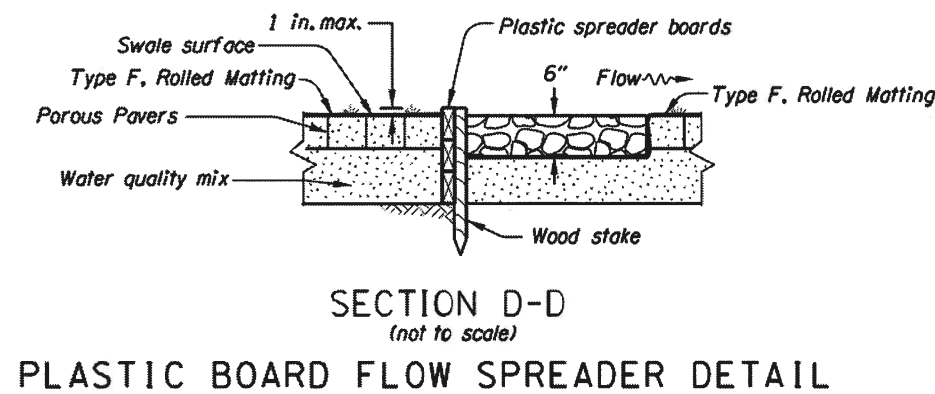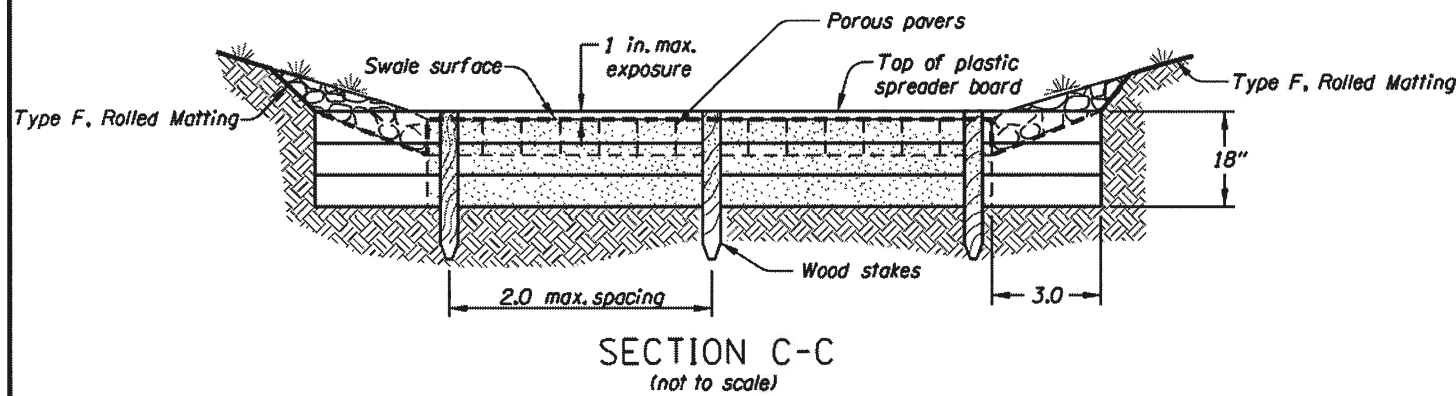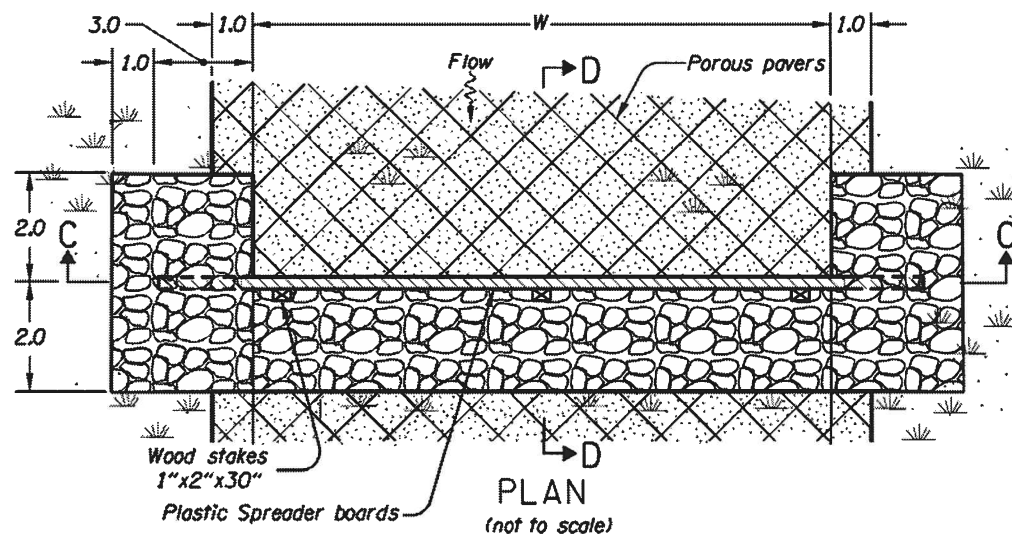


REVISED AS CONSTRUCTED

Tony Bumpala 11-18-2020  
PROJECT INSPECTOR DATE

BIOFILTRATION SWALE DATA							
Facility Name	Plan Sheet & Note *	STA. To STA.	W (ft.)	Longitudinal Slope (ft./ft.)	Side Slope Left (V:H)	Side Slope Right (V:H)	DFI
Water Quality Swale	C01D	"L" STA 20+16.0 TO "L" STA 21+21.0	10	.005	1:4	1:6	D01239

WETLAND PLANT PLUGS				
Scientific Name	Common Name	Type	Spacing	Quantity (Swale A)
<i>Carex Densa</i>	Dense Sedge	Plugs	1 per 2 sq. ft.	525
<i>Eleocharis Palustris</i>	Common Spikerush	Plugs	1 per 2 sq. ft.	525
<i>Juncus Tenuis</i>	Poverty Rush	Plugs	1 per 2 sq. ft.	525
<i>Mimulus Guttatus</i>	Seep Monkeyflower	Plugs	1 per 2 sq. ft.	525

- NOTES:
1. Construct spreader boards level.
  2. Extend spreader boards a minimum of 3 feet into side slopes.
  3. Reinforce side slopes at flow spreader locally with 1 1/2"-3/4" granular drain backfill material..
  4. Fasten wood stakes to spreader boards with 2 1/2" galvanized wood screws every 2" (minimum).
  5. Place plastic board flow spreader at beginning and end of swale and every 50 feet throughout length of biofiltration swale.
  6. Install matting according to RD1055 channel application. Omit check slots.
  7. Install Type S2 markers at beginning and end of biofiltration swale. See sheet HA02 for details.

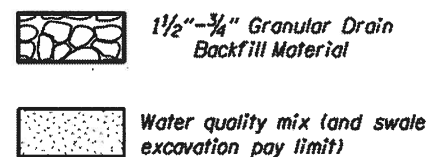

Note: All dimensions are in feet unless otherwise noted.

REGISTERED PROFESSIONAL ENGINEER  
60211PE  
Digitally Signed Dec 9 2019 3:39 PM  
OREGON  
JAN. 04, 2010  
RICHARD C. CARSON  
RENEWS: 12-31-2019

OREGON DEPARTMENT OF TRANSPORTATION


OR 140: ATLANTIC AVE. INTERSECTION IMPROVEMENTS PROJECT

LAKE OF THE WOODS HIGHWAY JACKSON COUNTY


Designer: Richard Carson Reviewer: DeLanie Cutsforth  
Drafter: Richard Carson Checker: DeLanie Cutsforth

STORMWATER DETAIL SHEET NO. HA01

STORMWATER DRAINAGE FACILITY IDENTIFICATION

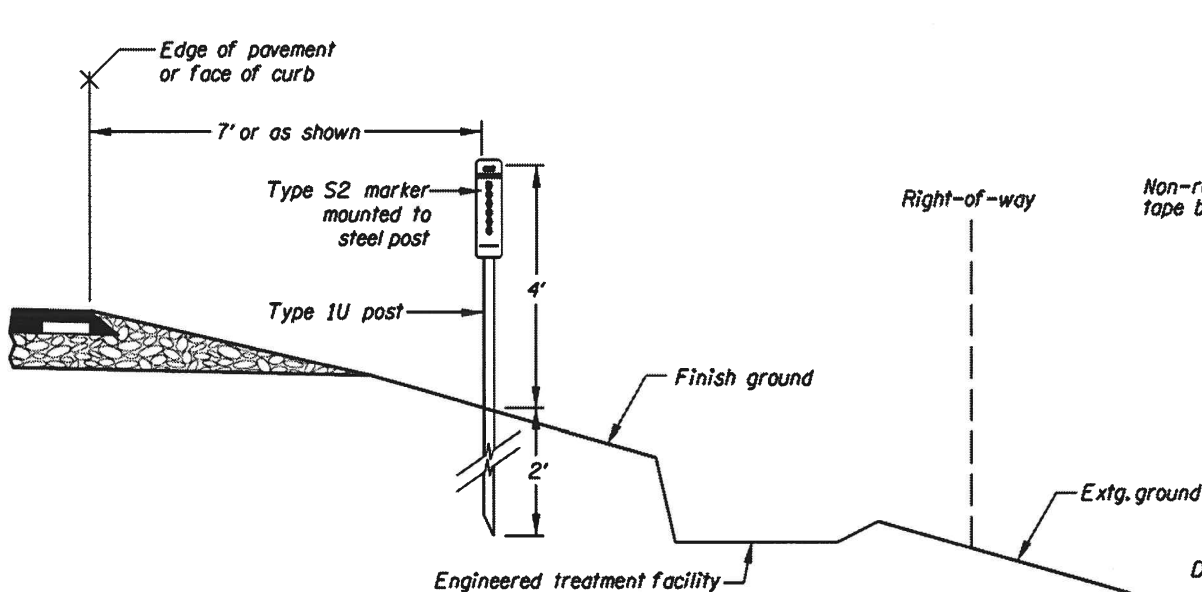

SECTION A-A

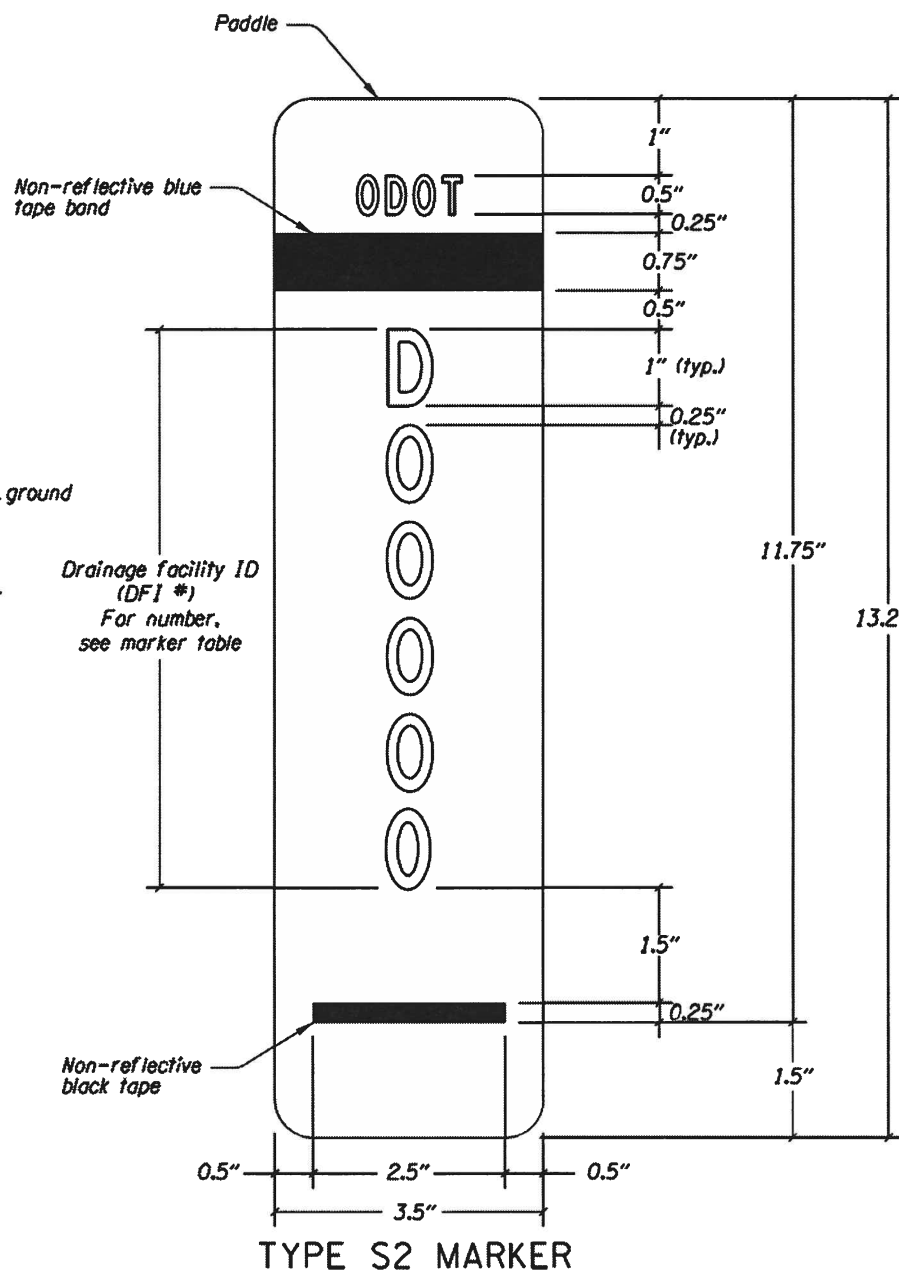


TYPE S2 MARKER

MARKER TABLE

FACILITY LOCATION	DFI #	TYPE S2 MARKER	
		START	END
Sta. "L" 20+16.0	D01239		✓
Sta. "L" 21+21.0	D01239	✓	

REVISED AS CONSTRUCTED

*Tom Simpson* 11-18-2020  
PROJECT INSPECTOR DATE

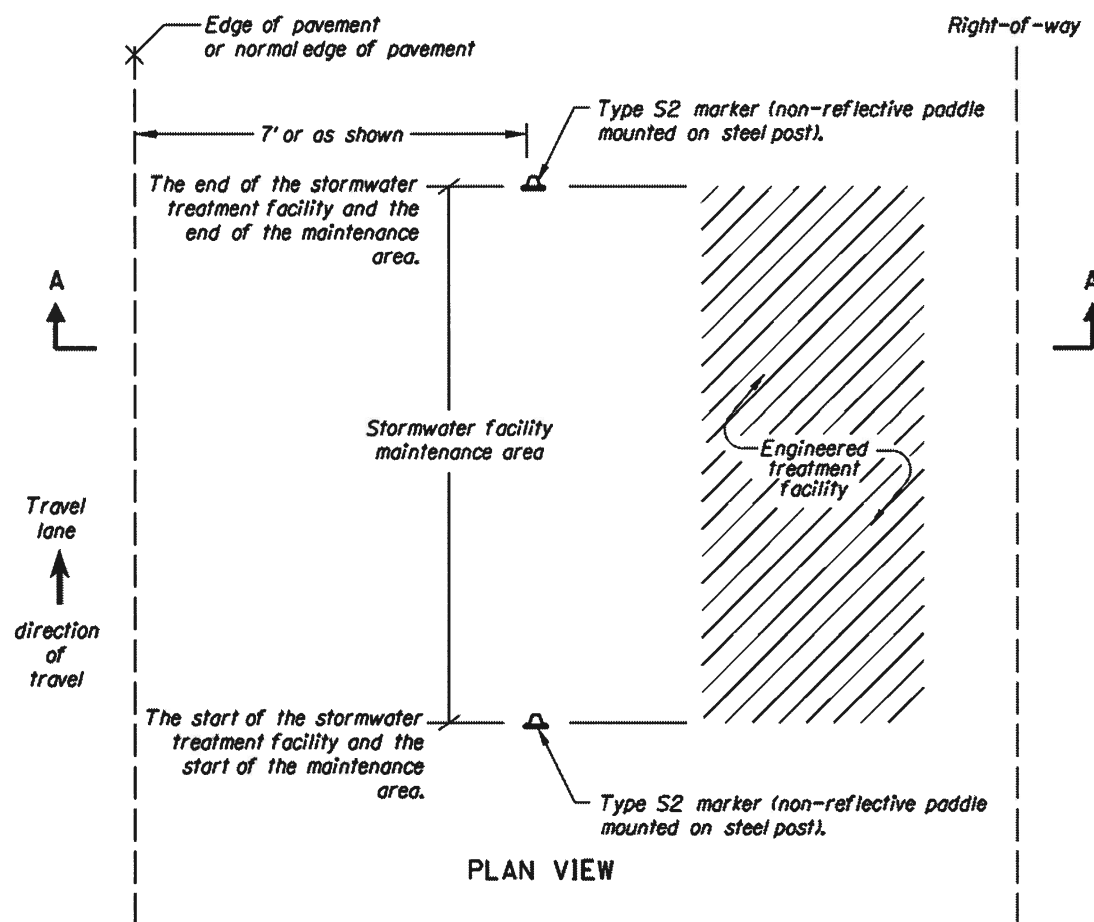

PLAN VIEW

INSTALLATION DETAIL



OREGON DEPARTMENT OF TRANSPORTATION



OR 140: ATLANTIC AVE. INTERSECTION IMPROVEMENTS PROJECT

LAKE OF THE WOODS HIGHWAY JACKSON COUNTY

Designer: Richard Carson Reviewer: DeLanie Cutsforth  
Drafter: Richard Carson Checker: DeLanie Cutsforth

STORMWATER DETAIL

SHEET NO. HA02

RENEWS: 12-31-2019