


SHEET PREPARED BY:

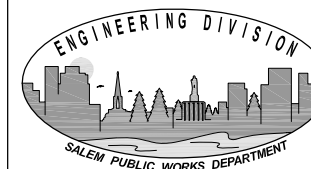

DKS Associates
TRANSPORTATION SOLUTIONS

117 Commercial St., NE, Suite 310 Telephone: (503) 391-8773
Salem, Oregon 97301 Fax: (503) 391-8701

SEALED
ORIGINALS SEALED BY:
SCOTT M. MANSUR
REG #: 56,267
DATE SIGNED:
CERTIFICATE EXP: 12-31-2010

**CENTER ST BRIDGE
TO
FRONT STREET
RAMP SIGNAL**

REVISIONS			
NO.	DESCRIPTION	DATE	BY

PROJECT NO: 705508
DATUM:
SURVEY:
HORIZ SCALE:
VERT SCALE:
DESIGN: ANM / SMM
DRAWN: DKS CAD
CHECKED:


APPROVED:

SHEET TITLE

TRAFFIC
SIGNAL
PLAN

TS-02

SHEET: 3 OF 12

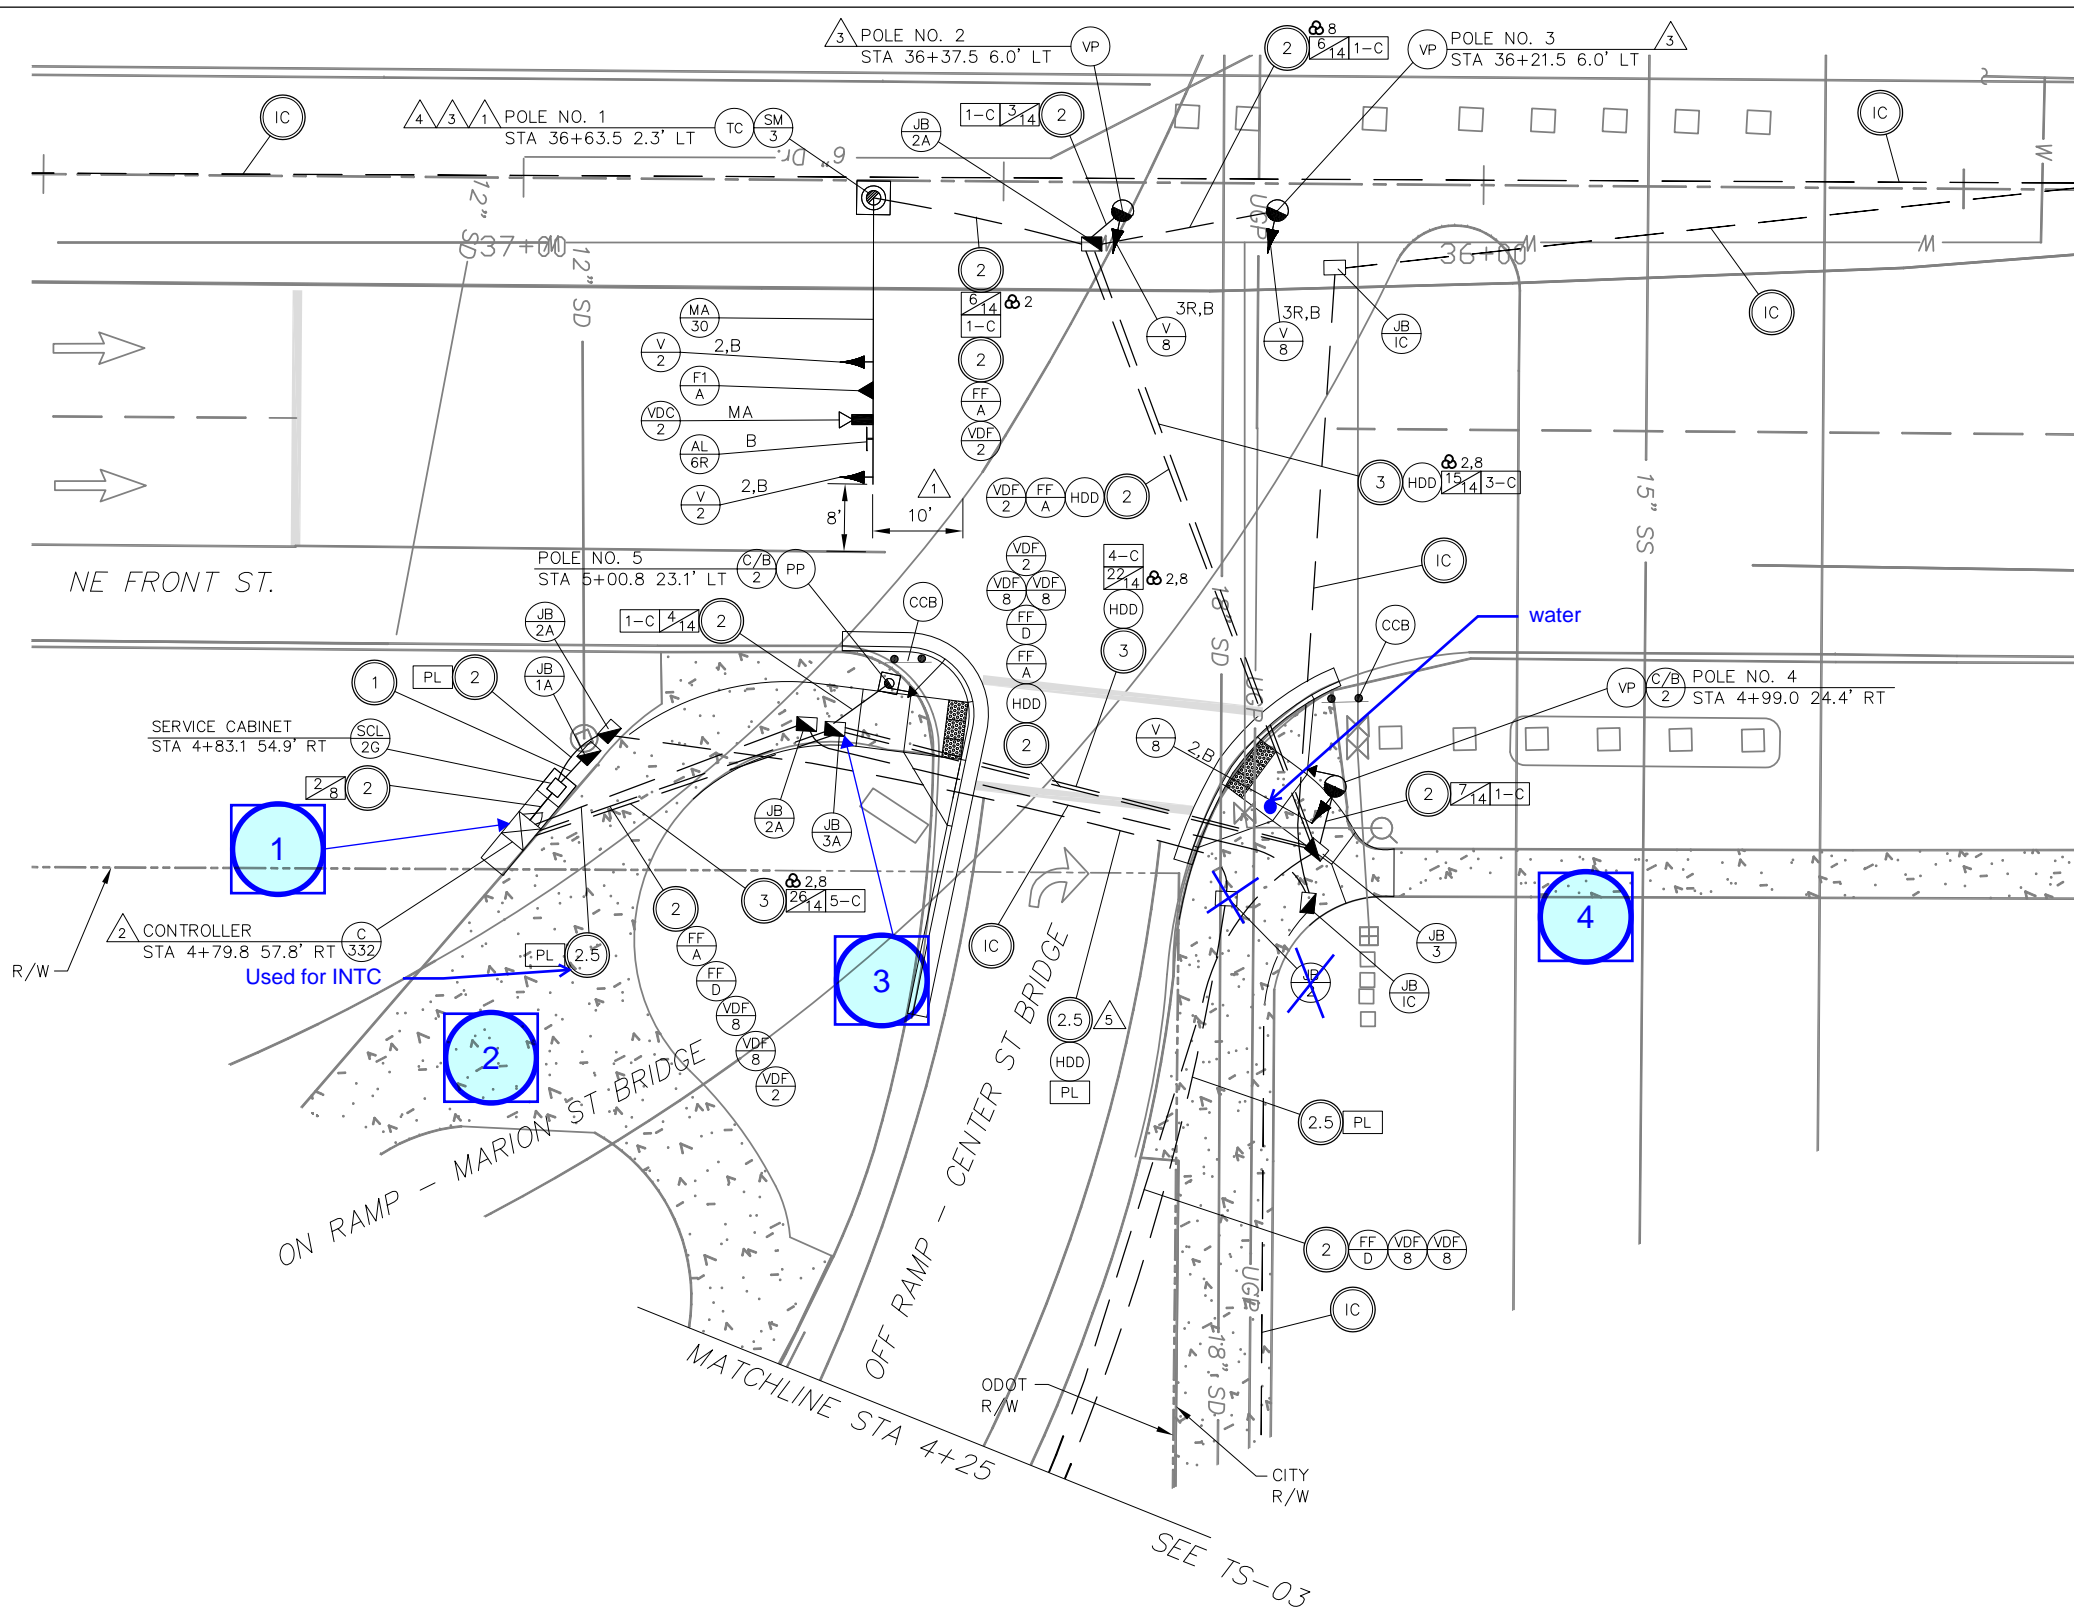

705508


CONSTRUCTION NOTES:

- 1 CONTRACTOR TO CONFIRM FINAL POLE LOCATION WITH ENGINEER PRIOR TO INSTALLATION. CONFIRM CLEARANCE BETWEEN END OF TRAFFIC SIGNAL MAST ARM AND MARION STREET RAMP STRUCTURE.
- 2 CONTRACTOR TO PROVIDE TWO PRE-EMPTION DISCRIMINATOR MODULES (ONE FOR CHANNEL'S A AND C AND ONE FOR B AND D).
- 3 CONTRACTOR TO POTHOLE EXISTING UTILITIES WITHIN 6' OF PROPOSED SIGNAL FOUNDATION. COORDINATE WITH ENGINEER PRIOR TO FOUNDATION EXCAVATION.
- 4 CONTRACTOR TO TRIM EXISTING TREE AS DIRECTED BY ENGINEER.

AS - BUILT


THIS AS-BUILT DRAWING WAS PREPARED UNDER MY SUPERVISION FROM DATA COLLECTED UNDER MY SUPERVISION AND REPRESENTS TO MY KNOWLEDGE, THE BEST INFORMATION REGARDING MATERIALS AND DIMENSIONS IN THE AS-BUILT PROJECT. THE CITY OF SALEM DOES NOT GUARANTEE THE ACCURACY OF THIS AS-BUILT DRAWING.

PROJECT MANAGER: RICHARD BARNES P.E. DATE: _____
PROJECT INSPECTOR: JIM KRAWCZYK DATE: _____

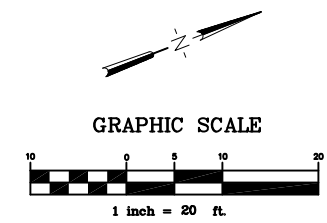

ODOT: M.P. 4.93 F.C. 072

Traffic Section Approval

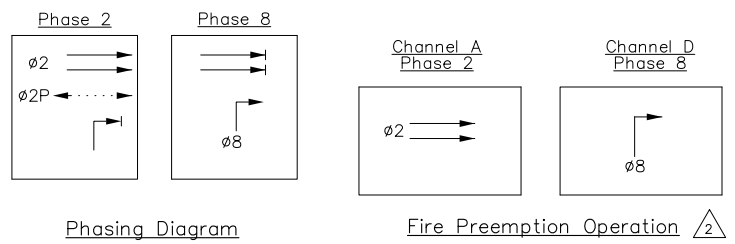

SHEET PREPARED BY:



AS-BUILT

"THIS AS-CONSTRUCTED DRAWING WAS PREPARED UNDER MY SUPERVISION FROM DATA COLLECTED UNDER MY SUPERVISION AND REPRESENTS, TO MY KNOWLEDGE, THE BEST INFORMATION REGARDING MATERIALS AND DIMENSIONS INCLUDED IN THE AS-CONSTRUCTED PROJECT. THE CITY OF SALEM DOES NOT GUARANTEE THE ACCURACY OF THIS AS-CONSTRUCTED DRAWING."

Richard L. Barnes PE
Date:

SEALED

ORIGINALS SEALED BY:
HOWARD D. RONEY
REG#: 10714
DATE SIGNED: 05/18/2011
CERTIFICATE EXPIRED: 12/31/2012

TRAFFIC COMMUNICATIONS SIGNAL INTERCONNECT

REVISIONS			
NO.	DESCRIPTION	DATE	BY
1	AS-BUILT	8/7/12	DTN

PN: 709524

DATUM: SPCS / NGVD 29(47)
SURVEY: COS
HORIZ SCALE: AS SHOWN
VERT SCALE: AS SHOWN
DESIGN: HDR
DRAWN: JAK
CHECKED:

APPROVED:


SHEET TITLE

**SCHEDULE 'B'
INTERSECTION ENLARGEMENT**

FRONT ST/CENTER ST OFF RAMP

SG-224


NOTE:
SEE LEGEND SHEETS
SG-100 AND SG-101

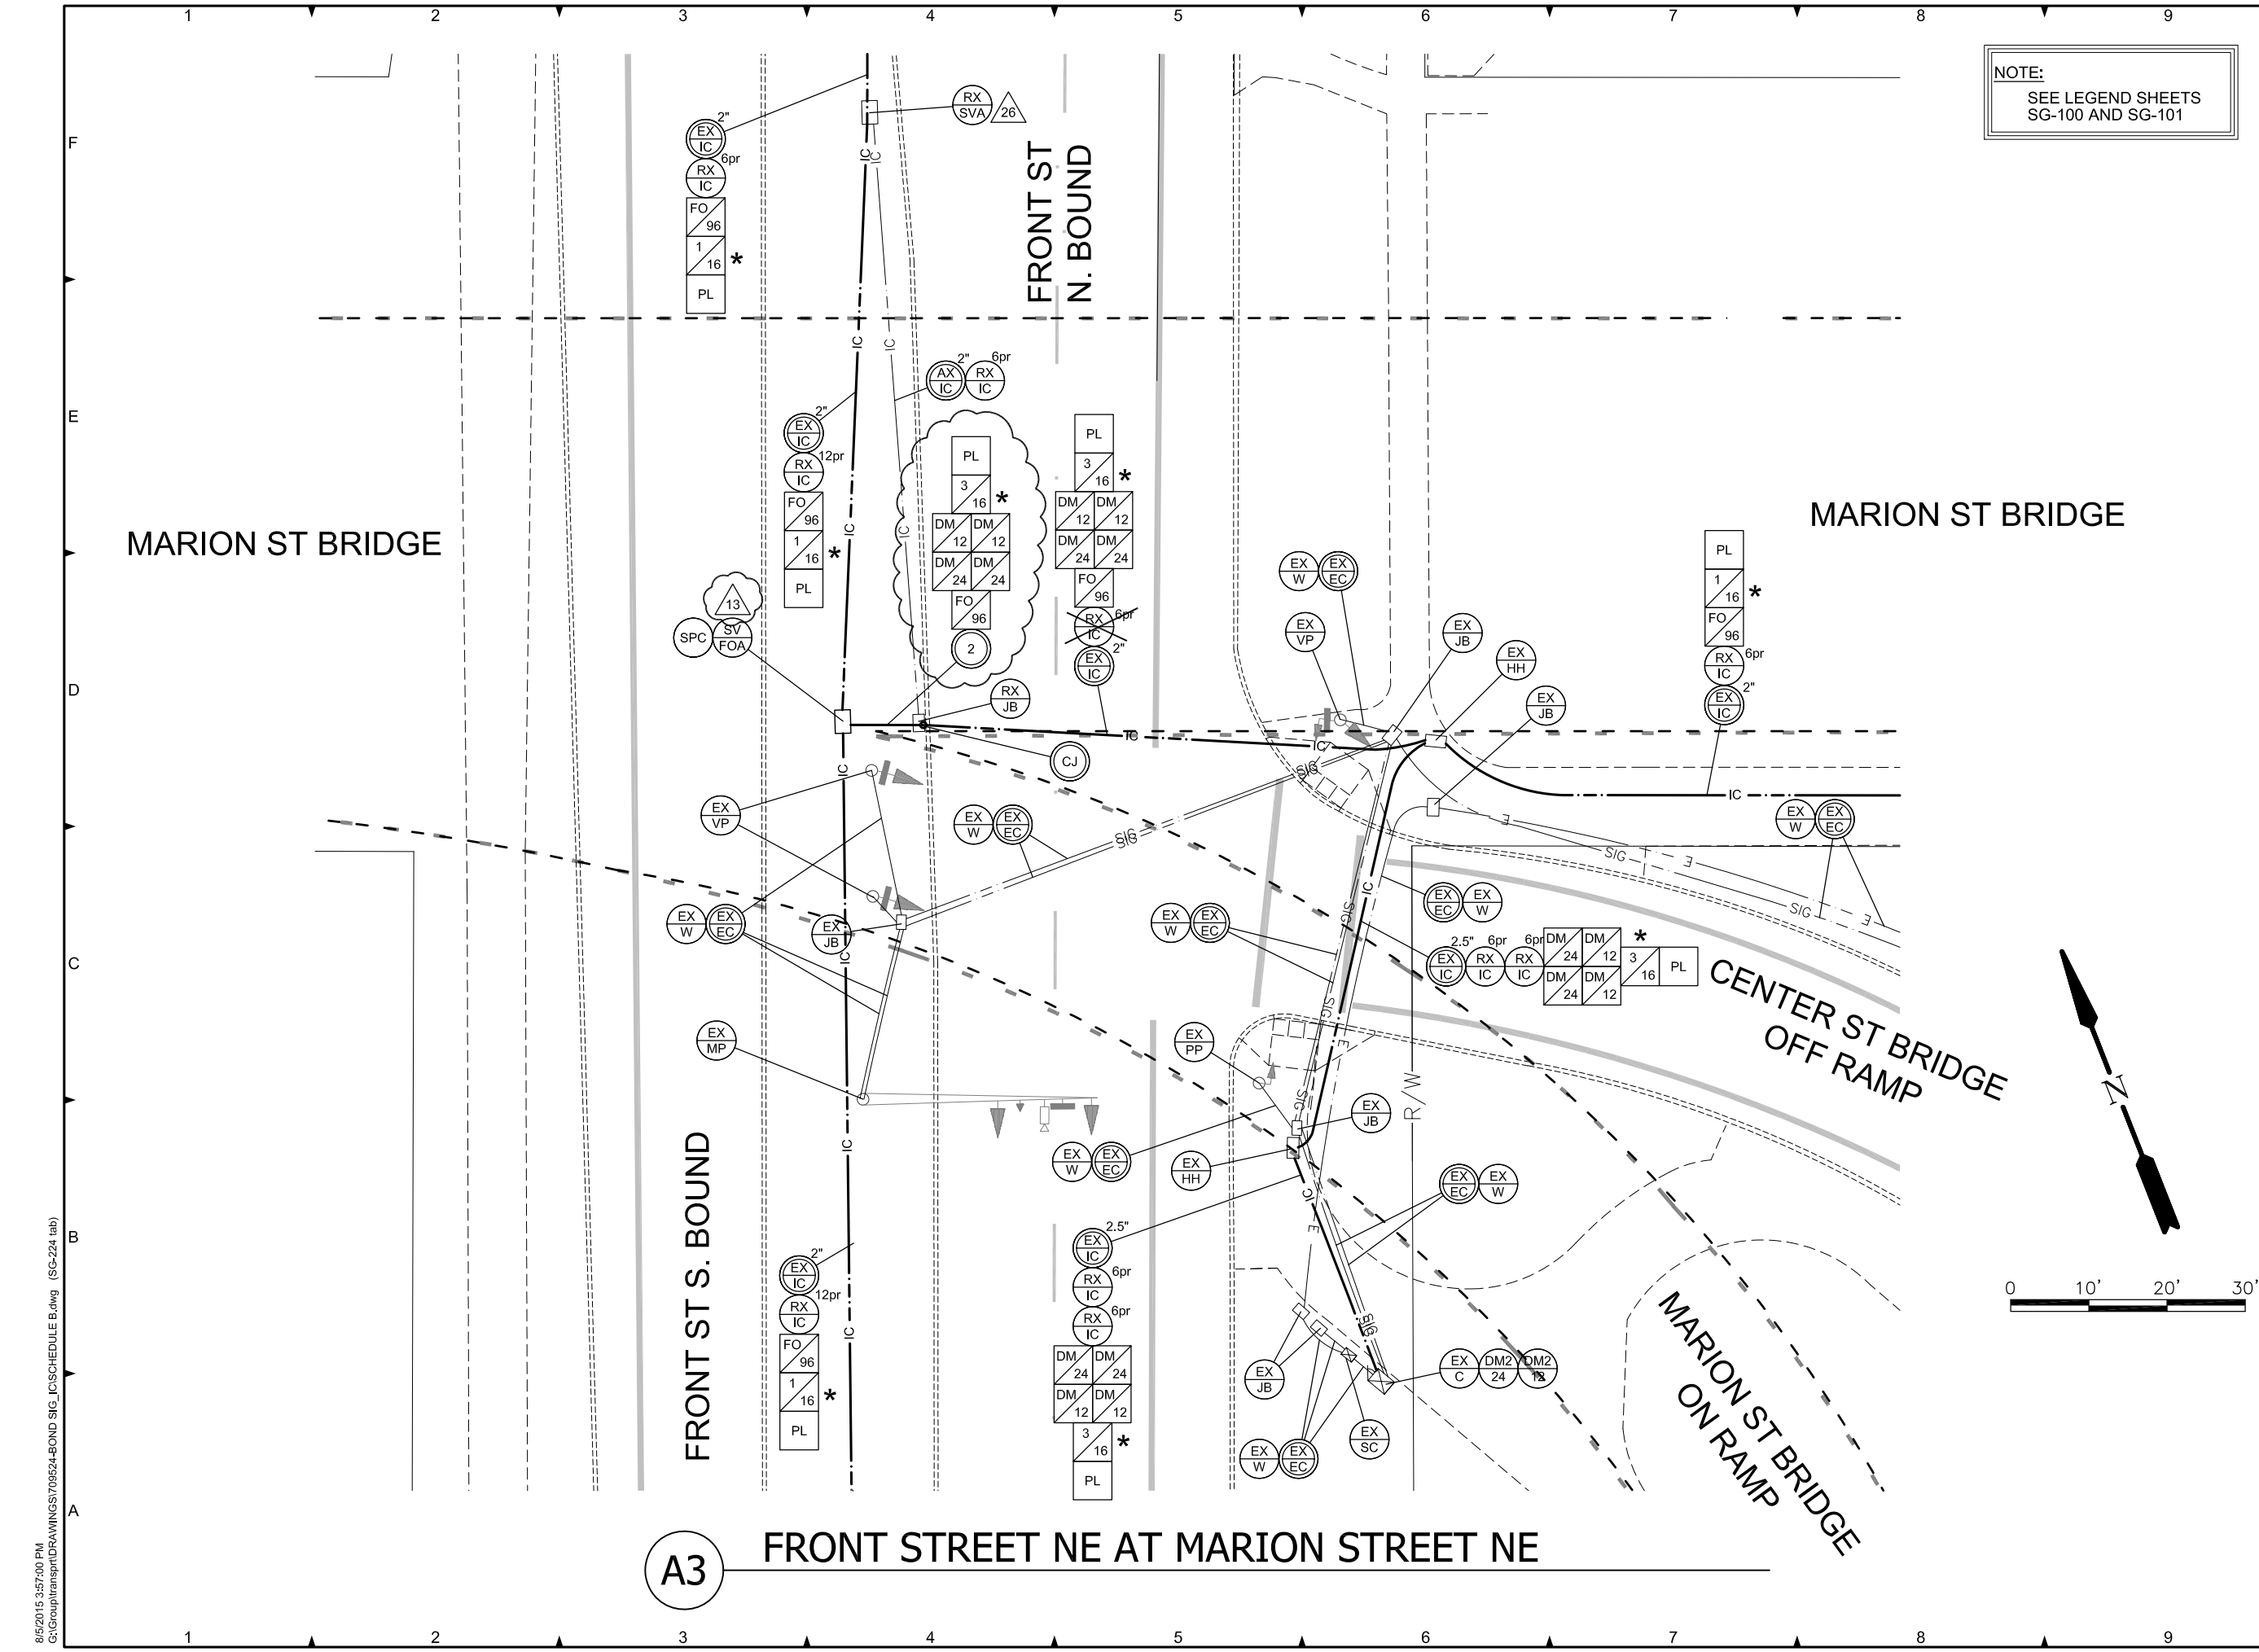

A3 FRONT STREET NE AT MARION STREET NE

8/5/2015 3:57:00 PM C:\Group\transprt\DRAWINGS\709524-BOND SIG_IC\SCHEDULE B.dwg (SG-224 tab)

SHEET PREPARED BY:

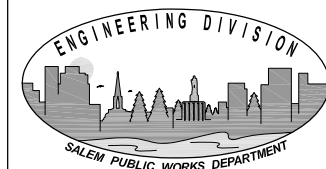

DKS Associates
TRANSPORTATION SOLUTIONS

117 Commercial St., NE, Suite 310 Telephone: (503) 391-8773
Salem, Oregon 97301 Fax: (503) 391-8701

SEALED
ORIGINALS SEALED BY:
SCOTT M. MANSUR
REG #: 56,267
DATE SIGNED:
CERTIFICATE EXP: 12-31-2010

**CENTER ST BRIDGE
TO
FRONT STREET
RAMP SIGNAL**

REVISIONS			
NO.	DESCRIPTION	DATE	BY


PROJECT NO: 705508
DATUM:
SURVEY:
HORIZ SCALE:
VERT SCALE:
DESIGN: ANM / SMM
DRAWN: DKS CAD
CHECKED:

APPROVED:

SHEET TITLE

**TRAFFIC
INTERCONNECT
PLAN**

TS-06
SHEET: 7 OF 12

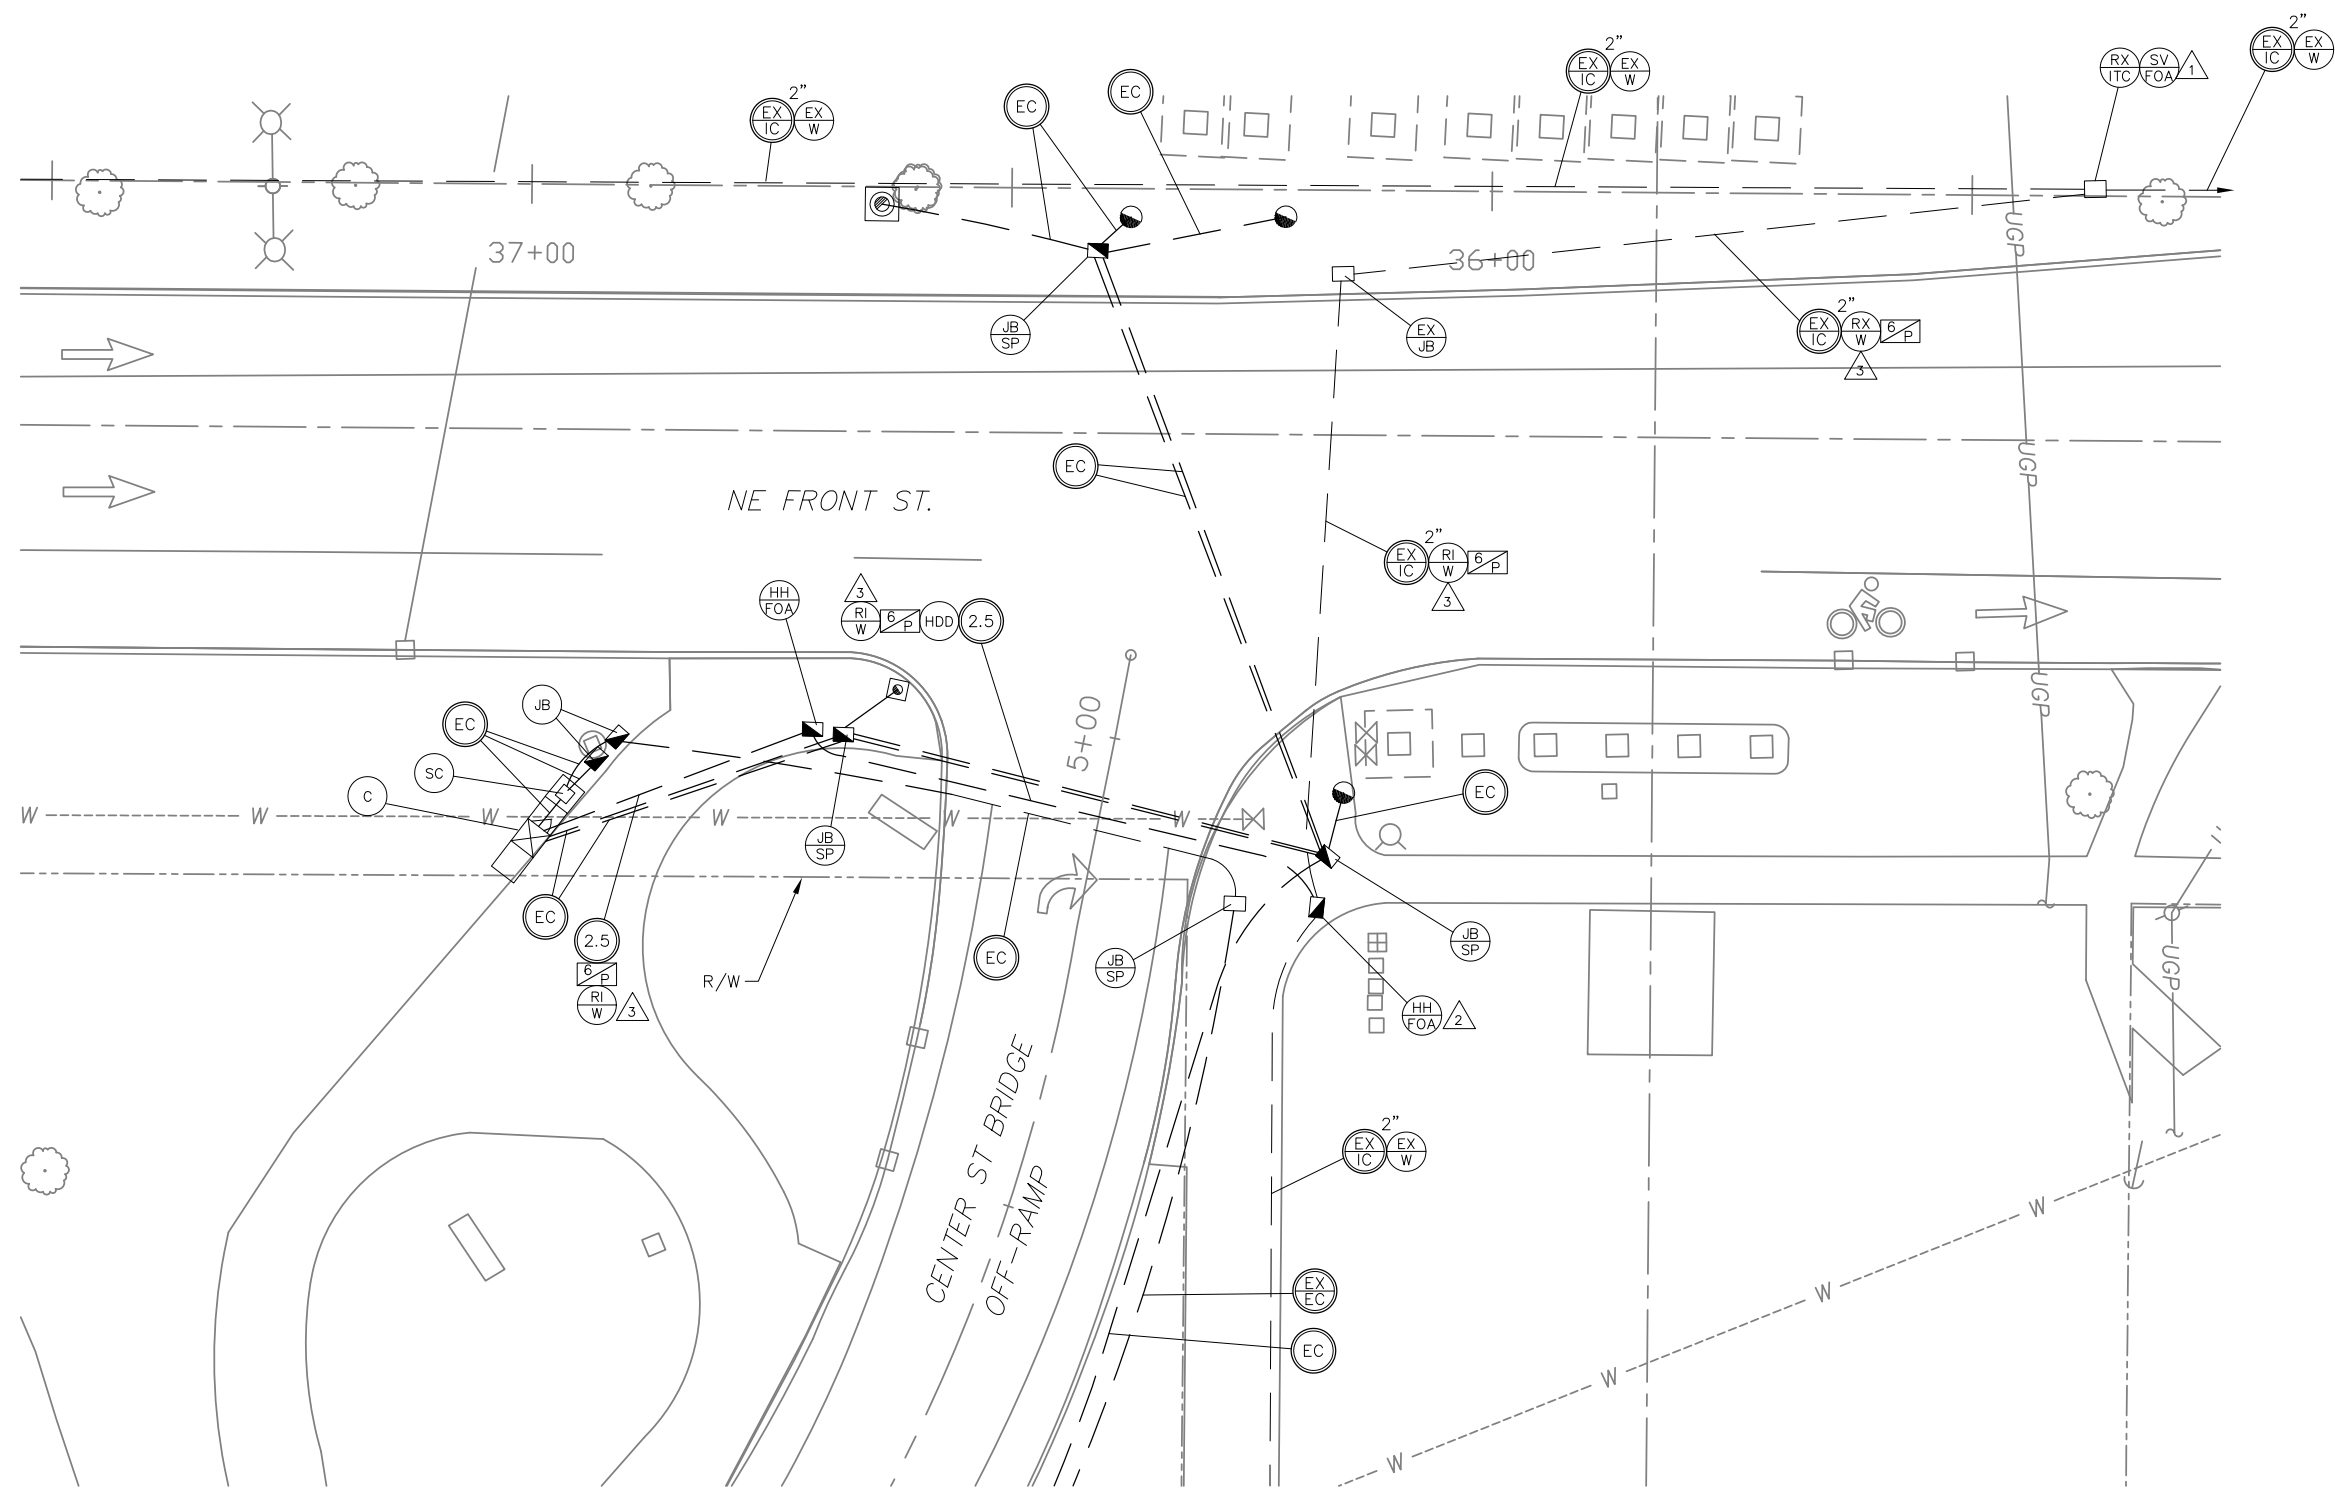

705508


- CONSTRUCTION NOTES:**
- 1. CONTRACTOR TO REMOVE EXISTING INTERCONNECT TERMINAL CABINET, MAINTAINING EXISTING INTERCONNECT, INSTALL COPPER SPLICE CLOSURE, RE-SPLICE INTERCONNECT CABLES AND PLACE IN NEW FIBER OPTIC SPLICE VAULT.
 - 2. CONTRACTOR TO INSTALL FIBER OPTIC HANDHOLE ON TOP OF EXISTING INTERCONNECT CONDUITS AS SHOWN. EXTEND EXISTING CONDUITS AND WIRING INTO HANDHOLE.
 - 3. CONTRACTOR TO PULL BACK EXISTING 6-PAIR INTERCONNECT CABLE AND REINSTALL INTO NEW TRAFFIC SIGNAL CONTROLLER AS SHOWN.

AS - BUILT

THIS AS-BUILT DRAWING WAS PREPARED UNDER MY SUPERVISION FROM DATA COLLECTED UNDER MY SUPERVISION AND REPRESENTS TO MY KNOWLEDGE, THE BEST INFORMATION REGARDING MATERIALS AND DIMENSIONS IN THE AS-BUILT PROJECT. THE CITY OF SALEM DOES NOT GUARANTEE THE ACCURACY OF THIS AS-BUILT DRAWING.

PROJECT MANAGER: _____ DATE: _____
RICHARD BARNES P.E.

PROJECT INSPECTOR: _____ DATE: _____
JIM KRAWCZYK

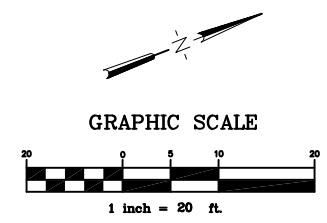

ODOT: M.P. 4.93 F.C. 072

Traffic Section Approval