# **OPERATION & MAINTENANCE MANUAL**

# **Water Quality Bioslope**

Manual prepared: February 2019

**DFI No. D01222** 



Figure 1: DFI No. D01222, looking southeast

#### 1. Identification

Drainage Facility ID (DFI): D01222

Facility Type: Water Quality Bioslope/Media Filter Drain

(MFD)

Construction Drawings: (V-File Numbers) 43V-086

Location: District: 2B

Highway No.: 047

Mile Post: 65.53 to 65.80, [Right side]

## 2. Manual Purpose

The purpose of this manual is to outline inspection needs and summarize maintenance actions.

## 3. Facility Location

The location map below details the facility location. The highway, mile posts, side streets, access location, and stormwater flow directions are noted on the map. **NOTE: Mile posts are based off of the V-File, and may vary from TransGIS mile posts.** 

Facility location type: Roadway shoulder

Flow direction: East



Figure 2: Facility Map Overview


## 4. Facility Summary

The width is measured perpendicular to the edge of pavement and is equivalent to the flow length. The length is measured parallel to the edge of pavement and is equivalent to the length of the contributing impervious area.

The length and width of the applicable facility components are:

Component	Length (feet)	Width (feet)
Bioslope	1551	8

The slope of the facility is presented by a vertical distance (rise) followed by the horizontal distance (run).

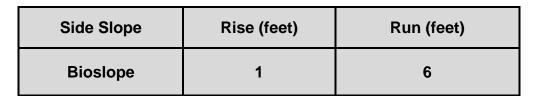

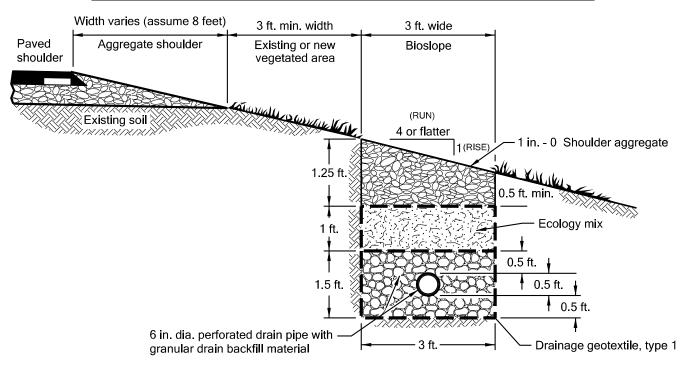


Figure 3: Bioslope Section (Typical)

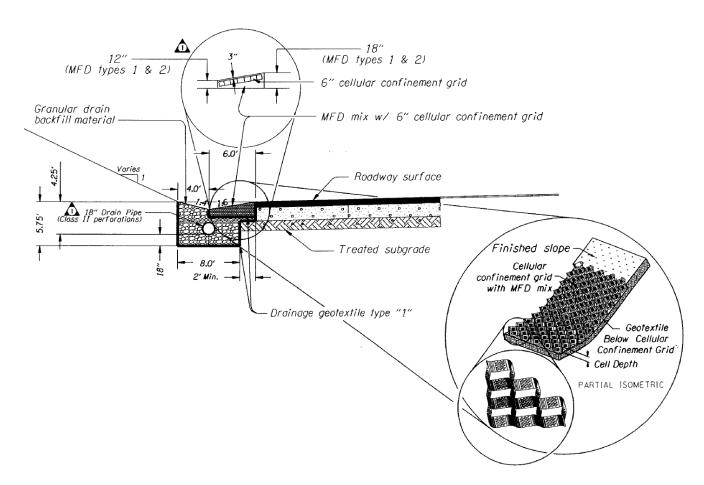


Figure 4: Bioslope Type 1 with ditch configuration (No vegetated area/zone)

**Site Specific:** This water quality facility has type 1 bioslope throughout. The water flows through the facility to the east and exits the facility by draining through a manhole and a storm drain pipe to the northeast. The water ultimately flows to Willow Creek.

The facility is a modified version of the typical bioslope (Figure 3). The main difference is the exclusion of a vegetation area between the edge of pavement and the bioslope section. This was developed as a result of right of way limitations, and in some locations, the prohibitive costs of moving adjacent high voltage line and frontage road.

## 5. Facility Access

Maintenance access to the facility:

☐Roadside pad	⊠Roadside shoulder	
☐Access road with Gate	☐Access road without Gate	



Figure 5: Maintenance access

## 6. Operational Components / Maintenance Items

#### Classification and Standard Operational (Op) Plan:

This facility is classified as a:

☐ Filter Strip (Op Plan A)

A filter strip consists of a vegetated or media slope located parallel to the edge of pavement. It maintains sheet flow of stormwater runoff over the width of the strip.

☑ Bioslope(Op Plan B)

A bioslope consists of a filter strip and treatment zone. It is a flow-through stormwater treatment facility located along roadside embankments.

A standard operational plan illustrates the general facility footprint configuration and explains the purpose of each facility component. Operational plans (A, B) are provided in the Standard Operation Manual.

See Appendix A for the site specific operational plan.

#### **Operational Components**

Filter strips and bioslopes have many components that assist with treatment, conveyance, and infiltration of stormwater runoff. The components in use can vary depending on the facility design. The facility components table (Table 1) has been provided to highlight the applicable components for this facility. The component is in use when the box contains an "x" (e.g.  $\boxtimes$ ).

The Standard Operation Manual for Water Quality Filter Strips and Bioslopes (implemented February 2019) outlines facility operation, typical footprint configuration, and component definitions and details. A link to the manual is attached to the feature marker in TransGIS.

https://gis.odot.state.or.us/TransGIS/

#### **Maintenance Items**

Operational components marked in Table 1 should be inspected and maintained according to Section 7. Each facility component is defined and detailed in the Standard Operation Manual using the associated ID number indicated below.

Table 1: Bioslope/Filter Strip Components		ID#
Facility Inlet		
Pavement Sheet Flow	$\boxtimes$	B1
Flow Spreader		B2
Ground Cover		
Vegetated Slope		B3
Aggregate Media Slope		B4
Underground Components		
Water Quality Mix		B5
Ecology Mix	×	В6
Granular Drain Backfill Material	$\boxtimes$	B7
Geotextile Fabric		B8
Cellular Confinement Grid	$\boxtimes$	B9
Structures		
Curb/Berm		B10
Check Dam		B11
Cleanout		B12
Facility Outlet		
Perforated Drain Pipe	$\boxtimes$	B13
Open Slope Outlet		B14
Open Channel Outlet		B15
Storm Drain Outlet Pipe	$\boxtimes$	B16
Outfall Type		
	□C	
Waterbody (Creek/Lake/Ocean)	□L	B17
	□o	
Outfall Channel		B18
Storm Drain System		B19
Outfall Components		
Pervious Berm		B20
Riprap Pad		B21

#### 7. Maintenance

### **Maintenance Frequency/Maintain Records**

- a. Inspect annually. Preferably prior to the rainy season.
- Clean and maintain as necessary. Refer to Activity 125 for conditions when maintenance is needed.
- c. Keep a record of inspections, maintenance, and repairs.

#### **Maintenance Guide/Maintenance Actions**

The ODOT Routine Road Maintenance Water Quality and Habitat Guide (the *Blue Book*) outlines the standard maintenance actions for water quality facilities under Activity 125.

There are standard maintenance tables for standard ODOT designs. The maintenance tables describe the maintenance component, the defect or problem, the condition when maintenance is needed, and the recommended maintenance to correct the problem. Use the following tables to maintain ODOT filter strips and bioslopes:

- Table 1 (General Maintenance): Contains general maintenance and inspection guidelines that are applicable to all ODOT water quality facilities
- Table 4 (Water Quality Filter Strips)
- Table 5 (Water Quality Bioslopes)

The ODOT Maintenance Guide can be viewed at the following website: http://www.oregon.gov/ODOT/HWY/OOM/pages/mguide.aspx

The *Blue Book* can be viewed at the following website: <a href="http://www.oregon.gov/ODOT/Maintenance/Documents/blue\_book.pdf">http://www.oregon.gov/ODOT/Maintenance/Documents/blue\_book.pdf</a>

#### 8. Limitations

Filter strips and bioslopes are NOT designed to allow the use of heavy equipment. Vehicles entering the facility can create depressions (tire ruts), damage vegetation, and damage structural components (e.g. flow spreaders). These conditions may result in poor treatment and drainage performance.

## 9. Waste Material Handling


Material removed from the facility is defined as waste by the Department of Environmental Quality (DEQ). Refer to the road waste section of the ODOT Maintenance Yard Environmental Management System (EMS) Policy and Procedures Manual for disposal options:

## http://www.oregon.gov/ODOT/HWY/OOM/pages/ems.aspx

Contact any of the following for more detailed information about management of waste materials found on site:

ODOT Clean Water Unit	(503) 986-3008
ODOT Statewide Hazmat Coordinator	(503) 667-7442
ODOT Region 1 Hazmat Coordinator	(503) 731-8290
ODOT Region 2 Hazmat Coordinator	(503) 986-2647
ODOT Region 3 Hazmat Coordinator	(541) 957-3594
ODOT Region 4 Hazmat Coordinator	(541) 388-6186
ODOT Region 5 Hazmat Coordinator	(541) 963-1590
ODEQ Northwest Region Office	(503) 229-5263

Α	Appendix A – Si	te Specific (	Operational	Plan	
Cor	ntents:				
Ope	rational Plan: DFI D01	222			
			A-1		

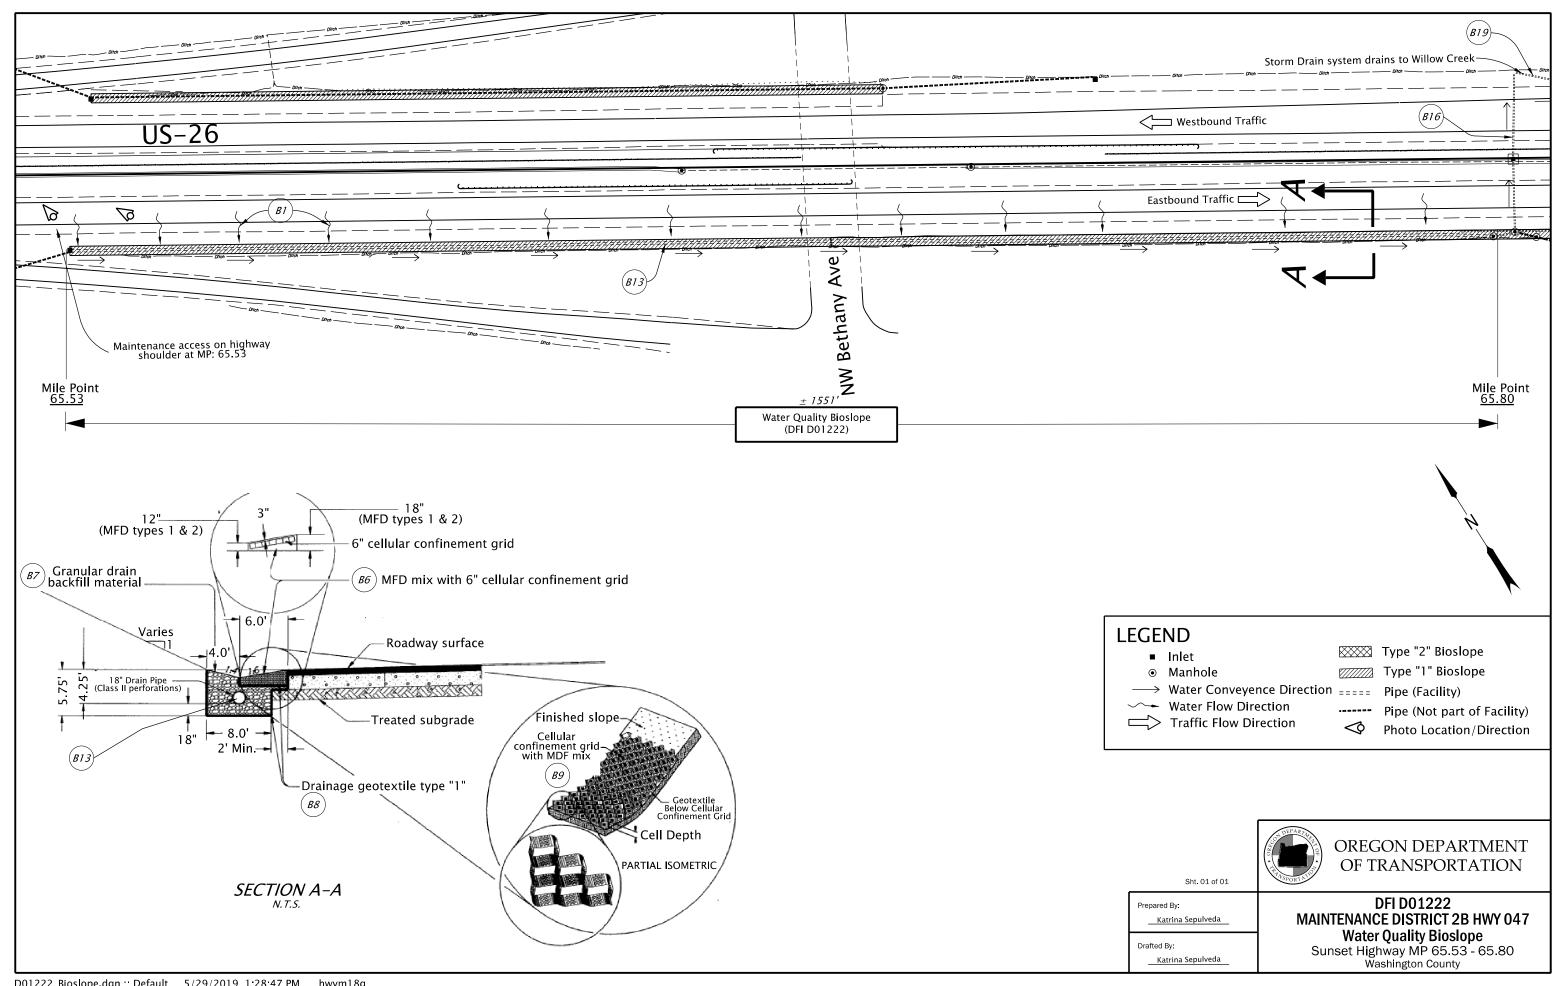

_		
В	Appendix B – Project Contract F	'lans
Con	itents:	
Site	Specific Subset of Project Contract Plan	43V-086
	B-	1

#### INDEX OF SHEETS SHEET NO. Title Sheet Index Of Sheets Cont'd. 1A-2 Std. Drg. Nos.

**HILLSBORO** 


STATE OF OREGON

## DEPARTMENT OF TRANSPORTATION

PLANS FOR PROPOSED PROJECT


GRADING, DRAINAGE, STRUCTURES, PAVING, SIGNING, ILLUMINATION, SIGNALS & ROADSIDE DEVELOPMENT


**US26: NW 185TH AVE - CORNELL ROAD SEC. SUNSET HIGHWAY WASHINGTON COUNTY APRIL 2010** 

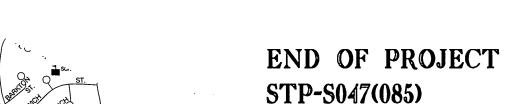

STA. "LW" 3042+00 (M.P.66.35)

BEGINNING OF PROJECT STP-S047(085)

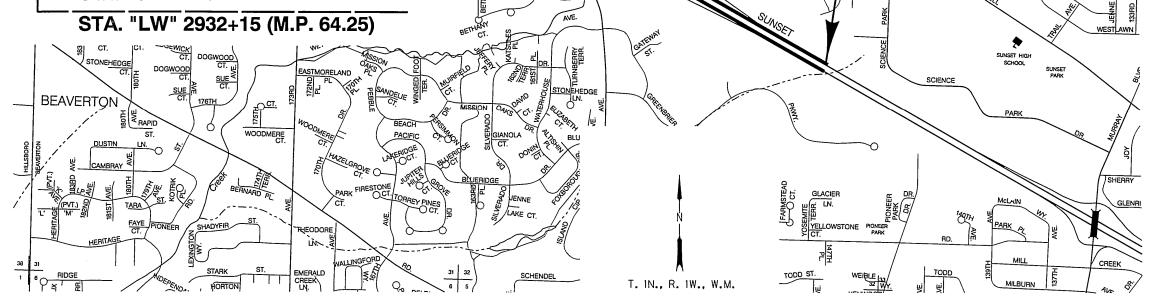

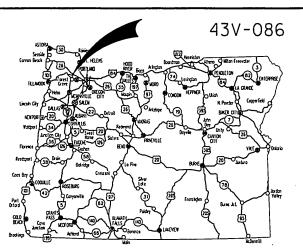

Overall Length Of Site - 2.10 Miles

#### **ATTENTION:**

Oregon Law Requires You To Follow Rules
Adopted By The Oregon Utility Notification
Center. Those Rules Are Set Forth In
OAR 952-001-0010 Through OAR 952-001-0090.
You May Obtain Copies Of The Rules By Calling
The Center. (Note: The Telephone Number For
The Oregon Utility Center Is (503) 232-1987.)

يكى فرائح والمجلى المباكن والمباكن المباكن المباكن المباكن المباكن المباكن المباكن المباكن المباكن المباكن LET'S ALL WORK TOGETHER TO MAKE THIS JOB SAFE 

#### OREGON TRANSPORTATION COMMISSION

Gail Achterman Michael Nelson Janice Wilson

VICE-CHAIR COMMISSIONER COMMISSIONER

COMMISSIONER DIRECTOR OF TRANSPORTATION

These plans were developed using ODOT design standards. Exceptions to these standards, if any, have been submitted and approved by the ODOT Chief Engineer or their delegated

Naveen G. Chandra P.E. - R1 Project Delivery Manager

Print name and title

Concurrence by ODOT Chief Engineer

US26: NW 185TH AVE - CORNELL ROAD SEC. SUNSET HIGHWAY

FEDERAL HIGHWAY ADMINISTRATION	PROJECT NUMBER	SHEET NO.
OREGON DIVISION	STP-S047(085)	1

43V-086

INI	DEX OF SHEETS, CONT'D.	
SHEET NO.	DESCRIPTION	
2,2A,2A-2 Thru	T. d. (C. d)	
2A-16	Typical Sections	
2B.2B-2 Thru 2B-3	Details	
2C, 2C-2 Thru 2C-24	Traffic Control Plans	
2C-25 Thru 2C-31	Detour Plan	
2D, 2D-2	Pipe Data Sheet	
3	Alignment	
3A	General Construction	
<i>3B</i>	Drainage & Utilities	
3C	Drainage Profile	
4	Alignment	
4A	General Construction	
4B	Drainage & Utilities	
4C	Drainage Profile	
5	Alignment	
5A	General Construction	
5B	Drainage & Utilities	
5C	Drainage Profile	
6	Alignment	
6A	General Construction	
6B	Drainage & Utilities	
6C	Drainage Profile	
7	Alignment	
7A	General Construction	
7B	Drainage & Utilities	
6C	Drainage Profile	
8	Alignment	
8A	General Construction	
8B	Drainage & Utilities	
8C	Drainage Profile	
9	Alignment	
9A	General Construction	
9B	Drainage & Utilities	
9C	Drainage Profile	
10	Alignment	
10A	General Construction	
10B	Drainage & Utilities	
10C	Drainage Profile	
11	Alignment	
11A	General Construction	
11B	Drainage & Utilities	
11C	Drainage Profile	
12	Alignment	
12A	General Construction	
12B	Drainage & Utilities	
12C	Drainage Profile	
<del></del>		

	INE	DEX OF SHEETS, CONT'D.
SHEET NO.		DESCRIPTION
	PERMANENT PAVEMENT MARKERS	
	ST	Striping Details
	ST-2 Thru ST-11 Incl.	Striping Plan
		GEO/HYDRO
	CA CA C There	GEOTHIDRO
	GA,GA-2 Thru GA-11 Incl.	Erosion Control Plan
	GA-12 Thru GA-15 Incl.	Erosion Control Details
DRAWING NO.	SHEET NO.	DESCRIPTION
83488	GB	Geotechnical Data
83495	GB-2	Geotechnical Data
83498	GB-3	Geotechnical Data
83499	GB-4	Geotechnical Data
27.42	1	- NORTH RETAINING WALL
83489	GC	Retaining Wall Plan & Profile
83490	GC-2	Retaining Wall Plan & Profile
83491	GC-3	Retaining Wall Plan & Profile
83492	GC-4	Retaining Wall Plan & Profile
97406		- SOUTH RETAINING WALL
83496	GC-5	Retaining Wall Plan & Profile
83493	GC-6	North Retaining Wall Details
83494	GC-7	South Retaining Wall Details
83497	GC-8	Retaining Wall Details
	GJ,GJ-2 Thru GJ-3	Water Quality Details
	RO	ADSIDE DEVELOPMENT
	GN,GN-2 Thru GN-8	Roadside Development Details
	GN-9 Thru GN-12	Roadside Development Plan


	DEX OF SHEETS, CONT'D.	
DRAWING NO.	DESCRIPTION DESCRIPTION	
	PERMANENT SIGNING	
S-11907 Thru S-11925 Incl	Sign Installation Plan	
S-11926 Thru S-11935 Incl.	Sign Details	
S-11936 Thru S-11944 Incl.	Sign Post & Data Table	
-		
	ILLUMINATION	
I-1688 Thru I-1698 Incl.	Illumination Plan	
I-1699	Illumination Details	
	TRAFFIC SIGNALS	
ITS-889 Thru ITS-895 Incl.	Communication Plan	
15564 Thru 15568 Incl.	Ramp Meter Plan	
15569	Ramp Meter Details	
AUTOMATED	TRAFFIC RECORDER #34-010	
TDS-485	Base Mounted Service Cabinet	
TDS-34-010A	Traffic Recorder Plan Legend	
TDS-34-010B	Traffic Recorder Loop Details	
	SIGN SUPPORTS	
BRIDGE NO.08404A - NW MURRAY BLVD.		
83409	Plan, Elevation & Section	
83410	Details	
BRIDGE NO	D. 08910A - NW CORNELL RD.	
83411	Plan, Elevation & Section	
BRIDGE N	0.16966 - NW BETHANY BLVD.	
83412	Plan, Elevation & Section	
CANT	TILEVER SIGN STRUCTURES	
S-11945	Plan & Elevation	

US26: NW 185TH AVE - CORNELL ROAD SEC.

SUNSET HIGHWAY WASHINGTON COUNTY

FEDERAL HIGHWAY ADMINISTRATION PROJECT NUMBER NO.


OREGON STP-S047(085) 1A

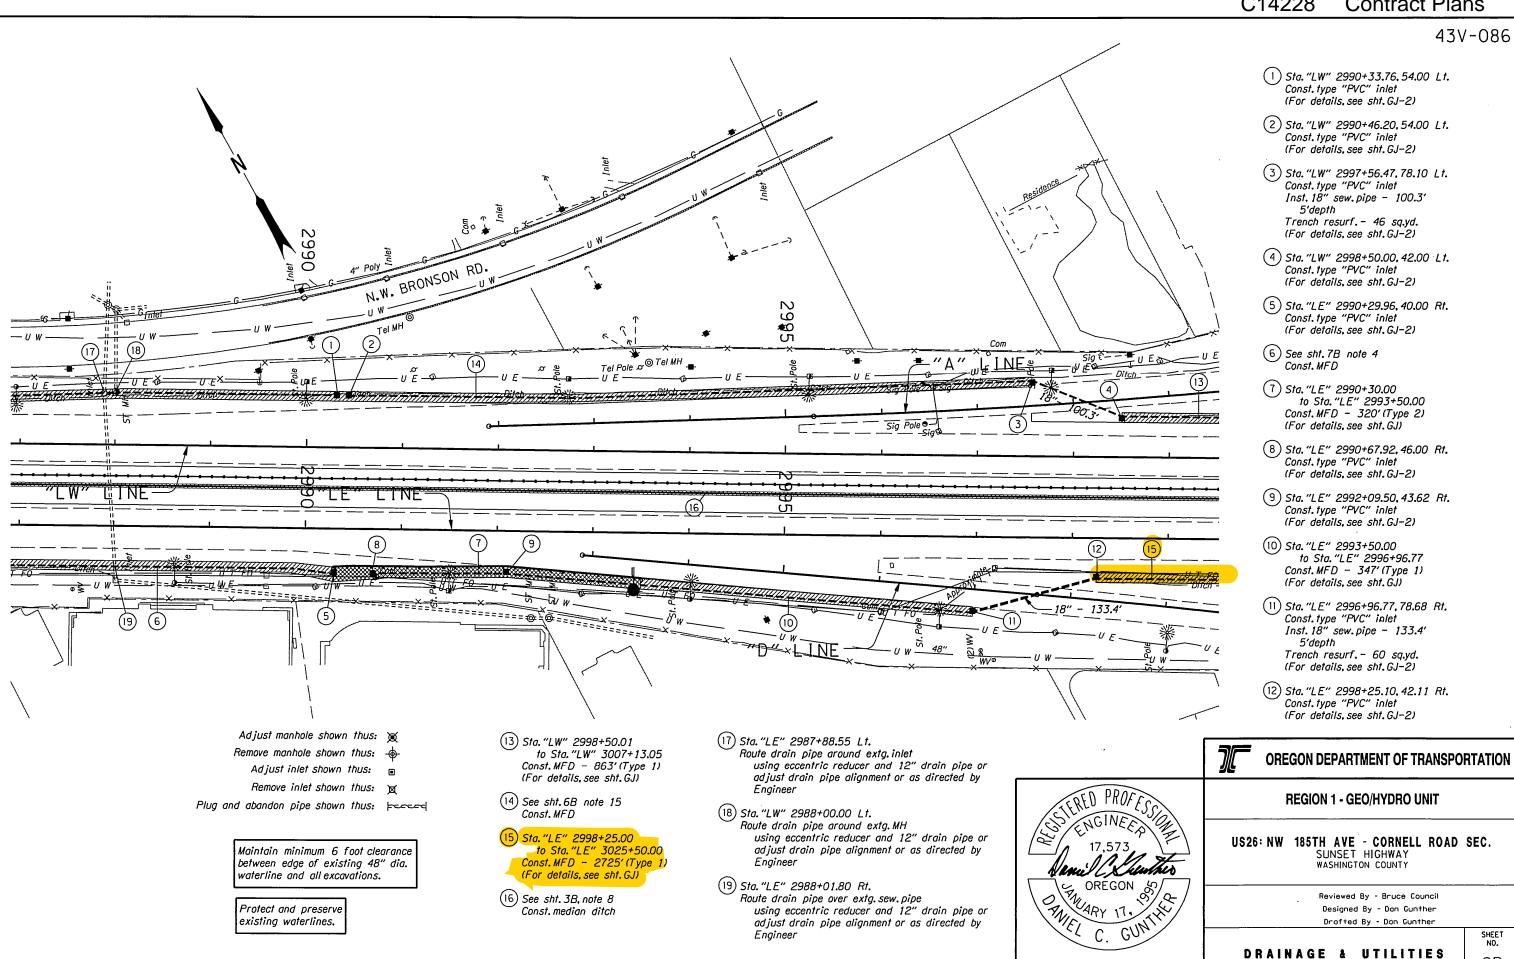

RENEWAL DATE: 6-30-2011


8B

C14228 Contract Plans 43V-086 8B 2 8B (1) Sta. 2990+46,20, 54.00 Lt. "LW" LINE Sta. 2990+33.76, 54.00 Lt.-F.L. 231.42 Out (NW) F.L. 231,45 Out (SE) 8B (3) BB (4) Finish grade @ @ "LW" Sta. 2997+56.47. 78.10 Lt. Inlet Sta. 2998+50.00, 42.00 Lt. Inlet F.L. 225.97 In (NW) F.L. 225.97 Out (SE) F.L. 227.15 In (NW) F.L. 227.15 Out (SE) --235--235-<u>--230</u>--230-0,96% 18" - 100.3' -225-225 --220--220-2990+00 2995+00 3000+00 8B (5) Sta. 2990+29.96, 40.00 Rt.-- 8B 📵 F.L. 230.60 Out (NW) Sta. 2990+67.92, 46.00 Rt F.L. 230.60 Out (SE) \_8B (9) Finish grade @ @ "LE" "LE" LINE 8B (11) Sta. 2992+09.50. 43.62 Rt. -240--240-- *8B* (12) Sta. 2996+96.77. 78.68 Rt. Inlet -F.L. 227.17 In (NW) F.L.230.4 In (NW) Sta. 2998+25.10, 42.11 Rt. F.L. 225.57 In (W) F.L. 230.4 Out (SE) F.L. 227.17 Out (E) F.L. 225.57 Out (\$E) -235 -235-230 <del>-230</del>-0.83% 18" - 133.4" -225 -225 --220--220 <del>-215</del>-215 3000+00 2990+00 2995+00 **OREGON DEPARTMENT OF TRANSPORTATION REGION 1 - GEO/HYDRO UNIT** US26: NW 185TH AVE - CORNELL ROAD SEC.
SUNSET HIGHWAY
WASHINGTON COUNTY OREGON SO Reviewed By - Bruce Council Designed By - Dan Gunther Drafted By - Dan Gunther SHEET NO. DRAINAGE PROFILE 80 RENEWAL DATE: 6-30-2011

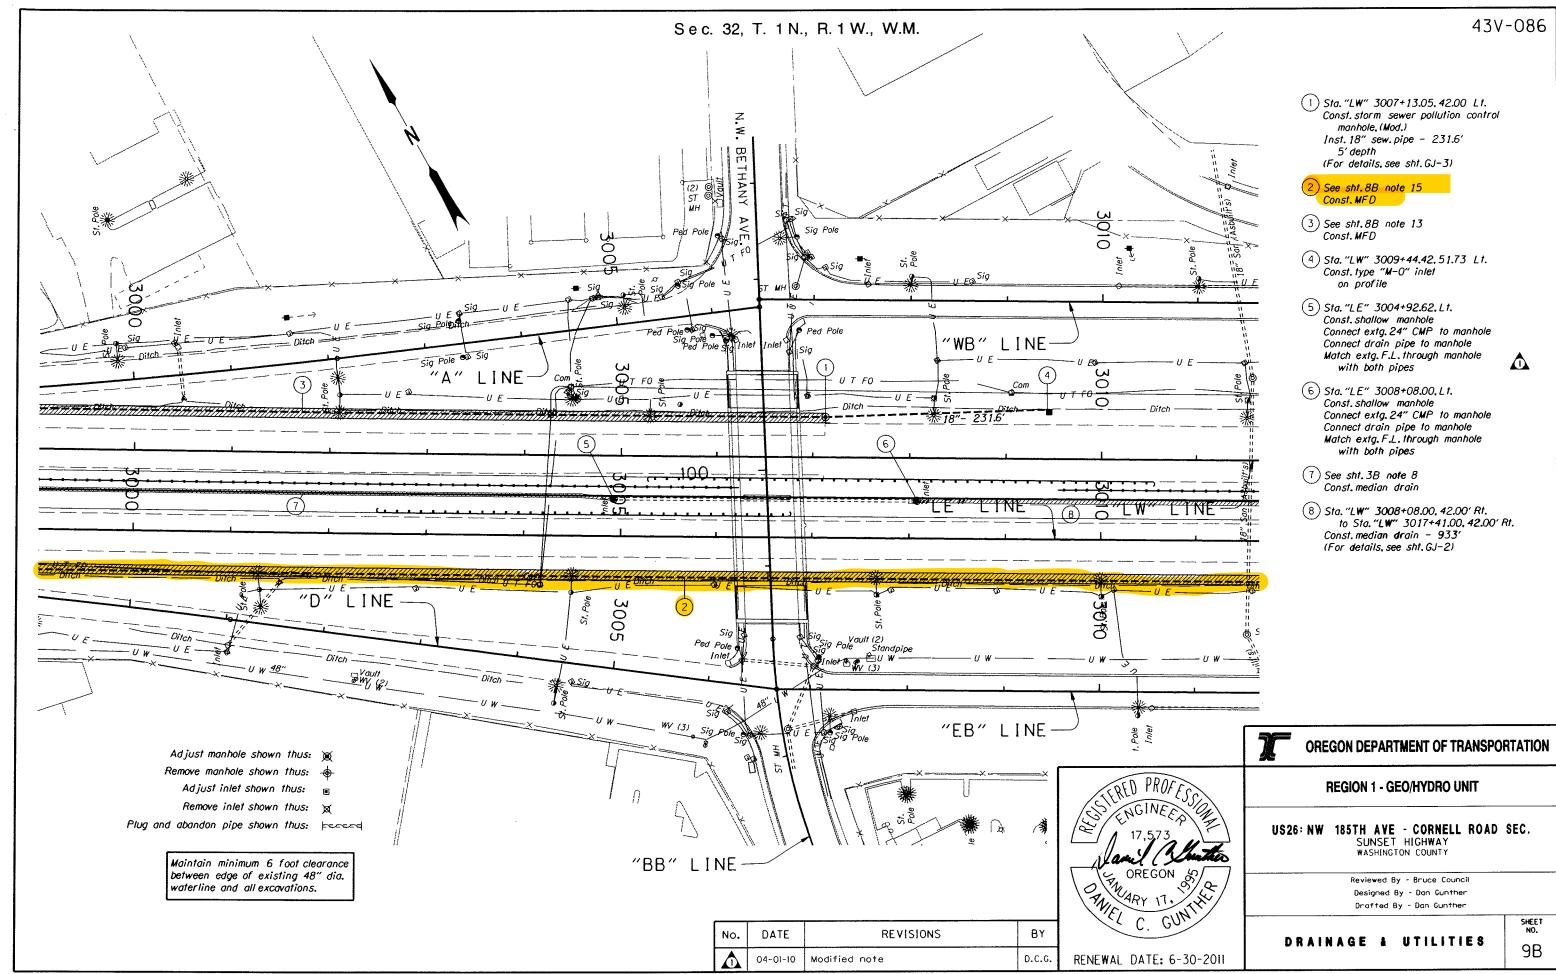

hwye66d

C14228 Contract Plans 43V-086 "LW" LINE -230--230-9B(1) Finish grade @ € "LW" 3007+13.05, 42.00 SSC-MH Rim 212.40 F.L. In 209.16(NW) F.L. Out 209.07(\$E) 225 225 -220 -220--9B 4 Sta.3009+44.42, 51.73 Lt.Type "MO" Inlet F.L.207.05 In (NW) -215 215 -2-10 210-0.89% 18" - 231.6" -205--205-3000+00 3005+00 3010+00 -230-<del>-230</del>-"LE" LINE 225 -220--220-Finish grade @ @ "LE" -215 -2<del>15</del>--210-210 -205--200-3000+00 3005+00 3010+00 **OREGON DEPARTMENT OF TRANSPORTATION REGION 1 - GEO/HYDRO UNIT** US26: NW 185TH AVE - CORNELL ROAD SEC.
SUNSET HIGHWAY
WASHINGTON COUNTY OREGON S Reviewed By - Bruce Council Designed By - Dan Gunther Drafted By - Dan Gunther SHEET NO. DRAINAGE PROFILE 9C RENEWAL DATE: 6-30-2011

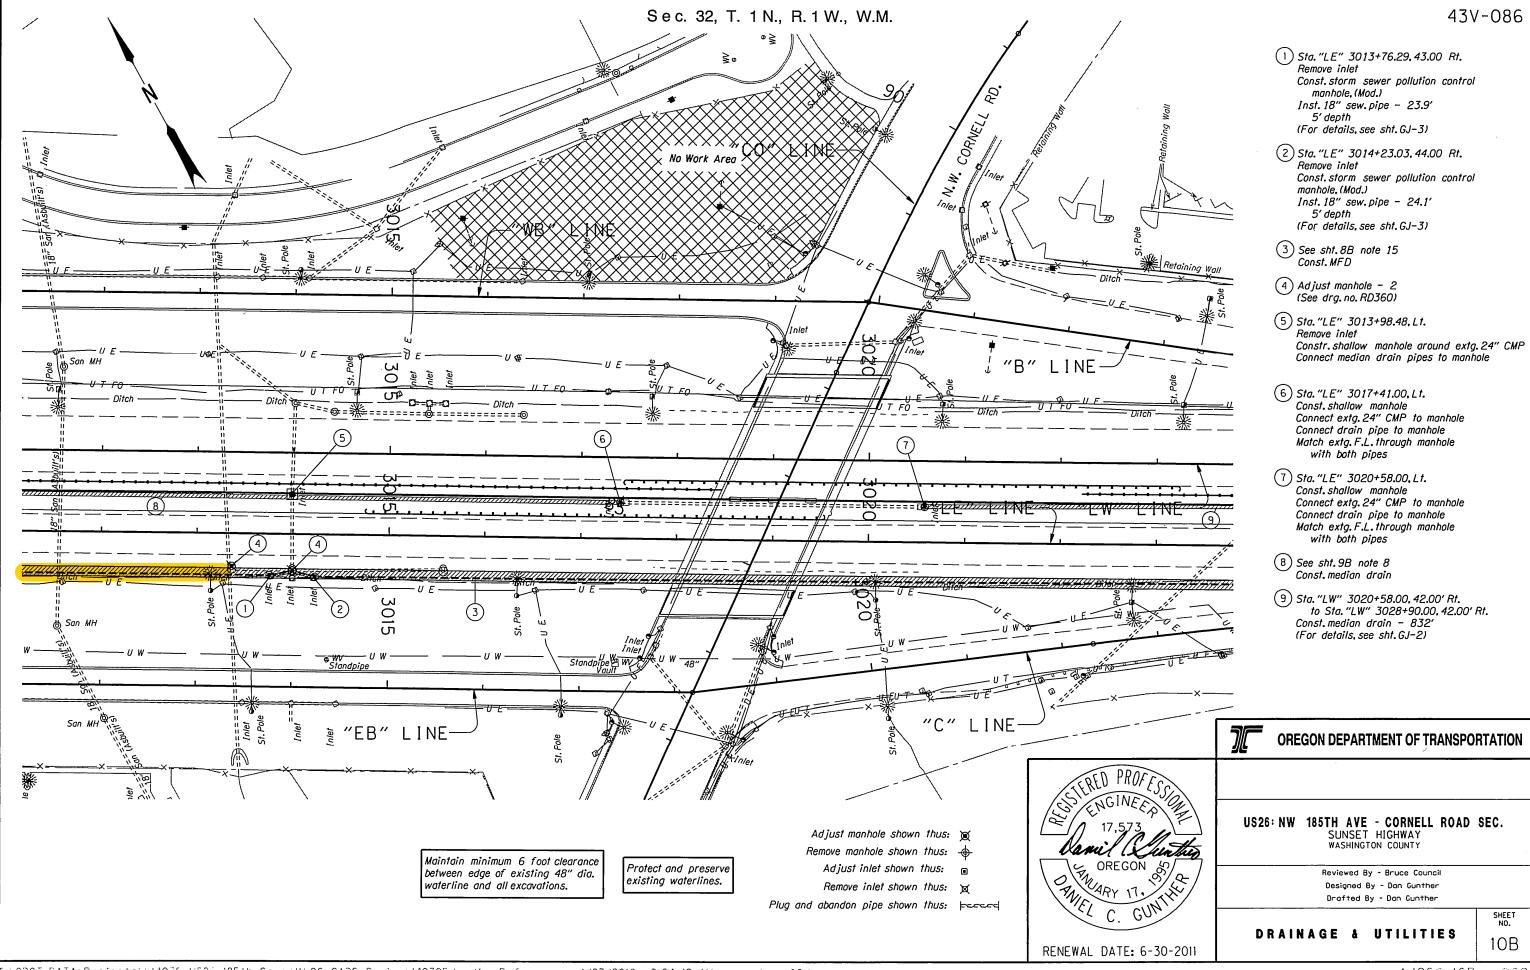

C14228 Contract Plans 43V-086 "LE" LINE 10B (4) Sta. 3013+99.70, exgt. MH Rim 206.52 F.L. In 200.34(SE) F.L.In 200.74(W) F.L. Out 200,02(NE) Std. 3013+76.296. 43.00 Rt. SSPC-MH -220-Rim 205.55 F.L. In 202.29(NW) F.L. Out 202.23(E) Finish grade @ & "LE" 215 10B 2 215 Sta. 3014+23.03, 44.00 Rt. \$SPC-MH Rim 205.49 F.L.In 202.22(SE) F.L.Out 202.02(NW) -210 -210--205 -205---200--200-6.00% 18" - 24.1' 6.40% 18" - 23.9' 3015+00 3020+00 **OREGON DEPARTMENT OF TRANSPORTATION** US26: NW 185TH AVE - CORNELL ROAD SEC.
SUNSET HIGHWAY
WASHINGTON COUNTY Navid ( ) ka OREGON 50/ Reviewed By - Bruce Council Designed By - Dan Gunther Drafted By - Dan Gunther SHEET NO. DRAINAGE PROFILE 10C RENEWAL DATE: 6-30-2011

