

# OPERATION & MAINTENANCE MANUAL

**DFI No. D00062**

**Facility Type: Bioslope**



Prepared: June 2016

**INDEX**

1. IDENTIFICATION ..... - 2 -  
2. FACILITY CONTACT INFORMATION..... - 2 -  
3. CONSTRUCTION ..... - 2 -  
4. BIOSLOPE OVERVIEW ..... - 3 -  
5. FACILITY HAZ MAT SPILL FEATURE ..... - 9 -  
6. OVERFLOW ..... - 9 -  
7. MAINTENANCE REQUIREMENTS ..... - 9 -  
8. WASTE MATERIAL HANDLING ..... - 9 -

**APPENDIX A:**

**Operational Plan Drawing**

**APPENDIX B:**

**ODOT Project Plan Sheets**

## 1. Identification

Drainage Facility ID (DFI): D00062  
Facility Type: Bioslope  
Construction Drawings: (V-File Number) 44V-024  
Location: District: 4  
Highway Number: 210  
Mile Post: 1.03 to 1.20  
Description: Bioslope is adjacent to south side of frontage road. It is 67 and 209 feet left of highway centerline at M.P. 1.03 and M.P. 1.20, respectively.

## 2. Facility Contact Information

Contact the Engineer of Record, Region Technical Center, or Geo-Environmental's Senior Hydraulics Engineer for:

- operational clarification
- maintenance clarification
- repair or restoration assistance

### Engineering Contacts:

Region Technical Center Hydro Unit Manager

Or

Geo-Environmental's Senior Hydraulics Engineer (503) 986-3365.

## 3. Construction

Engineer of Record: ODOT Designer -- Region 2 Hydraulics, Bo Miller, (503) 986-2738

Facility construction year: 2011  
Contractor: R & R Construction

## 4. Bioslope Overview

Road runoff, from the frontage road, flows across the shoulder and into the bioslope where it percolates downward through the media filter drain mix. The pollutants are removed by the mix and the treated water collects in a gravel filled toe trench. It is stored in the voids within the trench gravels until it percolates into the surrounding soil. There are no subsurface drain pipes in the trenches under these bioslopes. The bioslope is shown, looking east and west respectively, in Photos 1 and 2. Since construction in 2011, a bike path that bisects the facility has been constructed. This is shown in Photos 3 and 4, along with surrounding culverts. Photos 6-9 illustrate the facility's footprint. Photo 10 indicates a pipe located below the facility that runs underneath the Frontage road from an existing ditch. A plan view, cross section, and profile view of the bioslope is shown in Appendix A. The bioslope is shown on the construction drawings in Appendix B.

### A. Maintenance equipment access:

The bioslope is easily reached from the frontage road shoulder. The shoulder slopes are between four to six units horizontal to one unit vertical (4H : 1V). Maintenance equipment can park on these slopes near the facility. There are no guardrails at the road edge.

### B. Heavy equipment access into facility:

- Allowed (no limitations)
- Allowed (with limitations)
- Not allowed

Heavy equipment is allowed along the perimeter of the facility and along the road side. Entering the facility with heavy equipment, such as a large mower while wet, may cause damage to the facility.

### C. Special Features:

- Amended Soils
- Porous Pavers
- Liners
- Underdrains



Photo 1: Photo taken in 2011, looking east



Photo 2: Taken in 2011, looking west





Photo 3: Bike path looking east

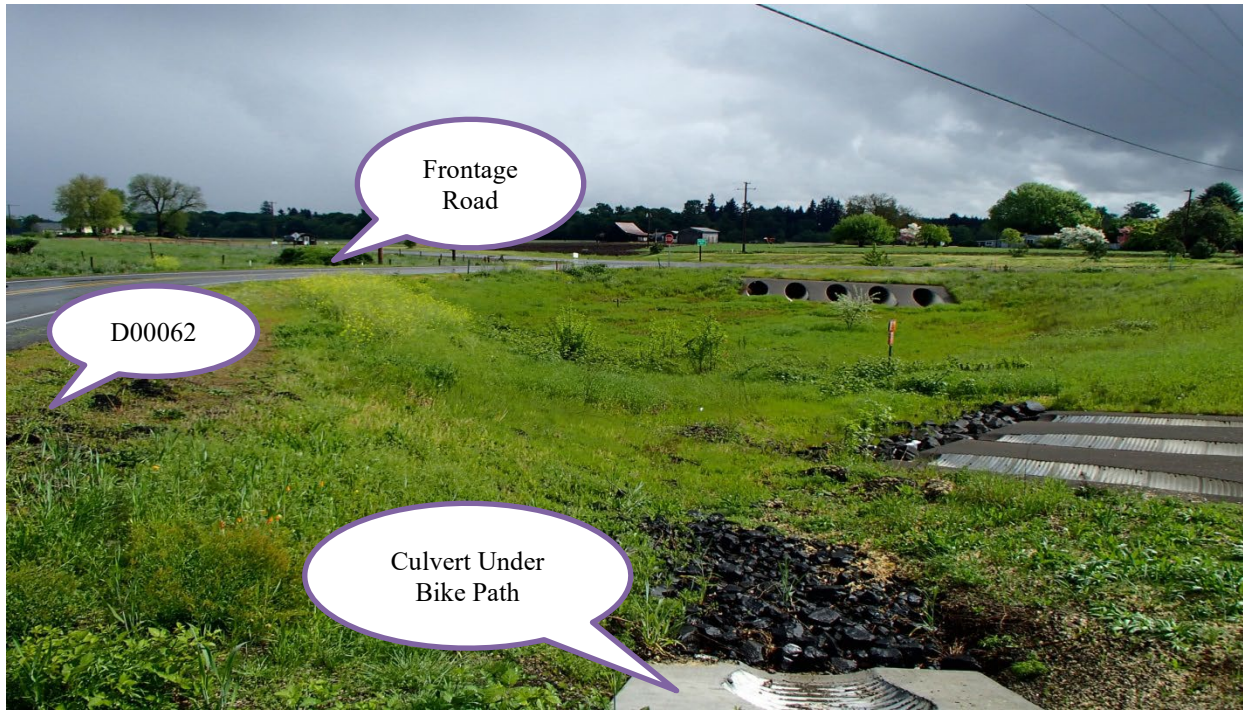


Photo 4: Surrounding culverts looking east, taken in 2016





Photo 3: Facility foot print looking east, taken in 2016



Photo 4: Facility foot print looking east, taken in 2016





Photo 5: Facility foot print looking east, taken in 2016



Photo 6: Facility foot print looking east, taken in 2016





Photo 9: Surrounding culverts looking west, taken in 2016



Photo 10: Pipe under facility looking west, take in 2016

## 5. Facility Haz Mat Spill Feature

The bioslope can capture small spills. The contaminated bioslope materials must be removed and the facility reconstructed as shown on the attached plans.

## 6. Cell Overflow

Runoff that is not captured by the bioslope flows down the roadway embankment slopes and into the roadway drainage ditches.

The overflow outlets for this facility are:

Designed into facility:

■ Other, as noted below:

The roadside ditches.

## 7. Maintenance Recommendations



Routine maintenance table for non-proprietary stormwater treatment and storage/detention facilities have been incorporated into ODOT's Maintenance Guide. These tables summarize the maintenance requirements for ponds, swales, filter strips, bioslopes, and detention tanks and vaults. Special maintenance recommendations in addition to the routine recommendations are noted below when applicable.

The ODOT Maintenance Guide can be viewed at the following website:

<http://www.oregon.gov/ODOT/HWY/OOM/MGuide.shtml>

Maintenance recommendations for proprietary structures, such as underground water quality manholes and/or vaults with filter media are noted in Appendix C when applicable.

The following stormwater facility maintenance table (See ODOT Maintenance Guide) should be used to maintain the facility outlined in this Operation and Maintenance Manual or follow the Maintenance recommendations outlined in Appendix C when proprietary structure is selected below:

- Table 1 (general maintenance)
- Table 2 (stormwater ponds)
- Table 3 (water quality biofiltration swales)
- Table 4 (water quality filter strips)
- Table 5 (water quality bioslopes)
- Table 6 (detention tank)
- Table 7 (detention vault)
- Appendix C (proprietary structure)
- Special Maintenance requirements:

### **Special Maintenance Recommendations**

The bioslope is near the pavement edge and it is covered with shoulder aggregate. Vegetation will be sparse and there are no requirements for its establishment or maintenance.

## **8. Waste Material Handling**

Contaminated material removed from the facility is defined as waste by DEQ. Refer to the roadwaste section of the ODOT Maintenance Yard Environmental Management System (EMS) Policy and Procedures Manual for disposal options:  
<http://egov.oregon.gov/ODOT/HWY/OOM/EMS.shtml>

Contact any of the following for more detailed information about management of waste materials found on site:




ODOT Clean Water Unit	(503) 986-3008
ODOT Statewide Hazmat Coordinator	(503) 229-5129
ODOT Region Hazmat Coordinator	(503) 986-2647
ODEQ Northwest Region Office	(503) 229-5263



# Appendix A

## Content:

- **Operational Plan Drawing**

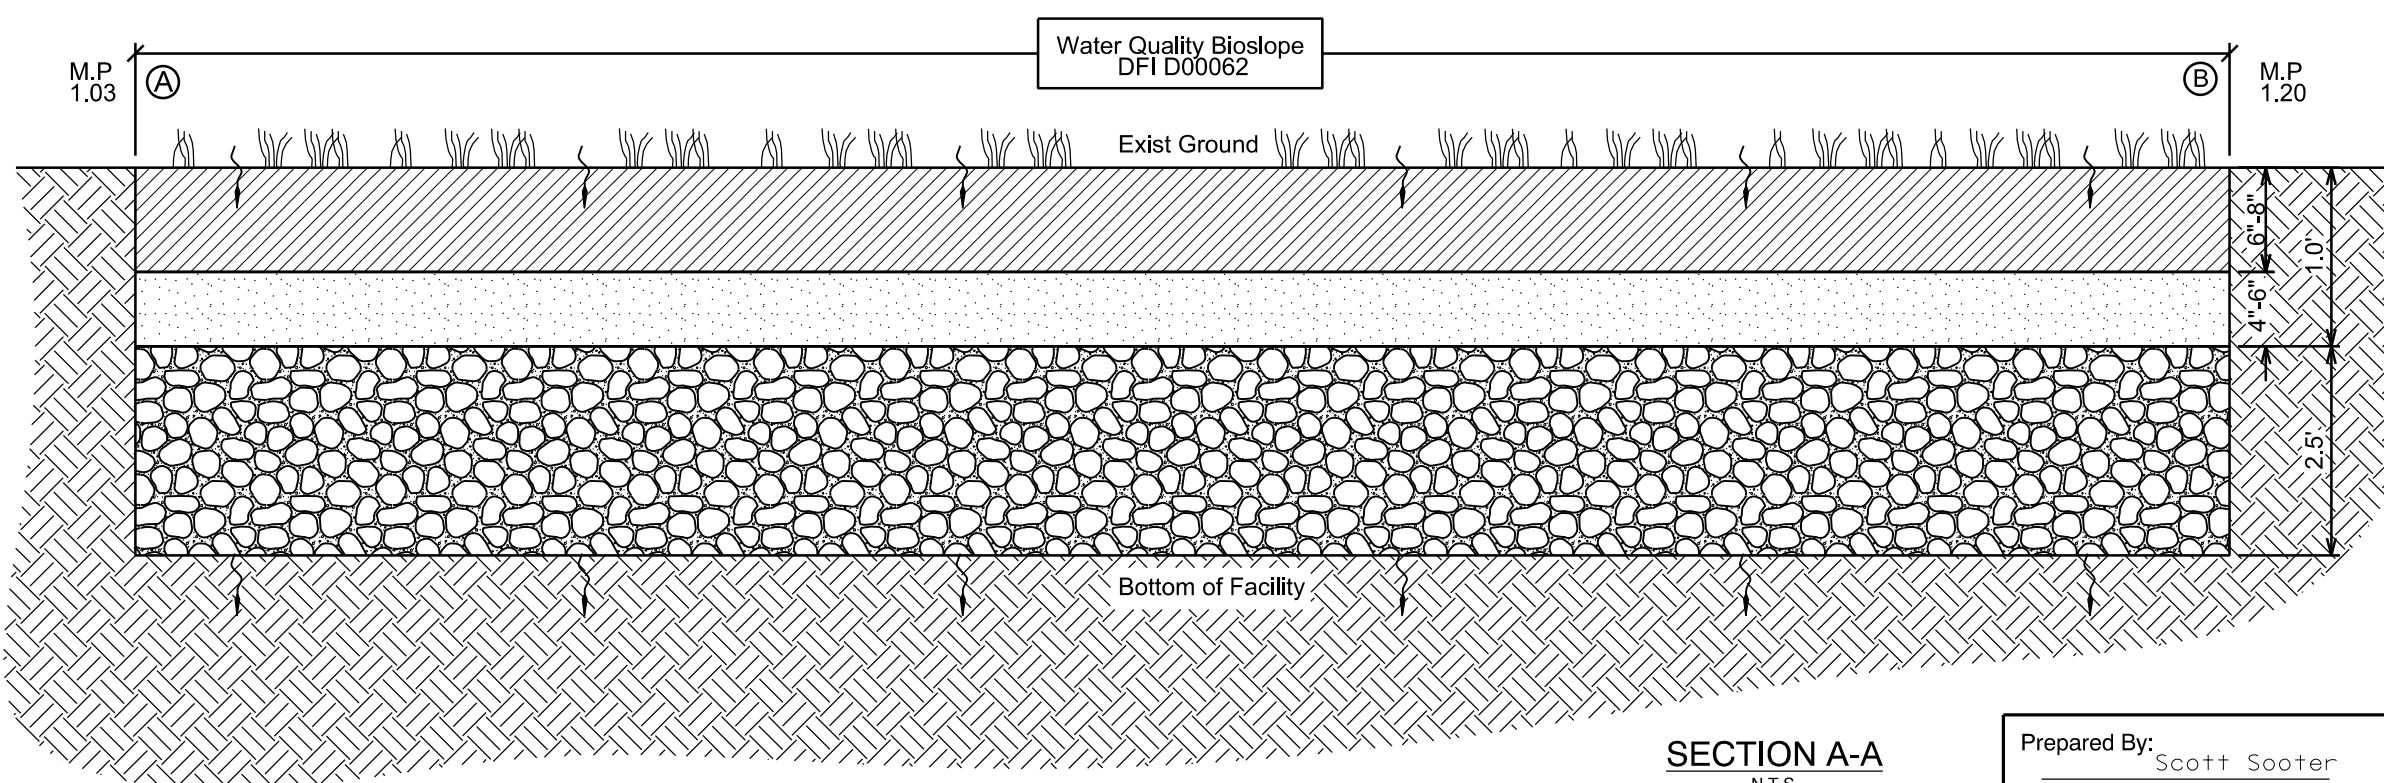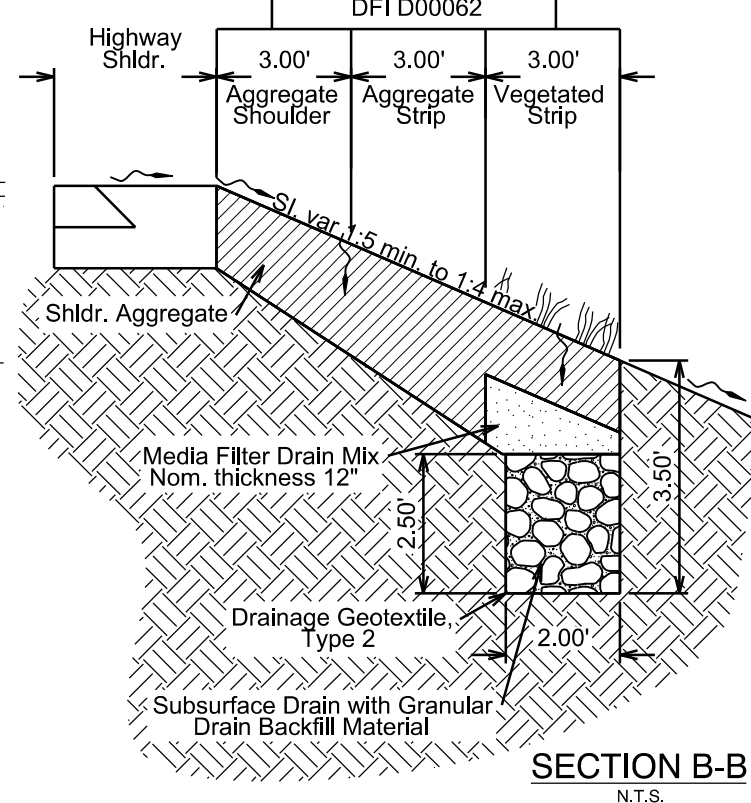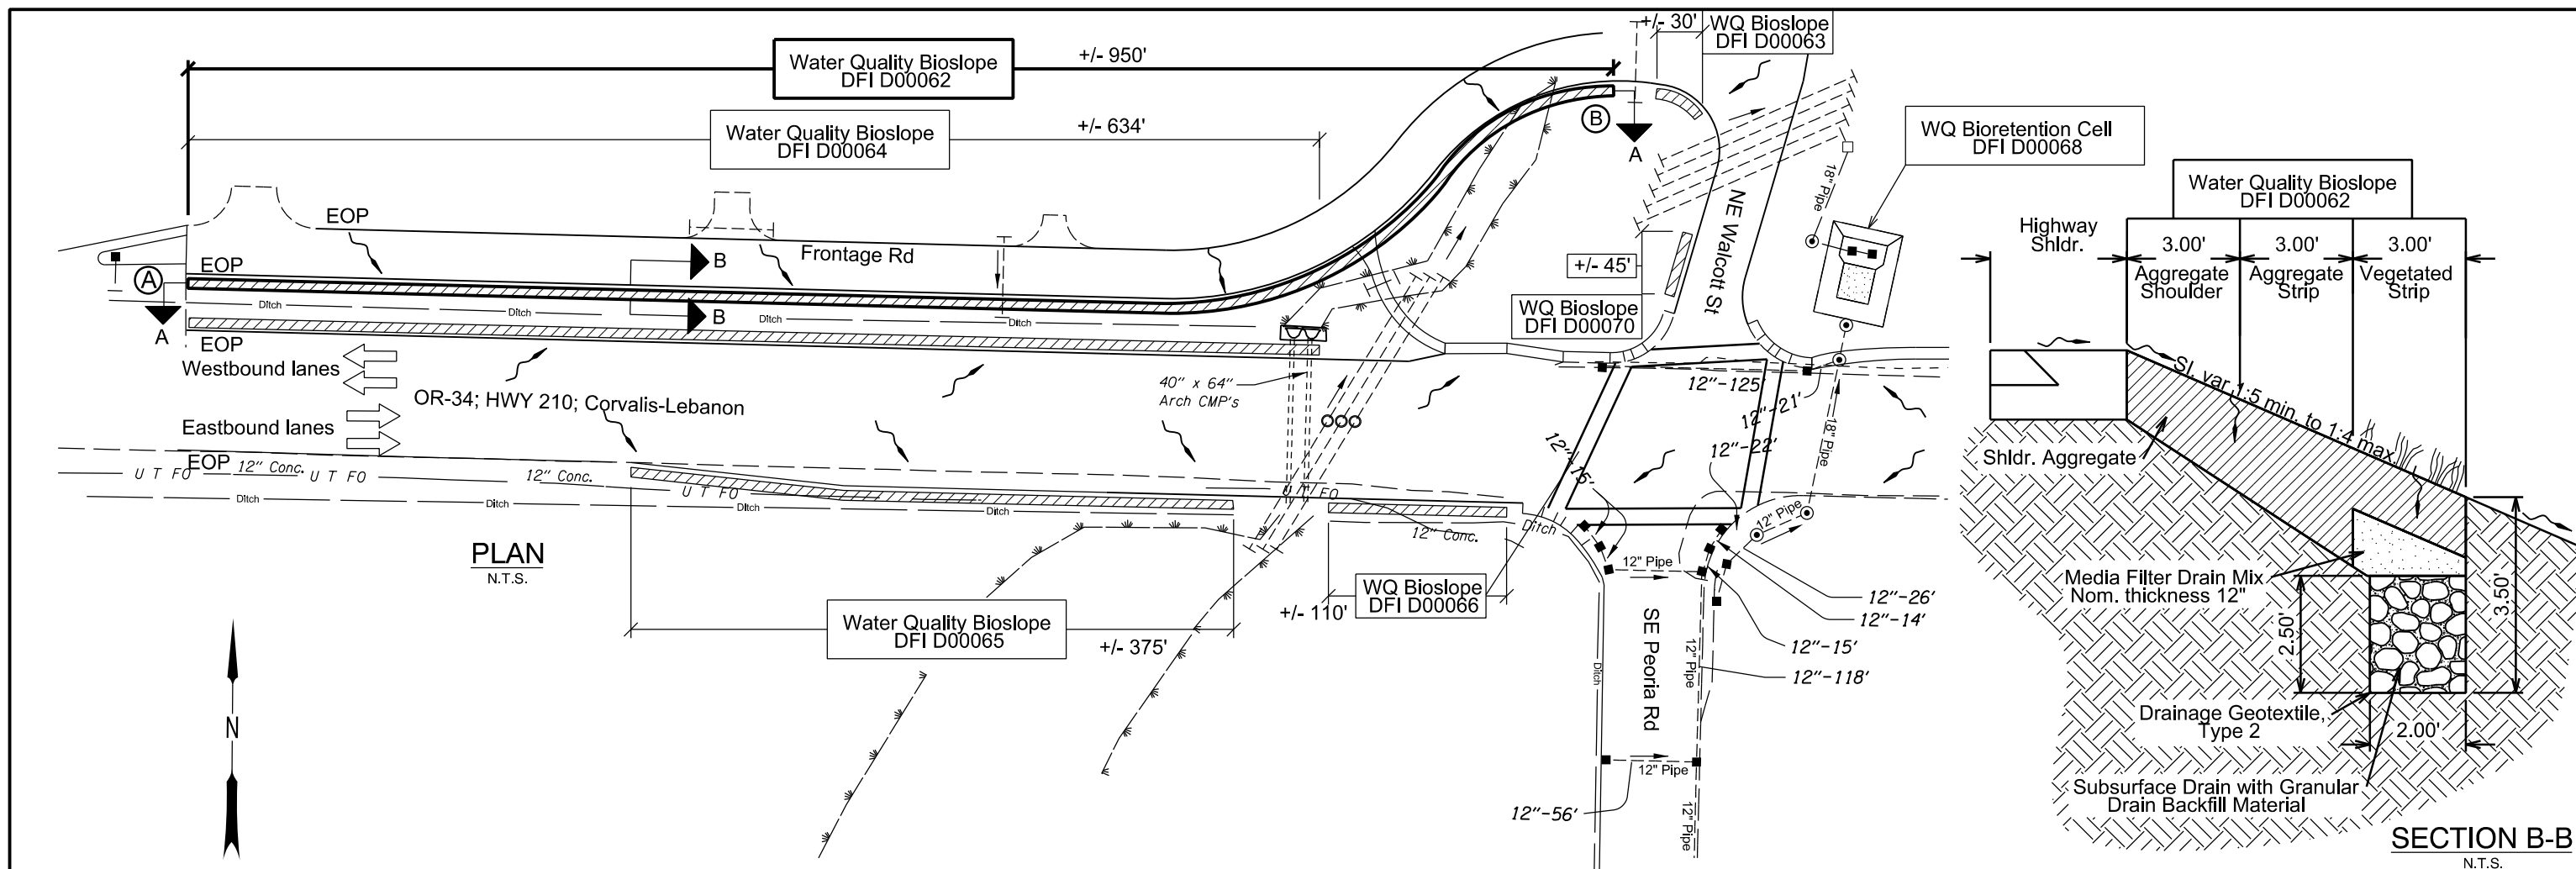

- LEGEND:**
- or ○ Manhole
  - or □ Inlet
  - Storm Pipe (Facility)
  - Storm Pipe
  - Conveyance Direction
  - ~ Pavement / Facility Flow Path
  - Media Filter Drain Mix (Ecology Mix)
  - Granular Drain Backfill Material
  - Shoulder Aggregate
  - Existing Soil
  - ~ Vegetation
  - Ⓐ Facility Start
  - Ⓑ Facility End

**OREGON DEPARTMENT OF TRANSPORTATION**

**DFI D00062**  
**MAINTENANCE DISTRICT 04 HWY 210**  
**WATER QUALITY BIOSLOPE**  
 HIGHWAY MP 1.03-1.20  
 LINN COUNTY


Prepared By: Scott Sooter

Drafted By: Scott Sooter

**SECTION A-A**  
N.T.S.



① M.P. 1.03, 86.15' Lt. to M.P. 1.20, 242.47' Lt.  
Bioslope

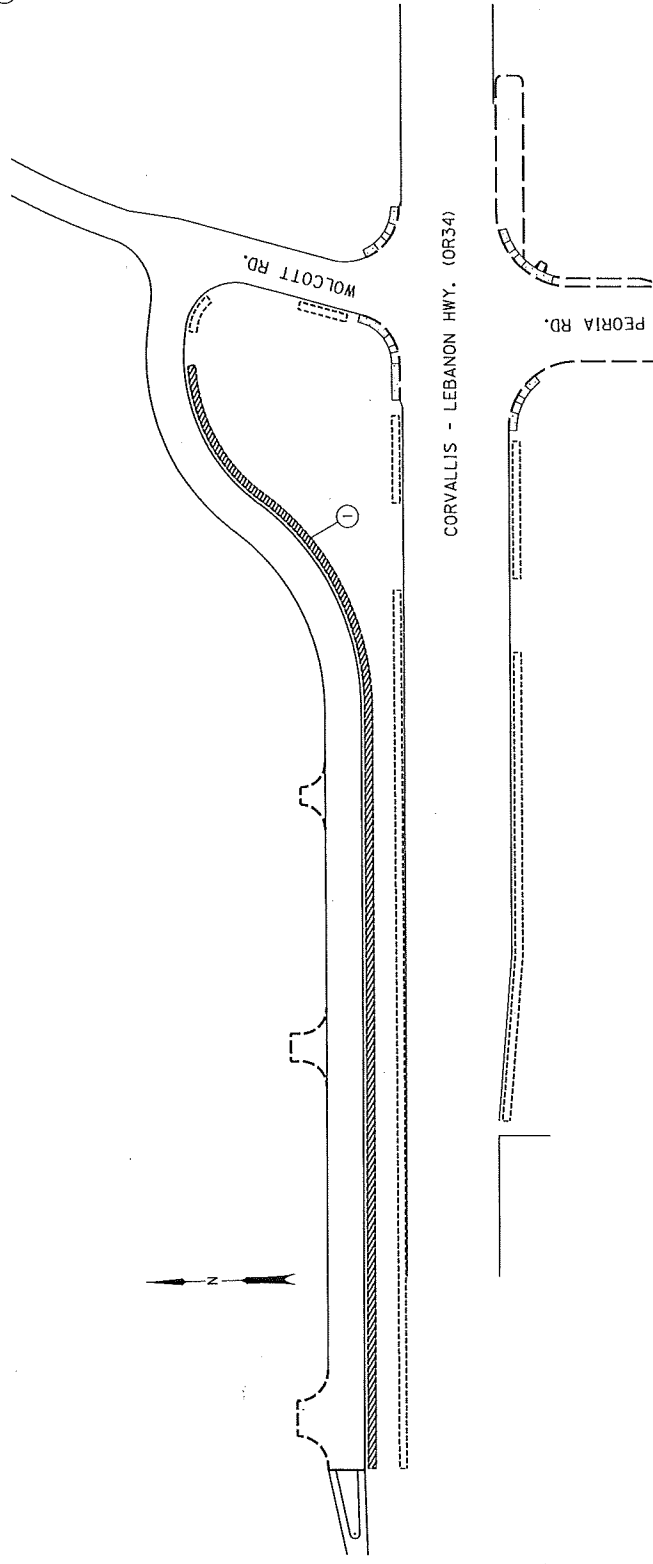

DFJ D00062  
**MAINTENANCE DISTRICT 4, HWY. 210**  
CORVALLIS-LEBANON HIGHWAY (M.P. 1.19)  
LINN COUNTY  
OPERATIONAL PLAN  
BIOSLOPE


## Appendix B

### Content:

- **ODOT Project Plan Sheets**
  - *Cover/Title Sheet*
  - *Water Quality/Detention Plan Sheets*
  - *Details*

HYDRAULICS COPY  
C14326 Contract Plans

44V-24

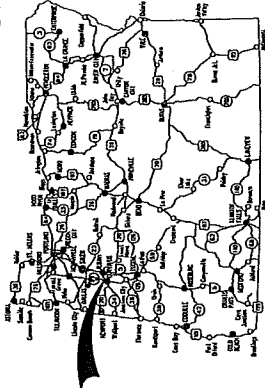

Overall Length Of Project - 0.92 Miles

**ATTENTION:**  
Oregon Law Requires You To Follow Rules Adopted By The Oregon Utility Registration Center (OURC) For The Installation Of New Utility Lines. You May Obtain Copies Of The Rules By Calling The Center. (Note: The Telephone Number For The Oregon Utility Center Is 1833-232-1967.)

LET'S ALL  
WORK TOGETHER  
TO MAKE THIS  
JOB SAFE

**OREGON TRANSPORTATION COMMISSION**  
Chair  
Michael Nelson  
Vice-Chair  
Mary F. Olson  
Commissioner  
David Johnson  
Matthew L. Garrett  
Director of Transportation

These plans were developed using ODOT design standards. Exceptions to these standards, if any, have been submitted and approved by the ODOT Chief Engineer or their delegated authority.

By: *Carol A. Cartwright* 1/10/11  
Signature & date  
Carol Cartwright - R2 Tech Center Manager  
Print name and title  
*[Signature]*  
Concurrence by ODOT Chief Engineer

**OR34: ROCHE STREET - WOLCOTT ROAD SEC.**  
CORVALLIS - LEBANON HIGHWAY  
LINN COUNTY

FEDERAL HIGHWAY ADMINISTRATION	PROJECT NUMBER	SHEET NO.
OREGON DIVISION	X-HPP-S210(013)	1

STATE OF OREGON  
**DEPARTMENT OF TRANSPORTATION**


PLANS FOR PROPOSED PROJECT

GRADING, DRAINAGE, STRUCTURE, PAVING, SIGNING,  
SIGNALS & ROADSIDE DEVELOPMENT

**OR34: ROCHE STREET - WOLCOTT ROAD SEC.**  
**CORVALLIS - LEBANON HIGHWAY**

LINN COUNTY

FEBRUARY 2011

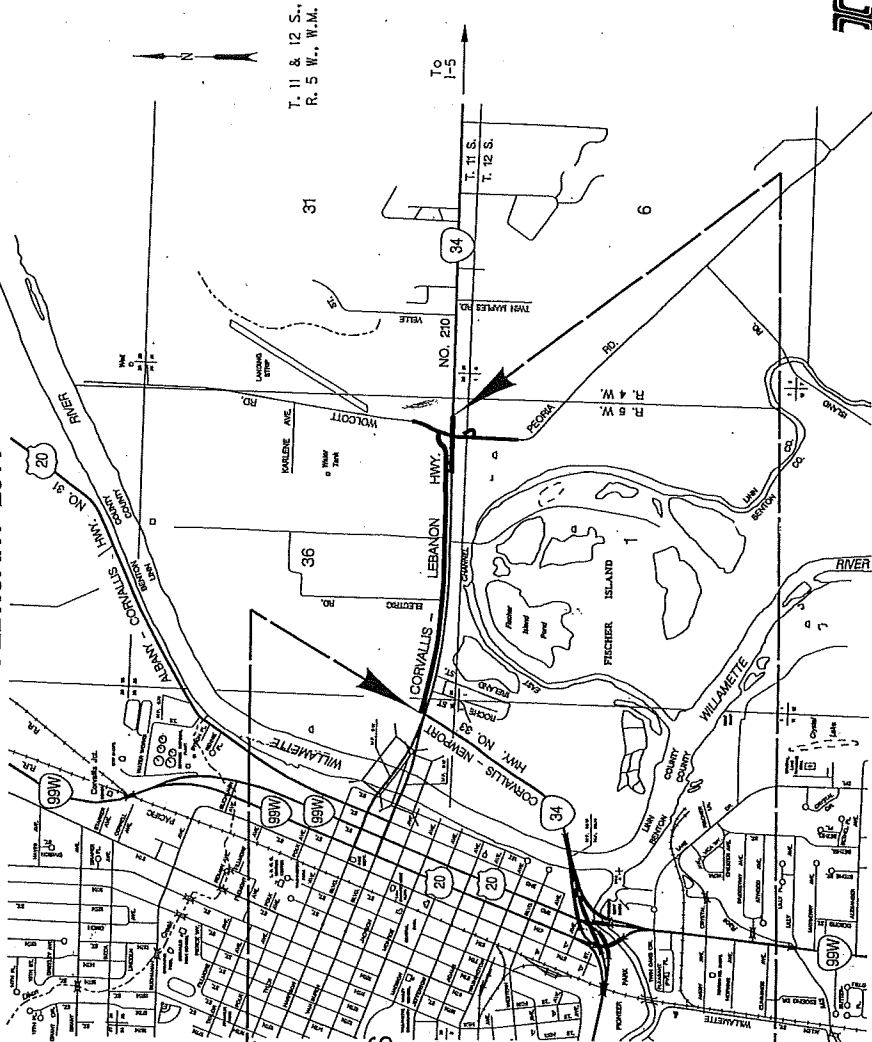

**X-HPP-S210(013)**

**BEGINNING OF PROJECT**

**STA. "SP" 1+20 (M.P. 0.34)**

CORVALLIS

**X-HPP-S210(013)**

**END OF PROJECT**


**STA. "L" 77+00 (M.P. 1.26)**

INDEX OF SHEETS	
SHEET NO.	DESCRIPTION
1	Title Sheet
1A	Index Of Sheets Cont'd.
1A-2	Sta. Drg. Nos.



C14326 Contract Plans

44V-24

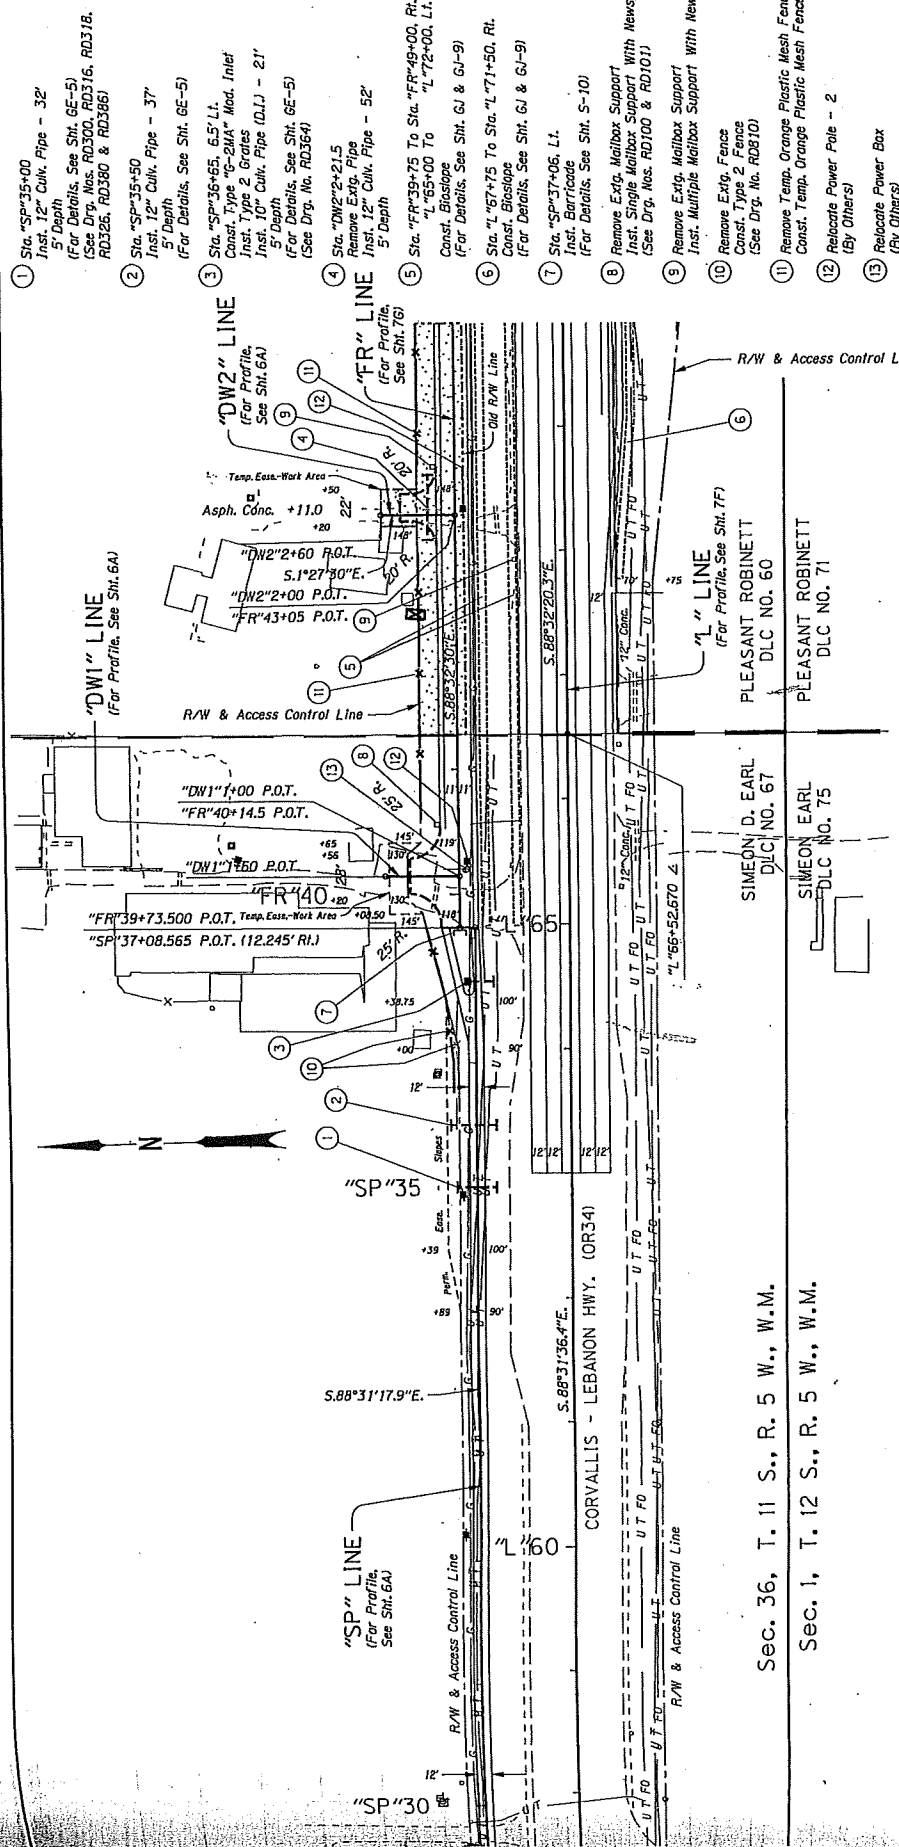

- ① Sta. "SP"35+00  
Inst. 12" Culk. Pipe - 32"  
5' Depth  
(For Details See Sht. 6E-5)  
(See Drg. Nos. RD300, RD316, RD318,  
RD325, RD380 & RD386)
- ② Sta. "SP"35+50  
Inst. 12" Culk. Pipe - 37"  
5' Depth  
(For Details See Sht. 6E-5)
- ③ Sta. "SP"36+65, 65' Lt.  
Const. Type "G-24A" Mod. Inlet  
Inst. Type 2 Grates  
Inst. 10" Culk. Pipe (D.L.J.) - 21"  
5' Depth  
(For Details See Sht. 6E-5)  
(See Drg. No. RD364)
- ④ Sta. "DW2"2+21.5  
Remove Exlg. Pipe  
Inst. 12" Culk. Pipe - 52"  
5' Depth  
(For Profile See Sht. 7B)
- ⑤ Sta. "FR"39+75 To Sta. "FR"49+00, Rt.  
"L"65+00 To "L"72+00, Lt.  
Const. Biotlope  
(For Details See Sht. 6J & 6J-9)
- ⑥ Sta. "L"67+75 To Sta. "L"71+50, Rt.  
Const. Biotlope  
(For Details See Sht. 6J & 6J-9)
- ⑦ Sta. "SP"37+06, Lt.  
Inst. Biotlope  
(For Details See Sht. 5-10)
- ⑧ Remove Exlg. Mailbox Support  
Inst. Single Mailbox Support With Newspaper Box  
(See Drg. Nos. RD100 & RD101)
- ⑨ Remove Exlg. Mailbox Support  
Inst. Multiple Mailbox Support With Newspaper Box
- ⑩ Remove Exlg. Fence  
Const. Type 2 Fence  
(See Drg. No. RD810)
- ⑪ Remove Temp. Orange Plastic Mesh Fence  
Const. Temp. Orange Plastic Mesh Fence
- ⑫ Relocate Power Pole - 2  
(By Others)
- ⑬ Relocate Power Box  
(By Others)

<b>OREGON DEPARTMENT OF TRANSPORTATION</b>	
<b>REGION 2 TECH CENTER</b>	
ORR34: ROCHE STREET - WOLCOTT ROAD SEC. CORVALLIS - LEBANON HIGHWAY LINN COUNTY	
Design Team Leader - Carol Cartwright Designed By - Kathy Fry Drafted By - Jeff Larson	
<b>GENERAL CONSTRUCTION</b>	SHEET NO. <b>6</b>


RENEWALS: 12-31-2011

REGISTERED PROFESSIONAL ENGINEER  
14,931  
CAROL A. CARTWRIGHT  
OREGON  
JULY 25, 1991

Remove Building Shown Thus:  
(By Others)

Contractor May Not Occupy Area Prior To 1 May 2011  
Shown Thus:

Sec. 36, T. 11 S., R. 5 W., W.M.  
Sec. 1, T. 12 S., R. 5 W., W.M.

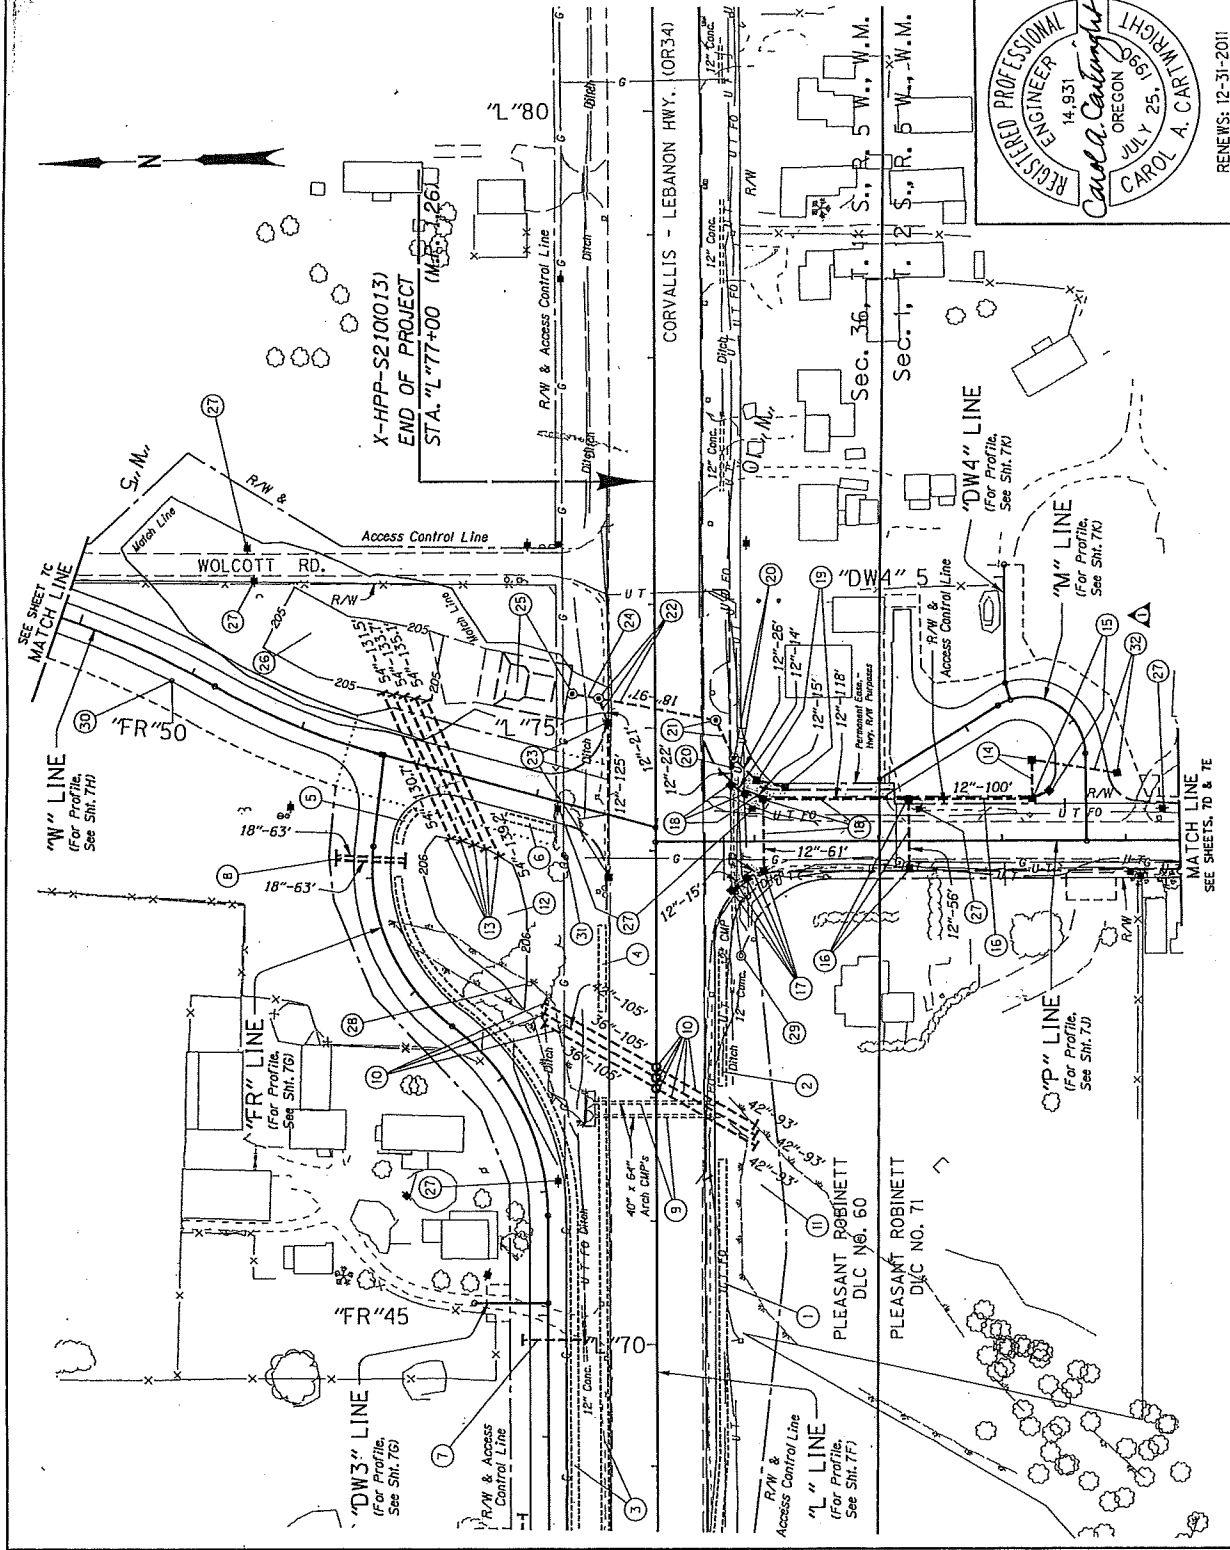

No.	DATE	REVISIONS	BY
1	02-14-11	Added Pipe & Inlet	K.F.


**OREGON DEPARTMENT OF TRANSPORTATION**

**REGION 2 TECH CENTER**

OR34: ROCHE STREET - WOLCOTT ROAD SEC  
CORVALLIS - LEBANON HIGHWAY  
LEBANON COUNTY

Design Team Leader - Carol Corrwright  
Designed By - Kathy Fry  
Drafted By - Jeff Larson

**DRAINAGE & UTILITIES**

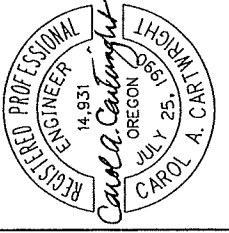

REVISIONS: 12-31-2011

- ① See Sht. 6, Note 6
- ② Sta. "L"72+70 To Sta. "L"73+20, Rt.  
Const. Bioslope  
(For Details, See Sht. GJ & GJ-9)
- ③ See Sht. 6, Note 5
- ④ Sta. "L"72+70 To Sta. "L"73+40, Lt.  
Const. Bioslope  
(For Details, See Sht. GJ & GJ-9)
- ⑤ Sta. "FR"49+30 To Sta. "FR"49+60, Rt.  
Const. Bioslope  
(For Details, See Sht. GJ & GJ-9)
- ⑥ Sta. "W"6+80 To Sta. "W"9+20, Rt.  
Const. Bioslope  
(For Details, See Sht. GJ & GJ-9)
- ⑦ Sta. "FR"44+80  
Inst. 10" Culk. Pipes (DI) - 50'  
5' Depth  
(For Details, See Sht. GE-5)
- ⑧ Sta. "FR"49+13 To Sta. "FR"49+17  
Inst. 18" Culk. Pipes - 126' (Total)  
5' Depth  
(For Details, See Sht. GE-5)  
(See Drg. No. RD3000)
- ⑨ Remove Exvg. Pipes - 2  
Trench Resurfacing - 138 Sq. Yd.  
(For Details, See Sht. 2B-8)  
(See Drg. No. RD302)
- ⑩ Sta. "L"72+07.5  
Sta. "L"72+16  
Sta. "L"72+24.5  
Const. Shallow Manhole - 3  
Inst. 42" Culk. Pipe - 384' (Total)  
10' Depth  
Inst. 36" Culk. Pipe - 210' (Total)  
5' Depth  
Const. Paved End Slope - 740 Sq. Ft.  
Const. Riprap (Class 100) - 10 Cu. Yd.  
Inst. Riprap Geotextile (Type 1) - 21 Sq. Yd.  
Trench Resurf. - 211 Sq. Yd.  
(For Details, See Shts. GE-5 & 2B-8)  
(See Drg. Nos. RD300, RD320, RD342, RD356  
RD386, RD390 & RD391)
- ⑪ Side Slope At Pipes  
Contour Grading Plan  
(For Details, See Sht. GN)

- ⑫ Loop Depression  
Contour Grading Plan  
(For Details, See Sht. GN)
- ⑬ Sta. "W"7+98 To Sta. "W"9+37.2  
Inst. 54" Culk. Pipes - 671' (Total)  
10' Depth  
Const. Paved End Slope - 1770 Sq. Ft.  
(For Details, See Shts. GE-3 & GE-5)  
Const. Riprap (Class 100) - 15 Cu. Yd.  
Inst. Riprap Geotextile (Type 1) - 38 Sq. Yd.  
(See Drg. No. RD300)
- ⑭ Sta. "P"3+25, Lt.  
Const. Type "G-2MA" Mod. Inlet  
Inst. 12" Sew. Pipe - 31.5'  
5' Depth  
(For Details, See Sht. 2B-3)
- ⑮ Sta. "P"3+25, Lt.  
Const. Type "CG-2" Inlet - 2  
Inst. 12" Sew. Pipe - 15'  
5' Depth
- ⑯ Sta. "P"2+25, Lt. & Rt.  
Const. Type "CG-2" Inlet - 2  
Inst. 12" Sew. Pipe - 156'  
5' Depth  
Trench Resurfacing - 9 Sq. Yd.
- ⑰ Sta. "P"1+07, Rt.  
Const. Type "CG-2" Inlet - 3  
Inst. 12" Sew. Pipe - 30'  
5' Depth
- ⑱ Sta. "P"1+07, Lt.  
Const. Type "CG-2" Inlet - 3  
Inst. 12" Sew. Pipe - 208'  
5' Depth
- ⑲ Sta. "P"1+25 To Sta. "P"1+01.8, Lt.  
Const. Type "G-2" Inlet - 2  
Inst. 12" Sew. Pipe - 24'  
5' Depth
- ⑳ Sta. "P"0+83.4, 68' Lt.  
Const. Manhole With Inlet  
Inst. 12" Sew. Pipe - 48'  
5' Depth  
(See Drg. No. RD348)
- ㉑ Sta. "P"0+69, Lt.  
Const. Manhole  
Inst. 18" Sew. Pipe - 34'  
5' Depth
- ㉒ Sta. "L"75+23.7, Lt.  
Const. Manhole  
Inst. 12" Sew. Pipe - 21'  
5' Depth  
Inst. 18" Sew. Pipe - 97'  
5' Depth  
Trench Resurfacing - 30 Sq. Yd.  
(For Details, See Sht. 2B-8)
- ㉓ Sta. "P"73+73, Lt.  
Const. Type "G-2" Inlet - 2  
Inst. 12" Sew. Pipe - 125'  
5' Depth
- ㉔ Sta. "L"75+23.7 To Sta. "B"1+3+99  
Inst. 18" Sew. Pipe - 22'  
5' Depth
- ㉕ Const. Biorotation Cell  
Const. Diversion M.H.  
(For Details, See Sht. GJ-2, Note 2)
- ㉖ Wolcott Road Depression  
Contour Grading Plan  
(For Details, See Sht. GN)
- ㉗ Relocate Power Pole - 7  
(By Others)
- ㉘ Relocate Communication Riser  
(By Others)
- ㉙ Relocate Telephone M.H.  
(By Others)
- ㉚ Relocate Water Valve  
(By Others)
- ㉛ Adjust Gas Valve Boxes - 2  
(By Others)
- ㉜ Sta. "W"1+55, Rt.  
Const. Type "D" Inlet  
Inst. 12" Sew. Pipe - 70'  
5' Depth

No.	DATE	REVISIONS	BY
△	02-14-11	Added Note	K.F.

REGISTERED PROFESSIONAL  
ENGINEER  
14,931  
*Carol A. Cartwright*  
OREGON  
JULY 25, 1991  
CAROL A. CARTWRIGHT

**OREGON DEPARTMENT OF TRANSPORTATION**

**REGION 2 TECH CENTER**

DR34: ROCHE STREET - WOLCOTT ROAD SEC.  
CORVALLIS - LEBANON HIGHWAY  
LINN COUNTY


Design Team Leader - Carol Cartwright  
Designed By - Kathy Fry  
Drafted By - Jeff Larson

**NOTES**


SHEET  
NO.  
**7B-2**

REVISIONS: 12-31-2011



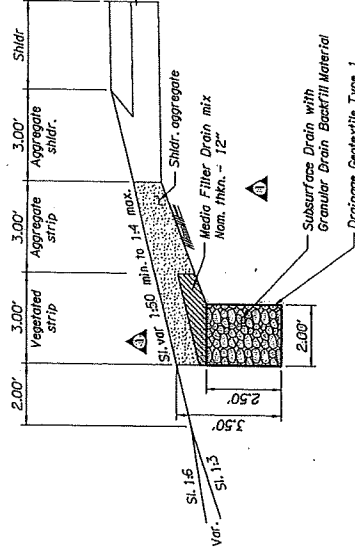

**BIOSLOPE SECTION**  
1:50 MIN. SLOPE

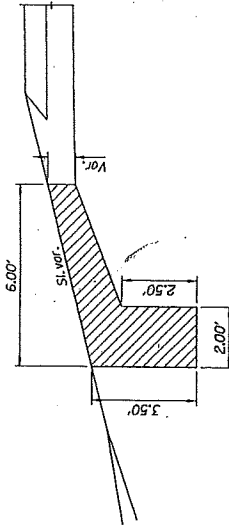

**BIOSLOPE EXCAVATION**

NOTE:  
Side-slopes are shown as vert. to horiz.

OREGON DEPARTMENT OF TRANSPORTATION

REGION 2 TECH CENTER


OR94: ROCHE STREET - WOLCOTT ROAD SEC.  
CORVALLIS LEBANON HIGHWAY  
LINK CEBBY

Reviewed By - Bruce Cornehoar, P.E.  
Designed By - Bo Miller, P.E.  
Drafted By - Sandra Gish


SHEET NO. GJ  
STORMWATER  
BIOSLOPE DETAILS

REGISTERED PROFESSIONAL ENGINEER  
14475  
*Bo Miller*  
OREGON  
JULY 26, 1988  
BO MILLER RET.  
RENEWS: 12-31-2012


No.	DATE	REVISIONS	BY
1	04-12-11	Modified detail, removed note	BM

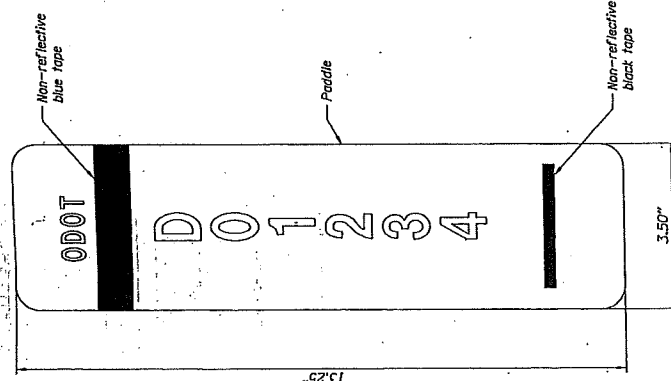


TYPE S2 MARKER  
(STATE SUPPLIED ITEM)

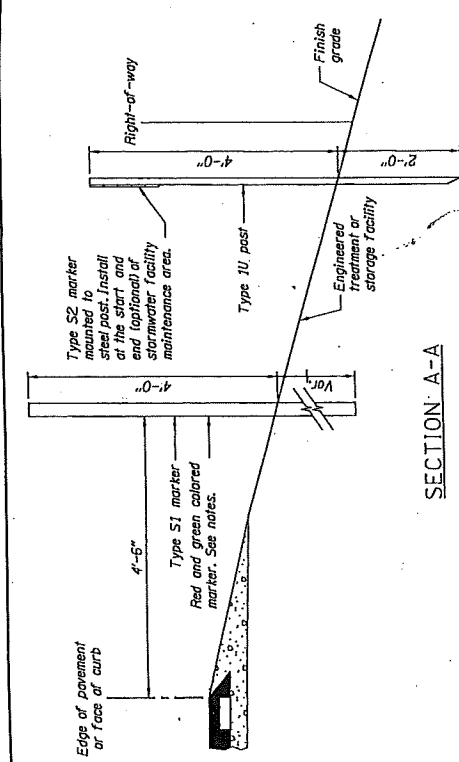

SECTION A-A

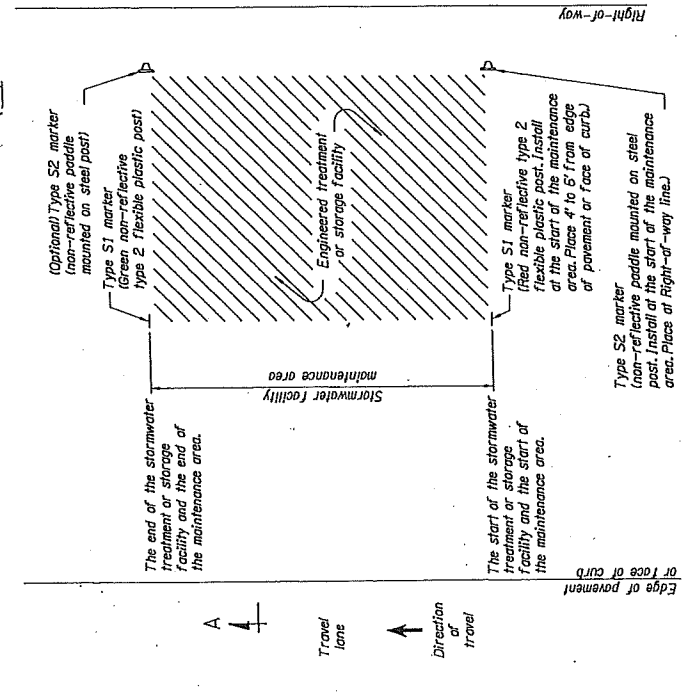

TYPE S1 & S2 MARKERS INSTALLATION DETAIL

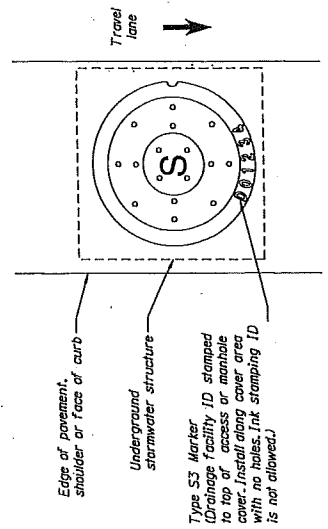

TYPE S3 MARKER INSTALLATION DETAIL

MARKER TABLE

STATION	FACILITY LOCATION	DFI NO.	TYPE S2 MARKER LOCATION		TYPE S1 MARKER		TYPE S3 MARKER	
			BEGIN	END	RED	GREEN	BEGIN	END

✓ Check where appropriate  
Red = Beginning of facility  
Green = End of facility

NOTES:

- Stormwater Facility Field Marker Type S1:**
- See Standard Drawing TM570 For Type 2 Flexible plastic post dimensions. Do not mount reflective sheathing to flexible plastic post.
  - A red Type S1 marker is used to mark the start of a stormwater facility maintenance area. A green Type S1 marker is used to mark the end of a stormwater facility maintenance area.
  - Place 4 to 6 feet from edge of pavement or face of curb.
  - See marker table for installation locations.
- Stormwater Facility Field Marker Type S2:**
- Paddle:
    - Aluminum sheet, nominal thickness 0.050"
    - White non-reflective background
    - Mount paddle to one (1) Type 1U steel post using 3/8" diameter aluminum blind rivets and washers. See Standard Drawing TM 570 detail labeled "Steel Posts" for mounting a traffic target. Install paddle onto Type 1U steel post using the same hole pattern.
    - Text and numbers are Type C font in non-reflective black
    - Band is non-reflective blue tape
    - Do not install paddle to other highway signing posts
    - Install paddle parallel to travel lane
    - Print paddle for each "DFI" noted in the marker table
  - Steel Posts:
    - See Standard Drawing TM571 For Type 1U steel post dimensions
- Stormwater Facility Field Marker Type S3:**
- The top of access or manhole cover shall be stamped with the drainage facility ID. Ink stamping ID is not allowed.

**OREGON DEPARTMENT OF TRANSPORTATION**

**REGION 2 TECH CENTER**

OR94: ROCHE STREET - WOLCOTT ROAD SEC. CORVALLIS - LEBANON HIGHWAY LINN COUNTY

Reviewed by - Angela J. Kasper  
Designed by - Tandra Mortensen  
Directed by - Jeff Larson

**REGISTERED PROFESSIONAL ENGINEER**  
14475  
BO Miller  
JULY 26, 1989  
OREGON 688  
BO MILLER  
RELS

**STORMWATER DETAILS**

SHEET NO. GJ

REVISIONS: 12-31-2010