

# **OPERATION & MAINTENANCE MANUAL**

**DFI No. : D00193**

**Facility Type: Water Quality Biofiltration  
Swale**



**JUNE, 2011**

**INDEX**

**1. IDENTIFICATION..... 1**

**2. FACILITY CONTACT INFORMATION..... 1**

**3. CONSTRUCTION..... 1**

**4. STORM DRAIN SYSTEM AND FACILITY OVERVIEW ..... 2**

**5. FACILITY HAZ MAT SPILL FEATURE(S)..... 4**

**6. AUXILIARY OUTLET (HIGH FLOW BYPASS)..... 4**

**7. MAINTENANCE REQUIREMENTS..... 5**

**8. WASTE MATERIAL HANDLING..... 5**

**APPENDIX A: Operational Plan and Profile Drawing(s)**

**APPENDIX B: ODOT Project Plan Sheets**

## 1. Identification

Drainage Facility ID (DFI): **D00193**  
Facility Type: Water Quality Biofiltration Swale  
Construction Drawings: (V-File Number) 39V-010  
Location: District: 2B (Old 2A)  
Highway No.: 140  
Mile Post: 4.80/4.81 (beg./end)  
Description: This facility is located on the west side of Hillsboro-Silverton Highway, Hwy 140 (OR 214), alongside SW Unger Road, south of Hillsboro. Access would be from either Unger Road or Hwy 140 (OR 214).

## 2. Facility Contact Information

Contact the Engineer of Record, Region Technical Center, or Geo-Environmental's Senior Hydraulics Engineer for:

- Operational clarification
- Maintenance clarification
- Repair or restoration assistance

### Engineering Contacts:

Region Technical Center Hydro Unit Manager

Or

Geo-Environmental Senior Hydraulics Engineer (503) 986-3365.

## 3. Construction

Engineer of Record: ODOT Designer – Region 2 Tech. Center, Daniel Gunther, P.E., (503) 986-2990

Facility construction: 2005  
Contractor: N/A

#### 4. Storm Drain System and Facility Overview

A water quality swale is a flat-bottomed open channel designed to treat stormwater runoff from highway pavement areas. This type of facility is lined with grass. Treatment by trapping sedimentation occurs when stormwater runoff flows through the grass.

This water quality Biofiltration swale is located on the west side of Hillsboro-Silverton Highway, Hwy 140 (OR 214), alongside SW Unger Road, south of Hillsboro Hillsboro when approaching Farmington Road from the north. Access would be from either Unger Road or Hwy 140 (OR 214).

An 18-inch diameter pipe conveys stormwater from another water quality swale (DFI\_D00194) across the highway into this 100-foot long facility; see Point A on the Operational Plans. Once in the facility the stormwater flows southward toward a rock check dam; see Point B on the Operational Plans. The stormwater flows from the swale into an existing ditch that runs adjacent to the facility. The ditch abuts the facility on its south side, moving water eastward, beneath the highway inside of a 30-inch diameter pipe and out beyond the right-of-way.

A. Maintenance equipment access:

Access would be from either Unger Road or Hwy 140 (OR 214).

B. Heavy equipment access into facility:

- Allowed (no limitations)
- Allowed (with limitations)
- Not allowed

C. Special Features:

- Amended Soils
- Porous Pavers
- Liners
- Underdrains

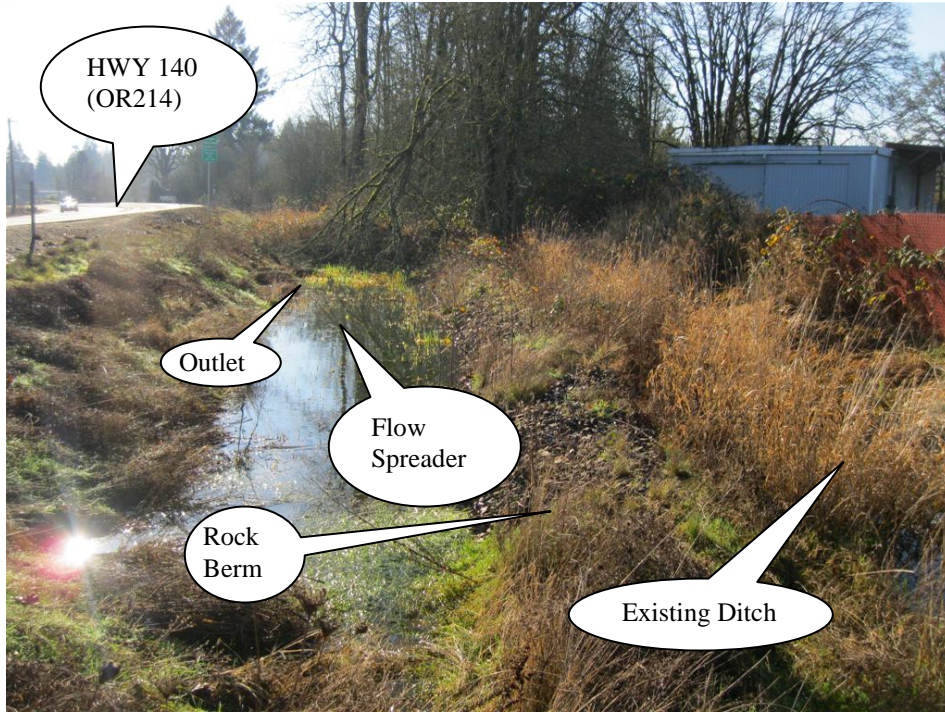


Photo 1: Facing south, this shows almost the whole facility and all the components.

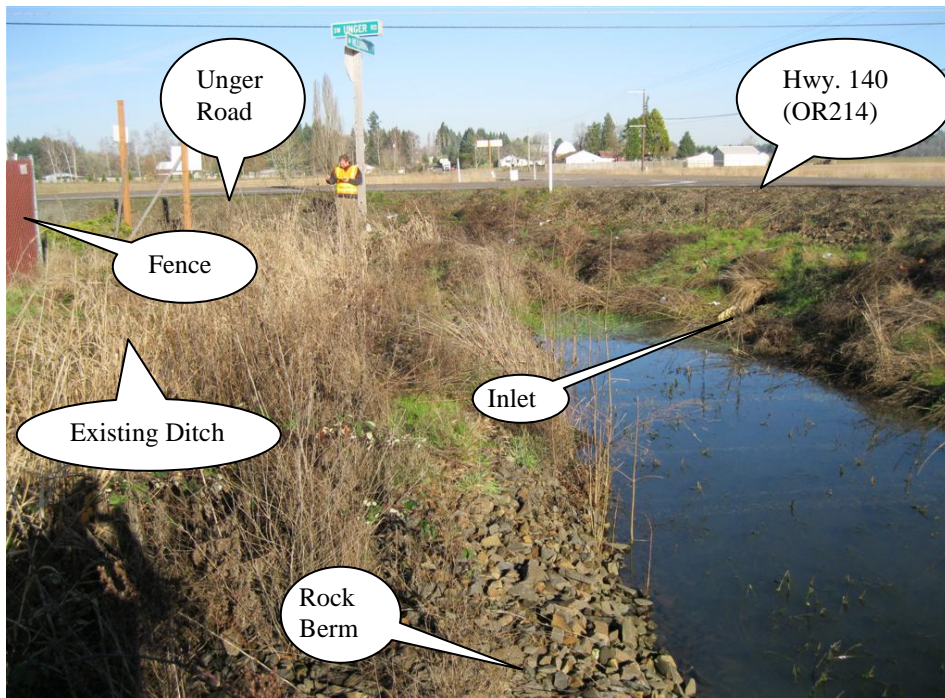


Photo2: Facing north, shows the inlet and the how the ditch runs adjacent to the swale.



Photo 3: Facing south, looking at the outlet.

## 5. Facility Haz Mat Spill Feature(s)

The water quality biofiltration swale and existing ditch can be used to store a volume of liquid by blocking the 30 inch-diameter outlet pipe located near the outlet of the water quality biofiltration swale. This pipe is located to the south and east of the swale as shown on the Operational Plans.

## 6. Auxiliary Outlet (High Flow Bypass)

Auxiliary Outlets are provided if the primary outlet control structure can not safely pass the projected high flows. Broad-crested spillway weirs and over flow risers are the two most common auxiliary outlets used in stormwater treatment facility design. The auxiliary outlet feature is either a part of the facility or an additional storm drain feature/structure.

The auxiliary outlet feature for this facility is:

Designed into facility

Other, as noted below

There are no auxiliary outlet features for this facility

## 7. Maintenance Requirements

Routine maintenance table for non-proprietary stormwater treatment and storage/detention facilities have been incorporated into ODOT's Maintenance Guide. These tables summarize the maintenance requirements for ponds, swales, filter strips, bioslopes, and detention tanks and vaults. Special maintenance requirements in addition to the routine requirements are noted below when applicable.

The ODOT Maintenance Guide can be viewed at the following website:

<http://www.oregon.gov/ODOT/HWY/OOM/MGuide.shtml>

Maintenance requirements for proprietary structures, such as underground water quality manholes and/or vaults with filter media are noted in Appendix C when applicable.

The following stormwater facility maintenance table (See ODOT Maintenance Guide) should be used to maintain the facility outlined in this Operation and Maintenance Manual or follow the Maintenance requirements outlined in Appendix C when proprietary structure is selected below:

- Table 1 (general maintenance)
- Table 2 (stormwater ponds)
- Table 3 (water quality biofiltration swales)
- Table 4 (water quality filter strips)
- Table 5 (water quality bioslopes)
- Table 6 (detention tank)
- Table 7 (detention vault)
- Appendix C (proprietary structure)
- Special Maintenance requirements:

Note: Special maintenance Requirements Require Concurrence from ODOT SR Hydraulics Engineer.

## 8. Waste Material Handling

Material removed from the facility is defined as waste by DEQ. Refer to the roadwaste section of the ODOT Maintenance Yard Environmental Management System (EMS) Policy and Procedures Manual for disposal options: <http://egov.oregon.gov/ODOT/HWY/OOM/EMS.shtml>

Contact any of the following for more detailed information about management of waste materials found on site:

ODOT Clean Water Unit

(503) 986-3008


ODOT Statewide Hazmat Coordinator (503) 229-5129  
ODOT Region Hazmat Coordinator (503) 731-8304  
ODEQ Northwest Region Office (503) 229-5263




# Appendix A

## Content:


- **Operational Plan and Profile Drawing(s)**

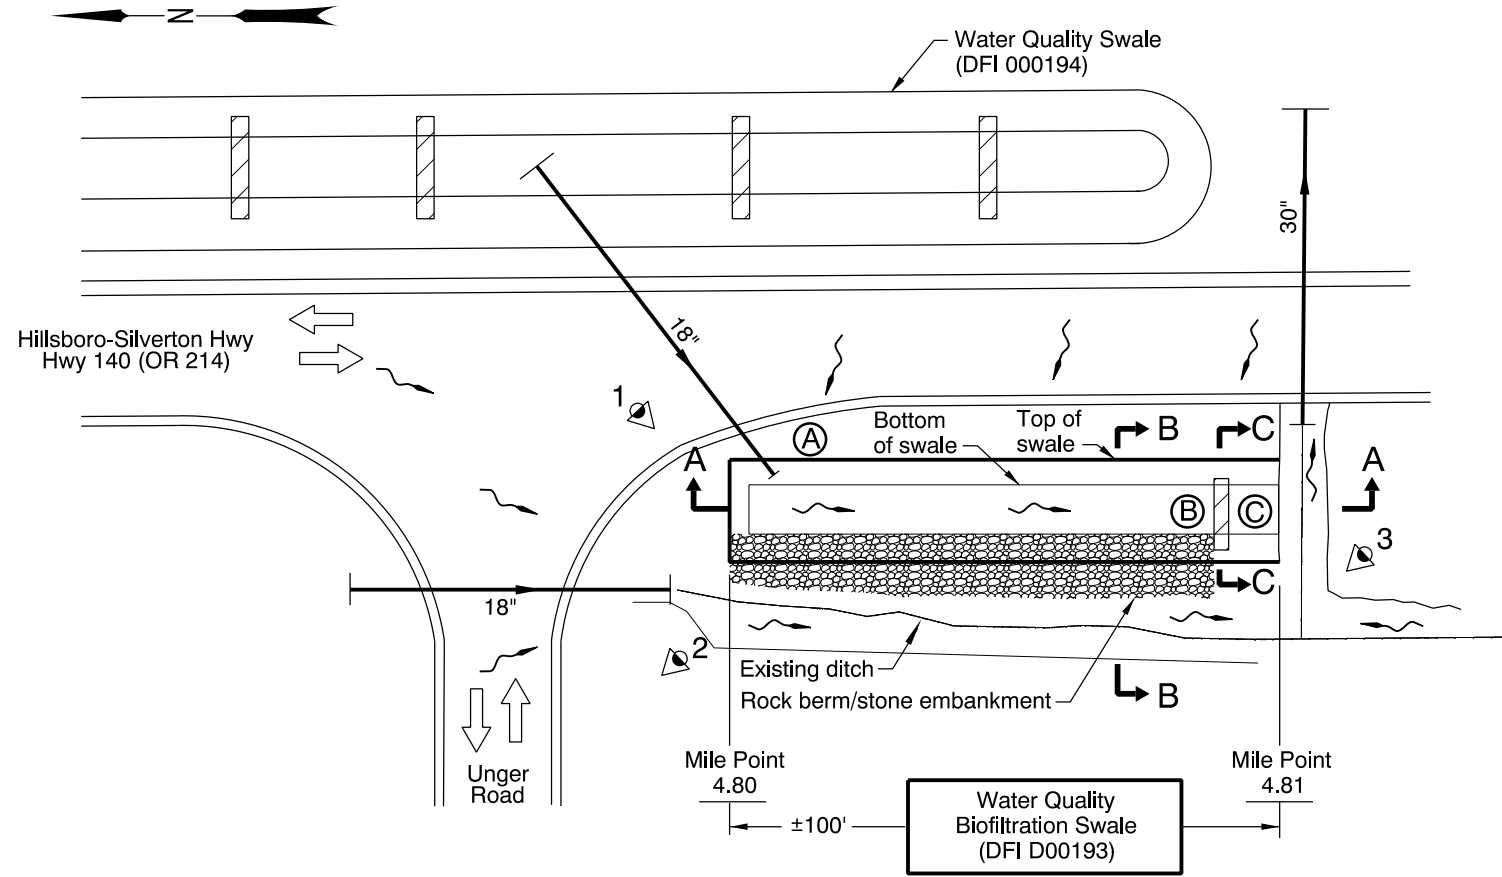

**PLAN**  
N.T.S.

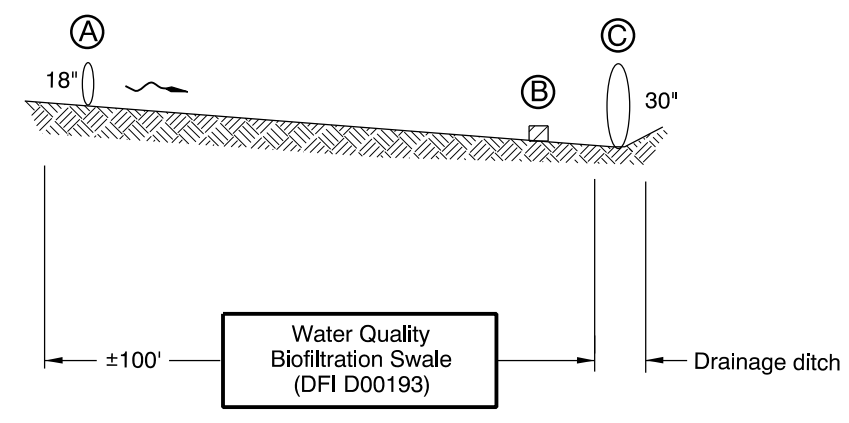


**SECTION A-A**  
N.T.S.

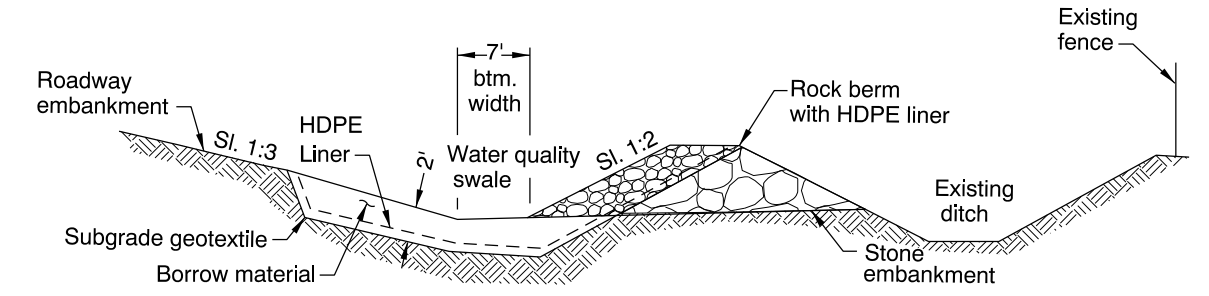

**SECTION B-B**  
N.T.S.

**Design Note:**  
A rock berm was created to separate the water quality swale from the drainage ditch. The rock berm contains a waterproof HDPE liner.

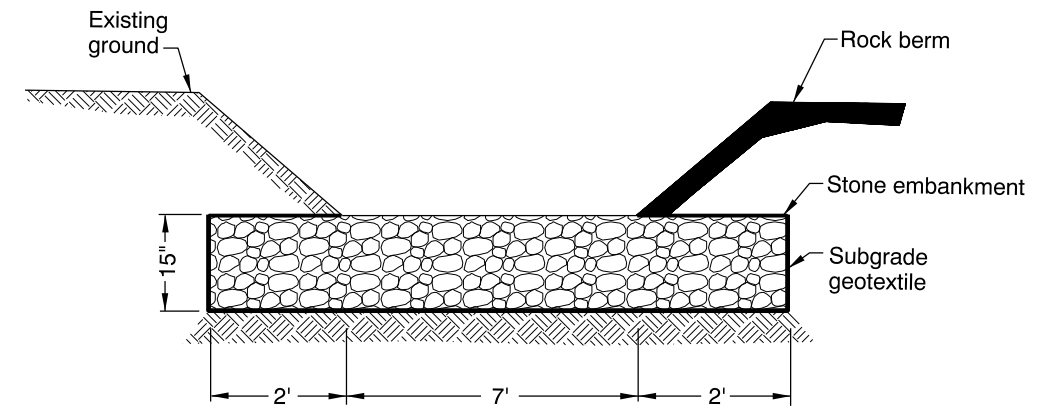

**SECTION C-C**  
N.T.S.

- LEGEND:**
- Photo Location / Direction
  - Swale Inlet is 18" pipe
  - Rock check dam flow spreader
  - Swale outlet is drainage ditch which flows to 30" pipe
  - Storm Pipe (Facility)
  - Conveyance Direction
  - Pavement / Facility Flow Path
  - Traffic Directional Flow

Sht. 1 of 1 OREGON DEPARTMENT OF TRANSPORTATION

Prepared By: J.D. Koziol  
Drafted By: Rodney Schultz

**DFI D00193**  
**MAINTENANCE DISTRICT 2B HWY 140**  
**WATER QUALITY BIOFILTRATION SWALE**  
HILLSBORO-SILVERTON HWY MP 4.80-4.81  
WASHINGTON COUNTY

# Appendix B

## Content:


- **ODOT Project Plan Sheets**
  - *Cover/Title Sheet*
  - *Water Quality/Detention Plan Sheets*
  - *Other Details*

INDEX OF SHEETS	
SHEET NO.	DESCRIPTION
1	Title Sheet
1A	Title Sheet Continued
2, 2A	Typical Sections
2B	Details
2C Thru 2C-3 Incl.	Traffic Control Plans
2D	Pipe Data Sheet
3	Alignment & General Construction
3A	Drainage & Utilities
4	Alignment & General Construction
4A	Drainage & Utilities
4B	Profile
5	Alignment & General Construction
5A	Drainage & Utilities
5A-2	Notes
6	Alignment & General Construction
6A	Drainage & Utilities
PERMANENT PAVEMENT MARKINGS	
ST, ST-2	Striping Plan
GEO/HYDRO	
GA Thru GA-4 Incl.	Erosion Control Plans
GJ, GJ-2	Water Quality Details
PERMANENT SIGNING	
S-08492 Thru S-08496 Incl.	Signing Plan

STATE OF OREGON  
 DEPARTMENT OF TRANSPORTATION  
 PLANS FOR PROPOSED PROJECT

GRADING, DRAINAGE, PAVING, STRIPING, & SIGNING

**OR219: HILLSBORO - SILVERTON HWY.  
 AT UNGER RD. SEC.  
 HILLSBORO - SILVERTON HIGHWAY  
 WASHINGTON COUNTY  
 NOVEMBER 2005**

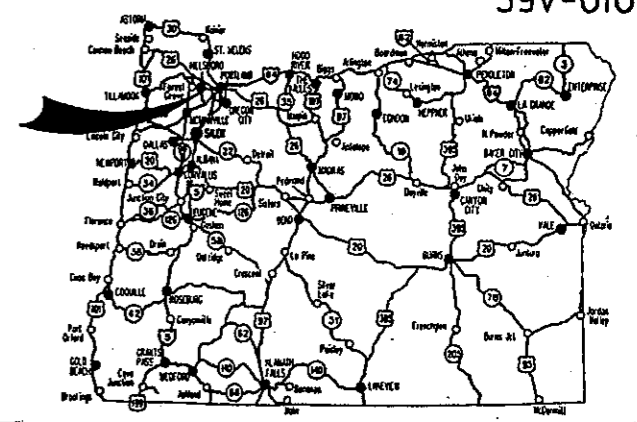

Overall Length Of Project - 0.96 km (0.59 Miles)

AS  
 CONSTRUCTED  
*Wayne A. Statler*  
 PROJECT MANAGER  
 2 MAR 2007  
 DATE

**ATTENTION:**  
 Oregon Law Requires You To Follow Rules Adapted By The Oregon Utility Notification Center. Those Rules Are Set Forth In OAR 952-001-0010 Through OAR 952-001-0090. You May Obtain Copies Of The Rules By Calling The Center. (Note: The Telephone Number For The Oregon Utility Center Is (503) 232-1987.)

LET'S ALL  
 WORK TOGETHER  
 TO MAKE THIS  
 JOB SAFE

- OREGON TRANSPORTATION COMMISSION**
- Stuart Foster CHAIRMAN
  - Gail L. Achterman COMMISSIONER
  - Mike Nelson COMMISSIONER
  - Randall Papé COMMISSIONER
  - Janice J. Wilson COMMISSIONER
  - Bruce A. Warner DIRECTOR OF TRANSPORTATION



REGISTERED PROFESSIONAL  
 ENGINEER  
 13,704  
 JULY 16, 1987  
 CATHERINE M. NELSON  
 Expires Dec. 31, 2006

Catherine M. Nelson  
 STATE HIGHWAY ENGINEER

OR219: HILLSBORO - SILVERTON HWY. AT UNGER RD. SEC. HILLSBORO - SILVERTON HIGHWAY WASHINGTON COUNTY		
FEDERAL HIGHWAY ADMINISTRATION	PROJECT NUMBER	SHEET NO.
OREGON DIVISION	X-STP-S140(030)	1



T. 1 S., R. 2 W.,  
 R 3 W., W.M.

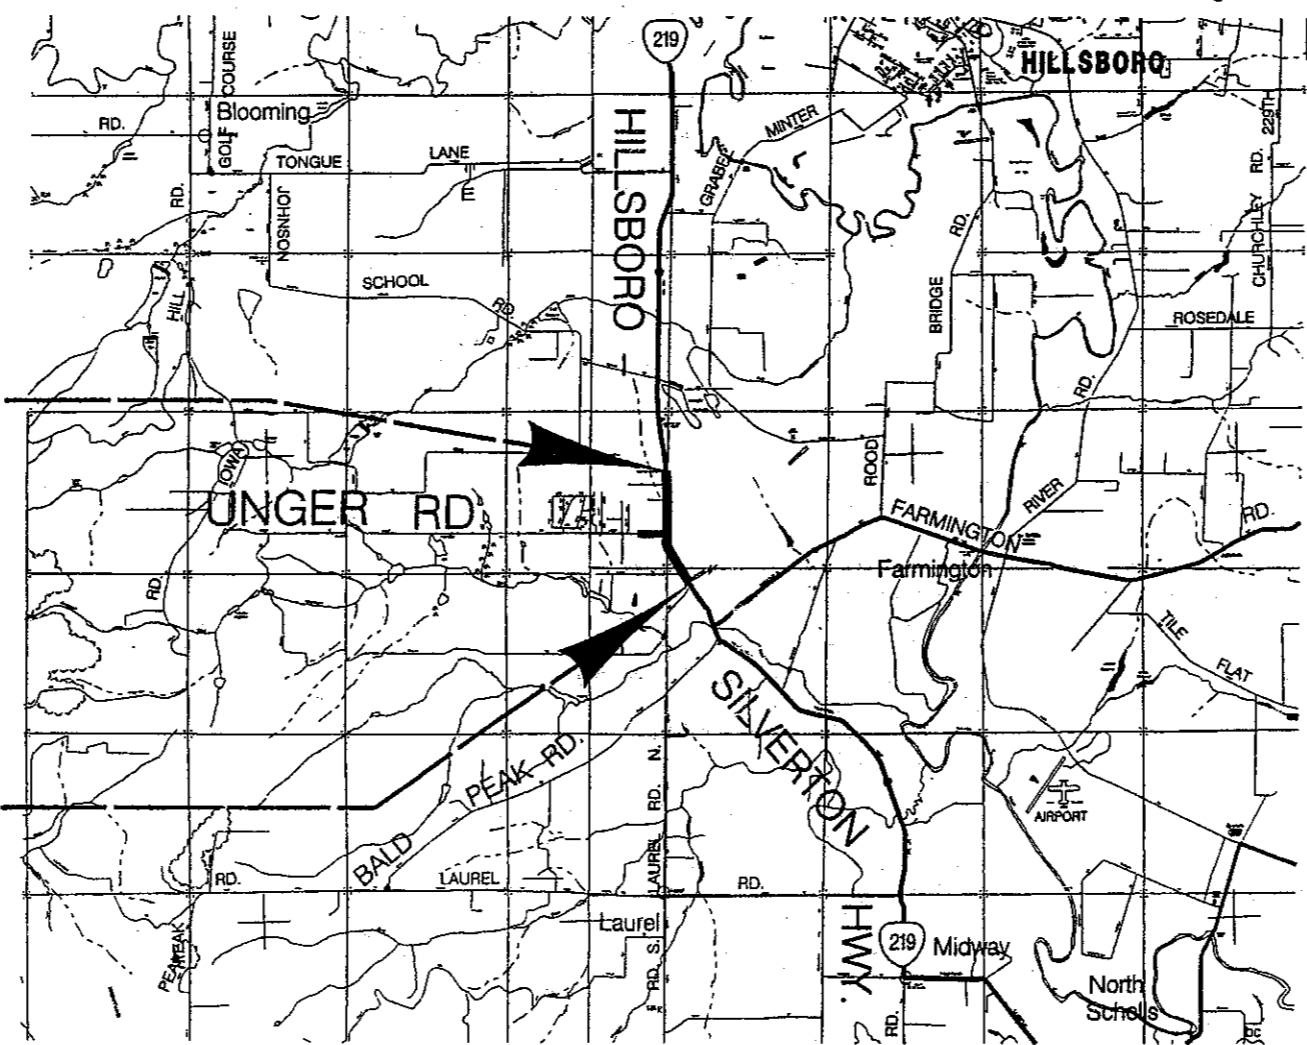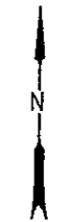


**BEGINNING OF PROJECT**

STA. "HS" 7+159 (M.P. 4.54)

**END OF PROJECT**

STA. "HS" 8+115 (M.P. 5.14)


PE000529 000

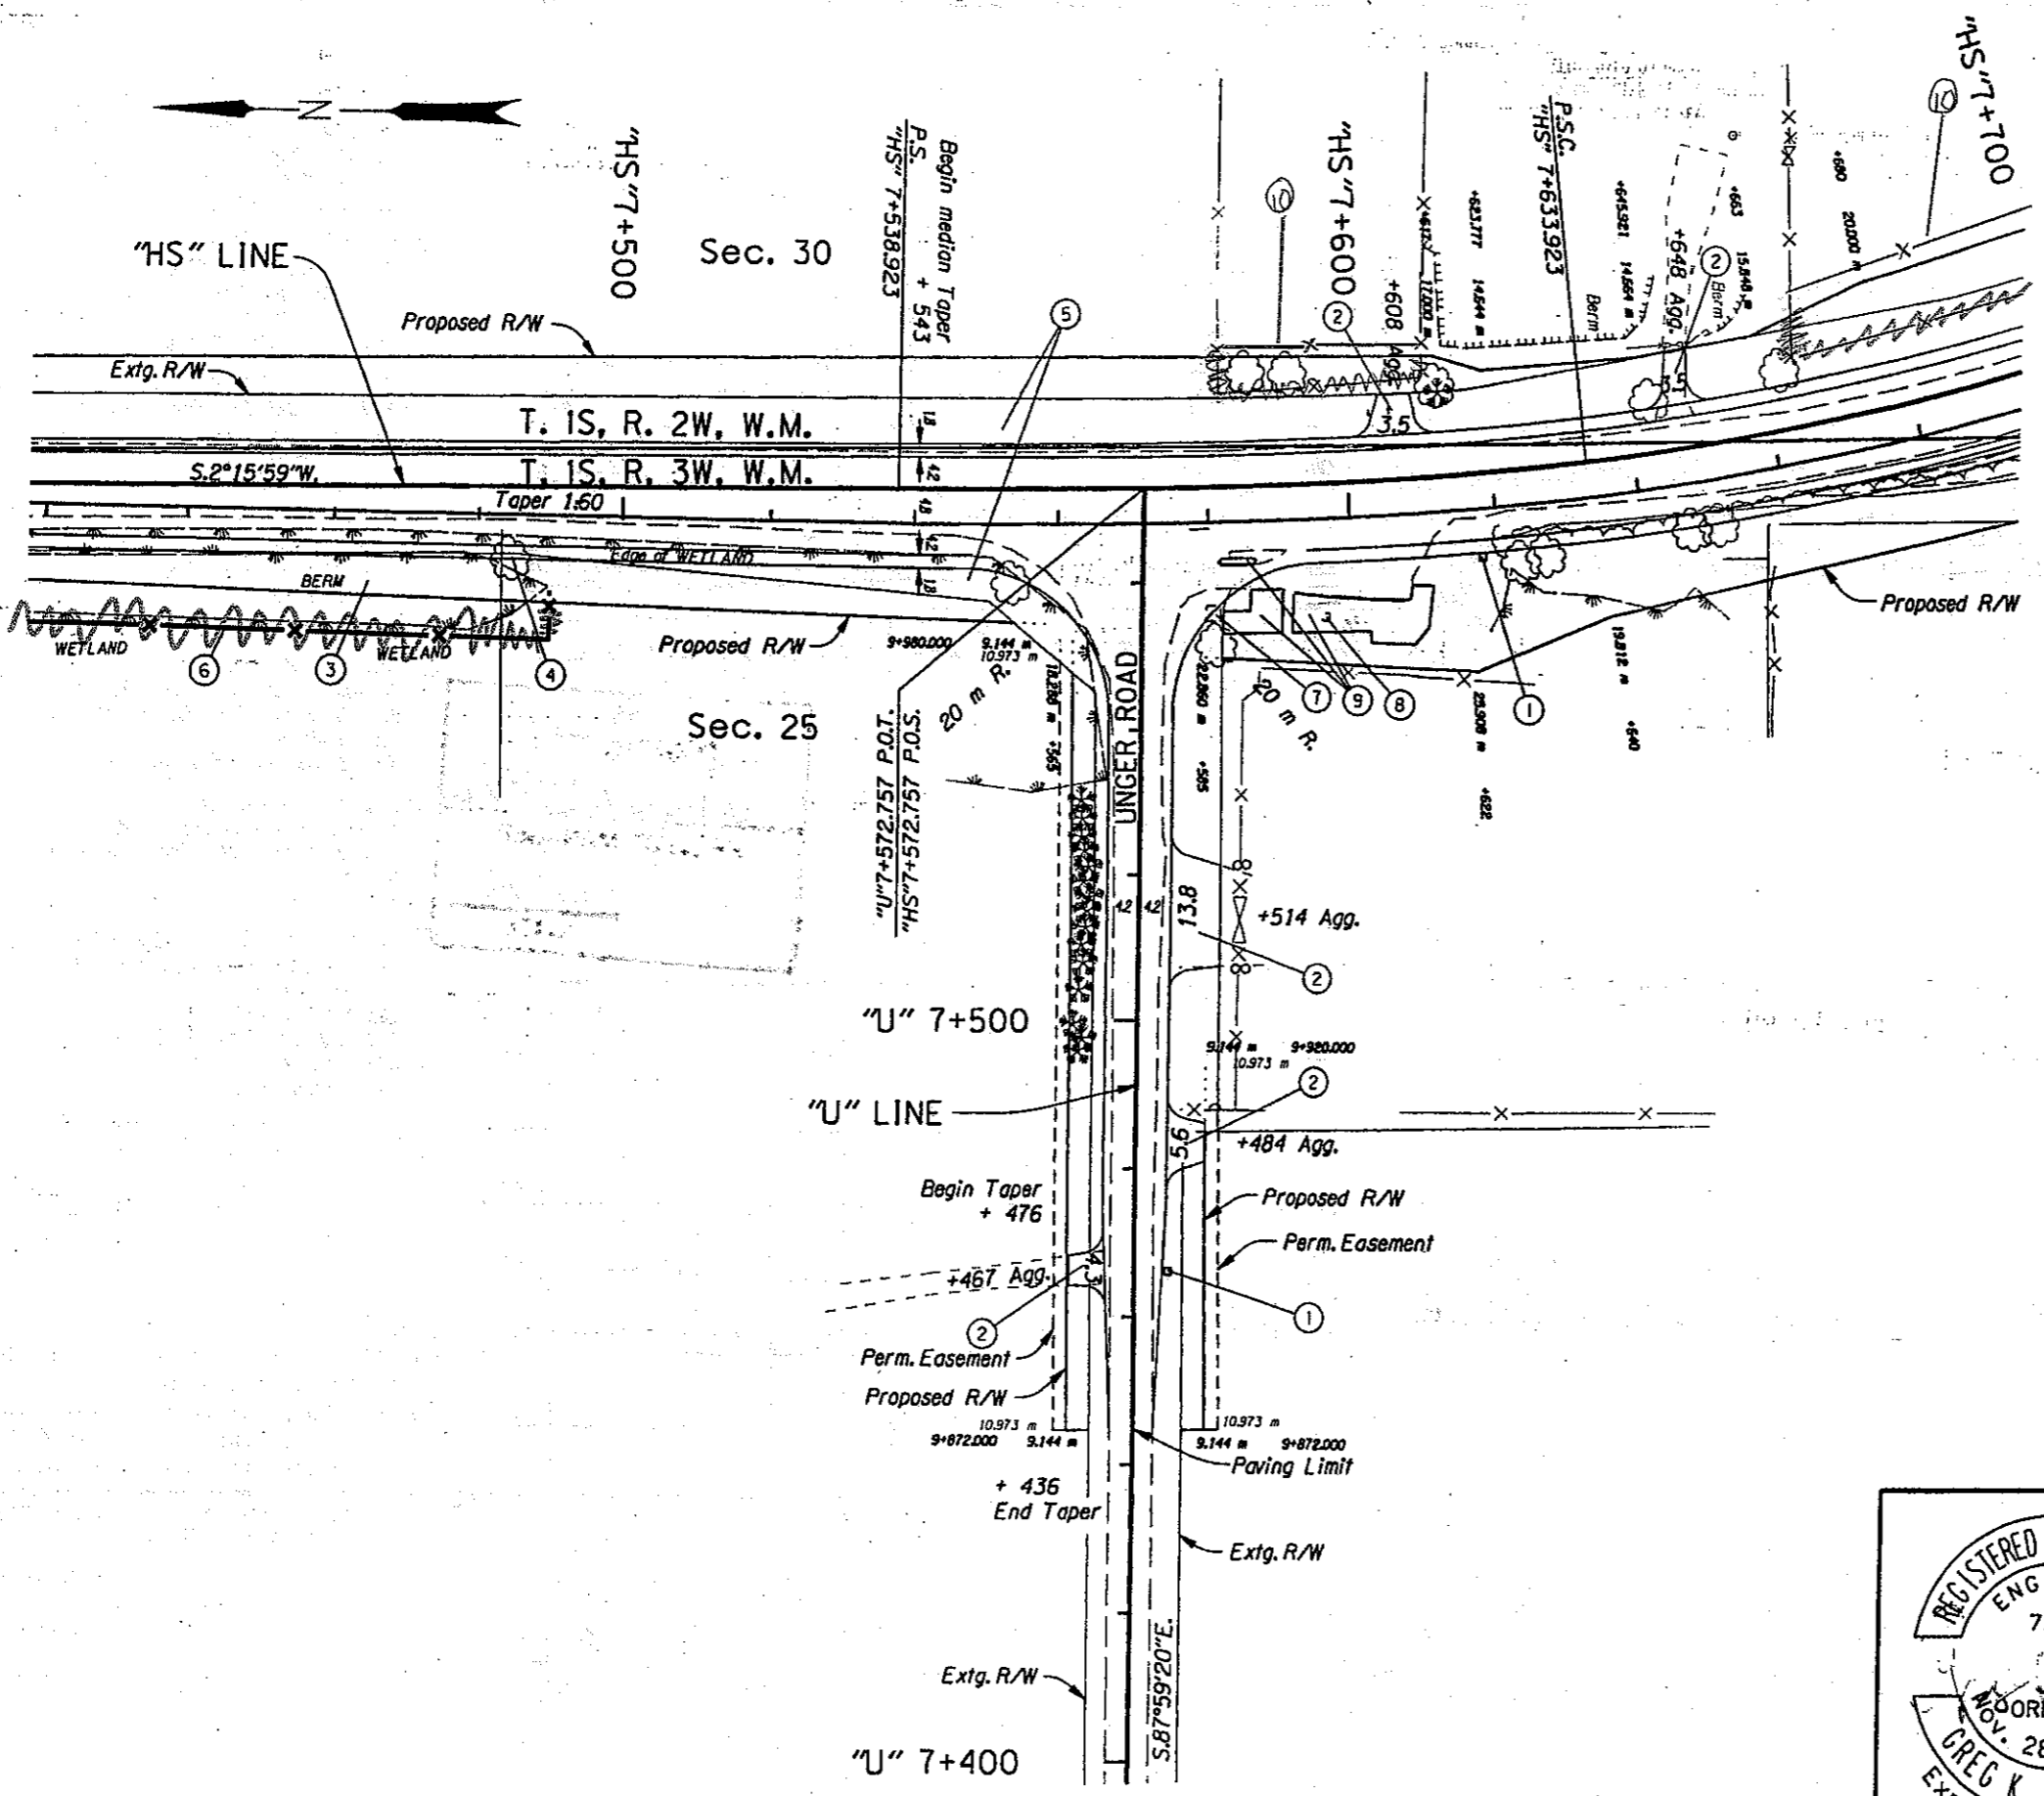


- ① Inst. Single Mailbox Support - 2  
Const. Conc. Collar  
(See Drg. No. RD100)
- ② Const. Asph. Conc. Approach - 5
- ③ See Note 4 On Sheet 3.
- ④ Remove Tree
- ⑤ Sta. "HS" 7+159 To "HS" 8+115 Lt. & Rt.  
Inst. Type 1 Delineators
- ⑥ Inst. Temp. Orange Plastic Mesh Delineation  
Fence. (As Directed)
- ⑦ Remove Underground Fuel Tank (By Others)
- ⑧ Remove 64 mm Steel Pipe  
(0.1 m Exposed, Possible Fuel Pipe  
For Underground Tank) (By Others)
- ⑨ Remove Conc. Pads - 42 m<sup>2</sup>  
(By Others)
- ⑩ Installed field fence

AS  
CONSTRUCTED  
*Wayne L. Statler*  
PROJECT MANAGER  
2 MAR 2007  
DATE

**NOTE:**  
1. All Dimensions Shown Are In Meters (m)  
Unless Otherwise Noted.  
2. Temp. Type Orange Plastic Mesh Delineation  
Fence Shown As Thus: —x—x—x—

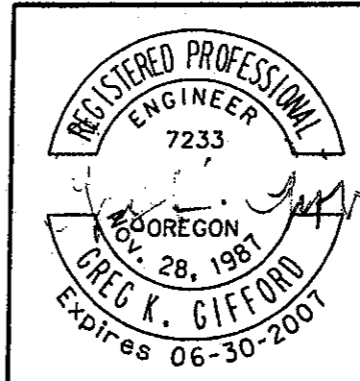

<b>OREGON DEPARTMENT OF TRANSPORTATION ROADWAY ENGINEERING SECTION</b>	
<b>OR219: HILLSBORO-SILVERTON HWY AT UNGER ROAD HILLSBORO-SILVERTON HIGHWAY WASHINGTON COUNTY</b>	
Project Leader - Sandy Van Bommel Designed By - Brian A. Davis Drafted By - David Hoase	
<b>ALIGNMENT &amp; GENERAL CONSTRUCTION</b>	SHEET NO. <b>4</b>

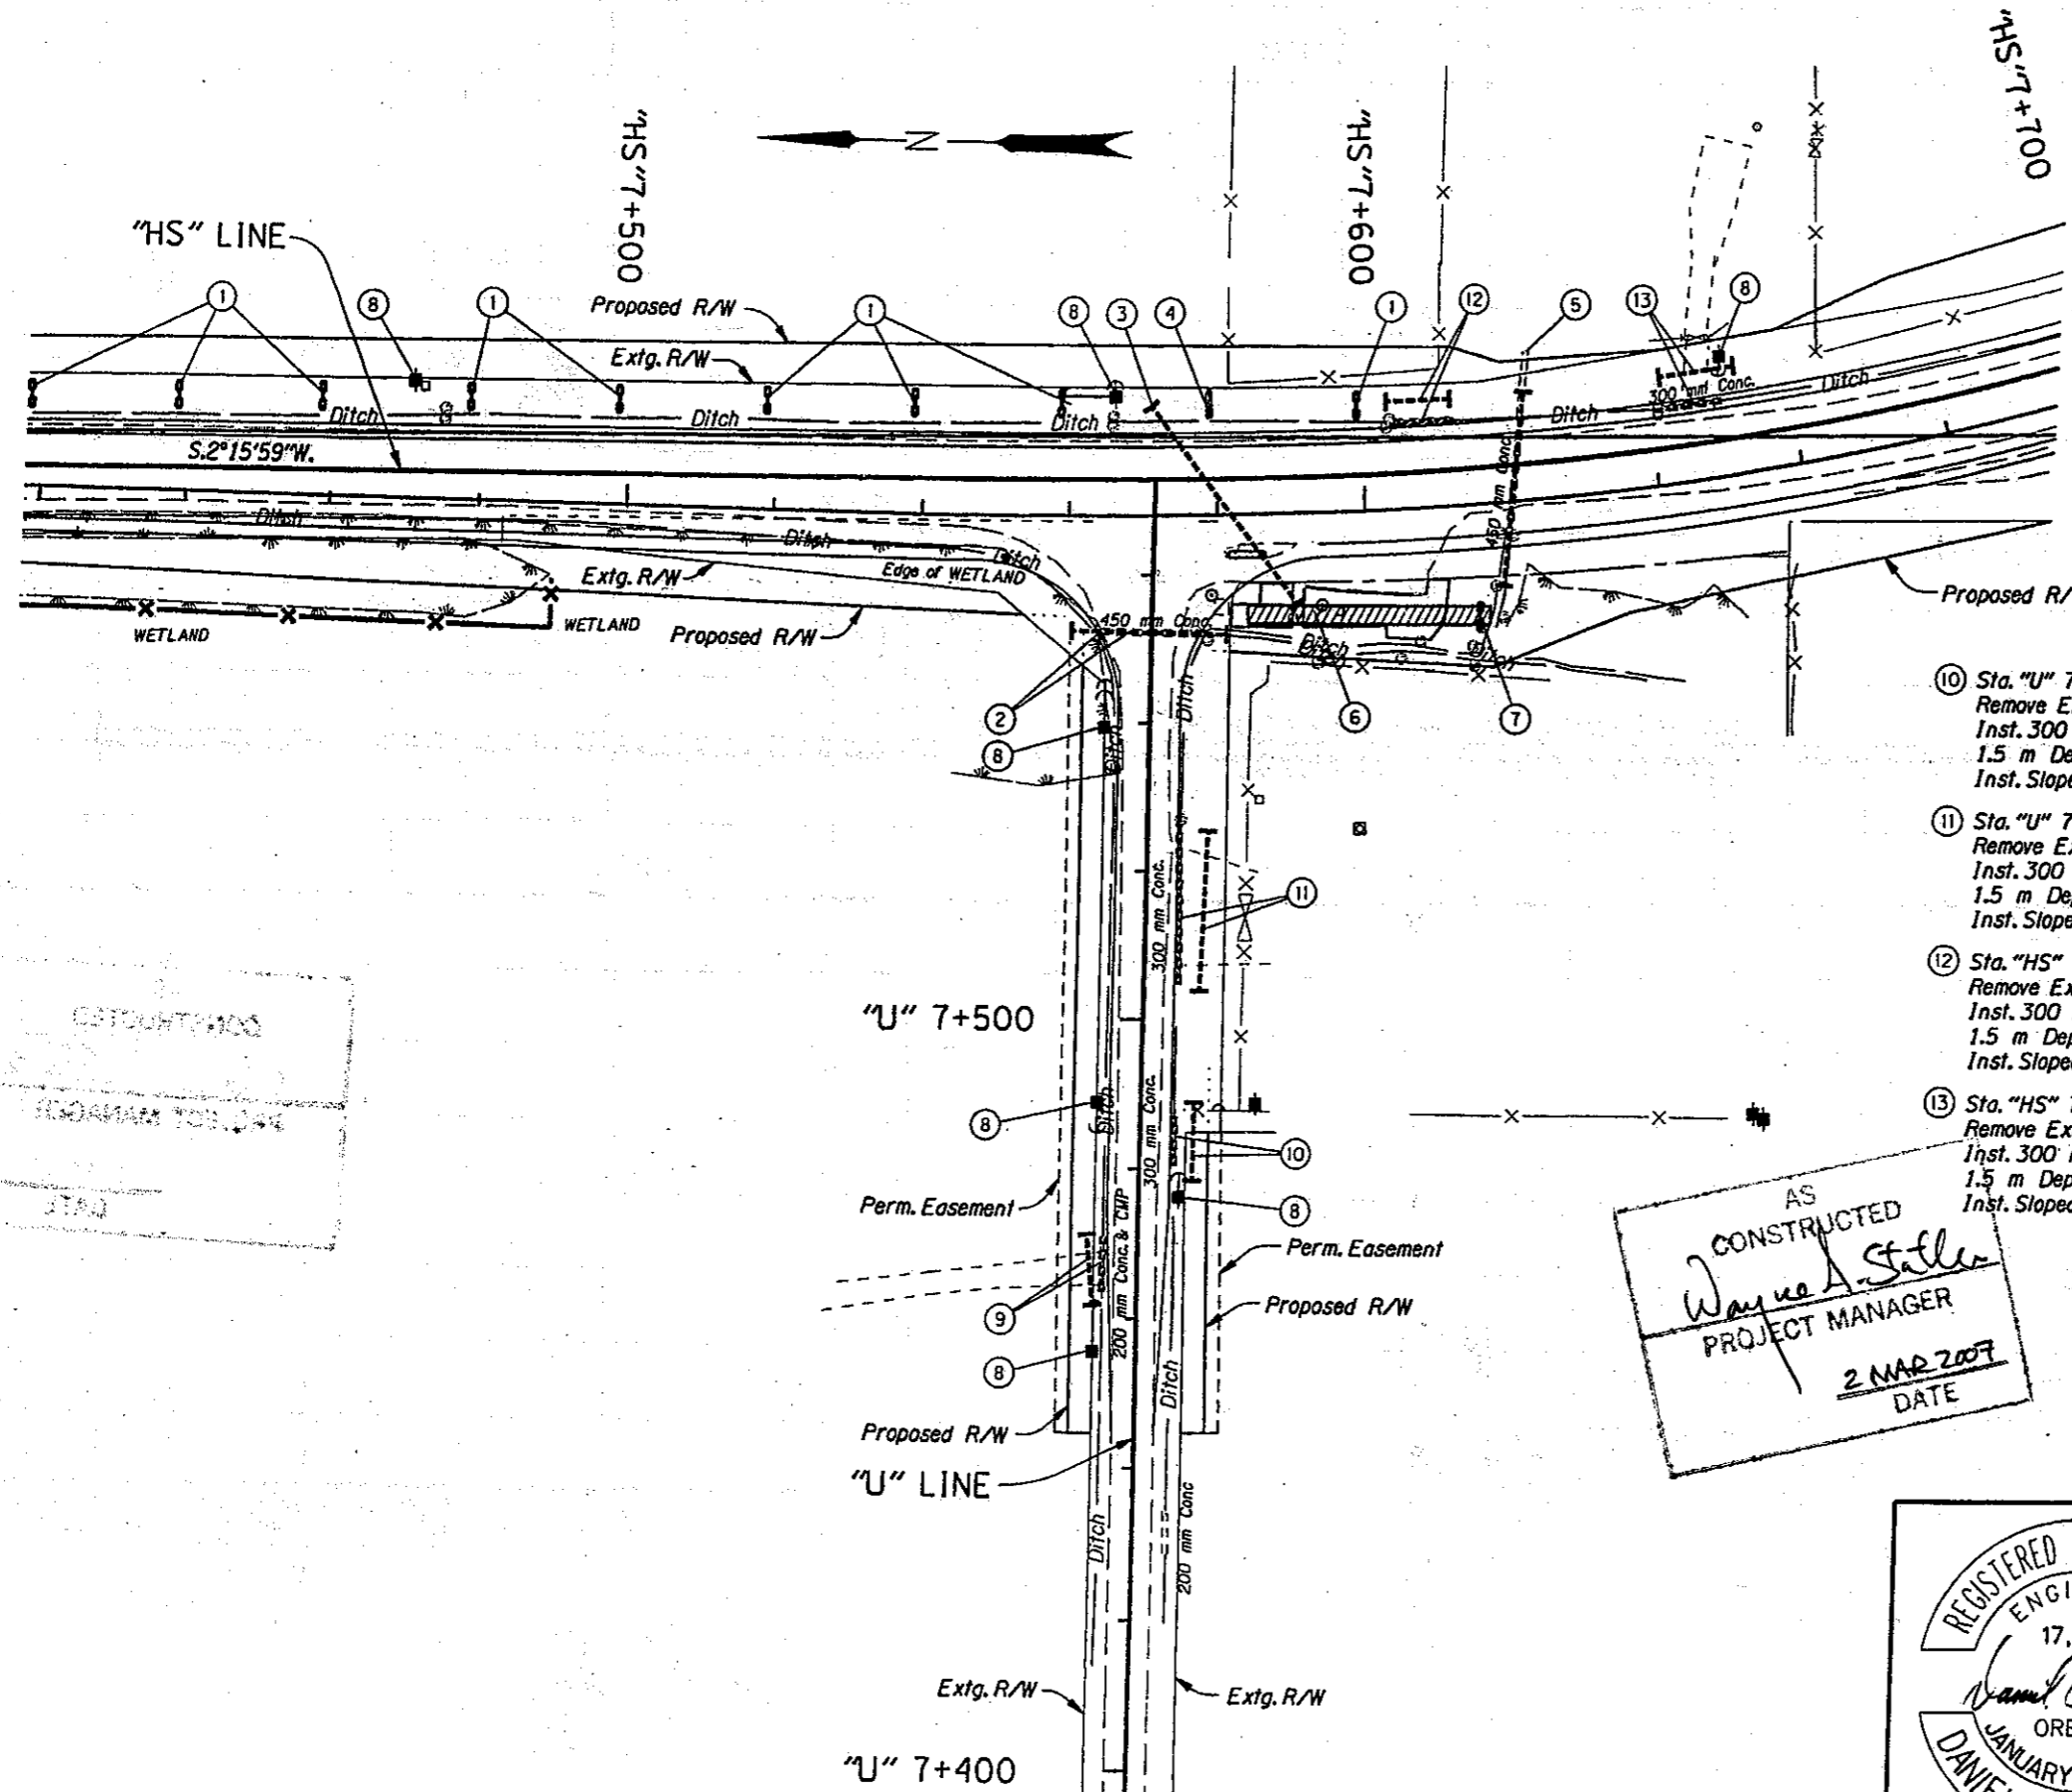

- ① See Sht. 3A, Note 7
- ② Sta. "U" 7+552, Lt.  
Remove Exist. Culv. Pipe - 18.0 m  
Inst. 600 mm Culv. Pipe - 22.2 m  
1.5 m Depth  
Inst. Sloped End Section - 2
- ③ Sta. "HS" 7+572, Lt.  
Inst. 450 mm Culv. Pipe - 35.2 m  
1.5 m Depth  
Inst. Sloped End Section - 2
- ④ Sta. "HS" 7+573, Lt.  
Const. Check Dam Type 1  
Dt. Exc. - 0.5 m<sup>3</sup>  
Stone Embankment - 0.5 m<sup>3</sup>  
Subgrade Geotextile - 6 m<sup>2</sup>  
(For Details, See Sheet GJ)  
(See Drg No. RD1005)
- ⑤ Sta. "HS" 7+622 Lt.  
Remove Exist. Culv. Pipe - 24 m  
Inst. 750 mm Culv. Pipe - 27.2 m  
1.5 m Depth  
Inst. Sloped End Section - 2
- ⑥ Sta. "FB" 0+013 to 0+046  
Const. Ditch  
Dt. Exc. - 64 m<sup>3</sup>  
Stone Embankment - 36 m<sup>3</sup>  
Subgrade Geotextile - 195 m<sup>2</sup>  
Ditch Liner (40 mm HDPE) - 195 m<sup>2</sup>  
(For Details, See Sheet GJ-2)
- ⑦ Sta. "FB" 0+044  
Const. Check Slot Structure - 1  
Dt. Exc. - 0.5 m<sup>3</sup>  
Stone Embankment - 0.5 m<sup>3</sup>  
Subgrade Geotextile - 6 m<sup>2</sup>
- ⑧ Relocate Utility Pole - 7  
(By others)
- ⑨ Sta. "U" 7+464, Lt.  
Remove Exist. Culv. Pipe - 7.0 m  
Inst. 300 mm Culv. Pipe - 11.2 m  
1.5 m Depth  
Inst. Sloped End Section - 2
- ⑩ Sta. "U" 7+481, Rt.  
Remove Exist. Culv. Pipe - 7.0 m  
Inst. 300 mm Culv. Pipe - 12.2 m  
1.5 m Depth  
Inst. Sloped End Section - 2
- ⑪ Sta. "U" 7+505, Rt.  
Remove Exist. Culv. Pipe - 22 m  
Inst. 300 mm Culv. Pipe - 23.2 m  
1.5 m Depth  
Inst. Sloped End Section - 2
- ⑫ Sta. "HS" 7+605 Lt.  
Remove Exist. Culv. Pipe - 8 m  
Inst. 300 mm Culv. Pipe - 17.2 m  
1.5 m Depth  
Inst. Sloped End Section - 2
- ⑬ Sta. "HS" 7+642 Lt.  
Remove Exist. Culv. Pipe - 8 m  
Inst. 300 mm Culv. Pipe - 12.2 m  
1.5 m Depth  
Inst. Sloped End Section - 2

NOTE:  
 1. All Dimensions Shown Are In Meters (m)  
 Unless Otherwise Noted.  
 2. Remove Extg. Pipe Shown Thus:   
 3. Temp. Type Orange Plastic Mesh Delineation  
 Fence Shown as Thus:


AS  
 CONSTRUCTED  
*Wayne A. Sattler*  
 PROJECT MANAGER  
 2 MAR 2007  
 DATE

REGISTERED PROFESSIONAL  
 ENGINEER  
 17,573  
*Daniel C. Gunther*  
 OREGON  
 JANUARY 17, 1995  
 DANIEL C. GUNTHER  
 1/19/05  
 Expires June 30, 2007

<b>OREGON DEPARTMENT OF TRANSPORTATION</b> REGION 1 GEO/HYDRO UNIT	
<b>OR219: HILLSBORO-SILVERTON HWY</b> AT UNGER ROAD HILLSBORO-SILVERTON HIGHWAY WASHINGTON COUNTY	
Project Leader - Sandy Van Bommel Designed By - Stephen Hay Drafted By - David Hoase	
<b>DRAINAGE &amp; UTILITIES</b>	SHEET NO. <b>4A</b>


CAPTION: 1005  
 REVISIONS FOR JAE  
 STA. J



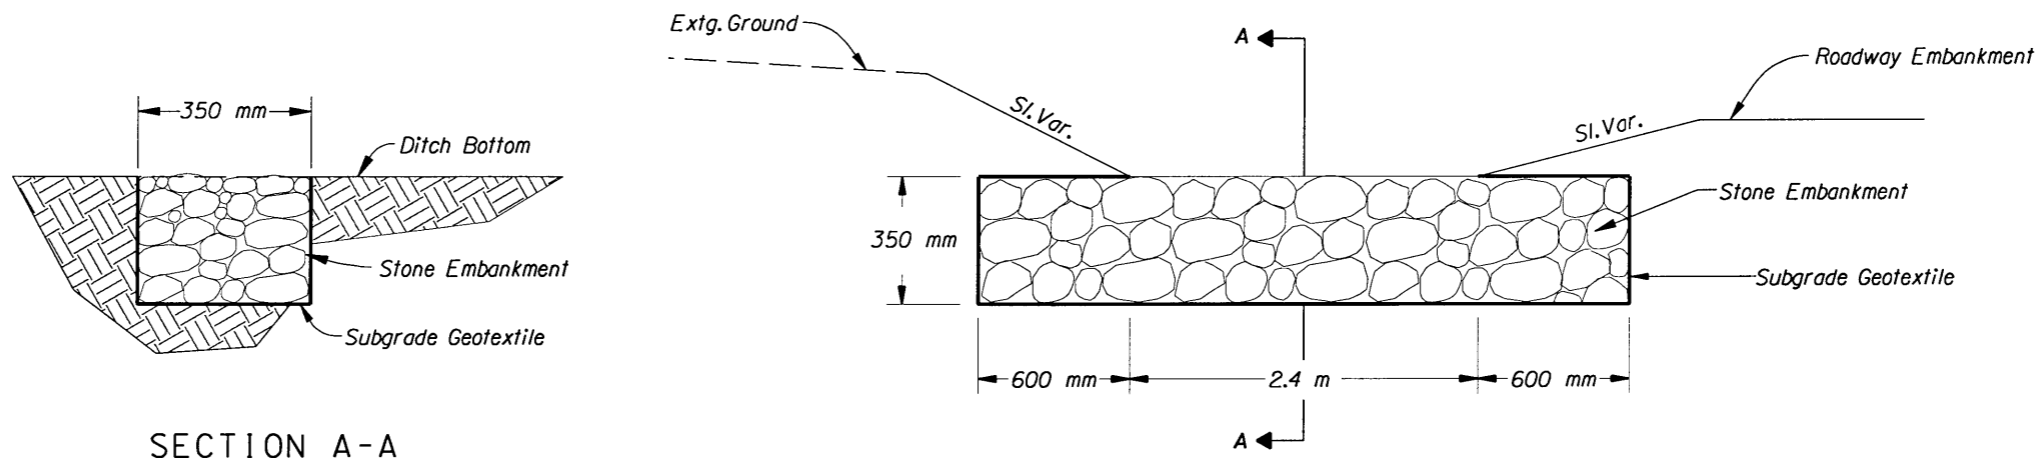


SECTION A-A

PERMANENT CHECK SLOT  
 FLAT BOTTOM DITCH  
 STA. "HB" 7+400 To STA. "HS" 7+560 Lt.  
 "HS" 7+600 Lt.  
 "HS" 7+880 To "HS" 8+050 Lt.  
 "FB" 0+044

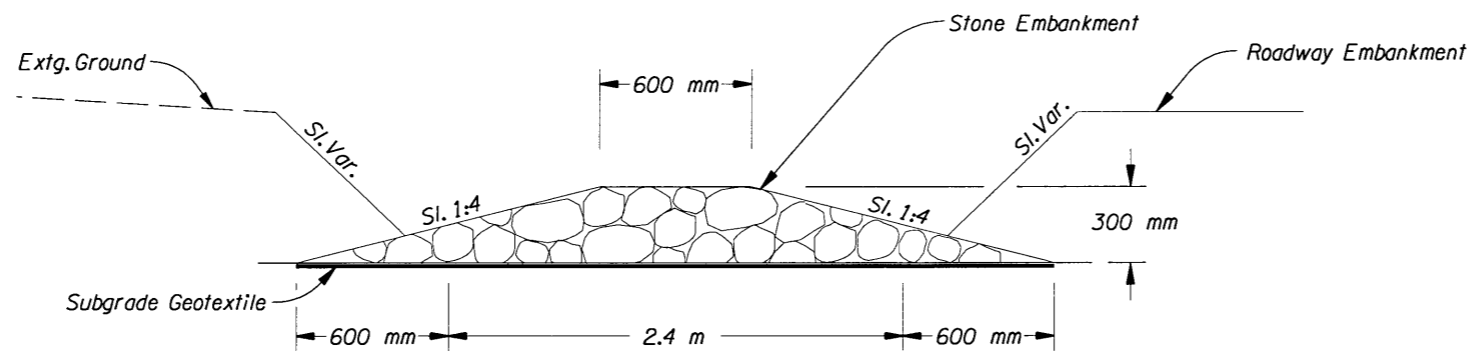

PERMANENT CHECK DAM  
 FLAT BOTTOM DITCH  
 STA. "HS" 7+573 Lt.

All Dimensions Are In Meters (m)  
 Unless Otherwise Noted.

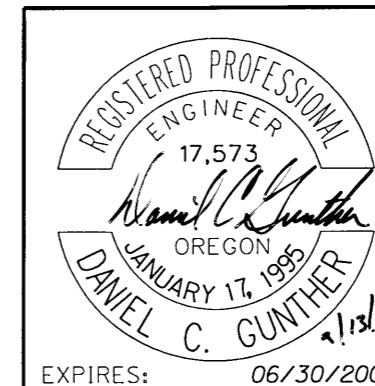

OREGON DEPARTMENT OF TRANSPORTATION  
 REGION 1 GEO/HYDRO UNIT

OR219: HILLSBORO-SILVERTON HWY  
 AT UNGER ROAD  
 HILLSBORO-SILVERTON HIGHWAY  
 WASHINGTON COUNTY

Reviewed By - Dan Gunther  
 Designed By - Stephen Hay  
 Drafted By - Charlotte Gerken



WATER QUALITY DETAILS

SHEET NO.  
 GJ




FLAT BOTTOM DITCH "FB"

39V-010

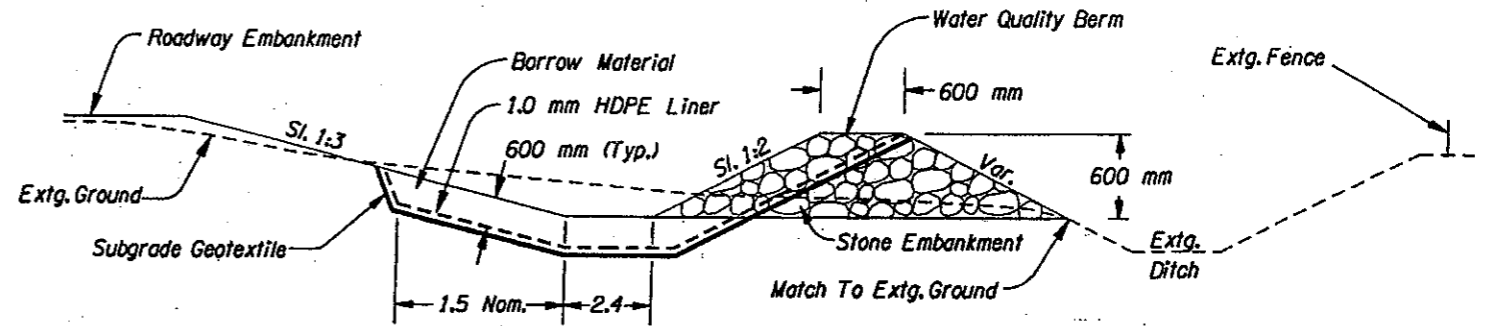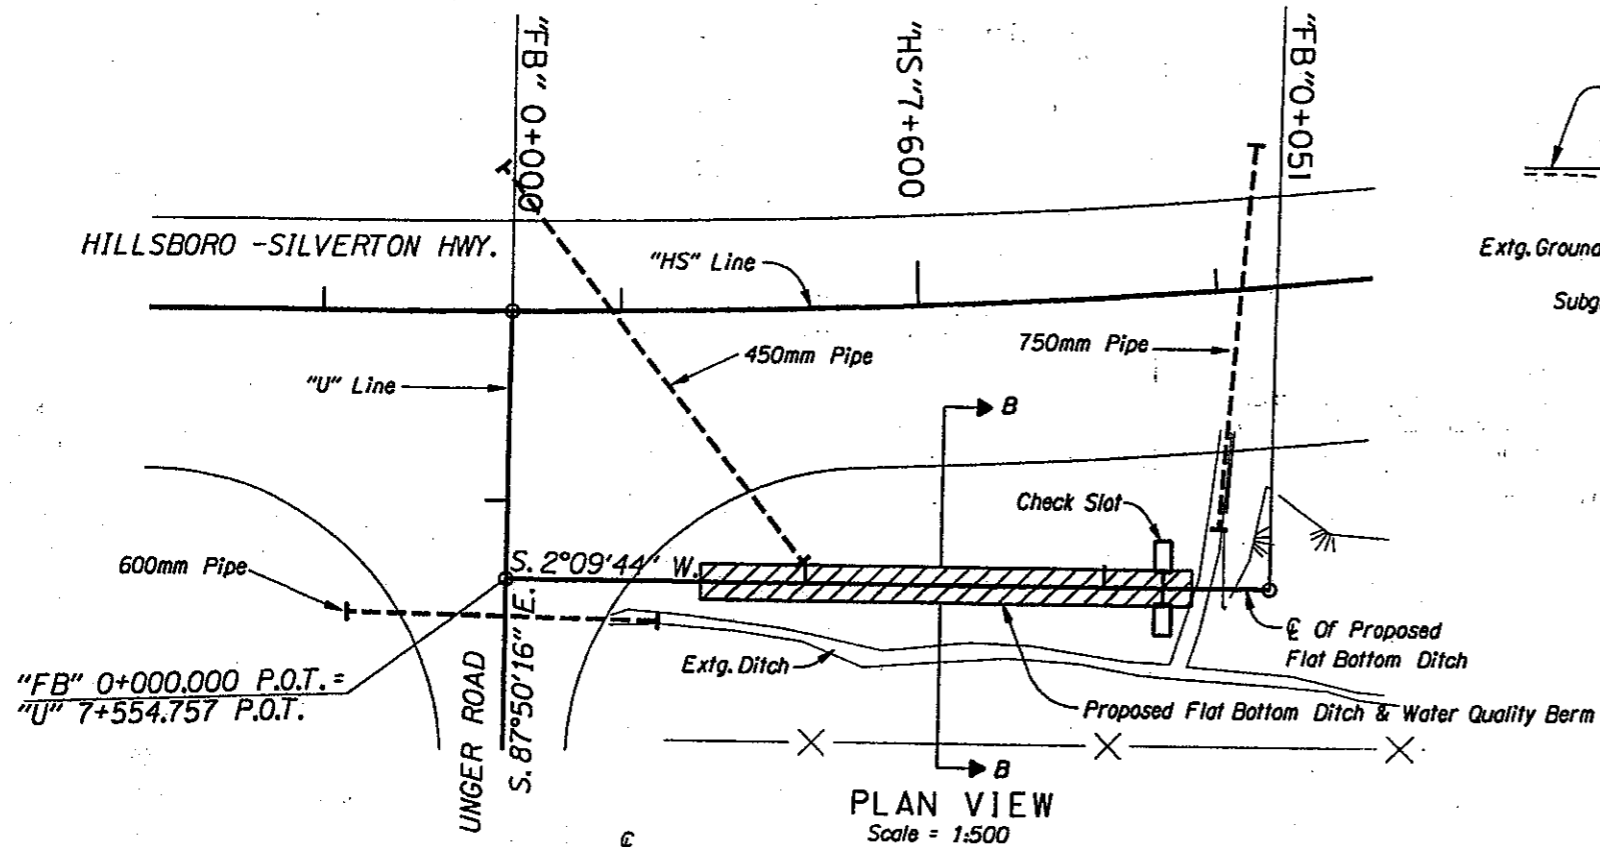


SECTION B-B  
STA. "FB" 0+013 To STA. "FB" 0+046

AS  
CONSTRUCTED  
*Wayne A. Statler*  
PROJECT MANAGER  
2 MAR 2007  
DATE

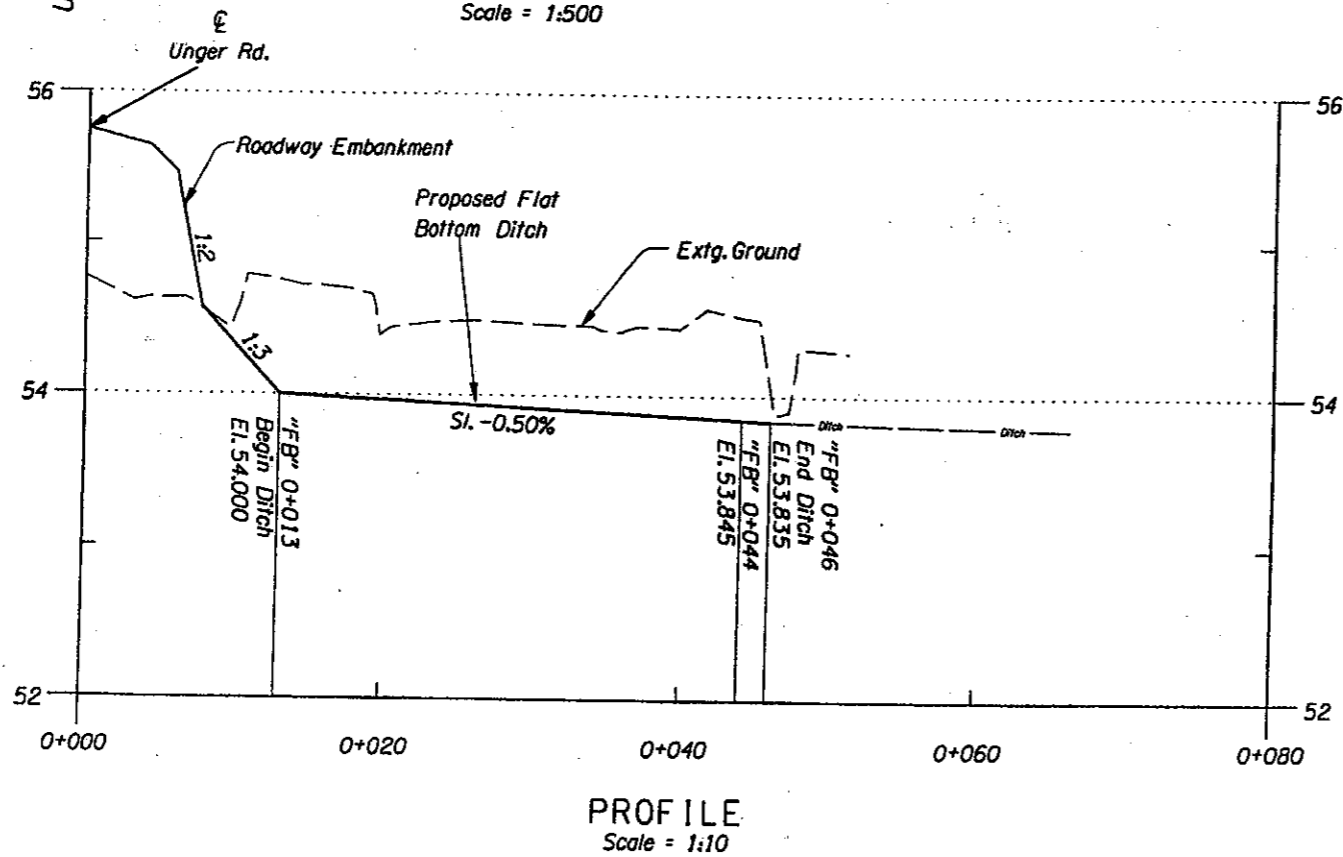

NOTE  
For Pipe Size Information Not Shown  
See Sheet 4A, Notes: 2, 3, & 5.

All Dimensions Are In Meters (m)  
Unless Otherwise Noted.

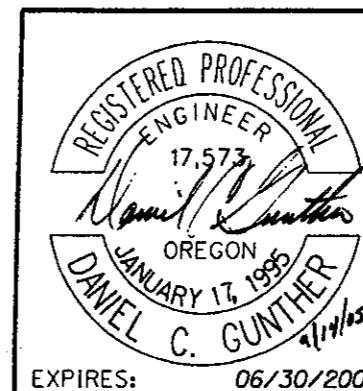

<b>OREGON DEPARTMENT OF TRANSPORTATION</b> REGION 1 GEO/HYDRO UNIT	
OR219: HILLSBORO-SILVERTON HWY AT UNGER ROAD HILLSBORO-SILVERTON HIGHWAY WASHINGTON COUNTY	
Reviewed By - Dan Gunther Designed By - Stephen Hay Drafted By - Charlotte Gerken	
WATER QUALITY DETAILS	SHEET NO. GJ-2