

# OPERATION & MAINTENANCE MANUAL

## WATER QUALITY BIOFILTRATION SWALE

Manual prepared: August 2017

DFI No. D00202



Figure 1: DFI No. D00202, looking South

## 1. Identification

Drainage Facility ID (DFI): D00202  
Facility Type: Water Quality Biofiltration Swale  
Construction Drawings: (V-File Numbers) 42V-198  
Location: District: 4  
Highway No.: 091  
Mile Post: 78.66 to 78.81, right

## 2. Manual Purpose

The purpose of this manual is to outline inspection needs and summarize maintenance actions.

## 3. Facility Location

The location map below details the facility location. The highway, mile posts, side streets, access location, and stormwater flow directions are noted on the map.

Flow direction: South




Figure 2: Facility location map

#### 4. Facility Summary

The length and width of a swale is based on the bottom dimensions.

The bottom length and bottom width of the swale is:


Bottom Length (feet)	Bottom Width (feet)
701	Varies: 0-2

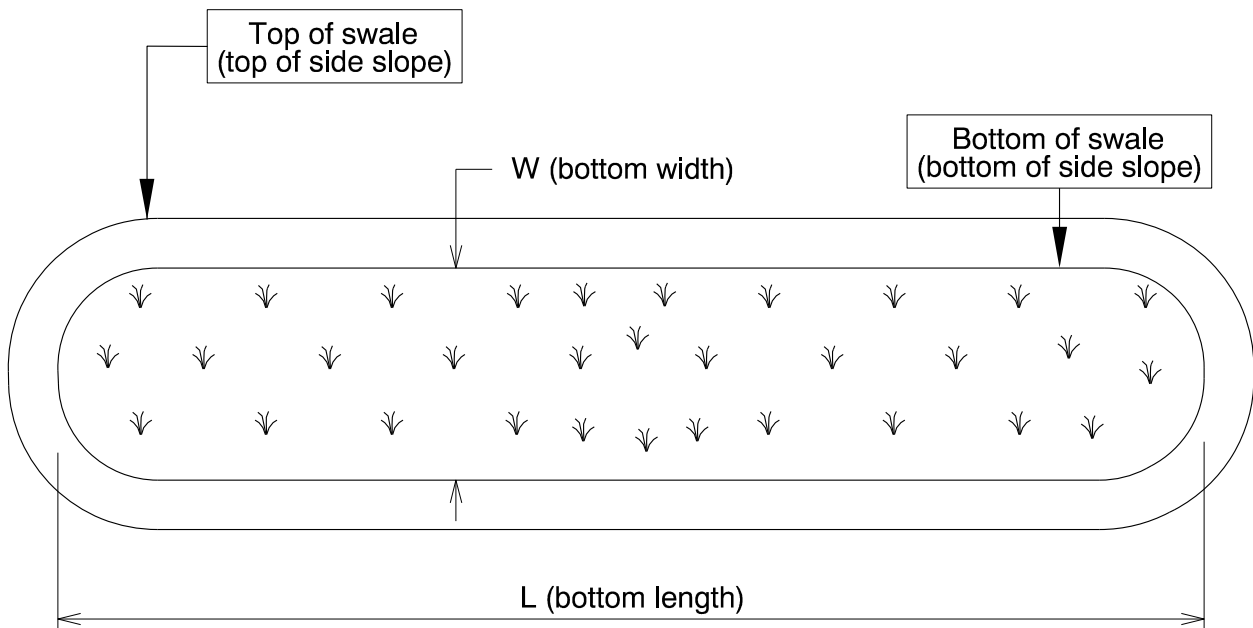

The depth of the swale is the vertical distance measured from the bottom of the swale to the top. The slope of the swale sides is presented by a vertical distance (rise) followed by the horizontal distance (run).

Depth and side slopes:

Depth (feet)	Rise (feet)	Run (feet)
0.5	1	4

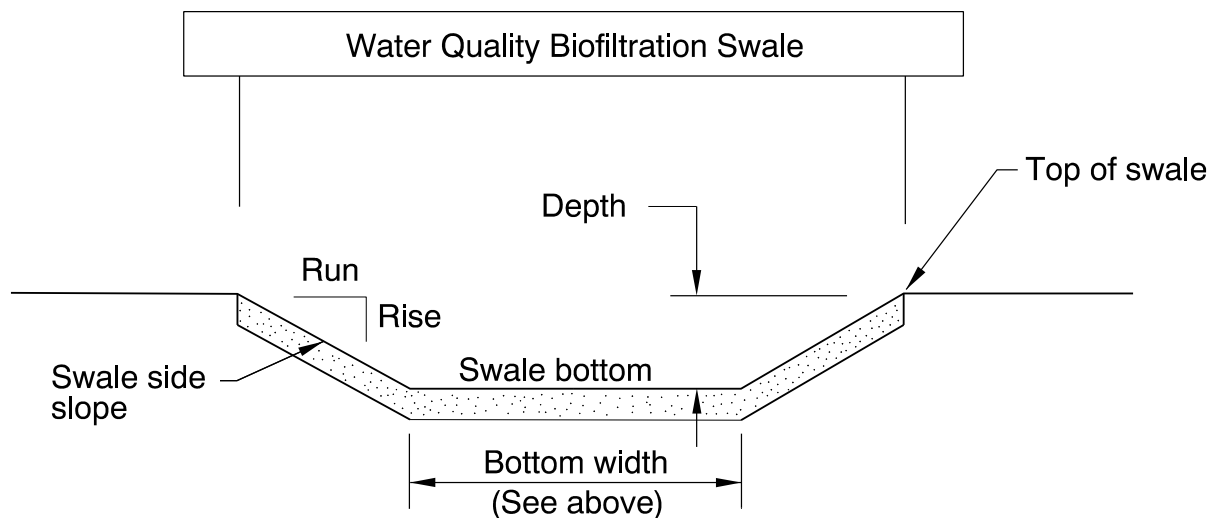

**Site Specific Information:** The swale is split into three sections by two driveways. Culverts convey water beneath these driveways. Swale length does not include the driveway widths. See Appendix A for details.

## 5. Facility Access

Maintenance access to the facility:

<input type="checkbox"/> Roadside pad	<input checked="" type="checkbox"/> Roadside shoulder
<input type="checkbox"/> Access road with Gate	<input type="checkbox"/> Access road without Gate



Figure 3: Facility access via roadside shoulder, looking North

## 6. Operational Components / Maintenance Items

### Classification

This facility is classified as an:

<input checked="" type="checkbox"/> <b>On-line Swale</b>	<input type="checkbox"/> <b>Off-line Swale</b>
A swale that does not include a high flow bypass component; flow drains into and through the facility	A swale that treats low/small flows and diverts high flows using a bypass component

## Bypass Component

This facility includes a high flow bypass component:

<input checked="" type="checkbox"/> No	<input type="checkbox"/> Yes
There is no bypass component. High flows drain into and through the facility	There is a bypass component. Only low/small flows drain into the swale. High flows are diverted around the swale using a bypass component

## Operational Components

A swale has many components that assist with treatment, conveyance, and reducing flow velocity to minimize erosion. The components in use can vary depending if the facility was designed to operate on-line or off-line. The facility components table (**Table 1**) has been provided to highlight the applicable components for this facility. The component is in use when the box contains an “x” (e.g. ).

The Standard Operation Manual for Water Quality Biofiltration Swales (implemented March 2017) outlines facility operation, typical footprint configuration, and component definitions and details. A link to the manual is attached to the feature marker in TransGIS.

<https://gis.odot.state.or.us/TransGIS/>

## Operational Plan

The applicable standard operational plan for this facility is:

<input checked="" type="checkbox"/> <b>Operational Plan A</b> <input type="checkbox"/> <b>Operational Plan B</b> <input type="checkbox"/> <b>Operational Plan C</b>
A standard operational plan illustrates the general facility footprint configuration and explains the purpose of each facility component. Operational plans (A, B, C) are provided in the Standard Operation Manual.

See Appendix A for the site specific operational plan.

## Maintenance Items

Operational components marked in **Table 1** should be inspected and maintained according to Section 7. Each facility component is defined and detailed in the Standard Operation Manual using the associated ID number indicated below.

<b>Table 1: Swale Components</b>		<b>ID #</b>
<b>Manholes/Structures</b>		
Pre-treatment manhole	<input type="checkbox"/>	<b>S1</b>
Weir type flow splitter/flow splitter manhole	<input type="checkbox"/>	<b>S2</b>
Orifice type flow splitter/flow splitter manhole	<input type="checkbox"/>	<b>S3</b>
Standard manhole	<input type="checkbox"/>	<b>S4</b>
<b>Swale Inlet</b>		
Pavement sheet flow	<input checked="" type="checkbox"/>	<b>S5</b>
Inlet Pipe (s)	<input type="checkbox"/>	<b>S6</b>
Open channel inlet	<input type="checkbox"/>	<b>S7</b>
Riprap pad	<input type="checkbox"/>	<b>S8</b>
<b>Ground Cover</b>		
Grass bottom	<input checked="" type="checkbox"/>	<b>S9</b>
Grass side slopes	<input checked="" type="checkbox"/>	<b>S10</b>
Granular drain rock	<input type="checkbox"/>	<b>S11</b>
Plantings	<input type="checkbox"/>	<b>S12</b>
<b>Underground Components</b>		
Geotextile fabric	<input type="checkbox"/>	<b>S13</b>
Water quality mix	<input checked="" type="checkbox"/>	<b>S14</b>
Perforated pipe	<input type="checkbox"/>	<b>S15</b>
Porous pavers (access grid)	<input type="checkbox"/>	<b>S16</b>
<b>Flow Spreader</b>		
Rock basin (used at inlet)	<input checked="" type="checkbox"/>	<b>S17</b>
Anchored board (midpoint of swale or every 50 feet along swale bottom)	<input type="checkbox"/>	<b>S18</b>
Other:	<input type="checkbox"/>	<b>S19</b>
<b>Swale Outlet</b>		
Catch basin with grate	<input type="checkbox"/>	<b>S20</b>
Outlet Pipe (s)	<input checked="" type="checkbox"/>	<b>S21</b>
Open channel outlet	<input checked="" type="checkbox"/>	<b>S22</b>
Auxiliary Outlet:	<input type="checkbox"/>	<b>S23</b>
<b>Outfall Type</b>		
Waterbody (Creek/Lake/Ocean)	<input checked="" type="checkbox"/> <b>C</b>	<b>S24</b>
	<input type="checkbox"/> <b>L</b>	
	<input type="checkbox"/> <b>O</b>	
Ditch	<input type="checkbox"/>	<b>S25</b>
Storm drain system	<input type="checkbox"/>	<b>S26</b>
<b>Outfall Components</b>		
Riprap pad	<input checked="" type="checkbox"/>	<b>S27</b>
Riprap bank protection	<input type="checkbox"/>	<b>S28</b>

## 7. Maintenance

### Maintenance Frequency/Maintain Records

- a. Inspect annually. Preferably prior to the rainy season.
- b. Clean and maintain as necessary. Refer to Activity 125 for conditions when maintenance is needed.
- c. Keep a record of inspections, maintenance, and repairs.

### Maintenance Guide/Maintenance Actions

The ODOT Routine Road Maintenance Water Quality and Habitat Guide (the *Blue Book*) outlines the standard maintenance actions for water quality facilities under Activity 125.

There are standard maintenance tables for standard ODOT designs. The maintenance tables describe the maintenance component, the defect or problem, the condition when maintenance is needed, and the recommended maintenance to correct the problem. Use the following tables to maintain ODOT swales:

- Table 1 (General Maintenance): Contains general maintenance and inspection guidelines that are applicable to all ODOT water quality facilities
- Table 3 (Maintenance of Water Quality or Biofiltration Swales): Contains maintenance information for swales

The *Blue Book* can be viewed at the following website:

[http://www.oregon.gov/ODOT/Maintenance/Documents/blue\\_book.pdf](http://www.oregon.gov/ODOT/Maintenance/Documents/blue_book.pdf)

## 8. Limitations

Access grid installed:

<input checked="" type="checkbox"/> No	<input type="checkbox"/> Yes
There are (Choose applicable weight: <b>no</b> , light, med., heavy) duty porous pavers installed in this swale	

Swales are designed to allow equipment access along the bottom. If an access grid is **NOT** installed, vehicles entering the swale can create depressions (tire ruts), damage vegetation, and damage structural components (e.g. flow spreaders). These conditions may result in poor treatment and drainage performance.

Equipment wheels should be kept on the tops and side slopes. Mower arms may be run along the swale bottom.



## 9. Waste Material Handling

Material removed from the facility is defined as waste by the Department of Environmental Quality (DEQ). Refer to the roadwaste section of the ODOT Maintenance Yard Environmental Management System (EMS) Policy and Procedures Manual for disposal options:

[http://www.oregon.gov/ODOT/Maintenance/Documents/ems\\_manual.pdf](http://www.oregon.gov/ODOT/Maintenance/Documents/ems_manual.pdf)


Contact any of the following for more detailed information about management of waste materials found on site:

ODOT Clean Water Unit	(503) 986-3008
ODOT Statewide Hazmat Coordinator	(503) 667-7442
ODOT Region 1 Hazmat Coordinator	(503) 731-8290
ODOT Region 2 Hazmat Coordinator	(503) 986-2647
ODOT Region 3 Hazmat Coordinator	(541) 957-3594
ODOT Region 4 Hazmat Coordinator	(541) 388-6186
ODOT Region 5 Hazmat Coordinator	(541) 963-1590
ODEQ Northwest Region Office	(503) 229-5263

## **A Appendix A – Site Specific Operational Plan**


### **Contents:**

**Operational Plan: DFI D00202**

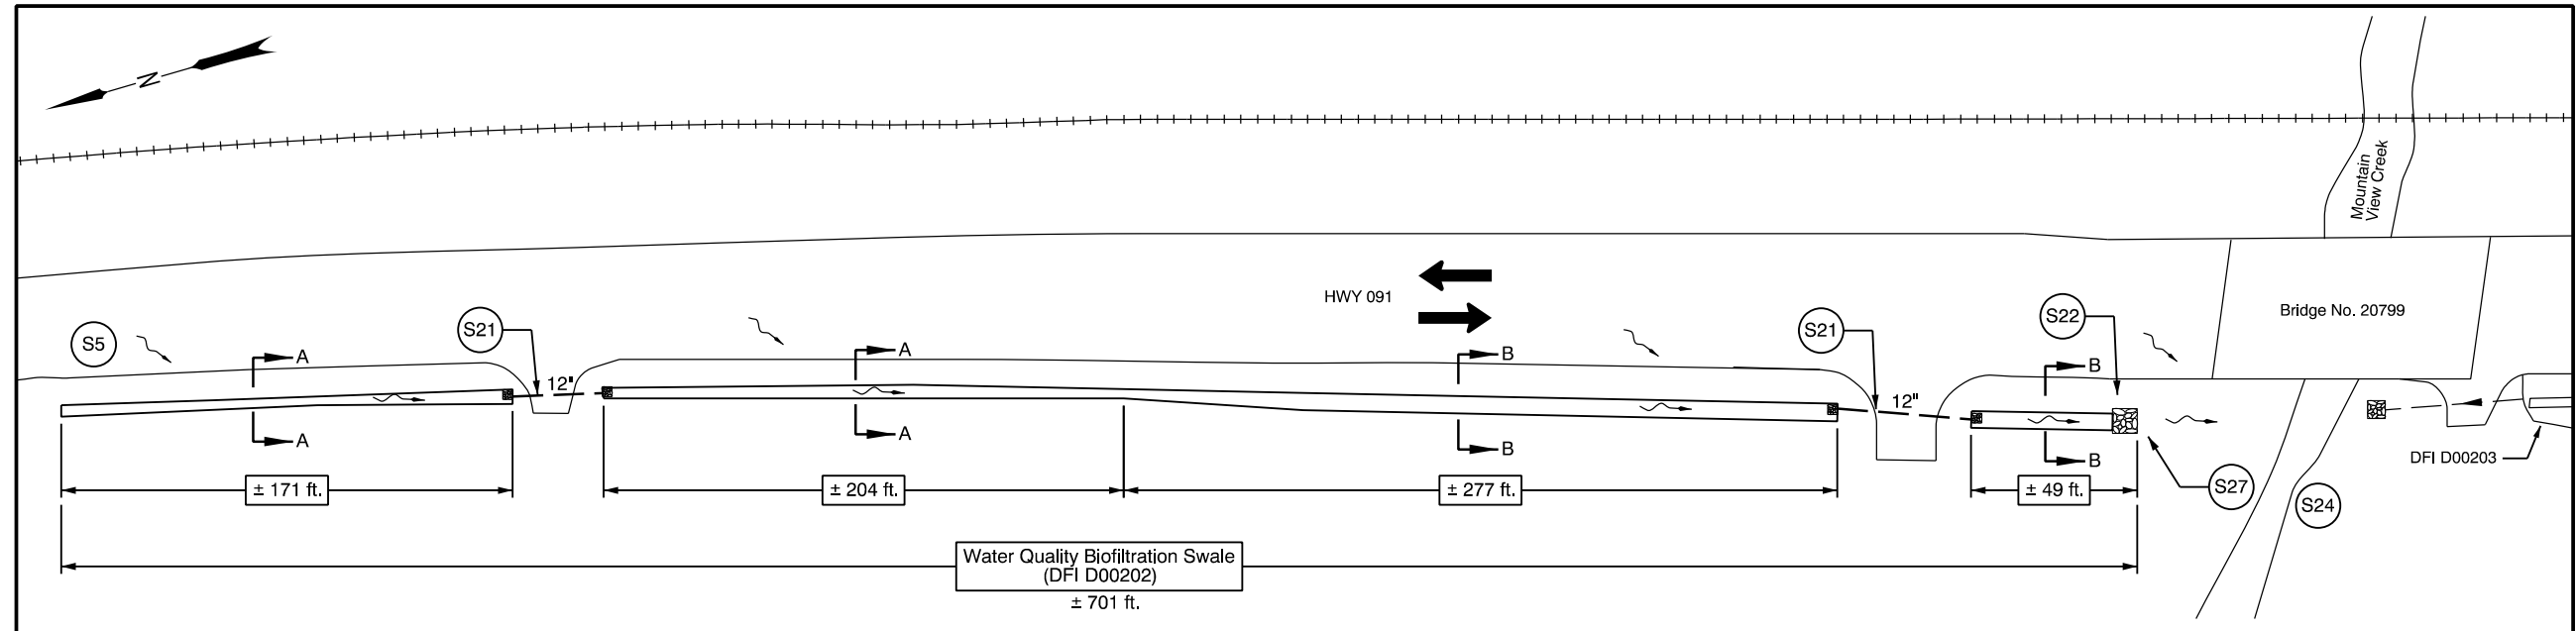


Water Quality Biofiltration Swale  
(DFI D00202)  
± 701 ft.


PLAN  
N.T.S.

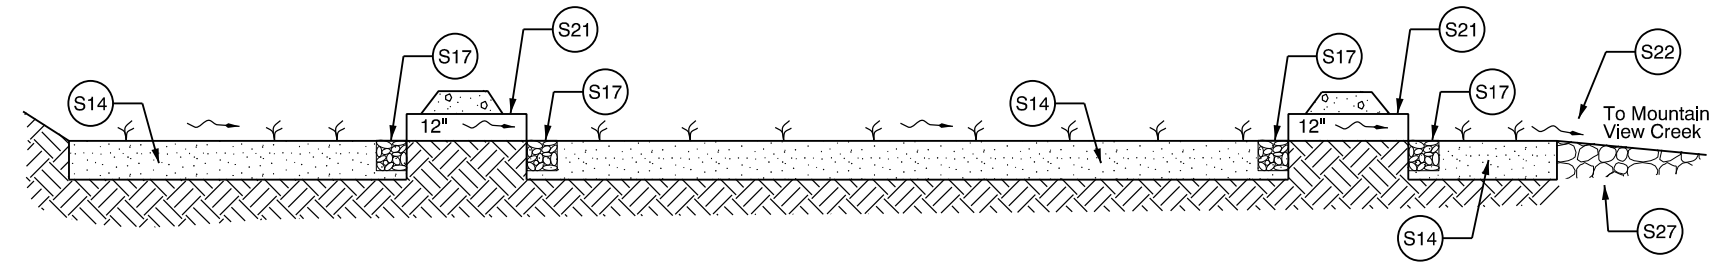

PROFILE  
N.T.S.

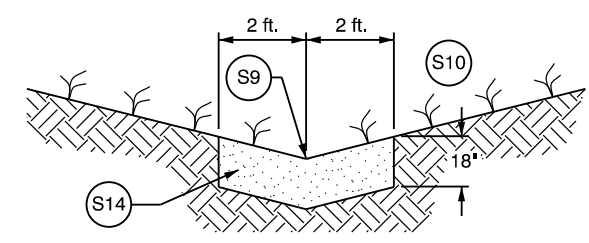

SECTION A-A  
N.T.S.

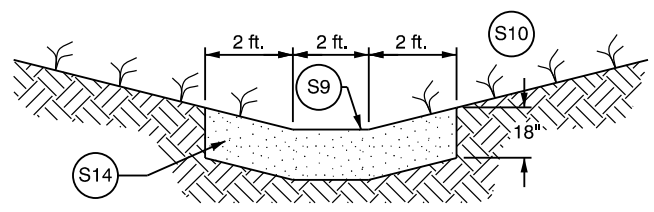

SECTION B-B  
N.T.S.

- LEGEND
- Storm Pipe
  - ~ Stormwater Flow Path
  - ← Traffic Flow Direction

OREGON DEPARTMENT OF TRANSPORTATION	
<b>DFI D00202</b> <b>MAINTENANCE DISTRICT 4 HWY 091</b> <b>WATER QUALITY BIOFILTRATION SWALE</b> HIGHWAY MP 78.66, 78.81 BENTON	
Prepared By:	Brooklyn Scholz
Drafted By:	Brooklyn Scholz

DFI\_D00202.dgn

## **B Appendix B – Project Contract Plans**

### **Contents:**

**Site Specific Subset of Project Contract Plan 42V-198**


INDEX OF SHEETS	
SHEET NO.	DESCRIPTION
1	Title Sheet
1A	Index Of Sheets Cont'd. & Std. Drg. Nos.

STATE OF OREGON  
DEPARTMENT OF TRANSPORTATION  
PLANS FOR PROPOSED PROJECT

GRADING, STRUCTURE, PAVING, & GUARDRAIL

**OR99W: LOCKE CREEK BRIDGE REPLACEMENT PROJECT**

**PACIFIC HIGHWAY WEST**

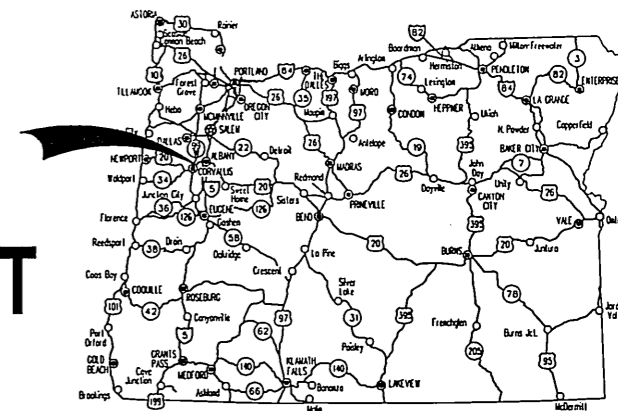

Overall Length Of Project - 0.26 Miles

**ATTENTION:**  
Oregon Law Requires You To Follow Rules Adopted By The Oregon Utility Notification Center. Those Rules Are Set Forth In OAR 952-001-0010 Through OAR 952-001-0090. You May Obtain Copies Of The Rules By Calling The Center. (Note: The Telephone Number For The Oregon Utility Center Is (503) 232-1987.)



**BENTON COUNTY  
NOVEMBER 2009**

**BEGINNING OF CONTRACT PROJECT**

**STA. "A" 327+62.00 (MP 78.54)**

**BEGINNING OF PROJECT**


**STA. "A" 334+68.00 (MP 78.67)**

**END OF PROJECT**

**STA. "A" 348+29.70 (MP 78.93)**

**END OF CONTRACT PROJECT**

**STA. "A" 354+14.50 (MP 79.04)**

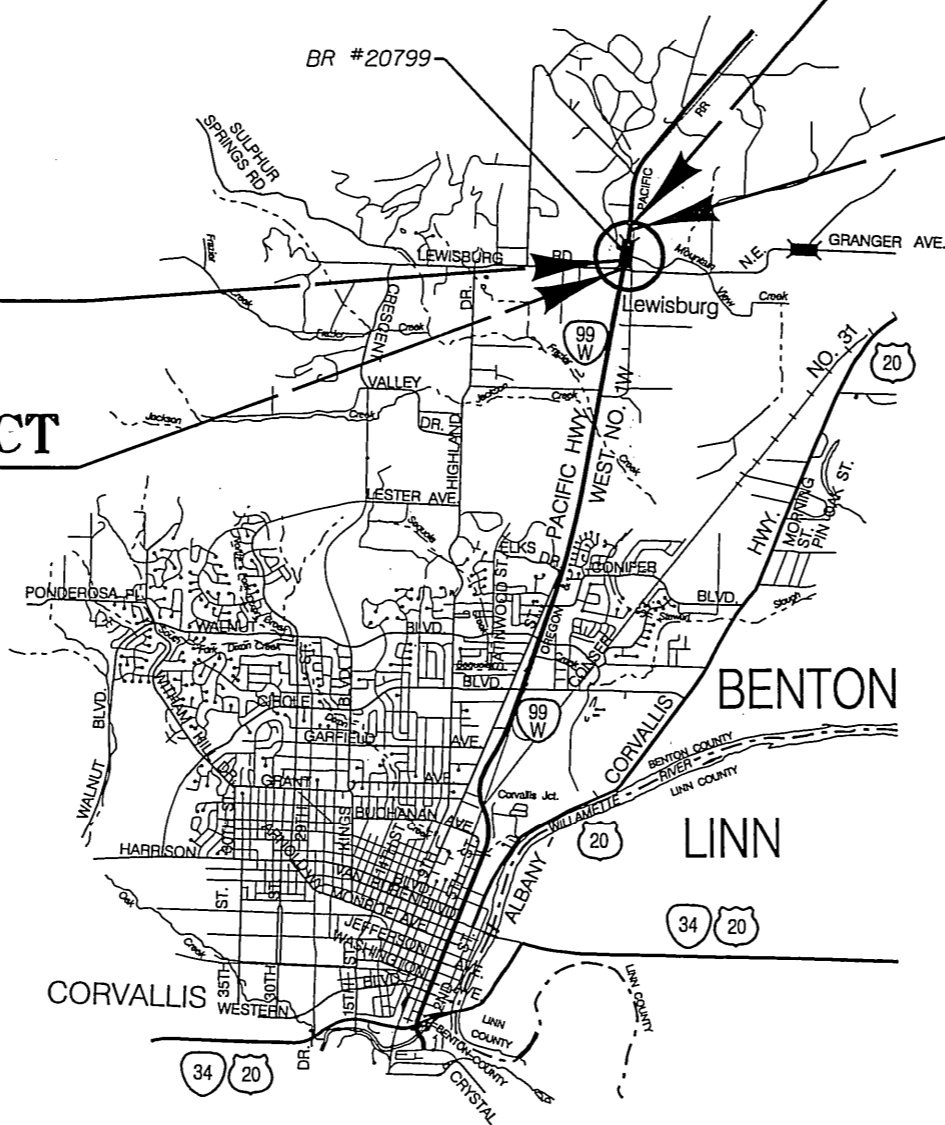


OREGON TRANSPORTATION COMMISSION	
Gail Achterman	CHAIRMAN
Michael Nelson	VICE CHAIRMAN
Janice Wilson	COMMISSIONER
Alan Brown	COMMISSIONER
David Lohman	COMMISSIONER
Matthew Garrett	DIRECTOR OF TRANSPORTATION




These plans were developed using ODOT design standards. Exceptions to these standards, if any, have been submitted and approved by the ODOT Chief Engineer or their delegated authority.


Approving Authority: *Randy G. Hinderer* 9/24/09  
Signature & date  
*Randy G. Hinderer P.E.*  
Print name and title  
*[Signature]*  
Concurrence by ODOT Chief Engineer

OR99W: LOCKE CREEK BRIDGE REPLACEMENT PROJECT		
PACIFIC HIGHWAY WEST		
BENTON COUNTY		
FEDERAL HIGHWAY ADMINISTRATION	PROJECT NUMBER	SHEET NO.
OREGON DIVISION	X-BRO-S091 (035)	1

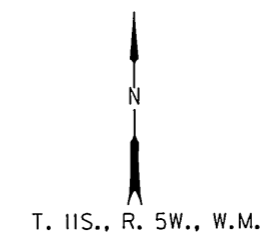

Sec. 12, T. 11S, R. 5W. W.M.  
PACIFIC HIGHWAY WEST

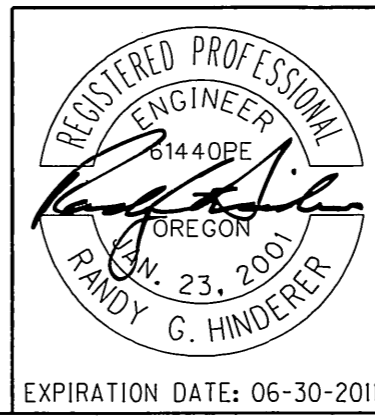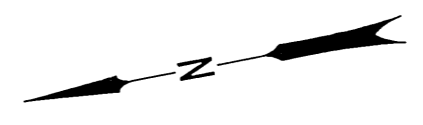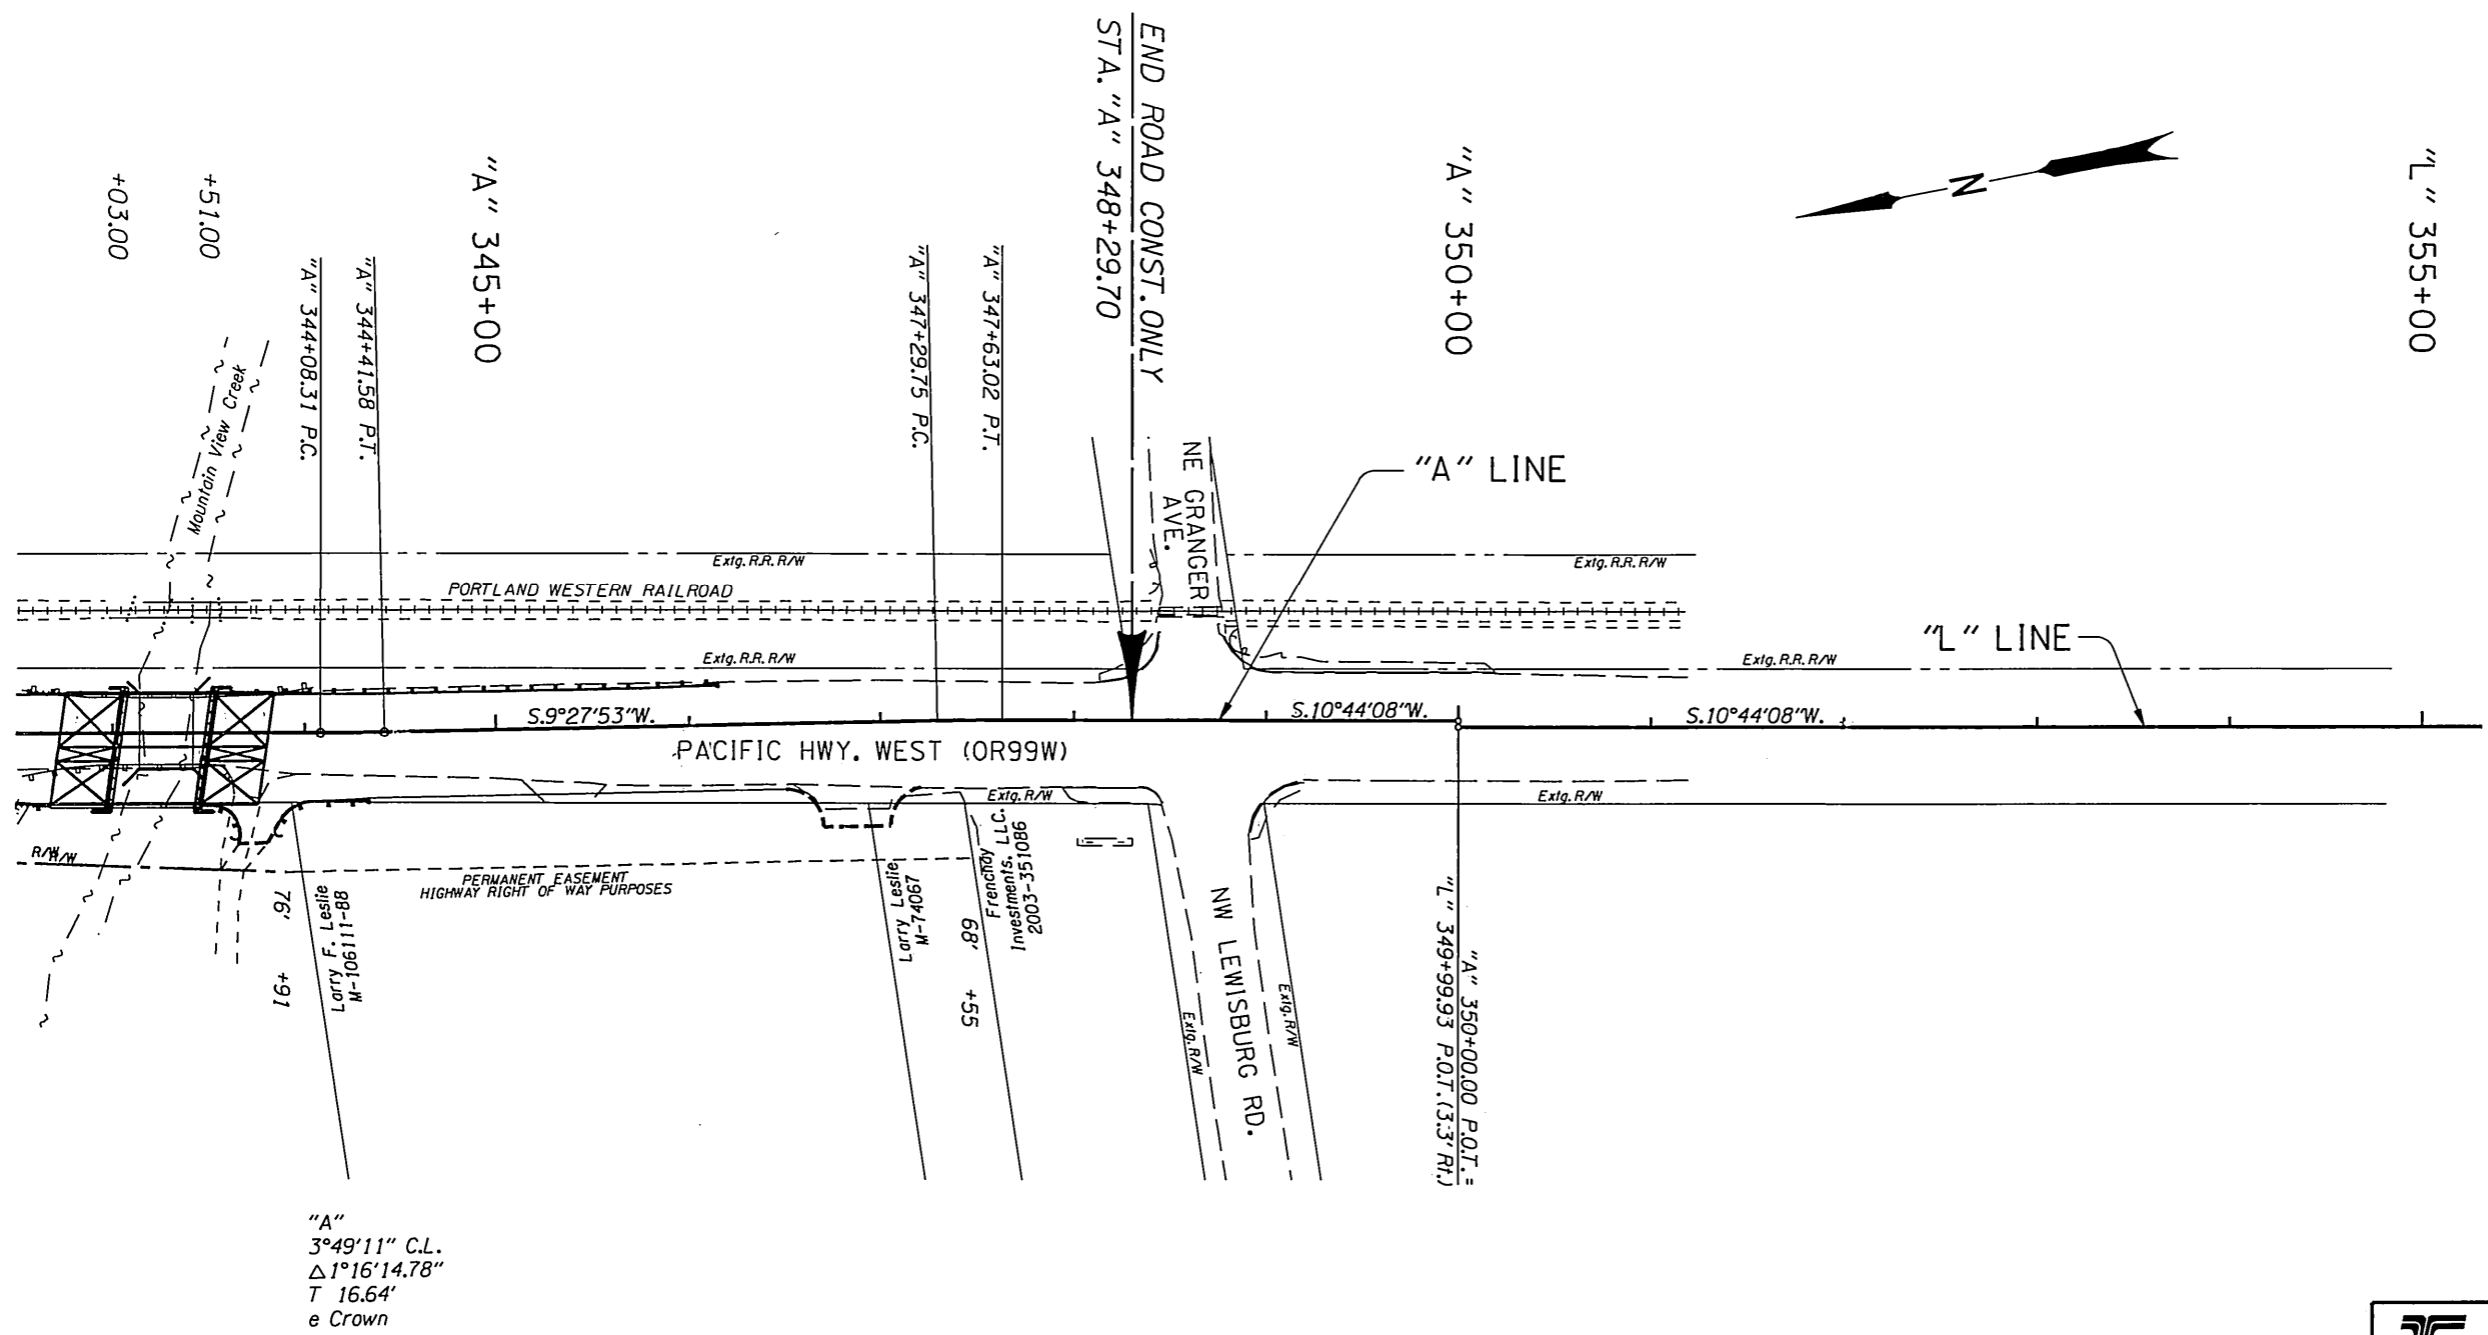

 <b>OREGON DEPARTMENT OF TRANSPORTATION</b>	
<b>LOCHNER</b> <small>CONSULTING ENGINEERS AND PLANNERS                  2001 Front St. NE Suite 120 Salem, Oregon 97301                  Phone (503) 586-0100 FAX (503) 589-9538</small>	
<b>OR99W: LOCKE CREEK BRIDGE REPLACEMENT PROJECT</b> PACIFIC HIGHWAY WEST BENTON COUNTY	
Reviewed By - Randy G. Hinderer Designed By - Chee Yeun Loy Drafted By - Ryan Berger	
<b>ALIGNMENT</b>	SHEET NO. <b>4</b>

Sec. 12, T. 11S, R. 5W. W.M.  
PACIFIC HIGHWAY WEST




END ROAD CONST. ONLY  
STA. "A" 348+29.70

"A" 350+00

"A" 345+00

+51.00  
+03.00

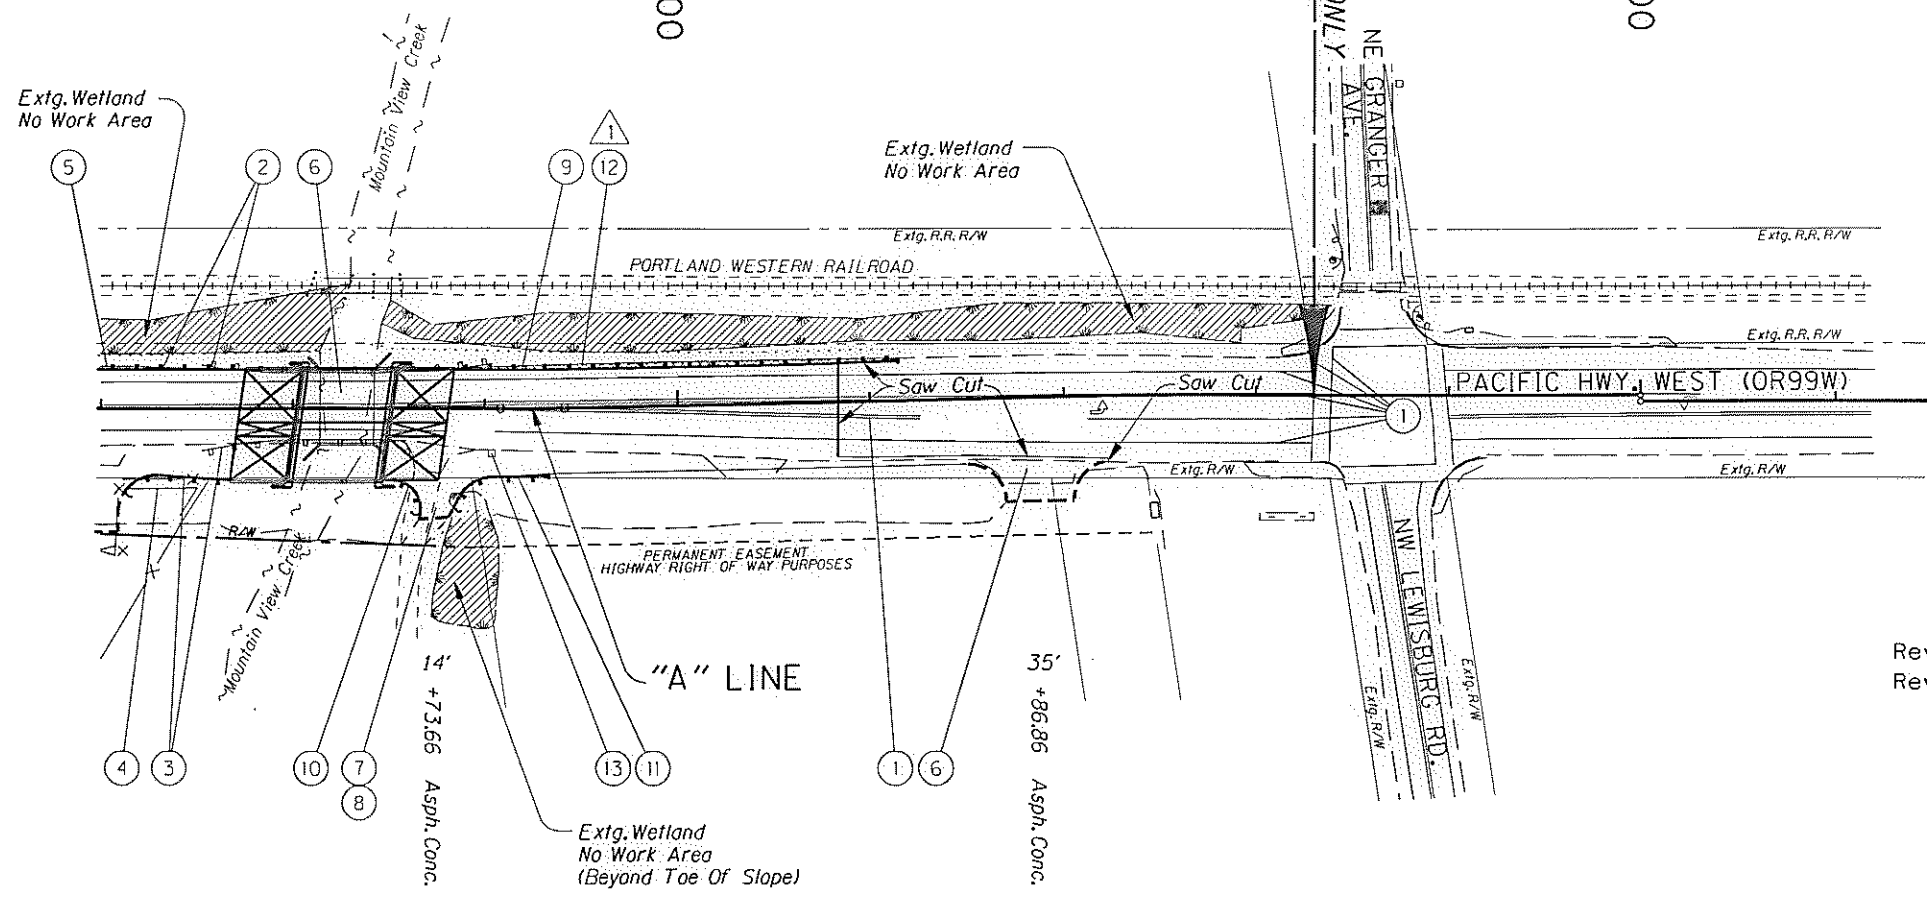

- ① See Note 2, Sht. 3A.
- ② See Note 4, Sht. 3A.
- ③ See Note 5, Sht. 3A.
- ④ See Note 6, Sht. 3A.
- ⑤ See Note 7, Sht. 3A.
- ⑥ Bridge No. 20799  
Remove Extg. Bridge  
Construct Structure - 107.3'  
Rdwy. Width 60' With 0' Walk  
And Reinf. Panel At Bridge Ends  
(For Details, See Bridge Plans)
- ⑦ Construct Type "A-1" Roadway Approach - 2
- ⑧ Reconstruct Extg. Dwy. Within Right Of Way Limits  
(See Drg. RD715)
- ⑨ Sta. "A" 343+84.12, 20.0' Lt. To Sta. "A" 346+15.71, 21.2' Lt.  
Construct Guardrail - 193.5' (Type 2A)  
Construct Guardrail - 12.5' (Type 3)  
Construct Guardrail Terminal, Non-Flare (Test Level 2) - 25'  
Construct Guardrail To Conc. Bridge Rail Transition
- ⑩ Sta. "A" 343+45.72, 37.3' Rt. To Sta. "A" 343+66.76, 53.4' Rt.  
Construct Guardrail - 12.5' (Type 4)  
Install Type 1 Modified Anchor  
Install Type B End Piece  
Construct Guardrail To Conc. Bridge Rail Transition  
(See Detail, Sht. 2B)
- ⑪ Sta. "A" 343+84.76, 50.1' Rt. To Sta. "A" 344+33.40, 35.4' Rt.  
Construct Guardrail - 31' (Type 2A)  
Construct Guardrail Terminal, Non-Flare (Test Level 2) - 25'  
Install Type 1 Modified Anchor  
Install Type B End Piece
- ⑫ Sta. "A" 343+84.00 To Sta. "A" 346+15.00, Lt.  
Remove Extg. Surfacing - 66 Sq. Yds.
- ⑬ Sta. "A" 344+03.74, 27.1' Rt.  
Relocate Existing Mail Box  
Remove Existing Mail Box Support  
Install New Mailbox Support  
Contractor To Coordinate With United States Postal Service  
For Relocation  
(See Drg. RD100, RD101)



Revised 10-20-2009,  
Revised Terminology, Note 12

REVISIONS	
⚠	Revised 10-20-2009 Addendum #1


REGISTERED PROFESSIONAL  
ENGINEER  
61440PE  
*Randy G. Hinderer*  
OREGON  
JAN. 23, 2001  
RANDY G. HINDERER  
EXPIRATION DATE: 06-30-2011

<b>OREGON DEPARTMENT OF TRANSPORTATION</b>	
<b>LOCHNER</b> CONSULTING ENGINEERS AND PLANNERS 2001 Front St. NE Suite 120 Salem, Oregon 97301 Phone (503) 586-0100 FAX (503) 589-9538	
<b>OR99W: LOCKE CREEK BRIDGE REPLACEMENT PROJECT</b>	
PACIFIC HIGHWAY WEST BENTON COUNTY	
Reviewed By - Randy G. Hinderer Designed By - Chee Yeun Lay Drafted By - Ryan Berger	
<b>GENERAL CONSTRUCTION</b>	SHEET NO. <b>4A</b>

Sec. 12, T. 11S, R. 5W. W.M.  
PACIFIC HIGHWAY WEST

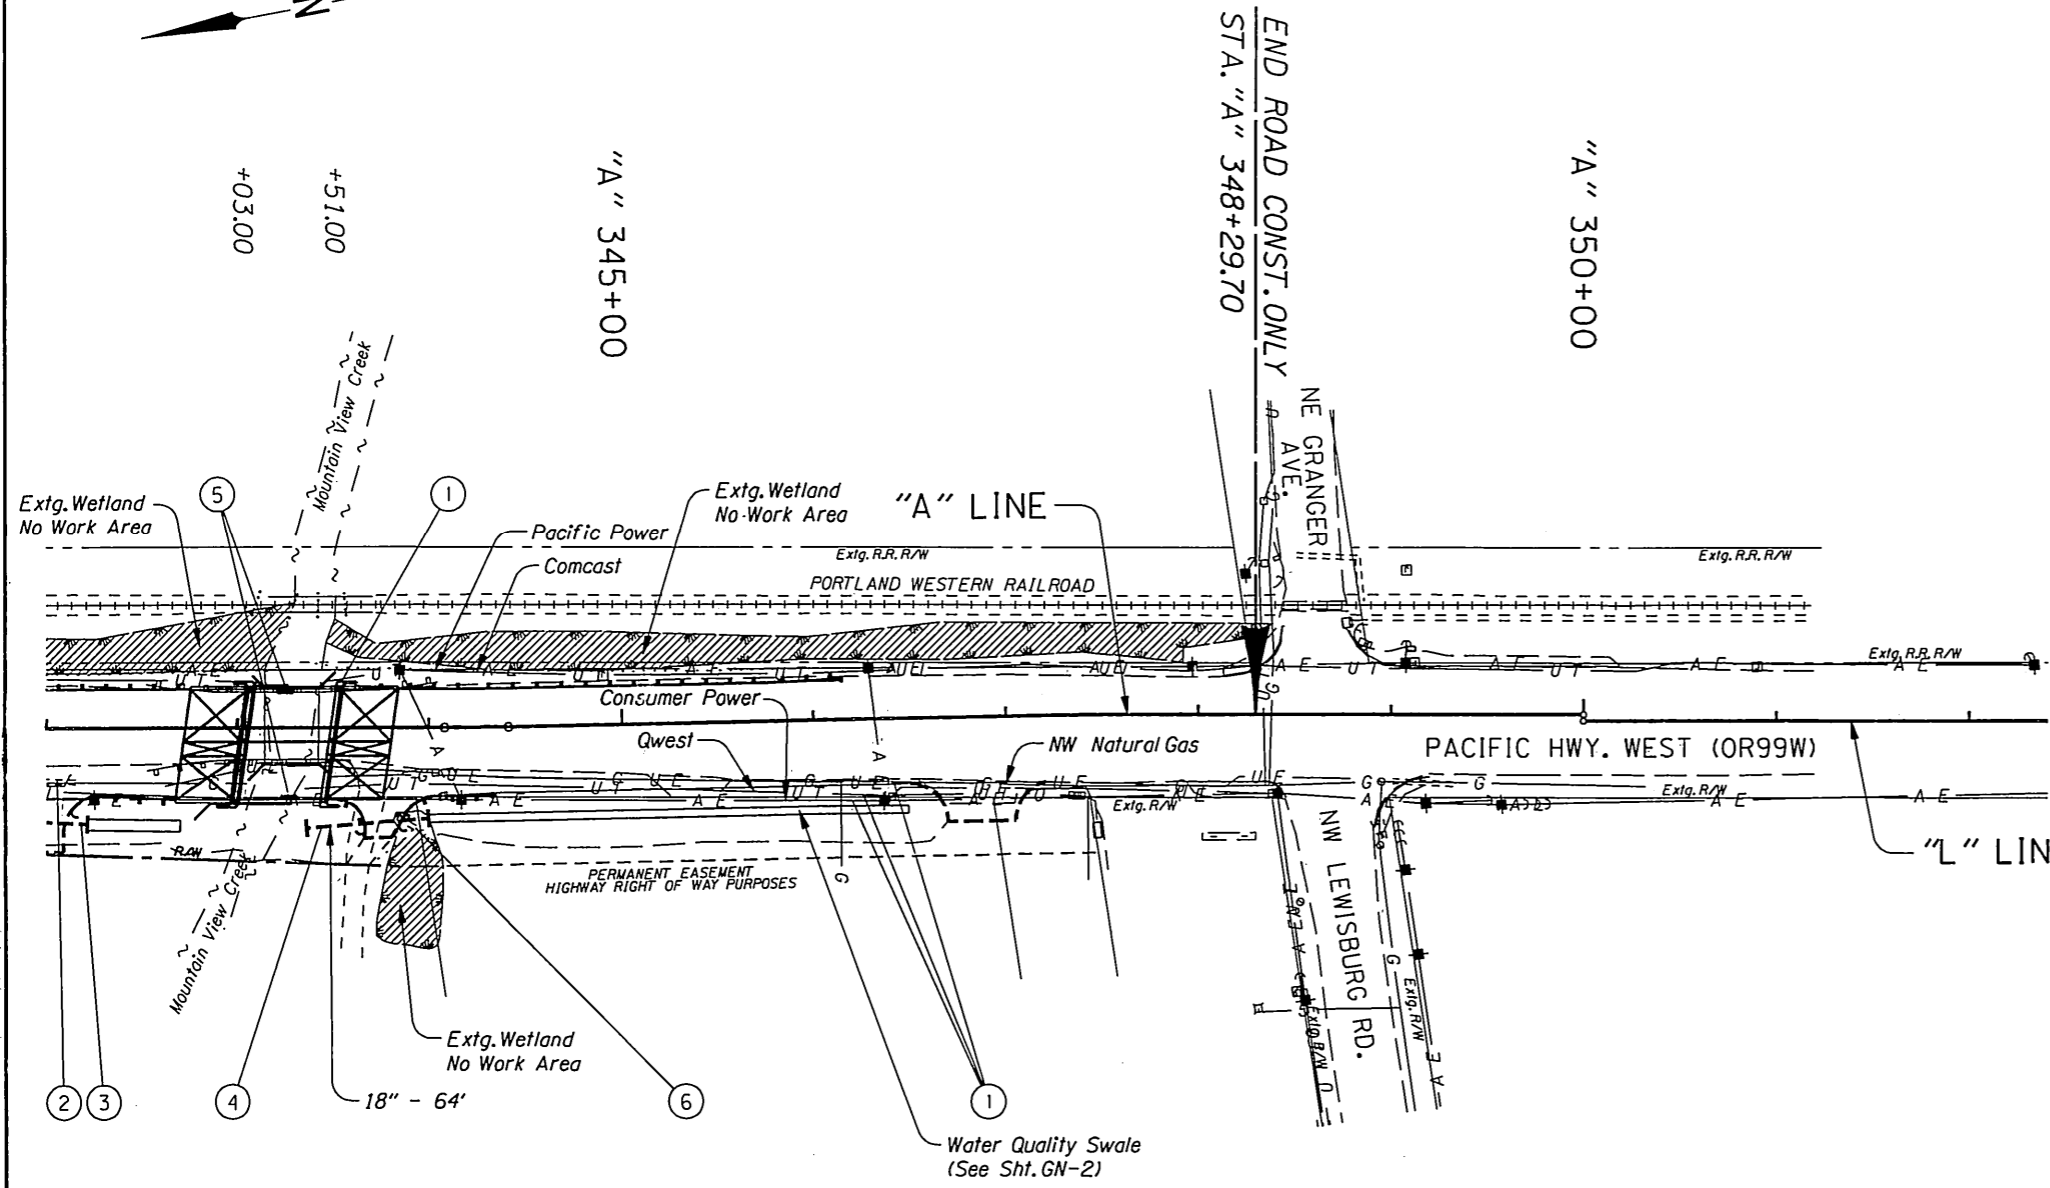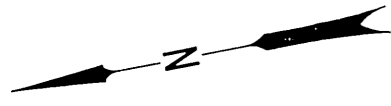


- ① Remove and Reinstall Extg. Utilities (By Others)
- ② See Note 3, Sht. 3B
- ③ See Note 4, Sht. 3B
- ④ Sta. "A" 343+24.00, 52.0' Rt. To Sta. "A" 343+87.42, 59.6' Rt. Install 18" Culvert Pipe - 64' 5' Depth  
S = 0.0469'/Ft.  
I.E. (In) - 235.86'  
I.E. (Out) - 232.86'  
Construct Sloped End (Inlet Only)  
Install 12" Thick Class 50 Riprap Embankment Protection At Both Pipe Ends - 1.5 Cu. Yds.
- ⑤ Bridge Drain System (For Details, See Bridge Plans)
- ⑥ Remove Extg. Culvert - 12'

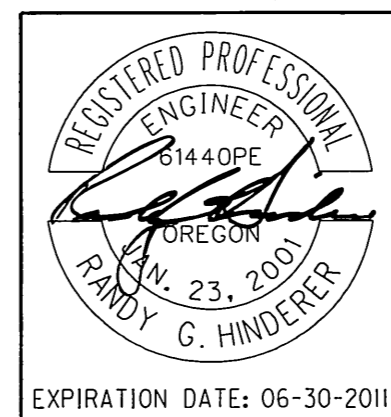


<p>OREGON DEPARTMENT OF TRANSPORTATION</p>	
<p><b>LOCHNER</b> CONSULTING ENGINEERS AND PLANNERS 2001 Front St. NE Suite 120 Salem, Oregon 97301 Phone (503) 368-0100 FAX (503) 369-9538</p>	
<p><b>OR99W: LOCKE CREEK BRIDGE REPLACEMENT PROJECT</b> PACIFIC HIGHWAY WEST BENTON COUNTY</p>	
<p>Reviewed By - Randy G. Hinderer Designed By - Chee Yeun Lay Drafted By - Ryan Berger</p>	
<p><b>DRAINAGE &amp; UTILITIES</b></p>	<p>SHEET NO. <b>4B</b></p>



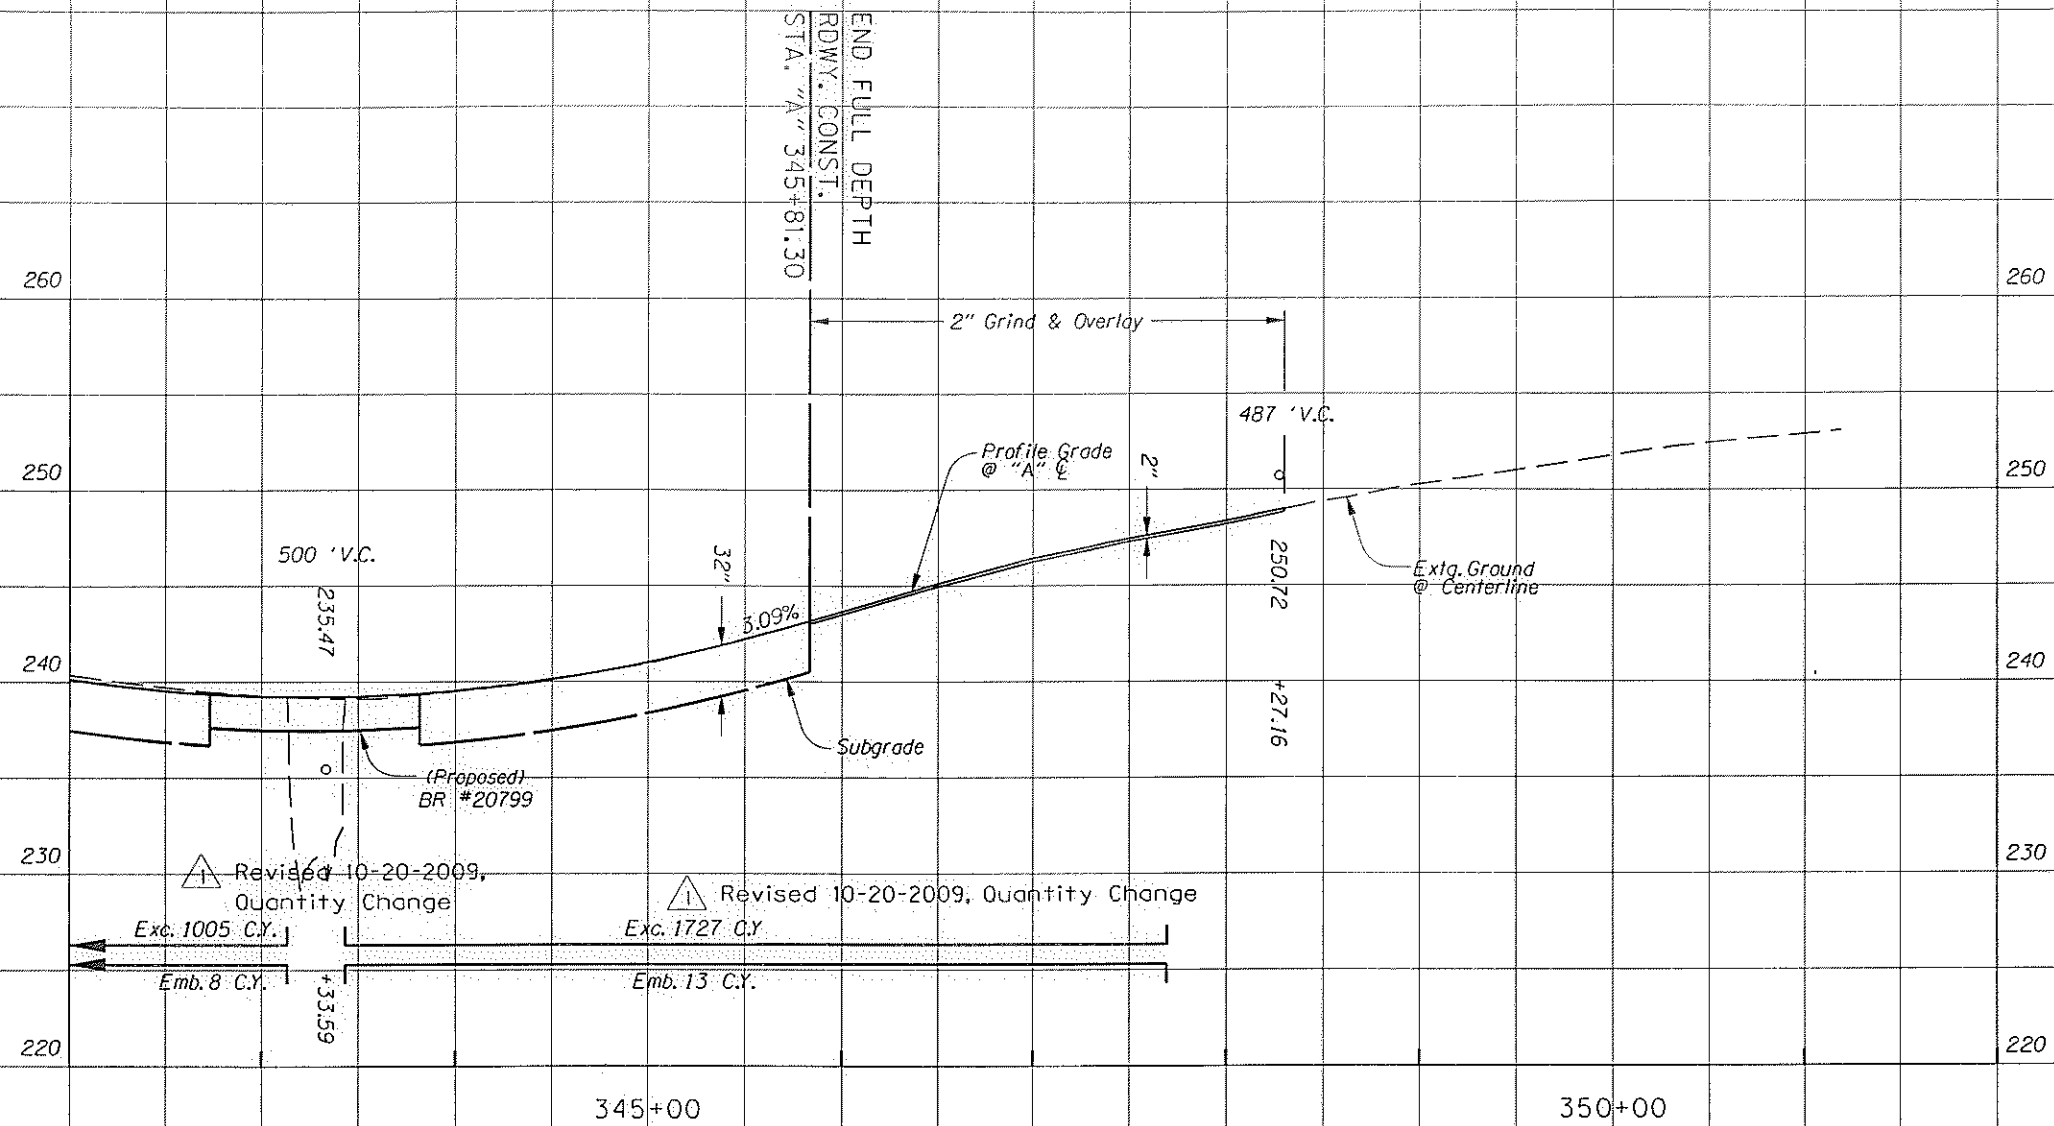

REVISIONS	
△	Revised 10-20-2009 Addendum #1

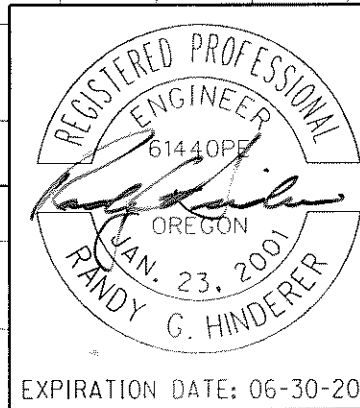

**OREGON DEPARTMENT OF TRANSPORTATION**

**LOCHNER**  
CONSULTING ENGINEERS AND PLANNERS  
2001 Front St. NE Suite 120 Salem, Oregon 97301  
Phone (503) 586-0100 FAX (503) 586-9538



**OR99W: LOCKE CREEK BRIDGE REPLACEMENT PROJECT**  
PACIFIC HIGHWAY WEST  
BENTON COUNTY

Reviewed By - Randy G. Hinderer  
Designed By - Chee Yuen Lay  
Drafted By - Ryan Berger



**PROFILE**

SHEET NO.  
**4C**

Sec. 12, T. 11S, R. 5W. W.M.  
PACIFIC HIGHWAY WEST

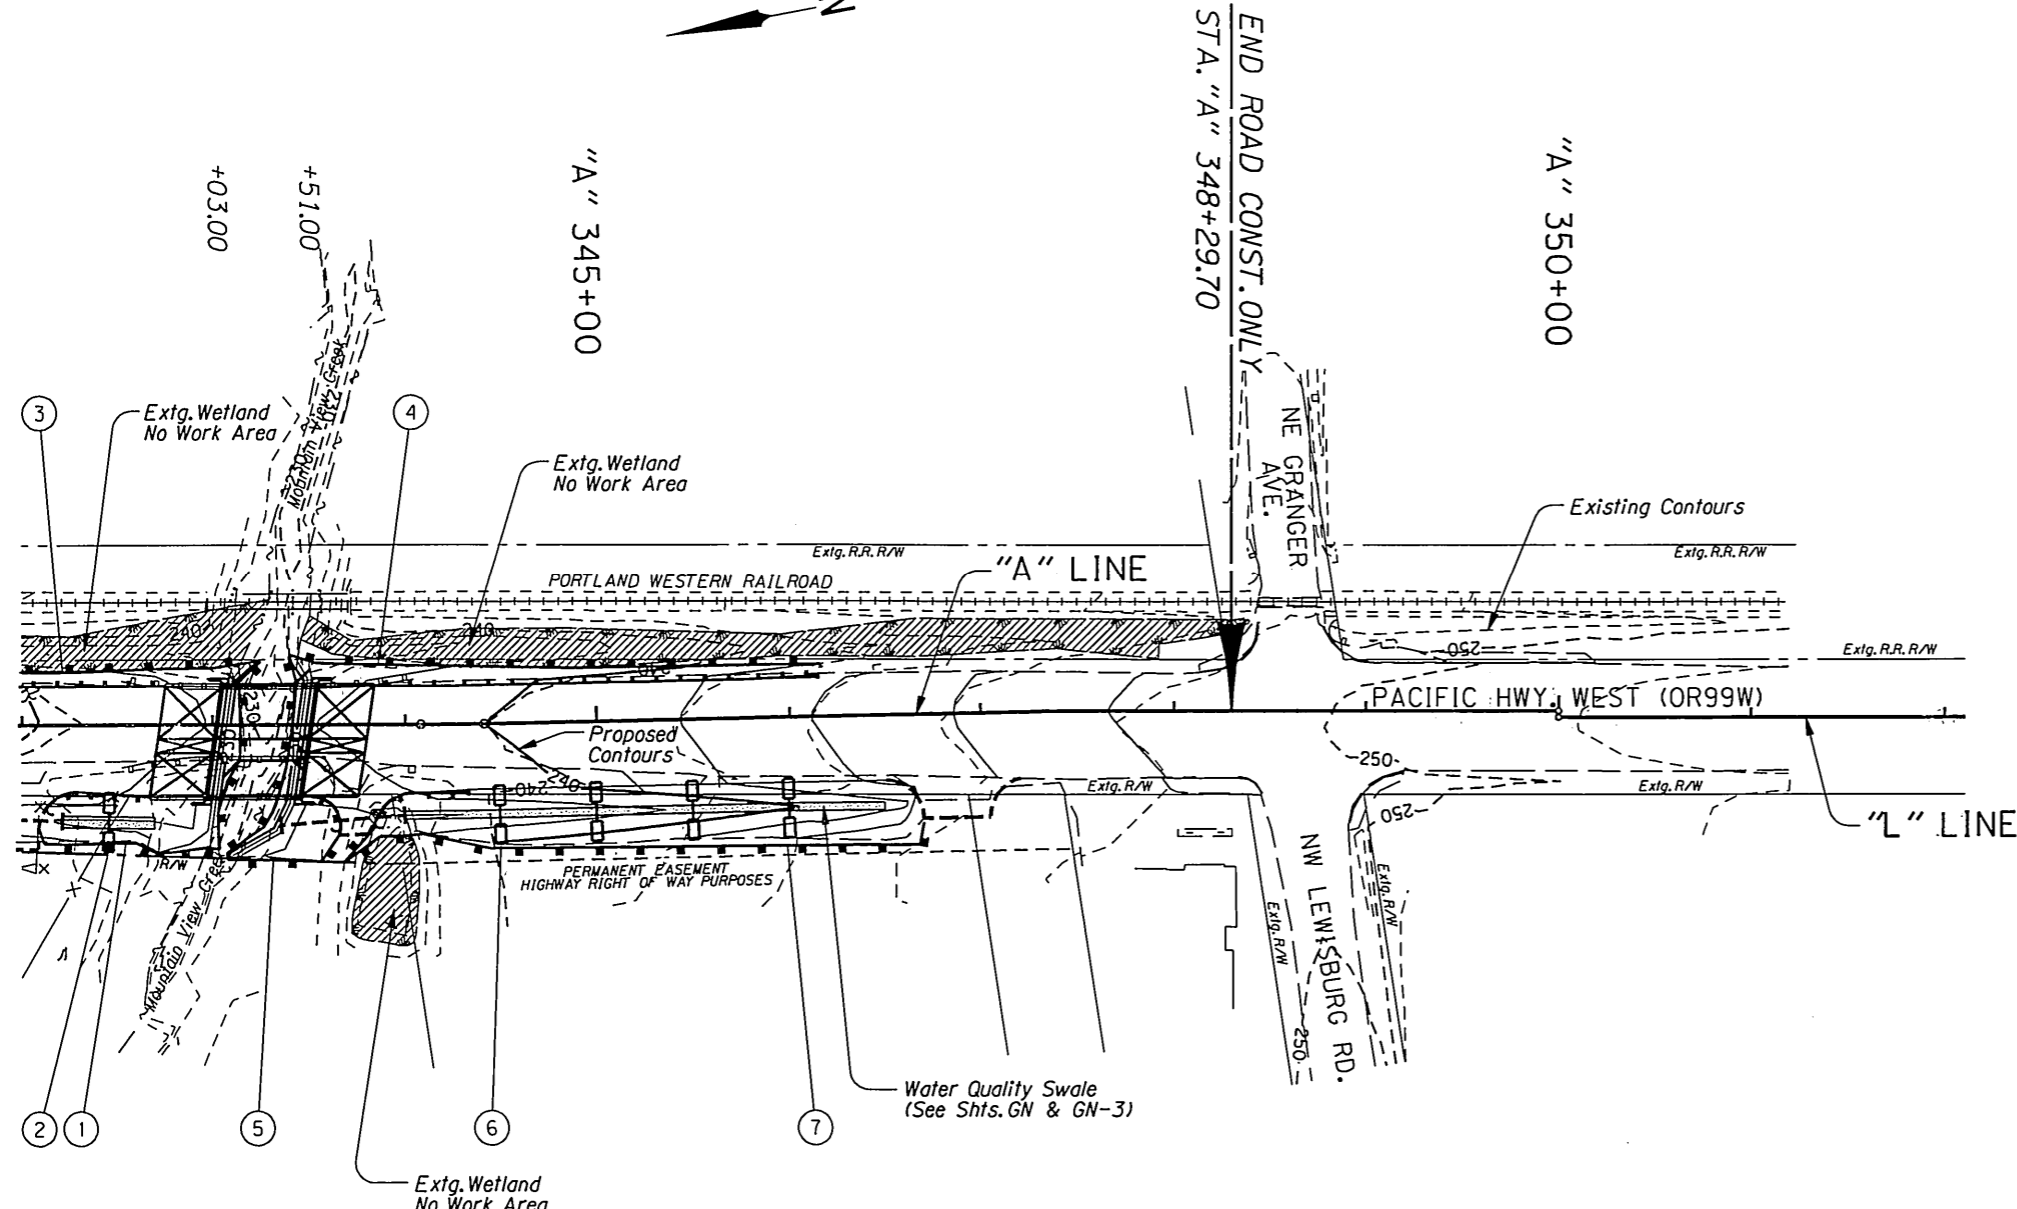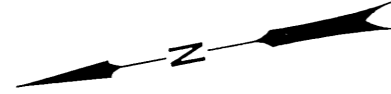


- ① See Note 5, Sht. GA-2.
- ② See Note 6, Sht. GA-2.
- ③ See Note 7, Sht. GA-2.
- ④ Sediment Fence Unsupported - 277'
- ⑤ Sediment Fence Unsupported - 185'
- ⑥ Const. Type 2 Check Dam - 4
- ⑦ Sediment Fence Unsupported - 328'

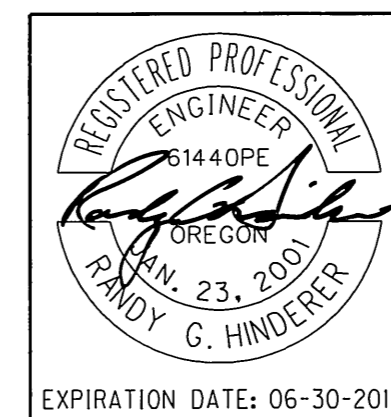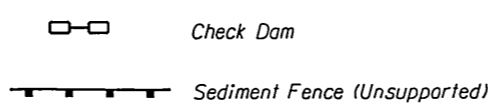


<p><b>OREGON DEPARTMENT OF TRANSPORTATION</b></p>	
<p><b>LOCHNER</b> CONSULTING ENGINEERS AND PLANNERS 2001 Front St. NE Suite 120 Salem, Oregon 97301 Phone (503) 586-0100 FAX (503) 589-9538</p>	
<p><b>OR99W: LOCKE CREEK BRIDGE REPLACEMENT PROJECT</b></p> <p>PACIFIC HIGHWAY WEST BENTON COUNTY</p>	
<p>Reviewed By - Randy G. Hinderer Designed By - Chee Yeun Loy Drafted By - Ryan Berger</p>	
<p><b>EROSION CONTROL</b></p>	<p>SHEET NO. <b>GA-3</b></p>

Sec. 12, T. 11S, R. 5W. W.M.  
PACIFIC HIGHWAY WEST

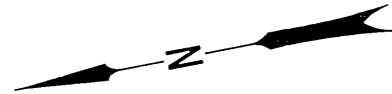

"A" 335+00  
BEGIN ROAD CONST. ONLY  
STA. "A" 334+68.00

"A" 340+00

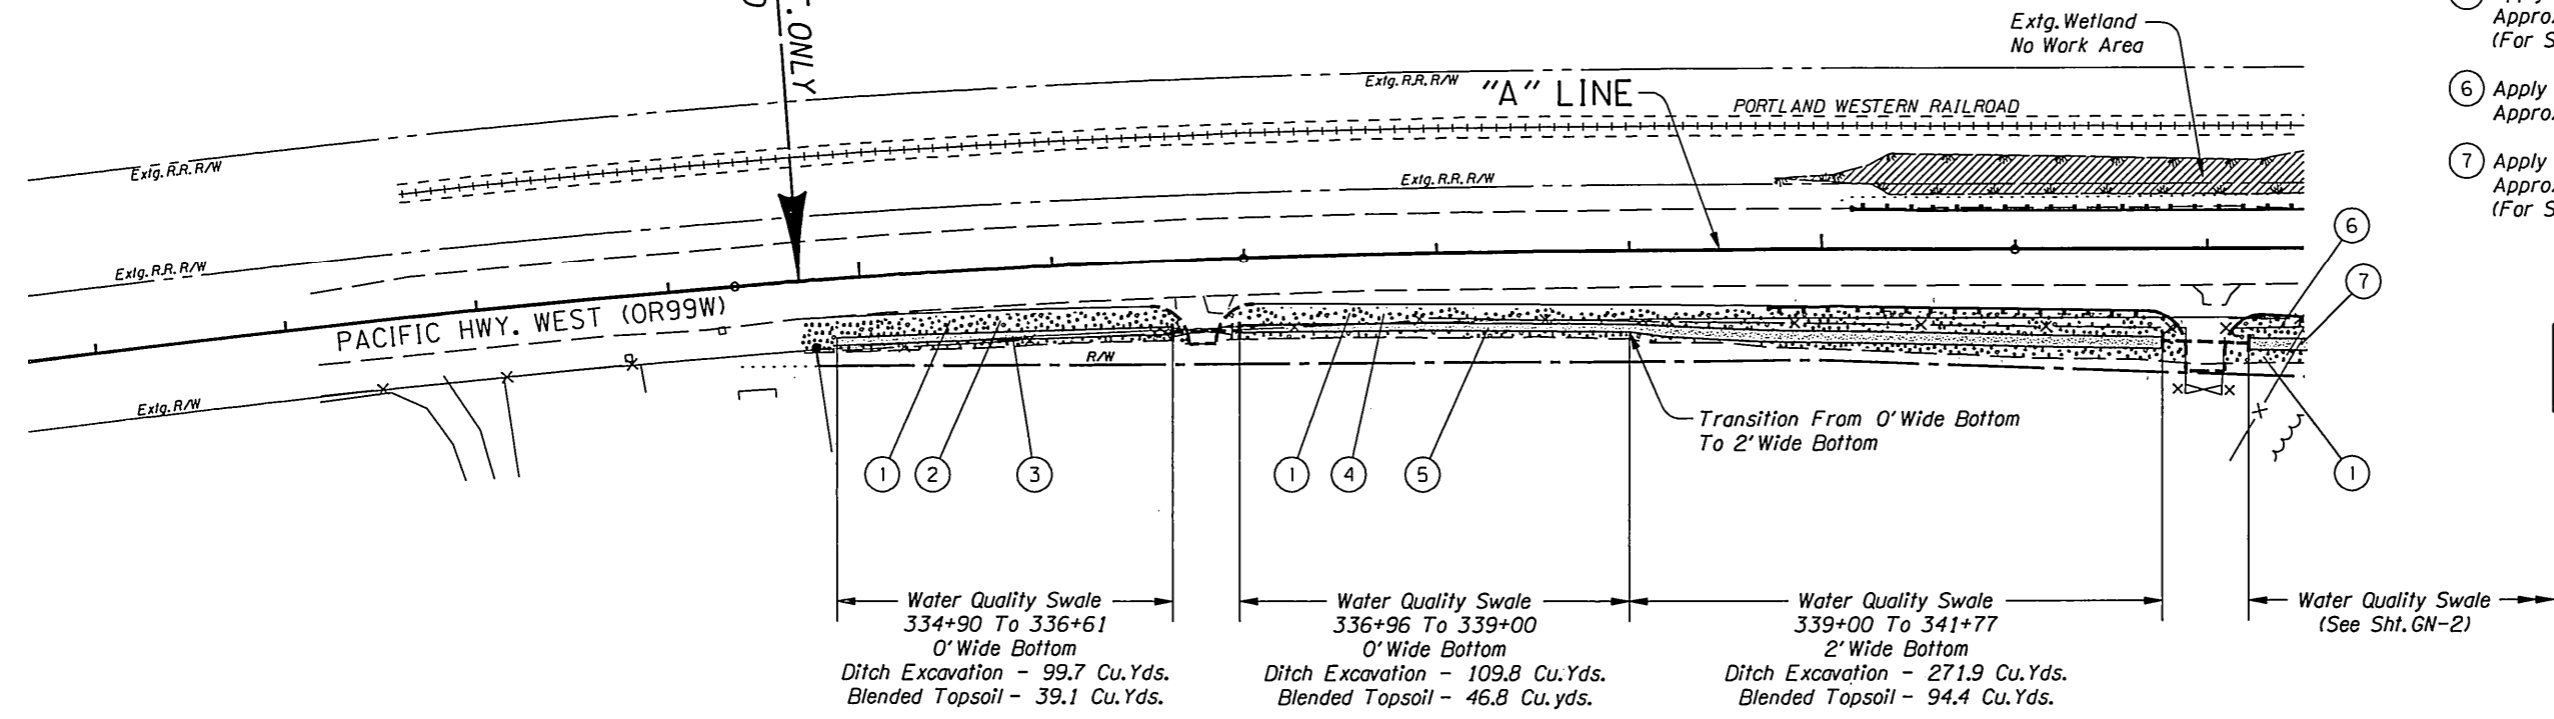

- ① Remove Extg. Vegetation As Necessary For Construction.
- ② Apply Permanent Seed Mix Approx. 0.06 Ac.
- ③ Apply Water Quality Seed Mix Approx. 0.02 Ac. (For Seed Mix, See Table Below)
- ④ Apply Permanent Seed Mix Approx. 0.18 Ac.
- ⑤ Apply Water Quality Seed Mix Approx. 0.05 Ac. (For Seed Mix, See Table Below)
- ⑥ Apply Permanent Seed Mix Approx. 0.03 Ac.
- ⑦ Apply Water Quality Seed Mix Approx. 0.01 Ac. (For Seed Mix, See Table Below)


Note:  
Excavation & Blended Topsoil Quantities Shown Are Approximate.

Water Quality Swale 334+90 To 336+61  
0' Wide Bottom  
Ditch Excavation - 99.7 Cu.Yds.  
Blended Topsoil - 39.1 Cu.Yds.


Water Quality Swale 336+96 To 339+00  
0' Wide Bottom  
Ditch Excavation - 109.8 Cu.Yds.  
Blended Topsoil - 46.8 Cu.Yds.

Water Quality Swale 339+00 To 341+77  
2' Wide Bottom  
Ditch Excavation - 271.9 Cu.Yds.  
Blended Topsoil - 94.4 Cu.Yds.

Water Quality Swale (See Sht. GN-2)

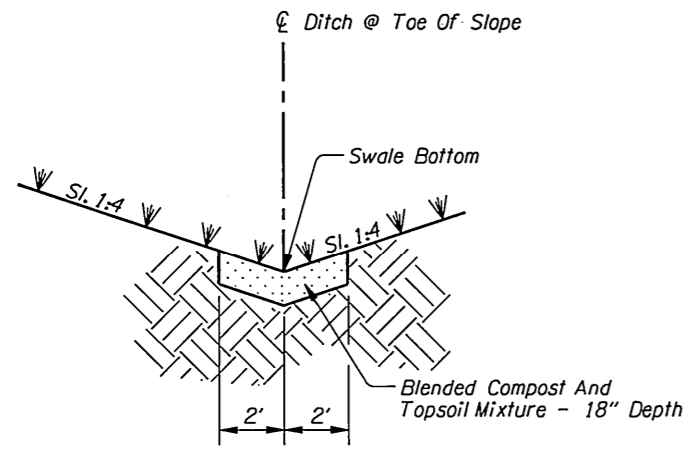

WATER QUALITY SWALE - 0' WIDE BOTTOM  
CROSS SECTION

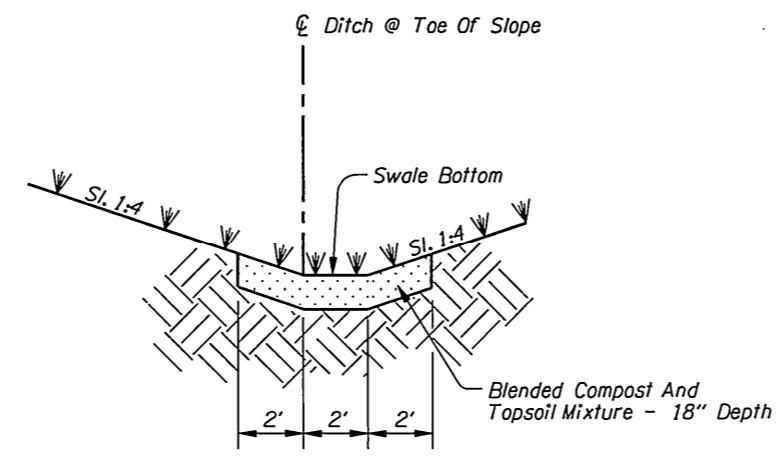


WATER QUALITY SWALE - 2' WIDE BOTTOM  
CROSS SECTION



EXPIRATION DATE: 06-30-2011


<b>OREGON DEPARTMENT OF TRANSPORTATION</b>	
<b>LOCHNER</b> CONSULTING ENGINEERS AND PLANNERS 2001 Front St. NE Suite 120 Salem, Oregon 97301 Phone (503) 586-0100 FAX (503) 589-0538	
<b>OR99W: LOCKE CREEK BRIDGE REPLACEMENT PROJECT</b>	
PACIFIC HIGHWAY WEST BENTON COUNTY	
Reviewed By - Randy C. Hinderer Designed By - Chee Yeun Loy Drafted By - Ryan Berger	
<b>ROADSIDE DEVELOPMENT</b>	SHEET NO. <b>GN</b>

Sec. 12, T. 11S, R. 5W. W.M.  
PACIFIC HIGHWAY WEST

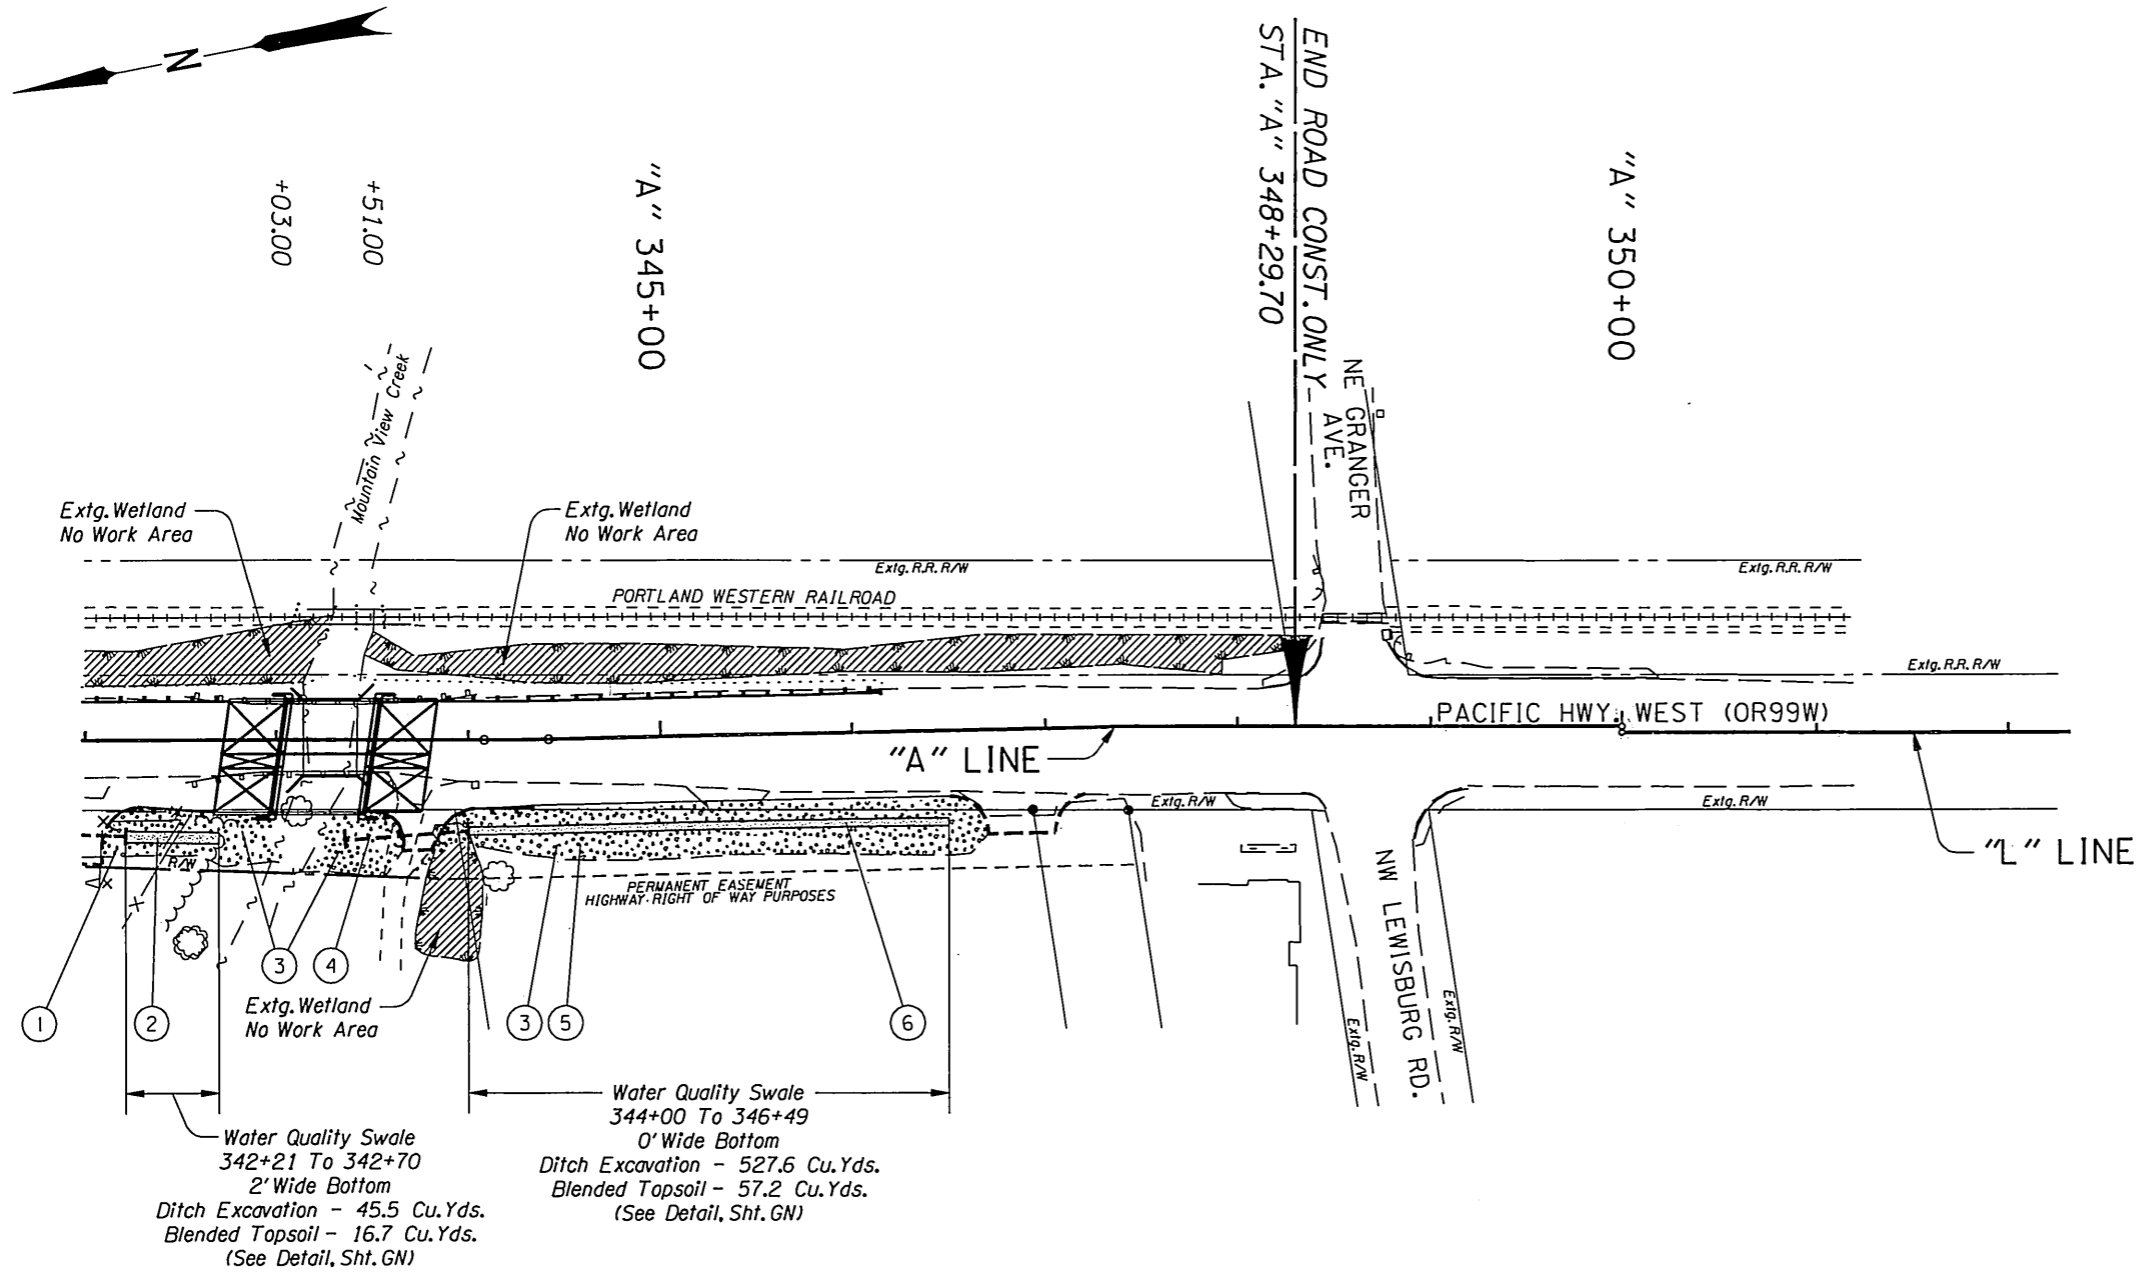


- ① See Note 6, Sht. GN.
- ② See Note 7, Sht. GN.
- ③ Remove Extg. Vegetation As Necessary For Construction.
- ④ Apply Permanent Seed Mix Approx. 0.03 Ac.
- ⑤ Apply Permanent Seed Mix Approx. 0.16 Ac.
- ⑥ Apply Water Quality Seed Mix Approx. 0.02 Ac. (For Seed Mix, See Sht. GN)

Note:  
Excavation & Blended Topsoil Quantities Shown Are Approximate.


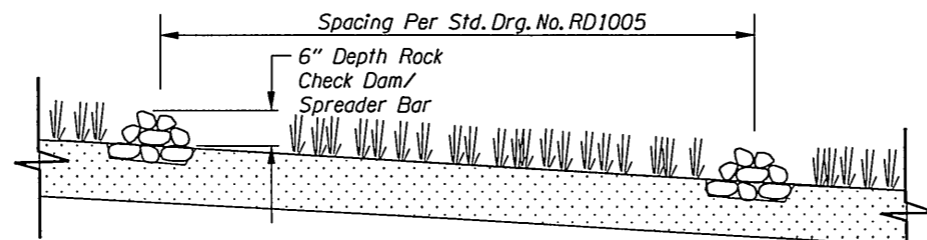


CHECK DAM INSTALLATION  
IN WATER QUALITY SWALE

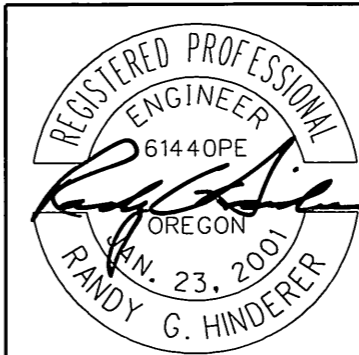


EXPIRATION DATE: 06-30-2011


<p>OREGON DEPARTMENT OF TRANSPORTATION</p>	
<p><b>LOCHNER</b> CONSULTING ENGINEERS AND PLANNERS 2001 Front St. NE Suite 120 Salem, Oregon 97301 Phone (503) 588-0100 FAX (503) 588-9538</p>	
<p>OR99W: LOCKE CREEK BRIDGE REPLACEMENT PROJECT PACIFIC HIGHWAY WEST BENTON COUNTY</p>	
<p>Reviewed By - Randy G. Hinderer Designed By - Chee Yeun Loy Drafted By - Ryan Berger</p>	
<p>ROADSIDE DEVELOPMENT</p>	<p>SHEET NO. GN-2</p>

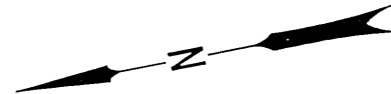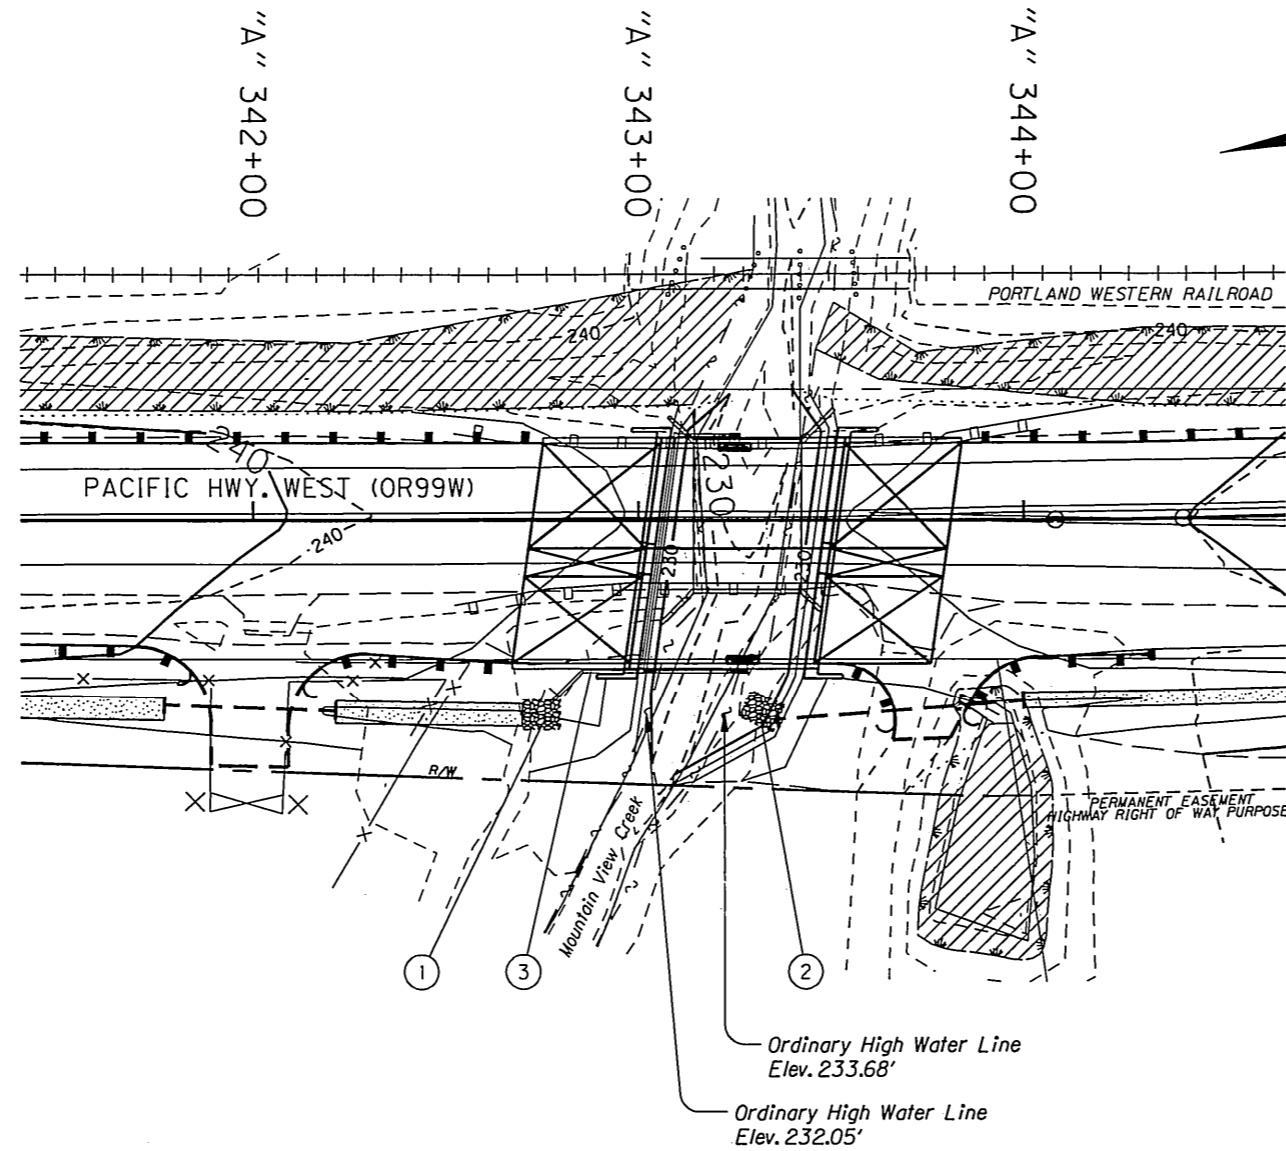


- ① Construct Dispersion Blanket  
8' Wide x 10' Long x 18" Deep  
Place Above Ordinary High Water Line  
(See Detail Below)
- ② Construct Dispersion Blanket  
8' Wide x 10' Long x 18" Deep  
Place Above Ordinary High Water Line  
(See Detail Below)
- ③ Bridge Drainage System  
Place Drain Outlet At Dispersion Blanket  
(See Bridge Plans For Drainage System Details)

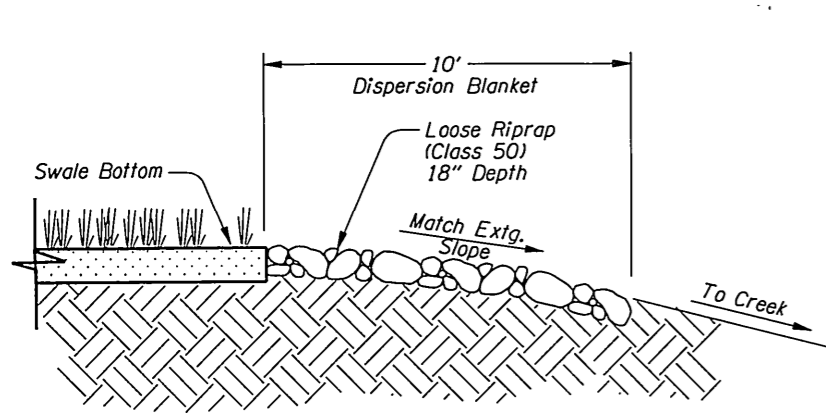


WATER QUALITY SWALE  
DISPERSION BLANKET SECTION

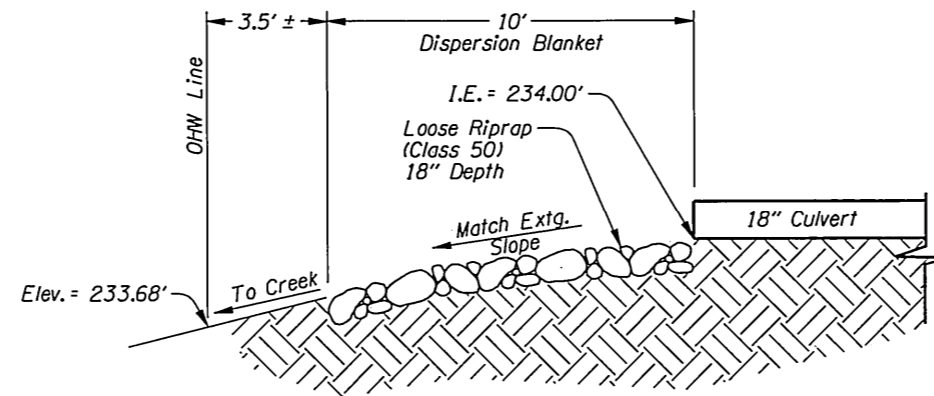

CROSS CULVERT OUTLET  
DISPERSION BLANKET SECTION

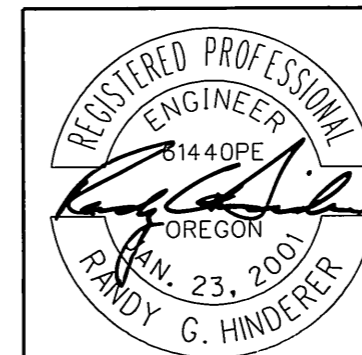

EXPIRATION DATE: 06-30-2011

 <b>OREGON DEPARTMENT OF TRANSPORTATION</b>	
<b>LOCHNER</b> <small>CONSULTING ENGINEERS AND PLANNERS                  2001 Front St. NE Suite 120 Salem, Oregon 97301                  Phone (503) 588-0100 FAX (503) 589-9538</small>	
<b>OR99W: LOCKE CREEK BRIDGE REPLACEMENT PROJECT</b> PACIFIC HIGHWAY WEST BENTON COUNTY	
Reviewed By - Randy G. Hinderer Designed By - Chee Yeun Lay Drafted By - Ryan Berger	
<b>ROADSIDE DEVELOPMENT</b>	SHEET NO. <b>GN-3</b>