

OPERATION & MAINTENANCE MANUAL

Manual prepared: August 2017

DFI No. D00203



Figure 1: DFI No. D00203, looking South

1. Identification

Drainage Facility ID (DFI): D00203
Facility Type: Water Quality Biofiltration Swale
Construction Drawings: (V-File Numbers) 42V-198
Location: District: 04
Highway No.: 091
Mile Post: 78.84 to 78.88, Right

2. Manual Purpose

The purpose of this manual is to outline inspection needs and summarize maintenance actions.

3. Facility Location

The location map below details the facility location. The highway, mile posts, side streets, access location, and stormwater flow directions are noted on the map.

Flow direction: North




Figure 2: Facility location map

4. Facility Summary

The length and width of a swale is based on the bottom dimensions.

The bottom length and bottom width of the swale is:


Bottom Length (feet)	Bottom Width (feet)
250	0

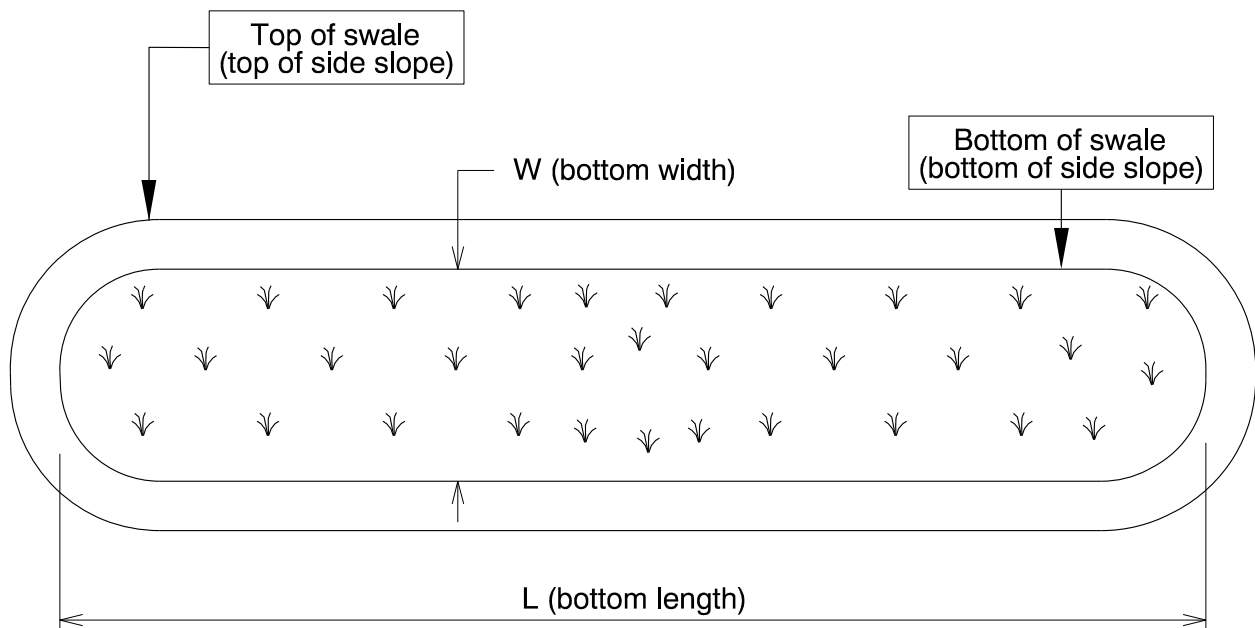

The depth of the swale is the vertical distance measured from the bottom of the swale to the top. The slope of the swale sides is presented by a vertical distance (rise) followed by the horizontal distance (run).

Depth and side slopes:

Depth (feet)	Rise (feet)	Run (feet)
0.5	1	4

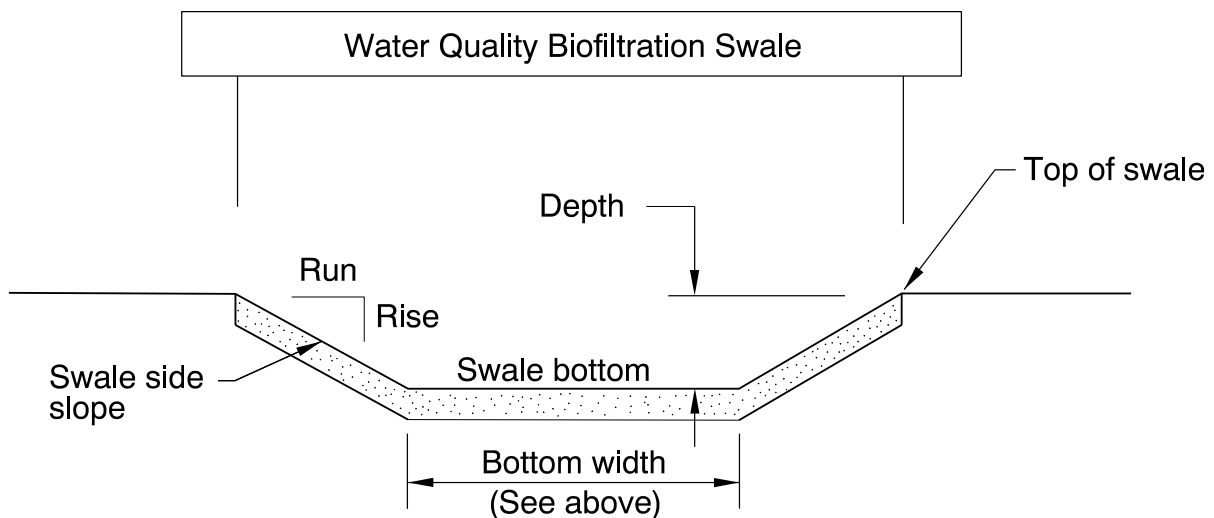

Site Specific Information: This swale does not have a flat bottom. It has 2' of WQ mix on either side of the centerline (toe of slope).

5. Facility Access

Maintenance access to the facility:

<input type="checkbox"/> Roadside pad	<input checked="" type="checkbox"/> Roadside shoulder
<input type="checkbox"/> Access road with Gate	<input type="checkbox"/> Access road without Gate



Figure 3: Shoulder area at South end of swale, looking South

6. Operational Components / Maintenance Items

Classification

This facility is classified as an:

<input checked="" type="checkbox"/> On-line Swale	<input type="checkbox"/> Off-line Swale
A swale that does not include a high flow bypass component; flow drains into and through the facility	A swale that treats low/small flows and diverts high flows using a bypass component

Bypass Component

This facility includes a high flow bypass component:

<input checked="" type="checkbox"/> No	<input type="checkbox"/> Yes
There is no bypass component. High flows drain into and through the facility	There is a bypass component. Only low/small flows drain into the swale. High flows are diverted around the swale using a bypass component

Operational Components

A swale has many components that assist with treatment, conveyance, and reducing flow velocity to minimize erosion. The components in use can vary depending if the facility was designed to operate on-line or off-line. The facility components table (**Table 1**) has been provided to highlight the applicable components for this facility. The component is in use when the box contains an “x” (e.g.).

The Standard Operation Manual for Water Quality Biofiltration Swales (implemented March 2017) outlines facility operation, typical footprint configuration, and component definitions and details. A link to the manual is attached to the feature marker in TransGIS.

<https://gis.odot.state.or.us/TransGIS/>

Operational Plan

The applicable standard operational plan for this facility is:

<input checked="" type="checkbox"/> Operational Plan A <input type="checkbox"/> Operational Plan B <input type="checkbox"/> Operational Plan C
A standard operational plan illustrates the general facility footprint configuration and explains the purpose of each facility component. Operational plans (A, B, C) are provided in the Standard Operation Manual.

See Appendix A for the site specific operational plan.

Maintenance Items

Operational components marked in **Table 1** should be inspected and maintained according to Section 7. Each facility component is defined and detailed in the Standard Operation Manual using the associated ID number indicated below.

Table 1: Swale Components		ID #
Manholes/Structures		
Pre-treatment manhole	<input type="checkbox"/>	S1
Weir type flow splitter/flow splitter manhole	<input type="checkbox"/>	S2
Orifice type flow splitter/flow splitter manhole	<input type="checkbox"/>	S3
Standard manhole	<input type="checkbox"/>	S4
Swale Inlet		
Pavement sheet flow	<input checked="" type="checkbox"/>	S5
Inlet Pipe (s)	<input type="checkbox"/>	S6
Open channel inlet	<input type="checkbox"/>	S7
Riprap pad	<input type="checkbox"/>	S8
Ground Cover		
Grass bottom	<input checked="" type="checkbox"/>	S9
Grass side slopes	<input checked="" type="checkbox"/>	S10
Granular drain rock	<input type="checkbox"/>	S11
Plantings	<input type="checkbox"/>	S12
Underground Components		
Geotextile fabric	<input type="checkbox"/>	S13
Water quality mix	<input checked="" type="checkbox"/>	S14
Perforated pipe	<input type="checkbox"/>	S15
Porous pavers (access grid)	<input type="checkbox"/>	S16
Flow Spreader		
Rock basin (used at inlet)	<input type="checkbox"/>	S17
Anchored board (midpoint of swale or every 50 feet along swale bottom)	<input type="checkbox"/>	S18
Other: Riprap check dams	<input checked="" type="checkbox"/>	S19
Swale Outlet		
Catch basin with grate	<input type="checkbox"/>	S20
Outlet Pipe (s)	<input checked="" type="checkbox"/>	S21
Open channel outlet	<input type="checkbox"/>	S22
Auxiliary Outlet:	<input type="checkbox"/>	S23
Outfall Type		
Waterbody (Creek/Lake/Ocean)	<input checked="" type="checkbox"/> C	S24
	<input type="checkbox"/> L	
	<input type="checkbox"/> O	
Ditch	<input type="checkbox"/>	S25
Storm drain system	<input type="checkbox"/>	S26
Outfall Components		
Riprap pad	<input type="checkbox"/>	S27
Riprap bank protection	<input checked="" type="checkbox"/>	S28

7. Maintenance

Maintenance Frequency/Maintain Records

- a. Inspect annually. Preferably prior to the rainy season.
- b. Clean and maintain as necessary. Refer to Activity 125 for conditions when maintenance is needed.
- c. Keep a record of inspections, maintenance, and repairs.

Maintenance Guide/Maintenance Actions

The ODOT Routine Road Maintenance Water Quality and Habitat Guide (the *Blue Book*) outlines the standard maintenance actions for water quality facilities under Activity 125.

There are standard maintenance tables for standard ODOT designs. The maintenance tables describe the maintenance component, the defect or problem, the condition when maintenance is needed, and the recommended maintenance to correct the problem. Use the following tables to maintain ODOT swales:

- Table 1 (General Maintenance): Contains general maintenance and inspection guidelines that are applicable to all ODOT water quality facilities
- Table 3 (Maintenance of Water Quality or Biofiltration Swales): Contains maintenance information for swales

The *Blue Book* can be viewed at the following website:

http://www.oregon.gov/ODOT/Maintenance/Documents/blue_book.pdf

8. Limitations

Access grid installed:

<input checked="" type="checkbox"/> No	<input type="checkbox"/> Yes
There are (Choose applicable weight: no, light, med., heavy) duty porous pavers installed in this swale	

Swales are designed to allow equipment access along the bottom. If an access grid is **NOT** installed, vehicles entering the swale can create depressions (tire ruts), damage vegetation, and damage structural components (e.g. flow spreaders). These conditions may result in poor treatment and drainage performance.

Equipment wheels should be kept on the tops and side slopes. Mower arms may be run along the swale bottom.

9. Waste Material Handling

Material removed from the facility is defined as waste by the Department of Environmental Quality (DEQ). Refer to the roadwaste section of the ODOT Maintenance Yard Environmental Management System (EMS) Policy and Procedures Manual for disposal options:

http://www.oregon.gov/ODOT/Maintenance/Documents/ems_manual.pdf


Contact any of the following for more detailed information about management of waste materials found on site:

ODOT Clean Water Unit	(503) 986-3008
ODOT Statewide Hazmat Coordinator	(503) 667-7442
ODOT Region 1 Hazmat Coordinator	(503) 731-8290
ODOT Region 2 Hazmat Coordinator	(503) 986-2647
ODOT Region 3 Hazmat Coordinator	(541) 957-3594
ODOT Region 4 Hazmat Coordinator	(541) 388-6186
ODOT Region 5 Hazmat Coordinator	(541) 963-1590
ODEQ Northwest Region Office	(503) 229-5263


A Appendix A – Site Specific Operational Plan

Contents:


Operational Plan: DFI D00203

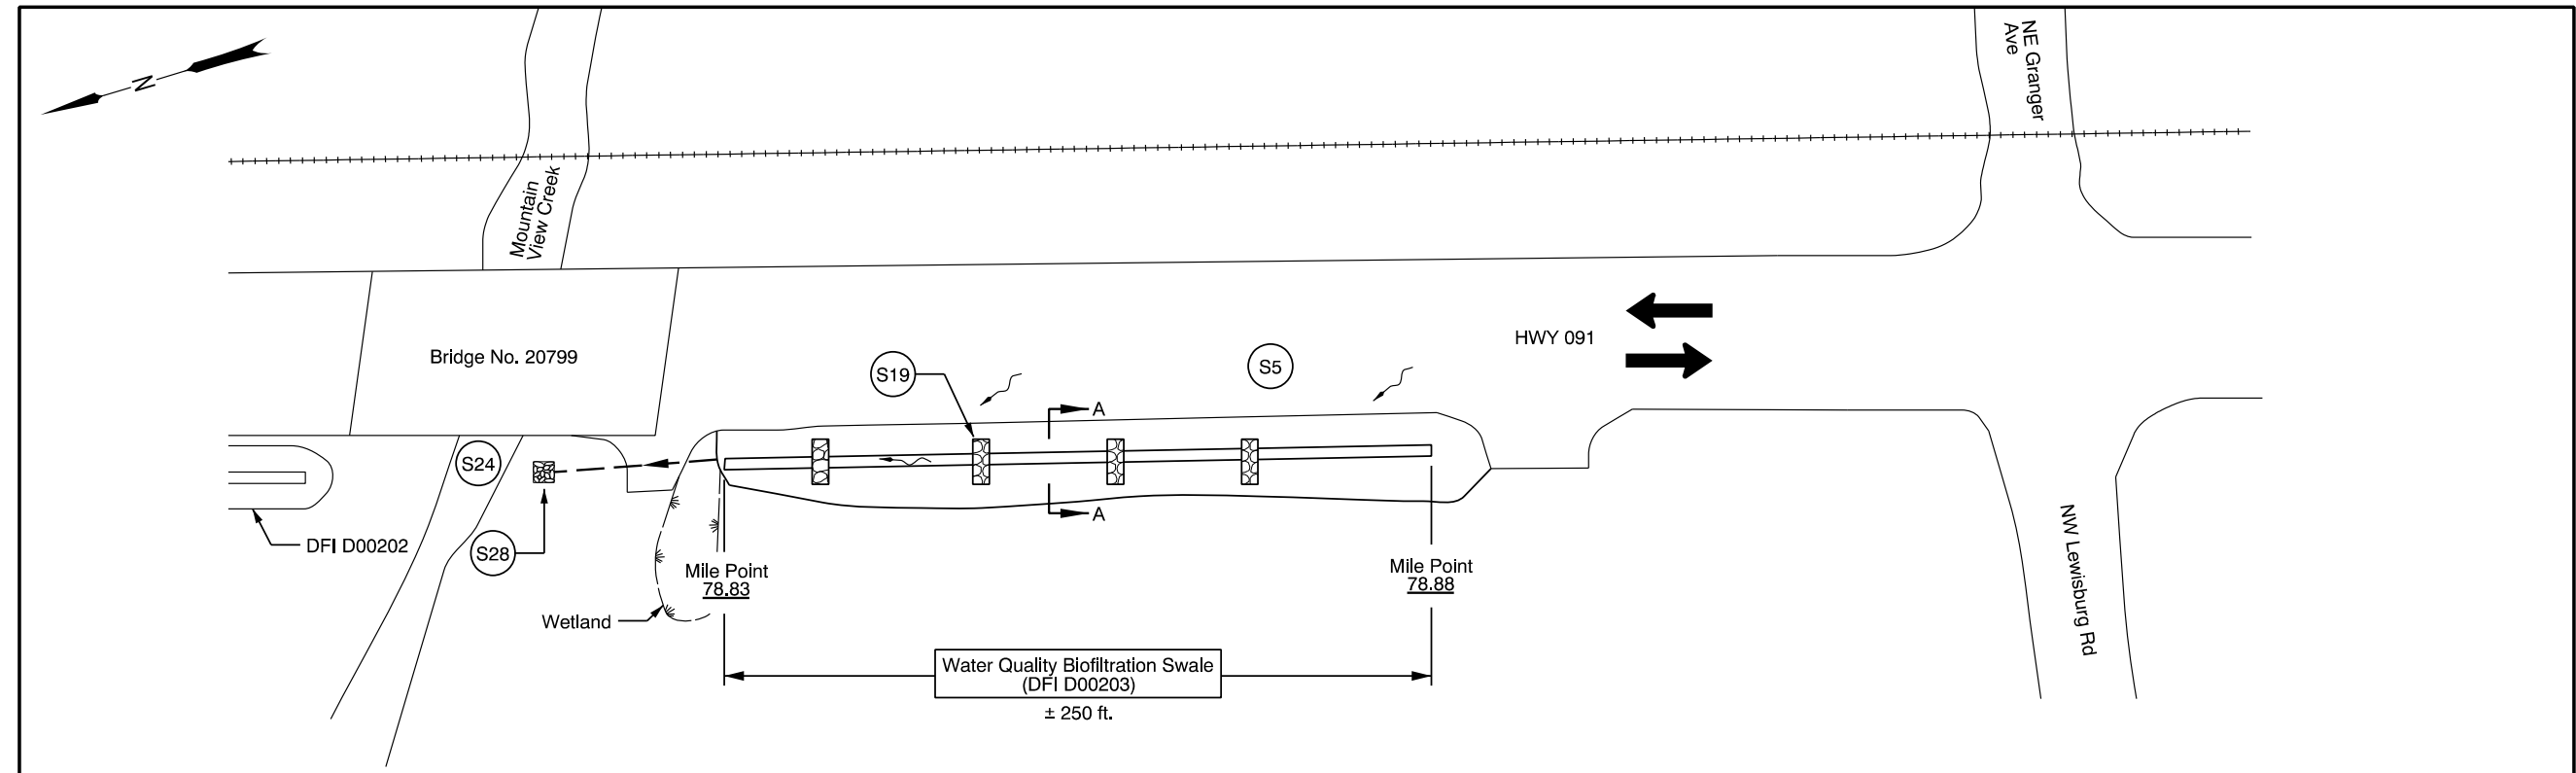

PLAN
N.T.S.

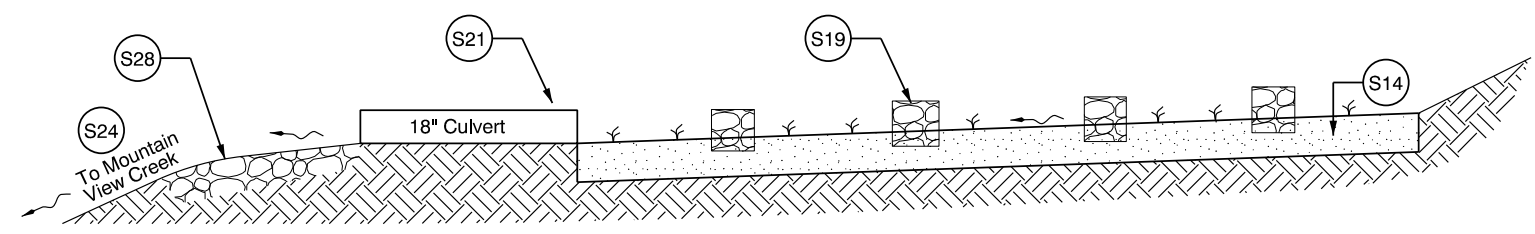

PROFILE
N.T.S.

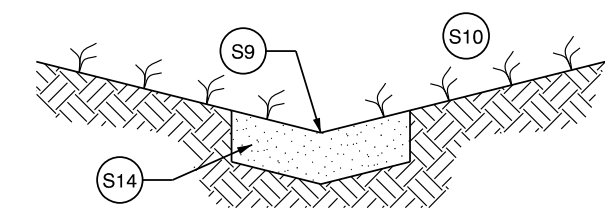

SECTION A-A
N.T.S.

- LEGEND**
- Storm Pipe
 - ~ Stormwater Flow Path
 - ← Traffic Flow Direction

OREGON DEPARTMENT OF TRANSPORTATION	
Prepared By: <u>Brooklyn Scholz</u>	DFI D00203 MAINTENANCE DISTRICT 4 HWY 091 WATER QUALITY BIOFILTRATION SWALE HIGHWAY MP 78.83, 78.88 BENTON
Drafted By: <u>Brooklyn Scholz</u>	

DFI_D00203.dgn

B Appendix B – Project Contract Plans

Contents:


Site Specific Subset of Project Contract Plan 42V-198

STATE OF OREGON
DEPARTMENT OF TRANSPORTATION
PLANS FOR PROPOSED PROJECT

GRADING, STRUCTURE, PAVING, & GUARDRAIL

OR99W: LOCKE CREEK BRIDGE REPLACEMENT PROJECT

PACIFIC HIGHWAY WEST

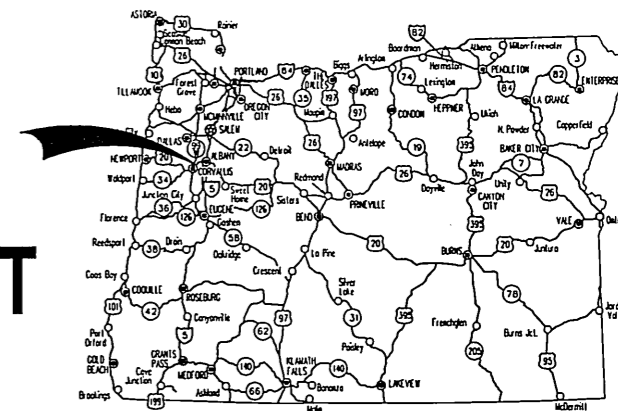

Overall Length Of Project - 0.26 Miles

INDEX OF SHEETS	
SHEET NO.	DESCRIPTION
1	Title Sheet
1A	Index Of Sheets Cont'd. & Std. Drg. Nos.

ATTENTION:
Oregon Law Requires You To Follow Rules Adopted By The Oregon Utility Notification Center. Those Rules Are Set Forth In OAR 952-001-0010 Through OAR 952-001-0090. You May Obtain Copies Of The Rules By Calling The Center. (Note: The Telephone Number For The Oregon Utility Center Is (503) 232-1987.)



**BENTON COUNTY
NOVEMBER 2009**

BEGINNING OF CONTRACT PROJECT

STA. "A" 327+62.00 (MP 78.54)

BEGINNING OF PROJECT


STA. "A" 334+68.00 (MP 78.67)

END OF PROJECT

STA. "A" 348+29.70 (MP 78.93)

END OF CONTRACT PROJECT

STA. "A" 354+14.50 (MP 79.04)

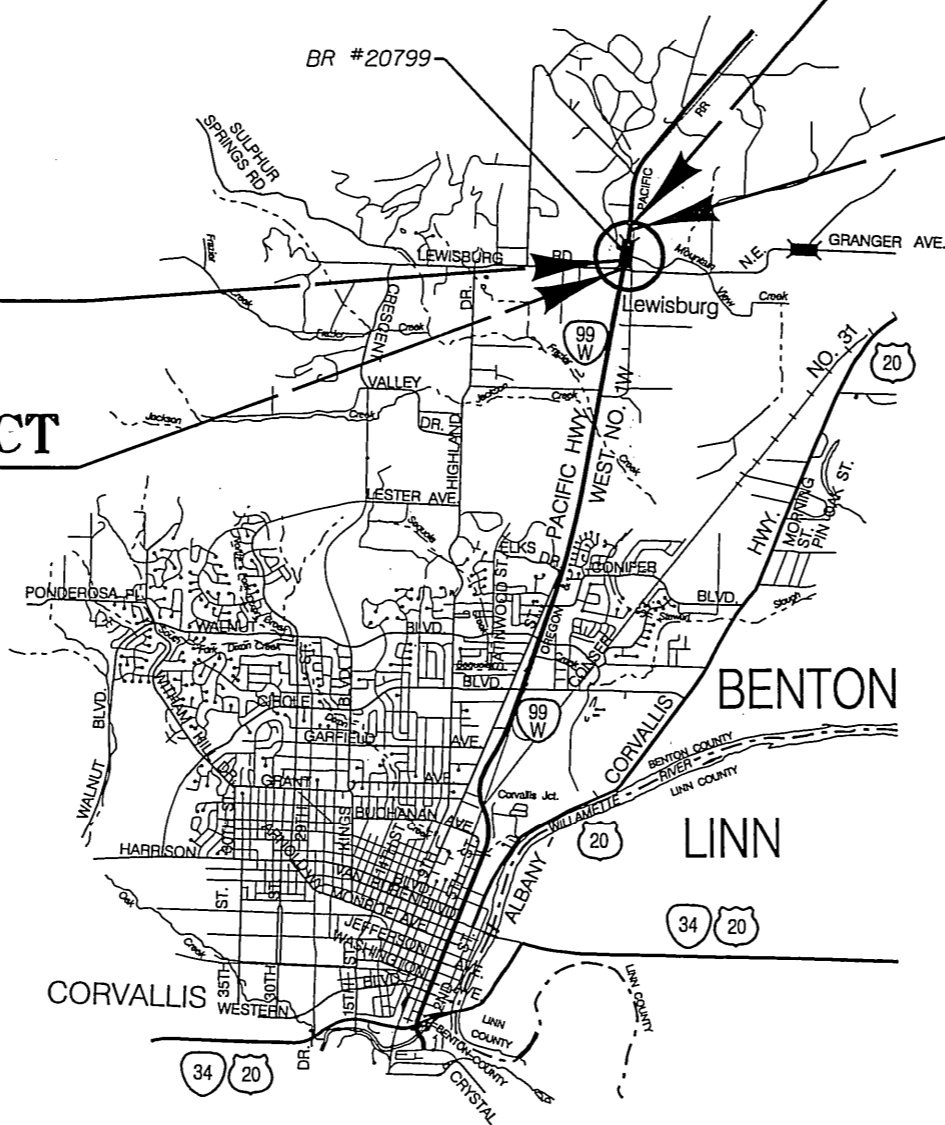


OREGON TRANSPORTATION COMMISSION	
Gail Achterman	CHAIRMAN
Michael Nelson	VICE CHAIRMAN
Janice Wilson	COMMISSIONER
Alan Brown	COMMISSIONER
David Lohman	COMMISSIONER
Matthew Garrett	DIRECTOR OF TRANSPORTATION



These plans were developed using ODOT design standards. Exceptions to these standards, if any, have been submitted and approved by the ODOT Chief Engineer or their delegated authority.

Approving Authority: *Randy G. Hinderer* 9/24/09
Signature & date
Randy G. Hinderer P.E.
Print name and title
[Signature]
Concurrence by ODOT Chief Engineer

OR99W: LOCKE CREEK BRIDGE REPLACEMENT PROJECT		
PACIFIC HIGHWAY WEST		
BENTON COUNTY		
FEDERAL HIGHWAY ADMINISTRATION	PROJECT NUMBER	SHEET NO.
OREGON DIVISION	X-BRO-S091 (035)	1

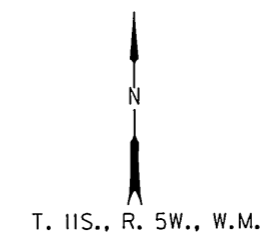

Sec. 12, T. 11S, R. 5W. W.M.
PACIFIC HIGHWAY WEST

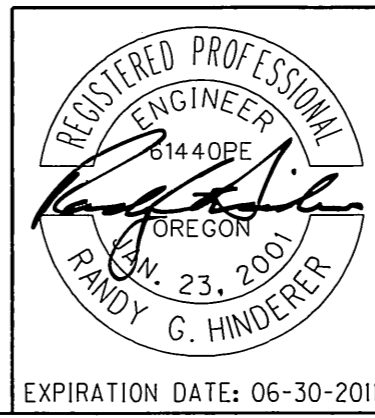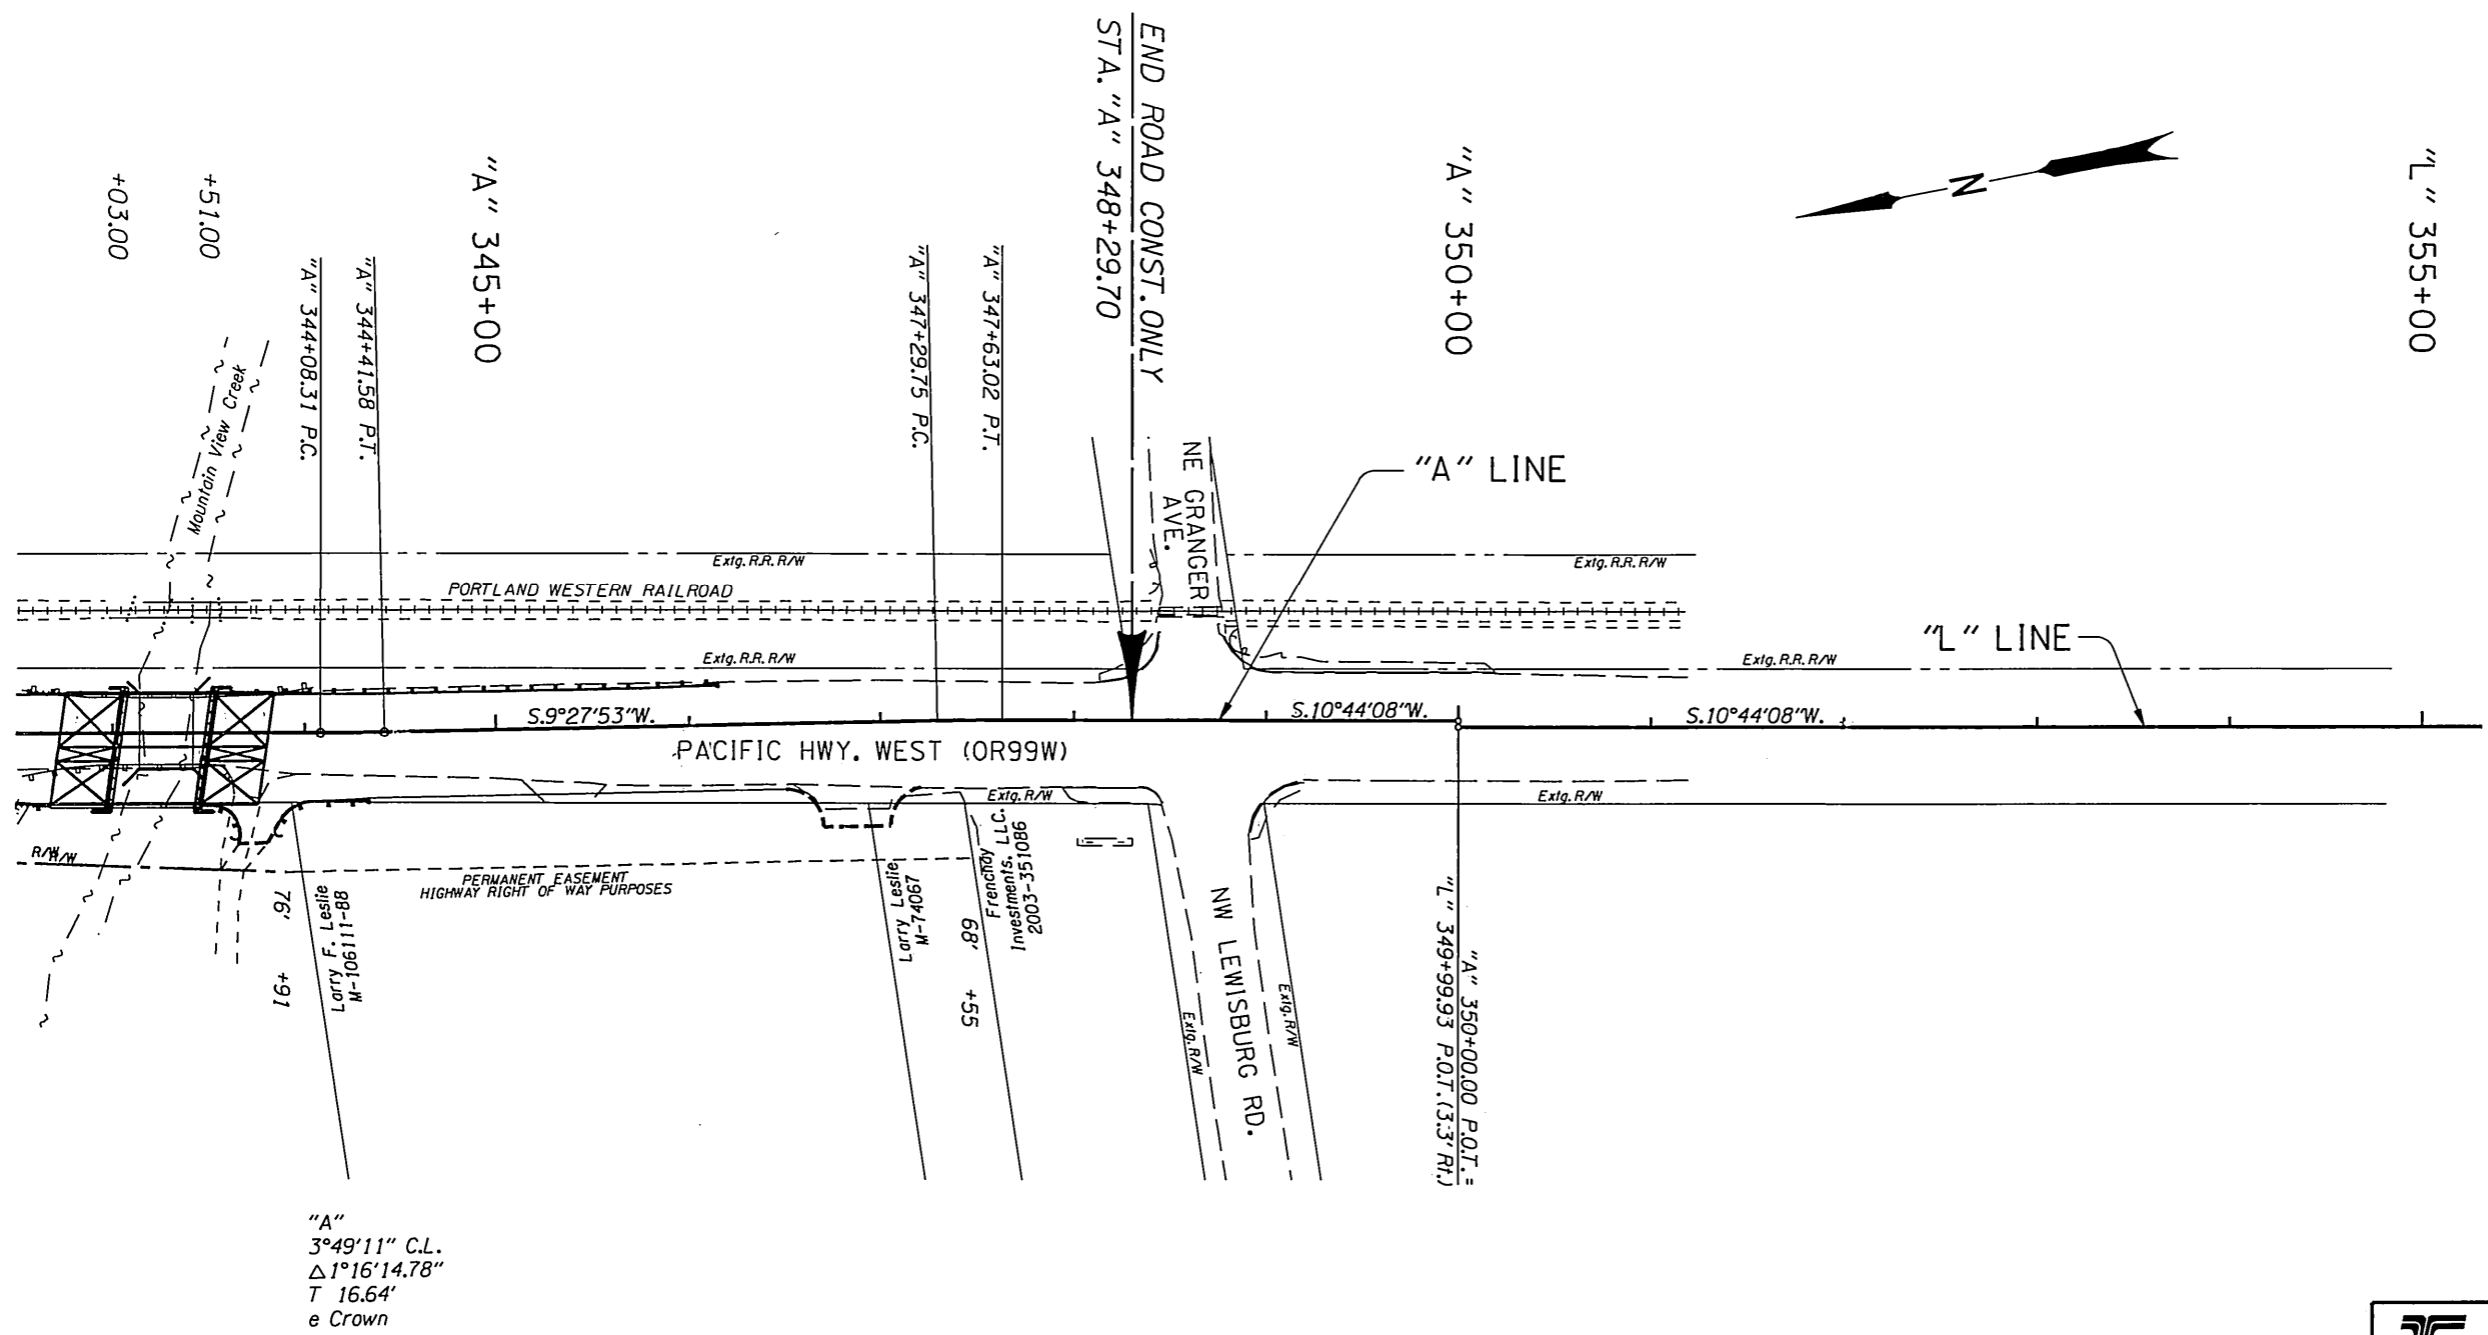

OREGON DEPARTMENT OF TRANSPORTATION	
LOCHNER CONSULTING ENGINEERS AND PLANNERS 2001 Front St. NE Suite 120 Salem, Oregon 97301 Phone (503) 586-0100 FAX (503) 589-9538	
OR99W: LOCKE CREEK BRIDGE REPLACEMENT PROJECT PACIFIC HIGHWAY WEST BENTON COUNTY	
Reviewed By - Randy G. Hinderer Designed By - Chee Yeun Loy Drafted By - Ryan Berger	
ALIGNMENT	SHEET NO. 4

Sec. 12, T. 11S, R. 5W. W.M.
PACIFIC HIGHWAY WEST




END ROAD CONST. ONLY
STA. "A" 348+29.70

"A" 350+00

"A" 345+00

+03.00
+51.00

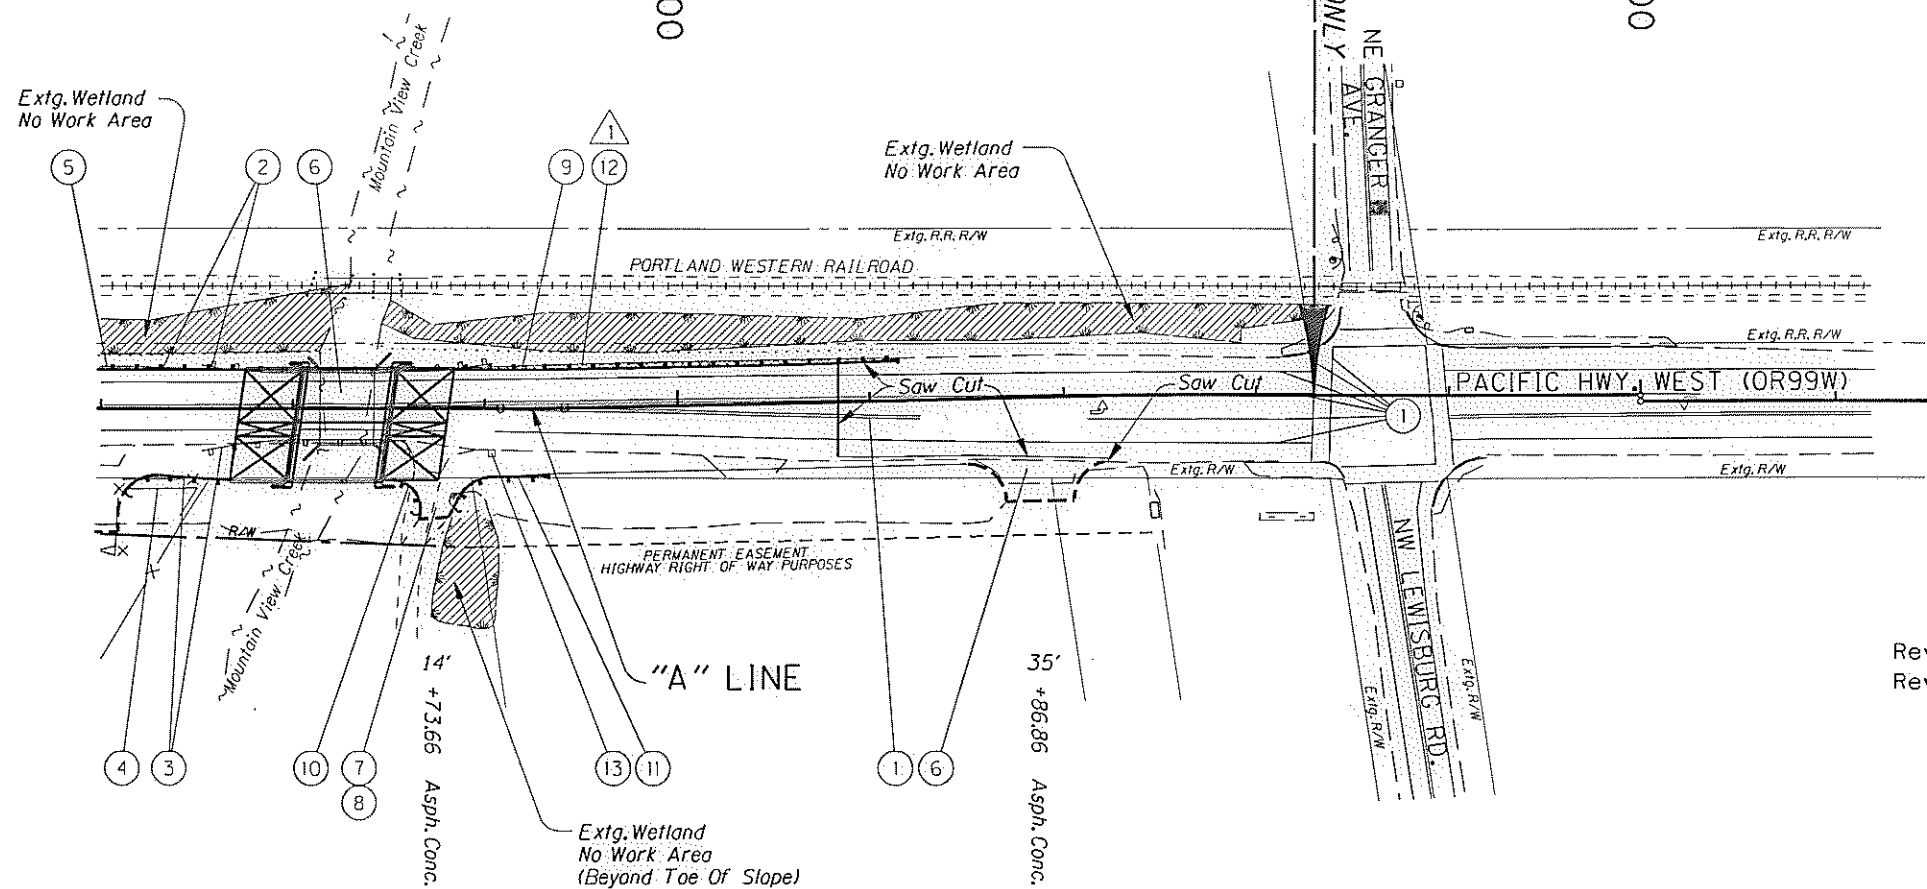


- ① See Note 2, Sht. 3A.
- ② See Note 4, Sht. 3A.
- ③ See Note 5, Sht. 3A.
- ④ See Note 6, Sht. 3A.
- ⑤ See Note 7, Sht. 3A.
- ⑥ Bridge No. 20799
Remove Extg. Bridge
Construct Structure - 107.3'
Rdwy. Width 60' With 0' Walk
And Reinf. Panel At Bridge Ends
(For Details, See Bridge Plans)
- ⑦ Construct Type "A-1" Roadway Approach - 2
- ⑧ Reconstruct Extg. Dwy. Within Right Of Way Limits
(See Drg. RD715)
- ⑨ Sta. "A" 343+84.12, 20.0' Lt. To Sta. "A" 346+15.71, 21.2' Lt.
Construct Guardrail - 193.5' (Type 2A)
Construct Guardrail - 12.5' (Type 3)
Construct Guardrail Terminal, Non-Flare (Test Level 2) - 25'
Construct Guardrail To Conc. Bridge Rail Transition
- ⑩ Sta. "A" 343+45.72, 37.3' Rt. To Sta. "A" 343+66.76, 53.4' Rt.
Construct Guardrail - 12.5' (Type 4)
Install Type 1 Modified Anchor
Install Type B End Piece
Construct Guardrail To Conc. Bridge Rail Transition
(See Detail, Sht. 2B)
- ⑪ Sta. "A" 343+84.76, 50.1' Rt. To Sta. "A" 344+33.40, 35.4' Rt.
Construct Guardrail - 31' (Type 2A)
Construct Guardrail Terminal, Non-Flare (Test Level 2) - 25'
Install Type 1 Modified Anchor
Install Type B End Piece
- ⑫ Sta. "A" 343+84.00 To Sta. "A" 346+15.00, Lt.
Remove Extg. Surfacing - 66 Sq. Yds.
- ⑬ Sta. "A" 344+03.74, 27.1' Rt.
Relocate Existing Mail Box
Remove Existing Mail Box Support
Install New Mailbox Support
Contractor To Coordinate With United States Postal Service
For Relocation
(See Drg. RD100, RD101)

Revised 10-20-2009,



Revised Terminology, Note 12

REVISIONS	
⚠	Revised 10-20-2009 Addendum #1

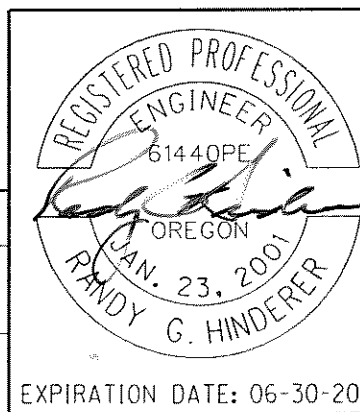


OREGON DEPARTMENT OF TRANSPORTATION	
LOCHNER CONSULTING ENGINEERS AND PLANNERS 2001 Front St. NE Suite 120 Salem, Oregon 97301 Phone (503) 586-0100 FAX (503) 589-9538	
OR99W: LOCKE CREEK BRIDGE REPLACEMENT PROJECT	
PACIFIC HIGHWAY WEST BENTON COUNTY	
Reviewed By - Randy G. Hinderer Designed By - Chee Yeun Lay Drafted By - Ryan Berger	
GENERAL CONSTRUCTION	SHEET NO. 4A


Sec. 12, T. 11S, R. 5W. W.M.
PACIFIC HIGHWAY WEST

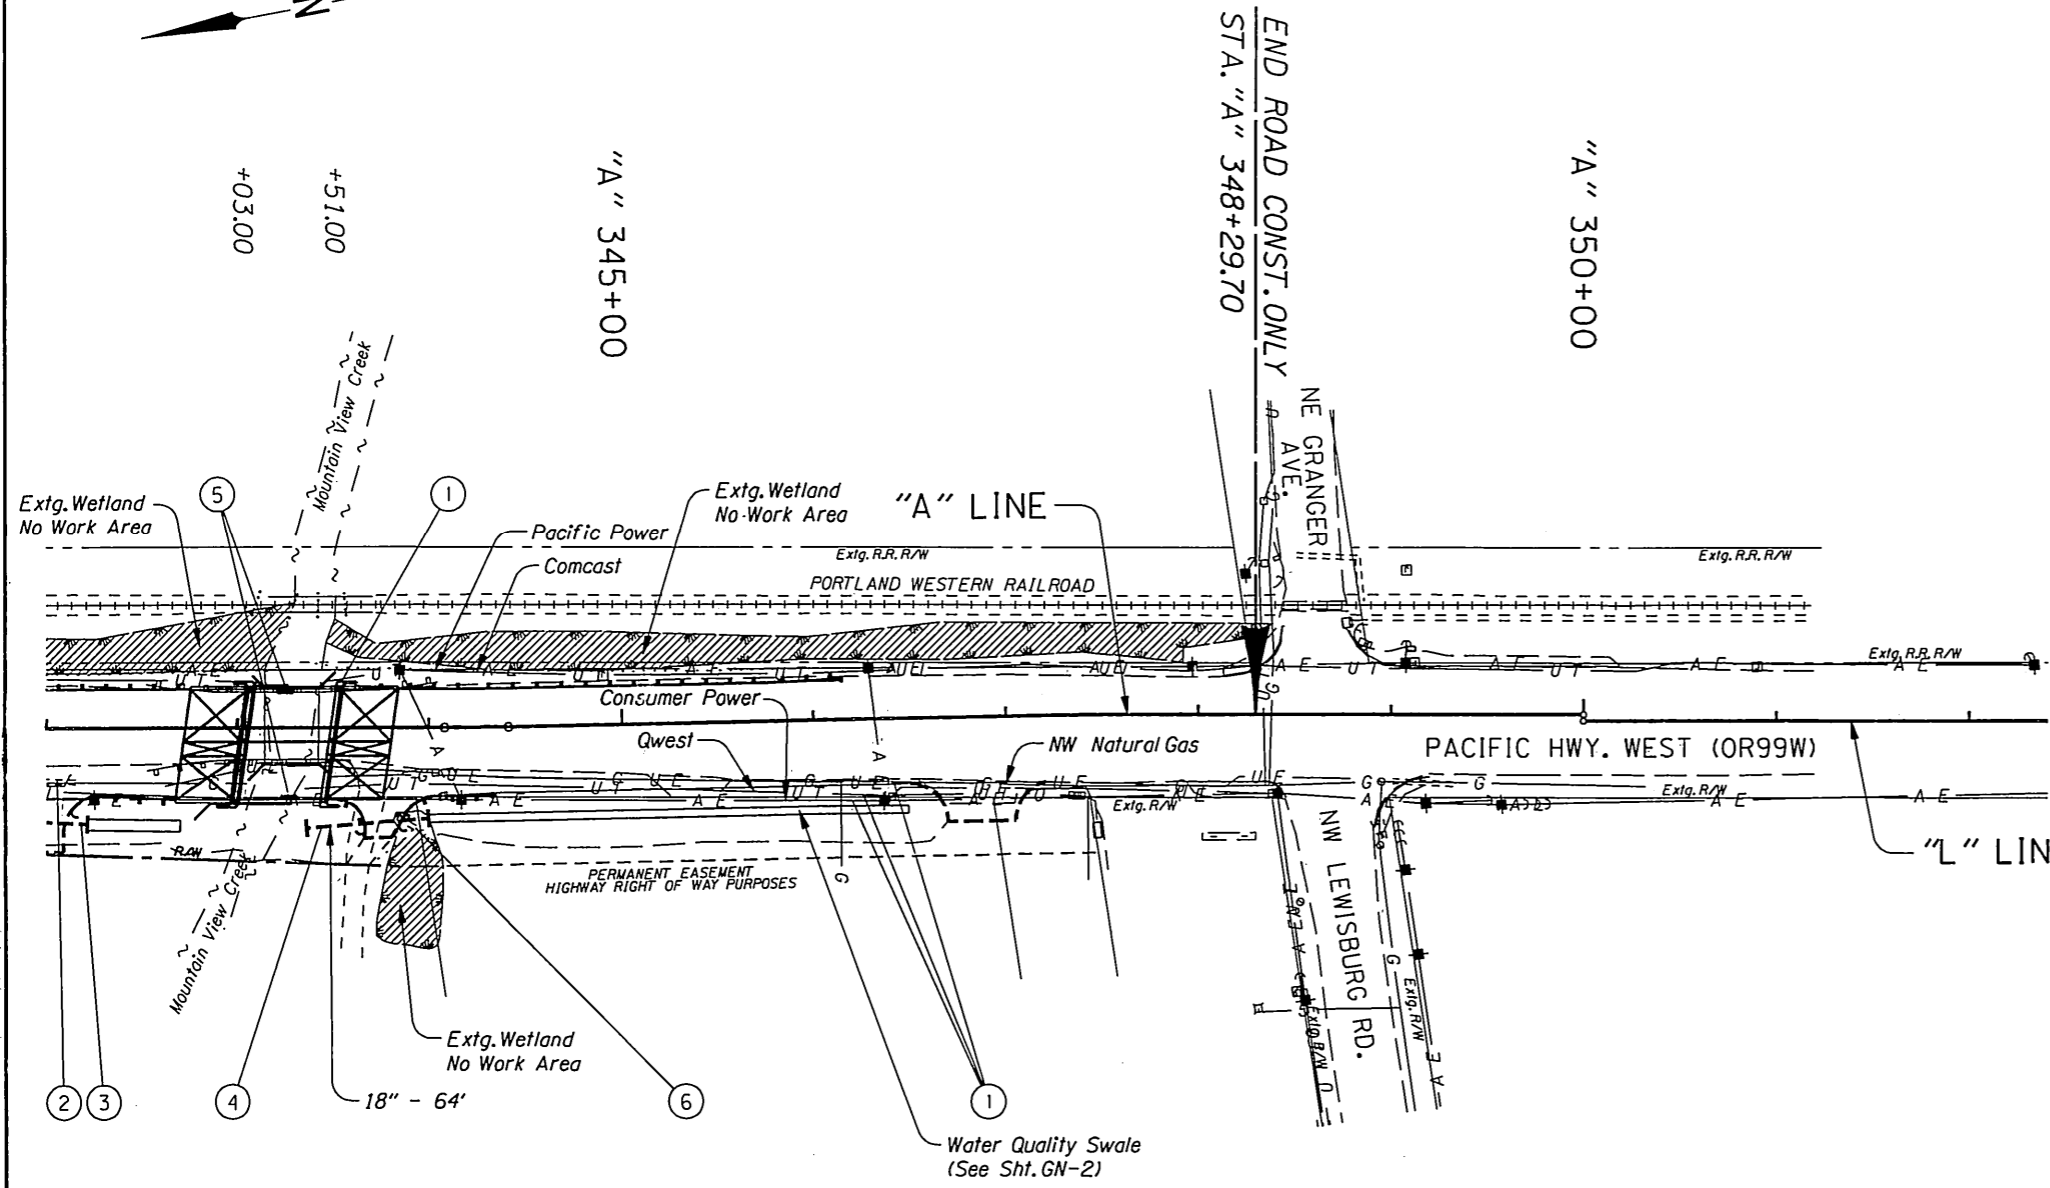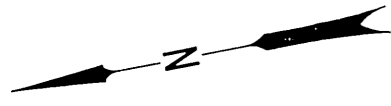


- ① Remove and Reinstall Extg. Utilities (By Others)
- ② See Note 3, Sht. 3B
- ③ See Note 4, Sht. 3B
- ④ Sta. "A" 343+24.00, 52.0' Rt. To Sta. "A" 343+87.42, 59.6' Rt. Install 18" Culvert Pipe - 64' 5' Depth
S = 0.0469'/Ft.
I.E. (In) - 235.86'
I.E. (Out) - 232.86'
Construct Sloped End (Inlet Only)
Install 12" Thick Class 50 Riprap Embankment Protection At Both Pipe Ends - 1.5 Cu. Yds.
- ⑤ Bridge Drain System (For Details, See Bridge Plans)
- ⑥ Remove Extg. Culvert - 12'

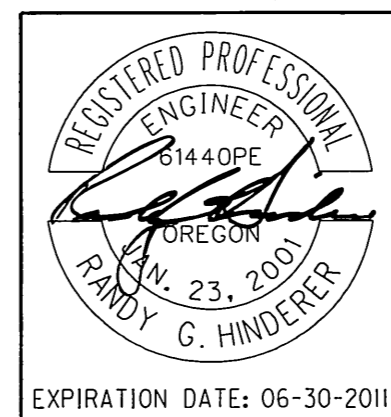

<p>OREGON DEPARTMENT OF TRANSPORTATION</p>	
<p>LOCHNER CONSULTING ENGINEERS AND PLANNERS 2001 Front St. NE Suite 120 Salem, Oregon 97301 Phone (503) 388-0100 FAX (503) 389-9538</p>	
<p>OR99W: LOCKE CREEK BRIDGE REPLACEMENT PROJECT PACIFIC HIGHWAY WEST BENTON COUNTY</p>	
<p>Reviewed By - Randy G. Hinderer Designed By - Chee Yeun Lay Drafted By - Ryan Berger</p>	
<p>DRAINAGE & UTILITIES</p>	<p>SHEET NO. 4B</p>

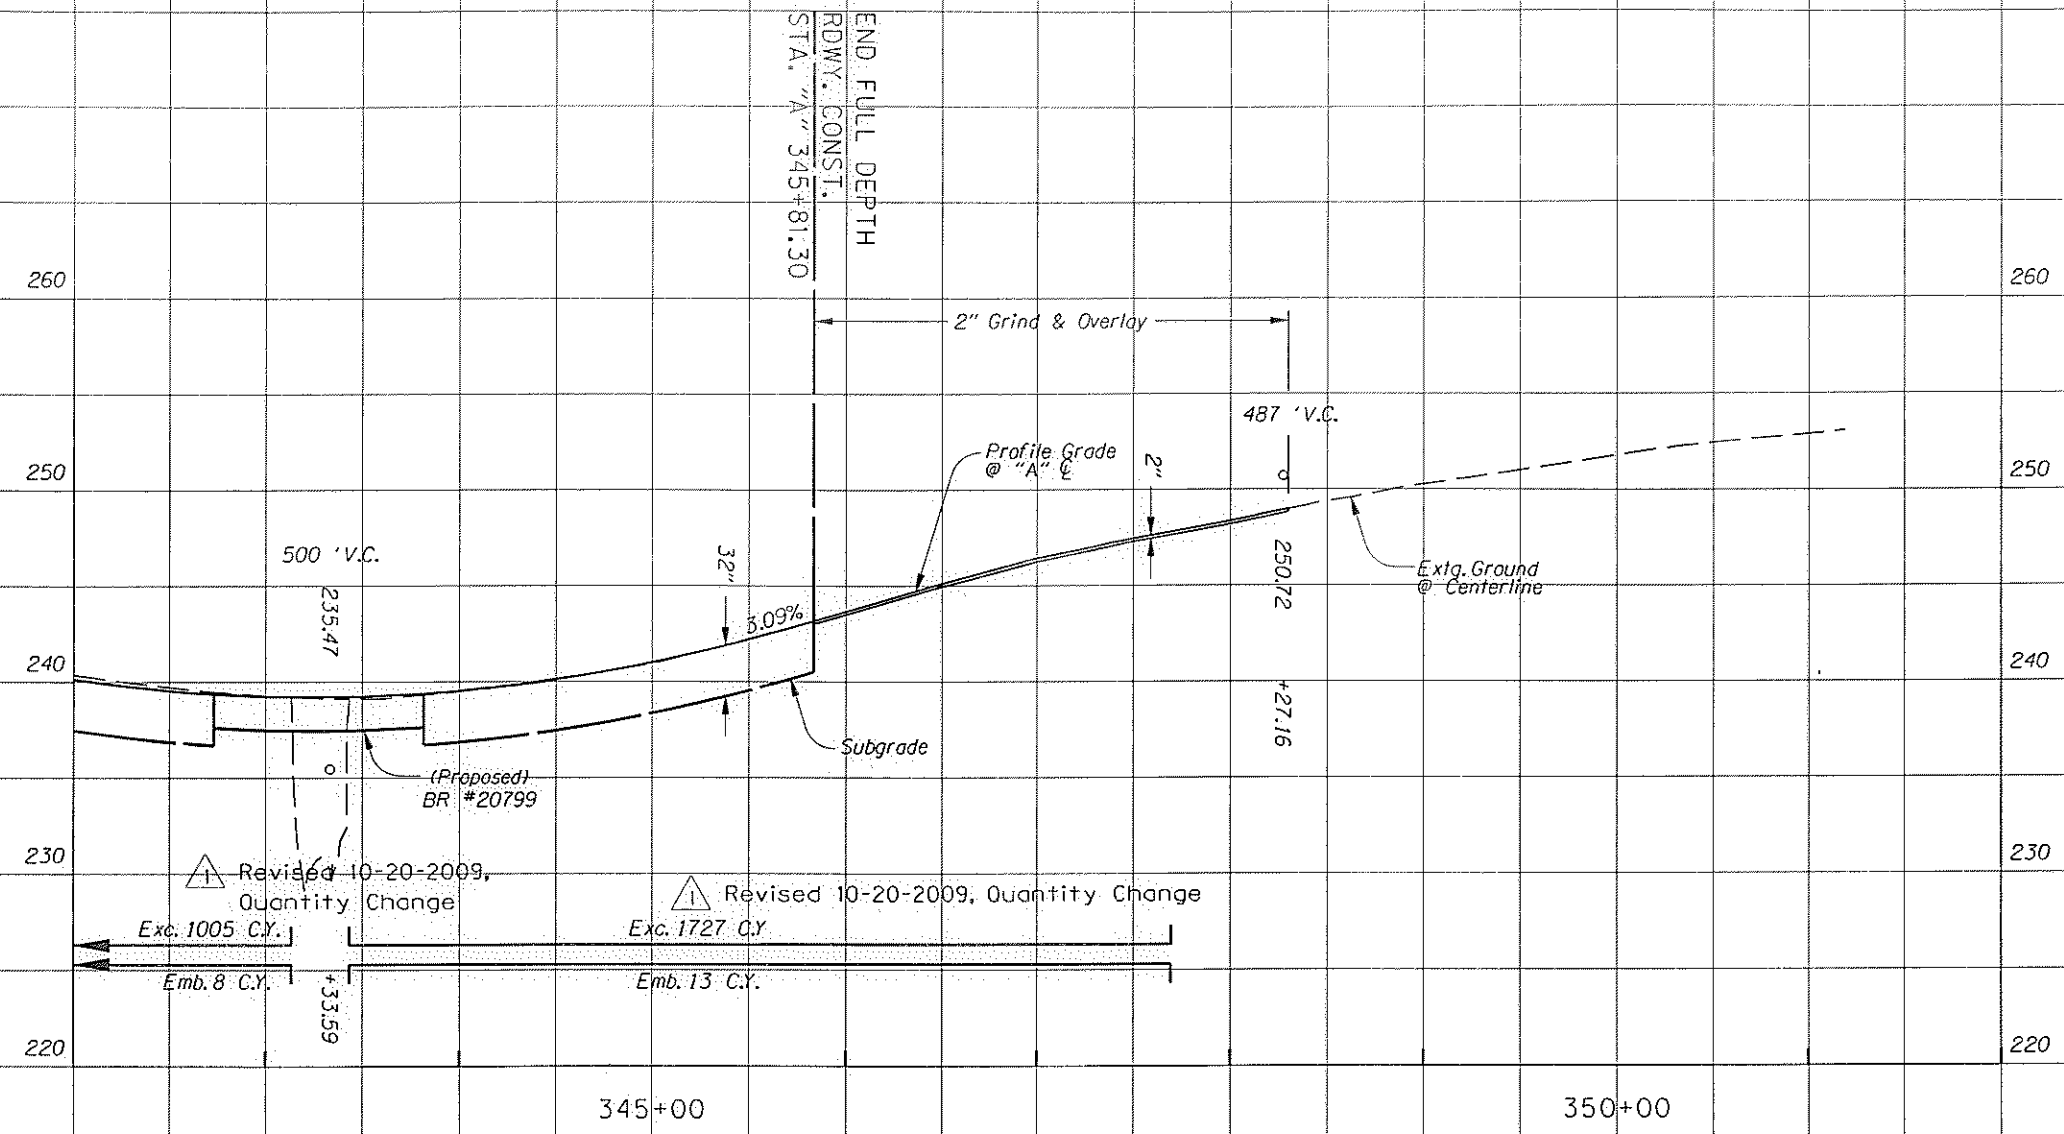

REVISIONS	
△	Revised 10-20-2009 Addendum #1

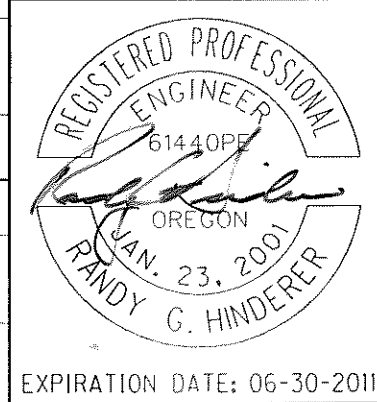

OREGON DEPARTMENT OF TRANSPORTATION

LOCHNER
CONSULTING ENGINEERS AND PLANNERS
2001 Front St. NE Suite 120 Salem, Oregon 97301
Phone (503) 586-0100 FAX (503) 586-9538



OR99W: LOCKE CREEK BRIDGE REPLACEMENT PROJECT
PACIFIC HIGHWAY WEST
BENTON COUNTY

Reviewed By - Randy G. Hinderer
Designed By - Chee Yaun Lay
Drafted By - Ryan Berger


PROFILE

SHEET NO.
4C

Sec. 12, T. 11S, R. 5W. W.M.
PACIFIC HIGHWAY WEST

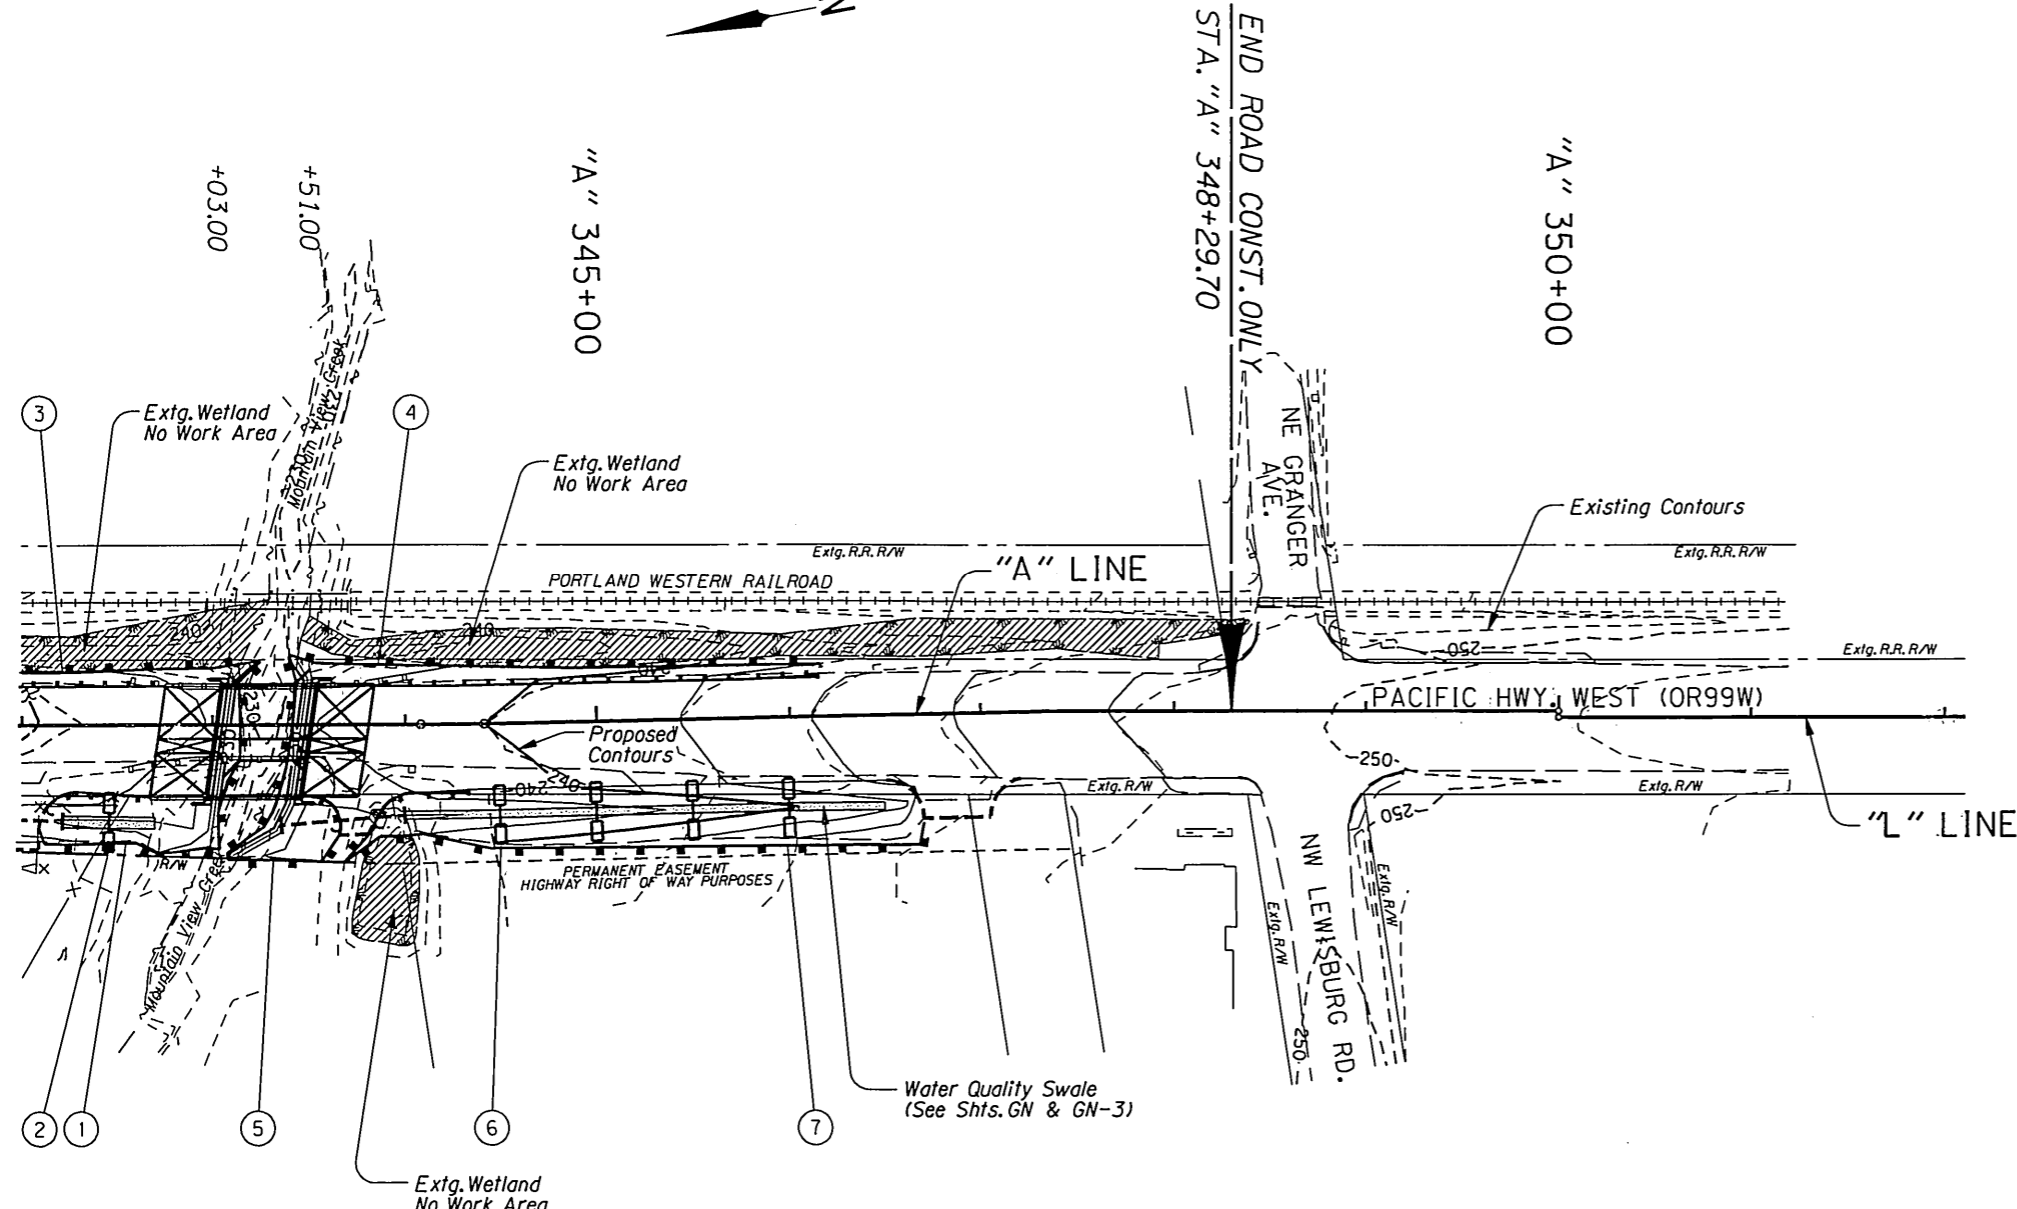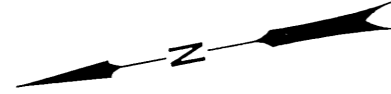


- ① See Note 5, Sht. GA-2.
- ② See Note 6, Sht. GA-2.
- ③ See Note 7, Sht. GA-2.
- ④ Sediment Fence Unsupported - 277'
- ⑤ Sediment Fence Unsupported - 185'
- ⑥ Const. Type 2 Check Dam - 4
- ⑦ Sediment Fence Unsupported - 328'

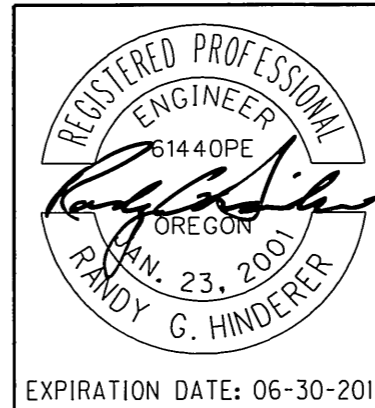

<p>OREGON DEPARTMENT OF TRANSPORTATION</p>	
<p>LOCHNER CONSULTING ENGINEERS AND PLANNERS 2001 Front St. NE Suite 120 Salem, Oregon 97301 Phone (503) 586-0100 FAX (503) 589-9538</p>	
<p>OR99W: LOCKE CREEK BRIDGE REPLACEMENT PROJECT PACIFIC HIGHWAY WEST BENTON COUNTY</p>	
<p>Reviewed By - Randy G. Hinderer Designed By - Chee Yeun Loy Drafted By - Ryan Berger</p>	
<p>EROSION CONTROL</p>	<p>SHEET NO. GA-3</p>


Check Dam
 Sediment Fence (Unsupported)

Sec. 12, T. 11S, R. 5W. W.M.
PACIFIC HIGHWAY WEST

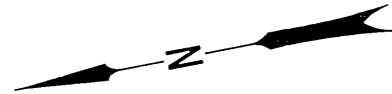


"A" 335+00
BEGIN ROAD CONST. ONLY
STA. "A" 334+68.00

"A" 340+00

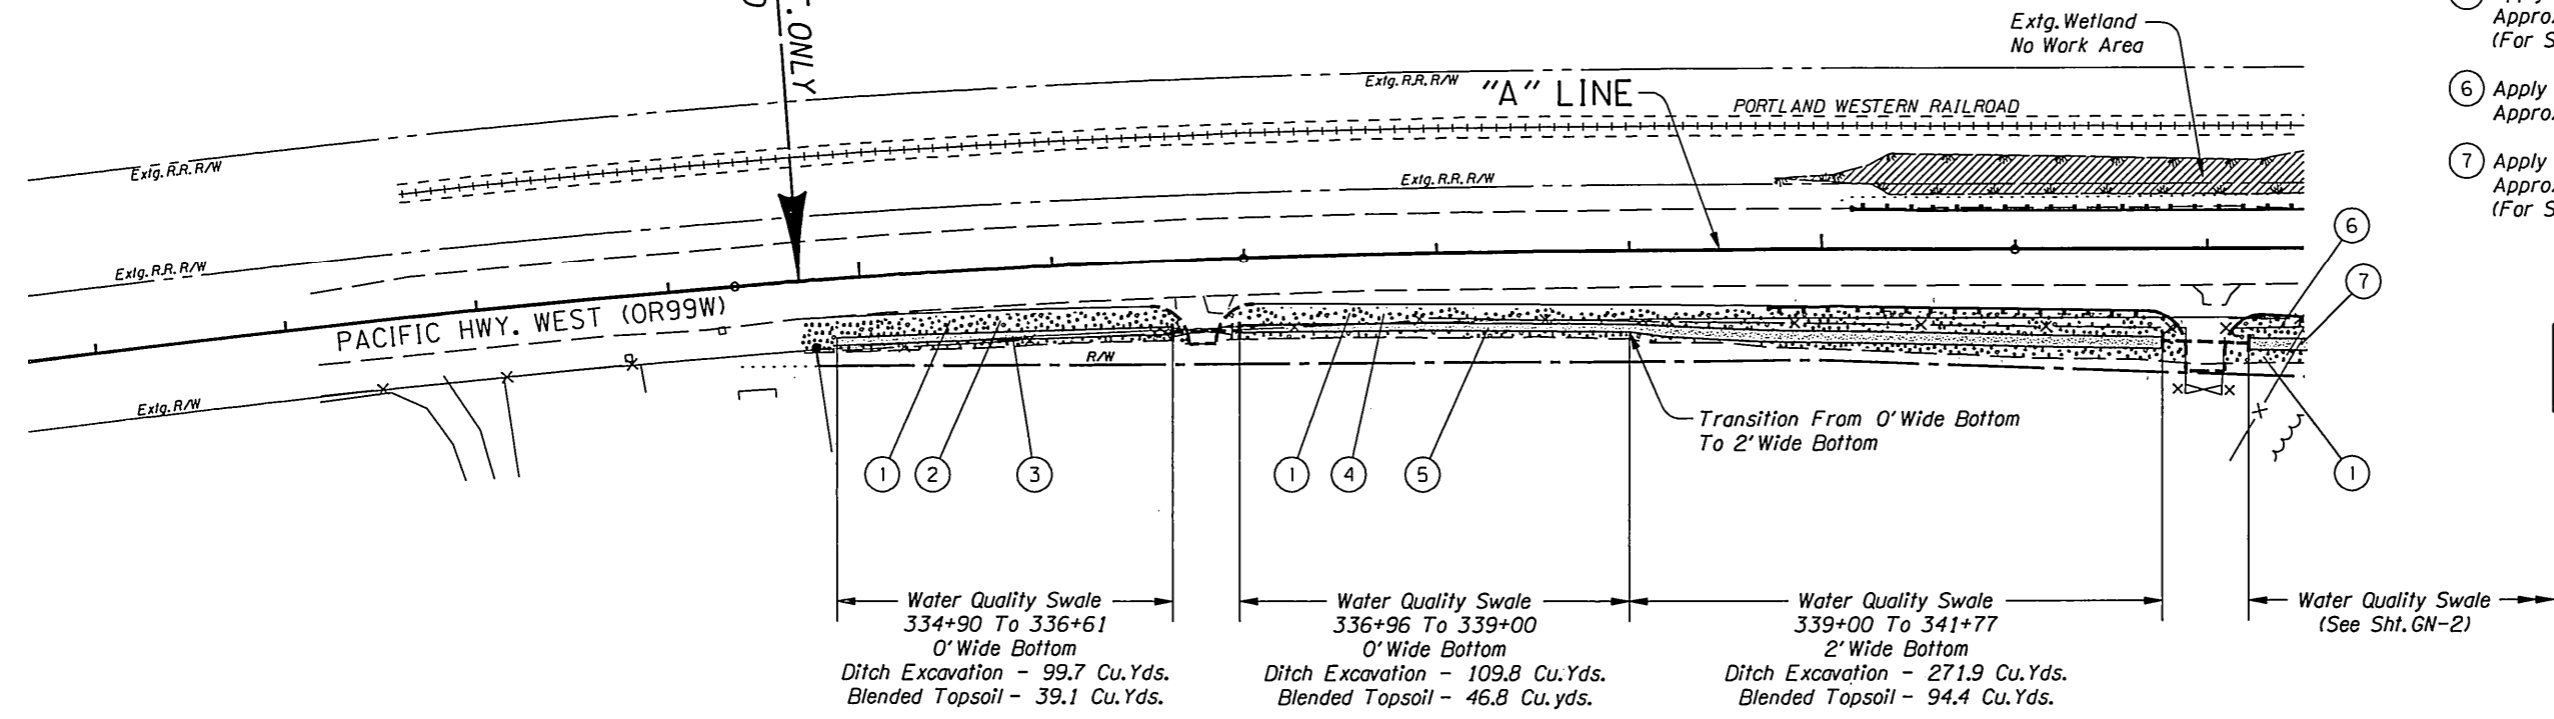


- ① Remove Extg. Vegetation As Necessary For Construction.
- ② Apply Permanent Seed Mix Approx. 0.06 Ac.
- ③ Apply Water Quality Seed Mix Approx. 0.02 Ac. (For Seed Mix, See Table Below)
- ④ Apply Permanent Seed Mix Approx. 0.18 Ac.
- ⑤ Apply Water Quality Seed Mix Approx. 0.05 Ac. (For Seed Mix, See Table Below)
- ⑥ Apply Permanent Seed Mix Approx. 0.03 Ac.
- ⑦ Apply Water Quality Seed Mix Approx. 0.01 Ac. (For Seed Mix, See Table Below)

Note:
Excavation & Blended Topsoil Quantities Shown Are Approximate.

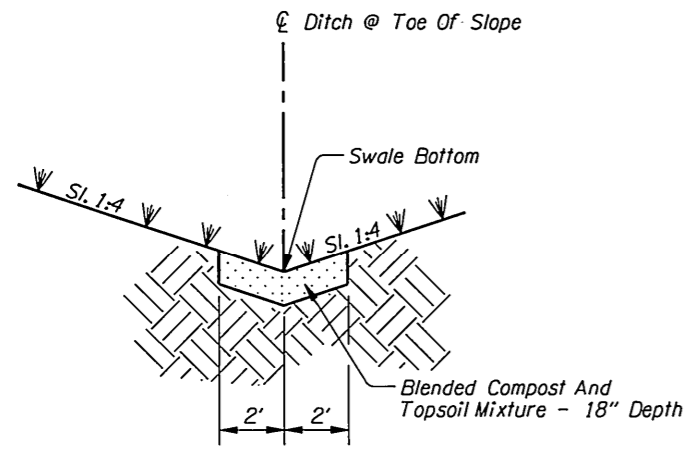

WATER QUALITY SWALE - 0' WIDE BOTTOM
CROSS SECTION

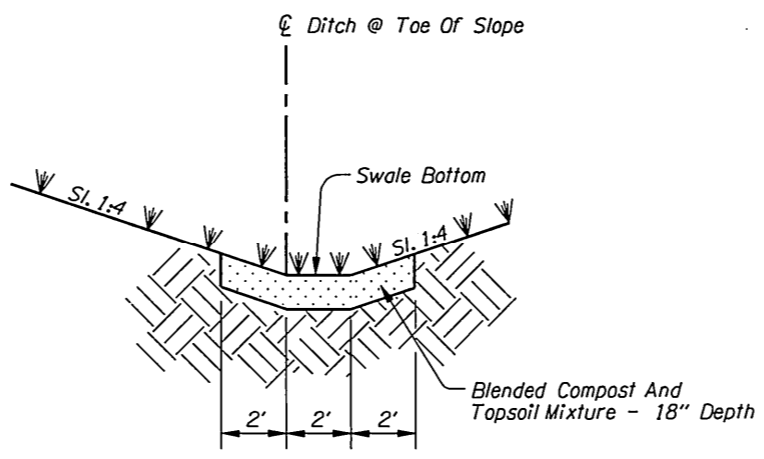


WATER QUALITY SWALE - 2' WIDE BOTTOM
CROSS SECTION



EXPIRATION DATE: 06-30-2011


OREGON DEPARTMENT OF TRANSPORTATION	
LOCHNER CONSULTING ENGINEERS AND PLANNERS 2001 Front St. NE Suite 120 Salem, Oregon 97301 Phone (503) 586-0100 FAX (503) 589-0538	
OR99W: LOCKE CREEK BRIDGE REPLACEMENT PROJECT	
PACIFIC HIGHWAY WEST BENTON COUNTY	
Reviewed By - Randy C. Hinderer Designed By - Chee Yeun Lay Drafted By - Ryan Berger	
ROADSIDE DEVELOPMENT	SHEET NO. GN

Sec. 12, T. 11S, R. 5W. W.M.
PACIFIC HIGHWAY WEST

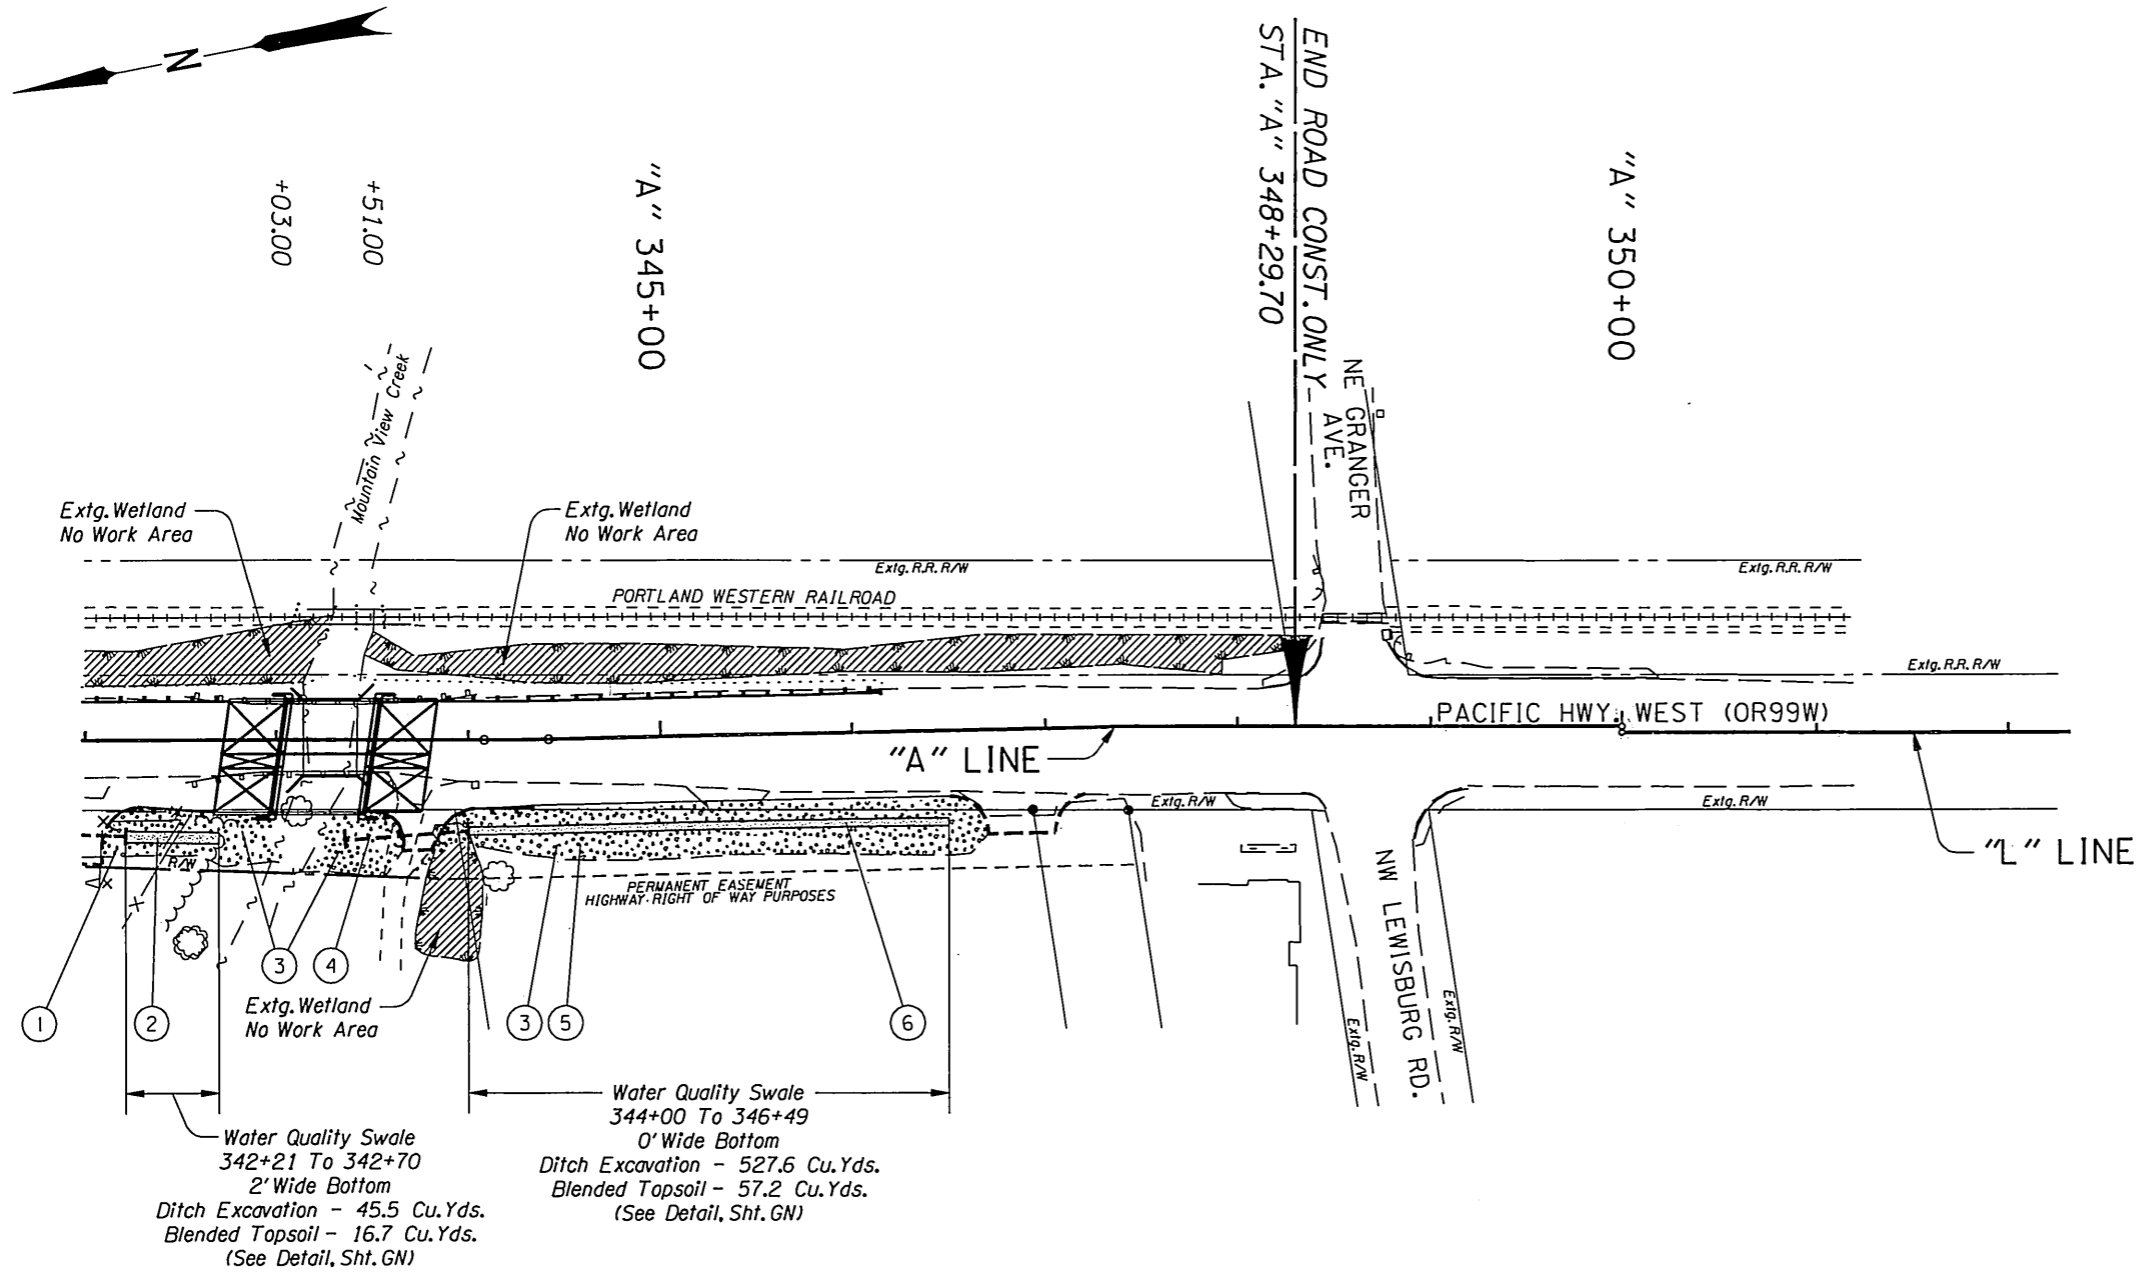


- ① See Note 6, Sht. GN.
- ② See Note 7, Sht. GN.
- ③ Remove Extg. Vegetation As Necessary For Construction.
- ④ Apply Permanent Seed Mix Approx. 0.03 Ac.
- ⑤ Apply Permanent Seed Mix Approx. 0.16 Ac.
- ⑥ Apply Water Quality Seed Mix Approx. 0.02 Ac. (For Seed Mix, See Sht. GN)

Note:
Excavation & Blended Topsoil Quantities Shown Are Approximate.


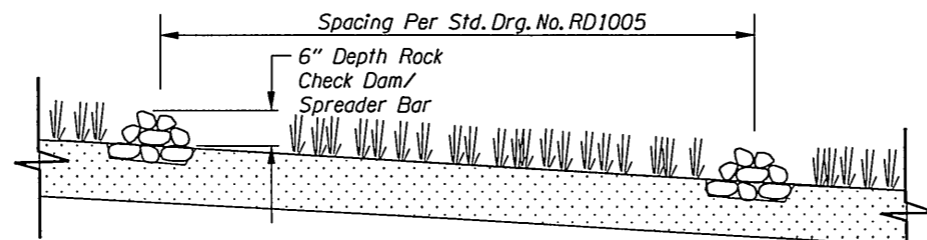


CHECK DAM INSTALLATION
IN WATER QUALITY SWALE

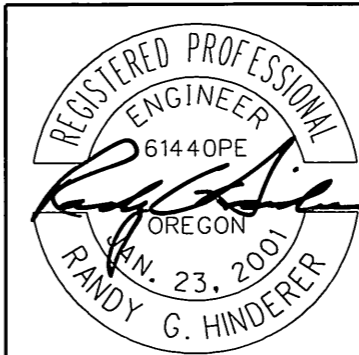


EXPIRATION DATE: 06-30-2011


<p>OREGON DEPARTMENT OF TRANSPORTATION</p>	
<p>LOCHNER CONSULTING ENGINEERS AND PLANNERS 2001 Front St. NE Suite 120 Salem, Oregon 97301 Phone (503) 588-0100 FAX (503) 588-9538</p>	
<p>OR99W: LOCKE CREEK BRIDGE REPLACEMENT PROJECT PACIFIC HIGHWAY WEST BENTON COUNTY</p>	
<p>Reviewed By - Randy G. Hinderer Designed By - Chee Yeun Loy Drafted By - Ryan Berger</p>	
<p>ROADSIDE DEVELOPMENT</p>	<p>SHEET NO. GN-2</p>

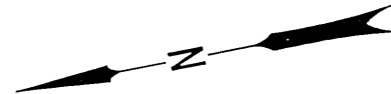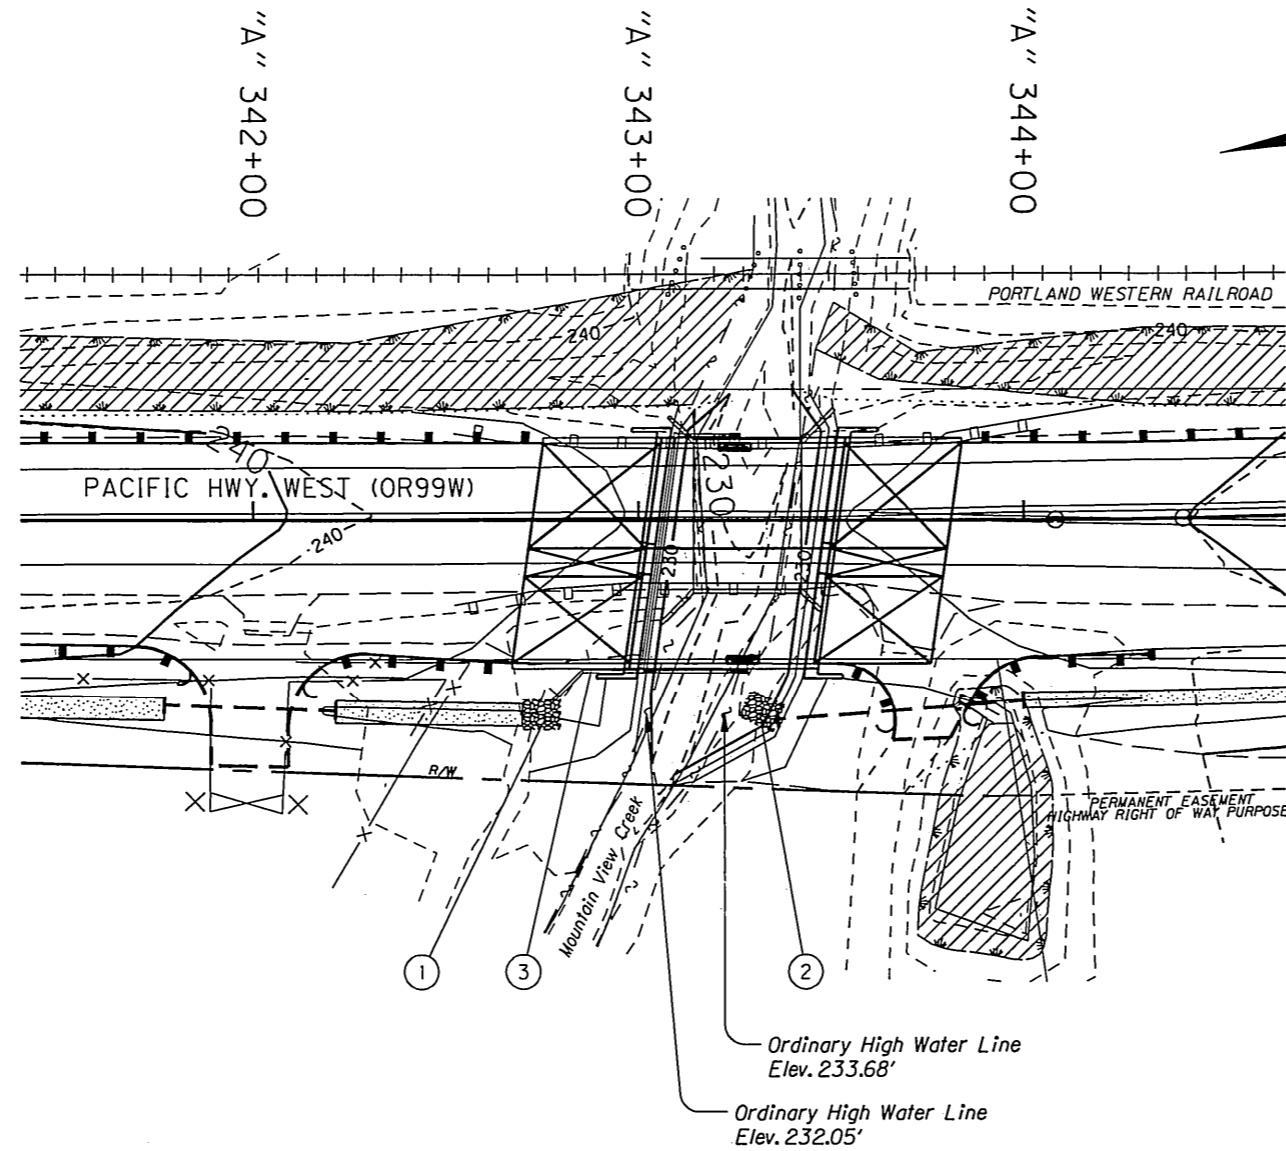


- ① Construct Dispersion Blanket
8' Wide x 10' Long x 18" Deep
Place Above Ordinary High Water Line
(See Detail Below)
- ② Construct Dispersion Blanket
8' Wide x 10' Long x 18" Deep
Place Above Ordinary High Water Line
(See Detail Below)
- ③ Bridge Drainage System
Place Drain Outlet At Dispersion Blanket
(See Bridge Plans For Drainage System Details)

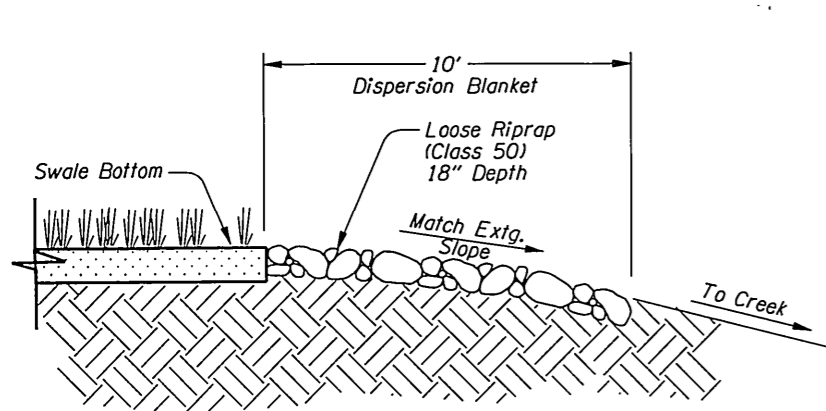


WATER QUALITY SWALE
DISPERSION BLANKET SECTION

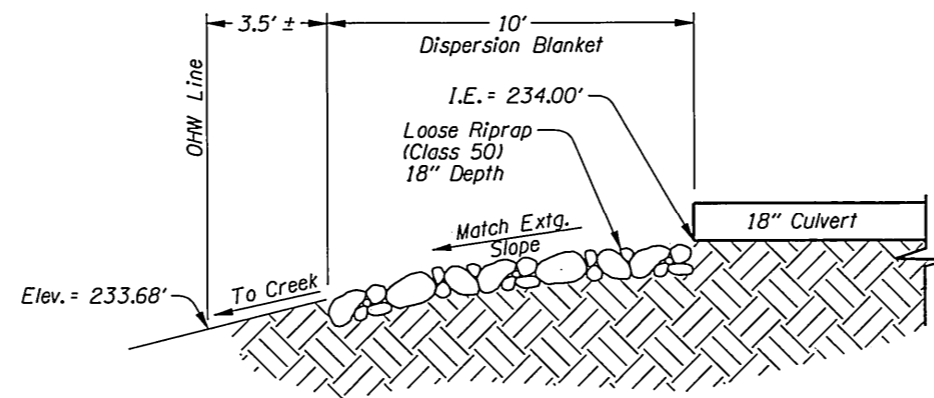

CROSS CULVERT OUTLET
DISPERSION BLANKET SECTION

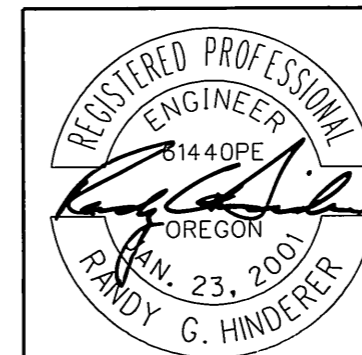

EXPIRATION DATE: 06-30-2011

 OREGON DEPARTMENT OF TRANSPORTATION	
LOCHNER CONSULTING ENGINEERS AND PLANNERS <small>2001 Front St. NE Suite 120 Salem, Oregon 97301 Phone (503) 588-0100 FAX (503) 589-9538</small>	
OR99W: LOCKE CREEK BRIDGE REPLACEMENT PROJECT PACIFIC HIGHWAY WEST BENTON COUNTY	
Reviewed By - Randy G. Hinderer Designed By - Chee Yeun Lay Drafted By - Ryan Berger	
ROADSIDE DEVELOPMENT	SHEET NO. GN-3