

OPERATION & MAINTENANCE MANUAL

DFI No. : D00677

Facility Type: Water Quality
Biofiltration Swale



[April, 2018]

INDEX

1. IDENTIFICATION..... 1

2. FACILITY CONTACT INFORMATION 1

3. CONSTRUCTION..... 1

4. STORM DRAIN SYSTEM AND FACILITY OVERVIEW 1

5. FACILITY HAZ MAT SPILL FEATURE(S)..... 3

6. AUXILIARY OUTLET (HIGH FLOW BYPASS)..... 3

7. MAINTENANCE REQUIREMENTS..... 3

8. WASTE MATERIAL HANDLING..... 4

APPENDIX A: Operational Plan and Profile Drawing

APPENDIX B: ODOT Project Plan Sheets

1. Identification

Drainage Facility ID (DFI): **D00677**
Facility Type: Water Quality Biofiltration Swale
Construction Drawings: (V-File Number) 46V-022
Location: District: 2B
Highway No.: 075
Mile Post: 1.23;1.31 (beg./end)
Description: This facility is located on the south side of the Sunrise Corridor.

2. Facility Contact Information

Contact the Engineer of Record, Region Technical Center, or Geo-Environmental's Senior Hydraulics Engineer for:

- Operational clarification
- Maintenance clarification
- Repair or restoration assistance

Engineering Contacts:

Region Technical Center Hydro Unit Manager

Or

Geo-Environmental Senior Hydraulics Engineer (503) 986-3365.

3. Construction

4. Engineer of Record: Consultant Designer – [OBEC Consulting Engineers, Amy Jones, 971-634-2005]

Facility construction: [2014]

Contractor: Kerr Contractors, Inc.

5. Storm Drain System and Facility Overview

A water quality swale is a flat-bottomed open channel designed to treat stormwater runoff from highway pavement areas. This type of facility is

lined with grass. Treatment by trapping sedimentation occurs when stormwater runoff flows through the grass.

This biofiltration swale is designed to treat runoff from the water quality design storm and provide infiltration prior to entering the storm drain pipe system that outfalls to extended detention pond D00676 prior to entering Dean Creek. It is located on the south side of the Sunrise Corridor at the base of the fill slope.

There is a 2-foot flat bottom roadside ditch and 3 storm drain pipes that convey stormwater runoff from paved areas along the Sunrise Corridor Alignment to the swale. See photo 1 and Points A, B, C, and D in Appendix A.

Runoff exits the swale by way of a Type "M-E" inlet connected to a 21-inch storm drain outlet pipe. See Point E on the Operational Plan in Appendix A.

The storm drain outlet pipe from the inlet connects to a pipe system that drains to extended detention pond D00676 prior to entering Dean Creek. The receiving waterway for the outlet pipe is Dean Creek.

A. Maintenance equipment access:

The swale and outlet structure can be accessed directly from the shoulder of the Sunrise Corridor.

B. Heavy equipment access into facility:

- Allowed (no limitations)
- Allowed (with limitations)
- Not allowed

C. Special Features:

- Amended Soils
- Porous Pavers
- Liners
- Underdrains



Photo 1: a view of water quality swale, looking Southeast.

6. Facility Haz Mat Spill Feature(s)

The water quality biofiltration swale can be used to store a volume of liquid by blocking the 21-inch diameter outlet pipe with the Type “M-E” inlet located at the outfall structure at the west end of the swale. A barrier such as a metal plate over the metal grate on the inlet could be used to prevent liquid from draining from the swale.

7. Auxiliary Outlet (High Flow Bypass)

There is no auxiliary outlet provided for the water quality swale. All runoff can be conveyed through the 21-inch outlet pipe.

The auxiliary outlet feature for this facility is:

Designed into facility

Other, as noted below

Overflow runoff will overtop the swale and sheet flow to the south.

8. Maintenance Requirements

Routine maintenance table for non-proprietary stormwater treatment and storage/detention facilities have been incorporated into ODOT's

Maintenance Guide. These tables summarize the maintenance requirements for ponds, swales, filter strips, bioslopes, and detention tanks and vaults. Special maintenance requirements in addition to the routine requirements are noted below when applicable.

The ODOT Maintenance Guide can be viewed at the following website:

<http://www.oregon.gov/ODOT/HWY/OOM/MGuide.shtml>

The following stormwater facility maintenance table (See ODOT Maintenance Guide) should be used to maintain the facility outlined in this Operation and Maintenance Manual:

- Table 1 (general maintenance)
- Table 2 (stormwater ponds)
- Table 3 (water quality biofiltration swales)
- Table 4 (water quality filter strips)
- Table 5 (water quality bioslopes)
- Table 6 (detention tank)
- Table 7 (detention vault)
- Appendix C (proprietary structure)
- Special Maintenance requirements:

9. Waste Material Handling

Material removed from the facility is defined as waste by DEQ. Refer to the roadwaste section of the ODOT Maintenance Yard Environmental Management System (EMS) Policy and Procedures Manual for disposal options: <http://egov.oregon.gov/ODOT/HWY/OOM/EMS.shtml>


Contact any of the following for more detailed information about management of waste materials found on site:

ODOT Clean Water Unit	(503) 986-3008
ODOT Statewide Hazmat Coordinator	(503) 229-5129
ODOT Region Hazmat Coordinator	(503) 731-8290
ODEQ Northwest Region Office	(503) 229-5263


Appendix A

Content:

- **Operational Plan and Profile Drawing**

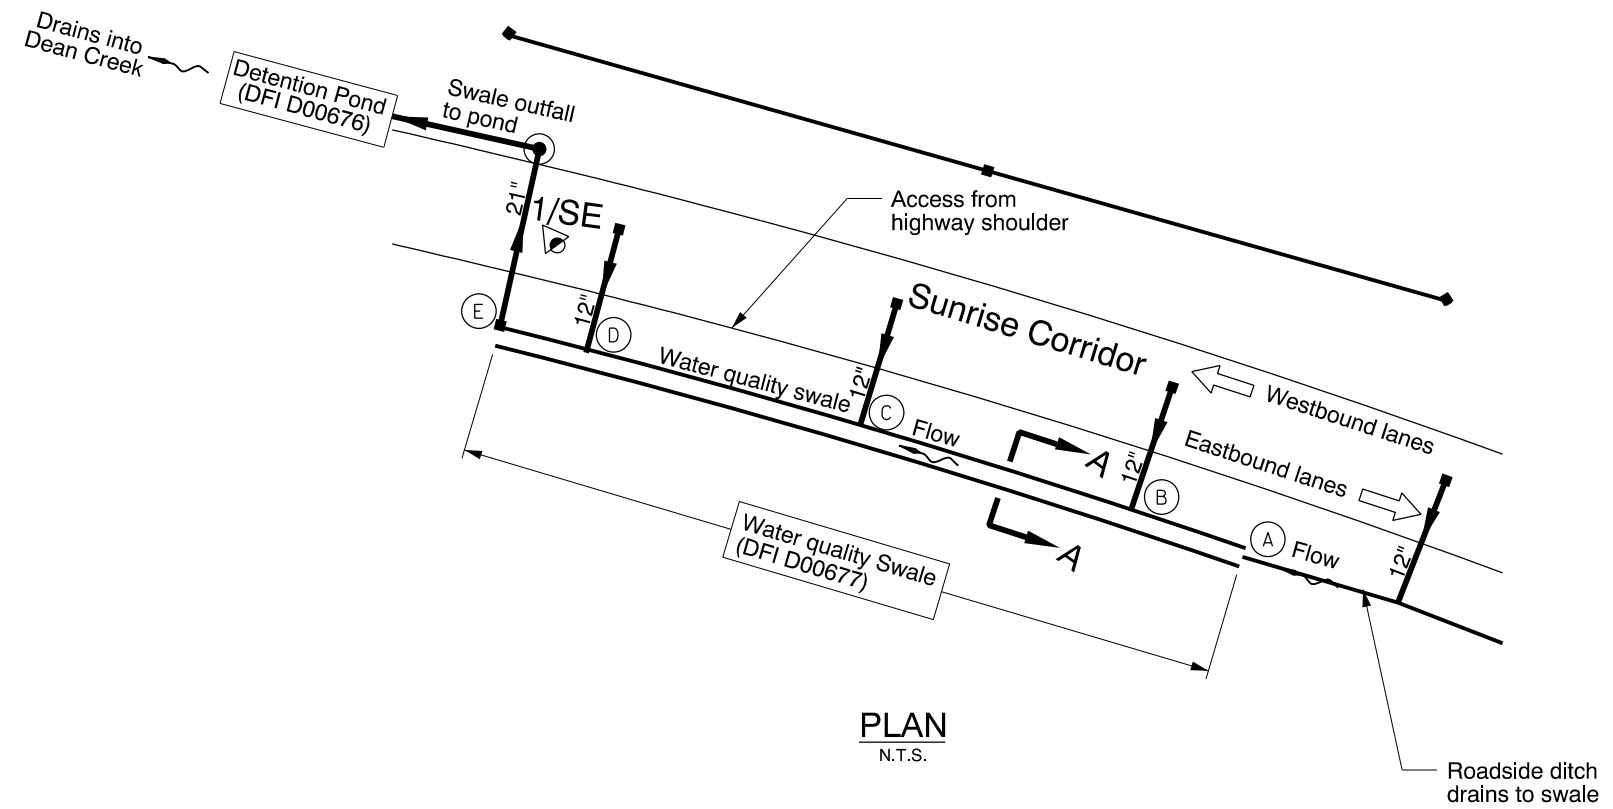

PLAN
N.T.S.

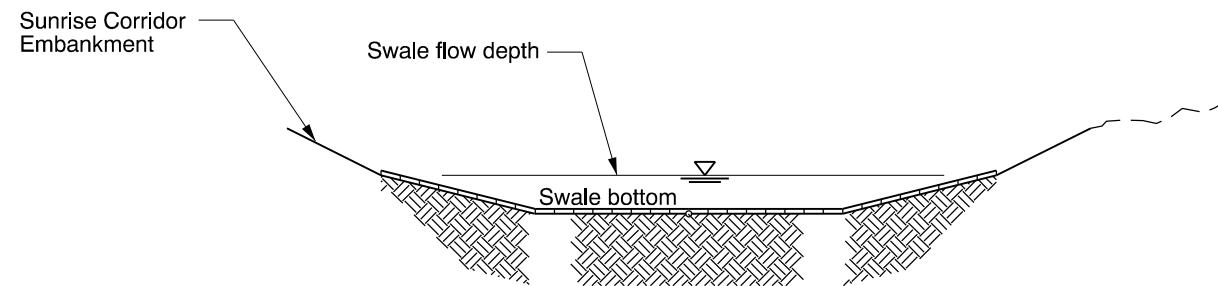

SECTION A-A
N.T.S.

LEGEND:

- Photo Location / Direction
- Roadside ditch outfall to swale
- 12" Storm drain pipe outlet
- 12" Storm drain pipe outlet
- 12" Storm drain pipe outlet
- Type "M-E" inlet and 21" storm drain pipe outfall
- Manhole
- Inlet
- Storm Pipe (Facility)
- Storm Pipe (does not drain to swale)
- Storm Pipe (Existing)
- Conveyance Direction
- Pavement / Facility Flow Path

OREGON DEPARTMENT OF TRANSPORTATION

Prepared By: Amy Jones
 Drafted By: Amy Jones


DFI D00677
MAINTENANCE DISTRICT 2B HWY 75
WATER QUALITY SWALE
 SUNRISE CORRIDOR MP 1.23 TO 1.31
 CLACKAMAS COUNTY

Appendix B

Content:

- **ODOT Project Plan Sheets**
 - *Cover/Title Sheet*
 - *Water Quality Plan Sheets*
 - *Other Details*

STATE OF OREGON
 DEPARTMENT OF TRANSPORTATION
 PLANS FOR PROPOSED PROJECT
**GRADING, DRAINAGE, STRUCTURES, PAVING, SIGNING,
 ILLUMINATION, SIGNALS & ROADSIDE DEVELOPMENT**

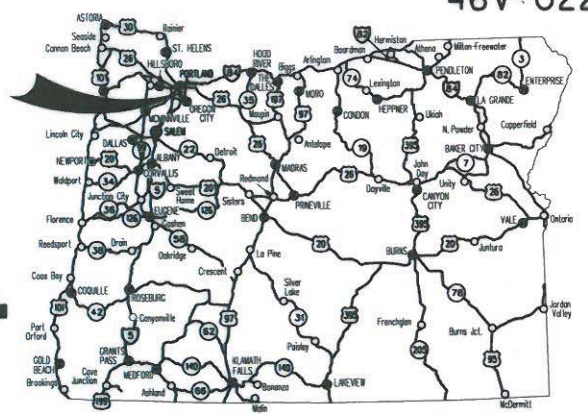

Overall Length Of Project - 3.90 Miles

INDEX OF SHEETS	
SHEET NO.	DESCRIPTION
1	Title Sheet
1A	Index Of Sheets Cont'd.

FFO - OR212/224: SUNRISE CORRIDOR (I-205 - SE 122ND AVE) SEC.

**CLACKAMAS HWY.
 CLACKAMAS COUNTY
 MARCH 2013**


**BEGIN WORK
 JTA-STP-S171(030)
 STA. "SR1" 505+78**

**BEGIN WORK
 JTA-STP-S171(030)
 STA. "G" 463+00**

**END WORK
 JTA-STP-S171(030)
 STA. "G" 492+00**

**END WORK
 JTA-STP-S171(030)
 STA. "OR" 352+20**

**END WORK
 JTA-STP-S171(030)
 STA. "T" 705+75**

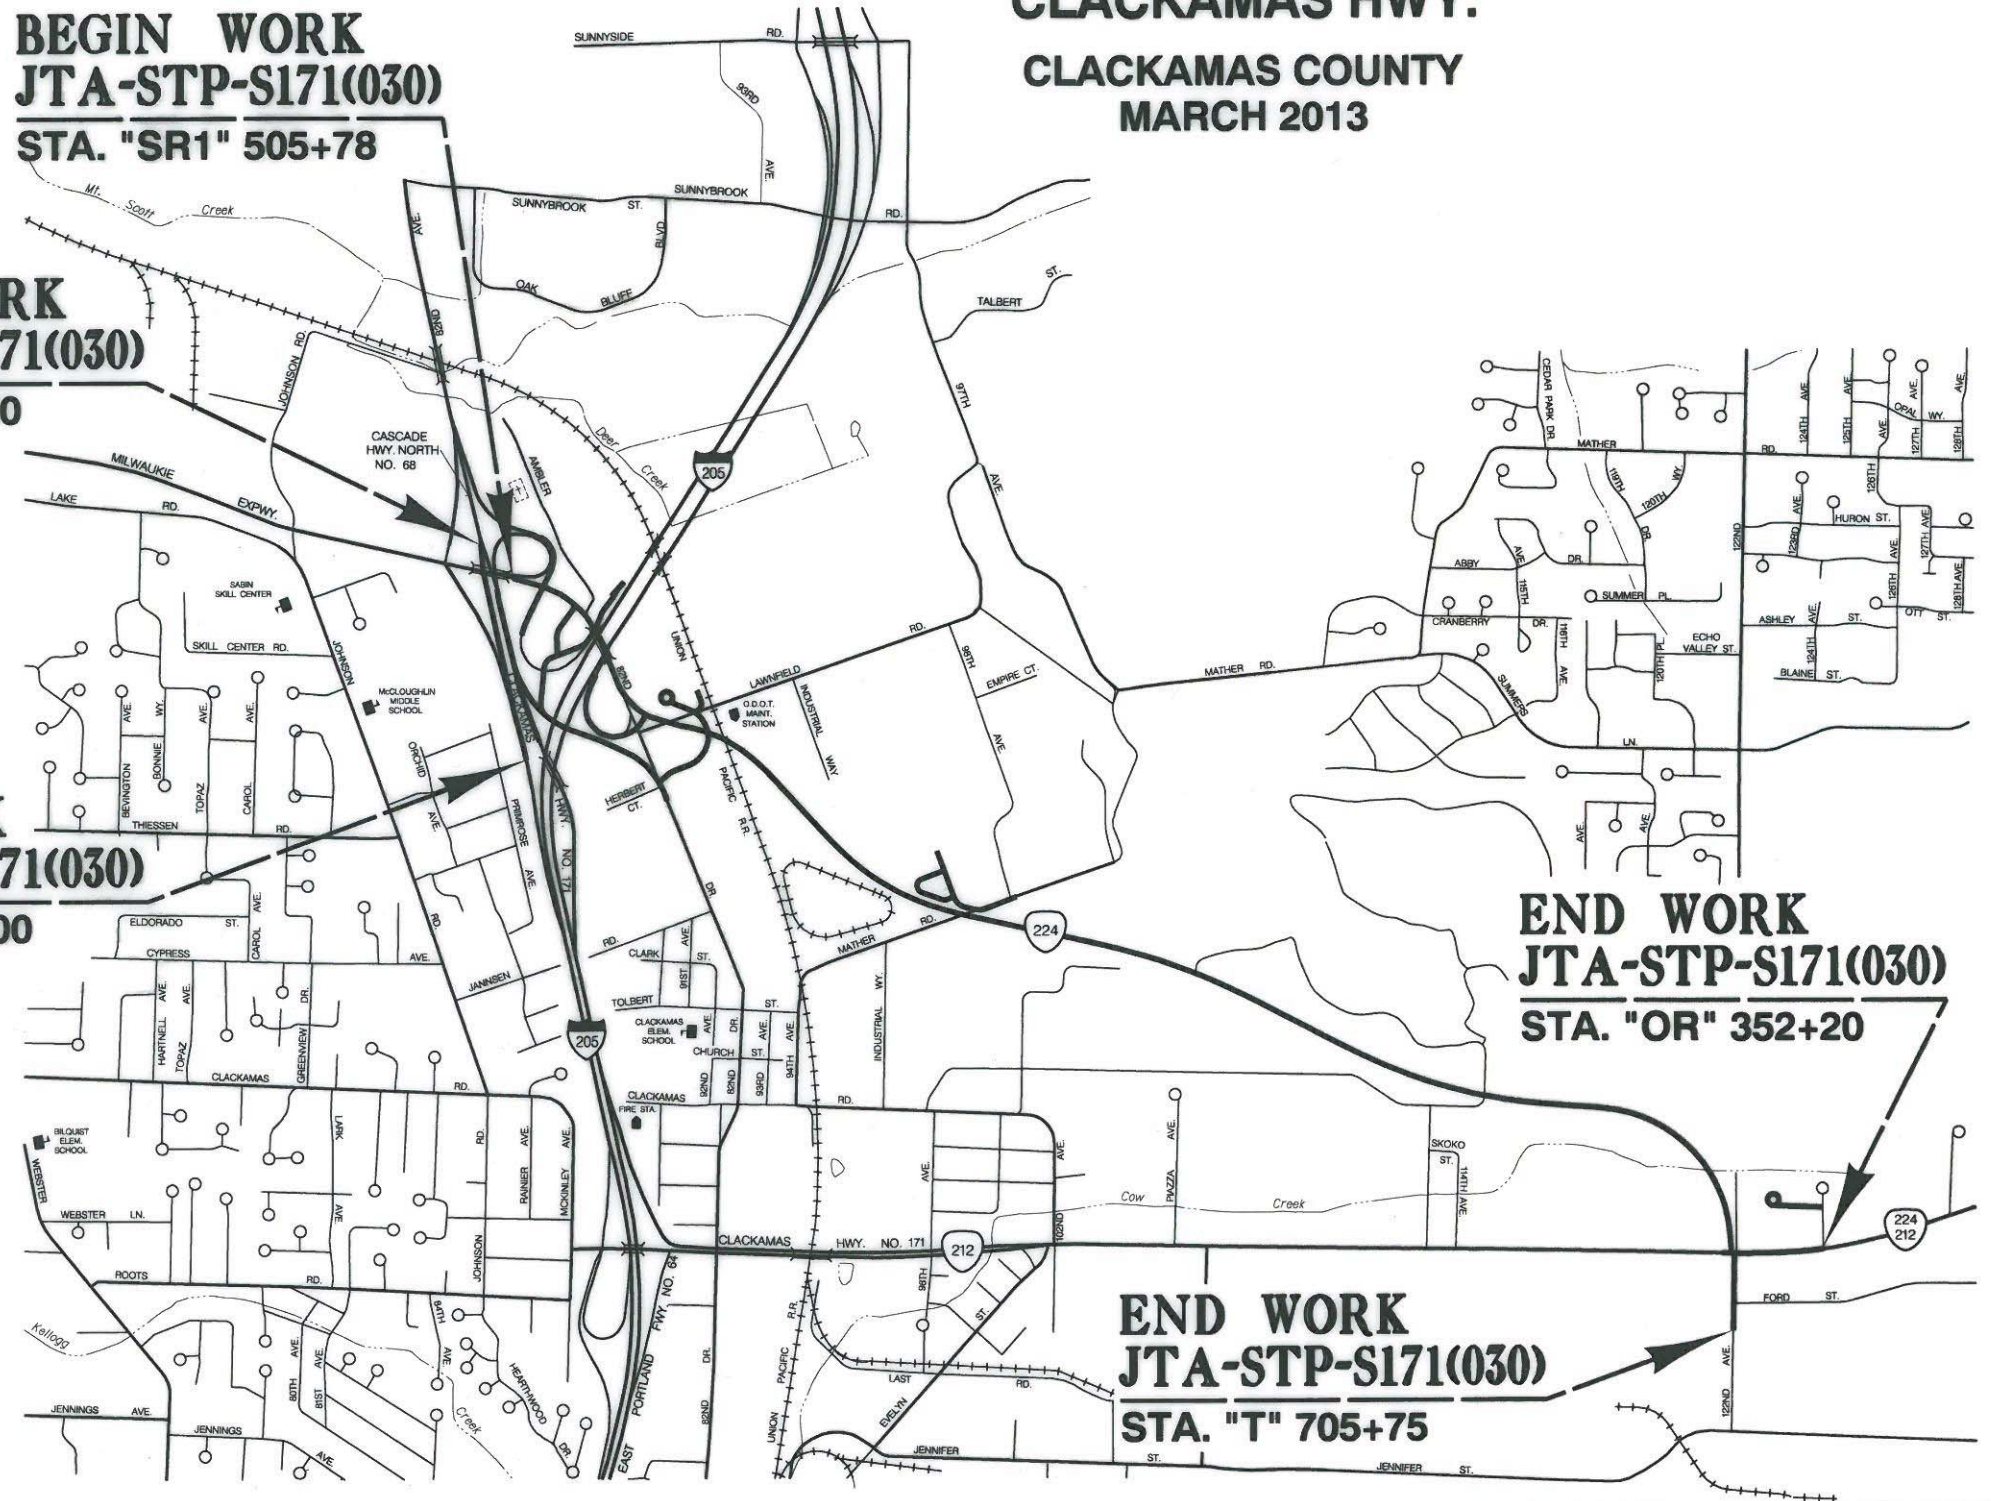

ATTENTION:
 Oregon Law Requires You To Follow Rules Adopted By The Oregon Utility Notification Center. Those Rules Are Set Forth In OAR 952-001-0010 Through OAR 952-001-0090. You May Obtain Copies Of The Rules By Calling The Center. (Note: The Telephone Number For The Oregon Utility Center is (503) 232-1987.)

**LET'S ALL
 WORK TOGETHER
 TO MAKE THIS
 JOB SAFE**

- OREGON TRANSPORTATION COMMISSION**
- Pat Egan CHAIR
 - David Lohman COMMISSIONER
 - Mary F. Olson COMMISSIONER
 - Mark Frohnmayer COMMISSIONER
 - Tammy Boney COMMISSIONER
 - Matthew L. Garrett DIRECTOR OF TRANSPORTATION

PLANS PREPARED FOR
 OREGON DEPARTMENT OF TRANSPORTATION

OBEC CONSULTING ENGINEERS
 CORPORATE OFFICE: 920 COUNTRY CLUB ROAD, SUITE 100B EUGENE, OREGON 97401-0089
 REGIONAL OFFICES: LAKE OSWEGO, SALEM, MEDFORD, OREGON; VANCOUVER, WASHINGTON

These plans were developed using ODOT design standards. Exceptions to these standards, if any, have been submitted and approved by the ODOT Chief Engineer or their delegated authority.

Approving Authority: *Lawrence H. Fox* 12/31/12
 Signature & date



LAWRENCE H. FOX - PROJECT MANAGER
 Print name and title

Concurrence by ODOT Chief Engineer


**FFO - OR212/224: SUNRISE CORRIDOR (I-205 - SE 122ND AVE) SEC.
 CLACKAMAS HWY.
 CLACKAMAS COUNTY**

FEDERAL HIGHWAY ADMINISTRATION	PROJECT NUMBER	SHEET NO.
OREGON DIVISION	JTA-STP-S171(030)	1

SEC. 4, 5, 9, 10, 11
 T. 2 S., R. 2 E., W.M.

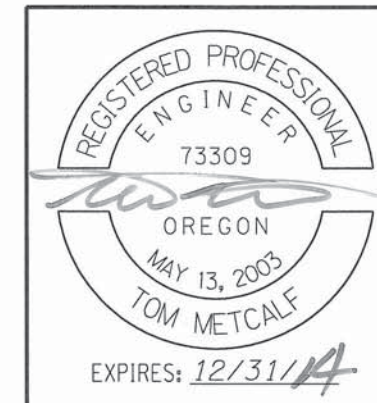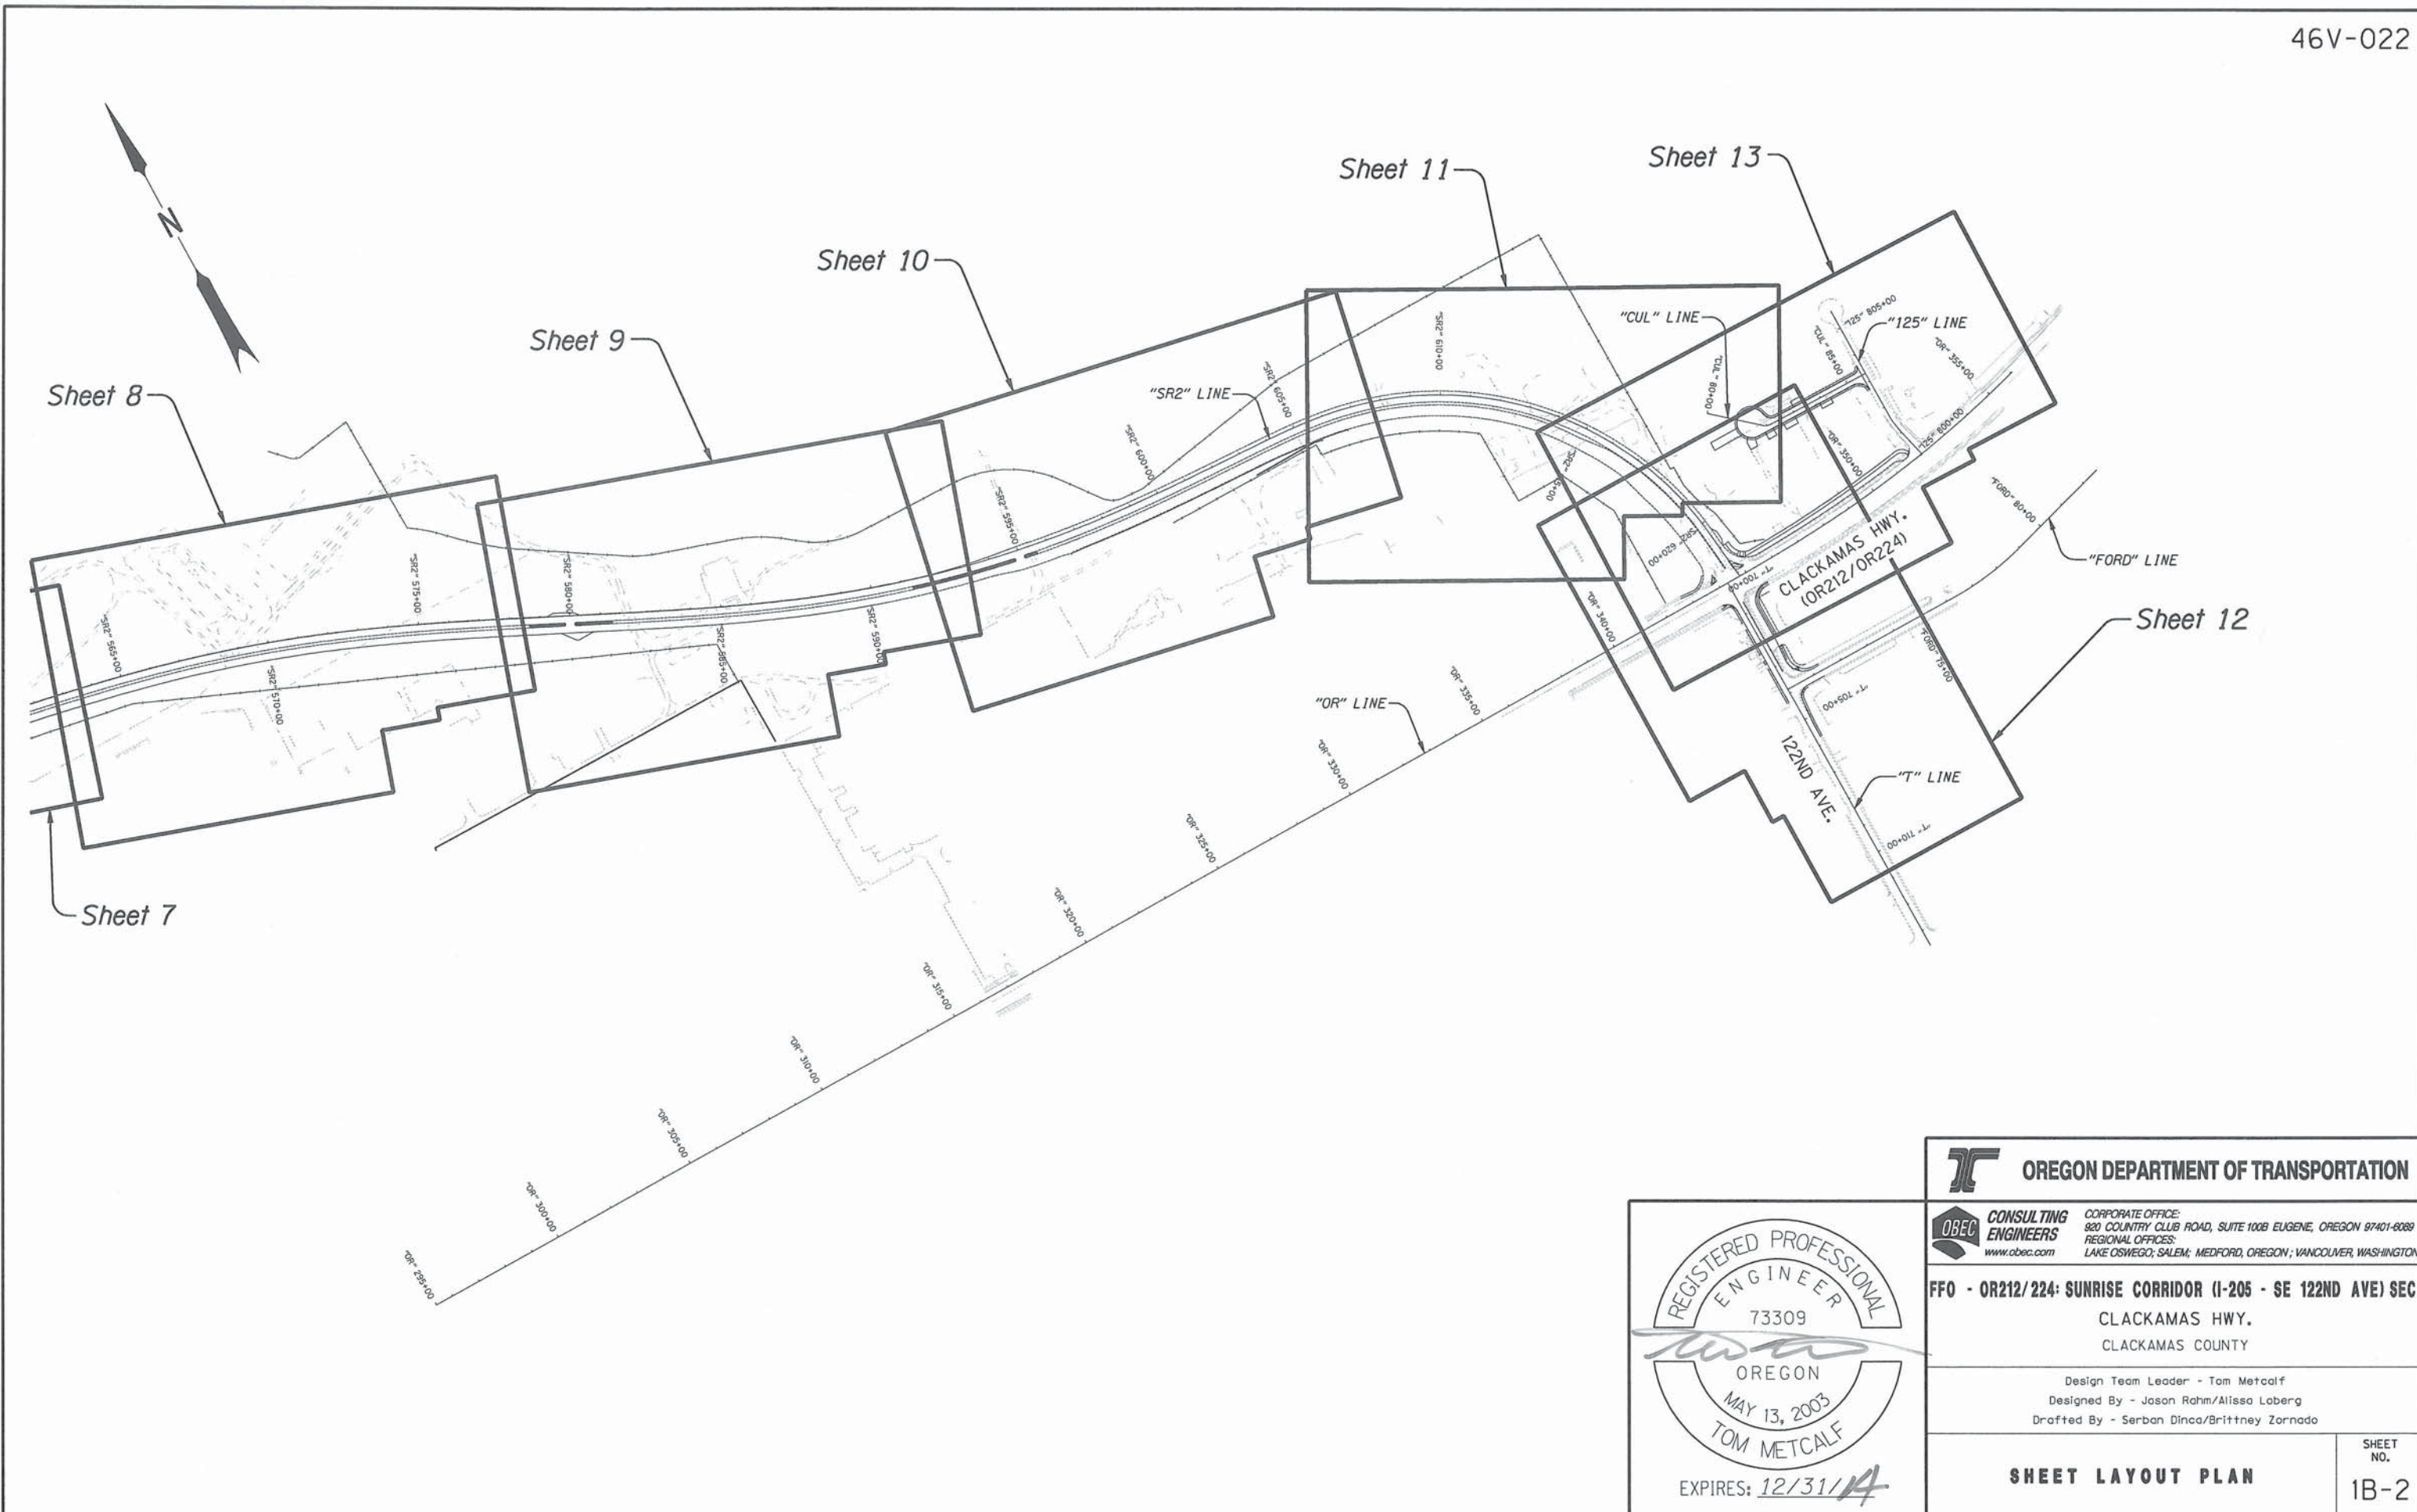

OREGON DEPARTMENT OF TRANSPORTATION	
CONSULTING ENGINEERS <small>www.obec.com</small>	<small>CORPORATE OFFICE: 920 COUNTRY CLUB ROAD, SUITE 100B EUGENE, OREGON 97401-6089 REGIONAL OFFICES: LAKE OSWEGO; SALEM; MEDFORD, OREGON; VANCOUVER, WASHINGTON</small>
FFO - OR212/224: SUNRISE CORRIDOR (I-205 - SE 122ND AVE) SEC. CLACKAMAS HWY. CLACKAMAS COUNTY	
<small>Design Team Leader - Tom Metcalf Designed By - Jason Rahm/Alissa Loberg Drafted By - Serban Dinca/Brittney Zornado</small>	
SHEET LAYOUT PLAN	
<small>SHEET NO.</small> 1B-2	

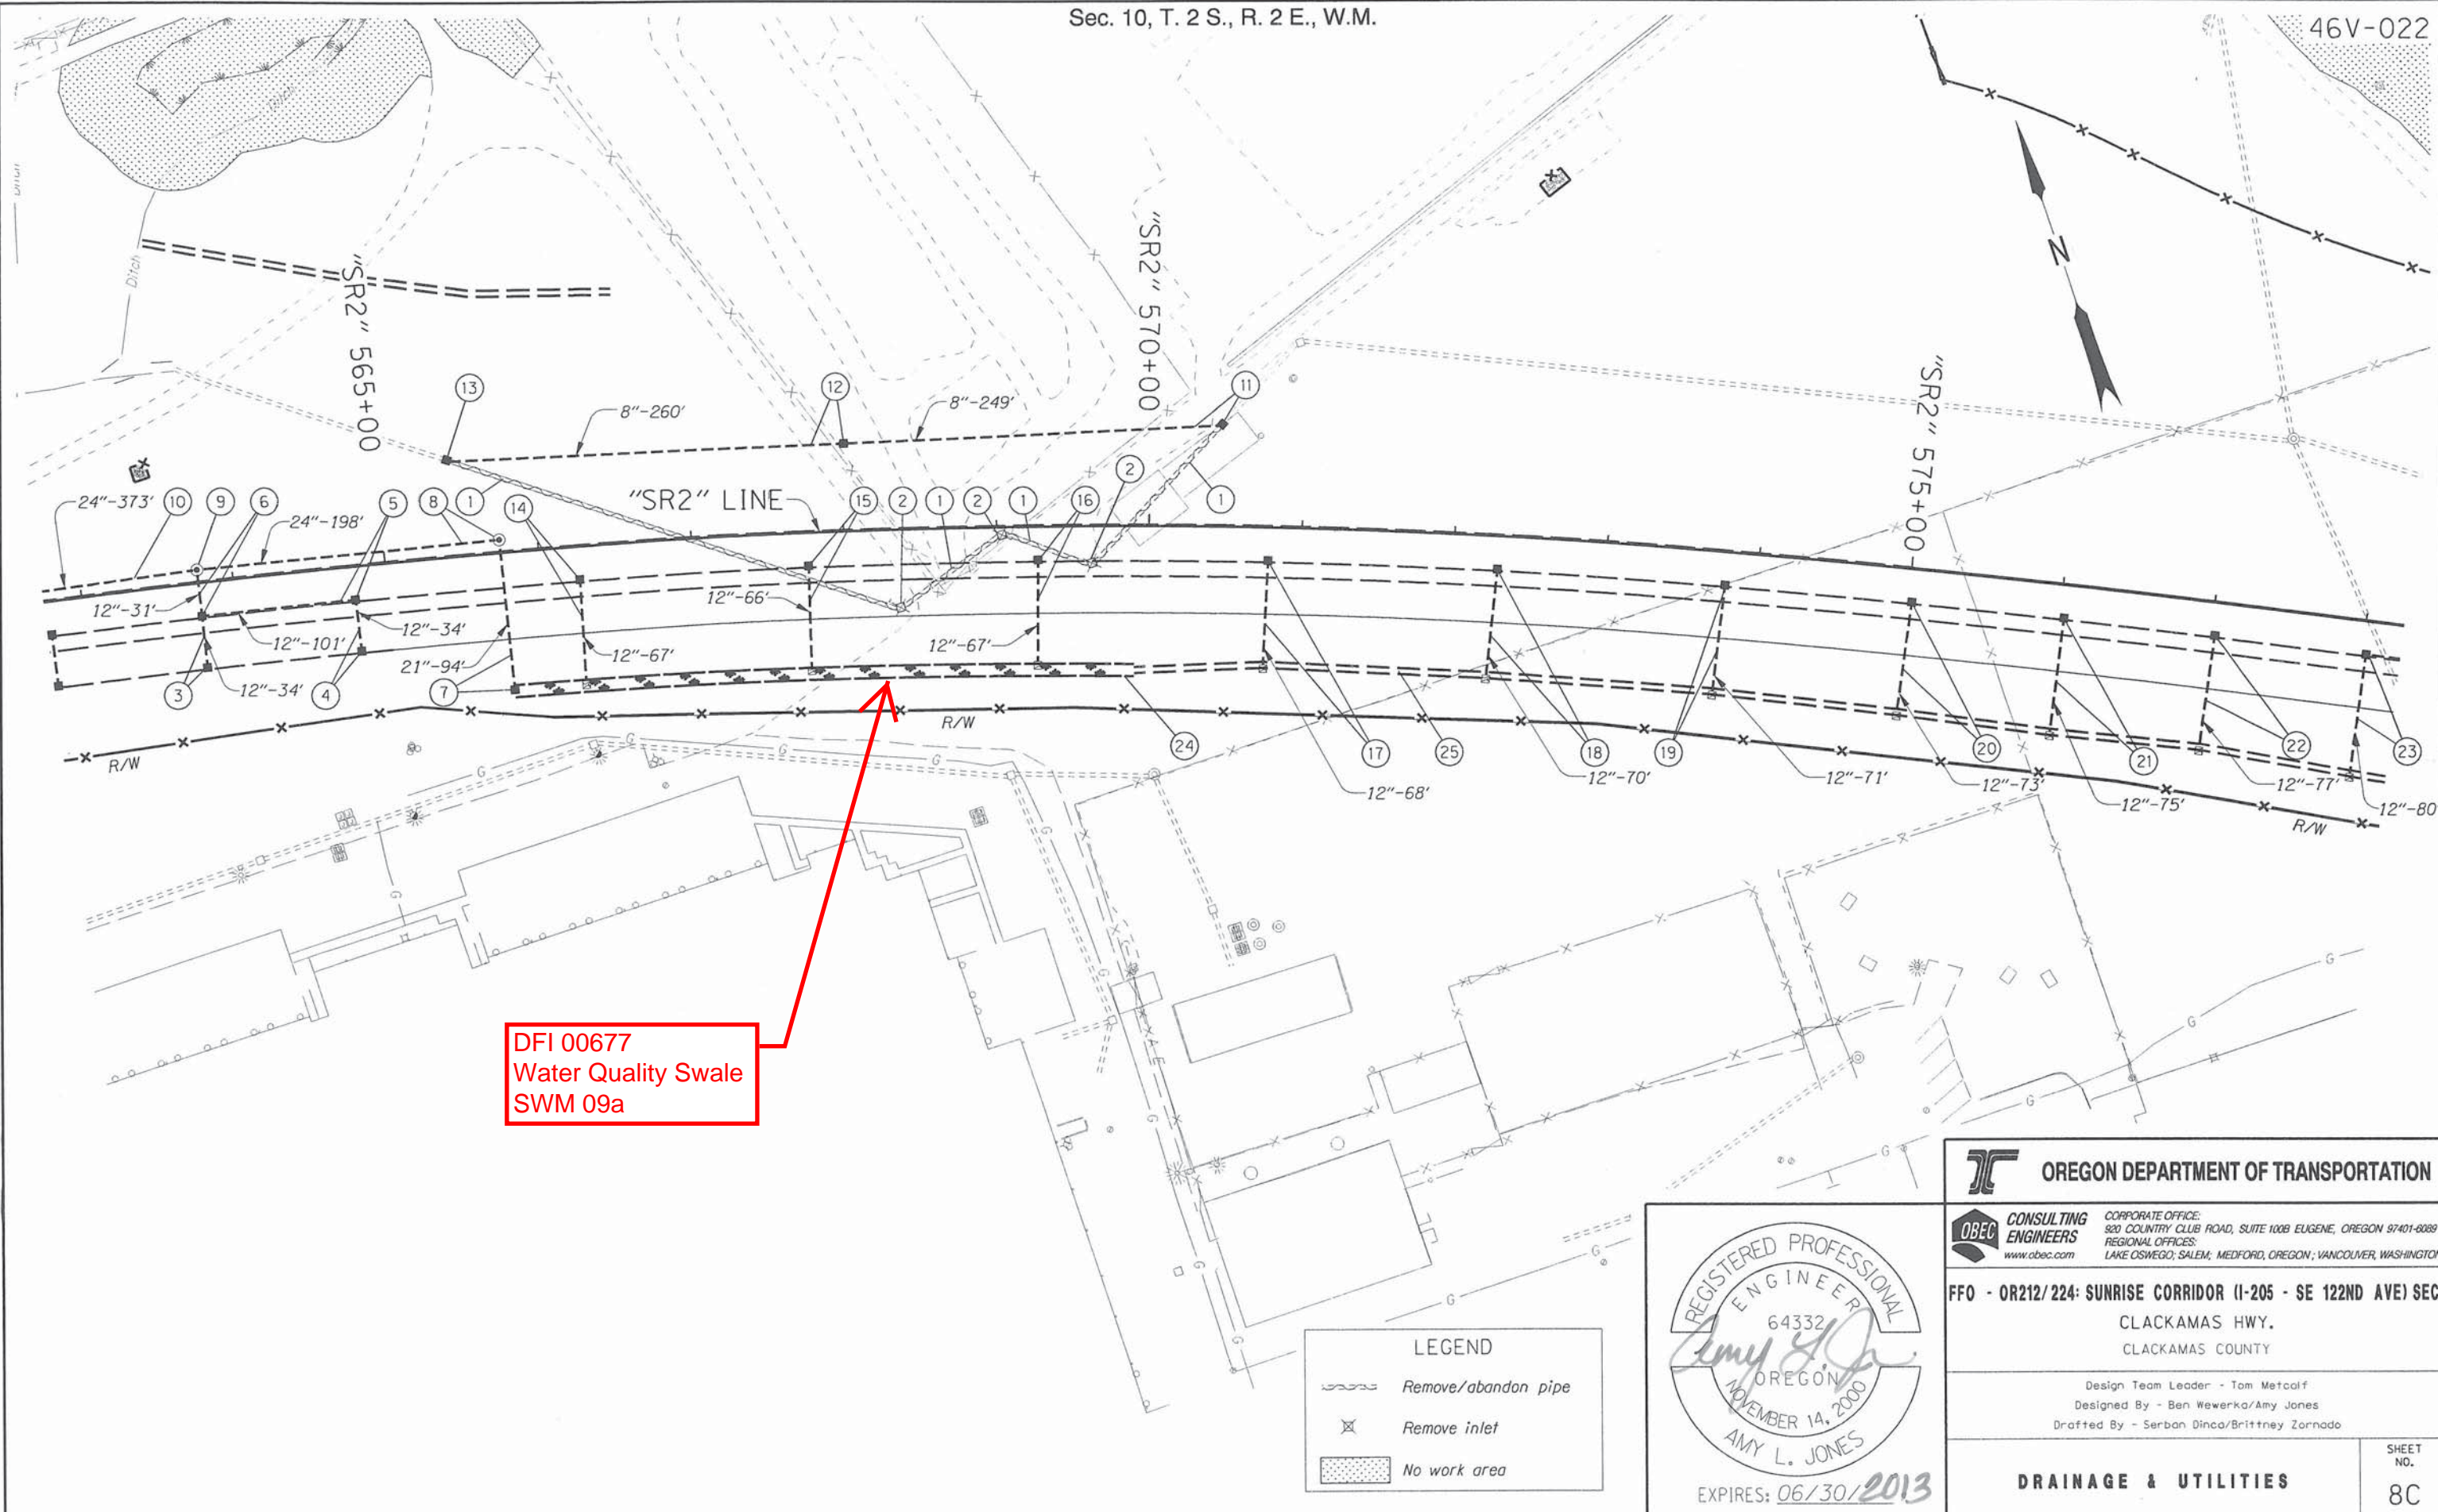

DFI 00677
 Water Quality Swale
 SWM 09a

LEGEND	
	Remove/abandon pipe
	Remove inlet
	No work area

REGISTERED PROFESSIONAL
 ENGINEER
 64332

 OREGON
 NOVEMBER 14, 2000
 AMY L. JONES
 EXPIRES: 06/30/2013

OREGON DEPARTMENT OF TRANSPORTATION

CONSULTING ENGINEERS
 www.obec.com
 CORPORATE OFFICE:
 920 COUNTRY CLUB ROAD, SUITE 100B EUGENE, OREGON 97401-8089
 REGIONAL OFFICES:
 LAKE OSWEGO; SALEM; MEDFORD, OREGON; VANCOUVER, WASHINGTON


FFO - OR212/224: SUNRISE CORRIDOR (I-205 - SE 122ND AVE) SEC.
 CLACKAMAS HWY.
 CLACKAMAS COUNTY

Design Team Leader - Tom Metcalf
 Designed By - Ben Wewerka/Amy Jones
 Drafted By - Serban Dinca/Brittney Zornado

DRAINAGE & UTILITIES

SHEET NO.
 8C

- ① Abandon pipe
- ② Remove inlet - 3
- ③ Sta. "SR2" 563+76.87, 55.9' Rt.
Const. type "G-2" inlet
Inst. 12" storm sew. pipe - 34'
5' depth
- ④ Sta. "SR2" 564+79.23, 55.9' Rt.
Const. type "G-2" inlet
Inst. 12" storm sew. pipe - 34'
5' depth
- ⑤ Sta. "SR2" 564+78.58, 21.9' Rt.
Const. type "G-2" inlet
Inst. 12" storm sew. pipe - 101'
5' depth
- ⑥ Sta. "SR2" 563+77.17, 21.9' Rt.
Const. type "G-2" inlet
Inst. 12" storm sew. pipe - 31'
10' depth
- ⑦ Sta. "SR2" 565+76.91, 85.31' Rt.
Const. type "M-E" inlet
Inst. 21" storm sew. pipe - 94'
10' depth
(See drg. no. RD368)
- ⑧ Sta. "SR2" 565+75.17, 8.7' Lt.
Const. storm manhole 60" dia.
Inst. 24" storm sew. pipe - 198'
10' depth
- ⑨ Sta. "SR2" 563+77.24, 8.71' Lt.
Const. storm manhole 60" dia.
- ⑩ See sht. 7D, note 4
Inst. 24" storm sew. pipe
- ⑪ Sta. "SR2" 570+47.65, 66.5' Lt.
Const. type "G-2" inlet
Inst. 8" storm sew. pipe - 249'
5' depth
Connect to extg. storm sew. pipe
- ⑫ Sta. "SR2" 568+02.26, 57.8' Lt.
Const. type "G-2" inlet
Inst. 8" storm sew. pipe - 260'
5' depth
- ⑬ Sta. "SR2" 565+45.53, 62.8' Lt.
Const. type "G-2" inlet
Connect to extg. storm sew. pipe
- ⑭ Sta. "SR2" 566+25.53, 21.9' Rt.
Const. type "G-2" inlet
Inst. 12" storm sew. pipe - 67'
5' depth
Const. sloped end
Const. riprap basin
(For details, see sht. GJ-22)
- ⑮ Sta. "SR2" 567+76.03, 21.9' Rt.
Const. type "G-2" inlet
Inst. 12" storm sew. pipe - 66'
5' depth
Const. sloped end
Const. riprap basin
(For details, see sht. GJ-22)
- ⑯ Sta. "SR2" 569+26.74, 21.9' Rt.
Const. type "G-2" inlet
Inst. 12" storm sew. pipe - 67'
5' depth
Const. sloped end
Const. riprap basin
(For details, see sht. GJ-22)
- ⑰ Sta. "SR2" 570+78.02, 21.9' Rt.
Const. type "G-2" inlet
Inst. 12" storm sew. pipe - 68'
5' depth
Const. sloped end
Const. riprap basin
(For details, see sht. GJ-22)
- ⑱ Sta. "SR2" 572+29.09, 21.9' Rt.
Const. type "G-2" inlet
Inst. 12" storm sew. pipe - 70'
5' depth
Const. sloped end
Const. riprap basin
(For details, see sht. GJ-22)
- ⑲ Sta. "SR2" 573+79.01, 21.9' Rt.
Const. type "G-2" inlet
Inst. 12" storm sew. pipe - 71'
5' depth
Const. sloped end
Const. riprap basin
(For details, see sht. GJ-22)
- ⑳ Sta. "SR2" 575+02.17, 21.9' Rt.
Const. type "G-2" inlet
Inst. 12" storm sew. pipe - 73'
5' depth
Const. sloped end
Const. riprap basin
(For details, see sht. GJ-22)
- ㉑ Sta. "SR2" 576+02.73, 21.9' Rt.
Const. type "G-2" inlet
Inst. 12" storm sew. pipe - 75'
5' depth
Const. sloped end
Const. riprap basin
(For details, see sht. GJ-22)
- ㉒ Sta. "SR2" 577+02.53, 21.9' Rt.
Const. type "G-2" inlet
Inst. 12" storm sew. pipe - 77'
5' depth
Const. sloped end
Const. riprap basin
(For details, see sht. GJ-22)
- ㉓ Sta. "SR2" 578+02.56, 21.9' Rt.
Const. type "G-2" inlet
Inst. 12" storm sew. pipe - 80'
5' depth
Const. sloped end
Const. riprap basin
(For details, see sht. GJ-22)
- ㉔ Const. water quality swale, D00677 (SWM09a)
Inst. facility field marker, type S1-2
Inst. facility field marker, type S2
(For details, see sht. GJ-12C)
- ㉕ Sta. "SR2" 569+90 to Sta. "SR2" 560+25, Rt.
Const. ditch
2' flat bottom, 1:4 and 1:2 slopes

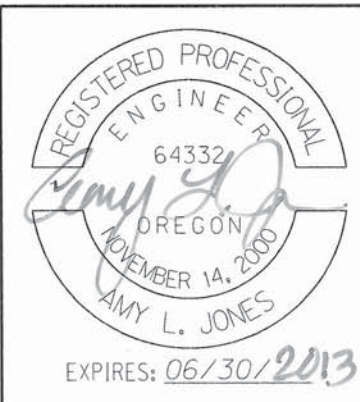



OREGON DEPARTMENT OF TRANSPORTATION

OBEC CONSULTING ENGINEERS
CORPORATE OFFICE: 920 COUNTRY CLUB ROAD, SUITE 100B EUGENE, OREGON 97401-6089
REGIONAL OFFICES: LAKE OSWEGO, SALEM, MEDFORD, OREGON; VANCOUVER, WASHINGTON
www.obec.com



FFO - OR212/224: SUNRISE CORRIDOR (I-205 - SE 122ND AVE) SEC.
CLACKAMAS HWY.
CLACKAMAS COUNTY

Design Team Leader - Tom Metcalf
Designed By - Ben Wewerka/Amy Jones
Drafted By - Serban Dinca/Brittney Zornado

DRAINAGE & UTILITIES NOTES
SHEET NO. 8D

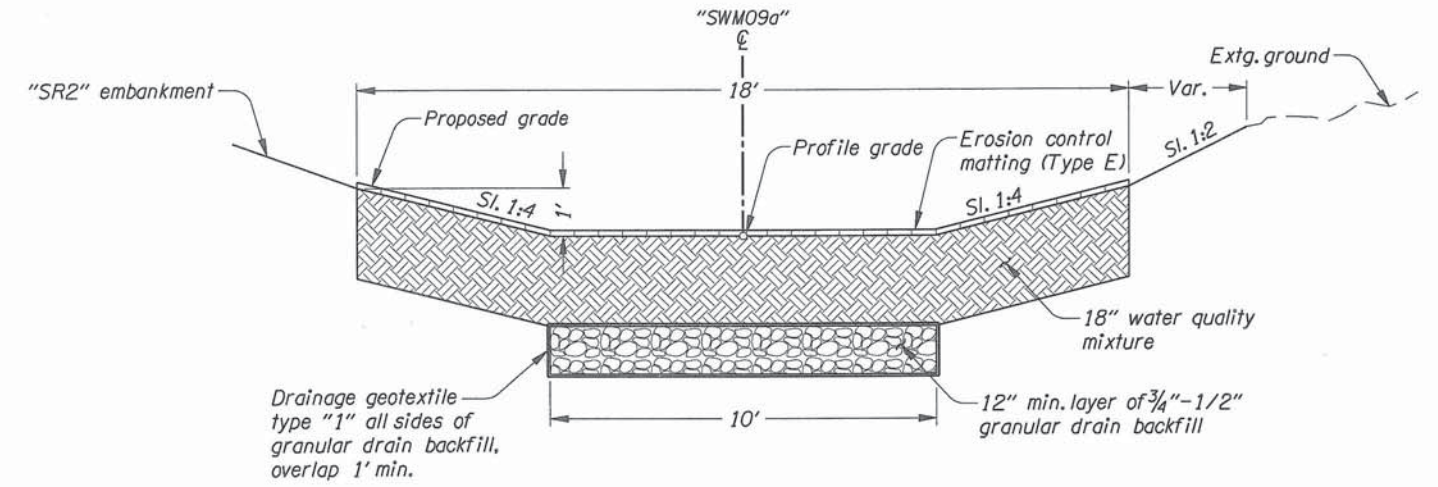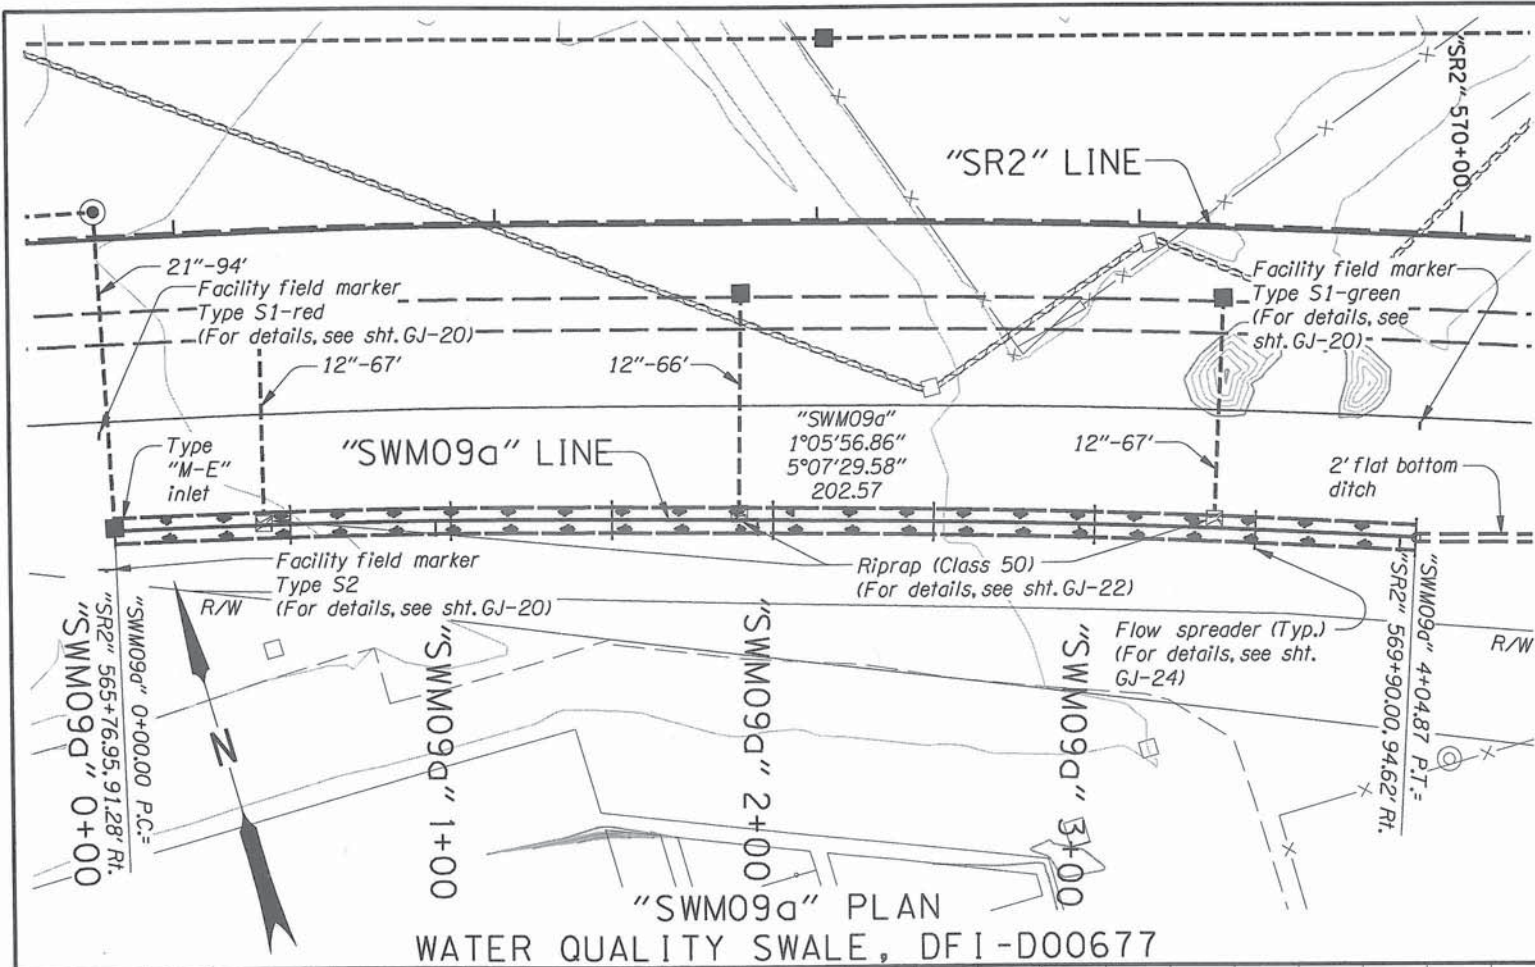

"SWM09a" WATER QUALITY SWALE TYPICAL SECTION, DFI-D00677

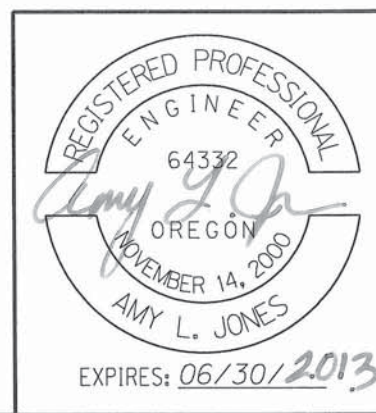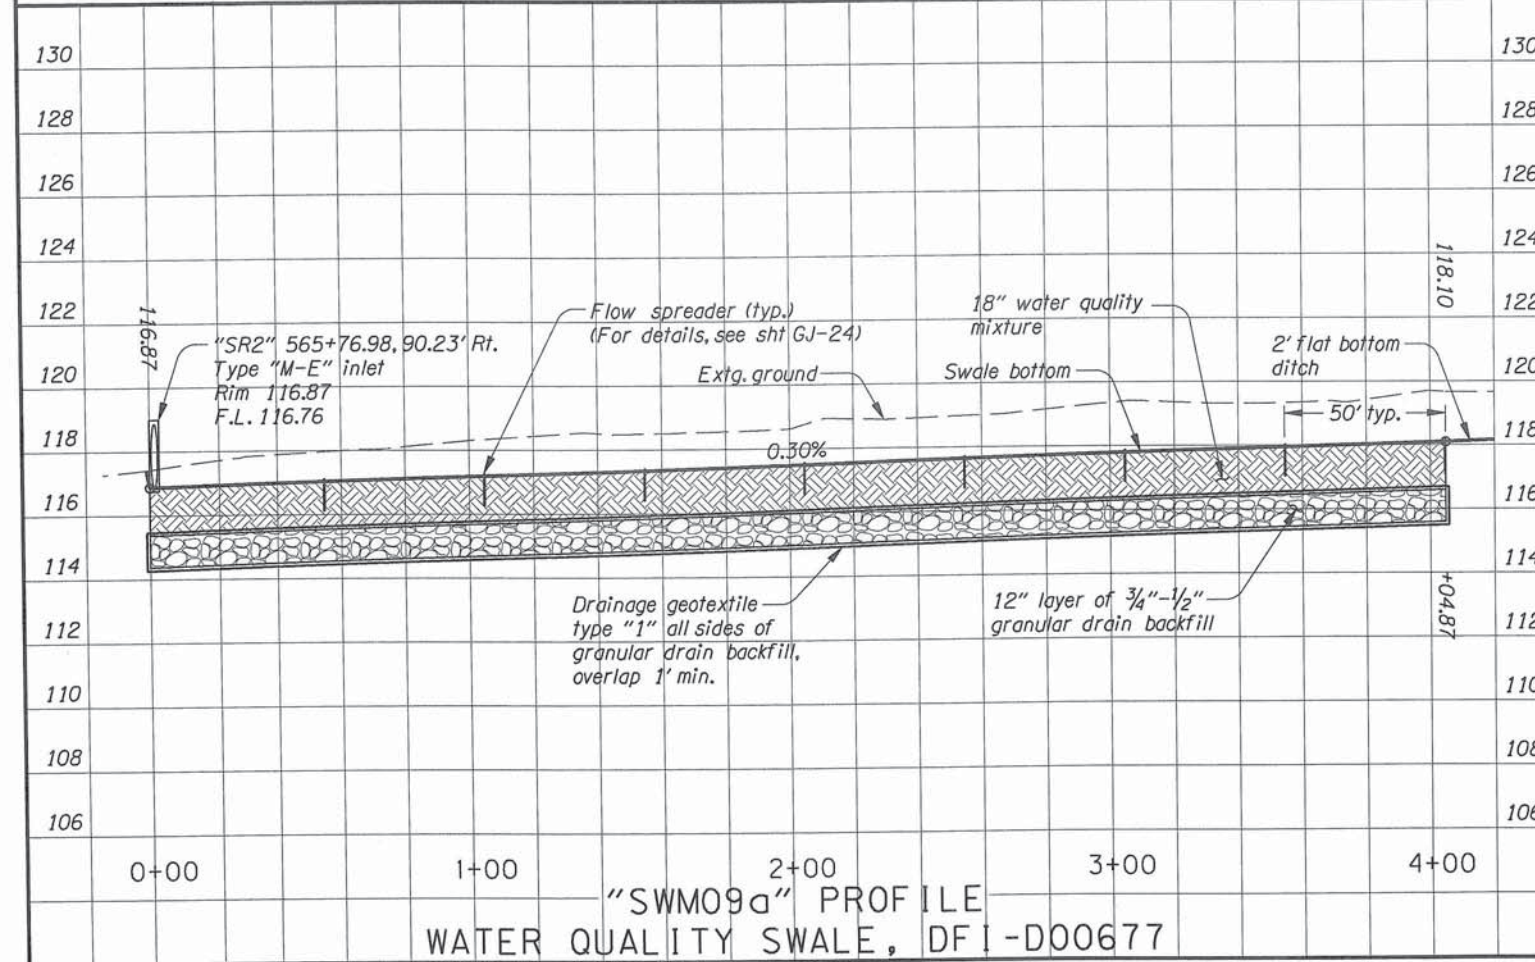

OREGON DEPARTMENT OF TRANSPORTATION

CONSULTING ENGINEERS
 CORPORATE OFFICE: 920 COUNTRY CLUB ROAD, SUITE 100B EUGENE, OREGON 97401-6089
 REGIONAL OFFICES: LAKE OSWEGO, SALEM, MEDFORD, OREGON; VANCOUVER, WASHINGTON
 www.obec.com

FFO - OR212/224: SUNRISE CORRIDOR (I-205 - SE 122ND AVE) SEC. CLACKAMAS HWY. CLACKAMAS COUNTY

Design Team Leader - Tom Metcalf
 Designed By - Ben Wewerka/Amy Jones
 Drafted By - Serban Dinca/Brittney Zornado

STORMWATER DETAILS

SHEET NO. **GJ-12C**