

OPERATION & MAINTENANCE MANUAL

DFI No. : D00682

**Facility Type: Water Quality Filter
Strip**



[April, 2018]

INDEX

1. IDENTIFICATION..... 1

2. FACILITY CONTACT INFORMATION 1

3. CONSTRUCTION..... 1

4. STORM DRAIN SYSTEM AND FACILITY OVERVIEW 1

5. FACILITY HAZ MAT SPILL FEATURE(S)..... 3

6. AUXILIARY OUTLET (HIGH FLOW BYPASS)..... 3

7. MAINTENANCE REQUIREMENTS..... 3

8. WASTE MATERIAL HANDLING..... 4

APPENDIX A: Operational Plan and Profile Drawing

APPENDIX B: ODOT Project Plan Sheets

1. Identification

Drainage Facility ID (DFI): **D00682**
Facility Type: Water Quality Filter Strip
Construction Drawings: (V-File Number) 46V-022
Location: District: 2B
Highway No.: 068
Mile Post: 0.11;0.12 (beg./end)
Description: This facility is located on the west side of OR 213 just north of the Sunrise Corridor.

2. Facility Contact Information

Contact the Engineer of Record, Region Technical Center, or Geo-Environmental's Senior Hydraulics Engineer for:

- Operational clarification
- Maintenance clarification
- Repair or restoration assistance

Engineering Contacts:

Region Technical Center Hydro Unit Manager

Or

Geo-Environmental Senior Hydraulics Engineer (503) 986-3365.

3. Construction

4. Engineer of Record: Consultant Designer – [OBEC Consulting Engineers, Amy Jones, 971-634-2005]

Facility construction: [2014]
Contractor: Kerr Contractors, Inc.

5. Storm Drain System and Facility Overview

A water quality filter strip is a grassed sloped area located between pavement and a downslope conveyance system designed to treat stormwater runoff from highway pavement areas. This type of facility provides treatment by dispersion. It relies on maintaining sheet flow across vegetated and permeable ground which maximizes stormwater contact with soil and vegetation.

This filter strip swale is designed to treat runoff from the water quality design storm for an area along 82nd Avenue that cannot be directed to bio-retention pond (D00667). It is located on the west side of OR 213 just north of the Sunrise Corridor.

The stormwater runoff sheet flows from paved areas along OR 213 to the filter strip.

Runoff exits the swale by way of a Type "D" inlet connected to a 12-inch storm drain outlet pipe. See Photo 1 and Point A on the Operational Plan in Appendix A.

The storm drain outlet pipe from the inlet and 12" pipe connect into the downstream pipe system that drains to Dean Creek. The receiving waterway for the outlet pipe is Dean Creek.

A. Maintenance equipment access:

The swale and outlet structure can be accessed directly from the shoulder of the Interstate 205 southbound off ramp to 82nd Drive.

B. Heavy equipment access into facility:

- Allowed (no limitations)
- Allowed (with limitations)
- Not allowed

C. Special Features:

- Amended Soils
- Porous Pavers
- Liners
- Underdrains



Photo 1: a view of water quality filter strip looking South.

6. Facility Haz Mat Spill Feature(s)

The water quality filter strip can be used to store a volume of liquid by blocking the 12-inch diameter outlet pipe with the Type “D” inlet located at the outfall structure at the west end of the swale. A barrier such as a metal plate over the metal grate on the inlet could be used to prevent liquid from draining from the swale.

7. Auxiliary Outlet (High Flow Bypass)

There is no auxiliary outlet provided for the water quality swale. Storm events larger than the water quality storm will be diverted to bypass the swale with the split flow manhole upstream of the swale. The intent of the filter strip is for water quality with no provisions for quantity management.

8. Maintenance Requirements

Routine maintenance table for non-proprietary stormwater treatment and storage/detention facilities have been incorporated into ODOT’s Maintenance Guide. These tables summarize the maintenance requirements for ponds, swales, filter strips, bioslopes, and detention tanks and vaults. Special maintenance requirements in addition to the routine requirements are noted below when applicable.

The ODOT Maintenance Guide can be viewed at the following website:

<http://www.oregon.gov/ODOT/HWY/OOM/MGuide.shtml>

The following stormwater facility maintenance table (See ODOT Maintenance Guide) should be used to maintain the facility outlined in this Operation and Maintenance Manual:

- Table 1 (general maintenance)
- Table 2 (stormwater ponds)
- Table 3 (water quality biofiltration swales)
- Table 4 (water quality filter strips)
- Table 5 (water quality bioslopes)
- Table 6 (detention tank)
- Table 7 (detention vault)
- Appendix C (proprietary structure)
- Special Maintenance requirements:

9. Waste Material Handling

Material removed from the facility is defined as waste by DEQ. Refer to the roadwaste section of the ODOT Maintenance Yard Environmental Management System (EMS) Policy and Procedures Manual for disposal options: <http://egov.oregon.gov/ODOT/HWY/OOM/EMS.shtml>


Contact any of the following for more detailed information about management of waste materials found on site:

ODOT Clean Water Unit	(503) 986-3008
ODOT Statewide Hazmat Coordinator	(503) 229-5129
ODOT Region Hazmat Coordinator	(503) 731-8290
ODEQ Northwest Region Office	(503) 229-5263

Appendix A

Content:

- **Operational Plan and Profile Drawing**

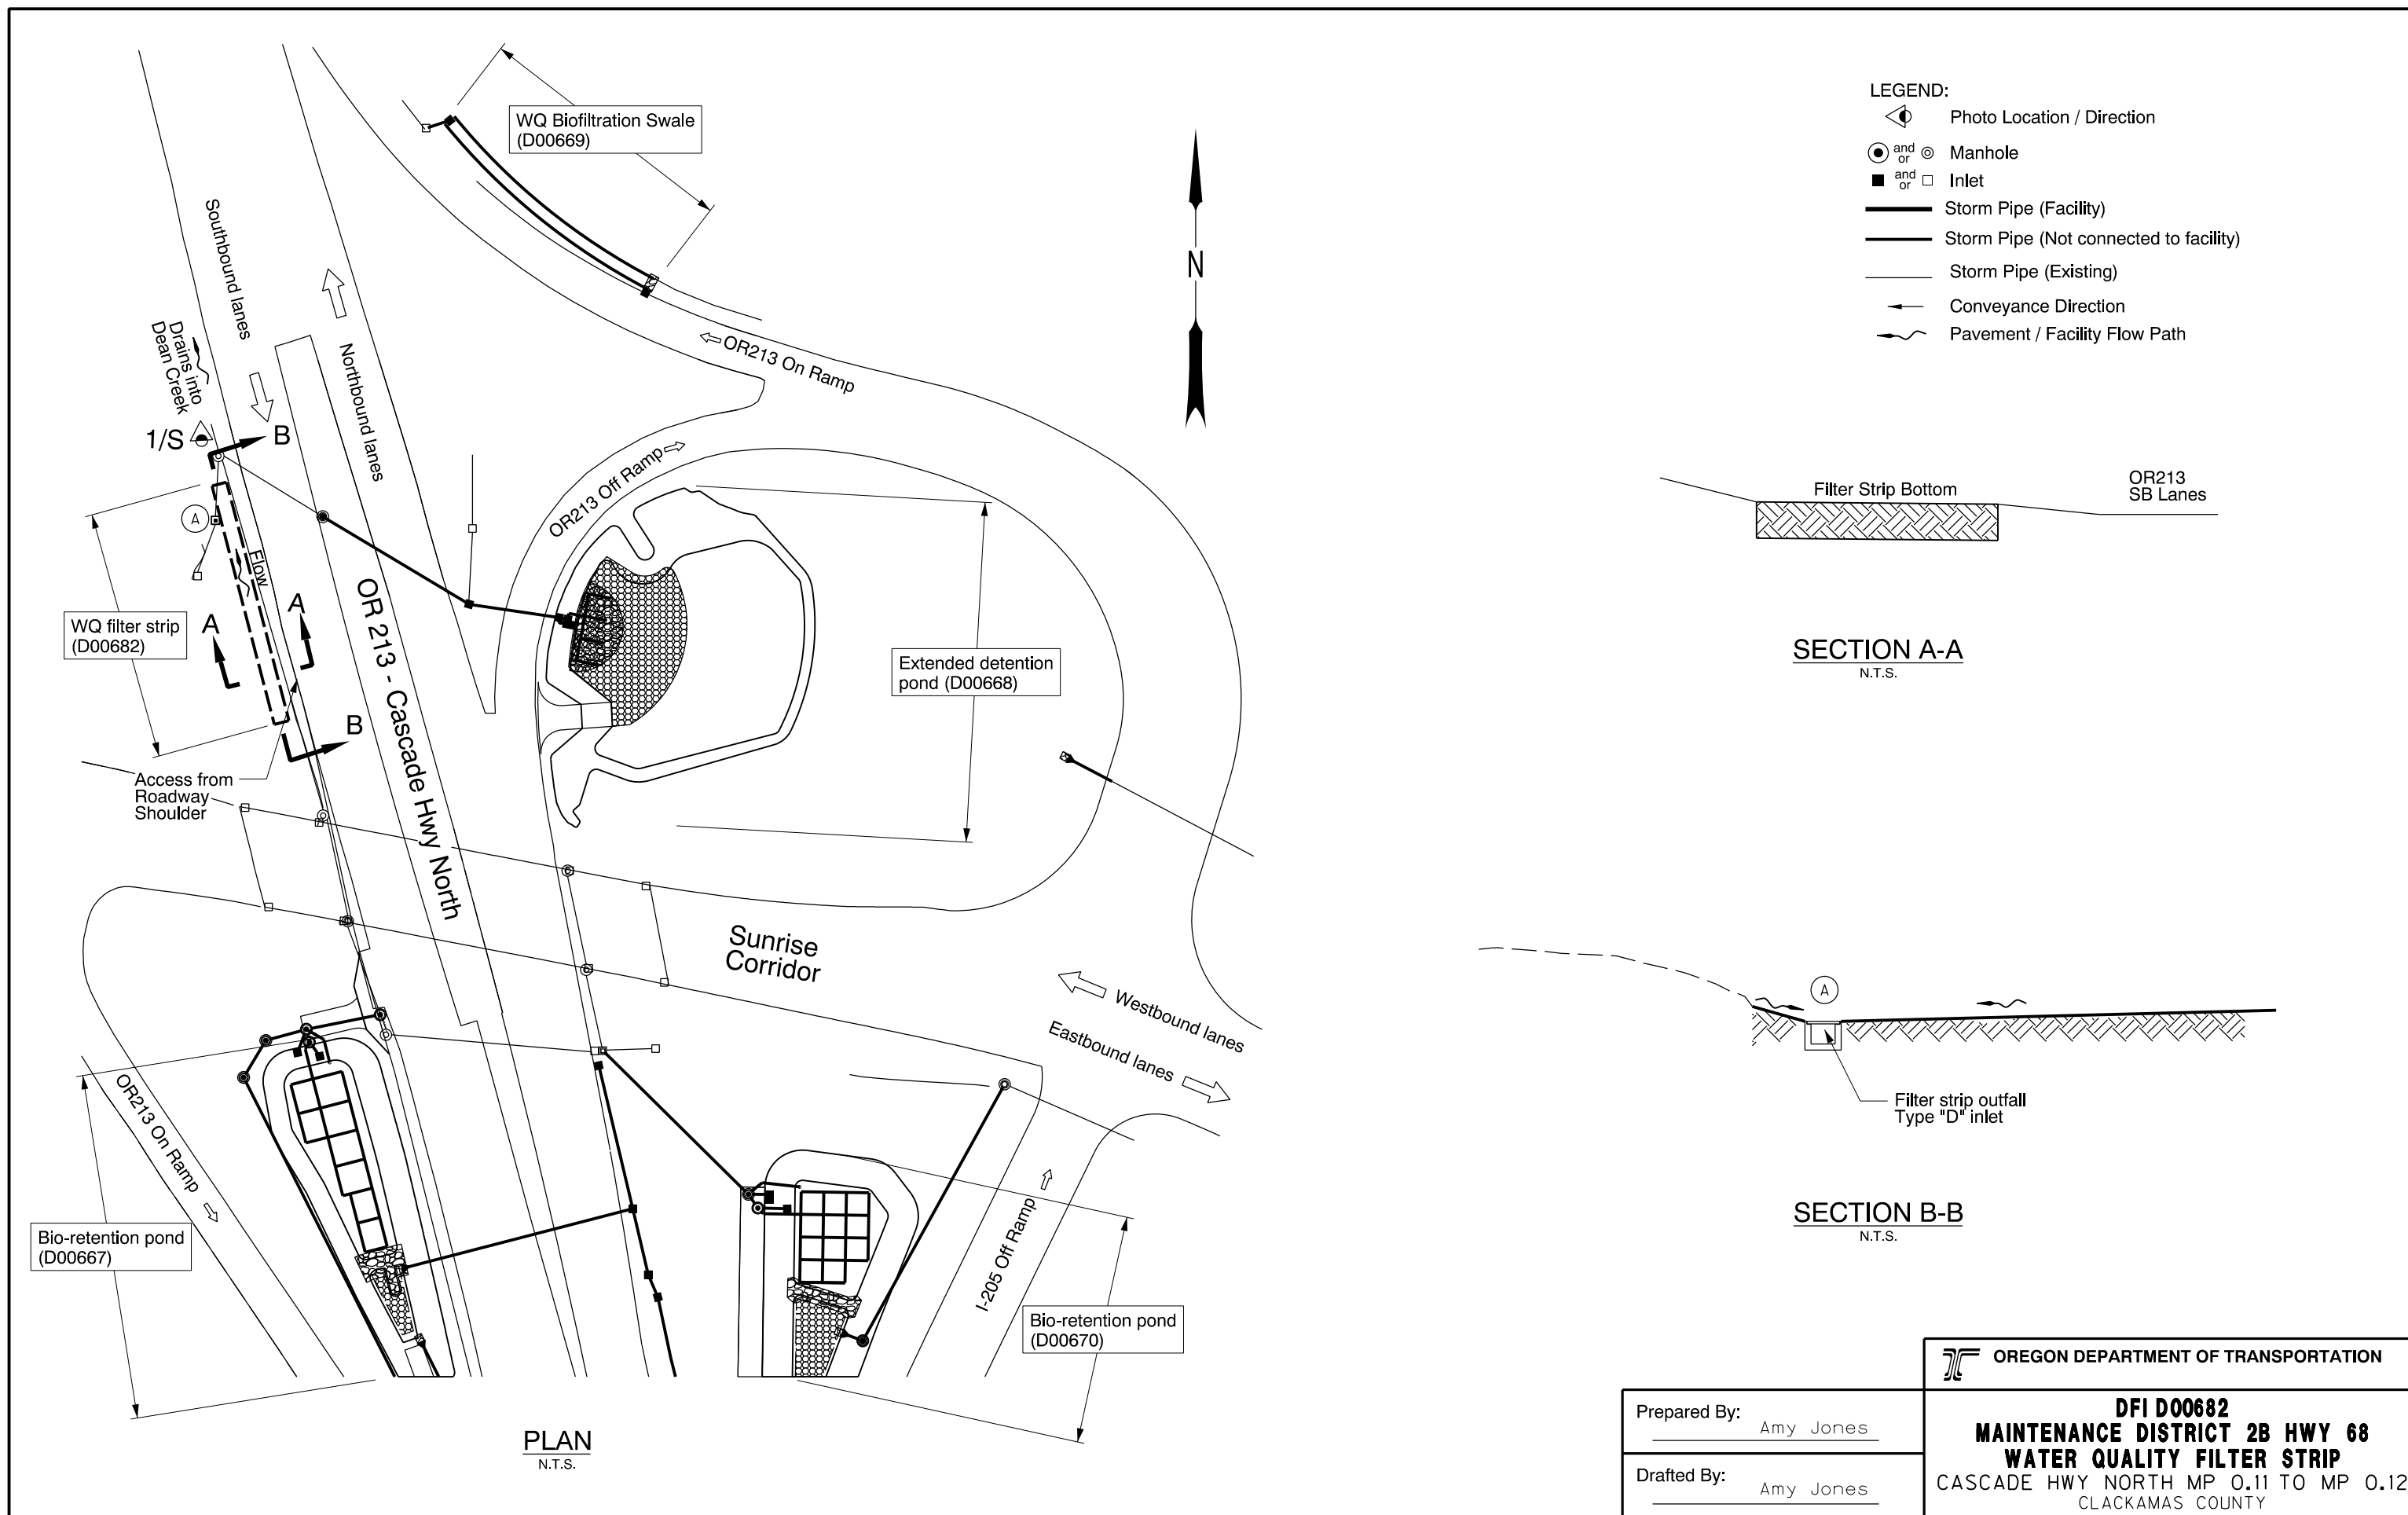

- LEGEND:**
- Photo Location / Direction
 - Manhole
 - Inlet
 - Storm Pipe (Facility)
 - Storm Pipe (Not connected to facility)
 - Storm Pipe (Existing)
 - Conveyance Direction
 - Pavement / Facility Flow Path

SECTION A-A
N.T.S.

SECTION B-B
N.T.S.

PLAN
N.T.S.


OREGON DEPARTMENT OF TRANSPORTATION	
Prepared By: Amy Jones	DFI D00682
Drafted By: Amy Jones	MAINTENANCE DISTRICT 2B HWY 68
WATER QUALITY FILTER STRIP	
CASCADE HWY NORTH MP 0.11 TO MP 0.12 CLACKAMAS COUNTY	

Appendix B

Content:

- **ODOT Project Plan Sheets**
 - *Cover/Title Sheet*
 - *Water Quality Plan Sheets*
 - *Other Details*

STATE OF OREGON
 DEPARTMENT OF TRANSPORTATION
 PLANS FOR PROPOSED PROJECT
**GRADING, DRAINAGE, STRUCTURES, PAVING, SIGNING,
 ILLUMINATION, SIGNALS & ROADSIDE DEVELOPMENT**

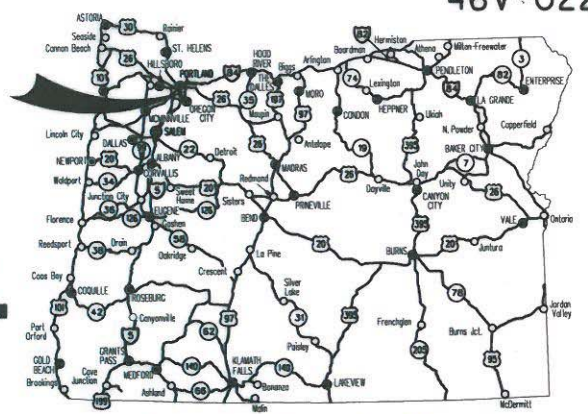

Overall Length Of Project - 3.90 Miles

INDEX OF SHEETS	
SHEET NO.	DESCRIPTION
1	Title Sheet
1A	Index Of Sheets Cont'd.

FFO - OR212/224: SUNRISE CORRIDOR (I-205 - SE 122ND AVE) SEC.

**CLACKAMAS HWY.
 CLACKAMAS COUNTY
 MARCH 2013**


**BEGIN WORK
 JTA-STP-S171(030)
 STA. "SR1" 505+78**

**BEGIN WORK
 JTA-STP-S171(030)
 STA. "G" 463+00**

**END WORK
 JTA-STP-S171(030)
 STA. "G" 492+00**

**END WORK
 JTA-STP-S171(030)
 STA. "OR" 352+20**

**END WORK
 JTA-STP-S171(030)
 STA. "T" 705+75**

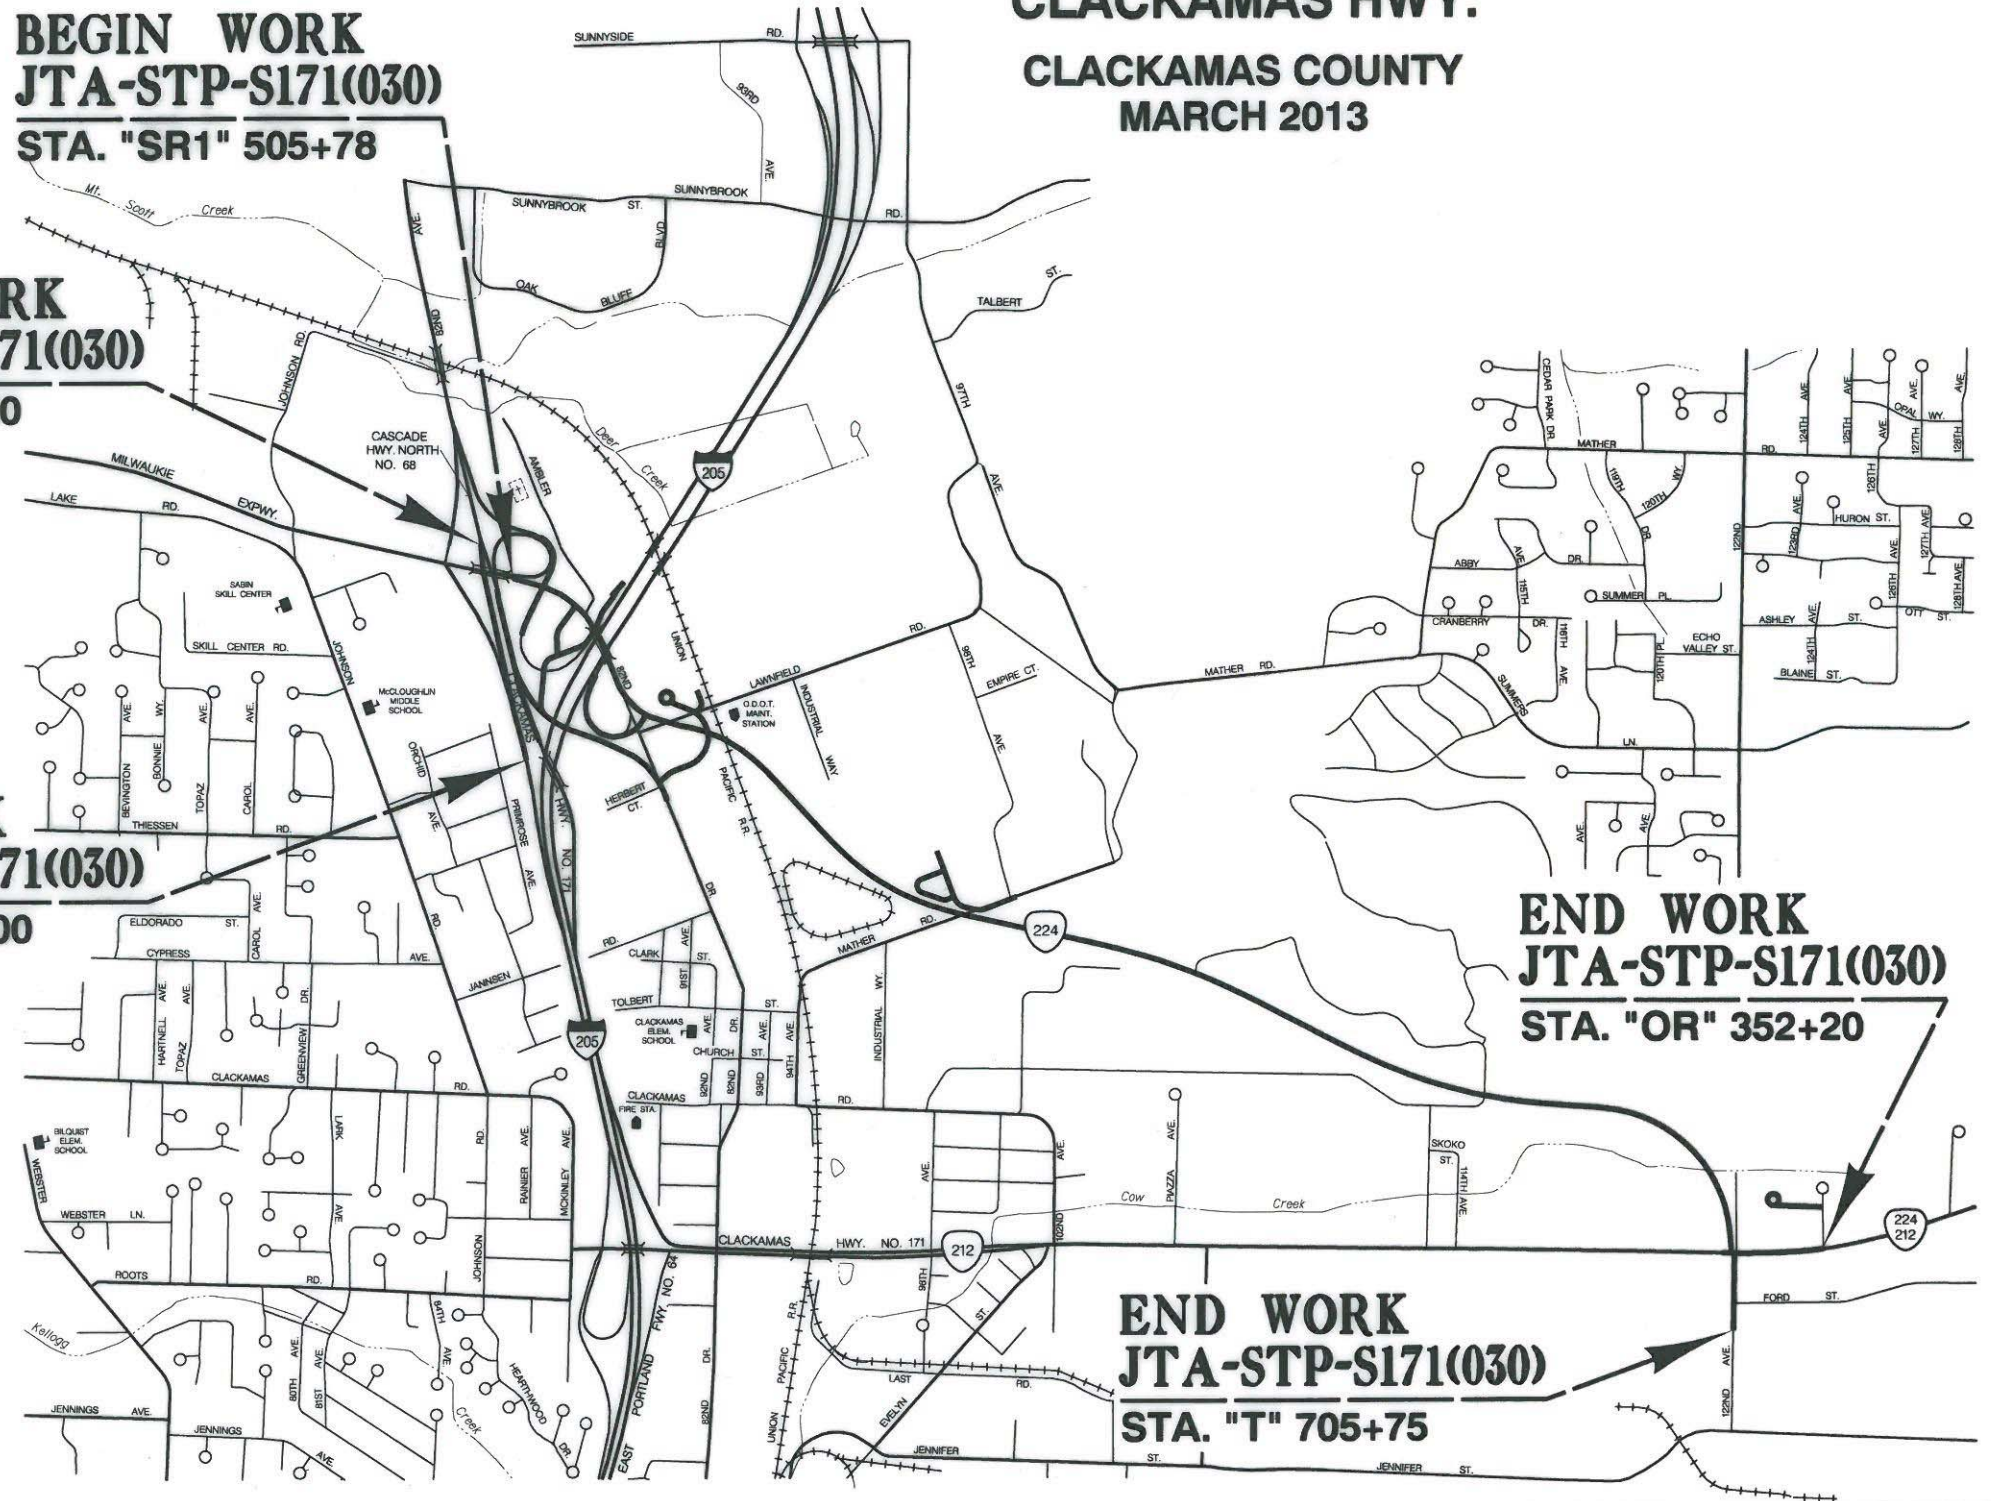

ATTENTION:
 Oregon Law Requires You To Follow Rules Adopted By The Oregon Utility Notification Center. Those Rules Are Set Forth In OAR 952-001-0010 Through OAR 952-001-0090. You May Obtain Copies Of The Rules By Calling The Center. (Note: The Telephone Number For The Oregon Utility Center is (503) 232-1987.)

**LET'S ALL
 WORK TOGETHER
 TO MAKE THIS
 JOB SAFE**

- OREGON TRANSPORTATION COMMISSION**
- Pat Egan CHAIR
 - David Lohman COMMISSIONER
 - Mary F. Olson COMMISSIONER
 - Mark Frohnmayer COMMISSIONER
 - Tammy Boney COMMISSIONER
 - Matthew L. Garrett DIRECTOR OF TRANSPORTATION

PLANS PREPARED FOR
 OREGON DEPARTMENT OF TRANSPORTATION

OBEC CONSULTING ENGINEERS
 CORPORATE OFFICE: 920 COUNTRY CLUB ROAD, SUITE 100B EUGENE, OREGON 97401-0089
 REGIONAL OFFICES: LAKE OSWEGO, SALEM, MEDFORD, OREGON; VANCOUVER, WASHINGTON

These plans were developed using ODOT design standards. Exceptions to these standards, if any, have been submitted and approved by the ODOT Chief Engineer or their delegated authority.

Approving Authority: *Lawrence H. Fox* 12/31/12
 Signature & date


LAWRENCE H. FOX - PROJECT MANAGER
 Print name and title

Concurrence by ODOT Chief Engineer

**FFO - OR212/224: SUNRISE CORRIDOR (I-205 - SE 122ND AVE) SEC.
 CLACKAMAS HWY.
 CLACKAMAS COUNTY**

FEDERAL HIGHWAY ADMINISTRATION	PROJECT NUMBER	SHEET NO.
OREGON DIVISION	JTA-STP-S171(030)	1

SEC. 4, 5, 9, 10, 11
 T. 2 S., R. 2 E., W.M.

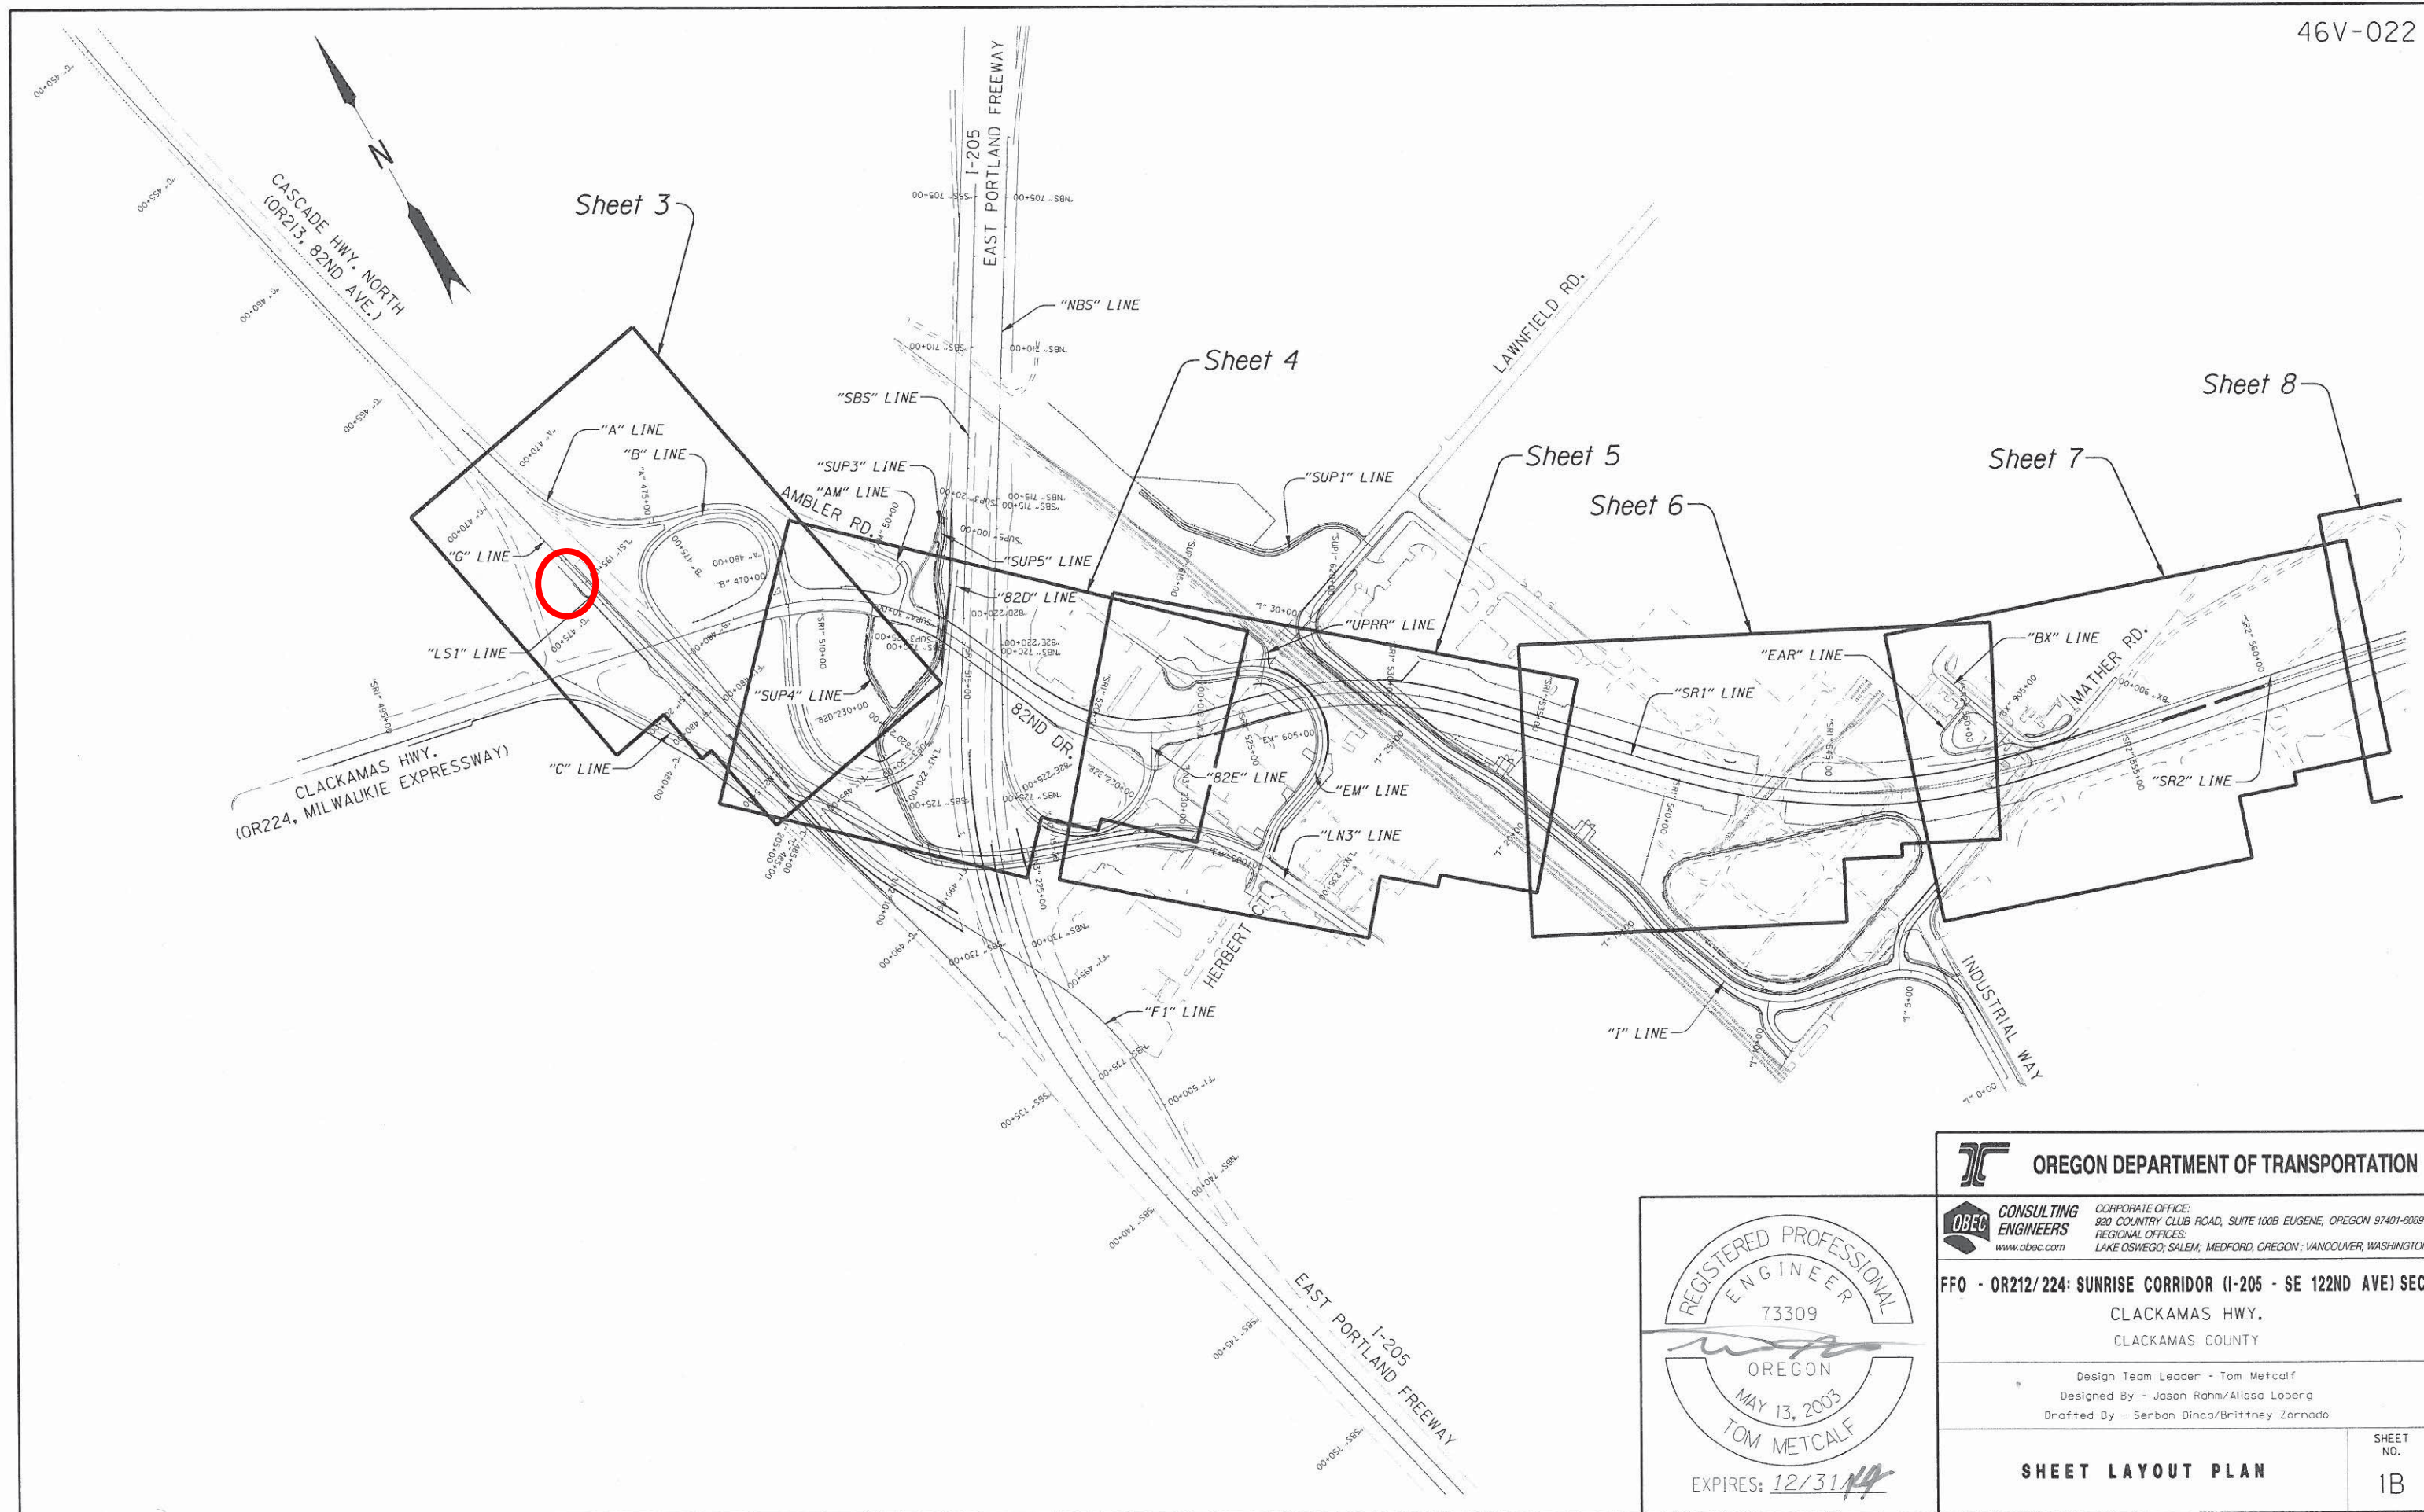

REGISTERED PROFESSIONAL
ENGINEER
73309
OREGON
MAY 13, 2003
TOM METCALF
EXPIRES: 12/31/14

OREGON DEPARTMENT OF TRANSPORTATION

OBEC CONSULTING ENGINEERS
CORPORATE OFFICE:
920 COUNTRY CLUB ROAD, SUITE 100B EUGENE, OREGON 97401-6089
REGIONAL OFFICES:
LAKE OSWEGO, SALEM, MEDFORD, OREGON; VANCOUVER, WASHINGTON
www.obec.com


FFO - OR212/224: SUNRISE CORRIDOR (I-205 - SE 122ND AVE) SEC.
CLACKAMAS HWY.
CLACKAMAS COUNTY

Design Team Leader - Tom Metcalf
Designed By - Jason Rahm/Alissa Loberg
Drafted By - Serban Dinca/Brittney Zornado

SHEET LAYOUT PLAN

SHEET NO.
1B

Sec. 4, T. 2 S., R. 2 E., W.M.

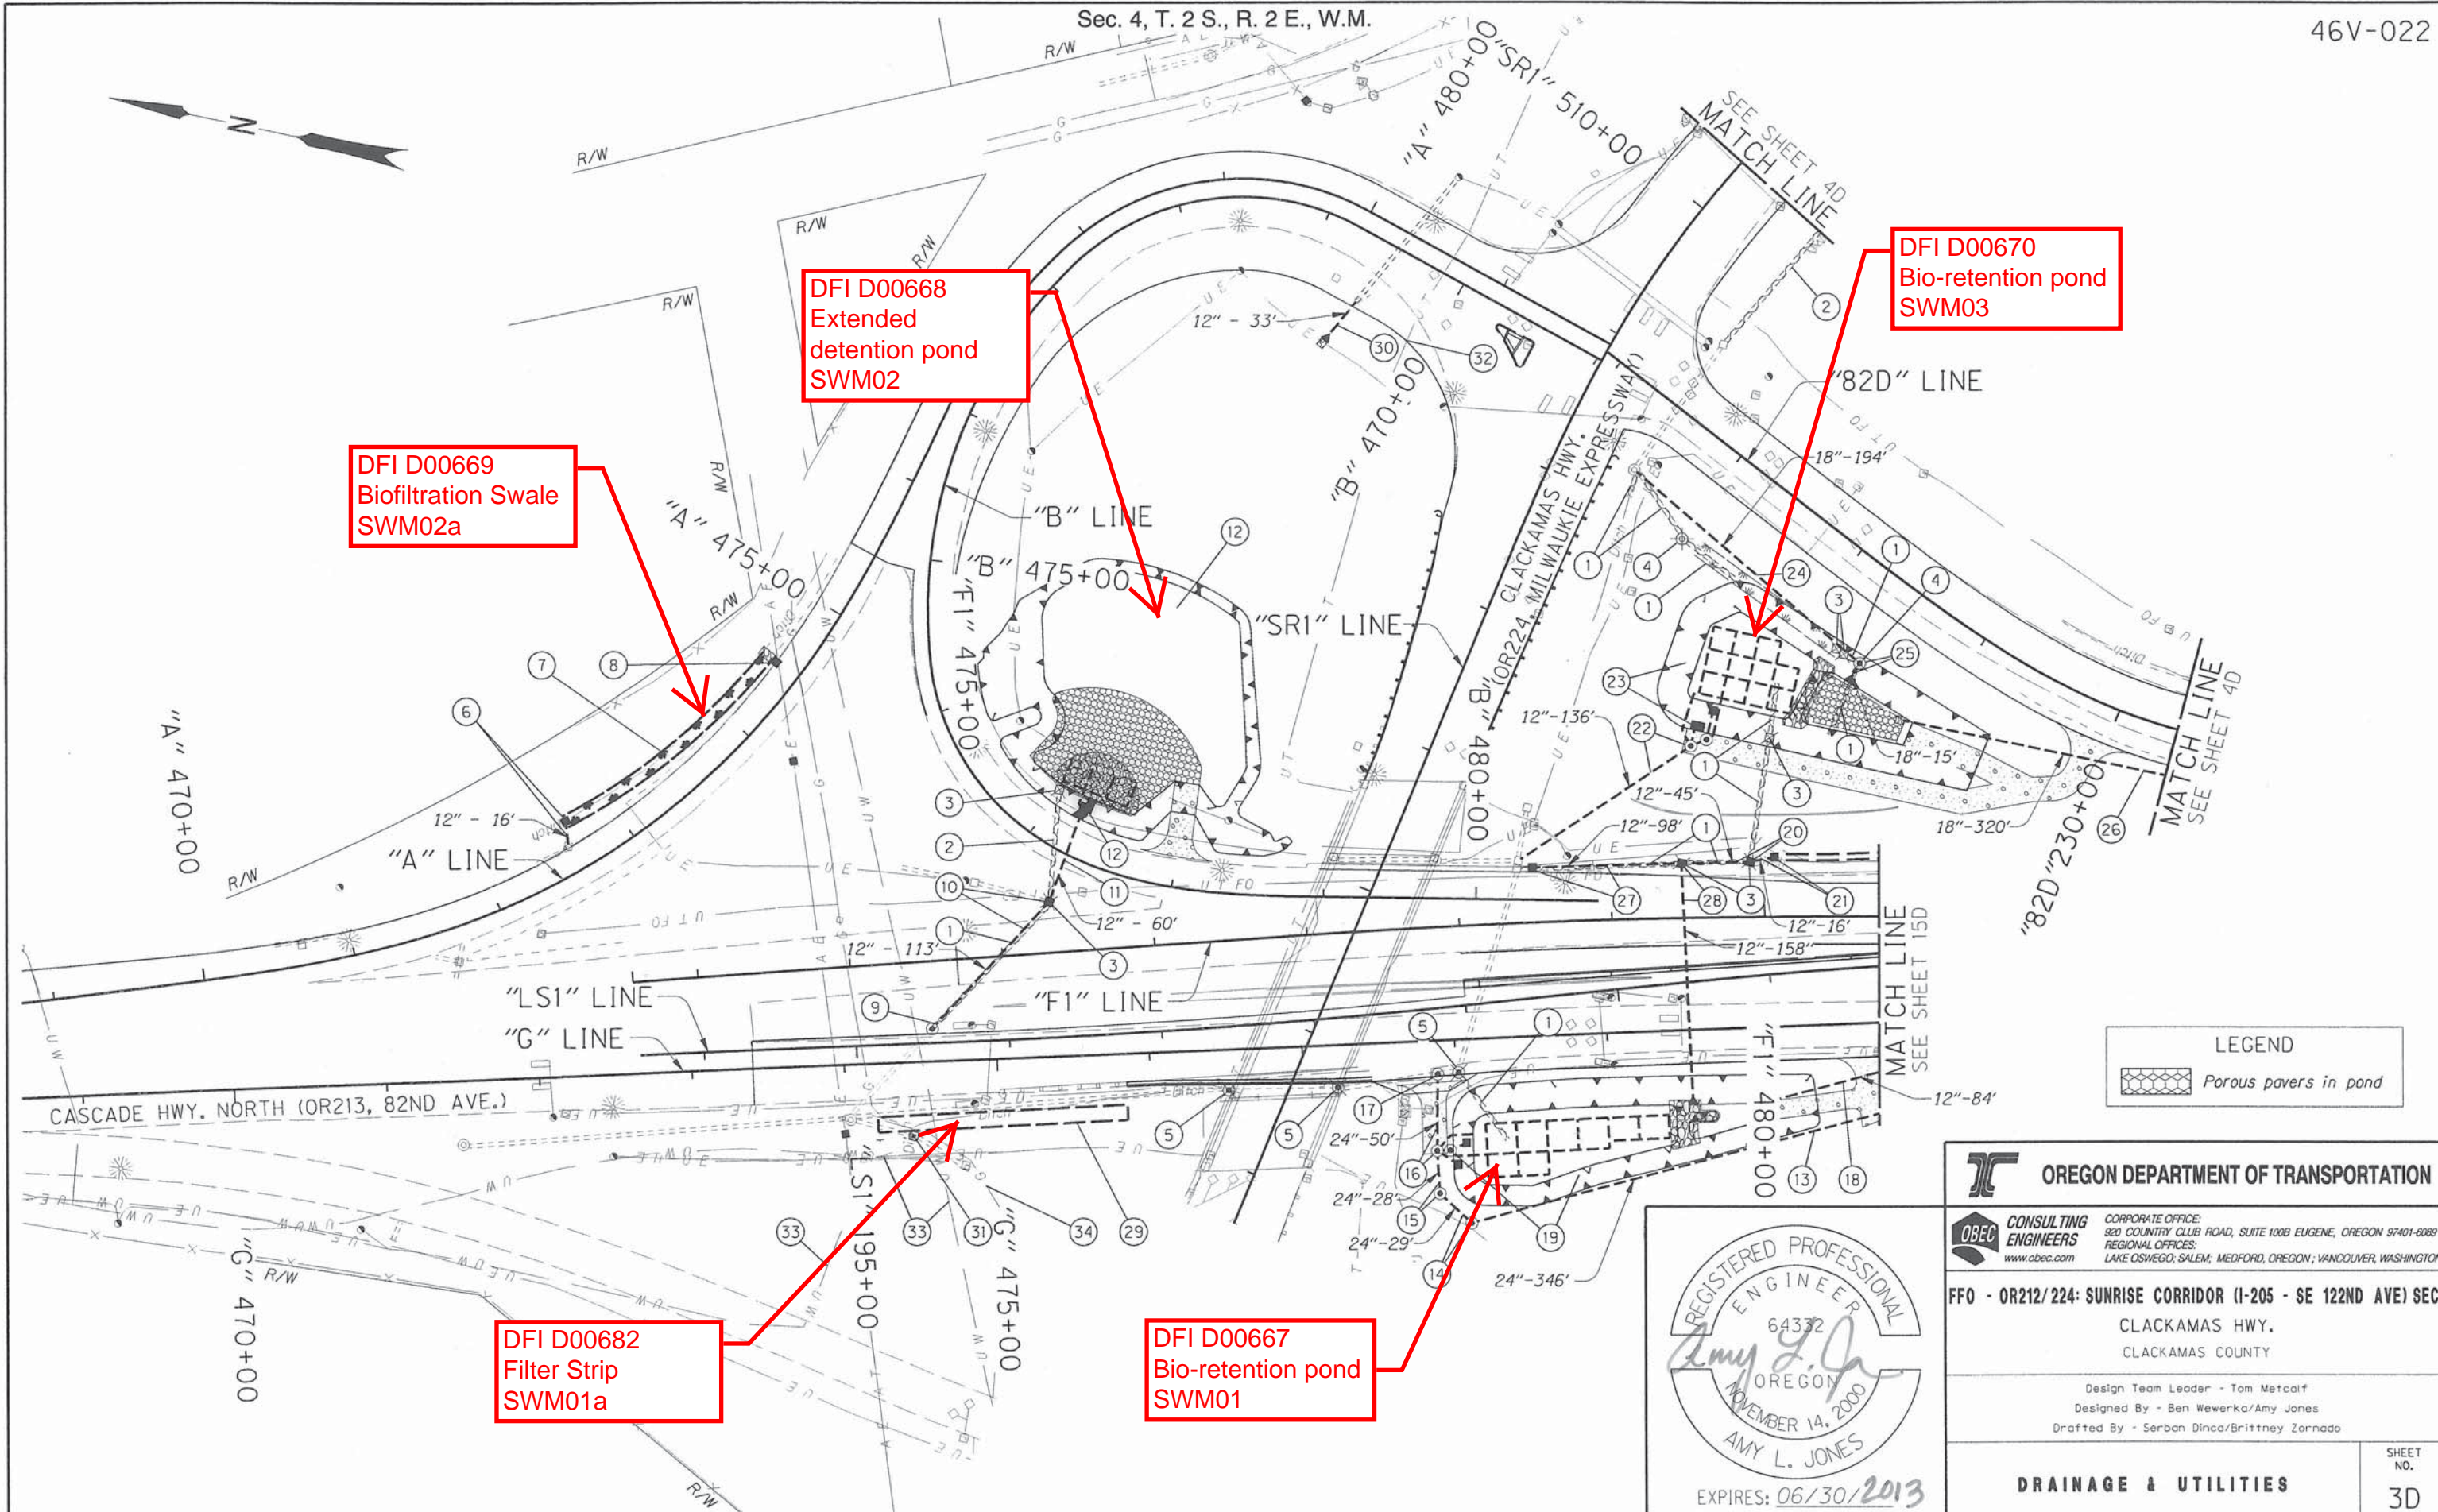

DFI D00669
Biofiltration Swale
SWM02a

DFI D00668
Extended
detention pond
SWM02

DFI D00670
Bio-retention pond
SWM03

DFI D00682
Filter Strip
SWM01a

DFI D00667
Bio-retention pond
SWM01

LEGEND

Porous pavers in pond

REGISTERED PROFESSIONAL
ENGINEER
64372
Amy L. Jones
OREGON
NOVEMBER 14, 2000
AMY L. JONES
EXPIRES: 06/30/2013

OREGON DEPARTMENT OF TRANSPORTATION

OBEC CONSULTING ENGINEERS
CORPORATE OFFICE: 920 COUNTRY CLUB ROAD, SUITE 100B EUGENE, OREGON 97401-6089
REGIONAL OFFICES: LAKE OSWEGO, SALEM, MEDFORD, OREGON; VANCOUVER, WASHINGTON
www.obec.com

FFO - OR212/224: SUNRISE CORRIDOR (I-205 - SE 122ND AVE) SEC.
CLACKAMAS HWY.
CLACKAMAS COUNTY

Design Team Leader - Tom Metcalf
Designed By - Ben Wewerka/Amy Jones
Drafted By - Serban Dinca/Brittney Zornada

DRAINAGE & UTILITIES

SHEET NO. 3D


- ① Remove pipe - 590'
- ② Abandon pipe
- ③ Remove inlet - 6
- ④ Remove manhole - 2
- ⑤ Minor adjust manhole - 3
(See drg. no. RD360)
- ⑥ Sta. "A" 472+66.6, Lt.
Const. type "D" inlet
Inst. 12" storm sew. pipe - 16'
5' depth
Connect to extg. inlet
(See drg. nos. RD300, RD326, RD370, RD380 & RD386)
- ⑦ Const. water quality swale, D00669 (SWM02a)
Inst. facility field markers, type S1 - 2
Inst. facility field marker, type S2
(For details, see sht. GJ-5B)
(See drg. no. RD399)
- ⑧ Sta. "A" 474+49.5, Lt.
Const. modified curb opening
(For details, see sheet 2B-14)
- ⑨ Sta. "F1" 474+50.64, 44.18' Lt.
Const. storm manhole over extg. storm sew. pipe
(See drg. nos. RD335, RD336, RD344 & RD356)
- ⑩ Sta. "F1" 475+32.86, 33.40' Lt.
Const. type "G-2M" inlet
Inst. 12" storm sew. pipe - 113'
10' depth
Tunneling, boring & jacking
(See drg. nos. RD308 & RD364)
- ⑪ Sta. "B" 477+24.04, 27.08' Lt.
Inst. 12" storm sew. pipe - 60'
5' depth
(See drg. no. RD302)
- ⑫ Const. storage pond, D00668 (SWM02)
Inst. facility field markers, type S1 - 2
Inst. facility field marker, type S2
Aggregate base - 65 tons
(For details, see sht. GJ-5)
- ⑬ Sta. "G" 481+44.11, 43.83' Rt. to
Sta. "G" 478+06.33, 119.98' Rt.
Inst. 24" storm sew. pipe - 346'
10' depth
- ⑭ Sta. "G" 478+06.33, 119.98' Rt.
Const. storm manhole 60" dia.
Inst. 24" storm sew. pipe - 29'
10' depth
(See drg. no. RD346)
- ⑮ Sta. "G" 477+86.16, 99.75' Rt.
Const. storm manhole 60" dia.
Inst. 24" storm sew. pipe - 28'
10' depth
- ⑯ Sta. "G" 477+85.48, 71.88' Rt.
Const. storm manhole 72" dia.
Inst. 24" storm sew. pipe - 50'
10' depth
- ⑰ Sta. "G" 477+88.02, 22' Rt.
Const. storm manhole 72" dia.
over extg. storm sew. pipe

- ⑱ Sta. "G" 480+87.09, 29.88' Rt. to Sta. "G" 480+04.97, 48.42' Rt.
Inst. 12" storm sew. pipe - 84'
5' depth
Const. sloped end
Const. riprap basin
(For details, see sht. GJ-22)
(For profile, see sht. 15F)
(See drg. nos. RD318 & RD316)
- ⑲ Const. bio-retention pond, D00667 (SWM01)
Inst. facility field markers, type S1 - 2
Inst. facility field marker, type S2
Conc. pipe anchor
Aggregate base - 150 tons
6" gate valve
(For details, see shts. GJ-4, GJ-4A, GJ-4B & GJ-21)
- ⑳ Sta. "F1" 479+91.16, 36.14' Lt.
Const. type "G-2" inlet
Inst. 12" storm sew. pipe - 45'
5' depth
- ㉑ Sta. "F1" 480+06.94, 39.09' Lt.
Const. type "D" inlet
Inst. 12" storm sew. pipe - 16'
5' depth
- ㉒ Sta. "F1" 479+54.26, 112.66' Lt.
Const. storm manhole 60" dia.
Inst. 12" storm sew. pipe - 136'
5' depth
- ㉓ Const. bio-retention pond, D00670 (SWM03)
Inst. facility field markers, type S1 - 2
Inst. facility field marker, type S2
Conc. pipe anchor
Aggregate base - 425 tons
6" gate valve
(For details, see shts. GJ-6 & GJ-6A)
- ㉔ Sta. "82D" 231+56.63, 60.5' Lt. to Sta. "82D" 233+49.63, 50.3' Lt.
Inst. 18" storm sew. pipe - 194'
10' depth
Connect to extg. manhole
(For profile, see sht. 4F-2)
- ㉕ Sta. "82D" 231+56.63, 60.5'
Const. storm manhole 60" dia.
Inst. 18" storm sew. pipe - 15'
5' depth
Const. sloped end
Const. paved end slope, Rt.
Const. riprap basin
(For detail, see sht. GJ-22)
(For profile, see sht. 4F-2)
(See drg. no. RD320)
- ㉖ Sta. "82D" 228+38.20, 57.3' Lt. to Sta. "82D" 231+14.08, 74.41' Lt.
Inst. 18" storm sew. pipe - 320'
10' depth
Const. sloped end
Const. riprap basin
(For detail, see sht. GJ-22)
(For profile, see sht. 4F-2)
- ㉗ Sta. "F1" 478+49.52, 35.94', Lt.
Const. type "G-2" inlet
Inst. 12" storm sew. pipe - 98'
5' depth


- ㉘ Sta. "F1" 479+46.43, 35.8' Lt.
Const. type "G-2" inlet
Inst. 12" storm sew. pipe - 158'
10' depth
Const. sloped end
Const. paved end slope, Rt.
Tunneling, boring & jacking
- ㉙ Const. water quality filter strip, D00682 (SWM01a)
Inst. facility field marker, type S1 - 2
Inst. facility field marker, type S2
(For details, see sht. GJ-4C)
- ㉚ Sta. "B" 470+56.04, 43.95' Lt.
Extend - 33', Lt. 5' depth
Const. sloped end
Const. paved end slope, Lt.
Const. riprap basin
(For details, see sht. GJ-22)
- ㉛ Sta. "G" 474+43.5, 48.25' Rt.
Adjust inlet
(See drg. no. RD376)
- ㉜ Preserve and protect telephone line
- ㉝ Preserve and protect water line
- ㉞ Preserve and protect gas line




OREGON DEPARTMENT OF TRANSPORTATION	
	CONSULTING ENGINEERS www.obec.com
CORPORATE OFFICE: 920 COUNTRY CLUB ROAD, SUITE 100B EUGENE, OREGON 97401-6089 REGIONAL OFFICES: LAKE OSWEGO; SALEM; MEDFORD, OREGON; VANCOUVER, WASHINGTON	
FFO - OR212/224: SUNRISE CORRIDOR (I-205 - SE 122ND AVE) SEC.	
CLACKAMAS HWY. CLACKAMAS COUNTY	
Design Team Leader - Tom Metcalf Designed By - Ben Wewarka/Amy Jones Drafted By - Serban Dinca/Brittney Zornado	
DRAINAGE & UTILITIES NOTES	SHEET NO. 3E

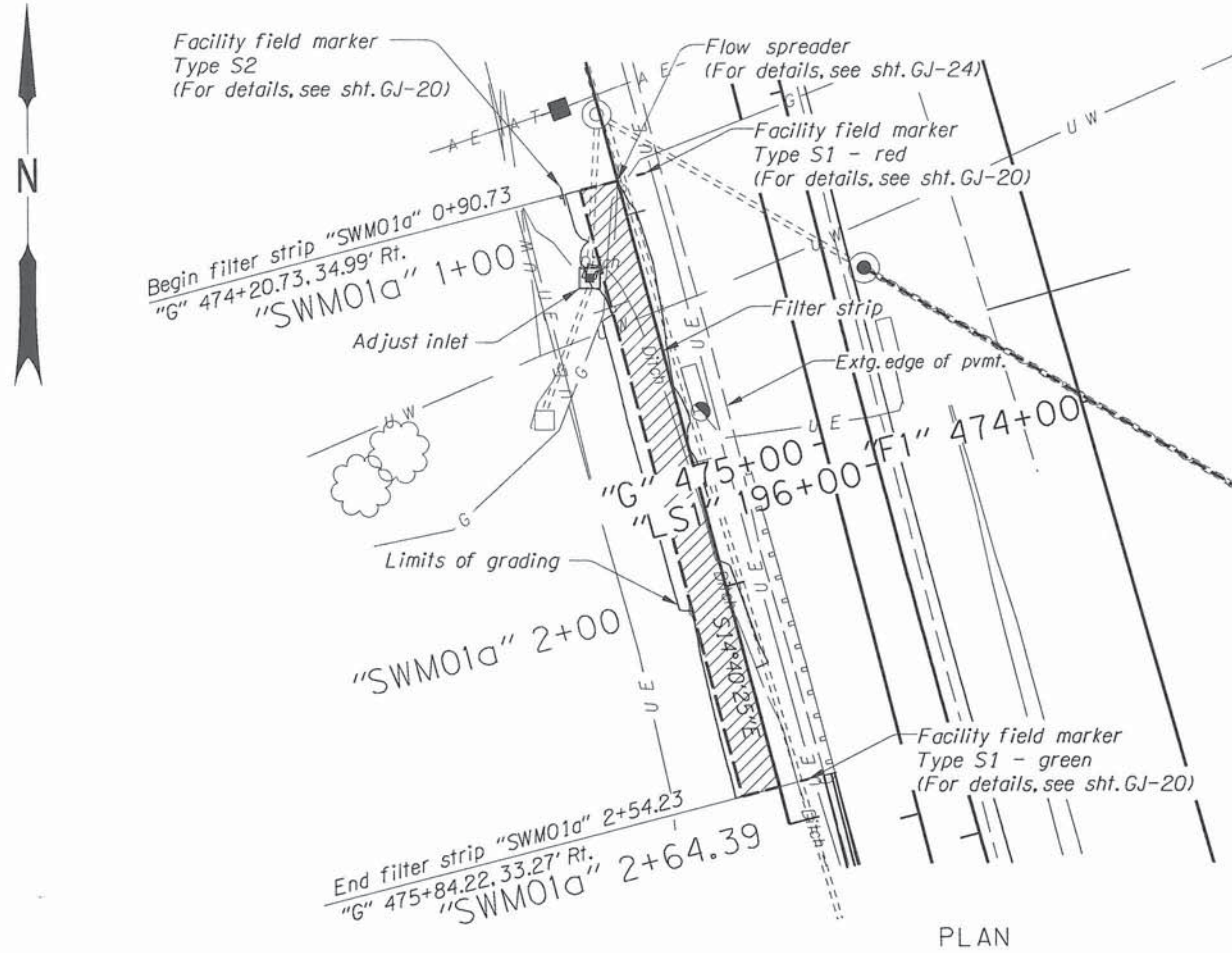

"SWM01a" WATER QUALITY FILTER STRIP PLAN
DFI-D00682

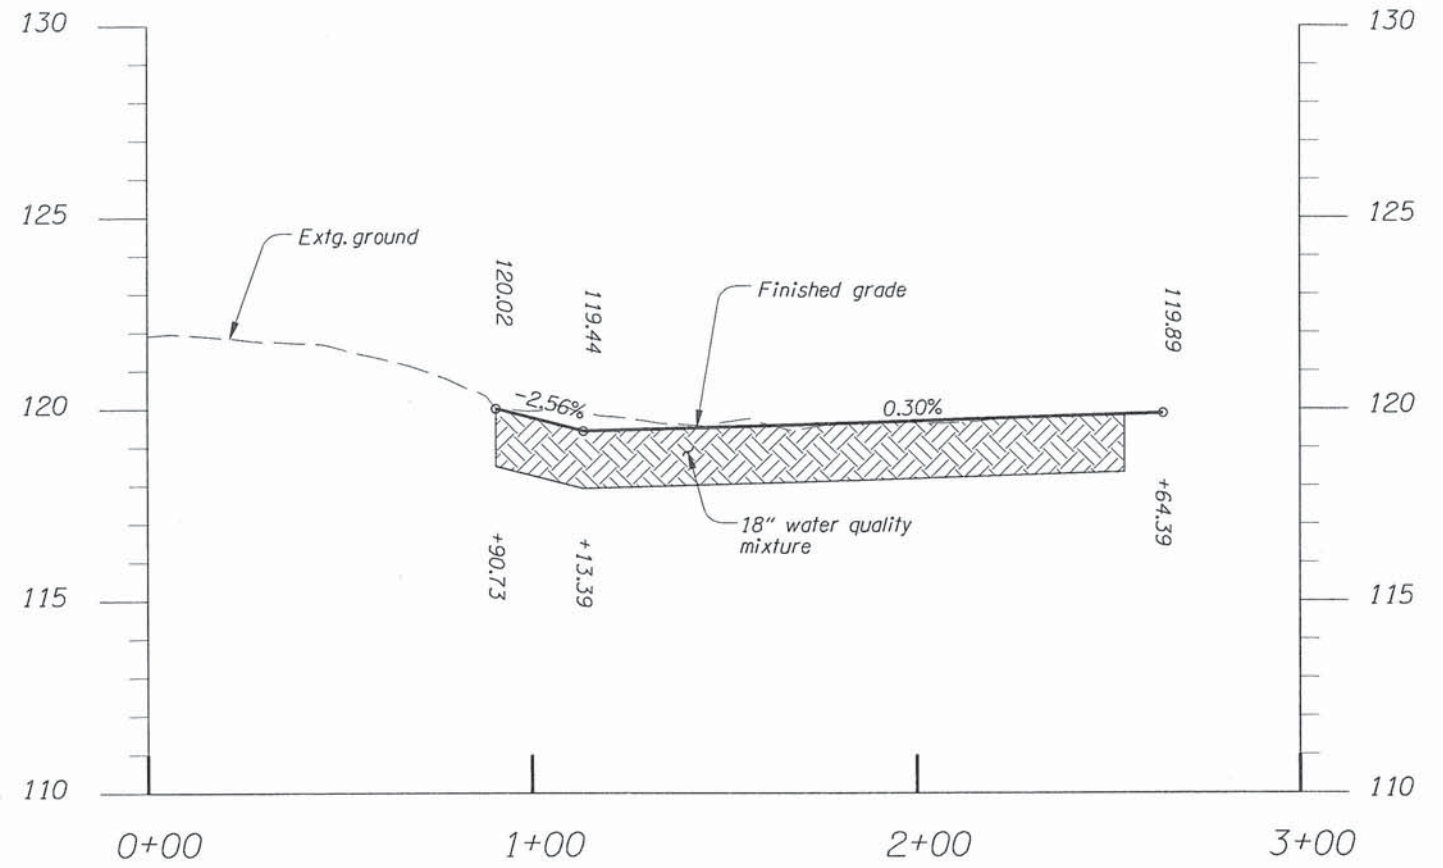

PROFILE

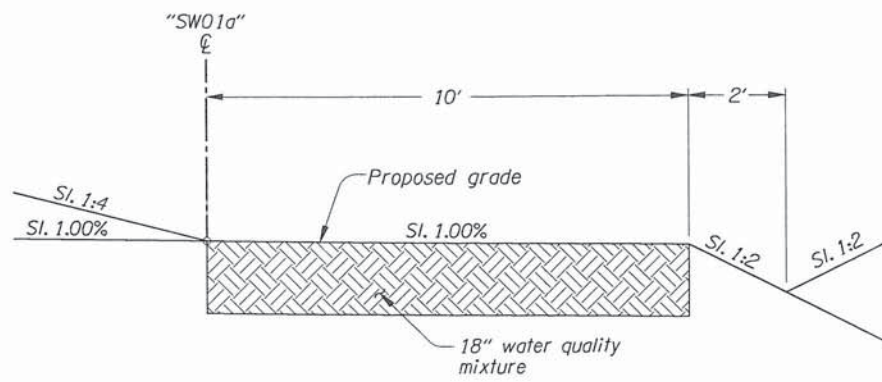

STA. "SWM01a" 0+90.77 To "SWM01a" 2+54.20

"SWM01a" WATER QUALITY FILTER STRIP TYPICAL SECTION
DFI-D00682



CONSULTING ENGINEERS www.obec.com <small>CORPORATE OFFICE: 920 COUNTRY CLUB ROAD, SUITE 100B EUGENE, OREGON 97401-6089 REGIONAL OFFICES: LAKE OSWEGO; SALEM; MEDFORD, OREGON; VANCOUVER, WASHINGTON</small>	
FFO - OR212/224: SUNRISE CORRIDOR (I-205 - SE 122ND AVE) SEC. CLACKAMAS HWY. CLACKAMAS COUNTY	
Design Team Leader - Tom Metcalf Designed By - Ben Wewerka/Amy Jones Drafted By - Serban Dinca/Brittney Zornado	
STORMWATER DETAILS	SHEET NO. GJ-4C