

## 1. Identification

Drainage Facility ID (DFI): D00729

Facility Name: **Cascade Ave. Drywells**

Project Name: US20: Cascade Improvements (Sisters) Sec.

Facility Type: UIC (Drywells)

Drawings: Plan view, see attached

Location: District 10; Highway 15; M.P. 92.24, LT

## 2. Designer

**Wade Coatney, PE, ODOT Region 4 Associate Engineer (541) 388-6234**

## 3. Construction

Construction is to be completed in the year 2013.  
The contractor is yet to be decided.

## 4. Storm Drain System and Facility Overview

The facility system consists of 12 drywells, each of which contains inlets (with a downturned elbow), sedimentation manholes and gate valves. The drywells are two standard sizes (8 feet deep and 12 feet deep) that are sized dependent on the drainage area. Runoff is directed to each of the drywells via a curb, inlet and piping system. The drainage area for each drywell varies from 7,000 sqft (0.16 acres) to 13,775 sqft (0.32 acres), with a total impervious surface area close to 2.6 acres. There is no natural outfall for this area, so all runoff is infiltrated on site.

The system collects runoff from 200 feet west of Pine Street to the west side of Larch Street.

### A. Maintenance equipment access:

Maintenance access to the facility is obtained from Cascade Avenue, US20 the McKenzie Highway.

### B. Special features:

Sedimentation manholes and inlets with a downturned elbow are required by DEQ as pretreatment for each drywell. Gate valves are required to be installed for the possibility that there is a hazardous material spill. This will allow the hazardous material to be kept from entering the drywell.

## **5. Haz Mat Spill Operation**

The drywells are not intended to collect hazardous material. The 12 inch gate valves will be installed to allow incident responders to cut the flow to the drywells. Once the flow has been stopped to the drywell and all material has been removed from the roadway, remove all remaining hazardous material from all inlets, manholes, and drywells. Refer to section 8 of this document for handling of hazardous materials. If hazardous material has reached a drywell, testing of surrounding soils may be required. Contact the ODOT Region 4 Hazmat Coordinator for testing requirements.

## **6. Overflow System**

There is no easily accessible outfall location for this project, which makes this an isolated system with no designed overflow system. The slope of the road does allow the potential for some drywells to bypass flow downstream to the next drywell. However, there are multiple mainline sags that do not allow for flow to be bypassed outside of the project limits.

## **7. Maintenance Requirements**

Routine maintenance and inspections will be required for all inlets, sedimentation manholes, and drywells. The ODOT Maintenance Guide incorporates routine maintenance activities and should be referenced for equipment use and general stormwater maintenance requirements. The ODOT Maintenance Guide can be viewed at the following website:

<http://www.oregon.gov/ODOT/HWY/OOM/MGuide.shtml>

Special maintenance requirements are noted below.

### **Schedule**

#### First 2 years

- Inspect all inlets, manholes, and drywells after each 24hr. rainfall > 0.50 inches.
- Inspect at a minimum 2 times per year.
- Remove sediment if required.

#### General Requirements

- Inspect all inlets, manholes, and drywells on a semi-annual basis.
- At a minimum remove sediment from all inlets, manholes, and drywells by-annually.
- Remove sediment from all inlets, manholes, and drywells when the sediment depth reaches 12 inches.

## **8. Waste Material Handling**

Material cleaned from the facility is defined as waste by DEQ. This means the material must be disposed at a permitted waste management facility (landfill, incinerator, etc.) or managed, reused, or recycled according to DEQ waste rules.

Management of road waste and the rules that surround it are extremely complicated. Refer to the road waste section of the ODOT Maintenance Yard Environmental Management System (EMS) Policy and Procedures Manual for disposal options:

<http://egov.oregon.gov/ODOT/HWY/OOM/EMS.shtml>

Contact any of the following for more detailed information about management of waste materials found on site:

ODOT Clean Water Unit	(503) 986-3008
ODOT Statewide Hazmat Coordinator	(503) 229-5129
ODOT Region 4 Hazmat Coordinator	(541) 388-6088
ODEQ Region Office	(541) 388-6146

# APPENDIX A

(Plan View)

INDEX OF SHEETS	
SHEET NO.	DESCRIPTION
1	Title Sheet
1A	Index Of Sheets Cont'd.
1A-2	Std. Drg. Nos.


STATE OF OREGON  
DEPARTMENT OF TRANSPORTATION

PLANS FOR PROPOSED PROJECT  
GRADING, DRAINAGE, PAVING, SIGNING & ROADSIDE DEVELOPMENT

**FFO-US20: CASCADE IMPROVEMENTS  
(SISTERS) SEC.**

**McKENZIE HWY. & SANTIAM HWY.  
DESCHUTES COUNTY  
MAY 2013**

T. 15 S., R. 10 E., W.M.

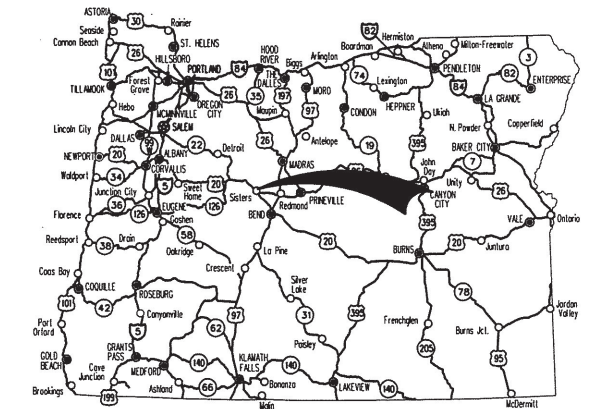

Overall Length Of Project - 1.41 Miles

**ATTENTION:**  
Oregon Law Requires You To Follow Rules Adopted By The Oregon Utility Notification Center. Those Rules Are Set Forth In OAR 952-001-0010 Through OAR 952-001-0090. You May Obtain Copies Of The Rules By Calling The Center. (Note: The Telephone Number For The Oregon Utility Center Is (503) 232-1987.)



**BEGINNING OF PROJECT  
PLH-TEA-S015(030)  
STA. "B" 19+85**


**END OF PROJECT  
PLH-TEA-S015(030)  
STA. "B" 46+69.68**

**END OF PROJECT  
PLH-TEA-S015(030)  
STA. "b" 3+18.00 (M.P. 92.22)**

**EQUA. STA "b" 0+00.00 P.O.T. Ah. =  
STA "a" 933+67.32 P.O.T. Bk.**

**EQUA. STA "a" 903+75.60 P.T. Ah. =  
STA 904+12.91 P.T. Bk.**

**BEGINNING OF PROJECT  
PLH-TEA-S015(030)  
STA. 889+53.00 (M.P. 0.08)**

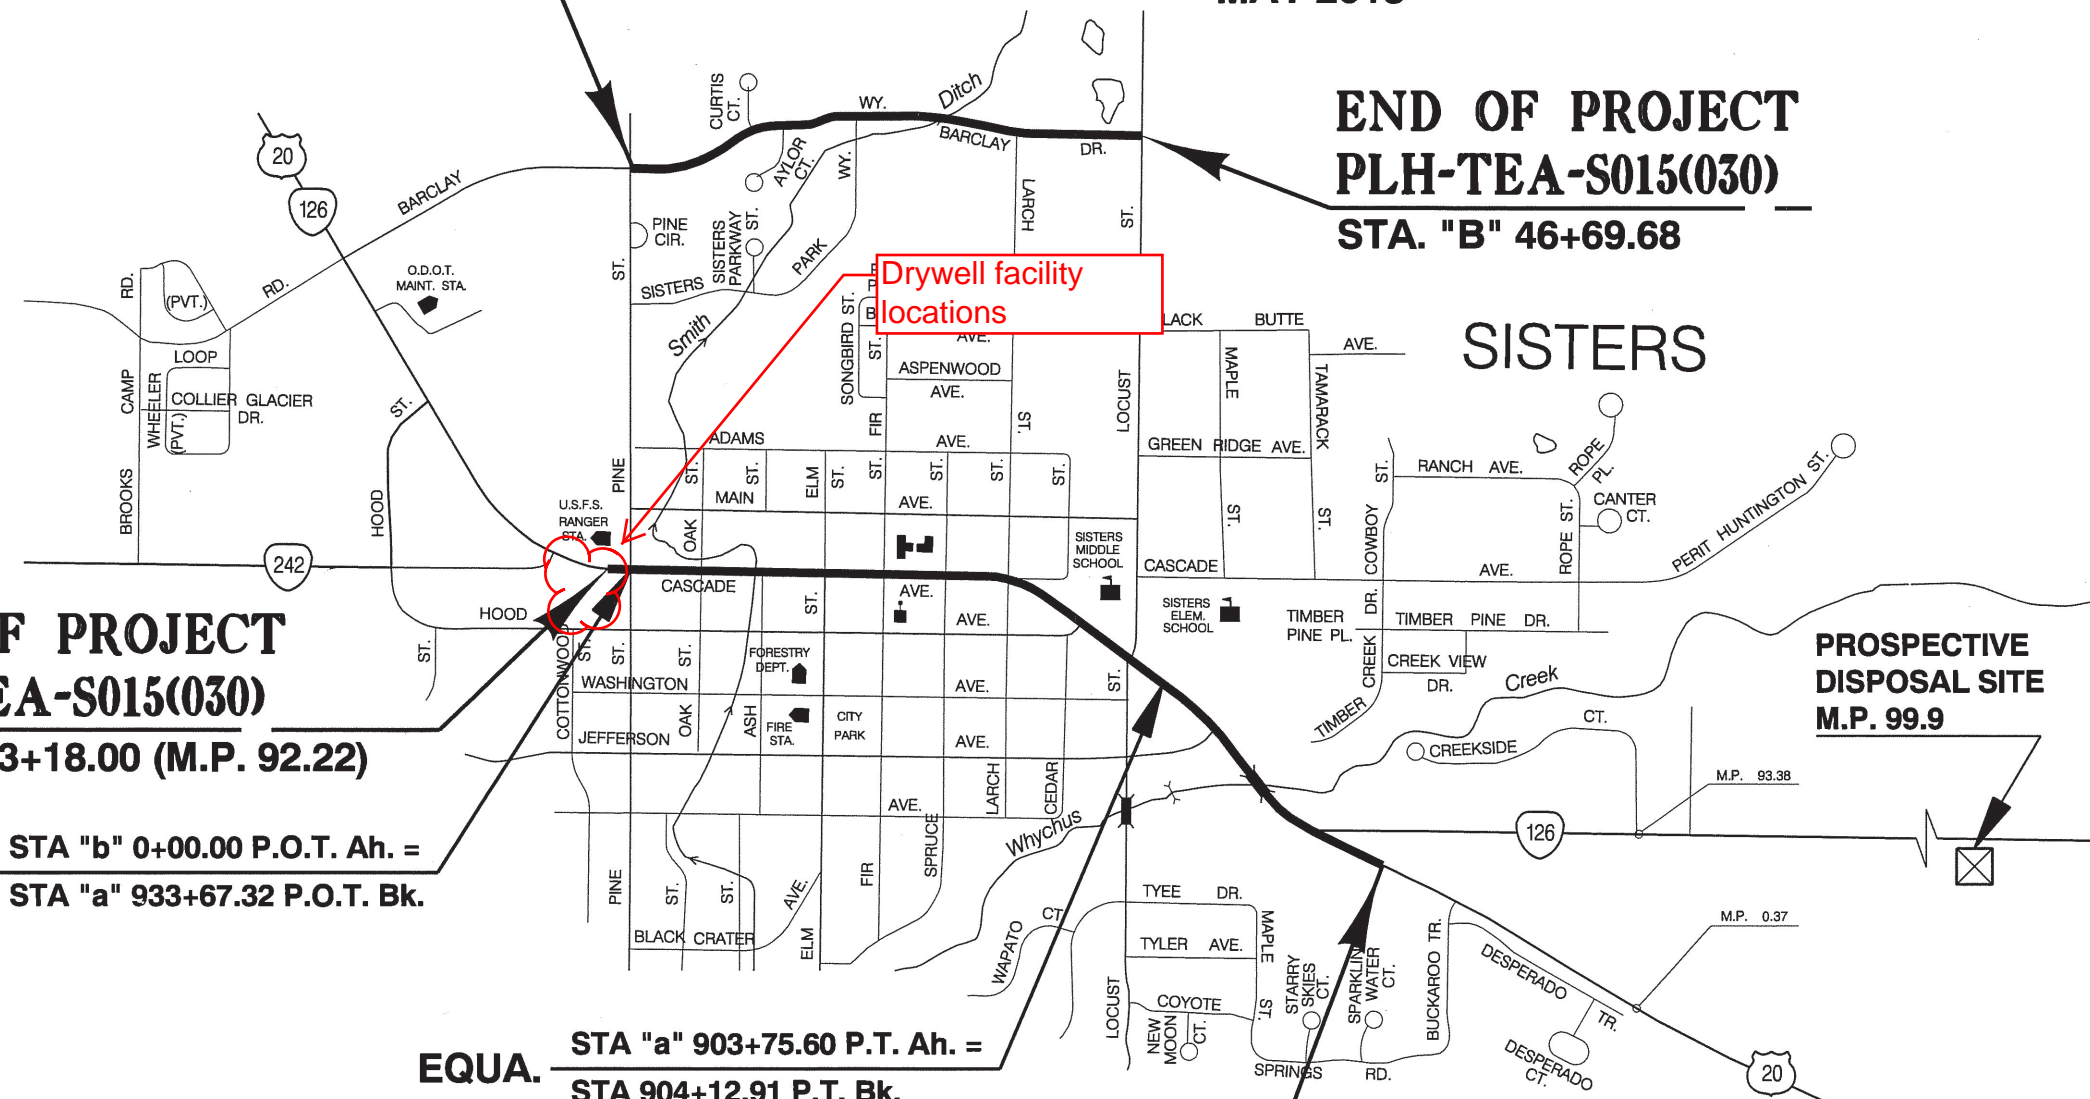

**PROSPECTIVE  
DISPOSAL SITE  
M.P. 99.9**

**OREGON TRANSPORTATION COMMISSION**

- Pat Egan CHAIR
- David Lohman COMMISSIONER
- Mary F. Olson COMMISSIONER
- Mark Frohnmayer COMMISSIONER
- Tammy Baney COMMISSIONER
- Matthew L. Garrett DIRECTOR OF TRANSPORTATION

These plans were developed using ODOT design standards. Exceptions to these standards, if any, have been submitted and approved by the ODOT Chief Engineer or their delegated authority.

Approving Authority: *Jon W. Heacock* 3/16/2013  
Signature & date

Jon Heacock, Region 4 TCM

Print name and title

*[Signature]*  
Concurrence by ODOT Chief Engineer

**FFO-US20: CASCADE IMPROVEMENTS  
(SISTERS) SEC.**


McKENZIE HWY. & SANTIAM HWY.  
DESCHUTES COUNTY

FEDERAL HIGHWAY ADMINISTRATION	PROJECT NUMBER	SHEET NO.
OREGON DIVISION	PLH-TEA-S015(030)	1




PE001724

PLAN SHEET LAYOUT  
Sec. 4, 5, 8, & 9, T. 15 S., R. 10 E., W.M.

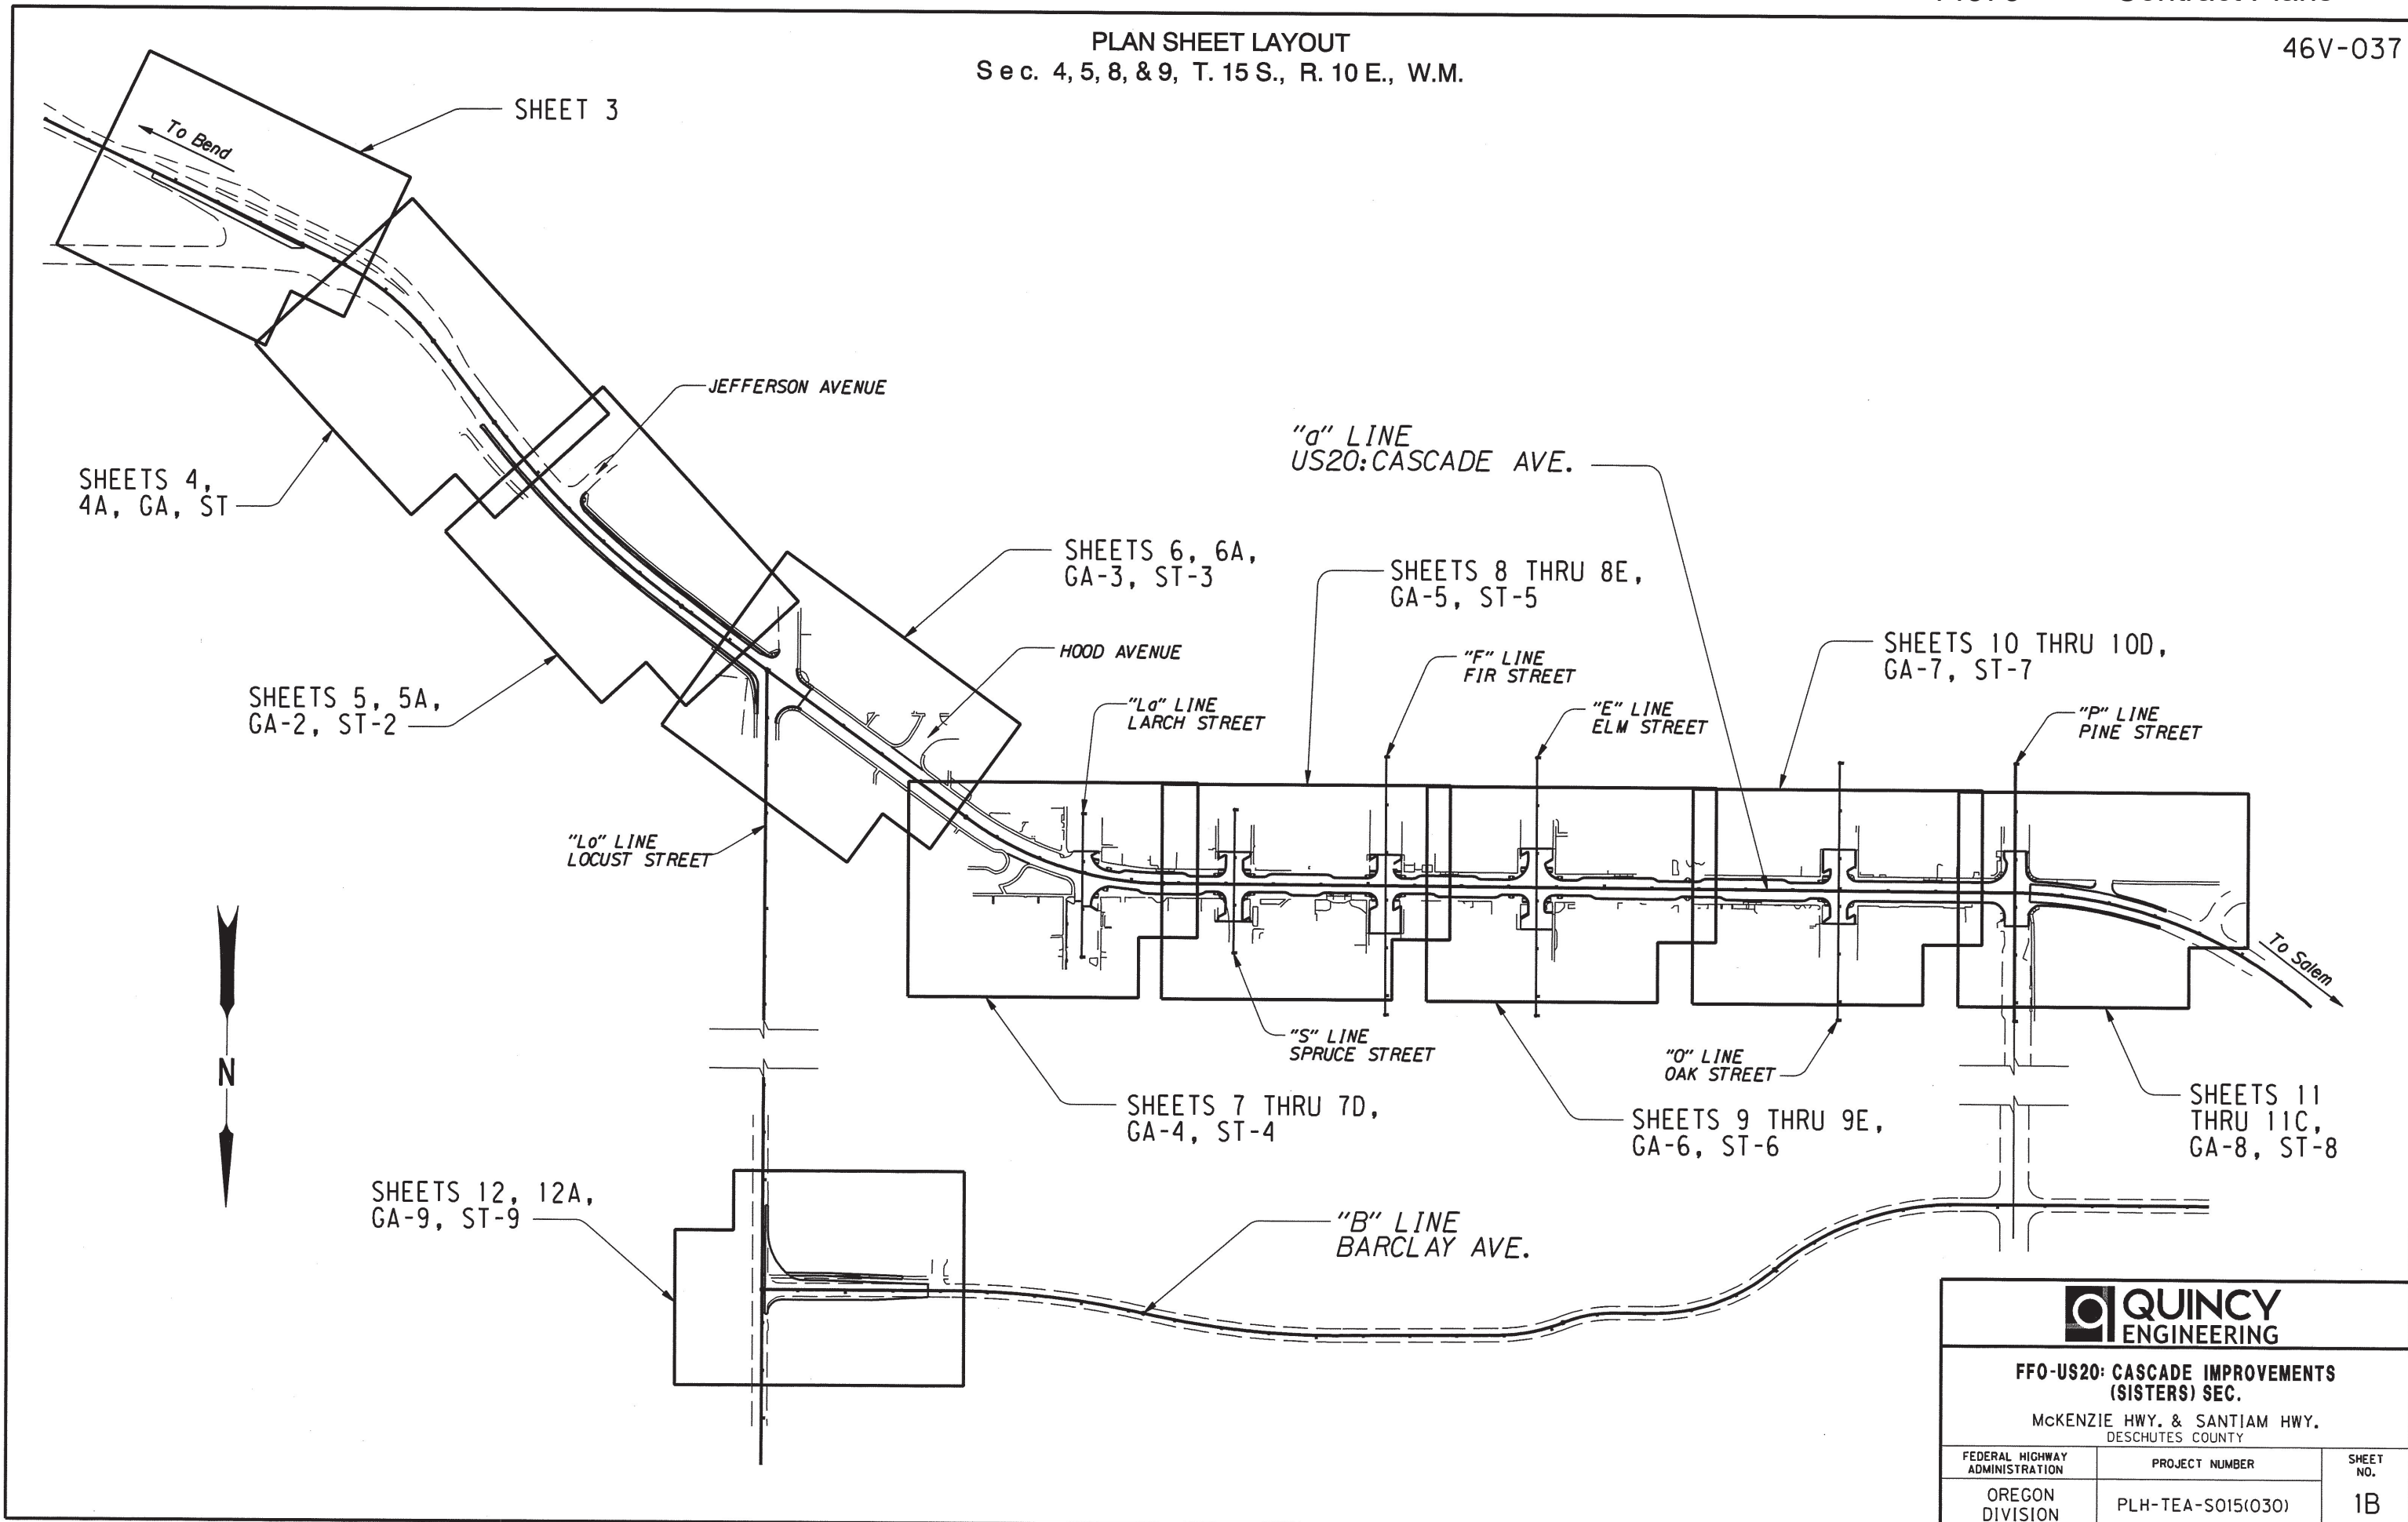


<b>QUINCY ENGINEERING</b>		
<b>FFO-US20: CASCADE IMPROVEMENTS (SISTERS) SEC.</b>		
MCKENZIE HWY. & SANTIAM HWY. DESCHUTES COUNTY		
FEDERAL HIGHWAY ADMINISTRATION	PROJECT NUMBER	SHEET NO.
OREGON DIVISION	PLH-TEA-S015(030)	1B

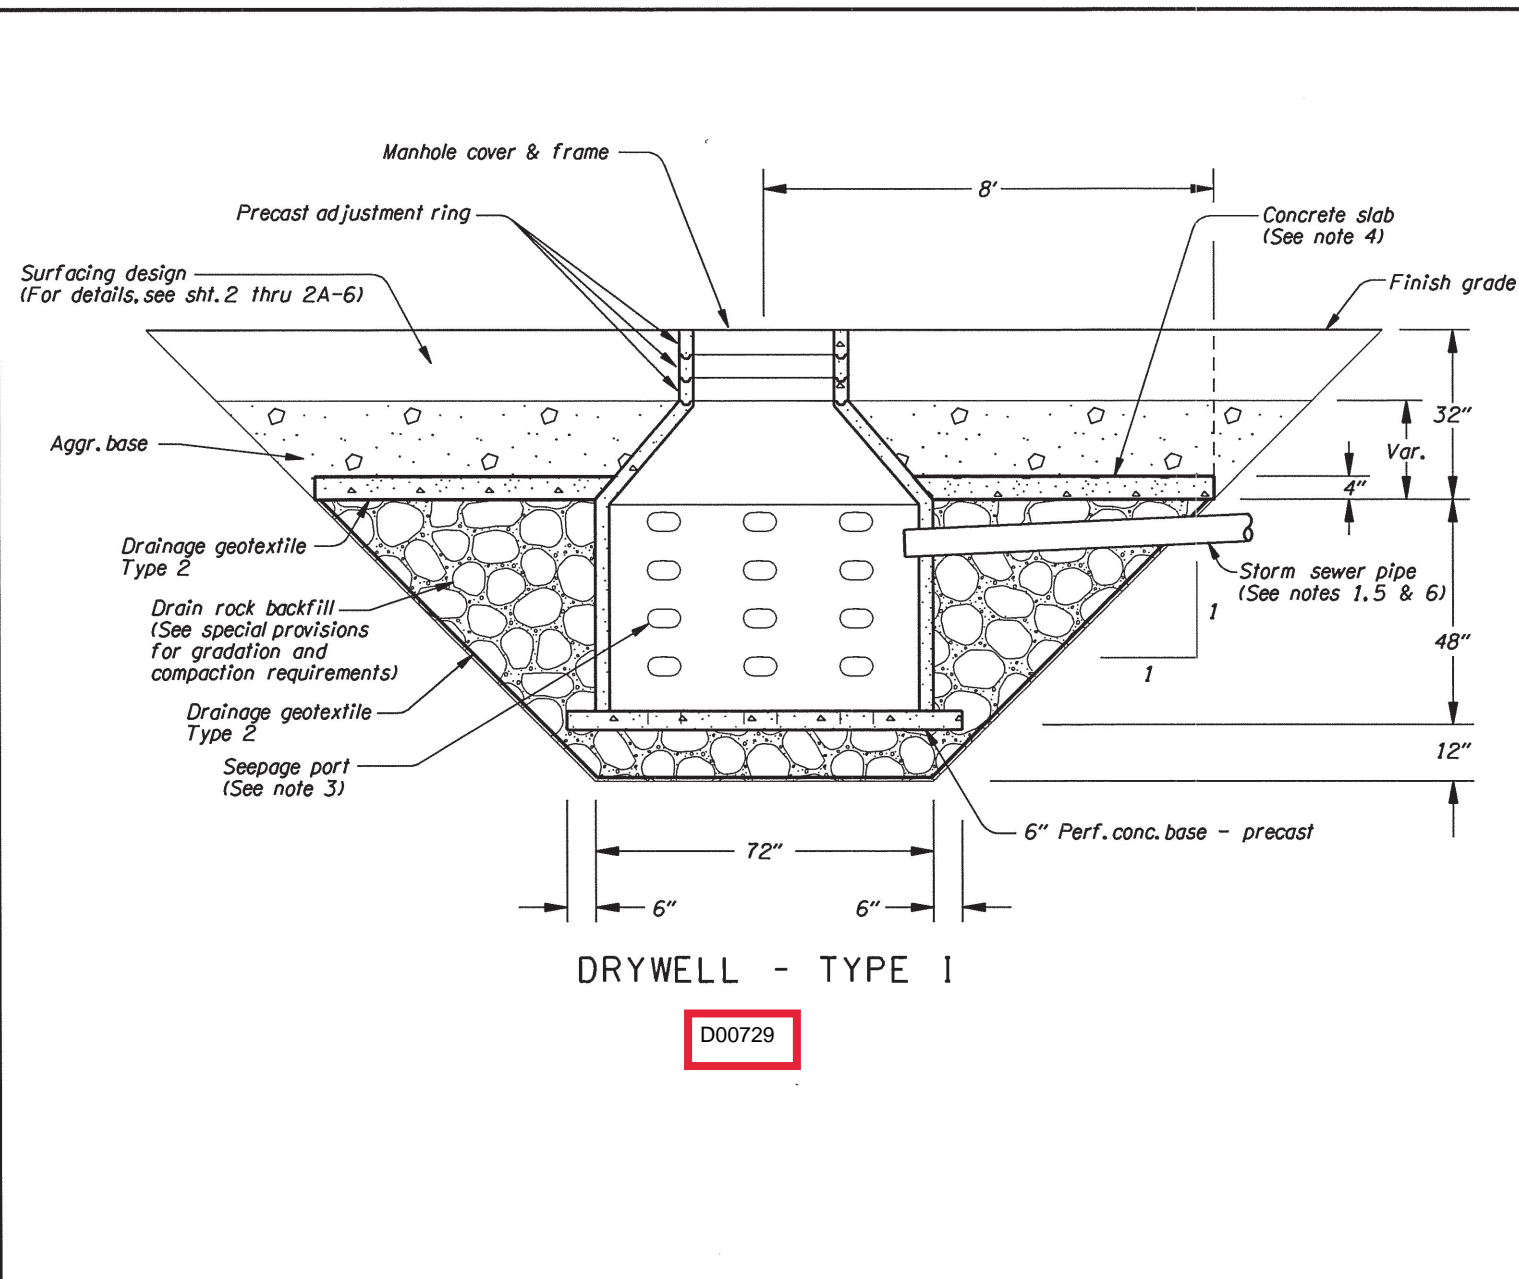


DRYWELL - TYPE I

D00729

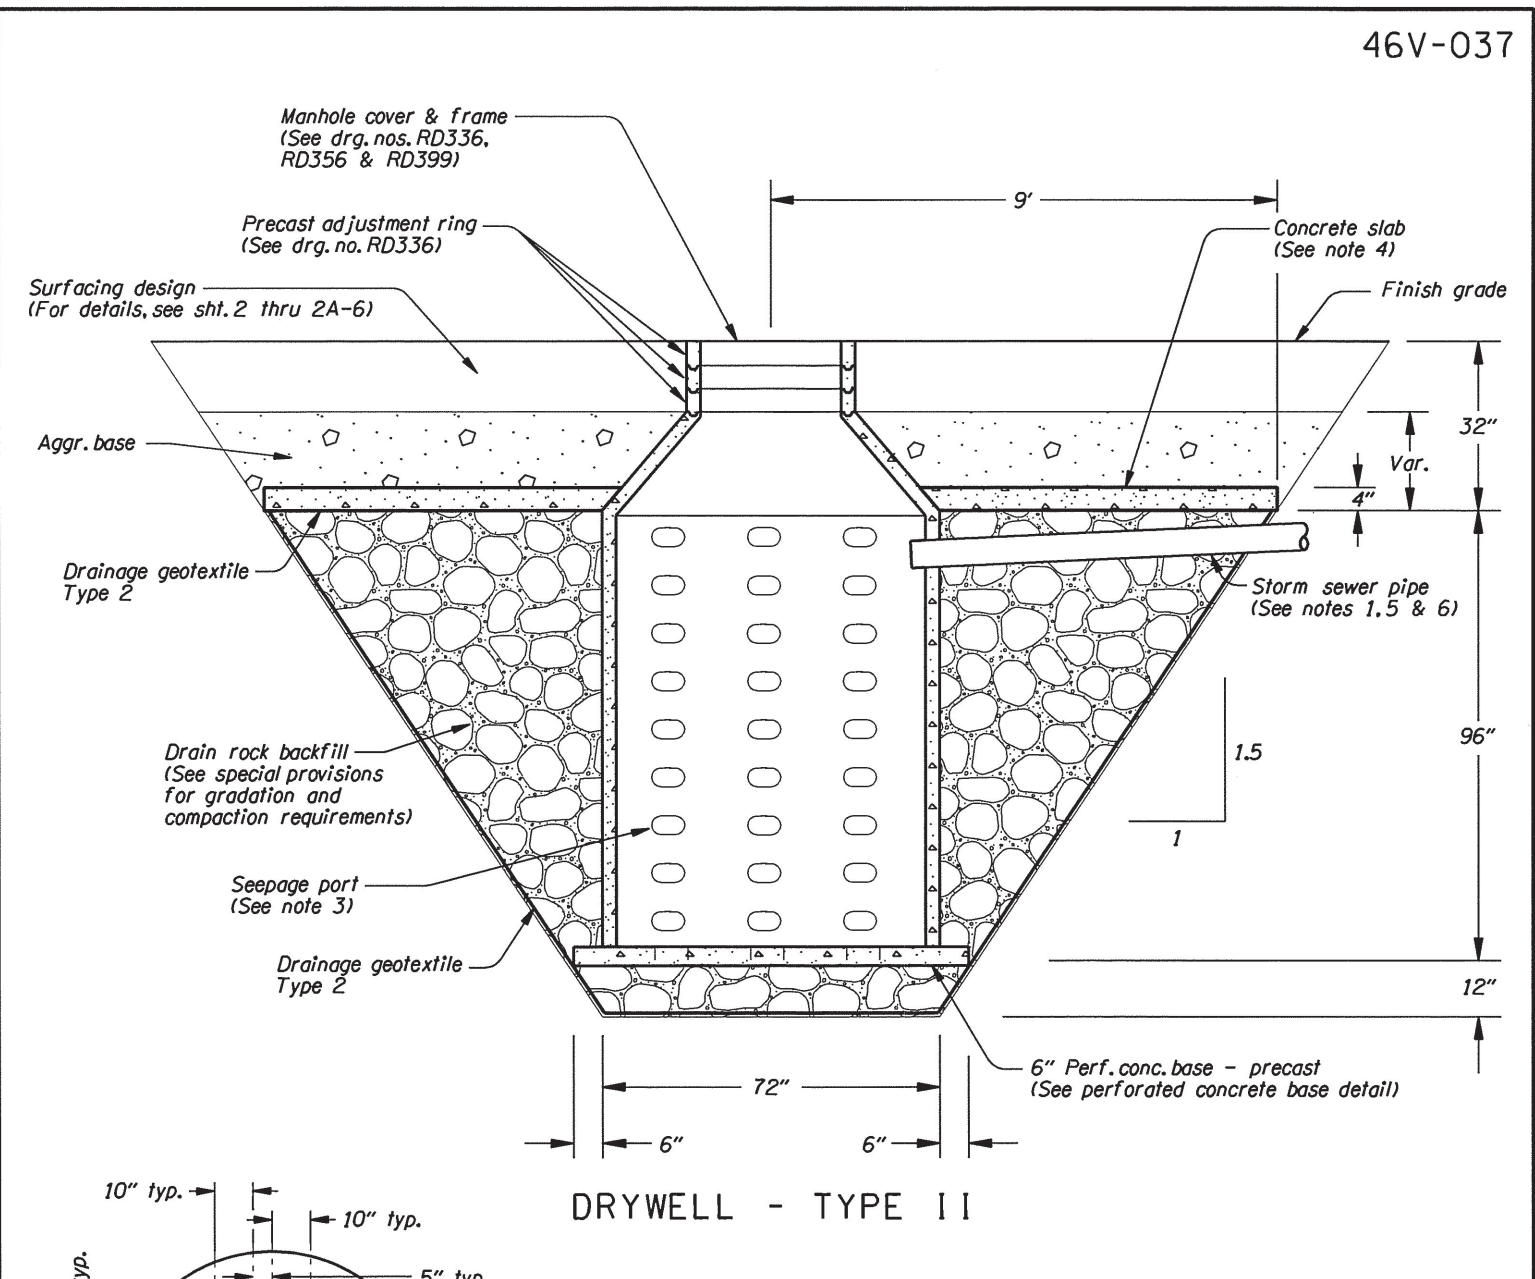


DRYWELL - TYPE II

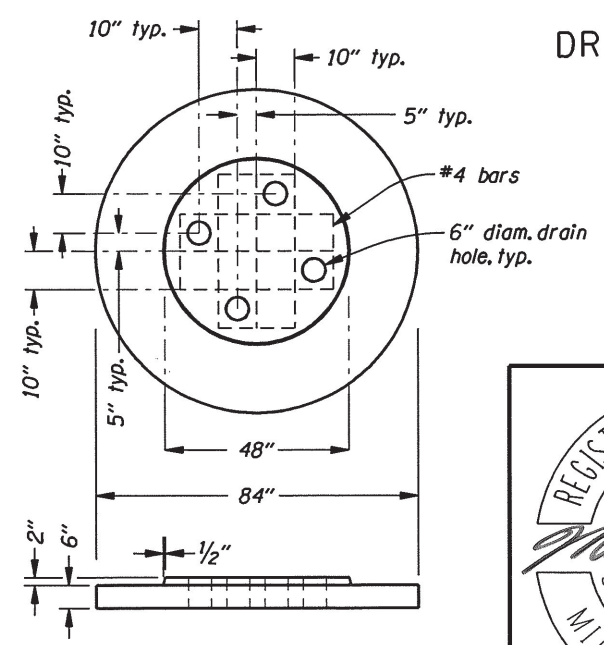


PERFORATED CONCRETE BASE


- GENERAL NOTES FOR ALL DETAILS:
1. For storm sewer pipe materials, sizes, slopes & locations, see plan sheets and pipe data sheets.
  2. All precast sections shall conform to requirements of ASTM C478.
  3. Seepage port size and location vary by manufacturer.
  4. Construct precast or cast-in-place concrete slab.
  5. Connect inlet pipe to structure using precast hole or core drilled hole.
  6. All connecting pipes shall have a tracer wire, or approved alternate.

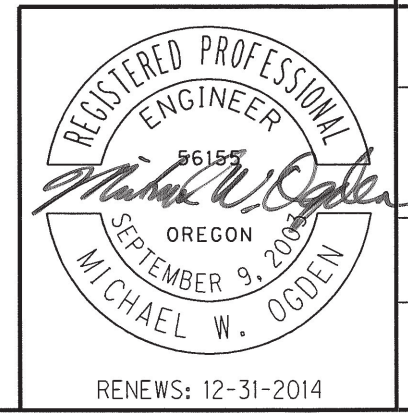


<b>OREGON DEPARTMENT OF TRANSPORTATION</b>	
<b>REGION 4 TECHNICAL CENTER</b>	
<b>FFO-US20: CASCADE IMPROVEMENTS (SISTERS) SEC.</b> McKENZIE HWY. & SANTIAM HWY. DESCHUTES COUNTY	
Reviewed By - Michael W. Ogden Designed By - Wade J. Coatsney Drafted By - Greg Saubier	
<b>DRAINAGE DETAILS</b>	SHEET NO. <b>2C</b>

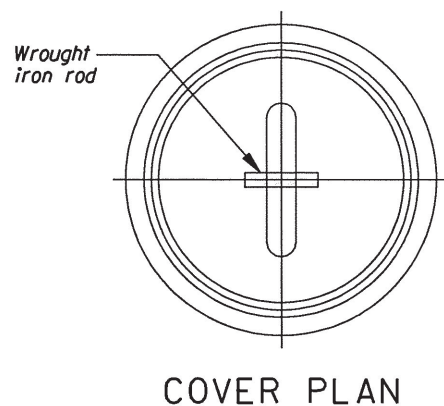


COVER PLAN

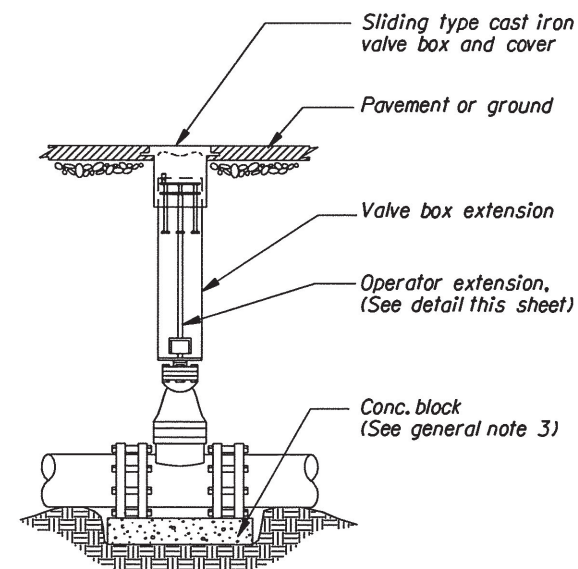


VALVE BOX ASSEMBLY DETAIL

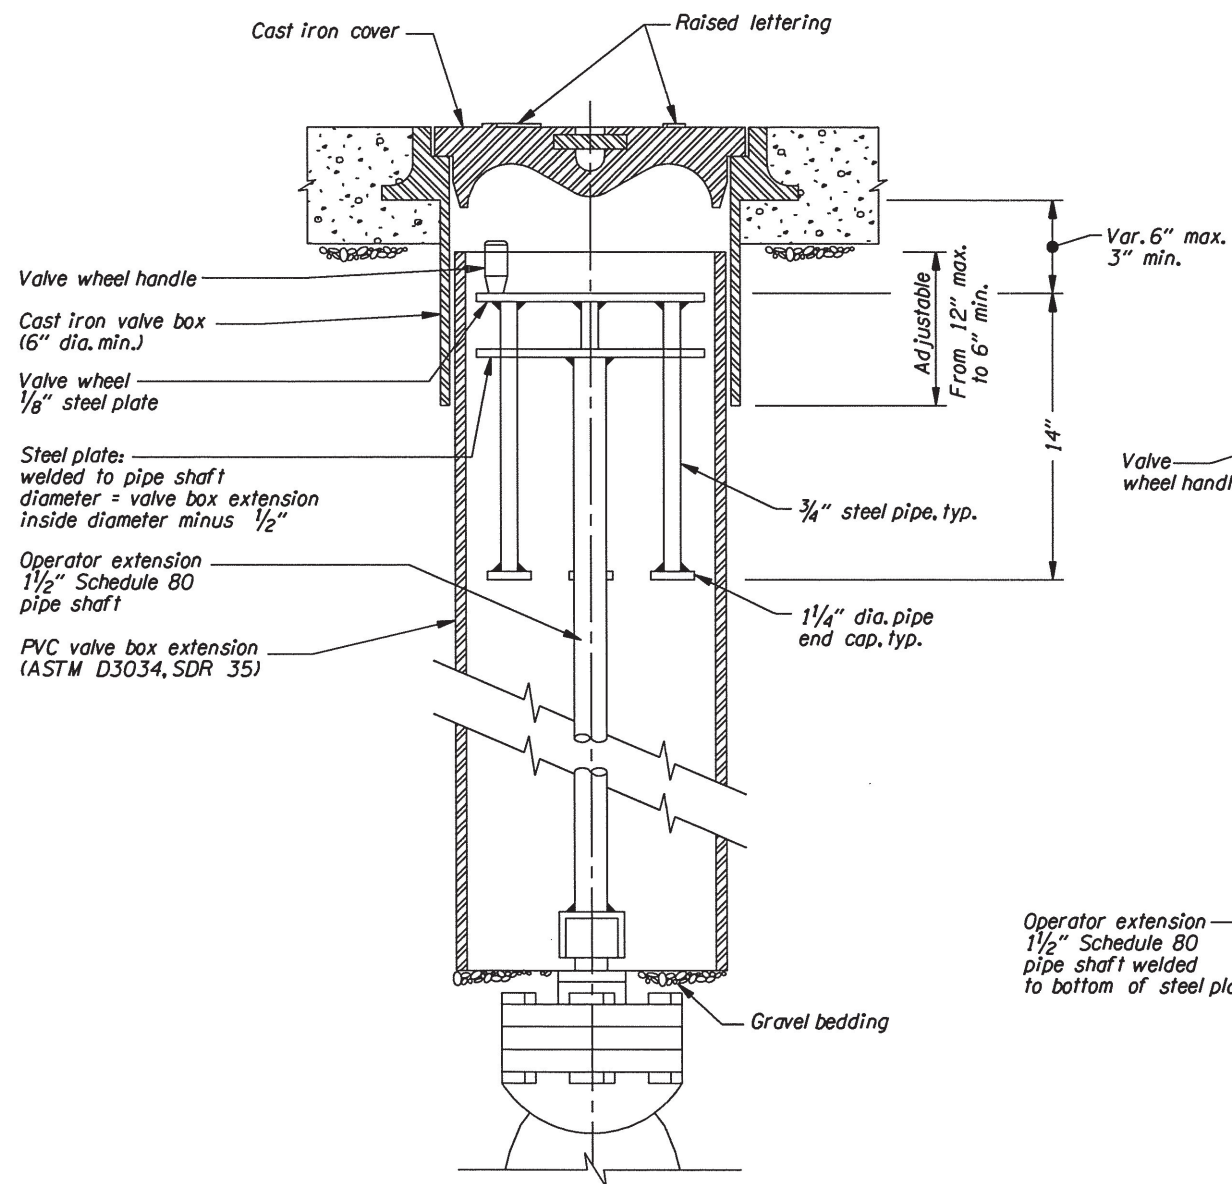

VALVE BOX EXTENSION SECTION

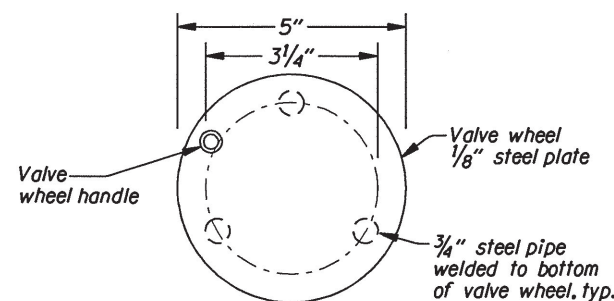


VALVE WHEEL

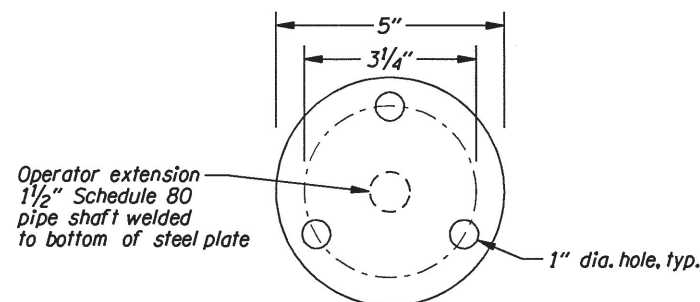

STEEL PLATE

GENERAL NOTES FOR ALL DETAILS:


1. Valve box not to rest on operating assembly.
2. Center valve box on axis operator extension.
3. Valves shall be installed on precast concrete block.
4. Welds shall be minimum 1/4" all around.
5. Hot-dip galvanize operator extension after fabrication.

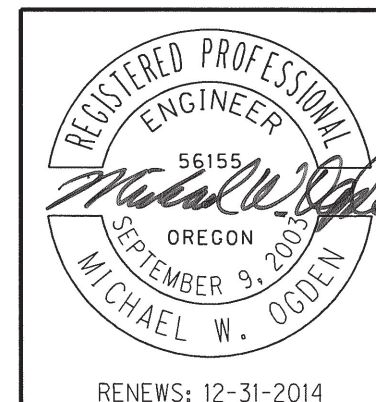


<b>OREGON DEPARTMENT OF TRANSPORTATION</b>	
<b>REGION 4 TECHNICAL CENTER</b>	
FFO-US20: CASCADE IMPROVEMENTS (SISTERS) SEC. MCKENZIE HWY. & SANTIAM HWY. DESCHUTES COUNTY	
Reviewed By - Michael W. Ogden Designed By - Wade J. Coatney Drafted By - Greg Saurbier	
<b>DRAINAGE DETAILS</b>	SHEET NO. <b>2C-3</b>




(For details not shown, see drg. nos. RD340 & RD346)

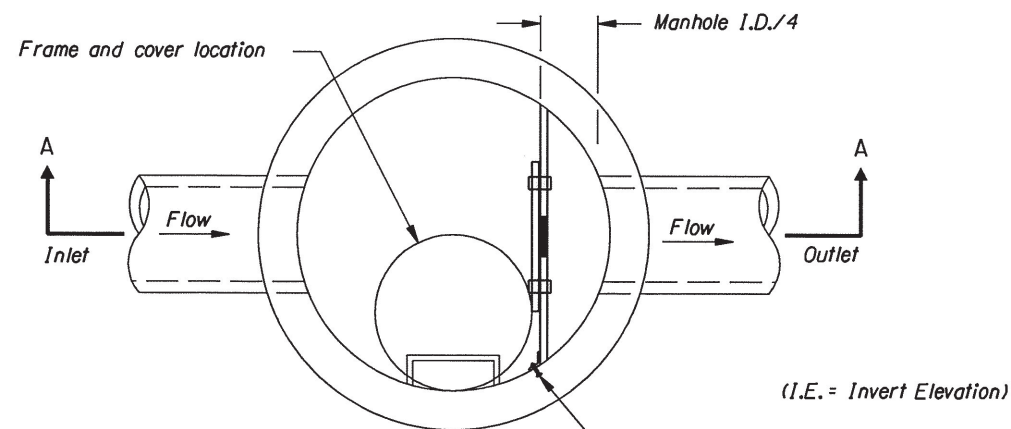


PLAN

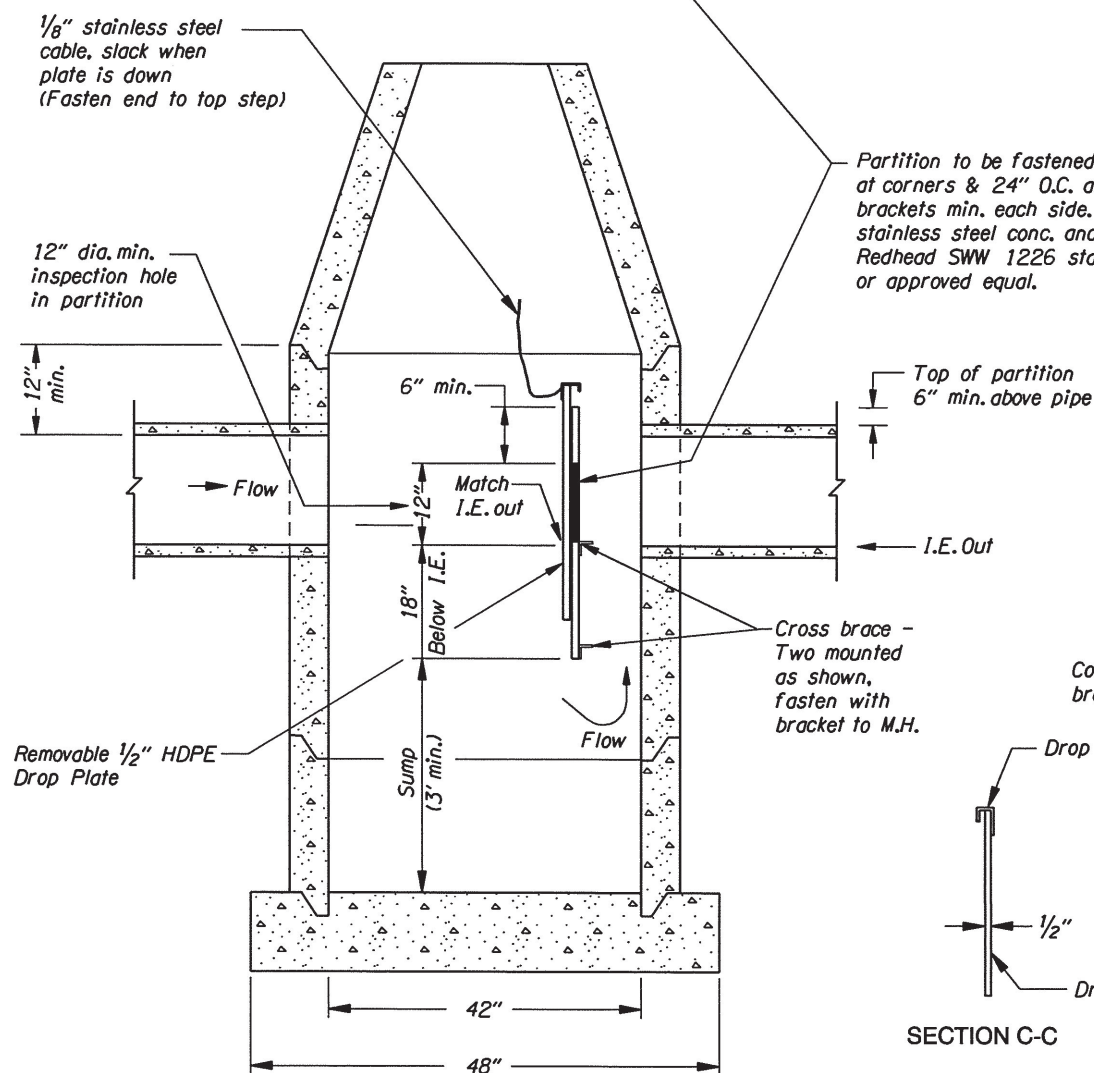

SECTION A-A

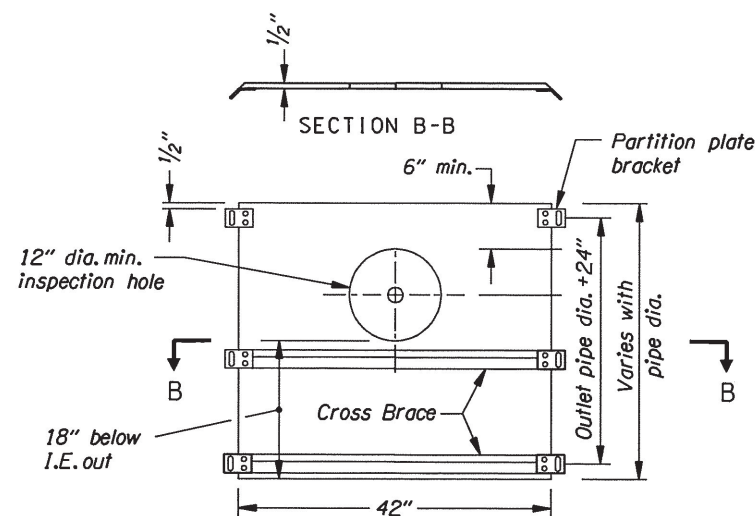

PARTITION PLATE

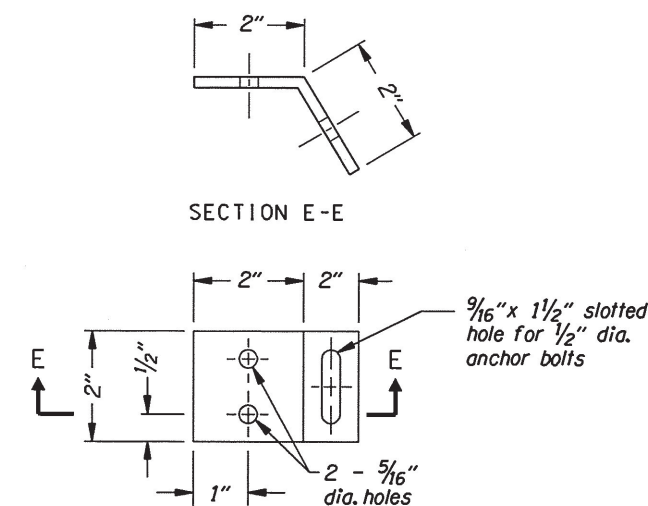


PARTITION PLATE BRACKET

Partition to be fastened to manhole wall at corners & 24" O.C. along sides. 3 brackets min. each side. With 1/2" dia. stainless steel conc. anchor bolts. - Redhead SWW 1226 stainless - 316 or approved equal.

GENERAL NOTES FOR ALL DETAILS:


1. Hardware, fasteners and anchors to be stainless steel; use 1/8" stainless steel cable.
2. See pipe data sheet and plan sheets for pipe size(s).
3. Removable drop plate and partition to be constructed of High Density Polyethelene (HDPE), 1/2" thick ASTM D1248-78 and installed prior to manhole cone or top.
4. Manhole and base per manhole standard drawings.
5. Cross brace L 2 1/2" x 1 1/2" x 3/16" hot-dip galvanize, ASTM A-123. Two per partition plate - Full width. Fasten to partition with stainless bolt, nut & washer at 18" ctrs. Fasten to M.H. at ends using partition plate brackets.
6. Hardware, fasteners, anchors, fittings, appurtenances, labor and equipment is incidental to sedimentation manhole item.

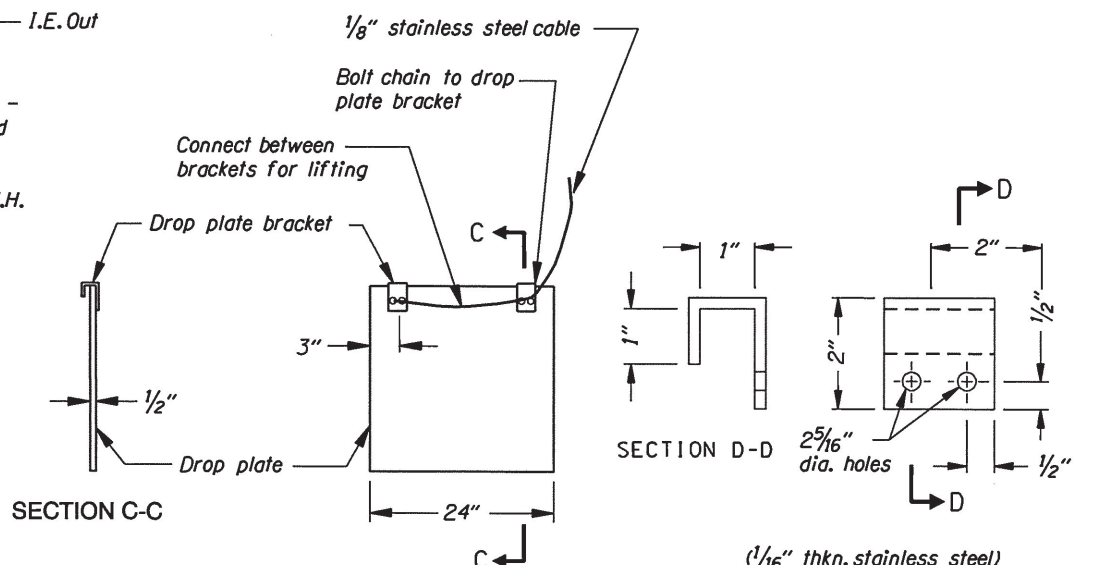

DROP PLATE

DROP PLATE BRACKET

SEDIMENTATION MANHOLE

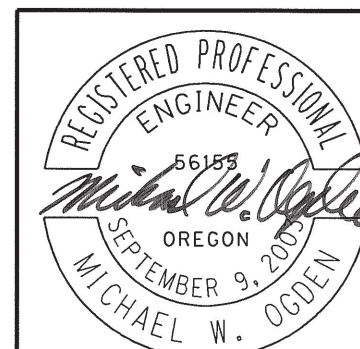


RENEWS: 12-31-2014

<b>OREGON DEPARTMENT OF TRANSPORTATION</b>	
<b>REGION 4 TECHNICAL CENTER</b>	
FFO-US20: CASCADE IMPROVEMENTS (SISTERS) SEC. MCKENZIE HWY. & SANTIAM HWY. DESCHUTES COUNTY	
Reviewed By - Michael W. Ogden Designed By - Wade J. Coatney Drafted By - Greg Saurbier	
<b>DRAINAGE DETAILS</b>	SHEET NO. <b>2C-4</b>

Sec. 4, 5, 8, & 9, T. 15 S., R. 10 E., W.M.

SISTERS

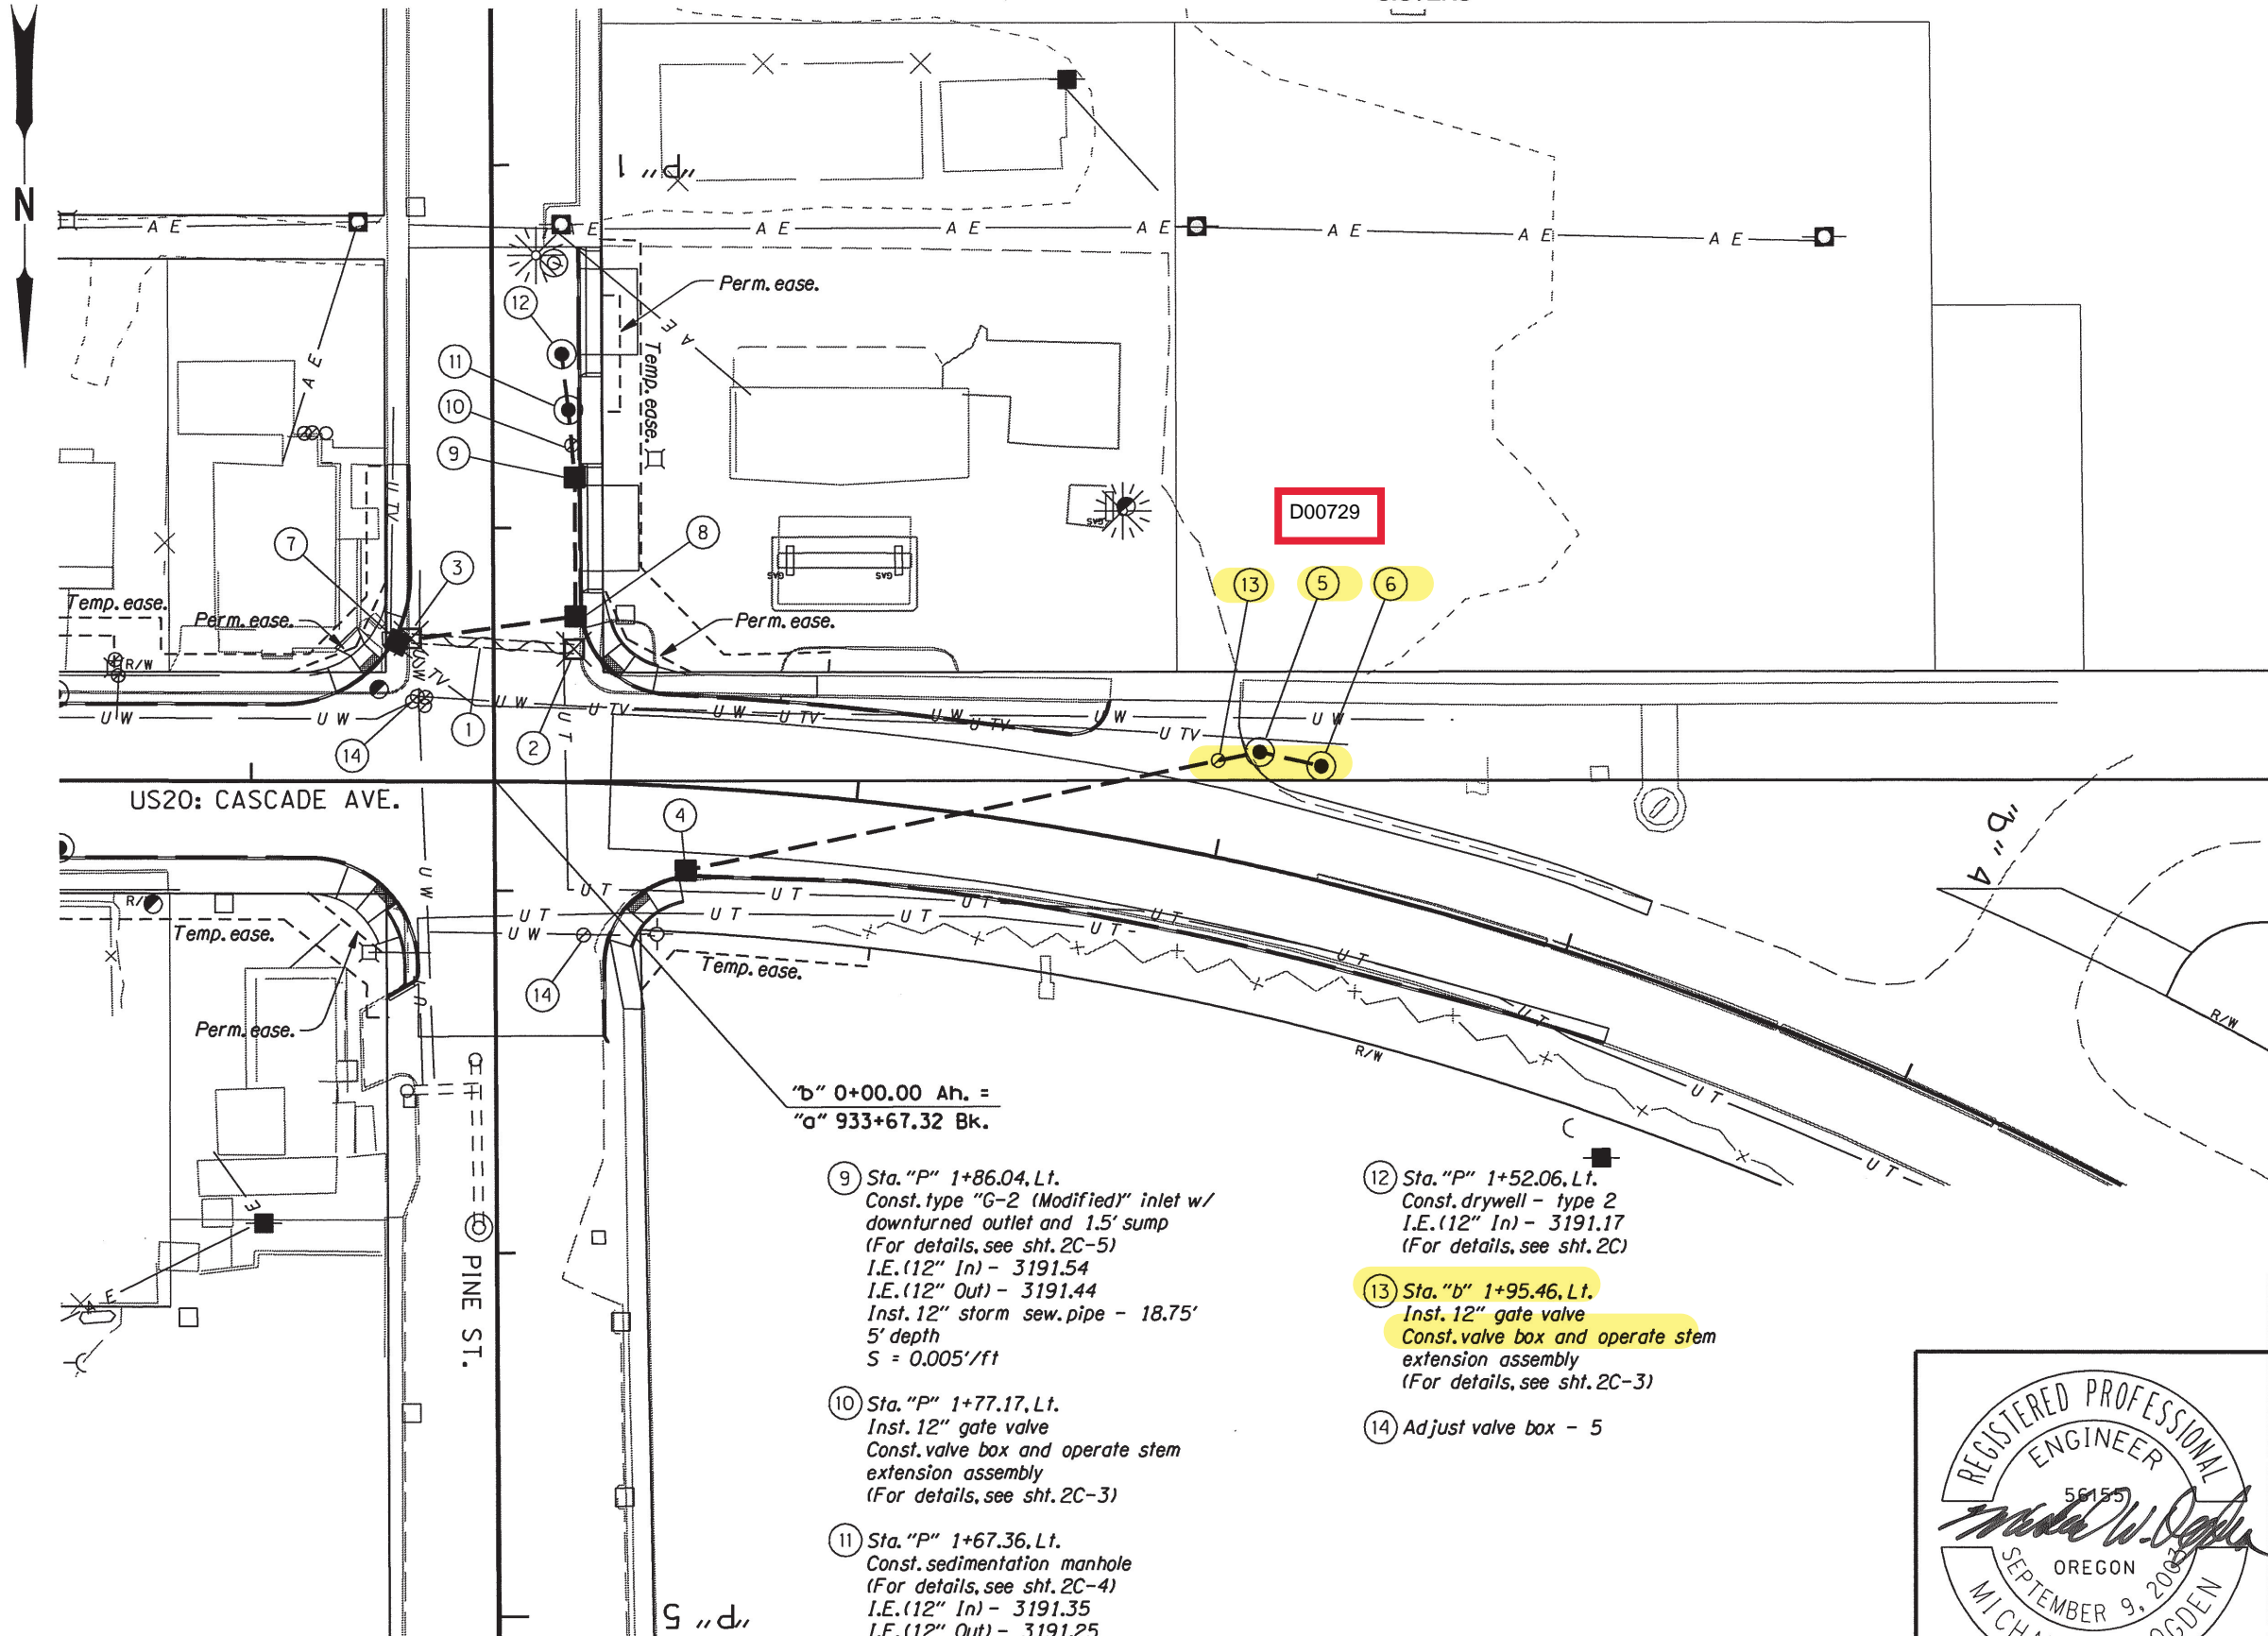


- ① Remove pipe - 45'
- ② Remove inlet
- ③ Decommission UIC
- ④ Sta. "b" 0+53.88, Rt.  
Const. type "G-2 (Modified)" inlet w/  
downturned outlet and 1.5' sump  
(For details, see sht. 2C-5)  
I.E. (12" In) - 3190.33  
Inst. 12" storm sew. pipe - 161.63'  
10' depth  
S = 0.005'/ft
- ⑤ Sta. "b" 2+05.85, Lt.  
Const. sedimentation manhole  
(For details, see sht. 2C-4)  
I.E. (12" In) - 3189.53  
I.E. (12" Out) - 3189.43  
Inst. 12" storm sew. pipe - 17.40'  
10' depth  
S = 0.005'/ft
- ⑥ Sta. "b" 2+22.71, Lt.  
Const. drywell - type 1  
(For details, see sht. 2C)  
I.E. (12" In) - 3189.34  
Inst. type "S3" facility field marker  
DFI no. D00729
- ⑦ Sta. "P" 2+31.46, Rt.  
Const. type "G-2 (Modified)" inlet w/  
downturned outlet and 1.5' sump  
(For details, see sht. 2C-5)  
I.E. (12" Out) - 3192.08  
Inst. 12" ductile iron pipe - 49.68'  
5' depth  
S = 0.005'/ft
- ⑧ Sta. "P" 2+24.46, Lt.  
Const. type "G-2 (Modified)" inlet w/  
downturned outlet and 1.5' sump  
(For details, see sht. 2C-5)  
I.E. (12" In) - 3191.84  
I.E. (12" Out) - 3191.74  
Inst. 12" storm sew. pipe - 38.42'  
5' depth  
S = 0.005'/ft


"b" 0+00.00 Ah. =  
"a" 933+67.32 Bk.

- ⑨ Sta. "P" 1+86.04, Lt.  
Const. type "G-2 (Modified)" inlet w/  
downturned outlet and 1.5' sump  
(For details, see sht. 2C-5)  
I.E. (12" In) - 3191.54  
I.E. (12" Out) - 3191.44  
Inst. 12" storm sew. pipe - 18.75'  
5' depth  
S = 0.005'/ft
- ⑩ Sta. "P" 1+77.17, Lt.  
Inst. 12" gate valve  
Const. valve box and operate stem  
extension assembly  
(For details, see sht. 2C-3)
- ⑪ Sta. "P" 1+67.36, Lt.  
Const. sedimentation manhole  
(For details, see sht. 2C-4)  
I.E. (12" In) - 3191.35  
I.E. (12" Out) - 3191.25  
Inst. 12" storm sew. pipe - 15.40'  
5' depth  
S = 0.005'/ft
- ⑫ Sta. "P" 1+52.06, Lt.  
Const. drywell - type 2  
I.E. (12" In) - 3191.17  
(For details, see sht. 2C)
- ⑬ Sta. "b" 1+95.46, Lt.  
Inst. 12" gate valve  
Const. valve box and operate stem  
extension assembly  
(For details, see sht. 2C-3)
- ⑭ Adjust valve box - 5


Notes:  
For drainage profile, see shts. 11C & 9E

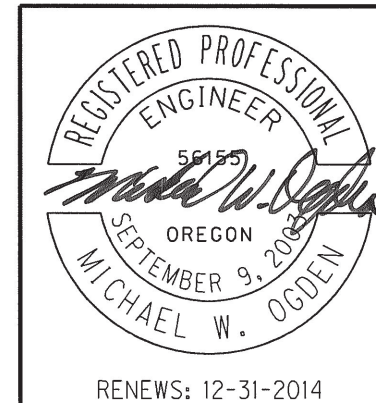

<b>OREGON DEPARTMENT OF TRANSPORTATION</b>	
<b>REGION 4 TECHNICAL CENTER</b>	
<b>FFO-US20: CASCADE IMPROVEMENTS (SISTERS) SEC. MCKENZIE HWY. &amp; SANTIAM HWY. DESCHUTES COUNTY</b>	
Reviewed By - Michael W. Ogden Designed By - Wade J. Coatney Drafted By - Greg Saurbier	
<b>DRAINAGE &amp; UTILITIES</b>	SHEET NO. <b>11A</b>

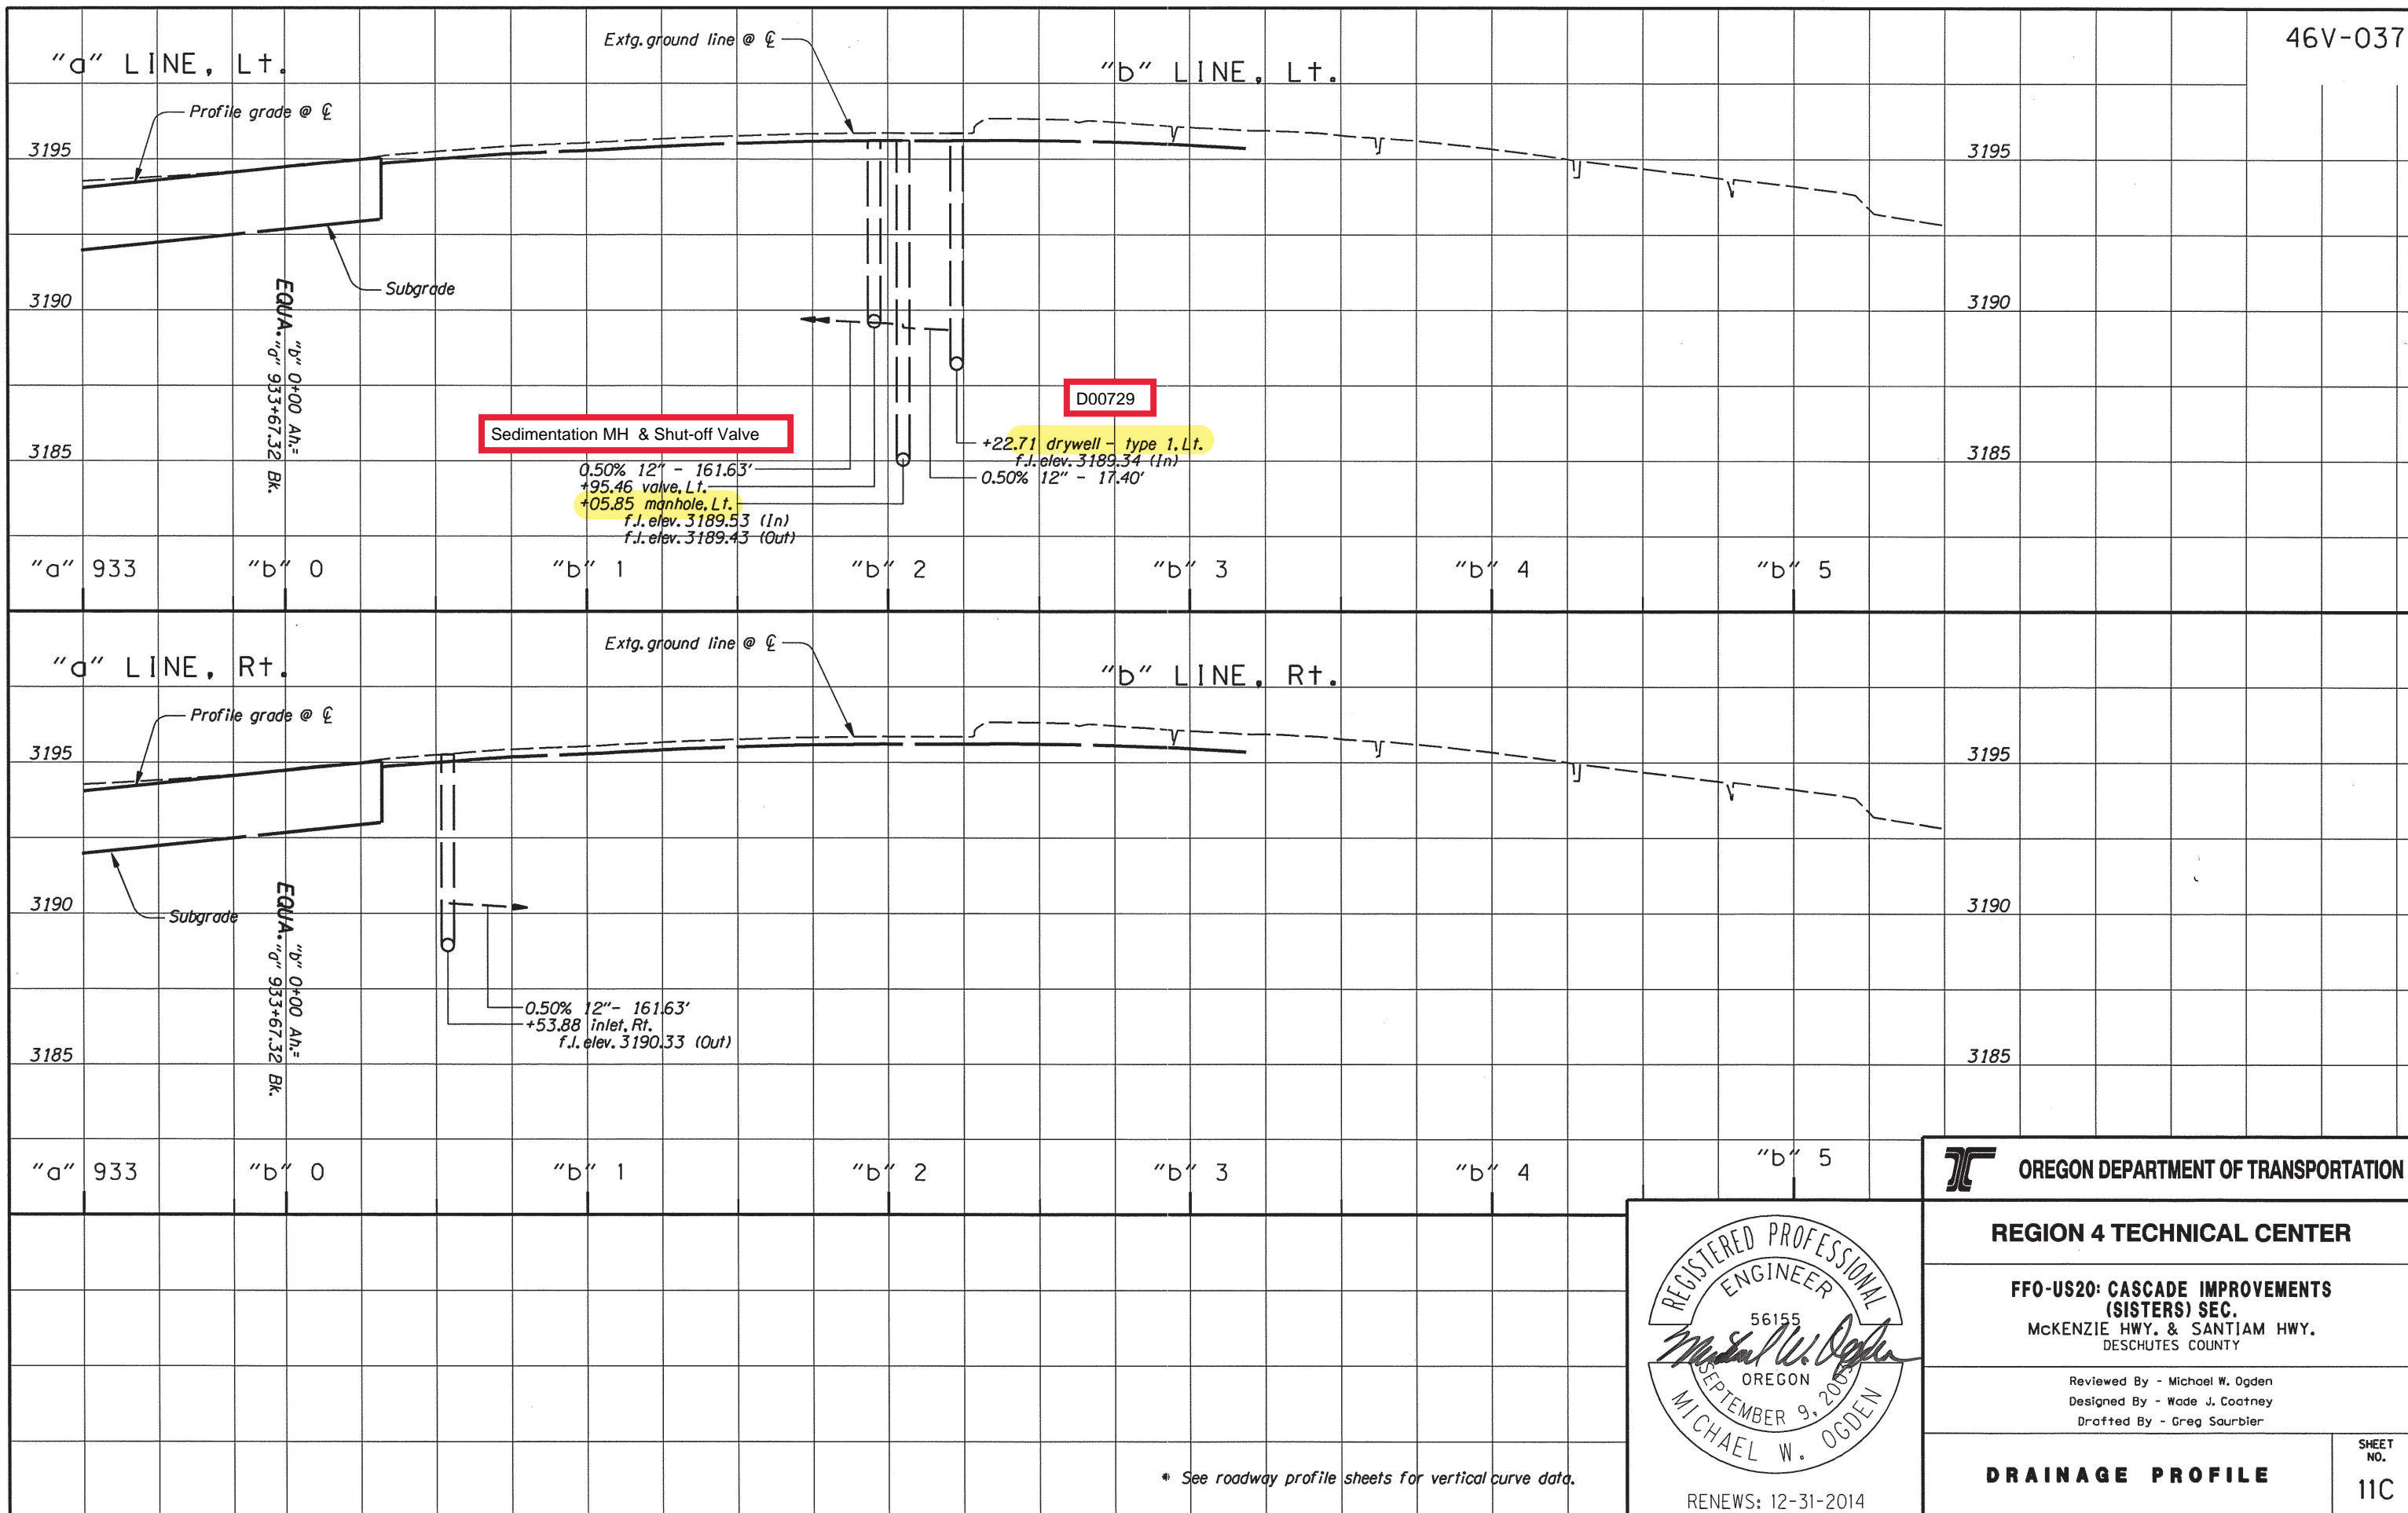

\* See roadway profile sheets for vertical curve data.

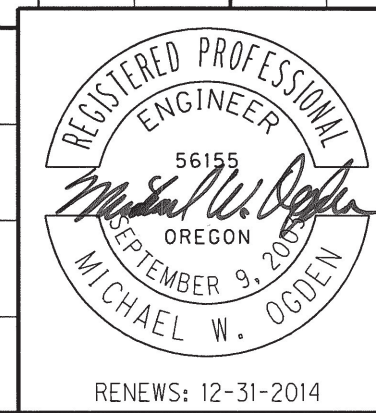

**OREGON DEPARTMENT OF TRANSPORTATION**

**REGION 4 TECHNICAL CENTER**

**FFO-US20: CASCADE IMPROVEMENTS (SISTERS) SEC.**  
 MCKENZIE HWY. & SANTIAM HWY.  
 DESCHUTES COUNTY

Reviewed By - Michael W. Ogden  
 Designed By - Wade J. Coatney  
 Drafted By - Greg Saubier

**DRAINAGE PROFILE**

SHEET NO. 11C