

OPERATION & MAINTENANCE MANUAL

Water Quality Biofiltration Swale

Manual prepared: July 2019

DFI No. D00845



Figure 1: DFI No. D00845, looking [west]

Identification

Drainage Facility ID (DFI): D00845
Facility Type: Water Quality Biofiltration Swale
Construction Drawings: (V-File Numbers) 47v-093
Location: District: 5
Highway No.: 9
Mile Post: 177.75 to 177.76, [right]

1. Manual Purpose

The purpose of this manual is to outline inspection needs and summarize maintenance actions.

2. Facility Location

The location map below details the facility location. The highway, mile posts, side streets, access location, and stormwater flow directions are noted on the map.

Facility location type: Roadway shoulder

Flow direction: [west]

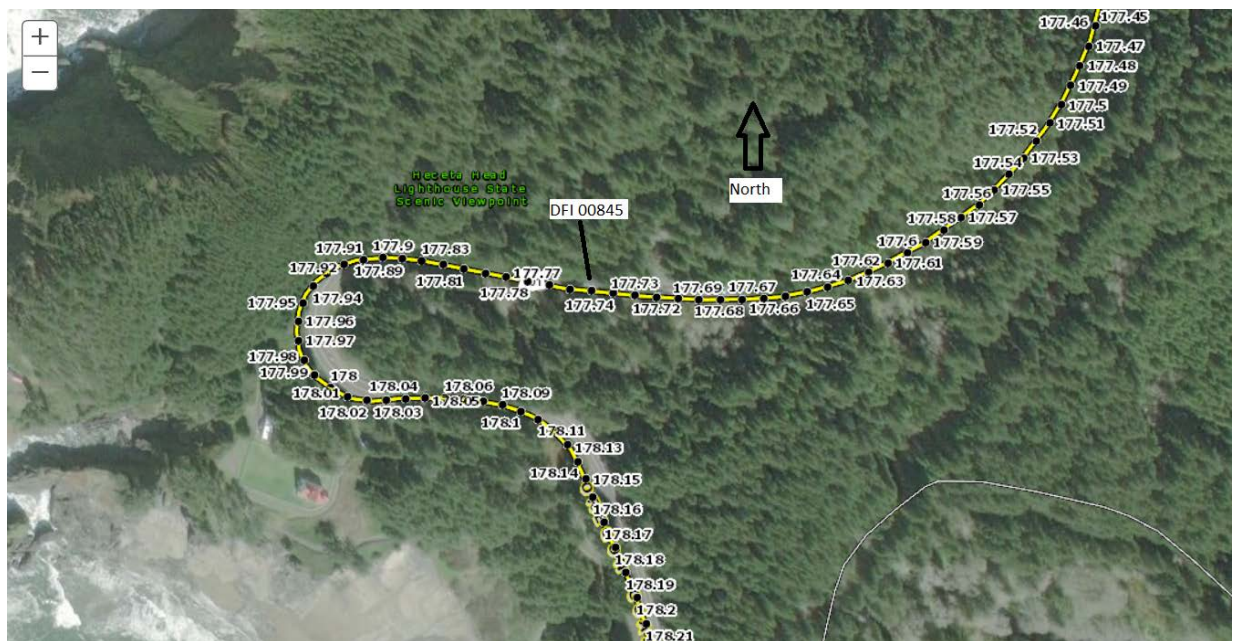



Figure 2: Facility location map

3. Facility Summary

The length and width of a swale is based on the bottom dimensions.

The bottom length and bottom width of the swale is:


Bottom Length (feet)	Bottom Width (feet)
50	Varies 0 – 20

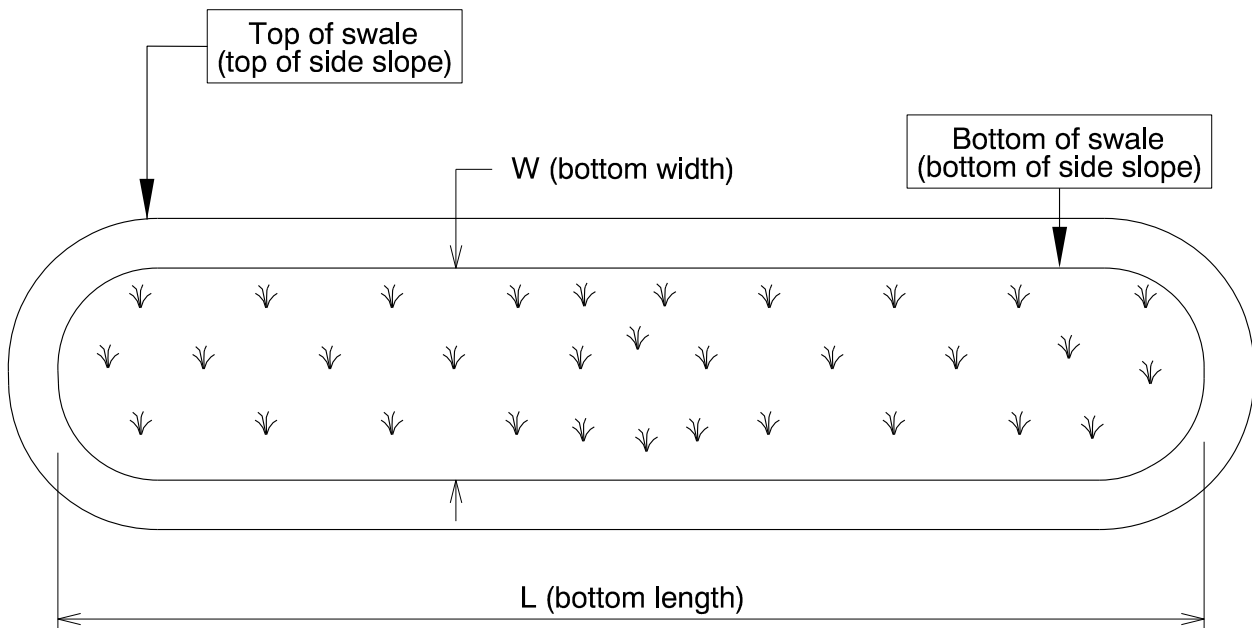

The depth of the swale is the vertical distance measured from the bottom of the swale to the top. The slope of the swale sides is presented by a vertical distance (rise) followed by the horizontal distance (run).

Depth and side slopes:

Depth (feet)	Rise (feet)	Run (feet)
Unknown	1	2

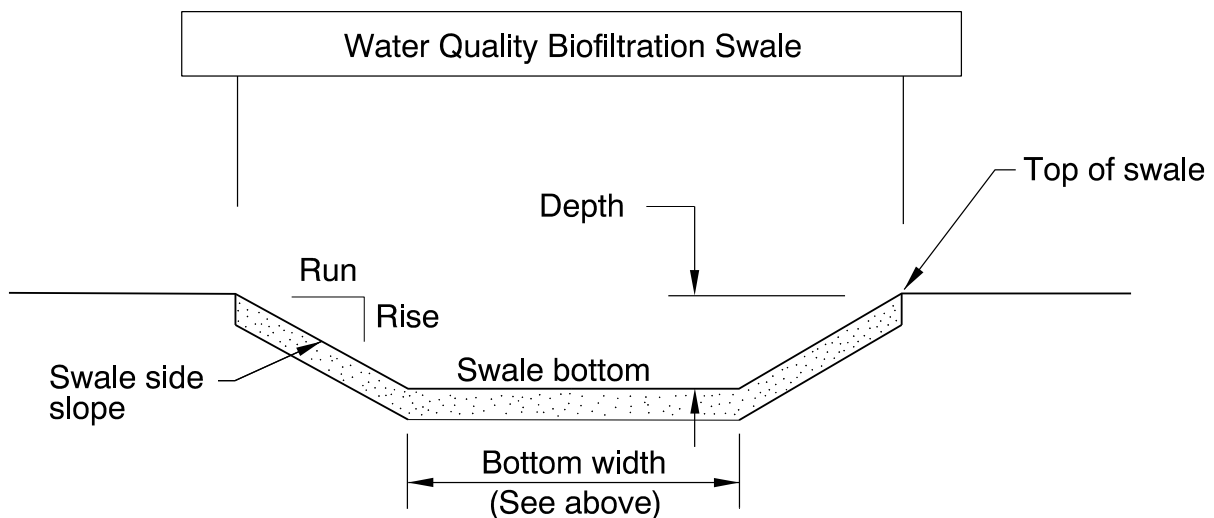

Site Specific Information: Water enters the biofiltration swale from the ditch alongside US101 and flows through the water quality soil before infiltrating into the stone embankment. From the stone embankment, water enters the perforated manhole from either the 18", partially perforated pipe or the stone embankment itself. Water is finally conveyed underneath US101 before discharging into an open channel.

4. Facility Access

Maintenance access to the facility:

<input type="checkbox"/> Roadside pad	<input checked="" type="checkbox"/> Roadside shoulder
<input type="checkbox"/> Access road with Gate	<input type="checkbox"/> Access road without Gate

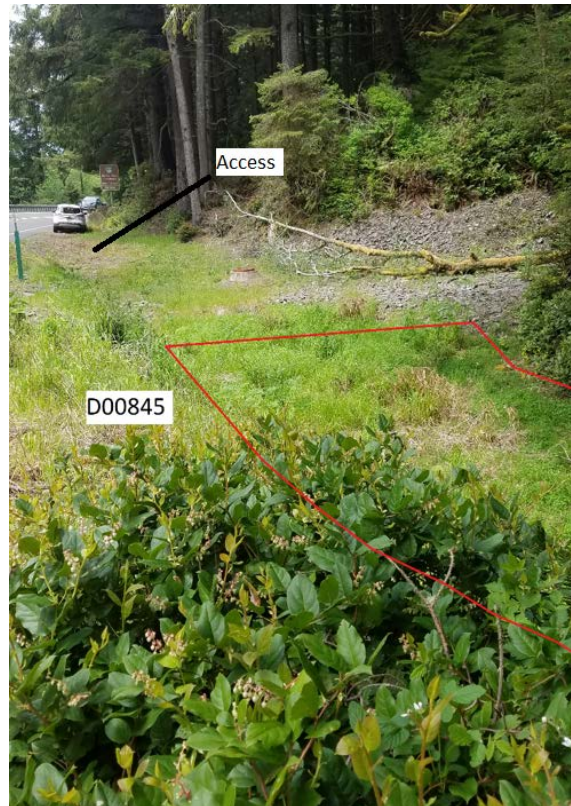


Figure 3: [looking west]

5. Operational Components / Maintenance Items

Classification

This facility is classified as an:

<input checked="" type="checkbox"/> On-line Swale	<input type="checkbox"/> Off-line Swale
A swale that does not include a high flow bypass component; flow drains into and through the facility	A swale that treats low/small flows and diverts high flows using a bypass component

Bypass Component

This facility includes a high flow bypass component:

<input checked="" type="checkbox"/> No	<input type="checkbox"/> Yes
There is no bypass component. High flows drain into and through the facility	There is a bypass component. Only low/small flows drain into the swale. High flows are diverted around the swale using a bypass component

Operational Components

A swale has many components that assist with treatment, conveyance, and reducing flow velocity to minimize erosion. The components in use can vary depending if the facility was designed to operate on-line or off-line. The facility components table (**Table 1**) has been provided to highlight the applicable components for this facility. The component is in use when the box contains an “x” (e.g.).

The Standard Operation Manual for Water Quality Biofiltration Swales (implemented March 2017) outlines facility operation, typical footprint configuration, and component definitions and details. A link to the manual is attached to the feature marker in TransGIS.

<https://gis.odot.state.or.us/TransGIS/>

Operational Plan

The applicable standard operational plan for this facility is:

<input checked="" type="checkbox"/> Operational Plan A	<input type="checkbox"/> Operational Plan B	<input type="checkbox"/> Operational Plan C
An on-line swale with roadside ditches	An on-line swale with piped inlets and outlets	An off-line swale with a piped high flow bypass
A standard operational plan illustrates the general facility footprint configuration and explains the purpose of each facility component. Operational plans (A, B, C) are provided in the Standard Operation Manual.		

See Appendix A for the site specific operational plan.

Maintenance Items

Operational components marked in **Table 1** should be inspected and maintained according to Section 7. Each facility component is defined and detailed in the Standard Operation Manual using the associated ID number indicated below.

Table 1: Swale Components		ID #
Manholes/Structures		
Pre-treatment manhole	<input type="checkbox"/>	S1
Weir type flow splitter/flow splitter manhole	<input type="checkbox"/>	S2
Orifice type flow splitter/flow splitter manhole	<input type="checkbox"/>	S3
Standard manhole	<input checked="" type="checkbox"/>	S4
Swale Inlet		
Pavement sheet flow	<input checked="" type="checkbox"/>	S5
Inlet Pipe (s)	<input type="checkbox"/>	S6
Open channel inlet	<input checked="" type="checkbox"/>	S7
Riprap pad	<input type="checkbox"/>	S8
Ground Cover		
Grass bottom	<input checked="" type="checkbox"/>	S9
Grass side slopes	<input checked="" type="checkbox"/>	S10
Granular drain rock	<input type="checkbox"/>	S11
Plantings	<input type="checkbox"/>	S12
Underground Components		
Geotextile fabric	<input type="checkbox"/>	S13
Water quality mix	<input checked="" type="checkbox"/>	S14
Perforated pipe	<input checked="" type="checkbox"/>	S15
Porous pavers (access grid)	<input type="checkbox"/>	S16
Flow Spreader		
Rock basin (used at inlet)	<input type="checkbox"/>	S17
Anchored board (midpoint of swale or every 50 feet along swale bottom)	<input type="checkbox"/>	S18
Other: N/A	<input type="checkbox"/>	S19
Swale Outlet		
Catch basin with grate	<input type="checkbox"/>	S20
Outlet Pipe (s)	<input checked="" type="checkbox"/>	S21
Open channel outlet	<input type="checkbox"/>	S22
Auxiliary Outlet: N/A	<input type="checkbox"/>	S23
Outfall Type		
Waterbody (Creek/Lake/Ocean)	<input checked="" type="checkbox"/> C	S24
	<input type="checkbox"/> L	
	<input type="checkbox"/> O	
Ditch	<input type="checkbox"/>	S25
Storm drain system	<input type="checkbox"/>	S26
Outfall Components		
Riprap pad	<input type="checkbox"/>	S27
Riprap bank protection	<input type="checkbox"/>	S28

6. Maintenance

Maintenance Frequency/Maintain Records

- a. Inspect annually. Preferably prior to the rainy season.
- b. Clean and maintain as necessary. Refer to Activity 125 for conditions when maintenance is needed.
- c. Keep a record of inspections, maintenance, and repairs.

Maintenance Guide/Maintenance Actions

The ODOT Routine Road Maintenance Water Quality and Habitat Guide (the *Blue Book*) outlines the standard maintenance actions for water quality facilities under Activity 125.

There are standard maintenance tables for standard ODOT designs. The maintenance tables describe the maintenance component, the defect or problem, the condition when maintenance is needed, and the recommended maintenance to correct the problem. Use the following tables to maintain ODOT swales:

- Table 1 (General Maintenance): Contains general maintenance and inspection guidelines that are applicable to all ODOT water quality facilities
- Table 3 (Maintenance of Water Quality or Biofiltration Swales): Contains maintenance information for swales

The *Blue Book* can be viewed at the following website:

http://www.oregon.gov/ODOT/Maintenance/Documents/blue_book.pdf

7. Limitations

Access grid installed:

<input checked="" type="checkbox"/> No	<input type="checkbox"/> Yes
There are no duty porous pavers installed in this swale	

Swales are designed to allow equipment access along the bottom. If an access grid is **NOT** installed, vehicles entering the swale can create depressions (tire ruts), damage vegetation, and damage structural components (e.g. flow spreaders). These conditions may result in poor treatment and drainage performance.

Equipment wheels should be kept on the tops and side slopes. Mower arms may be run along the swale bottom.

8. Waste Material Handling

Material removed from the facility is defined as waste by the Department of Environmental Quality (DEQ). Refer to the roadwaste section of the ODOT Maintenance Yard Environmental Management System (EMS) Policy and Procedures Manual for disposal options:

http://www.oregon.gov/ODOT/Maintenance/Documents/ems_manual.pdf


Contact any of the following for more detailed information about management of waste materials found on site:

ODOT Clean Water Unit	(503) 986-3008
ODOT Statewide Hazmat Coordinator	(503) 667-7442
ODOT Region 1 Hazmat Coordinator	(503) 731-8290
ODOT Region 2 Hazmat Coordinator	(503) 986-2647
ODOT Region 3 Hazmat Coordinator	(541) 957-3594
ODOT Region 4 Hazmat Coordinator	(541) 388-6186
ODOT Region 5 Hazmat Coordinator	(541) 963-1590
ODEQ Northwest Region Office	(503) 229-5263

A Appendix A – Site Specific Operational Plan


Contents:

Operational Plan: DFI D00845

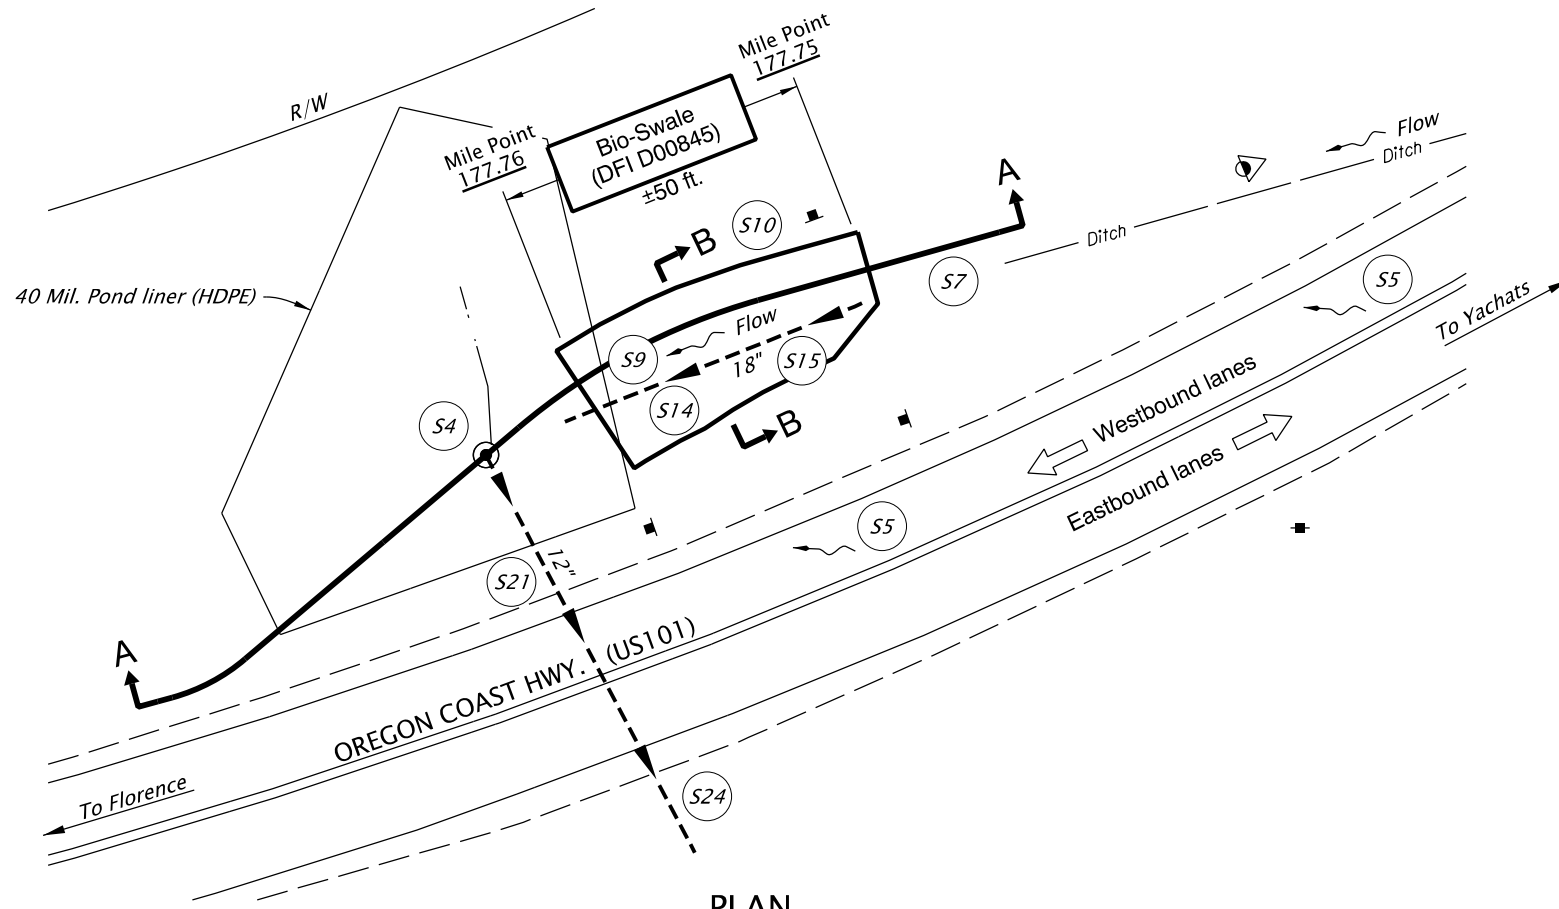


PLAN
N.T.S.

- LEGEND:
- (X#) Facility Component (see table 1 in O&M Manual)
 - and ○ or ● and □ Manhole
 - and □ Inlet
 - Storm Pipe (Facility)
 - - - Storm Pipe
 - - - Ditch Line
 - ▭ Swale Boundary
 - Conveyance Direction
 - Pavement / Facility Flow Path
 - ← Traffic Flow Direction
 - 📍 Photo Location / Direction

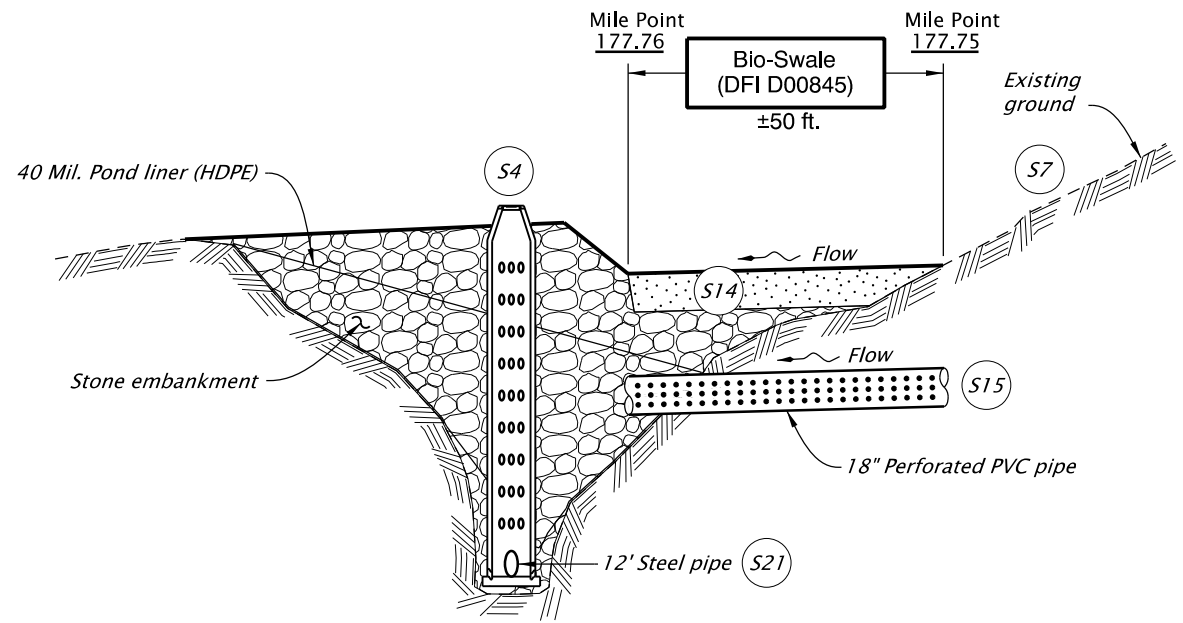

SECTION A-A
N.T.S.

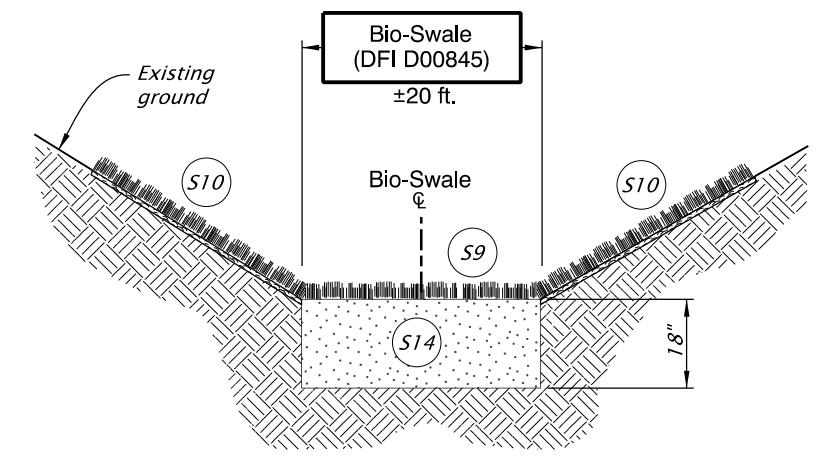

SECTION B-B
N.T.S.



OREGON DEPARTMENT OF TRANSPORTATION

Sht. ## of ##
Prepared By: Christopher Carman
Drafted By: Jeff Coon

DFI D00845
MAINTENANCE DISTRICT 5 US101
WATER QUALITY BIOFILTRATION SWALE
OREGON COAST HIGHWAY MP 177.75
LANE COUNTY

B Appendix B – Project Contract Plans

Contents:

Site Specific Subset of Project Contract Plan 47v-093


INDEX OF SHEETS	
SHEET NO.	DESCRIPTION
1	Title Sheet
1A	Index Of Sheets Cont.

STATE OF OREGON
DEPARTMENT OF TRANSPORTATION
PLANS FOR PROPOSED PROJECT

STRUCTURES, PAVING, DRAINAGE
US101: BRAYS POINT - SUTTON LAKE ROAD
SLIDE REPAIRS PROJECT

OREGON COAST HIGHWAY
LANE COUNTY
JUNE 2014

REVISED AS CONSTRUCTED
2-25-2015
DATE
Steve Logan
PROJECT MANAGER

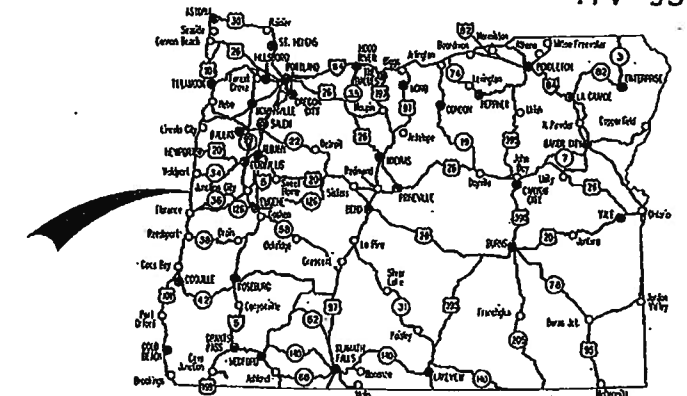

Overall Length Of Project - 0.53 Miles

NHPP-S009(421)
BEGINNING OF PROJECT
STA. "B" 0+00.00 (M.P. 170.23)


END WORK AREA
STA. "B" 7+75.00 (M.P. 170.38)

END WORK AREA
STA. "H" 719+19.31 (M.P. 177.54)

BEGIN WORK AREA
STA. "H" 705+96.92 (M.P. 177.79)

BEGIN WORK AREA
STA. "S" 1+00.00 (M.P. 183.05)

NHPP-S009(421)
END OF PROJECT
STA. "S" 7+00.00 (M.P. 183.16)

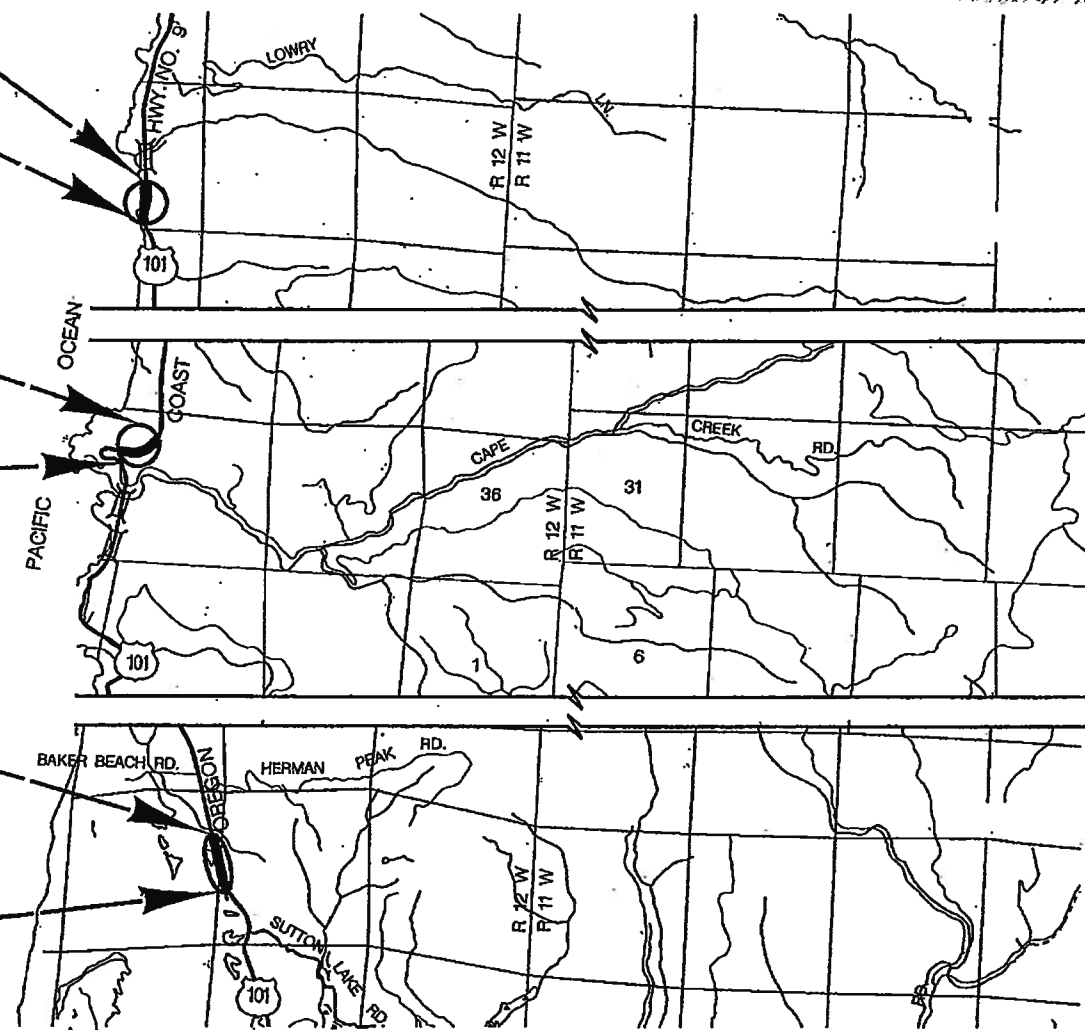

ATTENTION:
Oregon Law Requires You To Follow Rules Adopted By The Oregon Utility Notification Center. Those Rules Are Set Forth In OAR 952-001-0010 Through OAR 952-001-0090. You May Obtain Copies Of The Rules By Calling The Center. (Note: The Telephone Number For The Oregon Utility Center Is (503) 232-1987.)



OREGON TRANSPORTATION COMMISSION
Pot Egan: CHAIR
David Lohman: COMMISSIONER
Mark Frohnmeyer: COMMISSIONER
Tammy Boney: COMMISSIONER
Matthew L. Garrett: DIRECTOR OF TRANSPORTATION

These plans were developed using ODOT design standards. Exceptions to these standards, if any, have been submitted and approved by the ODOT Chief Engineer or their delegated authority.

By: *Carol A. Cartwright* 5/6/14
Signature & Date

Carol A. Cartwright - R2 Tech Center Manager
Print name and title


[Signature]
Concurrence by ODOT Chief Engineer

US101: BRAYS POINT - SUTTON LAKE ROAD
SLIDE REPAIRS PROJECT
OREGON COAST HIGHWAY
LANE COUNTY

FEDERAL HIGHWAY ADMINISTRATION	PROJECT NUMBER	SHEET NO.
OREGON DIVISION	NHPP-S009(421)	1

T. 15,16,17, S.,
R. 12 W., W.M.



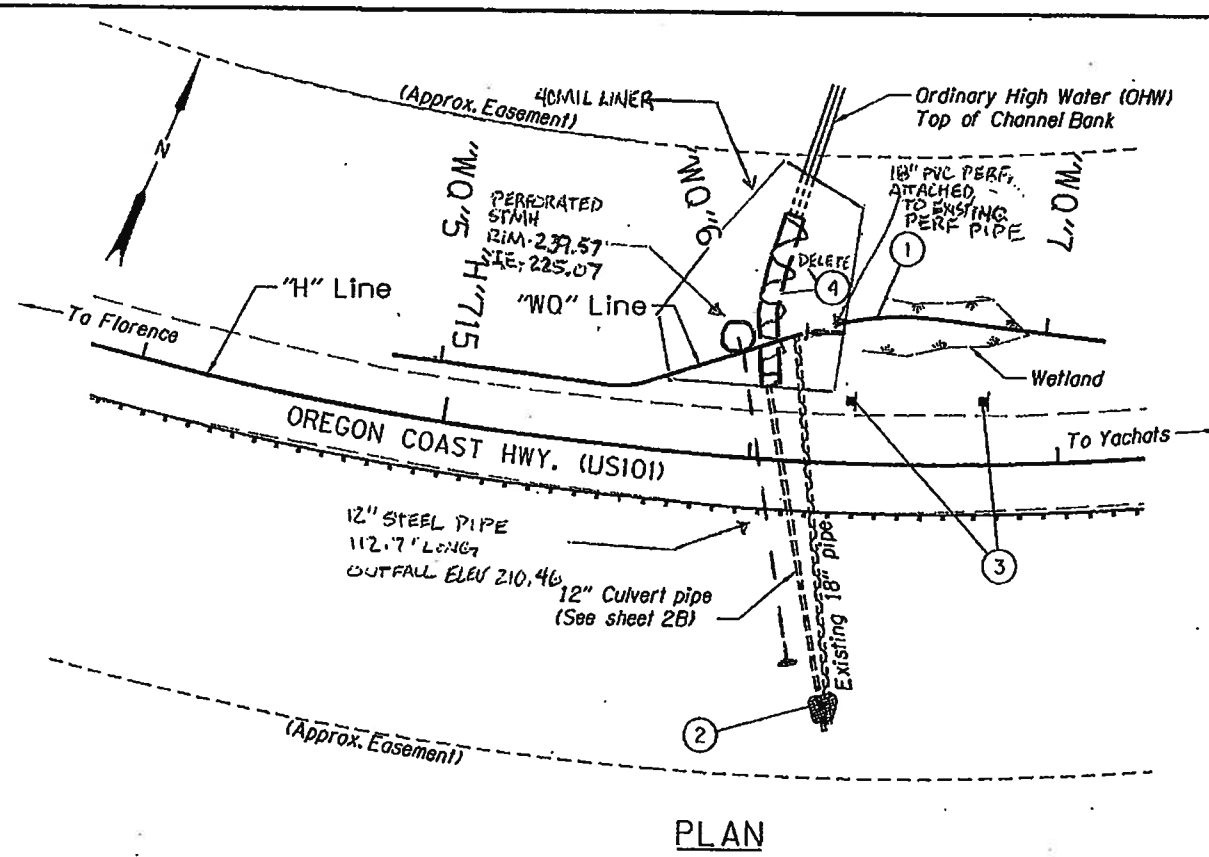


SWALE NO. 00845 MARKER TABLE

TYPE		FACILITY LOCATION			
S1	S2	RED	GREEN	STATION	OFFSET
✓			✓	"H" 716+32.14	20.0' Lt.
✓		✓		"H" 716+76.32	20.5' Lt.
	✓			"H" 716+76.32	35.5' Lt.

✓ Check where appropriate
 Red = Beginning of facility
 Green = End of facility


REVISED AS CONSTRUCTED
 2-27-2015
 DATE
 PROJECT MANAGER

- ① Sta. "WQ" 5+65.73 to 6+84.00
 Construct Embankment
 Stone Embankment - 450 cu.yd.
 Water Quality Mix - 70 cu.yd.
 Riprap Geotextile (Type-1) - 150 sq.yd.
- ② Sta. "H" 716+27.03
 Construct Riprap Pad (See GJ-2 details)
 General Excavation - 5 cu.yd.
 Loose riprap, (Class 50) - 5 cu.yd.
 Riprap geotextile (Type-1) - 13 sq.yd.
 Aggr. base - 0.05 cu.yd.
 18" storm sewer - 5'
- ③ Stormwater facility marker
 (See Swale No. 00845 Marker table)
 (See dwg. RD399)
- ④ Construct channel 1:3 side slopes
~~3/4" minus 6 cu.yd.~~
~~Riprap Geotextile (Type-1) 55 sq.yd.~~
 (For details, see sheet GJ-3)
 REMOVED AND DELETED
 DURING EWS TO RELIEVE
 IMPOUNDED WATER IN
 "BOWL" AREA.

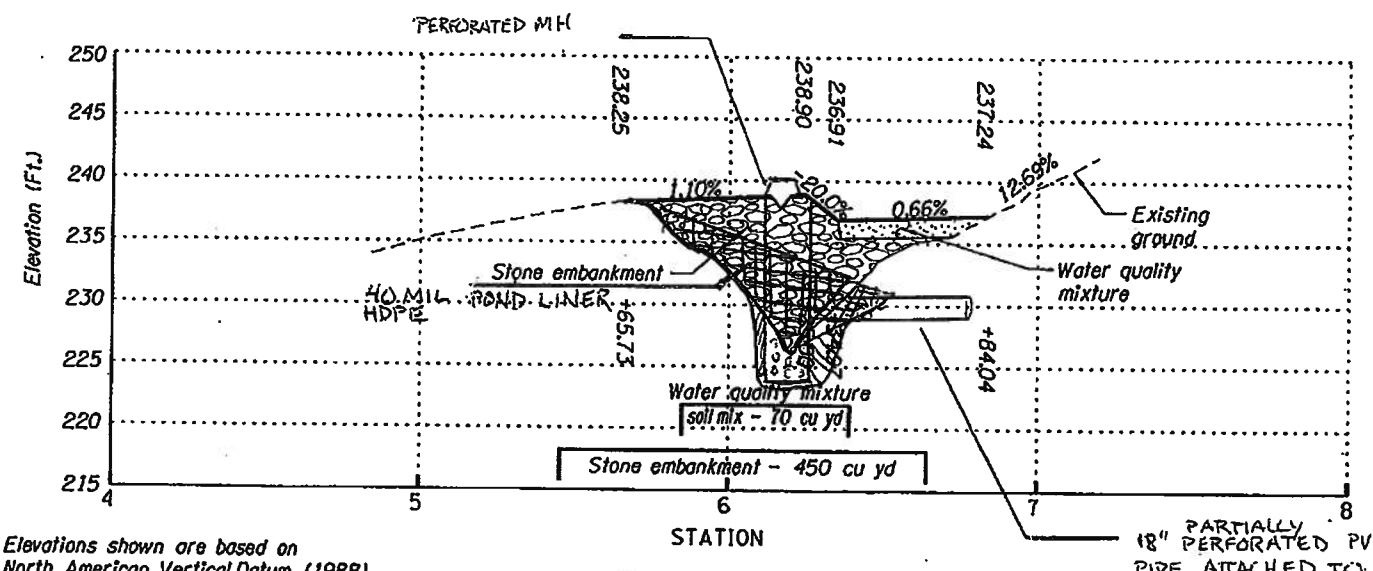

PARTIALLY
 18" PERFORATED PVC
 PIPE ATTACHED TO
 EXISTING CMP DIRECTING
 FLOW INTO "POND LINED"
 AREA.

Plug and abandon extg. pipe shown thus:

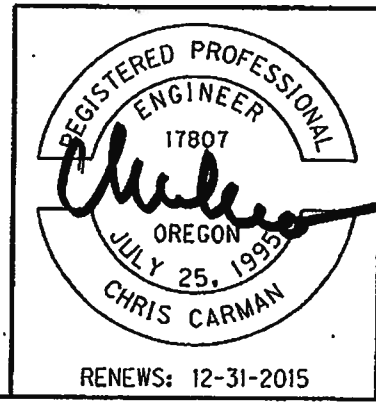

OREGON DEPARTMENT OF TRANSPORTATION

REGION 2 TECH CENTER

US101:BRAYS POINT - SUTTON LAKE RD.
 SLIDE REPAIRS PROJECT
 OREGON COAST HIGHWAY
 LANE COUNTY

Reviewed By - Bruce Carmichael
 Designed By - Christopher Carmon
 Drafted By - Julie Rentz

STORMWATER PLAN/PROFILE

SHEET NO. GJ