

OPERATION & MAINTENANCE MANUAL

DFI No. : D00846
Facility Type: Water Quality
Biofiltration Swale



December, 2017

INDEX

1. IDENTIFICATION 1

2. FACILITY CONTACT INFORMATION..... 1

3. CONSTRUCTION..... 1

4. STORM DRAIN SYSTEM AND FACILITY OVERVIEW 1

5. FACILITY HAZ MAT SPILL FEATURE(S)..... 2

6. AUXILIARY OUTLET (HIGH FLOW BYPASS) 2

7. MAINTENANCE REQUIREMENTS 3

8. WASTE MATERIAL HANDLING 3

APPENDIX A: Operational Plan and Profile Drawing(s)

APPENDIX B: ODOT Project Plan Sheets

1. Identification

Drainage Facility ID (DFI): **D00846**
Facility Type: Water Quality Biofiltration Swale
Construction Drawings: 47V-127
Location: District: 08
Highway No.: 022
Mile Post: MP 5.96 to MP 5.98
Description: This facility is located along the shoulder of Crater Lake Highway near the intersection with Merry Lane.

2. Facility Contact Information

Contact the Engineer of Record, Region Technical Center, or Geo-Environmental's Senior Hydraulics Engineer for:

- Operational clarification
- Maintenance clarification
- Repair or restoration assistance

Engineering Contacts:

Region Technical Center Hydro Unit Manager

Or

Geo-Environmental Senior Hydraulics Engineer (503) 986-3365.

3. Construction

Engineer of Record: DeLanie Cutsforth – Region 3 Tech Center, White City, (541) 774-6326

Facility construction: 2016
Contractor: N/A

4. Storm Drain System and Facility Overview

A water quality swale is a flat-bottomed open channel designed to treat stormwater runoff from highway pavement areas. This type of facility is lined with grass. Treatment by trapping sedimentation occurs when stormwater runoff flows through the grass.

This facility is located along the shoulder of Crater Lake Highway (No. 022). Access for this facility is available from the shoulder. Stormwater enters the facility via roadway runoff and a series of inlets. As the water flows through the swale it is treated as it slows and spreads out within the swale before outfalling into north jack creek.

A. Maintenance equipment access:

This facility can be accessed from the shoulder of Crater Lake Highway.

B. Heavy equipment access into facility:

- Allowed (no limitations)
- Allowed (with limitations)
- Not allowed

C. Special Features:

- Amended Soils
- Porous Pavers
- Liners
- Underdrains

5. Facility Haz Mat Spill Feature(s)

The water quality biofiltration swale can be used to store a volume of liquid by blocking the facility outlet through use of sandbags.

6. Auxiliary Outlet (High Flow Bypass)

Auxiliary Outlets are provided if the primary outlet control structure can not safely pass the projected high flows. Broad-crested spillway weirs and over flow risers are the two most common auxiliary outlets used in stormwater treatment facility design. The auxiliary outlet feature is either a part of the facility or an additional storm drain feature/structure.

The auxiliary outlet feature for this facility is:

Designed into facility

Other

There are no auxiliary outlets built into this facility. In the event that flows exceed design flows the water will overtop the swale.

7. Maintenance Requirements

Routine maintenance table for non-proprietary stormwater treatment and storage/detention facilities have been incorporated into ODOT's Maintenance Guide. These tables summarize the maintenance requirements for ponds, swales, filter strips, bioslopes, and detention tanks and vaults. Special maintenance requirements in addition to the routine requirements are noted below when applicable.

The ODOT Maintenance Guide can be viewed at the following website:

<http://www.oregon.gov/ODOT/HWY/OOM/MGuide.shtml>

Maintenance requirements for proprietary structures, such as underground water quality manholes and/or vaults with filter media are noted in Appendix C when applicable.

The following stormwater facility maintenance table (See ODOT Maintenance Guide) should be used to maintain the facility outlined in this Operation and Maintenance Manual or follow the Maintenance requirements outlined in Appendix C when proprietary structure is selected below:

- Table 1 (general maintenance)
- Table 2 (stormwater ponds)
- Table 3 (water quality biofiltration swales)
- Table 4 (water quality filter strips)
- Table 5 (water quality bioslopes)
- Table 6 (detention tank)
- Table 7 (detention vault)
- Appendix C (proprietary structure)
- Special Maintenance requirements:

Note: Special maintenance Requirements Require Concurrence from ODOT SR Hydraulics Engineer.

8. Waste Material Handling

Material removed from the facility is defined as waste by the Department of Environmental Quality (DEQ). Refer to the roadwaste section of the

ODOT Maintenance Yard Environmental Management System (EMS)
Policy and Procedures Manual for disposal options:

http://www.oregon.gov/ODOT/Maintenance/Documents/ems_manual.pdf




Contact any of the following for more detailed information about
management of waste materials found on site:

ODOT Clean Water Unit	(503) 986-3008
ODOT Statewide Hazmat Coordinator	(503) 667-7442
ODOT Region 1 Hazmat Coordinator	(503) 731-8290
ODOT Region 2 Hazmat Coordinator	(503) 986-2647
ODOT Region 3 Hazmat Coordinator	(541) 957-3594
ODOT Region 4 Hazmat Coordinator	(541) 388-6186
ODOT Region 5 Hazmat Coordinator	(541) 963-1590
ODEQ Northwest Region Office	(503) 229-5263


Appendix A

Content:


- **Operational Plan and Profile Drawing(s)**

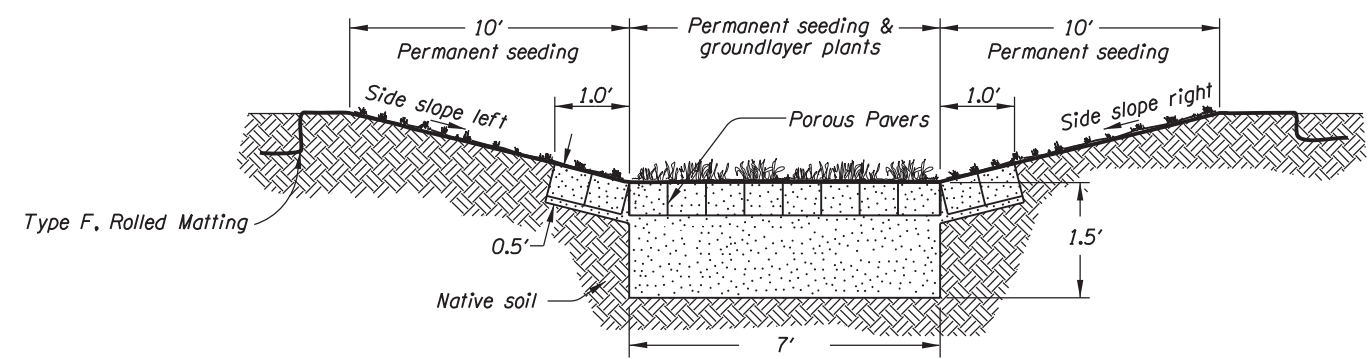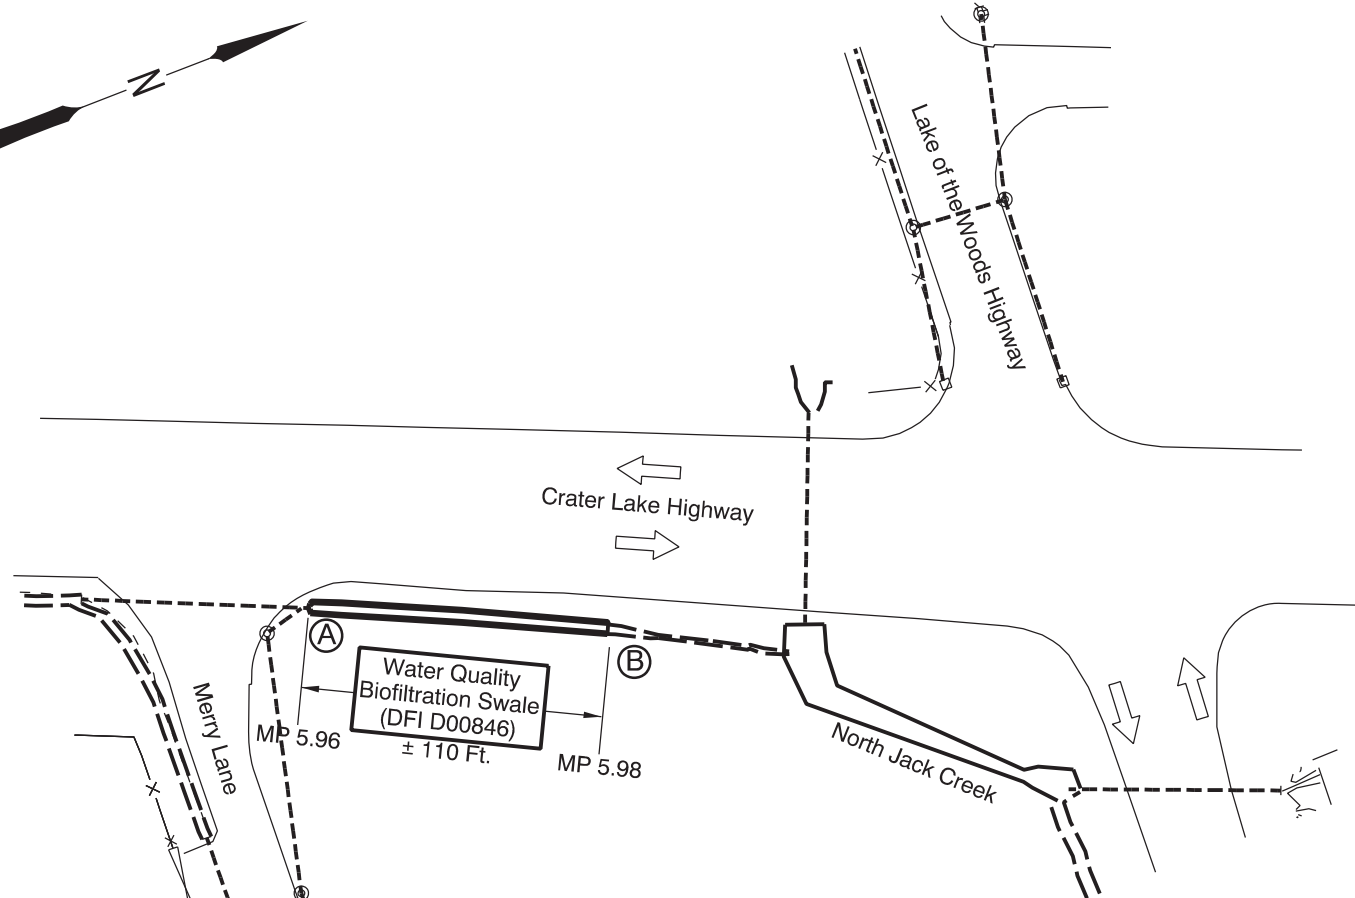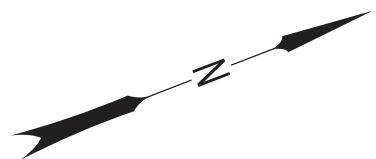

SECTION B-B
N.T.S.

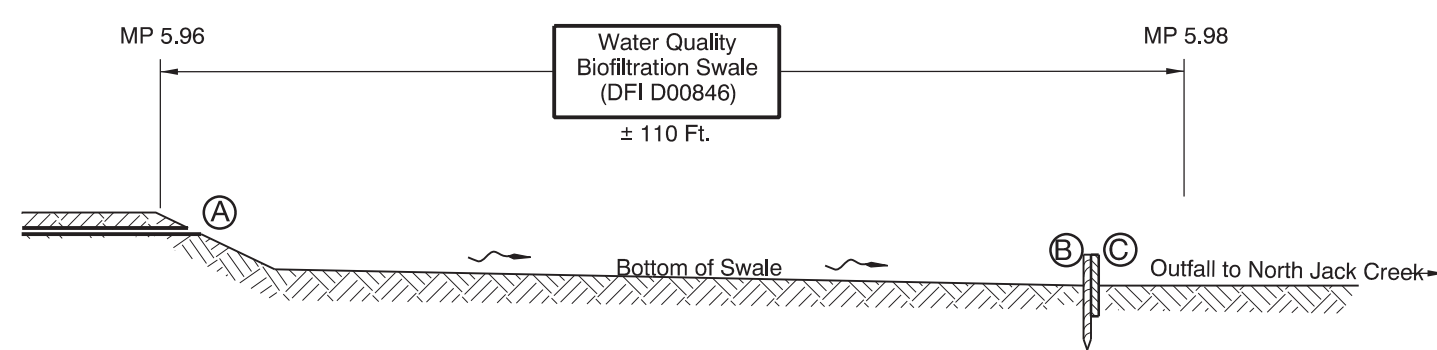

SECTION A-A
N.T.S.

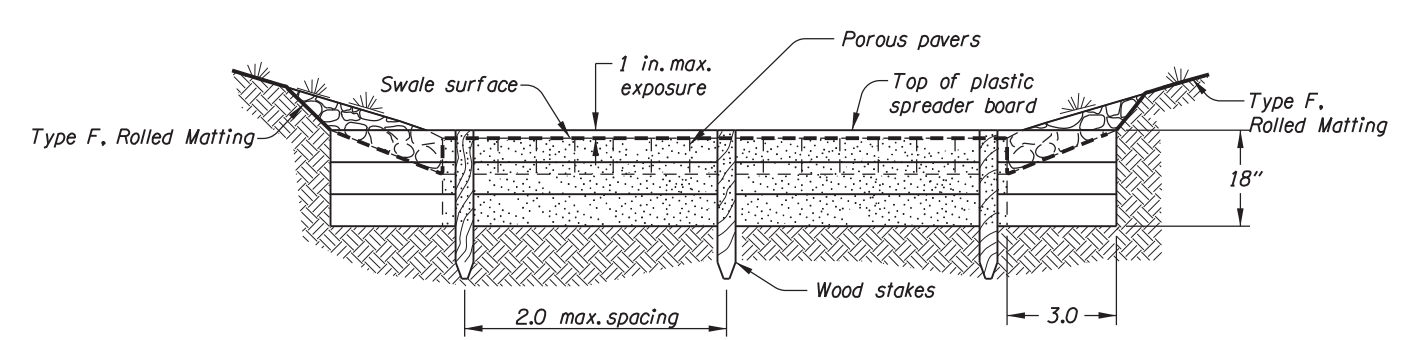

FLOW BOARD SPREADER DETAIL
N.T.S.

- LEGEND:**
- (A) Swale Inlet w/Flow Spreader Inlet
 - (B) Swale Outlet
 - (C) Flow Board Spreader
 - and ○ Manhole
 - and □
 - Storm Pipe (Facility)
 - Storm Pipe
 - ← Conveyance Direction
 - ~ Pavement / Facility Flow Path

OREGON DEPARTMENT OF TRANSPORTATION

Prepared By: T. BURRIER
 Drafted By: T. BURRIER

DFI D00846
MAINTENANCE DISTRICT 8 HWY 022
WQ BIOFILTRATION SWALE
 HIGHWAY MP 5.96 TO MP 5.98
 JACKSON COUNTY

Appendix B

Content:

- **ODOT Project Plan Sheets**
 - *Cover/Title Sheet*
 - *Water Quality/Detention Plan Sheets*
 - *Other Details*


INDEX OF SHEETS	
SHEET NO.	DESCRIPTION
1	Title Sheet
1A	Index Of Sheets Cont'd. & Std. Drg. Nos.

STATE OF OREGON
DEPARTMENT OF TRANSPORTATION

PLANS FOR PROPOSED PROJECT


PAVING & SIGNAL MODIFICATION
**OR62 & OR140
INTERSECTION**
CRATER LAKE & LAKE OF THE WOODS HIGHWAY

JACKSON COUNTY
DECEMBER 2014

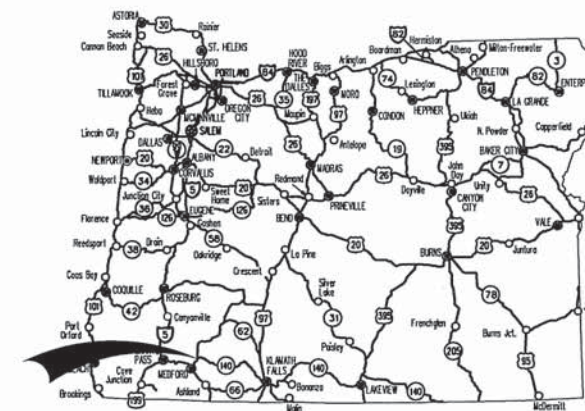

Overall Length Of Project - 0.27 Mile

ATTENTION:
Oregon Law Requires You To Follow Rules Adopted By The Oregon Utility Notification Center. Those Rules Are Set Forth In OAR 952-001-0010 Through OAR 952-001-0090. You May Obtain Copies Of The Rules By Calling The Center. (Note: The Telephone Number For The Oregon Utility Center Is (503) 232-1987.)

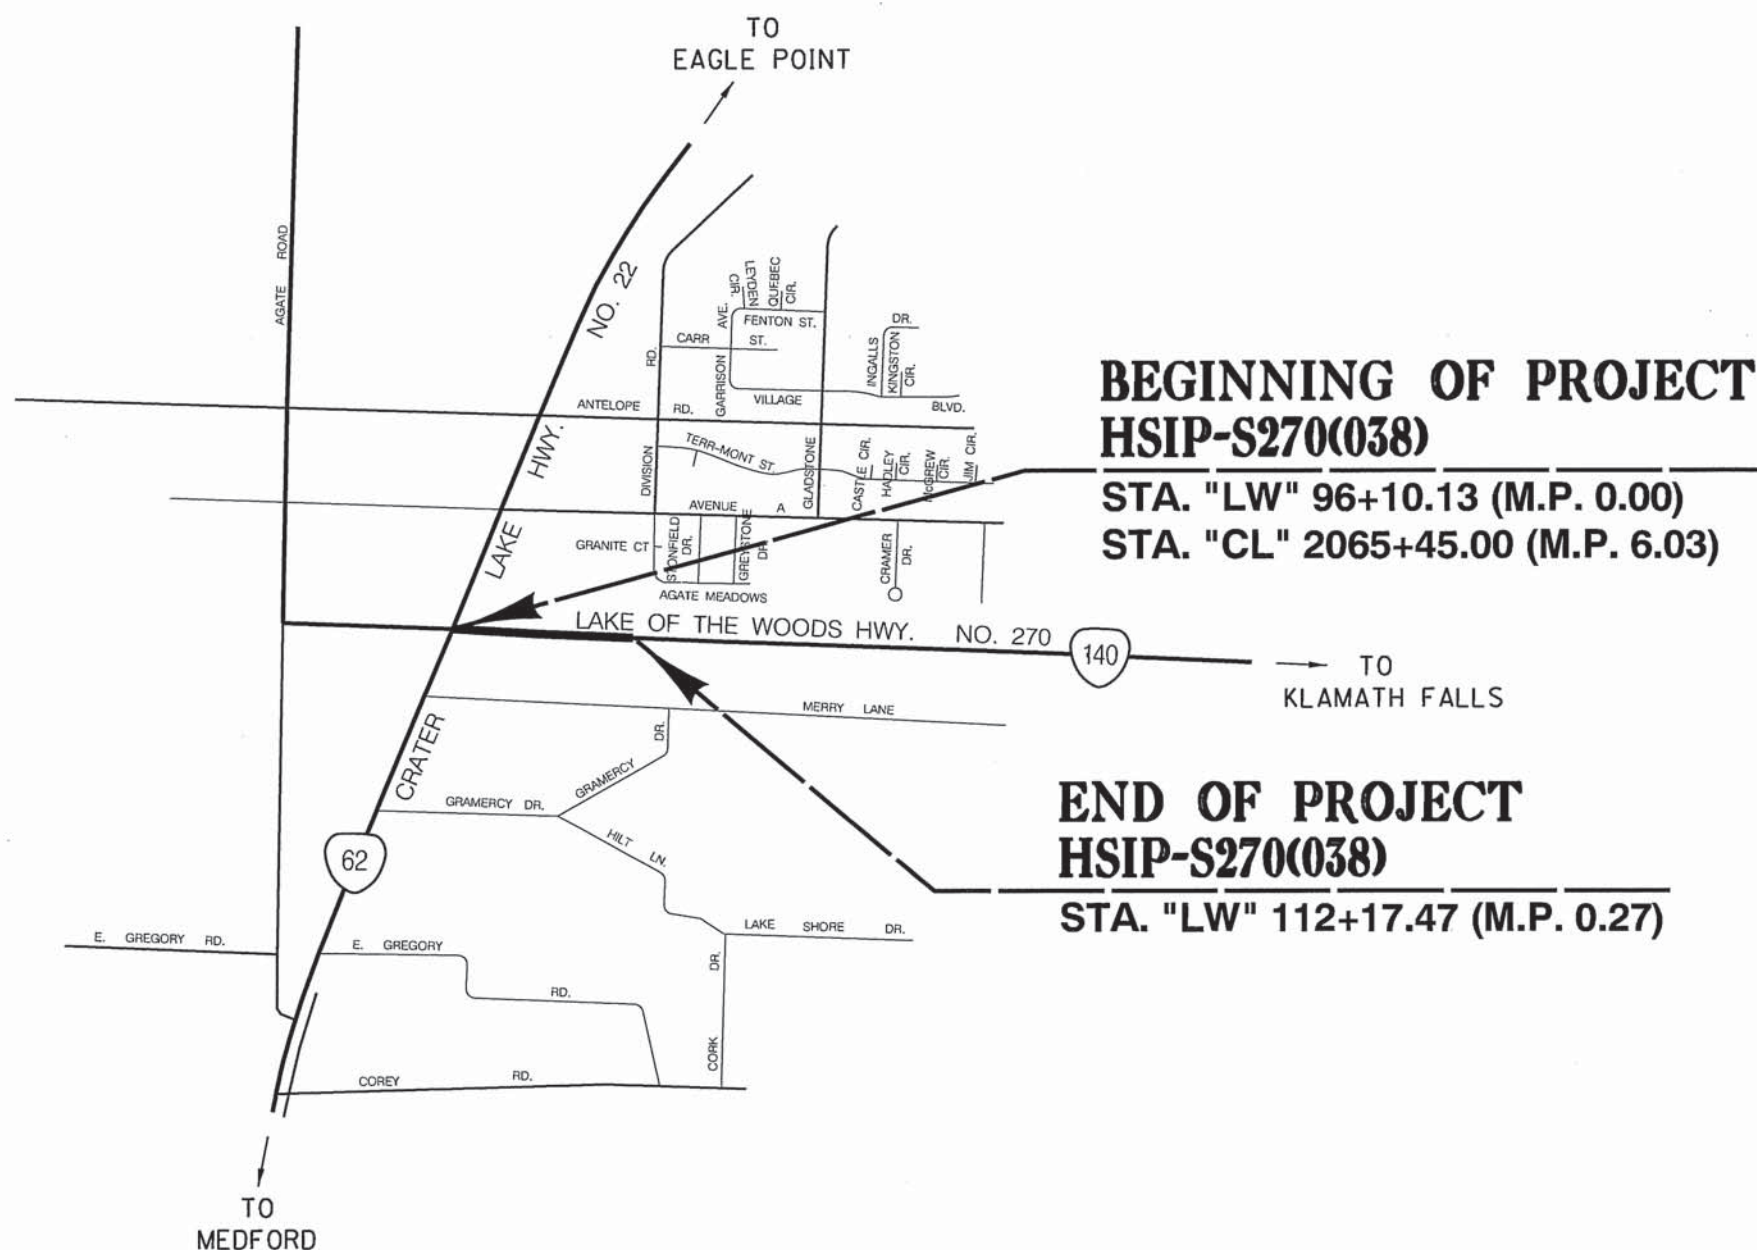

T. 36S., R. 1W., W.M.



OREGON TRANSPORTATION COMMISSION

Catherine Mator CHAIR
Tommy Boney COMMISSIONER
David Lohman COMMISSIONER
Susan Morgan COMMISSIONER
Alando Simpson COMMISSIONER
Matthew L. Garrett DIRECTOR OF TRANSPORTATION

These plans were developed using ODOT design standards. Exceptions to these standards, if any, have been submitted and approved by the ODOT Chief Engineer or their delegated authority.

Approving Authority: *M. Thompson*
Signature & date 10-13-2014

MARK THOMPSON, TECH. CENTER MGR.
Print name and title

Thomas Jones
Concurrence by ODOT Chief Engineer

**OR62 & OR140
INTERSECTION**
CRATER LAKE & LAKE OF THE WOODS HIGHWAY
JACKSON COUNTY

FEDERAL HIGHWAY ADMINISTRATION	PROJECT NUMBER	SHEET NO.
OREGON DIVISION	HSIP-S270(038)	1

Standard Drg. Nos.

- RD300 - Trench Backfill, Bedding, Pipe Zone And Mult. Installations
- RD302 - Street cut
- RD316 - Sloped Ends For Metal Pipe
- RD317 - Culvert Embankment Protection
- RD318 - Sloped Ends For Concrete Pipe
- RD319 - Miscellaneous Culvert Details
- RD320 - Paved End Slope For Culverts 60" Maximum Pipe Size
- RD326 - Coupling Bands For Corrugated Metal Pipe Types A, B, D, & E
- RD327 - Coupling Bands For Corrugated Metal Pipe Types F, J, & K
- RD336 - Standard Storm Sewer Manhole
- RD346 - Large Precast Manhole
- RD354 - Carry Through Manhole-Storm
- RD356 - Manhole Covers And Frames
- RD364 - Concrete Inlets Type G-1, G-2, G-2M, & G-2MA
- RD365 - Frames & Grates For Concrete Inlets
- RD371 - Concrete Inlet Base Type CG-3
- RD372 - Concrete Inlet Top, Option 1, Type CG-3
- RD380 - Fill Height Tables For Aluminum & Steel Corrugated Pipe
- RD384 - Fill Height Tables For Aluminum & Steel Spiral Rib Pipe
- RD386 - Fill Height Tables For Circular Concrete Pipe
- RD388 - Fill Height Tables For PVC Pipe
- RD390 - Fill Height Tables For Corrugated HDPE Pipe
- RD393 - Fill Height Tables For Polypropylene Pipe

- RD610 - Asphalt Pavement Details

- RD700 - Curbs
- RD715 - Approaches And Non-Sidewalk Driveways
- RD720 - Sidewalks
- RD755 - Sidewalk Ramp Details
- RD756 - Sidewalk Ramp Placement Options Curb Radii $\leq 15'$
- RD757 - Sidewalk Ramp Placement Options Curb Radii $> 15'$
- RD759 - Truncated Dome Detectable Warning Surface Details & Locations
- RD770 - Pedestrian Handrail
- RD771 - Pedestrian Handrail Details

- RD1005 - Check Dams
- RD1010 - Inlet Protection (Type 1, 2 & 3)
- RD1035 - Sediment Barrier (Type 3)
- RD1040 - Sediment Fence, Supported; Sediment Fence, Unsupported
- RD1055 - Matting

- TM200 - Sign Installation Details
- TM201 - Miscellaneous Sign Placement Details
- TM211 - Sign Details US & Interstate Route Shields
- TM212 - Signing Details Oregon Route Signs
- TM221 - Signing Details Milepost Markers
- TM222 - Installation Details Milepost Markers Posts
- TM223 - Conventional Roads Directional Sign Layout Street Name Signs
- TM230 - Mounting Details For Removable Legend (4" Through 8" Letters/Numbers)
- TM233 - Mounting Details For Removable Legend (Various Arrow Sizes)

- TM450 - Mast Arm Pole Details
- TM455 - Temporary Signal Details
- TM457 - Vehicle, Pedestrian Signal And Push Button Mounting Option Details
- TM458 - Pedestrian Ramp Placement Details
- TM460 - Vehicle Signal Details
- TM462 - Adjustable Signal Head Mounting Details
- TM465 - Overhead Sign, Fire Preemption And Photoelectronic Control Details
- TM467 - Pedestrian Signal And Pedestrian Push Button Details
- TM470 - Color Code Charts
- TM472 - Traffic Signal Junction Boxes/Hand Holes
- TM482 - Controller Cabinet And Foundation Details
- TM485 - Service Cabinets And Service Cabinet Wiring Details
- TM488 - Terminal Cabinet Detail

- TM500 - Pavement Marking Standard Detail Blocks
- TM501 - Pavement Marking Standard Detail Blocks
- TM502 - Pavement Marking Standard Detail Blocks
- TM503 - Pavement Marking Standard Detail Blocks
- TM515 - Pavement Markers
- TM517 - Recessed Pavement Markers
- TM521 - Durable Pavement Markings Method "A" & Method "B" Surface & Groove Installed Non-Profiled
- TM530 - Intersection Pavement Markings (Crosswalk, Stop Bar & Bike Lane Stencil)
- TM531 - Turn Arrow Marking Details
- TM539 - Median and Left Turn Channelization Details
- TM560 - Alignment Layout: General
- TM570 - Traffic Delineators
- TM571 - Traffic Delineators Steel Post Details
- TM576 - Traffic Delineator Installation For Non-Freeways

- TM602 - Triangular Base Breakaway Sign Support (Multi-Directional Slip Base Design)
- TM629 - Slip Base & Fixed Base Luminaire Supports (Details & Design Criteria)
- TM635 - Breakaway Sign and Luminaire Supports (Location Guidelines)
- TM650 - Traffic Signal Supports (Details & Design Criteria)
- TM651 - Traffic Signal Supports (Notes And Reactions)
- TM652 - Traffic Signal Supports (Steel Details)
- TM653 - Traffic Signal Supports (Foundation Requirements)
- TM670 - Wood Post Sign Supports
- TM671 - 3 Second Gust Wind Speed Map
- TM675 - Extruded Aluminum Panels
- TM676 - Sign Attachments
- TM677 - Sign Mounts
- TM678 - Secondary Sign Mounting Details
- TM680 - Signal Pole Mounts

- TM800 - Tables, Abrupt Edge And PCMS Details
- TM810 - Temporary Pavement Markings
- TM820 - Temporary Barricades
- TM821 - Temporary Sign Supports
- TM841 - Intersection Work Zone Details
- TM842 - Signalized Intersection Details
- TM843 - Multi-Lane Signalized Intersection Details

No R/W Map

INDEX OF SHEETS, CONT.	
SHEET NO.	DESCRIPTION
2, 2A	Typical Sections
2B thru 2B-3	Details
2C thru 2C-3	Traffic Control Plan
2D	Pipe Data Sheet
3, 4	General Construction
3A	General Construction Notes
3B, 3C, 4A	Profiles
GEO/HYDRO	
GA, GA-2	Erosion Control
GJ, GJ-2	Storm Water Details
PERMANENT PAVEMENT MARKINGS	
ST thru ST-3	Striping Plan
PERMANENT SIGNING	
S-14811 thru S-14816	Signing Plan
TRAFFIC SIGNALS	
17706 thru 17716 & 18076	Signal Plans



No.	DATE	REVISIONS	BY
1	12-03-14	Added 18076, TM455, TM677	JMS

Standard Drawings located on the web at:
http://www.oregon.gov/ODOT/HWY/ENGSERVICES/standard_drawings_home.shtml


OR62 & OR140 INTERSECTION		
CRATER LAKE & LAKE OF THE WOODS HIGHWAY JACKSON COUNTY		
FEDERAL HIGHWAY ADMINISTRATION	PROJECT NUMBER	SHEET NO.
OREGON DIVISION	HSIP-S270(038)	1A

2/137

Sec. 20, T. 36S, R. 1W, W.M.

47V-127

See sheet 3A for General Construction Notes.
See sheet 3B for "LW" Profile.
See sheet 3C for "CL" Profile.

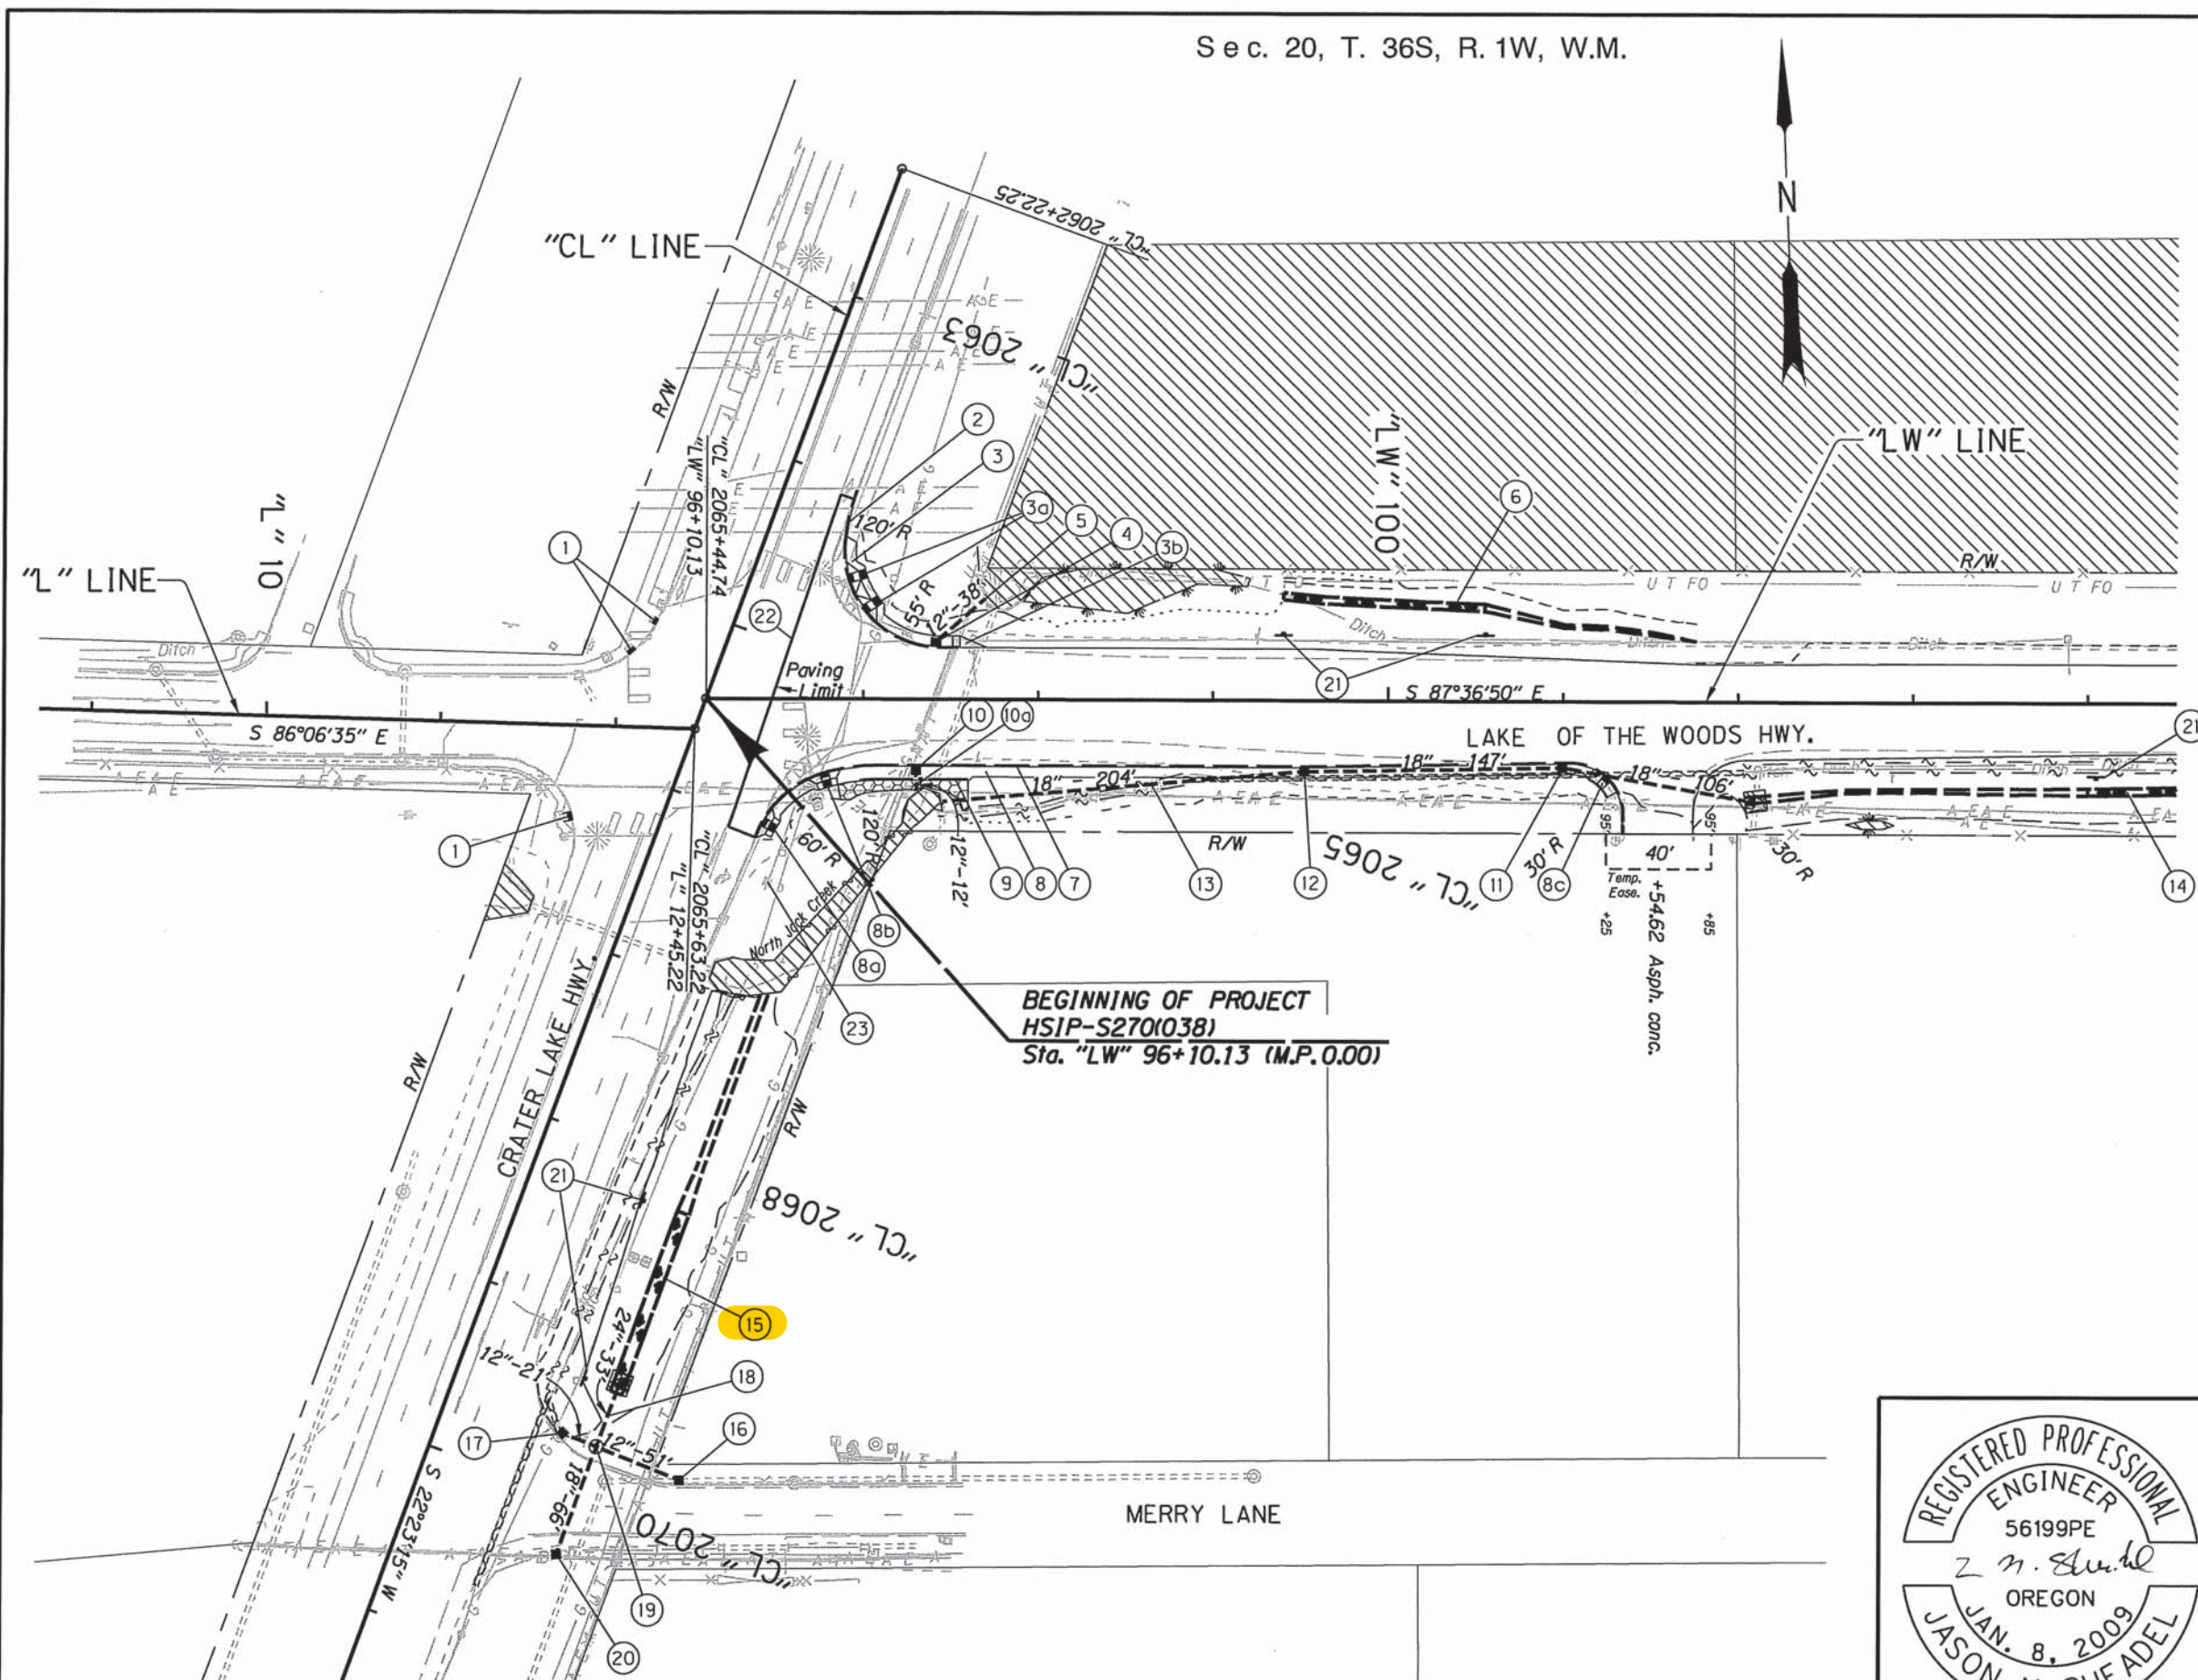

- Notes:
1. Station/Offset/Elevation callouts for type "CG-3" inlets are to top face of curb.
 2. Station/Offset/Elevation callouts for type "G2-MA" inlet and manhole are to center of structure.
 3. Station/Offset callouts for sidewalk ramps are to the center of the ramp at the back of curb.


- Remove extg. pipe shown thus:
- No Work/No Entry Area shown thus:
- Riprap Pad shown thus:
- Stone Embankment shown thus:

REGION 3 - TECHNICAL CENTER	
OR62 & OR140 INTERSECTION CRATER LAKE & LAKE OF THE WOODS HIGHWAY JACKSON COUNTY	
Designed By - Jason Sheadel Reviewed By - Brian Sheadel Drafted By - Judy Hardin	
GENERAL CONSTRUCTION	SHEET NO. 3

REGISTERED PROFESSIONAL ENGINEER
56199PE
JAN. 8, 2009
JASON N. SHEADEL
EXPIRES: JUNE 30, 2016

Sec. 20, T. 36S, R. 1W, W.M.

47V-127

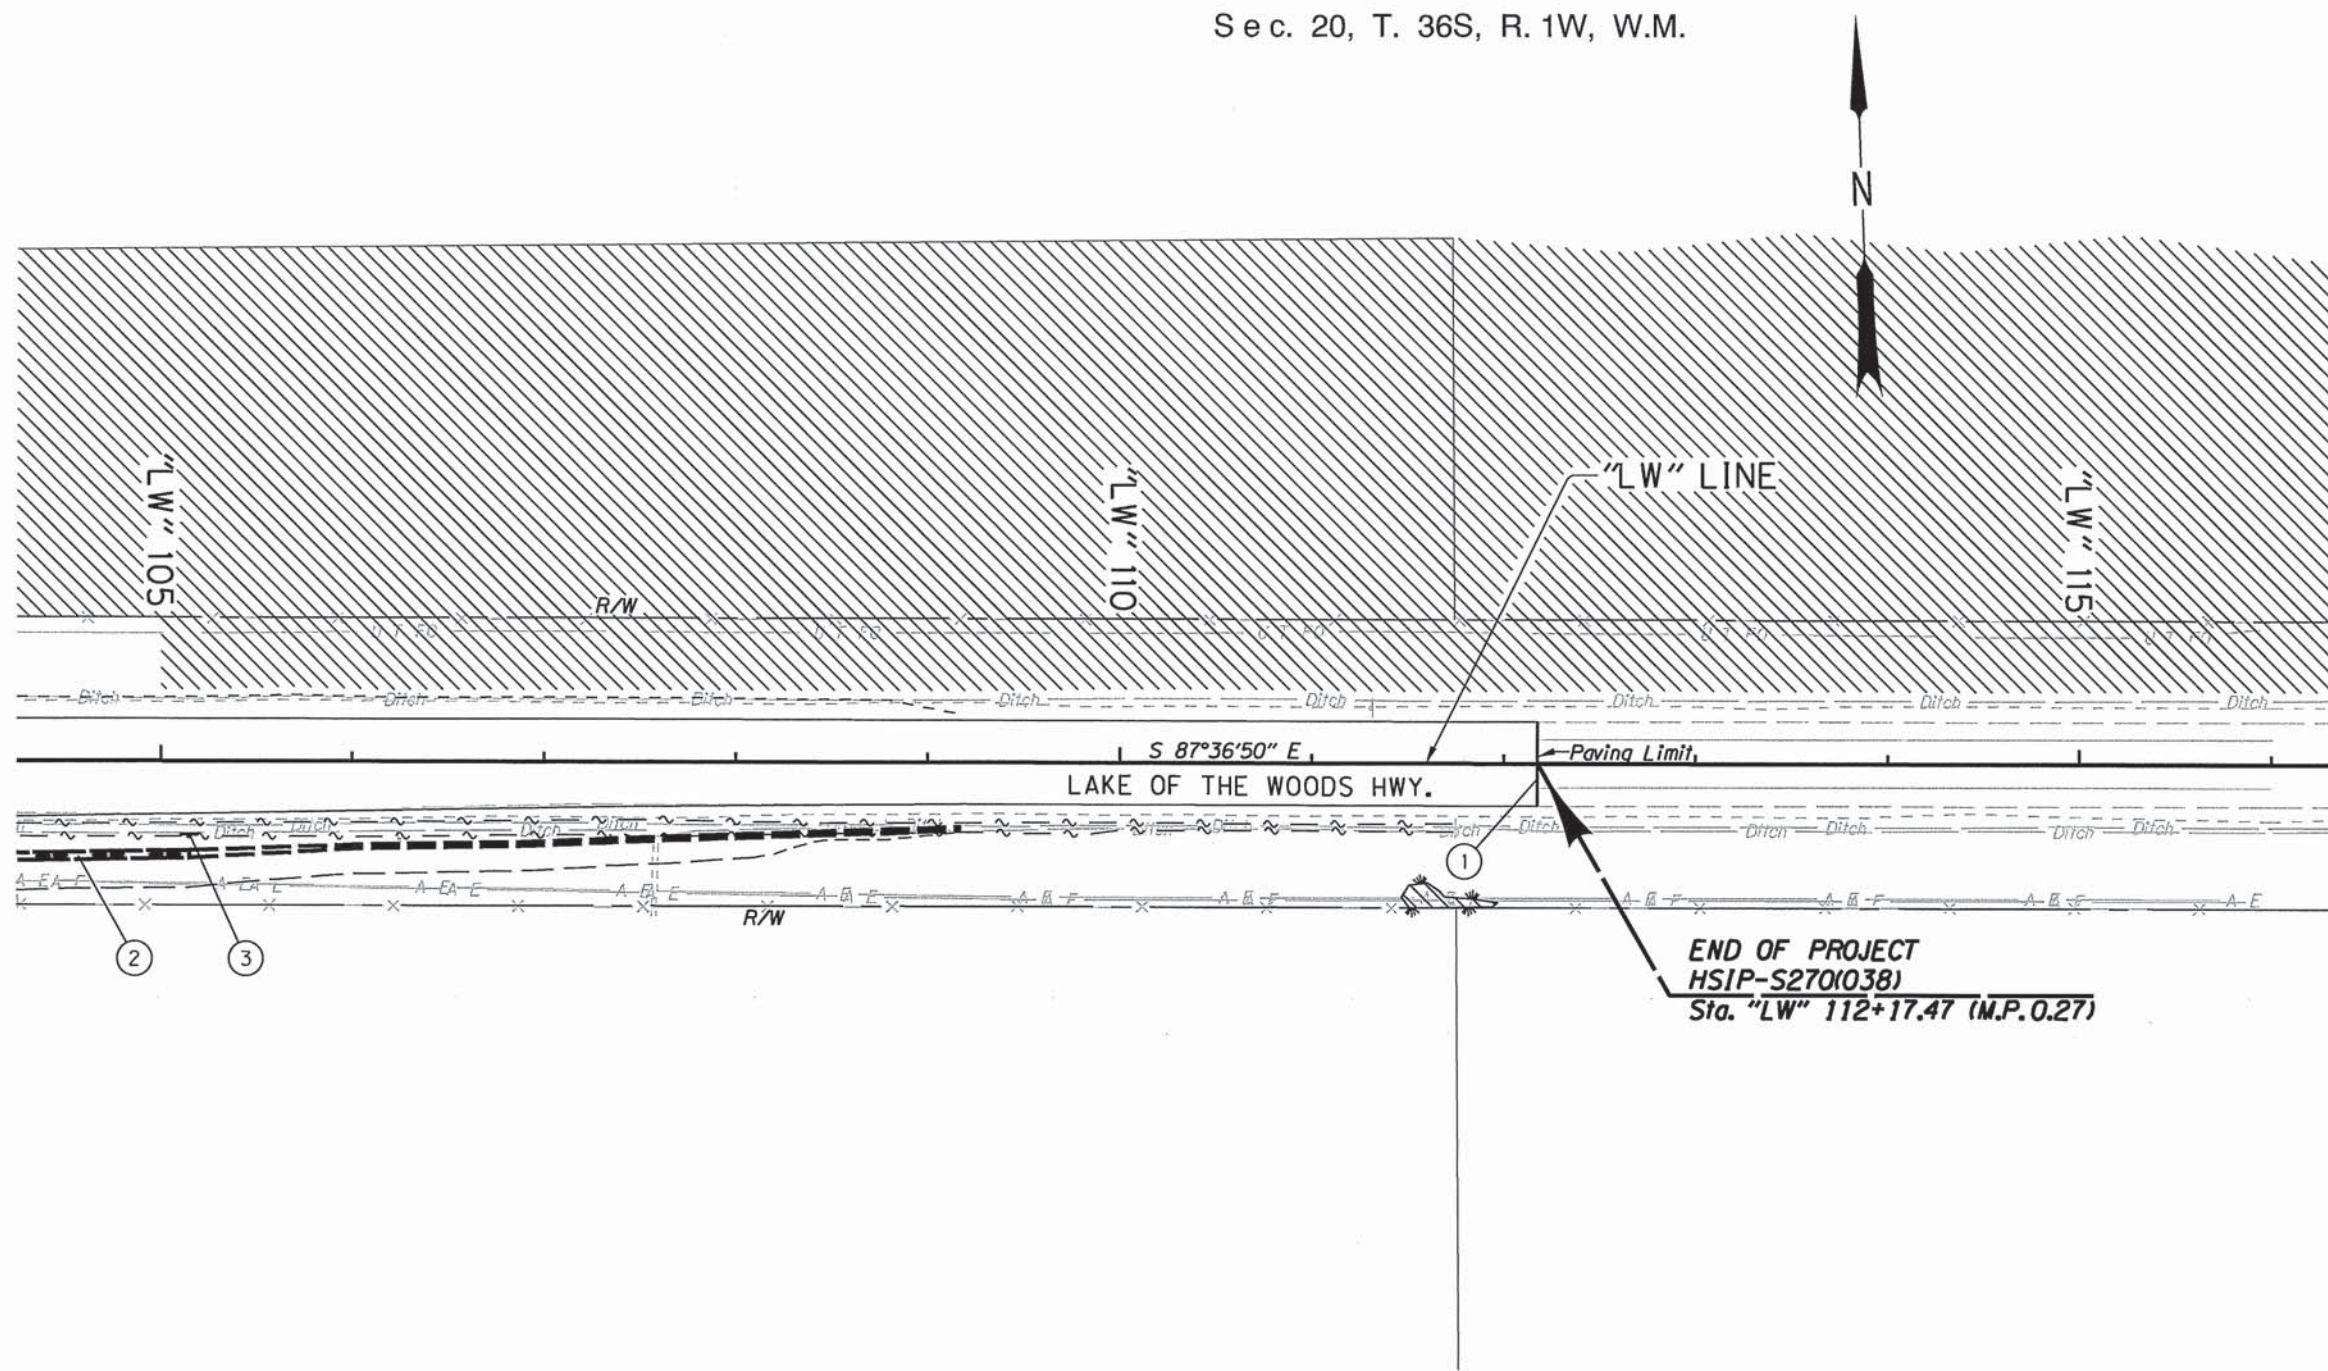

- ① Const. asphalt conc. pvmt. match
- ② Const. water quality swale "S"
(See sh. 3a, note 14)
- ③ Inst. field facility marker, Type "S2"
(See sh. 3A, note 21)

Note:
No work area shown to the north of Hwy. 140 is located just north of the extg. roadside ditch.
No Work/No Entry Area shown thus:

OREGON DEPARTMENT OF TRANSPORTATION	
REGION 3 - TECHNICAL CENTER	
OR62 & OR140 INTERSECTION CRATER LAKE & LAKE OF THE WOODS HIGHWAY JACKSON COUNTY	
Designed By - Jason Sheadel Reviewed By - Brian Sheadel Drafted By - Judy Hardin	
GENERAL CONSTRUCTION	SHEET NO. 4

REGISTERED PROFESSIONAL ENGINEER
56199PE
Jason N. Sheadel
OREGON
JAN. 8, 2009
JASON N. SHEADEL
EXPIRES: JUNE 30, 2016

① Remove extg. conc. sidewalk ramp landing
Const. P.C. conc. sidewalk perpendicular ramp landing
(See drg. nos. RD720, RD755, RD759)

② Sta. "CL" 2064+04, Lt. to Sta. "LW" 97+55, Lt.
Const. conc. curb and gutter
(See drg. no. RD700)

③ Sta. "CL" 2064+30, Lt. to Sta. "LW" 97+44, Lt.
Const. P.C. conc. sidewalk

③a Sta. "CL" 2064+52, 53.4' Lt. / Sta. "LW" 97+01, 51.0' Lt.
Const. perpendicular sidewalk ramps (Option G)
(See drg. no. RD757)

③b Sta. "LW" 97+44, 30.0' Lt. to Sta. "LW" 97+70, 30.0' Lt.
Const. sidewalk ramp at end of walk (Option F)
(See drg. no. RD756)

④ Sta. "LW" 97+41, 29.6' Lt.
Const. type "CG-3" inlet, 1309.84
Tamperproof cover Option 1 top
F.L. (12" out)=1304.00
(See drg. nos. RD356, RD371, RD372, RD700)

⑤ Sta. "LW" 97+41, 32.4' Lt. to
Sta. "LW" 97+69.3, 57.3' Lt.
Inst. 12" storm sewer pipe - 38'
5' depth
Sl.=0.0774'/ft.
F.L. (In)=1304.00
F.L. (Out)=1301.90
Connect to extg. box culvert wingwall
(For details, see sht. 2B-2)
(See drg. no. RD300)

⑥ Sta. "LW" 99+40 to Sta. "LW" 100+55, Lt.
Const. water quality swale "N"
(For details, see sht. GJ)

⑦ Sta. "CL" 2066+09, Lt. to Sta. "LW" 101+35, Rt.
Const. conc. curb and gutter
Const. curb ending at driveway
(See drg. no. RD700)

⑧ Sta. "CL" 2066+09, Lt. to Sta. "LW" 101+31, Rt.
Const. P.C. conc. sidewalk

⑧a Sta. "CL" 2065+99.5, 55.1' Lt.
Const. perpendicular sidewalk ramp (Option G)

⑧b Sta. "LW" 96+78, 42.5' Rt.
Const. perpendicular sidewalk ramp (Option G)

⑧c Sta. "LW" 101+25, 43.7' Rt.
Const. parallel sidewalk ramp
(See drg. no. RD755)

⑨ Sta. "LW" 96+98.5 to Sta. "LW" 97+60.0, Rt.
Const. three rail handrail, on structure (bolt down) - 62'
(See drg. nos. RD770, RD771)

⑩ Sta. "LW" 97+30.0, 37.5' Rt.
Const. type "CG-3" inlet, 1309.36
Tamperproof cover Option 1 top
F.L. (12" out)=1304.50

⑩a Sta. "LW" 97+30.0, 40.4' Rt. to
Sta. "LW" 97+30.7, 52.3' Rt.
Inst. 12" storm sewer pipe - 12'
5' depth
Sl.=0.1667'/ft.
F.L. (In)=1304.50
F.L. (Out)=1302.50
Connect to extg. box culvert wingwall
(For details, see sht. 2B-2)

⑪ Sta. "LW" 100+99.6, 37.7' Rt. to
Sta. "LW" 102+04.1, 56.0' Rt.
Const. type "CG-3" inlet, 1312.04, 34.9' Rt.
Tamperproof cover Option 1 top
F.L. (W)=1307.0
F.L. (E)=1307.0
Inst. 18" storm sewer pipe - 106'
5' depth
Const. paved end slope (1:4) - 35 sq. ft.
Inst. 18" sloped end section
Inst. riprap protection pad (Class 50) - 2 C.Y.
Sl.=0.0142'/ft.
F.L. (In)=1308.50
F.L. (Out)=1307.00
(See drg. nos. RD302, RD316, RD317, RD318, RD319, RD320)
(For details, see sht. 2B-3)

⑫ Sta. "LW" 99+52.4, 40.3' Rt. to
Sta. "LW" 100+99.6, 37.6' Rt.
Const. type "CG-3" inlet, 1310.66, 37.5' Rt.
Tamperproof cover Option 1 top
F.L. (W)=1304.90
F.L. (E)=1304.90
Inst. 18" storm sewer pipe - 147'
5' depth
Sl.=0.0142'/ft.
F.L. (In)=1307.00
F.L. (Out)=1304.90

⑬ Sta. "LW" 97+45.6, 58.2' Rt. to
Sta. "LW" 99+52.4, 40.3' Rt.
Inst. 18" storm sewer pipe - 204'
5' depth
Sl.=0.0142'/ft.
F.L. (In)=1304.90
F.L. (Out)=1302.00
Connect to extg. box culvert wingwall
(For details, see sht. 2B-2)

⑭ Sta. "LW" 104+00 to Sta. "LW" 105+15, Rt.
Const. water quality swale "S"
(For details, see sht. GJ)

⑮ Sta. "CL" 2068+25 to Sta. "CL" 2069+35, Lt.
Const. water quality swale "CL"
(For details, see sht. GJ)

⑯ Sta. "CL" 2069+72.0, 142.0' Lt.
Const. type "CG-3" inlet, 1308.23 - Connect to extg. 12" pipe
Tamperproof cover, - Option 1 top
F.L. (In - E) - Est. 1307 (Field verify)
F.L. (Out - W) - 1306.00
Inst. 12" storm sewer pipe - 51'
5' depth
Sl.=0.0100'/ft. (to manhole note 19)

⑰ Sta. "CL" 2069+69.5, 68.2' Lt.
Remove extg. "CG-3" inlet
Const. type "CG-3" inlet, 1306.80 (field verify extg. curb)
Tamperproof cover, Option 1 top
F.L. (Out - E) - 1304.50
Inst. 12" storm sewer pipe - 21'
5' depth
Sl.=0.0100'/ft. (to manhole note 19)

⑱ Sta. "CL" 2069+67.7, 90.0' Lt. to
Sta. "CL" 2069+35, 90' Lt.
Inst. 24" storm sewer pipe - 33'
5' depth
Const. paved end slope (1:4) - 35 sq. ft.
Inst. 24" sloped end section
Inst. riprap protection pad (Class 50) - 2 C.Y.
Sl.=0.0050'/ft.
F.L. (In)=1302.97
F.L. (Out)=1302.80


⑲ Sta. "CL" 2069+67.7, 90.0' Lt. to
Sta. "CL" 2070+33.2, 90.0' Lt.
Const. large precast manhole, 72" - 1307.45
Tamperproof cover
F.L. (In - S)=1302.97
F.L. (In - W)=1304.33
F.L. (Out - N)=1302.97
F.L. (In - E)=1305.49
Inst. 18" storm sewer pipe - 66'
5' depth
Trench resurfacing - 23 sq. yd.
Sl.=0.0025'/ft.
F.L. (In)=1303.14
F.L. (Out)=1302.97
(See drg. nos. RD336, RD346, RD354, RD356.)

⑳ Sta. "CL" 2070+33.2, 90.0' Lt.
Const. type "G2-MA" modified inlet, 1305.00
w/ 12" sump
F.L. (Out)=1303.14
(Slope sides of G2-MA to match rock shoulder
and ditch 1:4 side slopes)
(See drg. nos. RD364, RD365)

㉑ Inst. field facility marker, Type "S2"
(For location and details, see sht GJ & GJ-2)

㉒ Const. asphalt conc. pvmt. match
(See drg. no. RD610)



㉓ Sta. "CL" 2066+31, 69' Lt.
Remove extg. wood pole

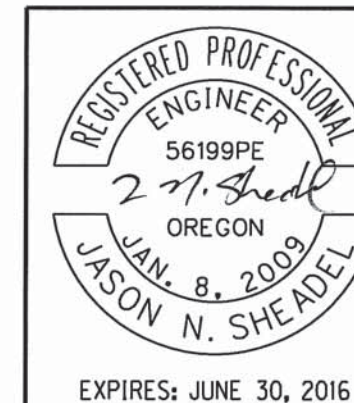


OREGON DEPARTMENT OF TRANSPORTATION	
REGION 3 - TECHNICAL CENTER	
OR62 & OR140 INTERSECTION CRATER LAKE & LAKE OF THE WOODS HIGHWAY JACKSON COUNTY	
Designed By - Jason Sheadel Reviewed By - Brian Sheadel Drafted By - Judy Hardin	
NOTES	SHEET NO. 3A

"CL" LINE

47V-127

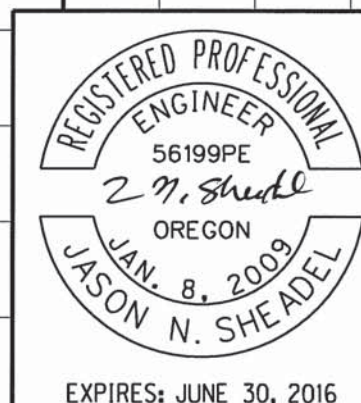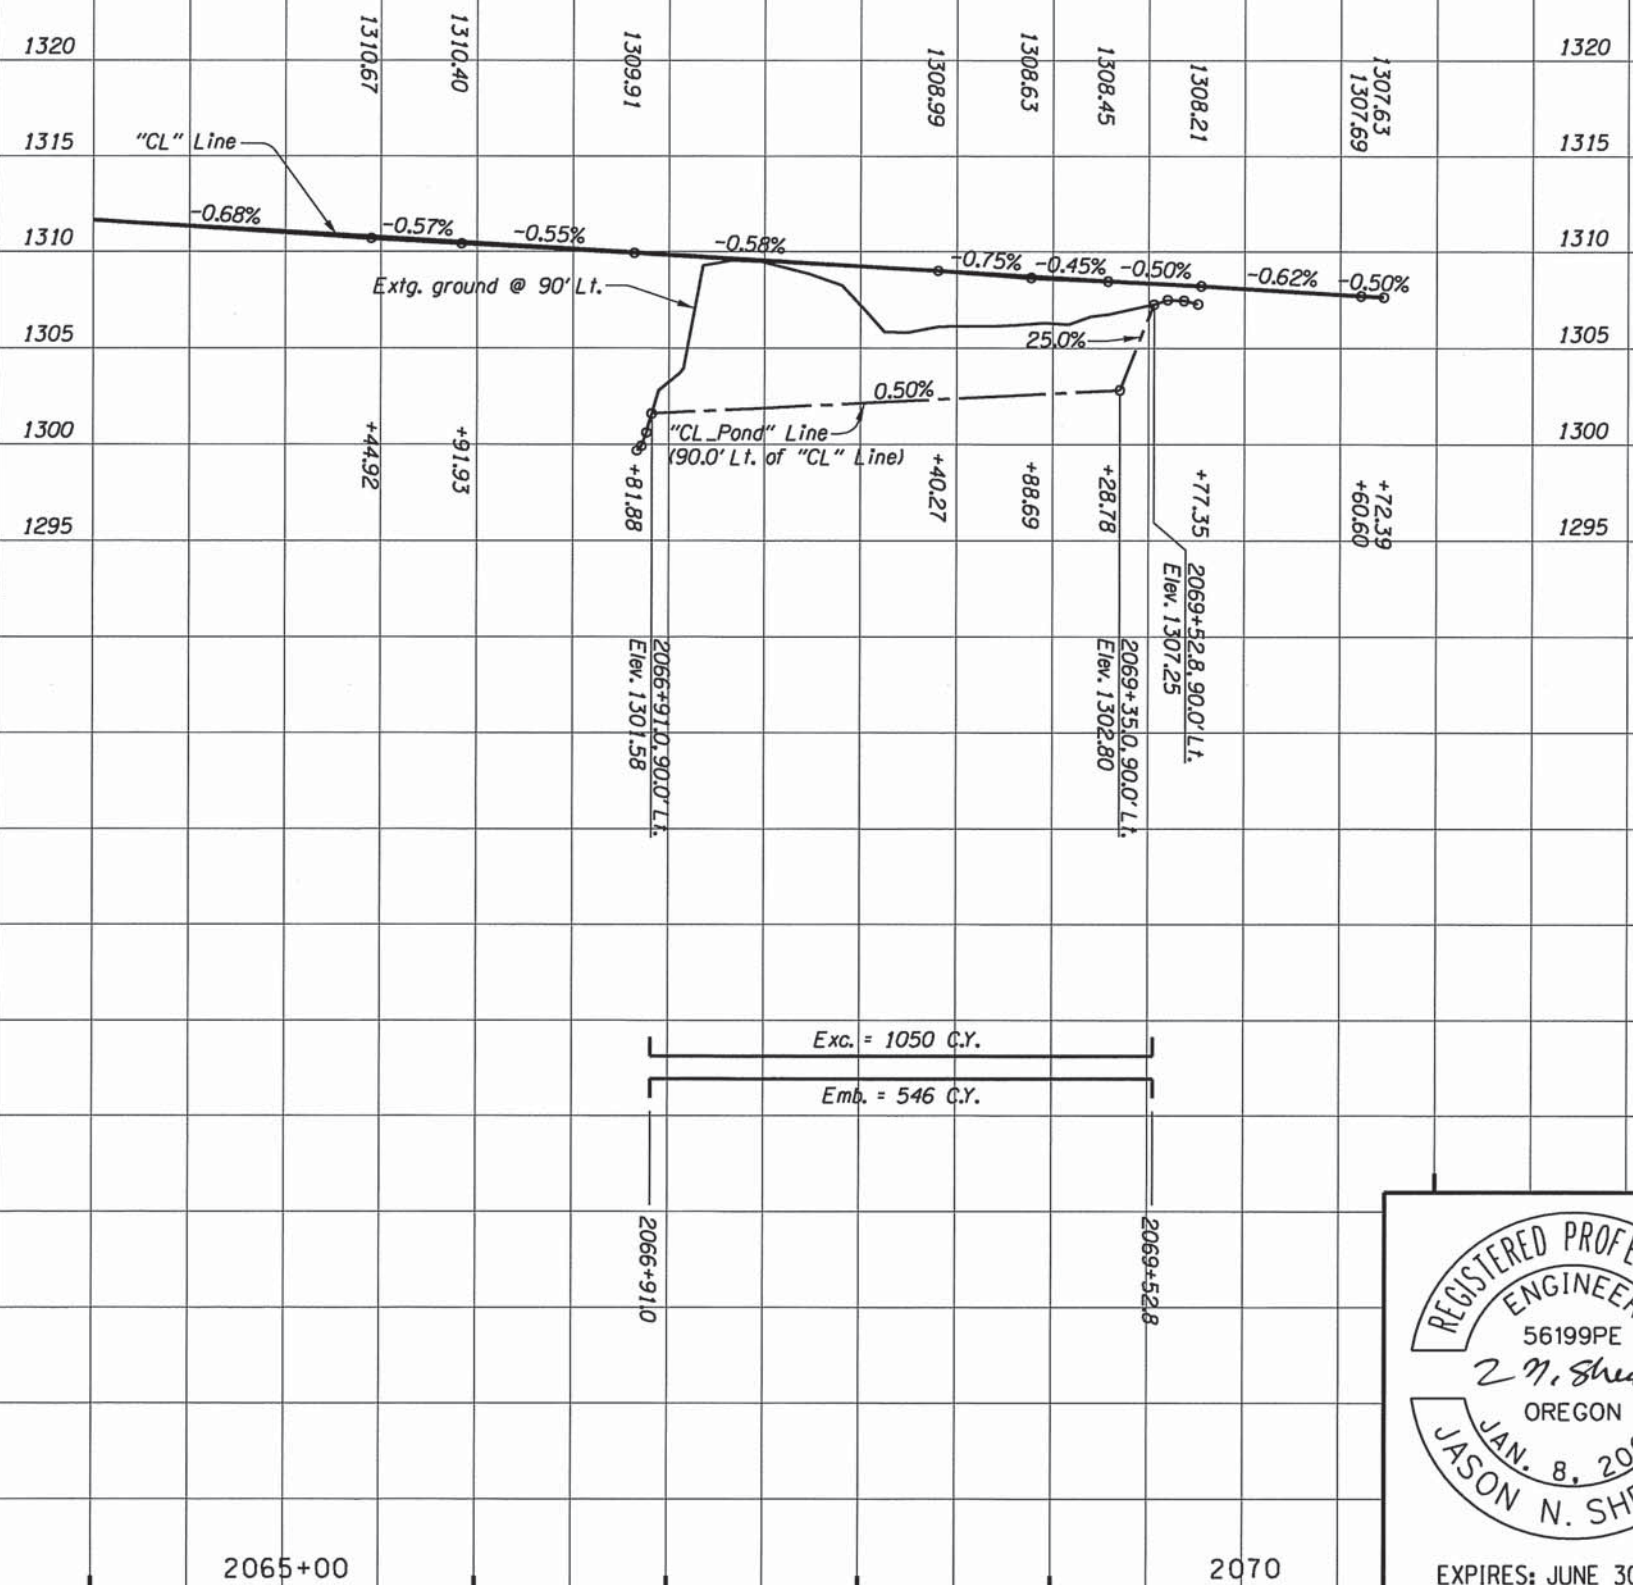

OREGON DEPARTMENT OF TRANSPORTATION	
REGION 3 - TECHNICAL CENTER	
OR62 & OR140 INTERSECTION CRATER LAKE & LAKE OF THE WOODS HIGHWAY JACKSON COUNTY	
Designed By - Jason Sheadel Reviewed By - Brian Sheadel Drafted By - Judy Hardin	
PROFILE	SHEET NO. 3C

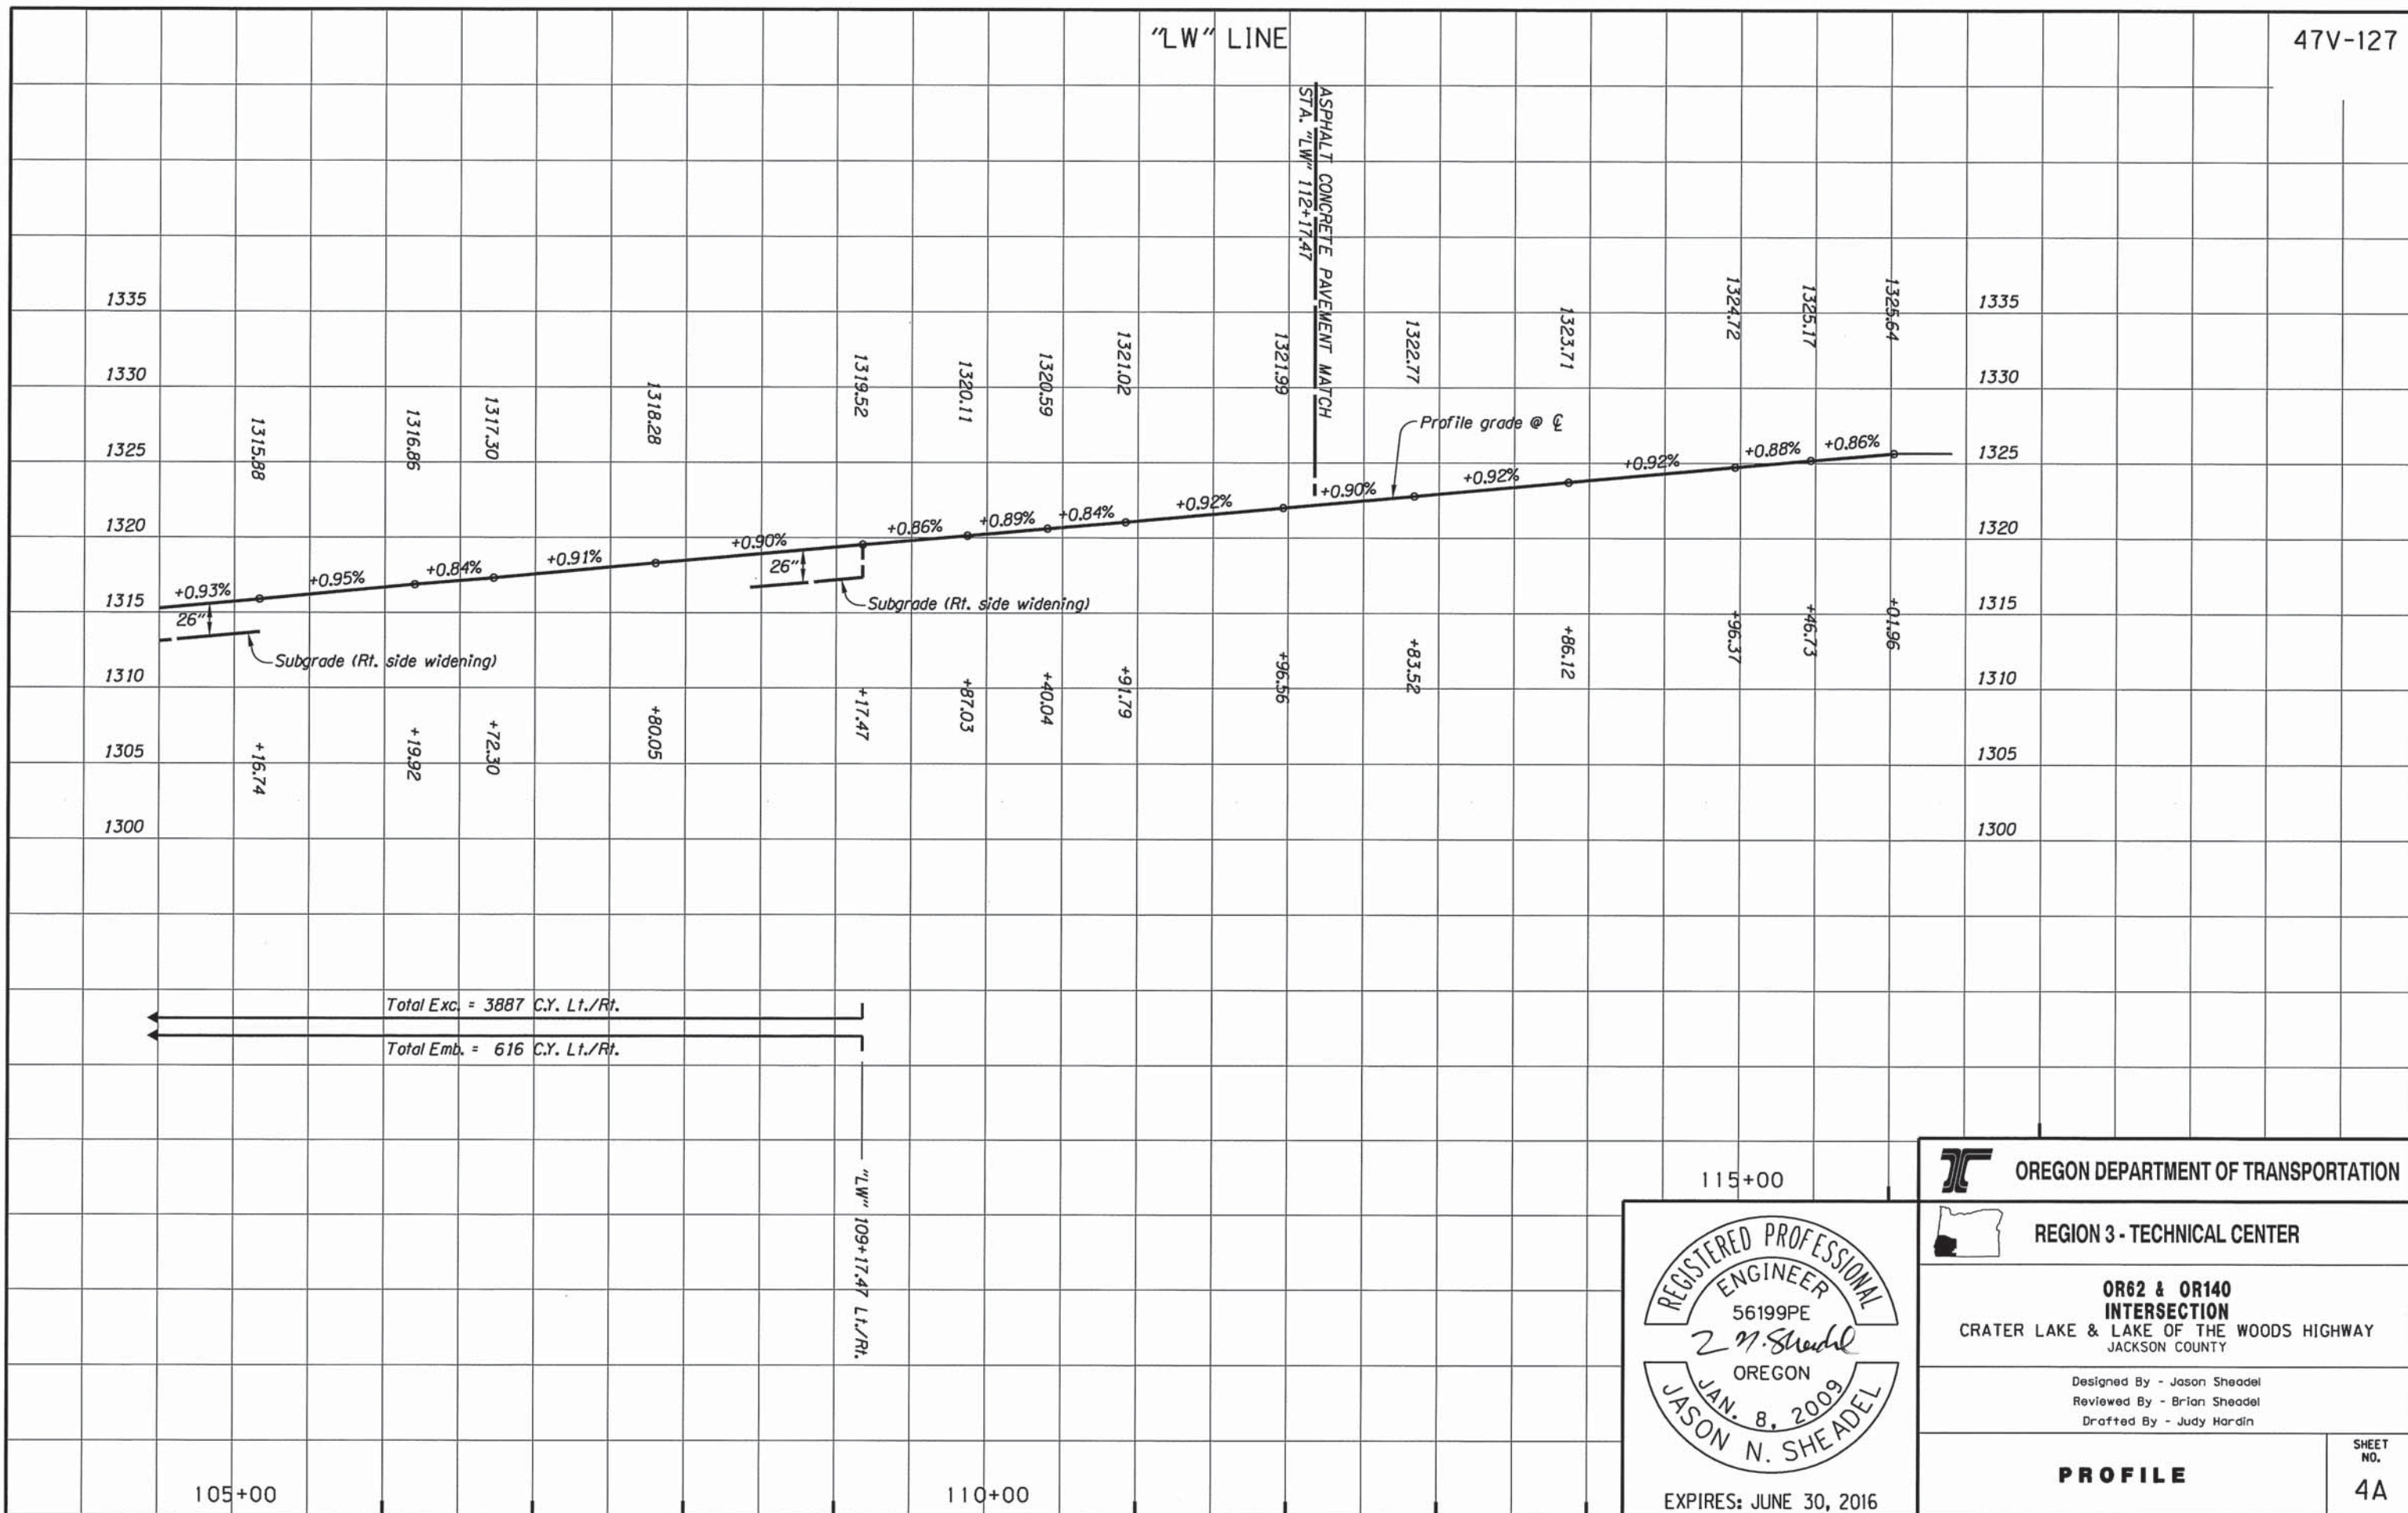

REGISTERED PROFESSIONAL
 ENGINEER
 56199PE
2 M. Sheadel
 OREGON
 JAN. 8, 2009
 JASON N. SHEADEL
 EXPIRES: JUNE 30, 2016

OREGON DEPARTMENT OF TRANSPORTATION

REGION 3 - TECHNICAL CENTER





OR62 & OR140 INTERSECTION
 CRATER LAKE & LAKE OF THE WOODS HIGHWAY
 JACKSON COUNTY

Designed By - Jason Sheadel
 Reviewed By - Brian Sheadel
 Drafted By - Judy Hardin

PROFILE

SHEET NO. 4A

WATER QUALITY SWALE DETAILS

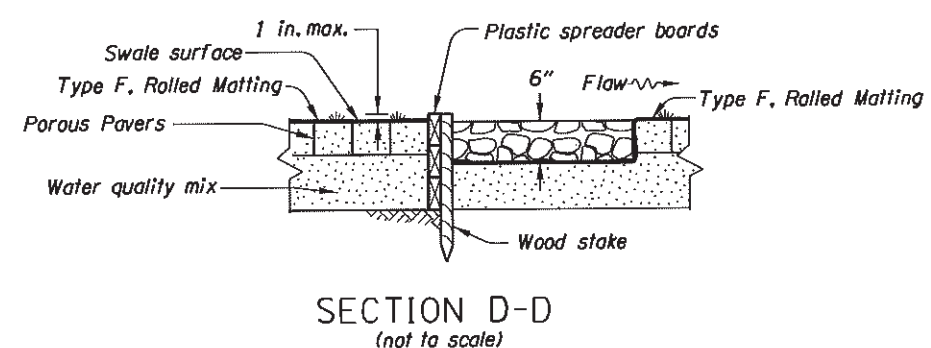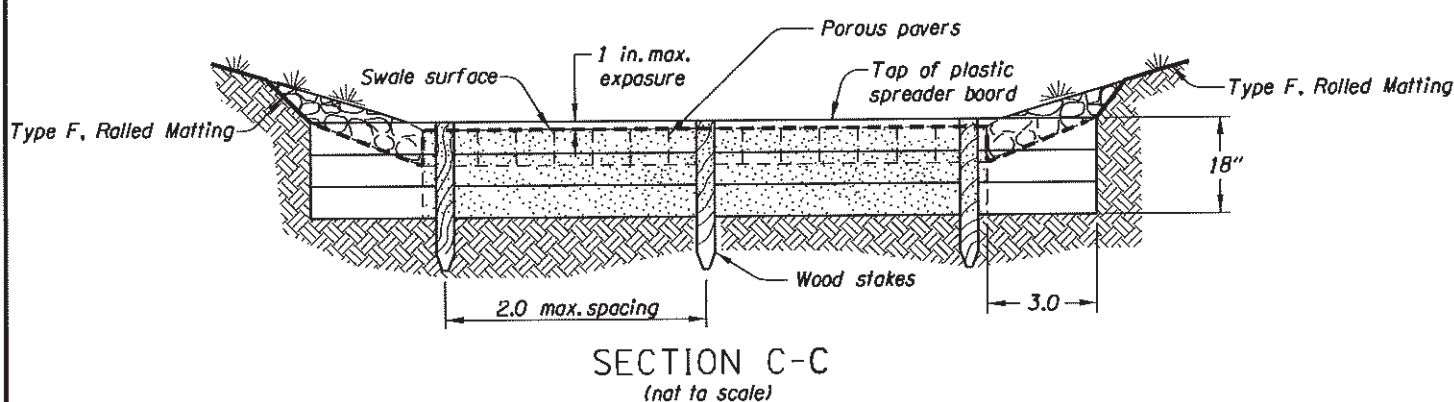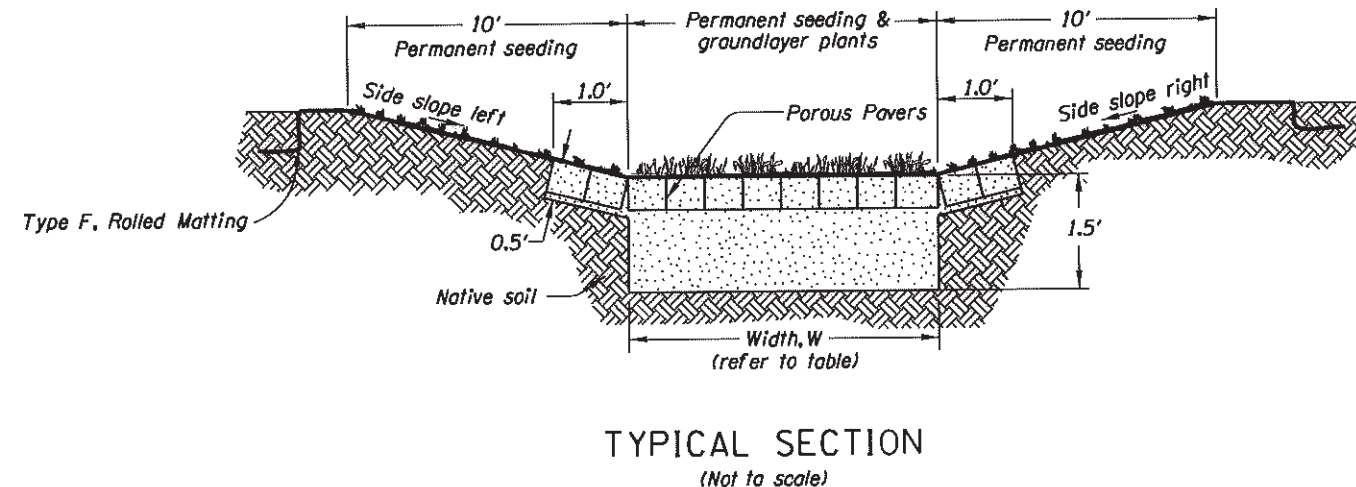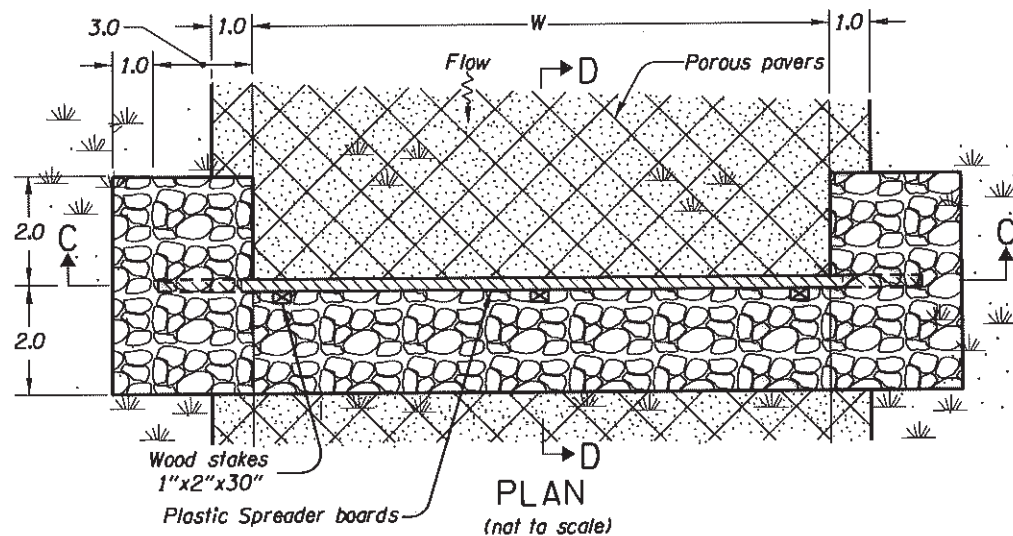


PLASTIC BOARD FLOW SPREADER DETAIL

Facility Name	Plan Sheet & Note #	STA. To STA.	W (ft.)	Longitudinal Slope (ft./ft.)	Side Slope Left (V:H)	Side Slope Right (V:H)	DFI
Water quality Swale "N"	Sheet 3, note 6	"LW" 99+40.00 To "LW" 100+55.00, Lt.	4.0	0.01	1:6	1:4	DO0847
Water quality Swale "S"	Sheet 3, note 14	"LW" 104+00.00 To "LW" 105+15.00, Rt.	4.0	0.01	1:4	1:4	DO0848
Water quality Swale "CL"	Sheet 3, note 15	"CL" 2068+25.00 To "CL" 2069+35.00, Lt.	7.0	0.005	1:4	1:4	DO0846


Scientific Name	Common Name	Type	Spacing	Quantity (each)		
				Swale "N"	Swale "S"	Swale "CL"
Carex Densa	Dense Sedge	Plugs	1 per 2 sq. ft.	230	230	385
Eleocharis Palustris	Common Spikerush	Plugs	1 per 2 sq. ft.	230	230	385
Juncus Tenuis	Poverty Rush	Plugs	1 per 2 sq. ft.	230	230	385
Mimulus Guttatus	Seep Monkeyflower	Plugs	1 per 2 sq. ft.	230	230	385

- NOTES:
1. Construct spreader boards level.
 2. Extend spreader boards a minimum of 3 feet into side slopes.
 3. Reinforce side slopes at flow spreader locally with 1 1/2"-3/4" granular drain backfill material.
 4. Fasten wood stakes to spreader boards with 2 1/2" galvanized wood screws every 2" (minimum).
 5. Place plastic board flow spreader at beginning and end of swale and every 50 feet throughout length of biofiltration swale.
 6. Install matting according to RD1055 channel application. Omit check slats.
 7. Install Type S2 markers at beginning and end of biofiltration swale. See sheet GJ-2 for details.

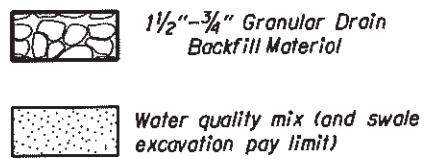

Note: All dimensions are in feet unless otherwise noted.

No.	DATE	REVISIONS	BY
1	11-24-14	Changed Stationing Rt. to Lt.	DC

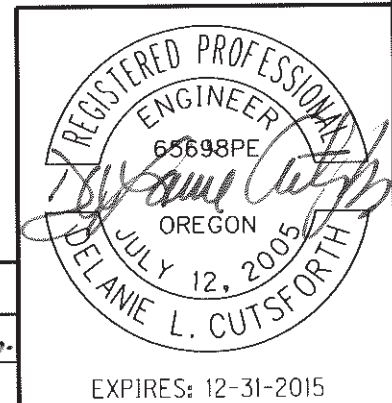

OREGON DEPARTMENT OF TRANSPORTATION

REGION 3 - TECHNICAL CENTER


OR62 & OR140 INTERSECTION
CRATER LAKE & LAKE OF THE WOODS HIGHWAY
JACKSON COUNTY

Designed By - DeLanie Cutsforth
Reviewed By - Wade Haladay
Drafted By - DeLanie Cutsforth


STORMWATER DETAILS

SHEET NO. GJ

STORMWATER DRAINAGE FACILITY IDENTIFICATION

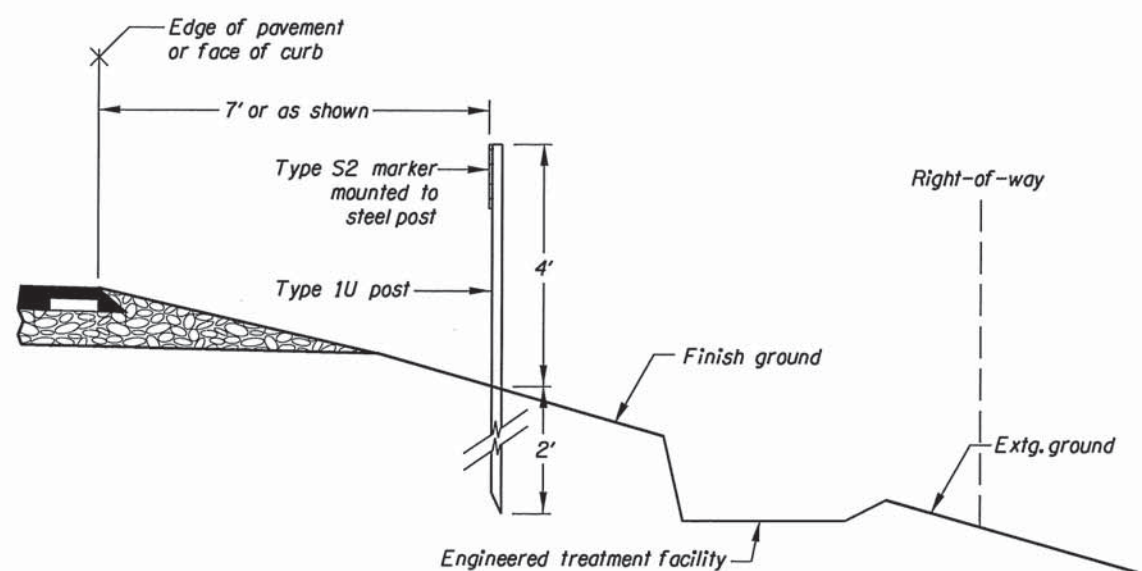


SECTION A-A

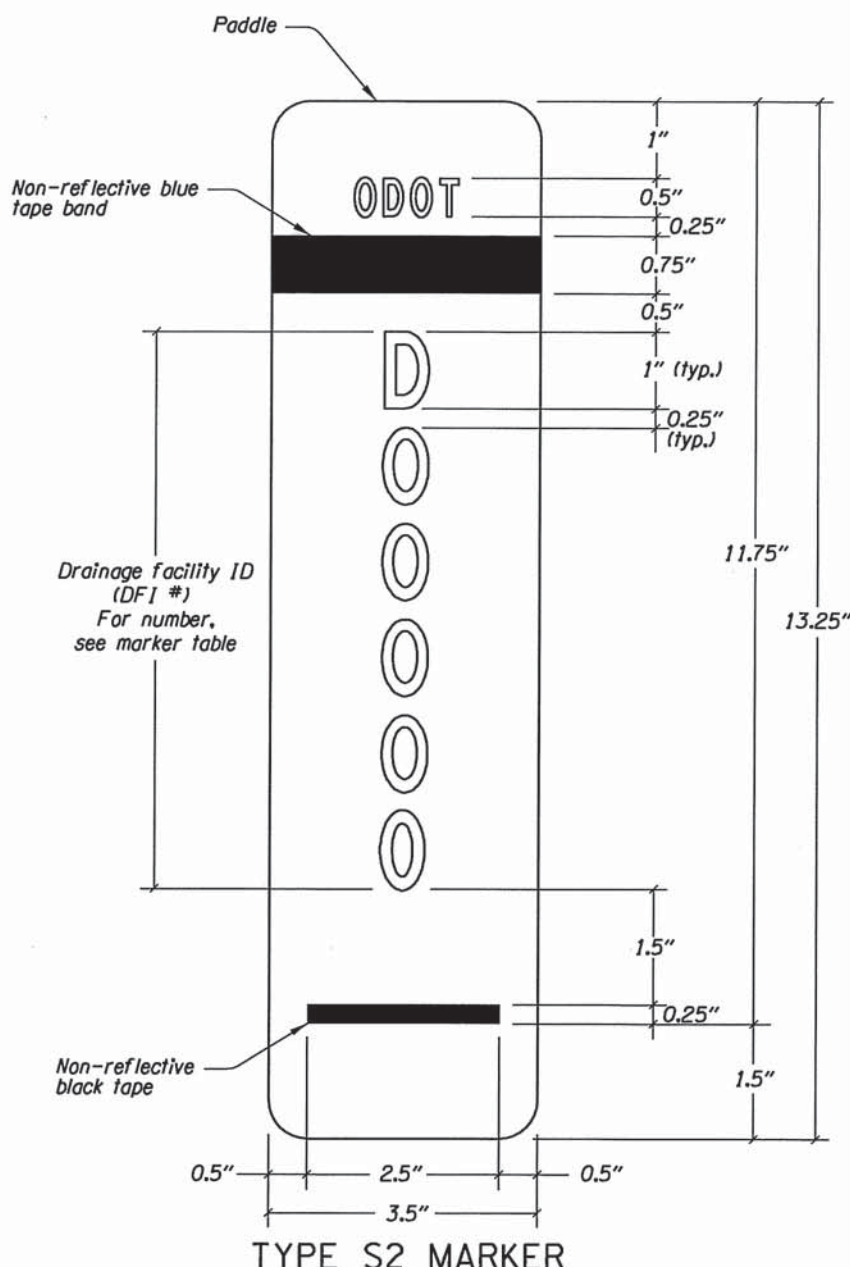

TYPE S2 MARKER


MARKER TABLE

FACILITY NAME	FACILITY LOCATION	DFI #	TYPE S2 MARKER	
			BEGIN	END
Water Quality Swale "N"	"LW" 99+40.00	D00847	✓	
Water Quality Swale "N"	"LW" 100+55.00	D00847		✓
Water Quality Swale "S"	"LW" 104+00.00	D00848	✓	
Water Quality Swale "S"	"LW" 105+15.00	D00848		✓
Water Quality Swale "CL"	"CL" 2068+25.00	D00846	✓	
Water Quality Swale "CL"	"CL" 2069+35.00	D00846		✓

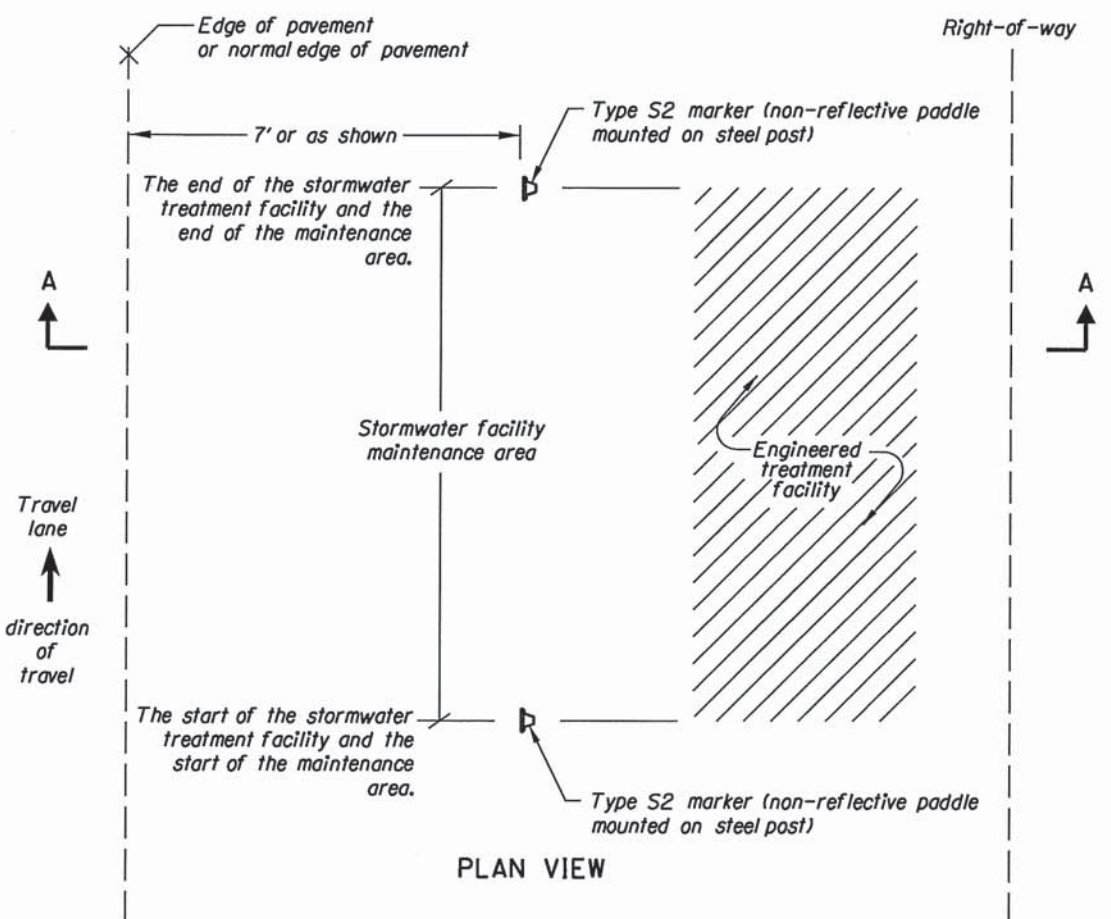

INSTALLATION DETAIL

- Notes:
- Paddle:**
 - Aluminum sheet, nominal thickness 0.050"
 - White non-reflective background
 - Mount paddle to one (1) type 1U steel post using 3/16" diameter aluminum blind rivets and washers. See standard drawing TM570 detail labeled "Steel Posts" for mounting a traffic target. Install paddle onto Type 1U steel post using same hole pattern.
 - Text and numbers are type C font in non-reflectorized black
 - Band is non-reflective blue tape
 - Do not mount paddle to other highway signing posts
 - Install paddle parallel to travel lane
 - Prepare paddle for each "DFI" noted in the marker table
 - Steel Posts:**
 - See drg. no. TM571 for type 1U steel post dimensions
 - Place 7 feet from edge of pavement or as directed.**
 - See marker table for installation locations.**

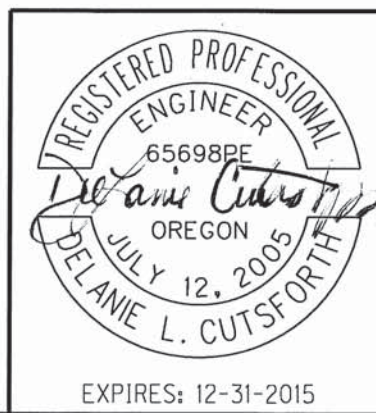

OREGON DEPARTMENT OF TRANSPORTATION

REGION 3 - TECHNICAL CENTER

OR62 & OR140 INTERSECTION
CRATER LAKE & LAKE OF THE WOODS HIGHWAY
JACKSON COUNTY

Designed By - DeLanie Cutsforth
Reviewed By - Wade Holaday
Drafted By - DeLanie Cutsforth

STORMWATER DETAILS

SHEET NO. GJ-2