

OPERATION & MAINTENANCE MANUAL

DFI No. : D00872

**Facility Type: Modified Media Filter
Drain (Bioslope)**



[July, 2015]

INDEX

1. IDENTIFICATION..... 1

2. FACILITY CONTACT INFORMATION 1

3. CONSTRUCTION..... 1

4. STORM DRAIN SYSTEM AND FACILITY OVERVIEW 2

5. FACILITY HAZ MAT SPILL FEATURE(S)..... 5

6. AUXILIARY OUTLET (HIGH FLOW BYPASS)..... 5

7. MAINTENANCE REQUIREMENTS..... 5

8. WASTE MATERIAL HANDLING..... 6

APPENDIX A: Operational Plan and Section Drawing(s)

APPENDIX B: ODOT Project Plan Sheets

1. Identification

Drainage Facility ID (DFI): **D00872**
Facility Type: Modified Media Filter Drain (Bioslope)
Construction Drawings: (V-File Number) 48V-038
Location: District: 2C
Highway No.: 171
Mile Post: 11.72; 11.79 (beg./end)
Description:
The facility is located on the north side of OR-224. The modified media filter drain (bioslope) is located east of SE 197th Ave intersection. The facility can be accessed via the shoulder of westbound OR-224.

2. Facility Contact Information

Contact the Engineer of Record (see section 3), Region Technical Center, or Geo-Environmental's Senior Hydraulics Engineer for:

- Operational clarification
- Maintenance clarification
- Repair or restoration assistance

Engineering Contacts:

Region Technical Center Geo-Environmental Unit Manager
(503) 731-8455.

Or

Geo-Environmental Senior Hydraulics Engineer (503) 986-3365.

3. Construction

Engineer of Record: ODOT Designer – Region 1 Tech. Center,
David McDonald P.E., (503) 731-3160

Facility construction: 2015
Contractor: Eagle Elsner

4. Storm Drain System and Facility Overview

Bioslopes are flow-through stormwater treatment facilities incorporated into roadside embankments and placed between pavement and a downstream conveyance system. These facilities utilize physical straining or filtration, sorption, carbonate precipitation, vegetative uptake and microbial degradation to provide stormwater treatment. Bioslopes are recommended for highway application because of their minimal right-of-way requirements and maintenance schedule. Other names for bioslopes that have been used include ecology embankment and media filter drain.

Bioslopes are designed to treat sheet flow from an adjacent impervious surface. A typical bioslope has the following facility features and components:

- Rock filter strip – It is provided upstream of the bioslope to evenly distribute flow into the treatment zone, reduce the runoff velocity, and provide pretreatment.
- Treatment Zone using Ecology mix – It is provided to remove pollutants as stormwater runoff drains through this zone. The ecology mix is a mixture of aggregate, dolomite, gypsum, and perlite.
- Sub surface drain – it is provided to allow positive outflow for runoff at the toe of the bioslope.

The bioslope is located on the north side of OR-224. The bioslope begins at milepoint 11.72 and extends east for approximately 400 ft.

The contributing drainage includes stormwater runoff from the forested area north of the facility and sheet flow from the highway.

Three PVC inlets exist along the length of this facility for maintenance to access/clean the subsurface drain pipe. The iron caps and concrete casing are visible from the highway within the ditch flow line. The bioslope ends at milepoint 11.79.

A. Maintenance equipment access:

Maintenance crews and equipment can access the bioslope facility by parking on the shoulder of westbound OR-224 between mile posts 11.72 and 11.79.

B. Heavy equipment access into facility:

- Allowed (no limitations)
- Allowed (with limitations)
- Not allowed

Access is allowed for light to mid weight equipment such as mowers and small excavators.

C. Special Features:

- Amended Soils
- Porous Pavers
- Liners
- Underdrains



Photo 1: Bioslope and facility ID, looking west from milepoint 11.79.



Photo 2: Looking west at the top of the iron cover and concrete casing of one of three PVC inlets along the bioslope.



Photo 3: Outfall drain into riprap basin, looking east towards bioslope.

5. Facility Haz Mat Spill Feature(s)

This facility has no Haz Mat spill features.

6. Auxiliary Outlet (High Flow Bypass)

There is no auxiliary flow outlet for this facility.

7. Maintenance Requirements

Routine maintenance table for non-proprietary stormwater treatment and storage/detention facilities have been incorporated into ODOT's Maintenance Guide. These tables summarize the maintenance requirements for ponds, swales, filter strips, bioslopes, and detention

tanks and vaults. Special maintenance requirements in addition to the routine requirements are noted below when applicable.

The ODOT Maintenance Guide can be viewed at the following website:

<http://www.oregon.gov/ODOT/HWY/OOM/MGuide.shtml>

Maintenance requirements for proprietary structures, such as underground water quality manholes and/or vaults with filter media are noted in Appendix C when applicable.

The following stormwater facility maintenance table (See ODOT Maintenance Guide) should be used to maintain the facility outlined in this Operation and Maintenance Manual or follow the Maintenance requirements outlined in Appendix C when proprietary structure is selected below:

- Table 1 (general maintenance)
- Table 2 (stormwater ponds)
- Table 3 (water quality biofiltration swales)
- Table 4 (water quality filter strips)
- Table 5 (water quality bioslopes)
- Table 6 (detention tank)
- Table 7 (detention vault)
- Appendix C (proprietary structure)
- Special Maintenance requirements:

8. Waste Material Handling

Material removed from the facility is defined as waste by DEQ. Refer to the roadwaste section of the ODOT Maintenance Yard Environmental Management System (EMS) Policy and Procedures Manual for disposal options: <http://www.oregon.gov/ODOT/Engineering/Pages/Manuals.aspx>


Contact any of the following for more detailed information about management of waste materials found on site:

ODOT Clean Water Unit	(503) 986-3008
ODOT Statewide Hazmat Coordinator	(503) 667-7442
ODOT Region Hazmat Coordinator	(503) 731-8290
ODEQ Northwest Region Office	(503) 229-5263


Appendix A

Content:


- **Operational Plan and Section Drawing(s)**

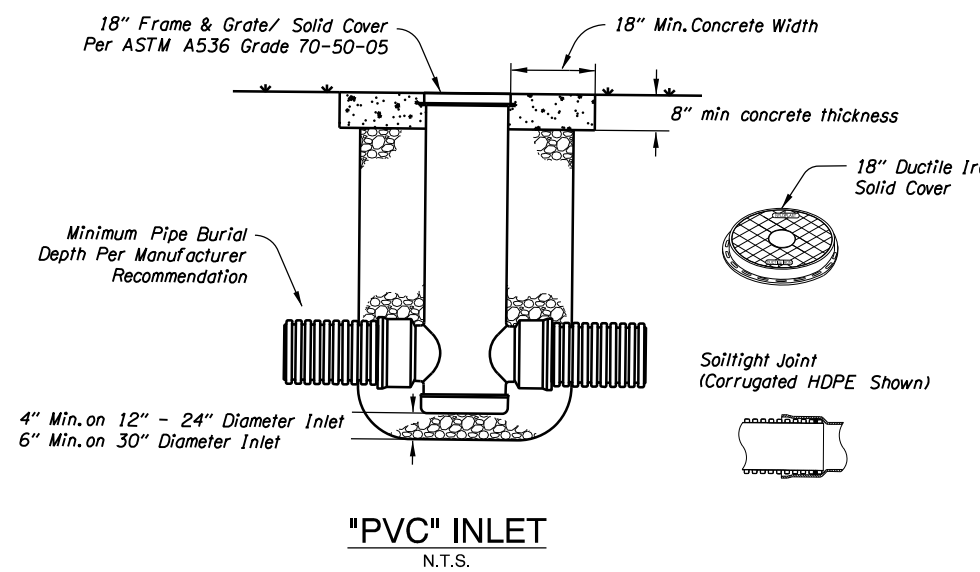

"PVC" INLET
N.T.S.

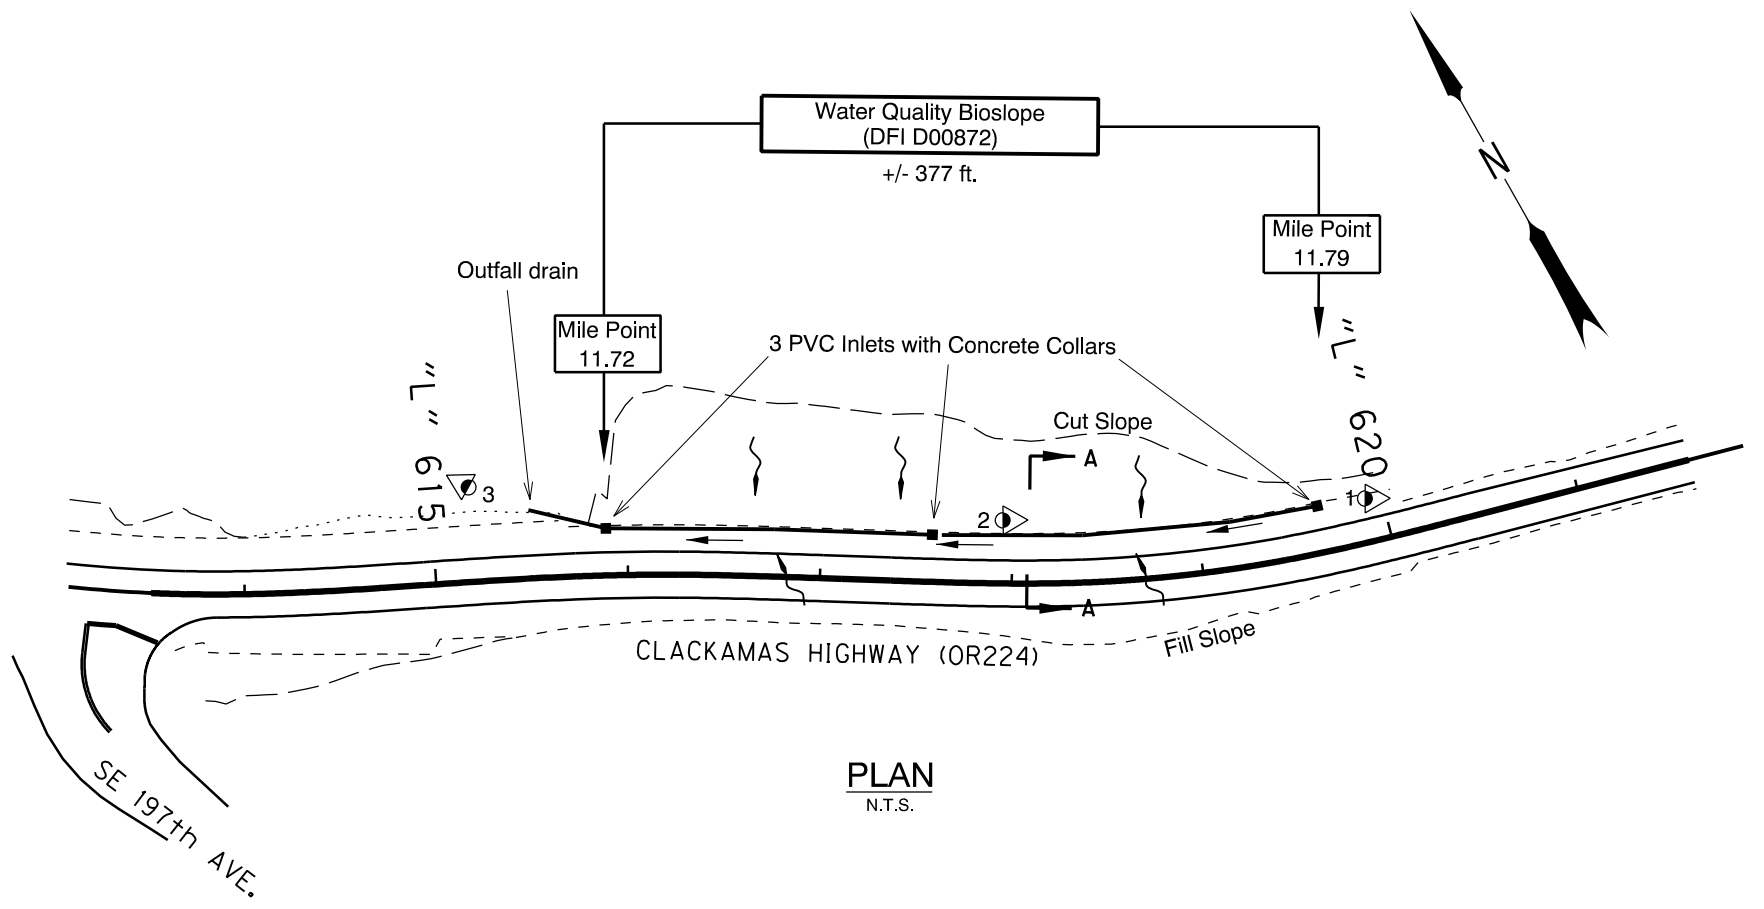

PLAN
N.T.S.

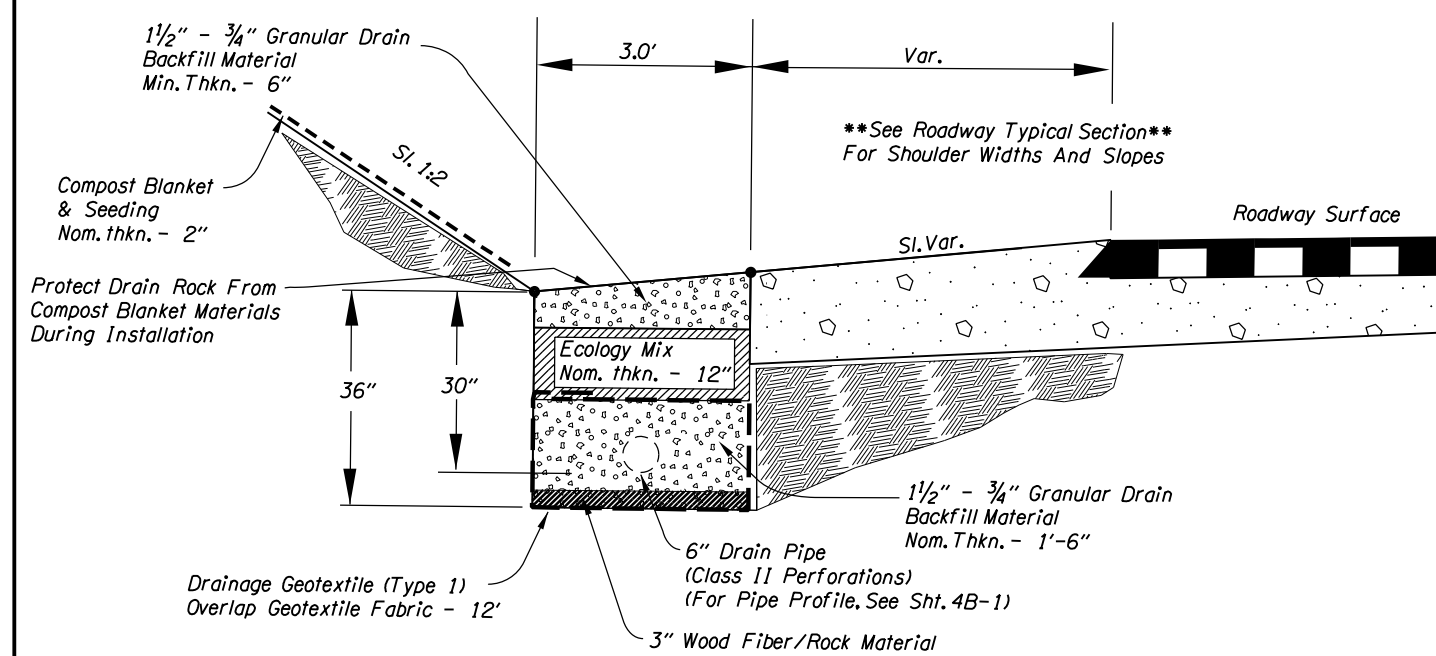

SECTION A-A
N.T.S.

MP 11.72 - MP 11.79 LT.

- LEGEND:**
- Photo Location / Direction
 - Manhole
 - Inlet
 - Storm Pipe (Facility)
 - Storm Pipe
 - Conveyance Direction
 - Pavement / Facility Flow Path

OREGON DEPARTMENT OF TRANSPORTATION

Prepared By: David McDonald
 Drafted By: Zoe Keve

DFI D00872
MAINTENANCE DISTRICT 2C HWY 171
BIOSLOPE
 HIGHWAY MP 11.72-11.79
 CLACKAMAS COUNTY

Appendix B

Content:

- **ODOT Project Plan Sheets**
 - *Cover/Title Sheet*
 - *Drainage and Utility Sheets (4B)*
 - *Pipe Data Sheet (2D)*
 - *Drainage Profile Sheets (4B-2))*
 - *Drainage Detail Sheets (GJ-2)*

INDEX OF SHEETS	
SHEET NO.	DESCRIPTION
1	Title Sheet
1A	Index Of Sheets Cont. & Std. Drg. Nos.

STATE OF OREGON
DEPARTMENT OF TRANSPORTATION

PLANS FOR PROPOSED PROJECT

GRADING, DRAINAGE, PAVING, SIGNING

OR224 (CLACKAMAS HWY): SE 197TH AVE. SEC.


CLACKAMAS HIGHWAY

CLACKAMAS COUNTY

APRIL 2015


NOT REVISED AS CONSTRUCTED
30 SEP 2015 CONTRACT 14803
PROJ. MGR. MARJORIE WEST

Marjorie West 12/9/15

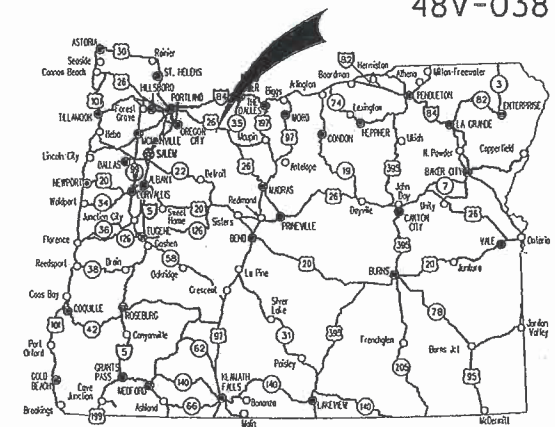

Overall Length Of Project - 0.29 Miles

ATTENTION:
Oregon Law Requires You To Follow Rules Adopted By The Oregon Utility Notification Center. Those Rules Are Set Forth In OAR 952-001-0010 Through OAR 952-001-0090. You May Obtain Copies Of The Rules By Calling The Center. (Note: The Telephone Number For The Oregon Utility Center Is (503) 232-1987.)

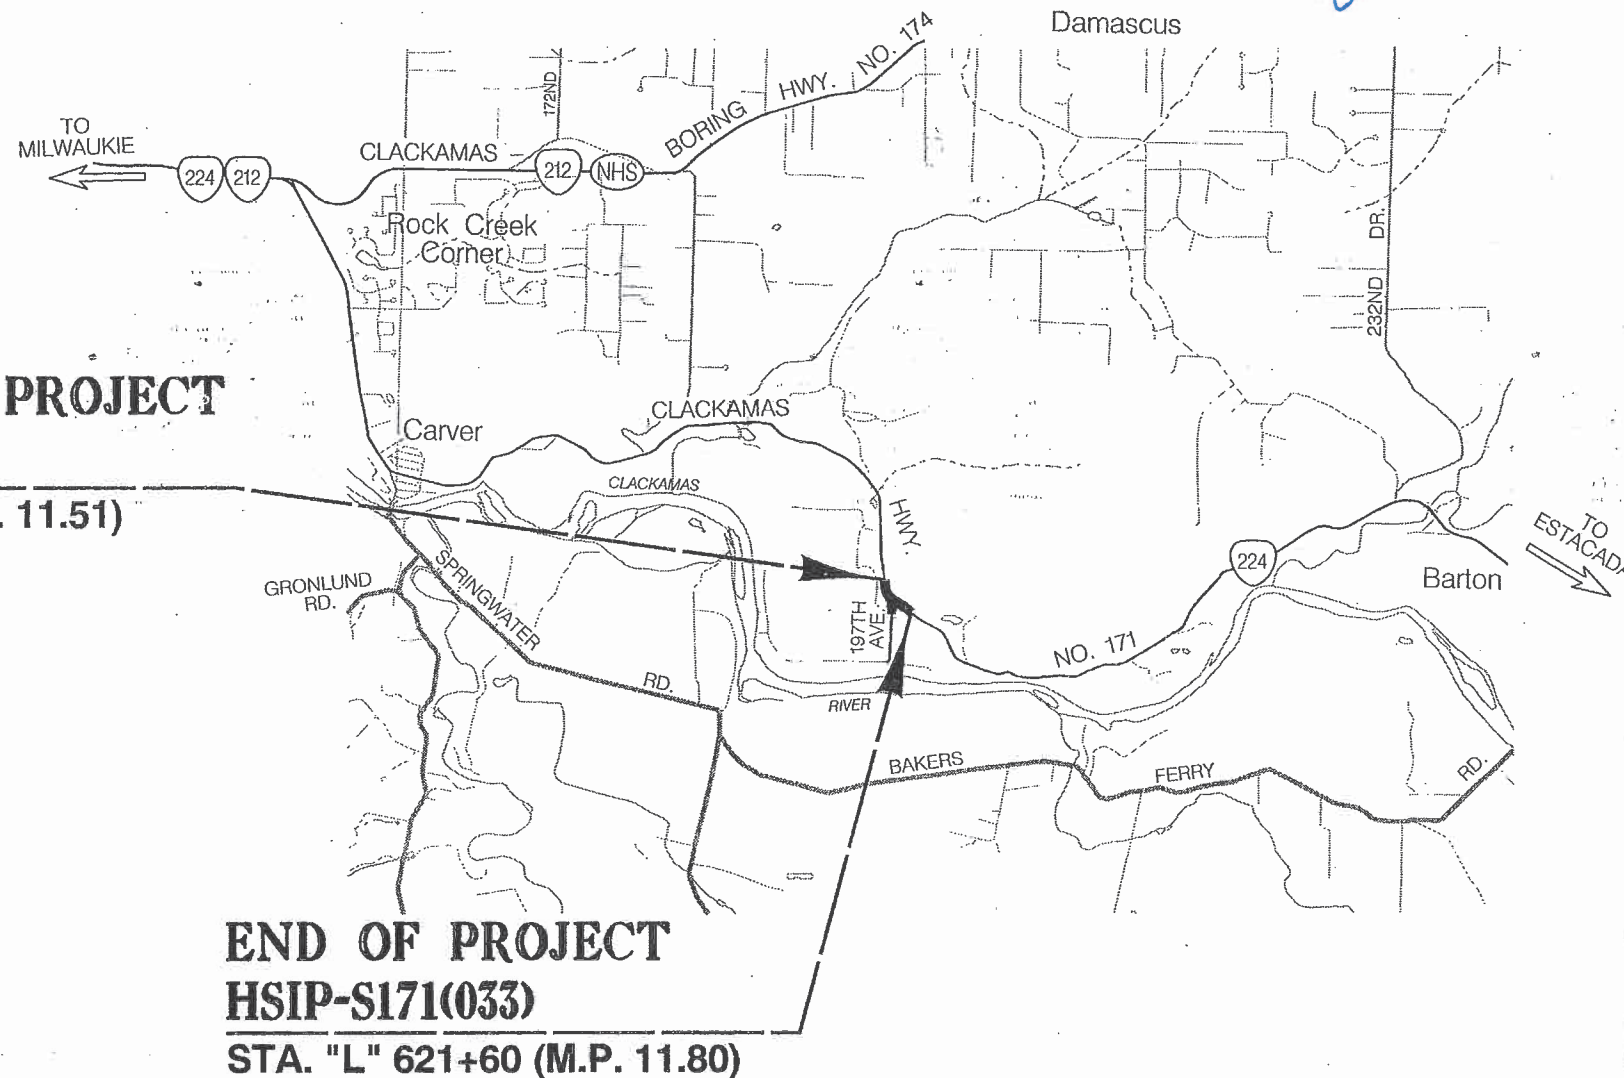

BEGINNING OF PROJECT
HSIP-S171(033)

STA. "L" 606+70 (M.P. 11.51)

END OF PROJECT
HSIP-S171(033)

STA. "L" 621+60 (M.P. 11.80)

OREGON TRANSPORTATION COMMISSION

- Tammy Boney CHAIR
- David Lohman COMMISSIONER
- Susan Morgan COMMISSIONER
- Alando Simpson COMMISSIONER
- Matthew L. Garrett DIRECTOR OF TRANSPORTATION

These plans were developed using ODOT design standards. Exceptions to these standards, if any, have been submitted and approved by the ODOT Chief Engineer or their delegated authority.

Approving Authority: *Tamira J. Clark*
Tamira J. Clark
Technical Center Manager, Region 1

Thomas Jones
Concurrence by ODOT Chief Engineer

OR224 (CLACKAMAS HWY): SE 197TH AVE. SEC.
CLACKAMAS HIGHWAY
CLACKAMAS COUNTY

FEDERAL HIGHWAY ADMINISTRATION	PROJECT NUMBER	SHEET NO.
OREGON DIVISION	HSIP-S171(033)	1

T. 2 S., R. 3 E., W.M.





PE002130 000







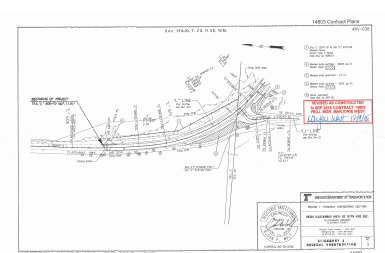


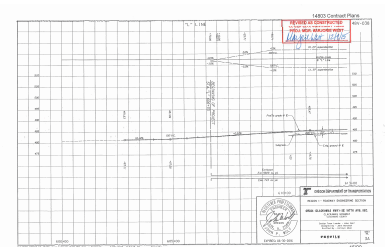


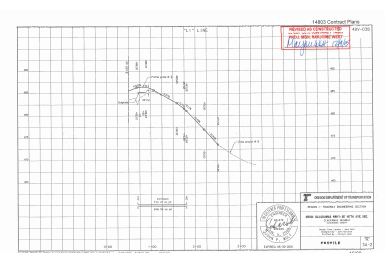


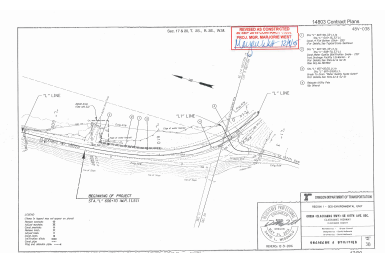


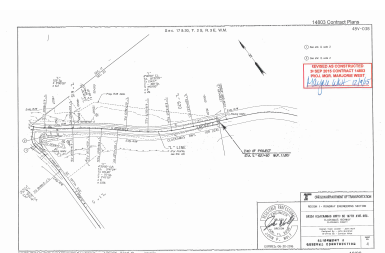

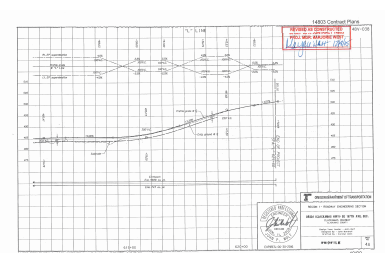

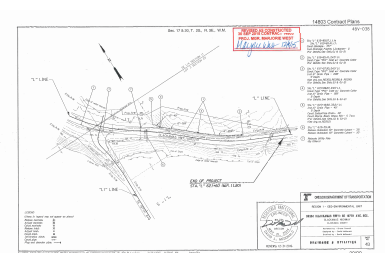

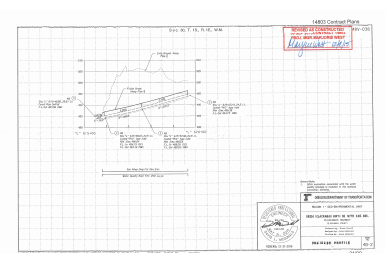

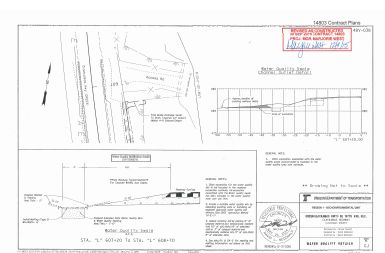









