

OPERATION & MAINTENANCE MANUAL

DFI No. : D01183

Facility Type: Drywell

September 2018

INDEX

1. IDENTIFICATION 1

2. FACILITY CONTACT INFORMATION 1

3. CONSTRUCTION 1

4. STORM DRAIN SYSTEM AND FACILITY OVERVIEW 2

5. MAINTENANCE REQUIREMENTS 2

6. WASTE MATERIAL HANDLING 3

Appendix A: Operational Plan and Profile Drawing(s)

Appendix B: ODOT Project Plan Sheets

1. Identification

Drainage Facility ID (DFI): **D01183**

Facility Type: Drywell

Construction Drawings: (V-File Number) 52V-005

Location: District: 2B

Highway No.: 026

Mile Post: 7.93 (beg./end)

Description: This facility is located along the south side of SE Powell Boulevard approximately 140 feet east of the intersection with 136th Avenue.

2. Facility Contact Information

Contact the Engineer of Record, Region Technical Center, or Geo-Environmental's Senior Hydraulics Engineer for:

- Operational clarification
- Maintenance clarification
- Repair or restoration assistance

Engineering Contacts:

Region Technical Center Hydro Unit Manager

Or

Geo-Environmental Senior Hydraulics Engineer (503) 986-3365.

3. Construction

Engineer of Record:

ODOT Designer – Region 1 Hydraulics, Bruce Council, PE, (503) 731-8319

Consultant Designer – HDR, Christine Higgins, PE, (503) 423-3700

Facility construction: 2019

Contractor: To be Determined

4. Storm Drain System and Facility Overview

Drywells are structural subsurface facilities with perforated sides or bottom used to dispose/infiltrate stormwater into the ground. Drywells are usually configured with an upstream sedimentation manhole as a form of pretreatment. Drywells have been designed to fully store and infiltrate the volume of runoff from the 25-year, 24-hour rainfall event.

This facility is located along the south side of SE Powell Boulevard approximately 140 feet east of the intersection with 136th Avenue behind the sidewalk. This facility's access manhole lid is flush with the adjacent ground, with 3.0 feet of drain rock surrounding the precast perforated drywell sections.

The drywell is the end point for the stormwater conveyance system. Runoff is collected with a curb inlet conveyed to a sedimentation manhole, and then discharged into the drywell where the water is infiltrated into the groundwater.

A. Maintenance equipment access:

The facility can be accessed from SE Powell Boulevard.

B. Heavy equipment access into facility:

- Allowed (no limitations)
- Allowed (with limitations)
- Not allowed

C. Special Features:

- Amended Soils
- Porous Pavers
- Liners
- Underdrains

5. Maintenance Requirements

Routine maintenance table for non-proprietary stormwater treatment and storage/detention facilities have been incorporated into ODOT's Maintenance Guide. These tables summarize the maintenance requirements for ponds, swales, filter strips, bioslopes, and detention tanks and vaults. Special maintenance requirements in addition to the routine requirements are noted below when applicable.

The ODOT Maintenance Guide can be viewed at the following website:

<https://www.oregon.gov/ODOT/GeoEnvironmental/Pages/Stormwater.aspx>

The stormwater facility maintenance table (See ODOT Maintenance Guide) should be used to maintain the facility outlined in this Operation and Maintenance Manual:

Mark as Required and always include Table 1:

- Table 1 (general maintenance)
- Table 2 (stormwater ponds)
- Table 3 (water quality biofiltration swales)
- Table 4 (water quality filter strips)
- Table 5 (water quality bioslopes)
- Table 6 (detention tank)
- Table 7 (detention vault)
- Appendix C (proprietary structure)

6. Waste Material Handling

Material removed from the facility is defined as waste by DEQ. Refer to the Roadwaste section of the ODOT Maintenance Yard Environmental Management System (EMS) Policy and Procedures Manual for disposal options:

https://www.oregon.gov/ODOT/Maintenance/Documents/ems_manual.pdf


Contact any of the following for more detailed information about management of waste materials found on site:

ODOT Clean Water Unit	(503) 986-3008
ODOT Statewide Hazmat Coordinator	(503) 229-5129
ODOT Region 1 Hazmat Coordinator	(503) 731-8290
ODEQ Northwest Region Office	(503) 229-5263

Appendix A

Content:

- **Operational Plan and Profile Drawing(s)**

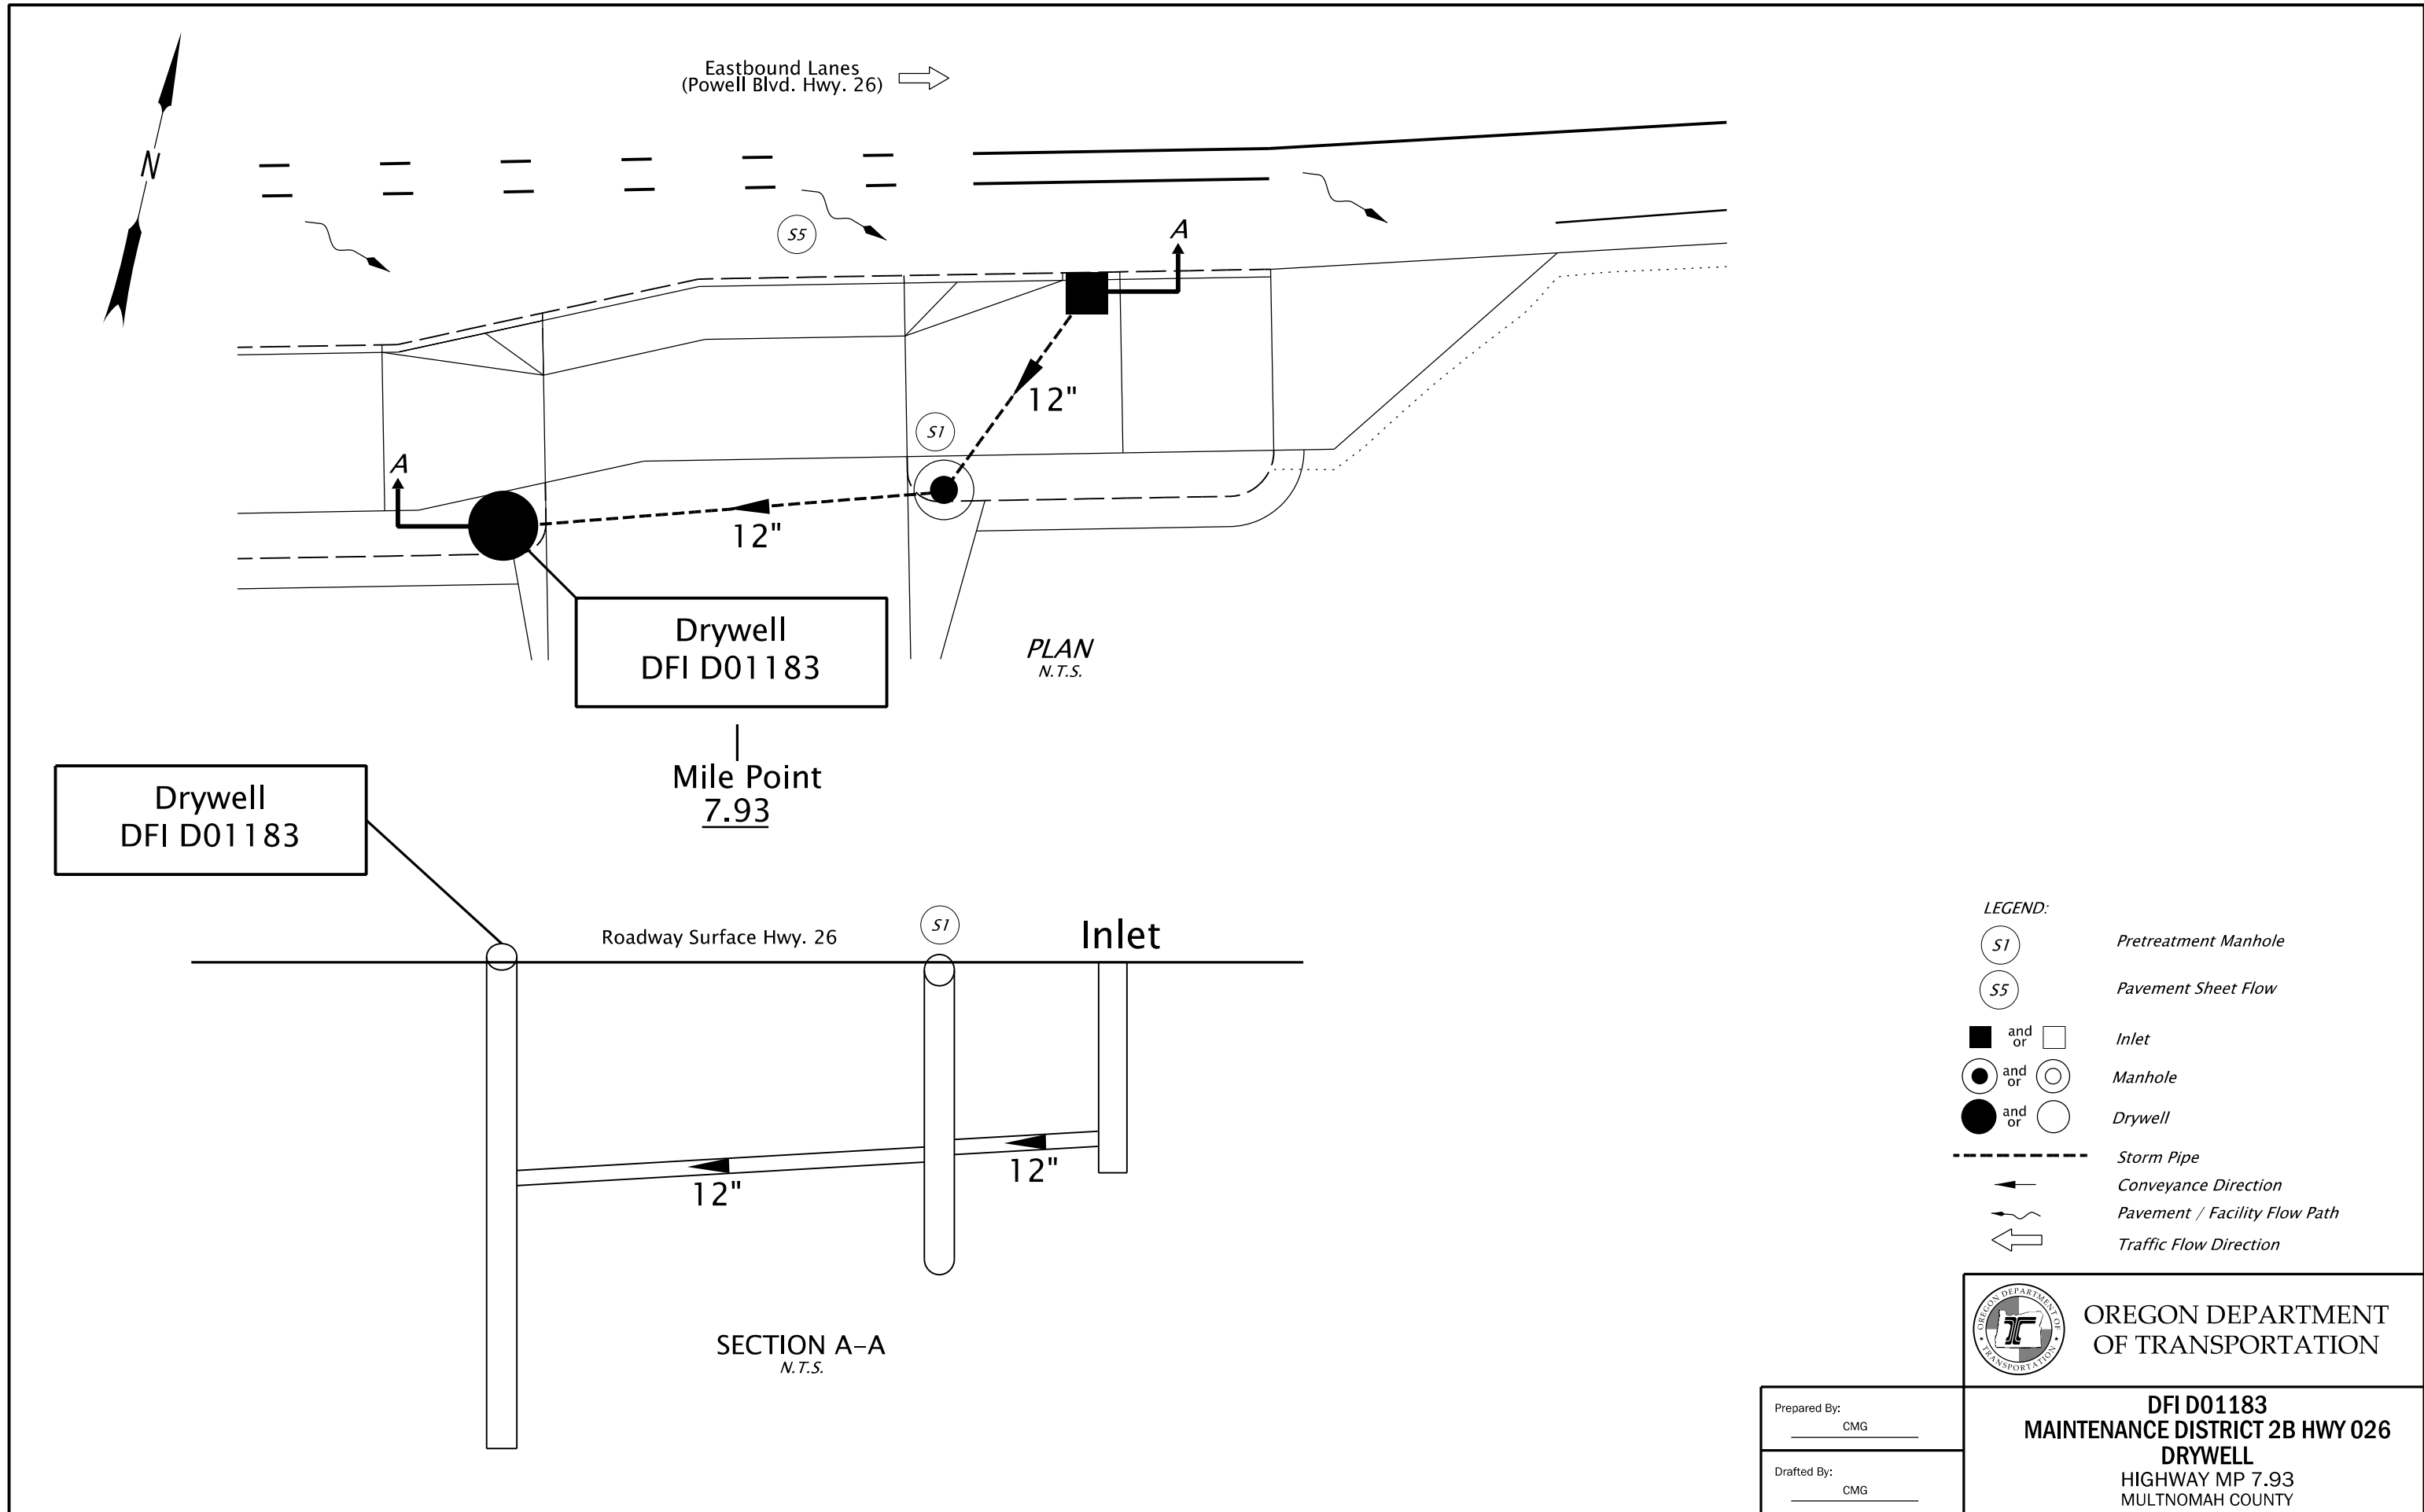

Appendix B

Content:

- **ODOT Project Plan Sheets**
 - *Cover/Title Sheet*
 - *Water Quality/Detention Plan Sheets*
 - *Other Details*

INDEX OF SHEETS	
SHEET NO.	DESCRIPTION
A01	Title Sheet
A02	Index Of Sheets, Cont.
A03	Standard Drawing Numbers
A04	Plan Sheet Layout
A05 thru A07	Control Data


STATE OF OREGON
DEPARTMENT OF TRANSPORTATION

PLANS FOR PROPOSED PROJECT
GRADING, PAVING, DRAINAGE, SIGNING,
ILLUMINATION, SIGNALS, AND ROADSIDE DEVELOPMENT

**US26 (POWELL BLVD):
SE 122ND AVE - SE 136TH AVE SEC.**

**MT. HOOD HIGHWAY
MULTNOMAH COUNTY
DECEMBER 2018**


**BEGINNING OF PROJECT
STA. "P" 1106+29.96 (M.P. 7.21)**

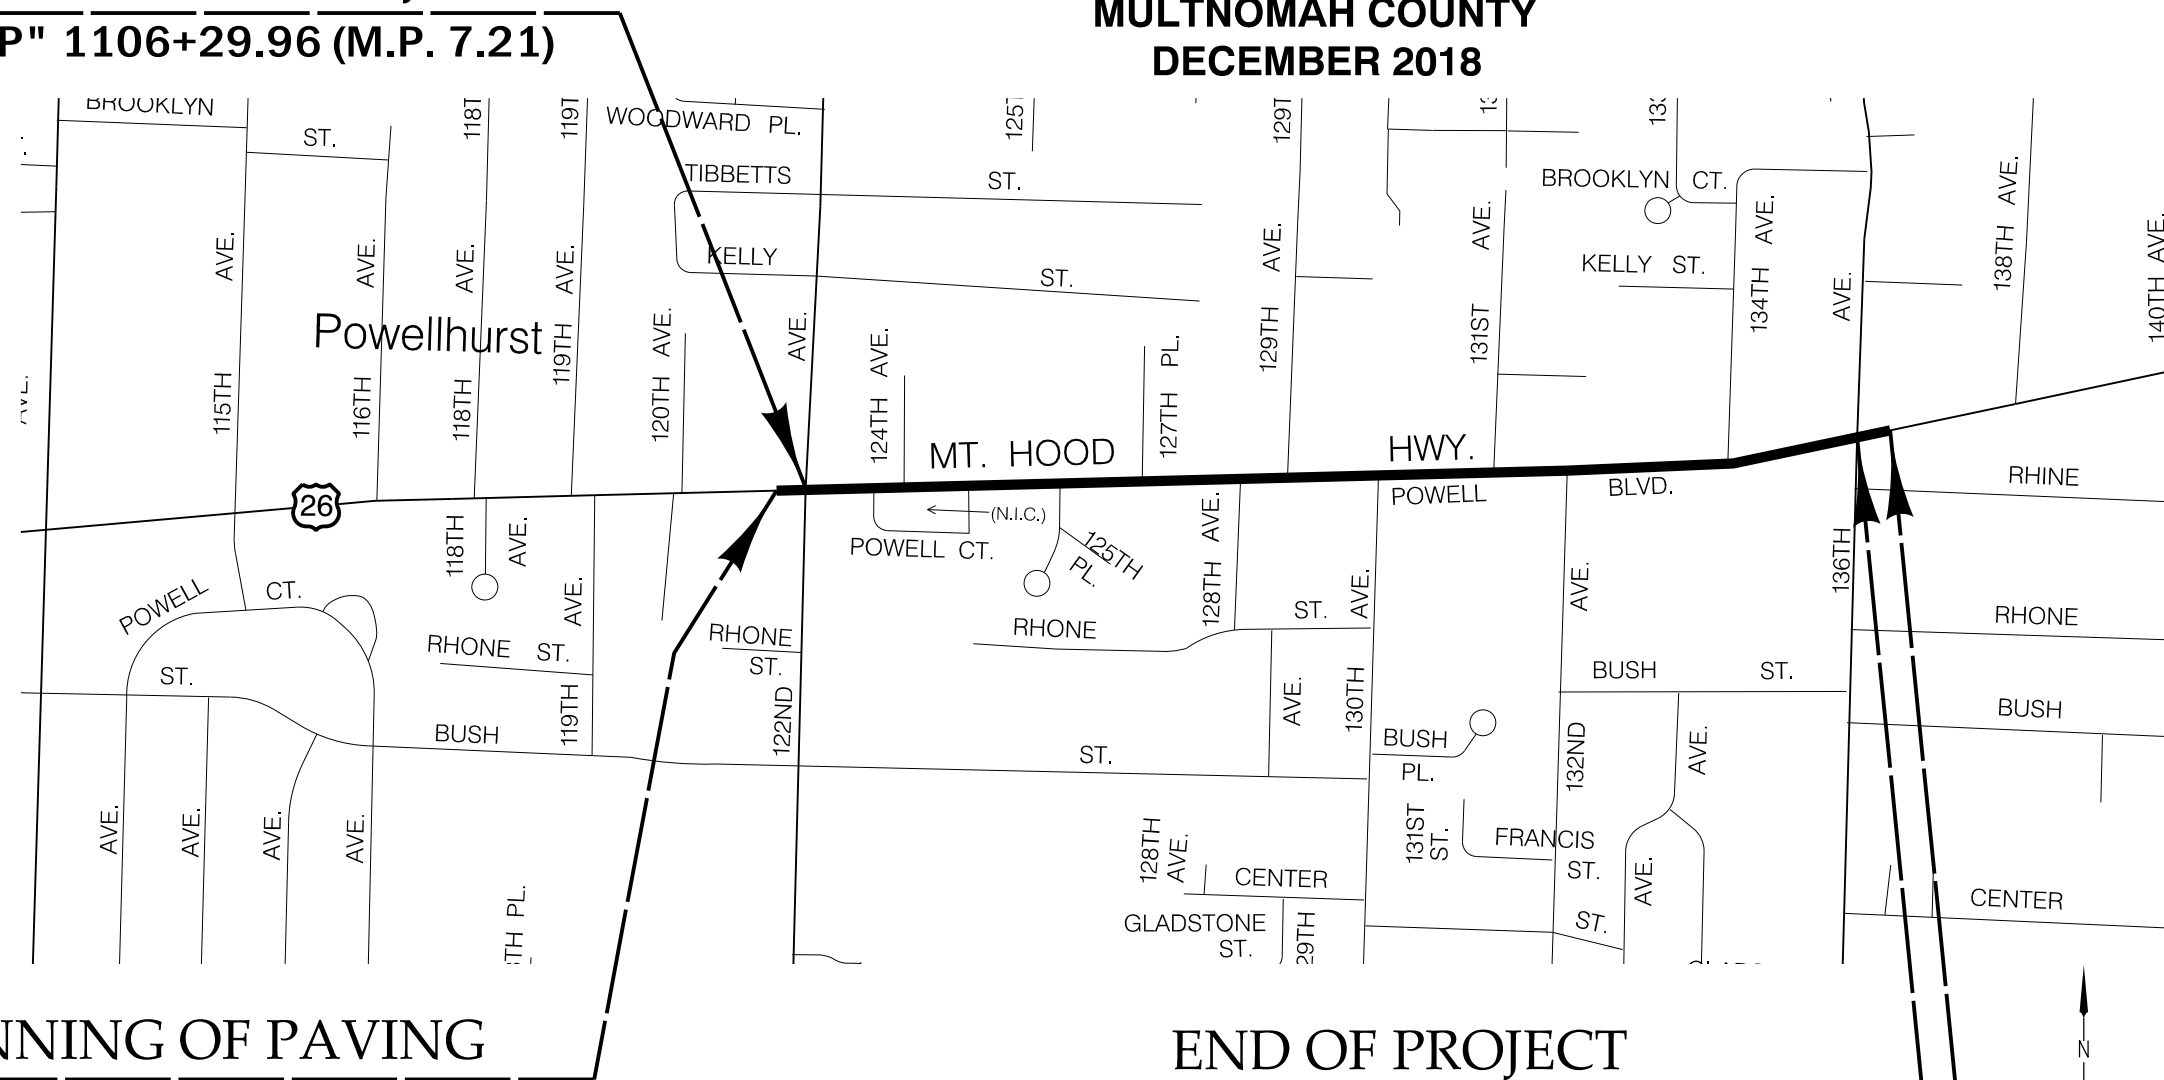

**BEGINNING OF PAVING
STA. "P" 1103+68.00 (M.P. 7.16)**

**END OF PROJECT
STA. "P" 1142+67.74 (M.P. 7.90)
END OF PAVING
STA. "P" 1145+25.00 (M.P. 7.95)**

T. 1 S., R. 2 E., W.M.

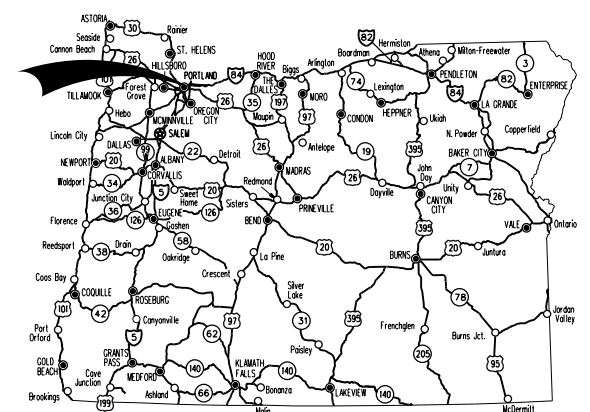

Overall Length Of Project - 0.93 Miles

ATTENTION:
Oregon Law Requires You To Follow Rules Adopted By The Oregon Utility Notification Center. Those Rules Are Set Forth In OAR 952-001-0010 Through OAR 952-001-0090. You May Obtain Copies Of The Rules By Calling The Center. (Note: The Telephone Number For The Oregon Utility Center Is (503) 232-1987.)



OREGON TRANSPORTATION COMMISSION
Tammy Baney CHAIR
David Lohman COMMISSIONER
Paula Brown COMMISSIONER
Alando Simpson COMMISSIONER
Sean O'Hollaren COMMISSIONER
Matthew L. Garrett DIRECTOR OF TRANSPORTATION

These plans were developed using ODOT design standards. Exceptions to these standards, if any, have been submitted and approved by the ODOT Chief Engineer or their delegated authority.

Approving Authority: _____
Signature & date


Print name and title

Concurrence by ODOT Chief Engineer

**US26 (POWELL BLVD):
SE 122ND AVE - SE 136TH AVE SEC.
MT. HOOD HIGHWAY
MULTNOMAH COUNTY**


FEDERAL HIGHWAY ADMINISTRATION	PROJECT NUMBER	SHEET NO.
OREGON DIVISION	HSIP-S026(126)	A01



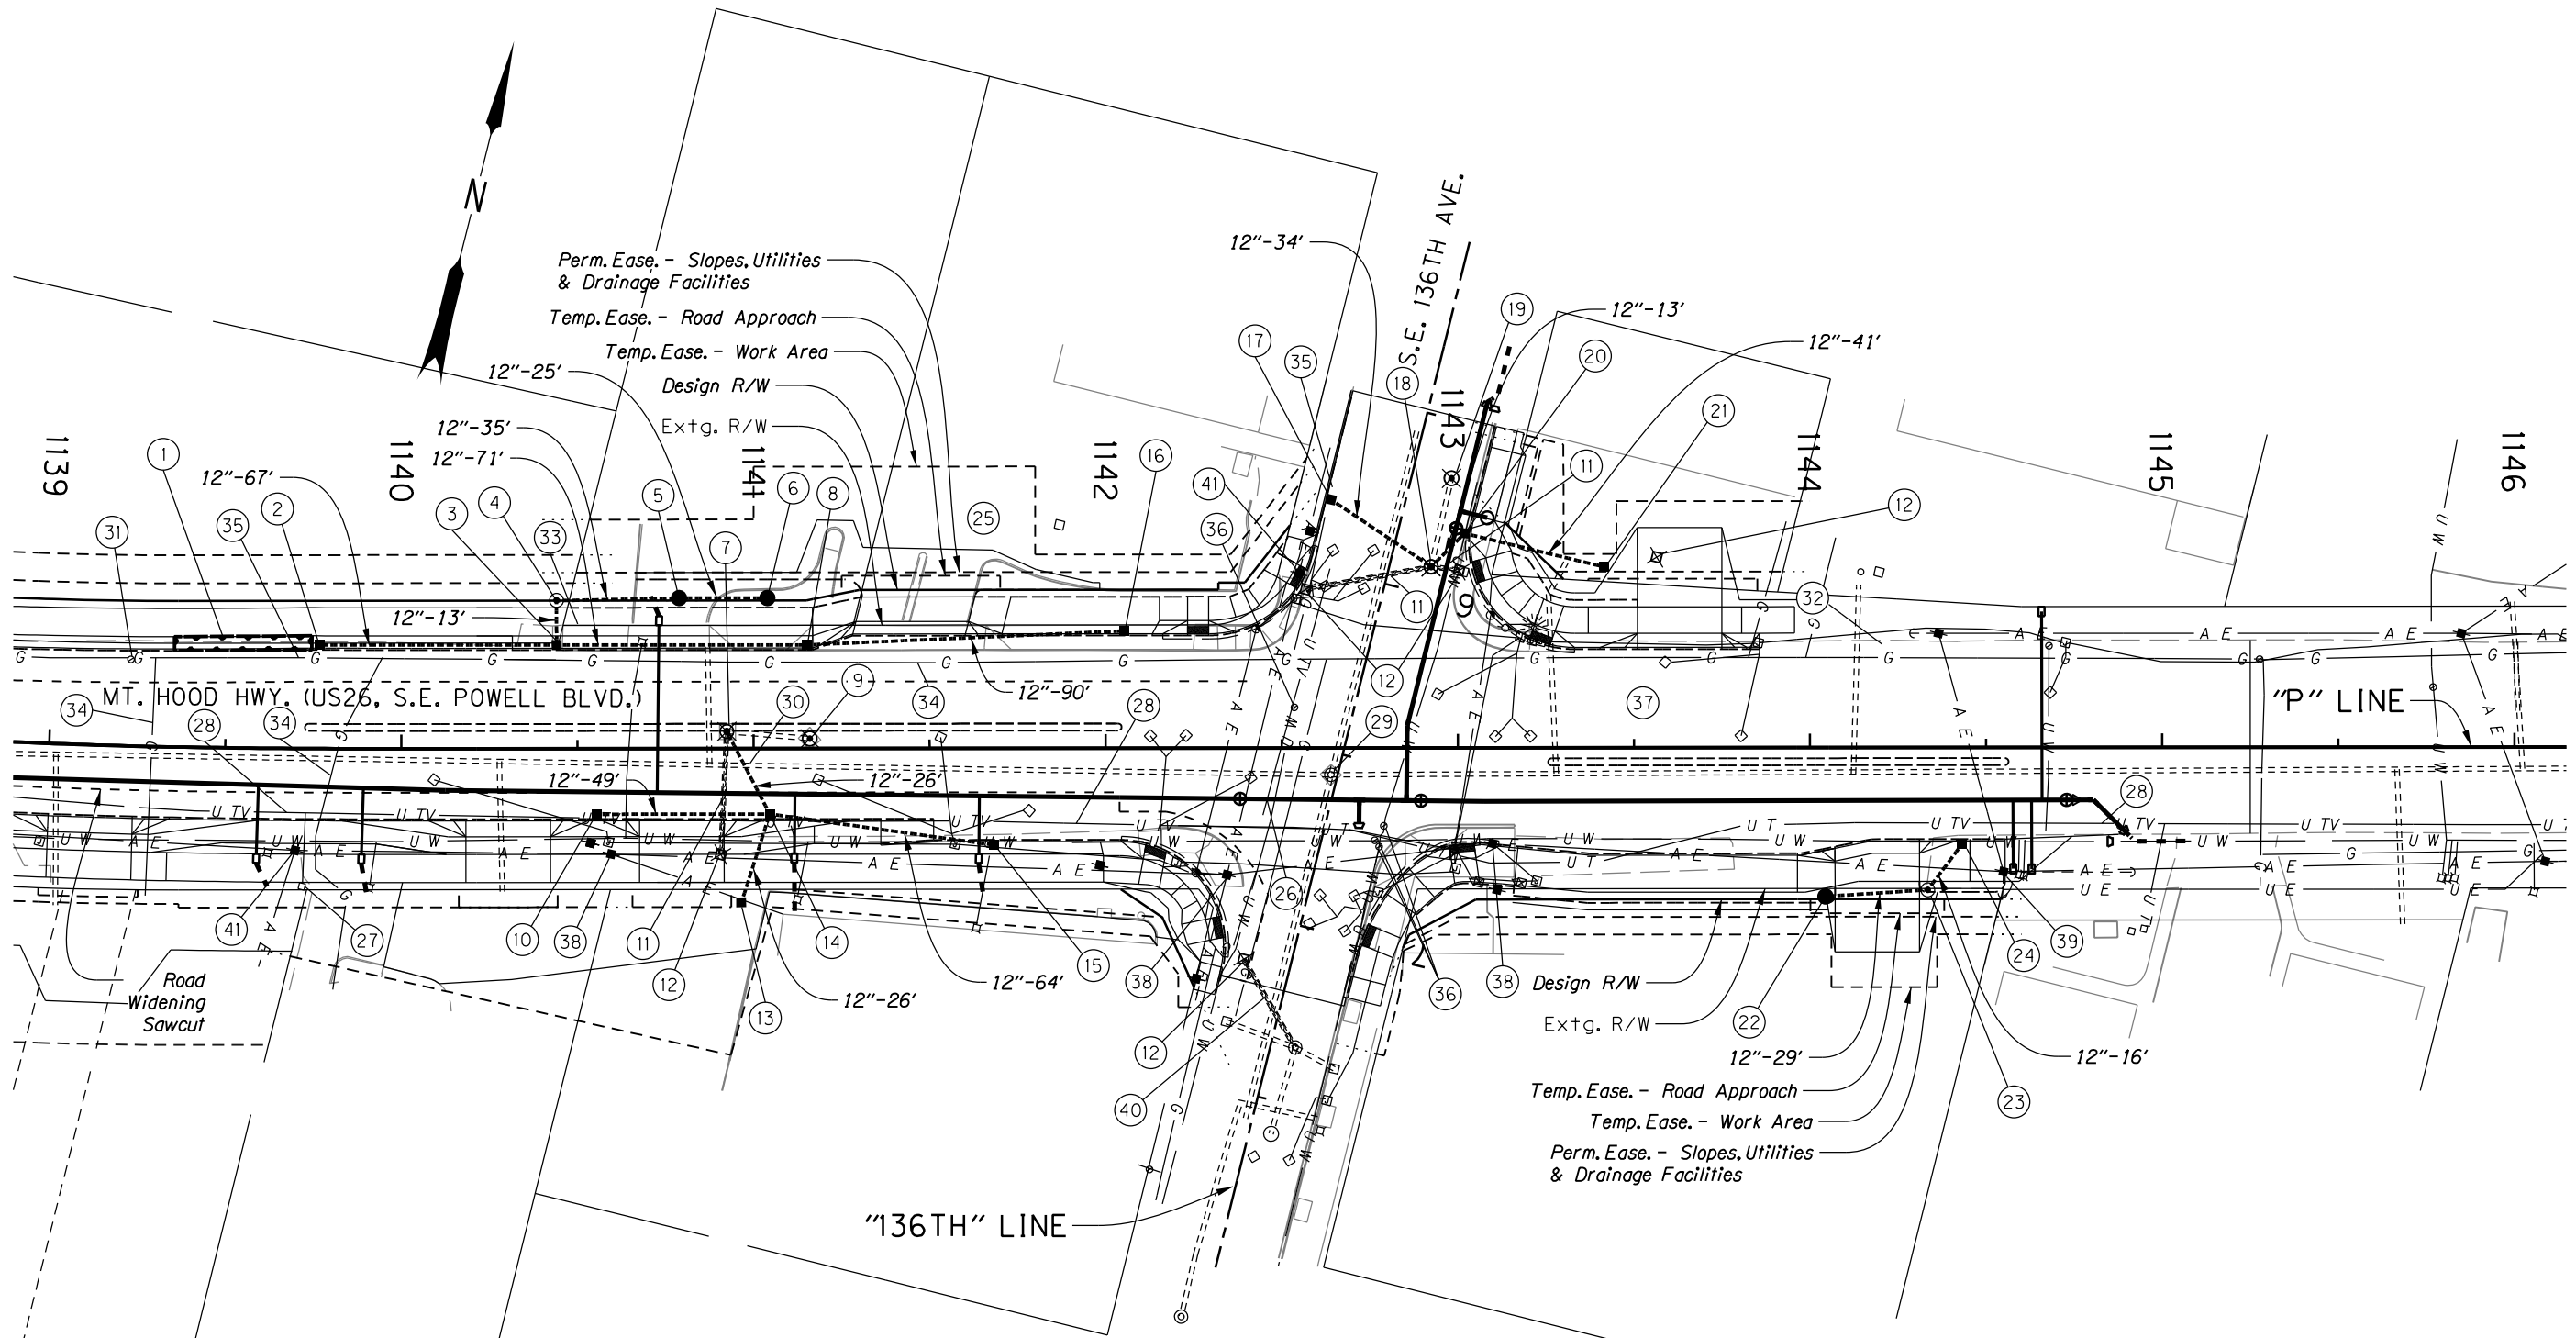

General Notes:


See sheets RA01 to RA14 for the relocation of the PWB water system.
 PWB will install the water meter in the water meter box installed by the Contractor.
 The road widening sawcut line does not reflect the sawcutting for trench resurfacing.

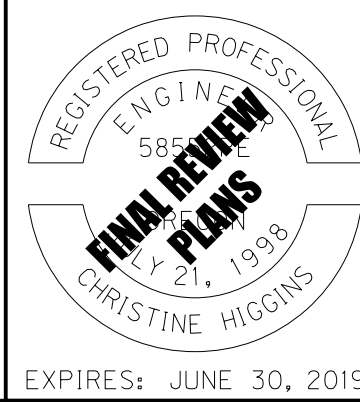

	HDR ENGINEERING, INC 1001 SW 5TH AVENUE, SUITE 1800 PORTLAND, OR 97204-1134 503.423.3700	
	US26 (POWELL BLVD): SE 122ND AVE - SE 136TH AVE SEC. MT. HOOD HIGHWAY MULTNOMAH COUNTY	


Designer: Cory Gieseke Drafter: Cory Gieseke	Reviewer: Christine Higgins Checker: Kyle Donovan	SHEET NO. C07C
DRAINAGE AND UTILITIES - PLANS		

- ① Sta. 1139+35.05 to 1139+74.05, Lt.
Const. stormwater planter D01179
Inst. field facility marker (Type S2) - 1
DFI no. D01179
(For details, see sht. HA03)
- ② Sta. 1139+76.59, Lt.
Const. type "CG-3" inlet with sump
Connect subdrain pipe from DFI no. D01179
- ③ Sta. 1140+44.39, Lt.
Const. type "CG-3" inlet with sump
Inst. 12" storm sew. pipe - 67'
5' depth
Inst. 12" storm sew. pipe - 71'
10' depth
- ④ Sta. 1140+44.16, 42.00' Lt.
Const. sedimentation manhole
Inst. 12" storm sew. pipe - 13', S=-0.77%
5' depth
(For details, see sht. HA01)
- ⑤ Sta. 1140+78.84, 42.65' Lt.
Const. drywell
Inst. 12" storm sew. pipe - 35'
10' depth
Inst. field facility marker (Type S3) - 1
DFI no. D01180
(For details, see sht. HA02)
- ⑥ Sta. 1141+03.92, 42.67' Lt.
Const. drywell
Inst. 12" storm sew. pipe - 25'
10' depth
Inst. field facility marker (Type S3) - 1
DFI no. D01181
(For details, see sht. HA02)
- ⑦ Sta. 1140+92.43, 4.85' Lt.
Minor adjust manhole
Method "B"
Inst. 12" storm sew. pipe - 26'
10' depth
Connect to extg. storm sewer manhole
- ⑧ Sta. 1141+15.28, Lt.
Const. type "CG-3" inlet with sump
Inst. 12" storm sew. pipe - 90'
5' depth
- ⑨ Sta. 1141+16.00, 2.78' Lt.
Minor adjust manhole
Method "B"
Inst. field facility marker (Type S3) - 1
DFI no. D01182
- ⑩ Sta. 1140+55.35, Rt.
Const. type "CG-2" inlet
- ⑪ Remove pipe - 78'
- ⑫ Remove inlet - 5
- ⑬ Sta. 1140+96.44, 43.57' Rt.
Const. area drain
- ⑭ Sta. 1141+04.50, Rt.
Const. type "CG-2" inlet
Inst. 12" storm sew. pipe - 26'
5' depth
Inst. 12" storm sew. pipe - 49'
5' depth
Inst. 12" storm sew. pipe - 64'
5' depth
- ⑮ Sta. 1141+68.31, Rt.
Const. type "CG-3" inlet with sump
- ⑯ Sta. 1142+05.50, Lt.
Const. type "CG-3" inlet with sump
- ⑰ Sta. "136TH" 5+80.56, Rt.
Const. type "CG-2" inlet with sump
- ⑱ Sta. "136TH" 5+92.21, 11.51' Lt.
Minor adjust manhole
Method "B"
Inst. 12" storm sew. pipe - 13', S=0.77%
10' depth
Inst. 12" storm sew. pipe - 34'
5' depth
Connect to extg. sedimentation manhole - 2
- ⑲ Sta. "136TH" 5+66.01, 11.30' Lt.
Minor adjust manhole
Method "B"
- ⑳ Sta. "136TH" 5+80.70, Lt.
Const. type "CG-2" inlet with sump
Inst. 12" storm sew. pipe - 41'
5' depth
- ㉑ Sta. 1143+41.57, 51.35' Lt.
Const. area drain
- ㉒ Sta. 1144+04.38, 42.38' Rt.
Const. drywell
Inst. 12" storm sew. pipe - 29'
10' depth
Inst. field facility marker (Type S3) - 1
DFI no. D01183
(For details, see sht. HA02)
- ㉓ Sta. 1144+33.41, 40.36' Rt.
Const. sedimentation manhole
Inst. 12" storm sew. pipe - 16'
5' depth
(For details, see sht. HA01)
- ㉔ Sta. 1144+43.17, Rt.
Const. type "CG-3" inlet with sump
- ㉕ Maintain and protect PWB Conduit No. 3
Water pipes over 12-inch in diameter are
not shown for confidentiality. Contact
Portland Water Bureau for locations.
- ㉖ Relocate CTL underground communication
line (by others)
- ㉗ Relocate CTL communications riser (by others)
- ㉘ Maintain and protect extg. CTL underground
communication line
- ㉙ Adjust BES sanitary manhole to finish grade
Minor Adjust Manhole - 1
Method "B"
- ㉚ Maintain and protect BES sanitary line
- ㉛ Adjust NWN gas test lead to finish grade (by others)
- ㉜ Locate buried NWN gas valve box and adjust to
finish grade - 1
- ㉝ Adjust NWN gas valve box to finish grade - 1
- ㉞ Maintain and protect NWN gas line
- ㉟ Relocate NWN gas line (by others)
- ㊱ Adjust PWB water valve box to finish grade - 8
- ㊲ Pothole buried PWB manhole - 1
- ㊳ Relocate PGE pole (by others)
- ㊴ Maintain and protect extg. PGE pole
- ㊵ Abandon pipe - 1
- ㊶ Relocate CTL pole (by others)

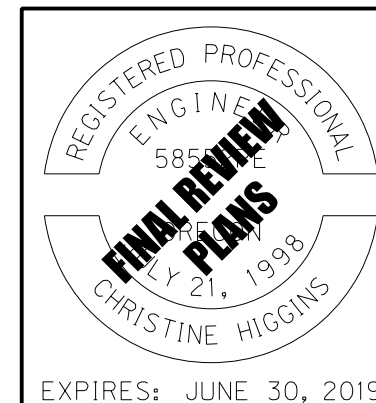


	HDR ENGINEERING, INC 1001 SW 5TH AVENUE, SUITE 1800 PORTLAND, OR 97204-1134 503.423.3700	
US26 (POWELL BLVD): SE 122ND AVE - SE 136TH AVE SEC. MT. HOOD HIGHWAY MULTNOMAH COUNTY		
Designer: Cory Gieseke Drafter: Cory Gieseke	Reviewer: Christine Higgins Checker: Kyle Donovan	SHEET NO. C07D
DRAINAGE AND UTILITIES - NOTES		EXPIRES: JUNE 30, 2019



"P" LINE

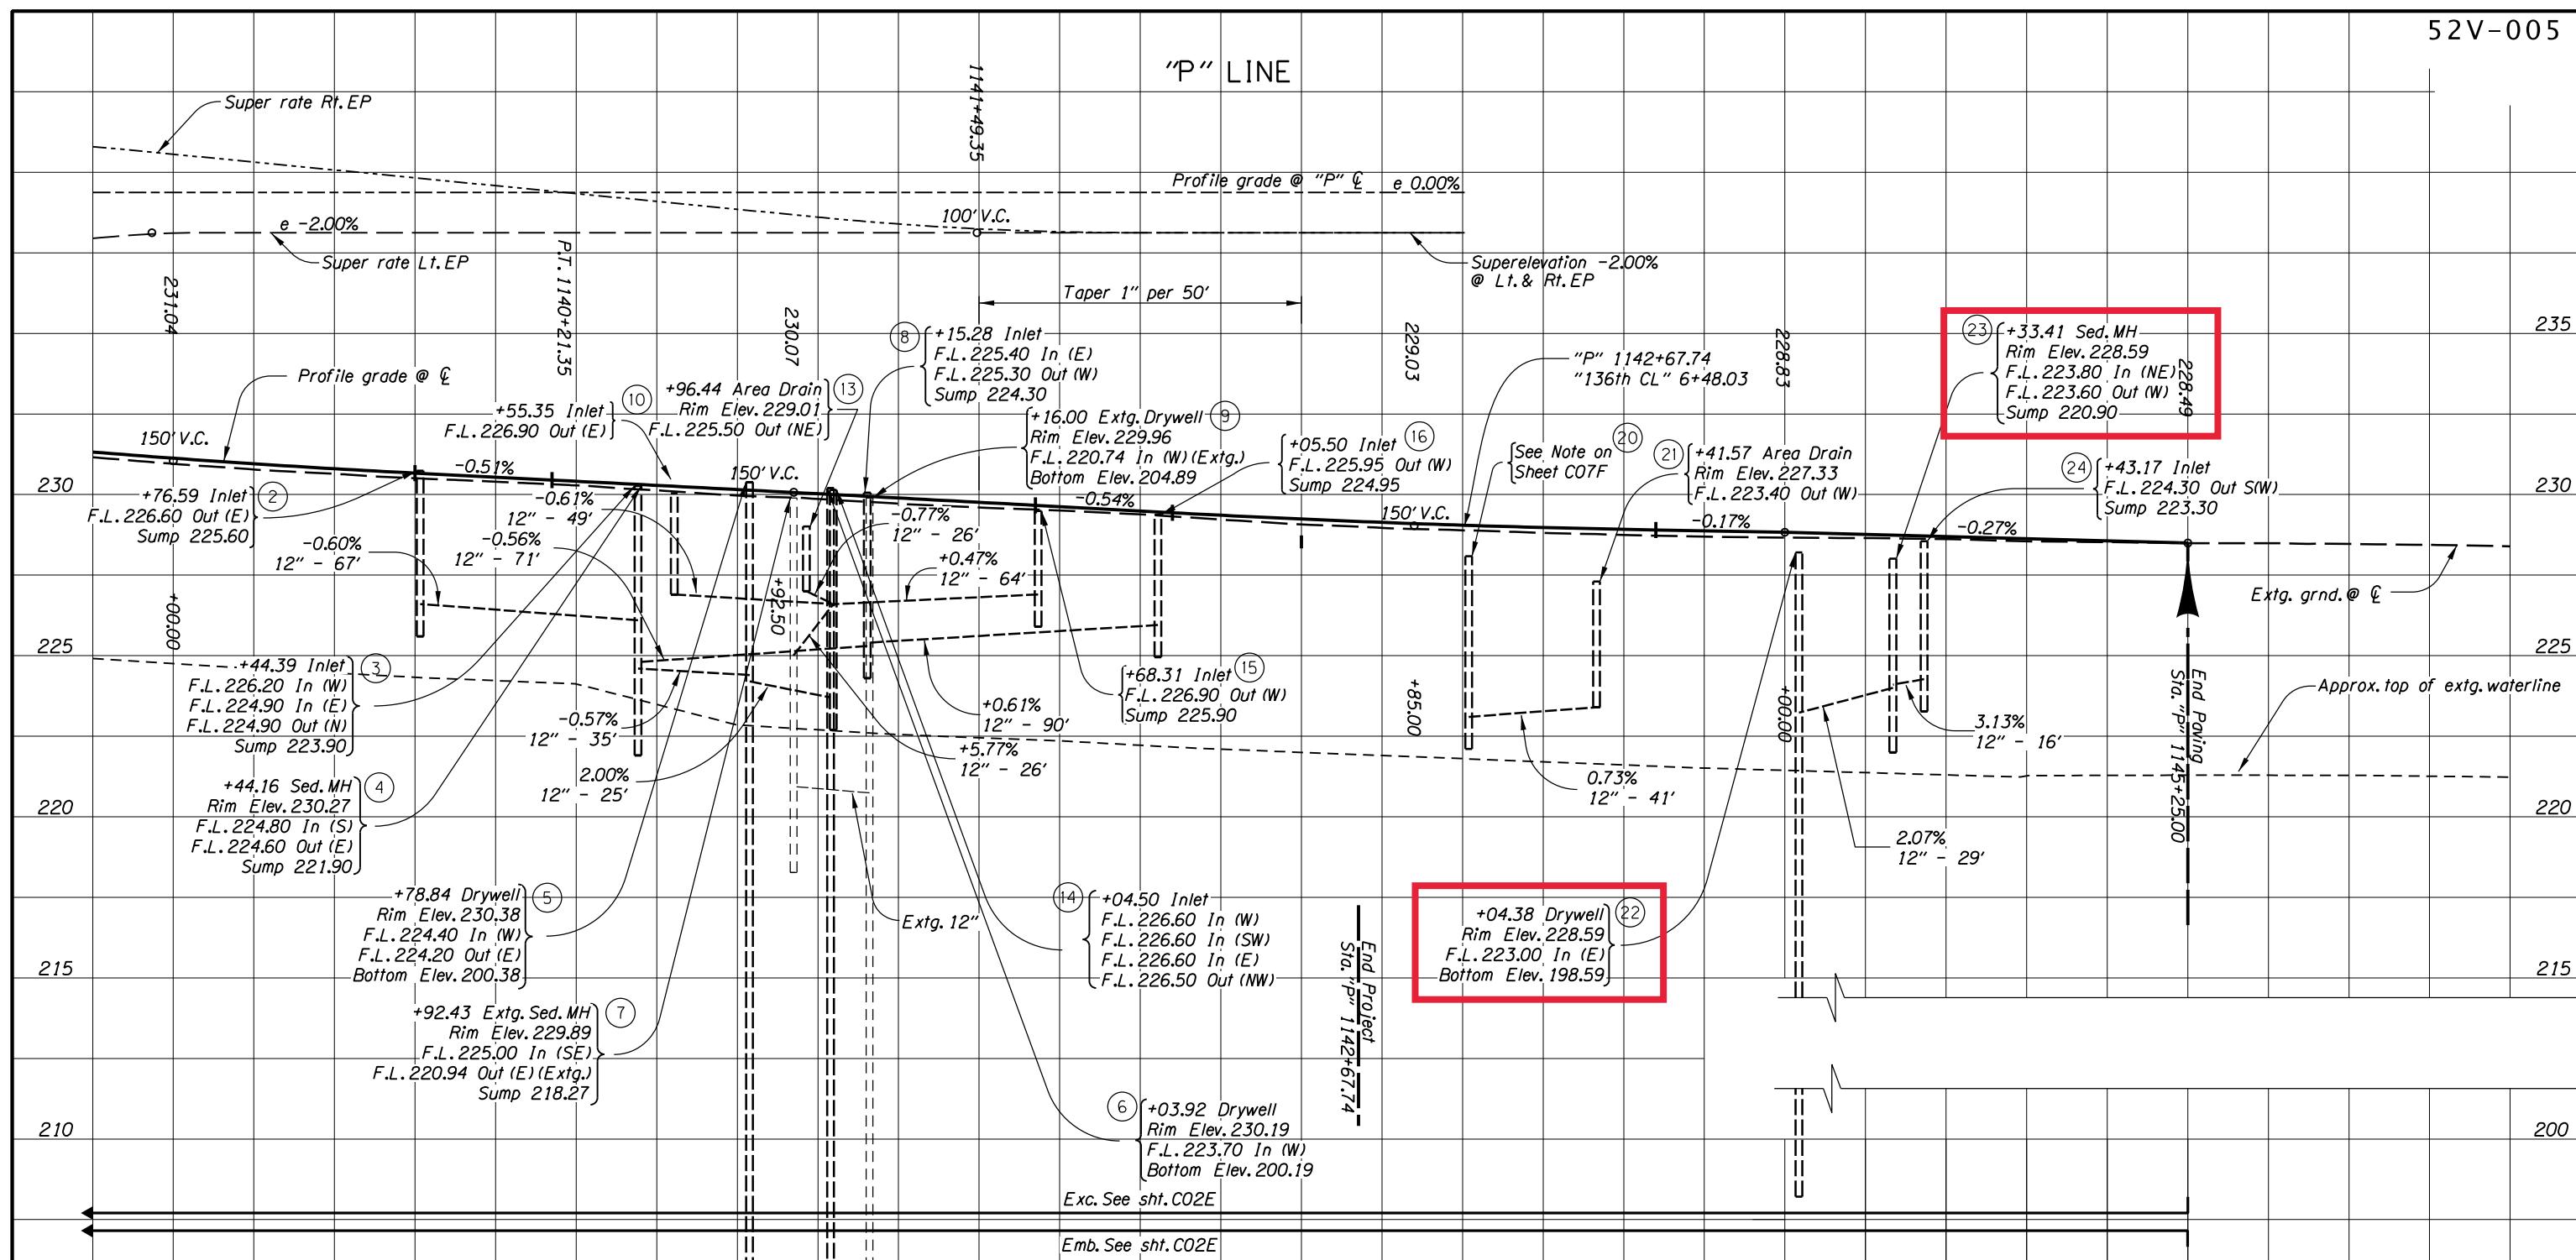

Note:
 Maintain and protect Portland Water Bureau conduit No. 3
 Location shown is approximate. Actual depth may vary.
 Field verify actual depth prior to excavation.
 PWB inspectors will need to be on-site prior
 to any potholing of waterlines.

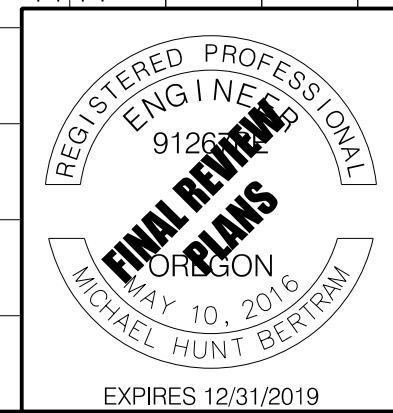


	HDR ENGINEERING, INC 1001 SW 5TH AVENUE, SUITE 1800 PORTLAND, OR 97204-1134 503.423.3700		
	US26 (POWELL BLVD): SE 122ND AVE - SE 136TH AVE SEC. MT. HOOD HIGHWAY MULTNOMAH COUNTY		
Designer: Mark Taylor Drafter: Mark Taylor	Reviewer: John Wolf Checker: Dustin Cooley		SHEET NO. C07E
PROFILE			

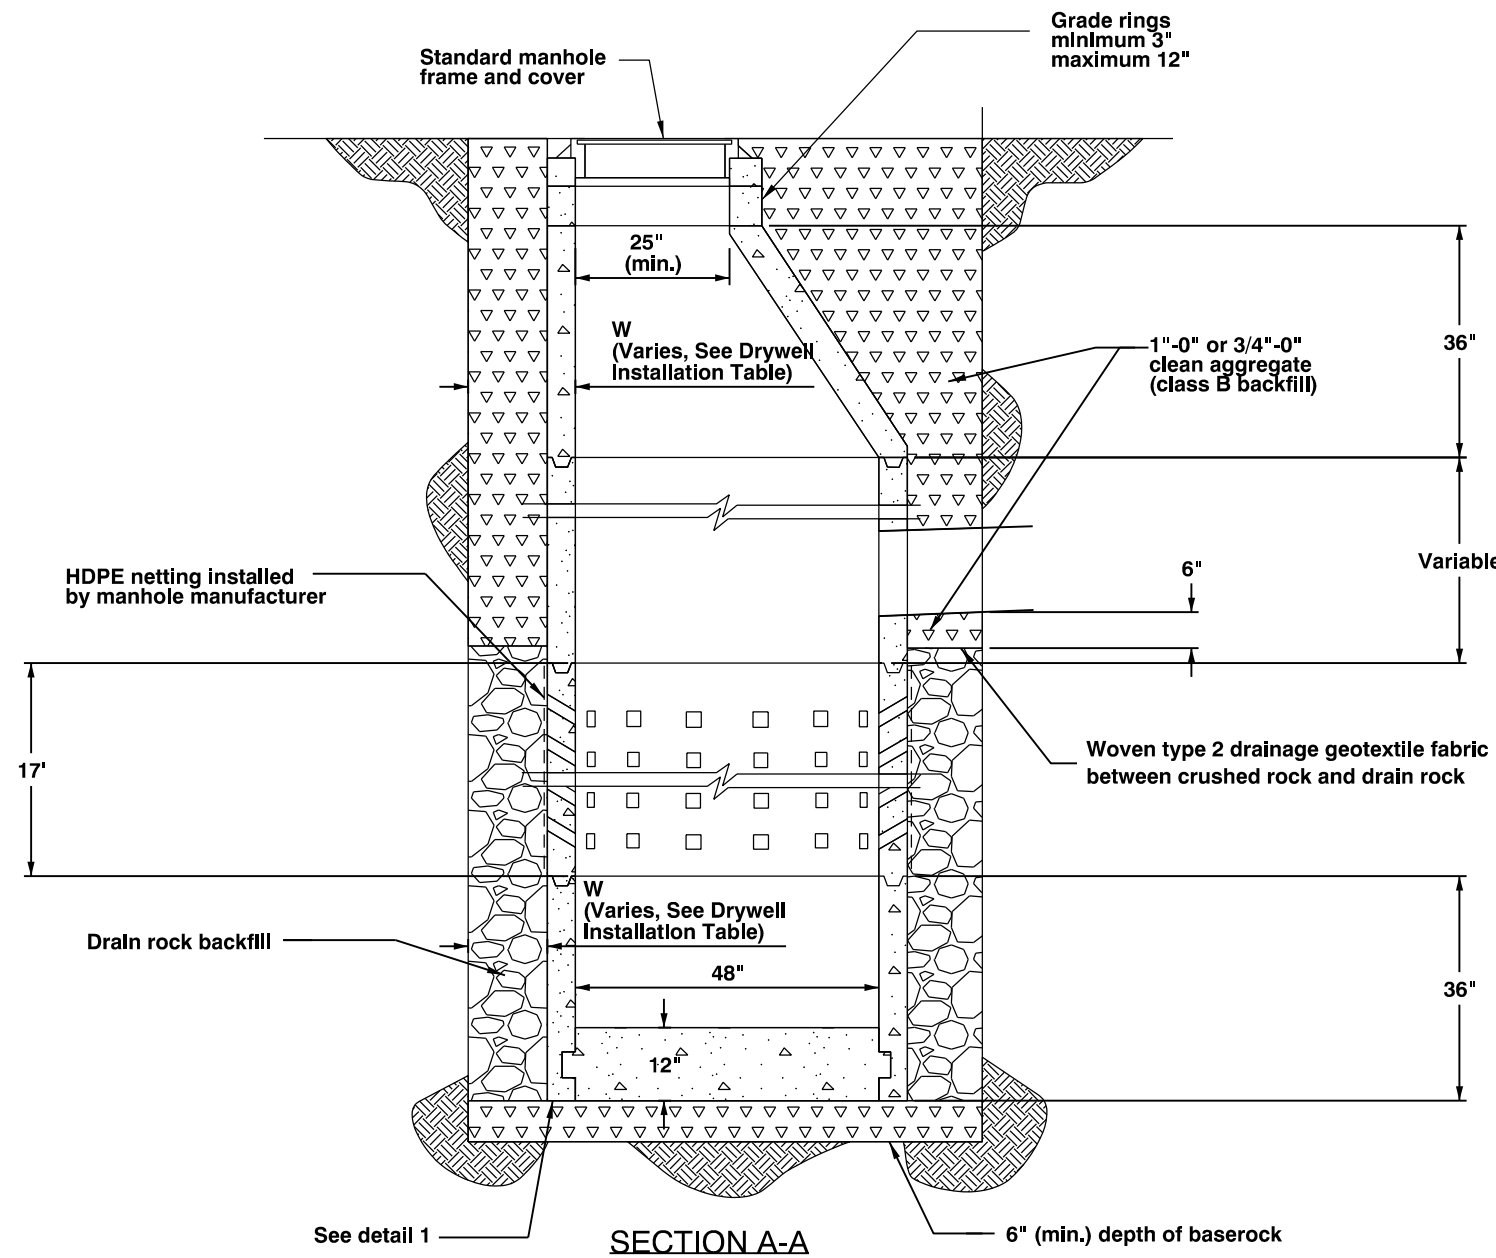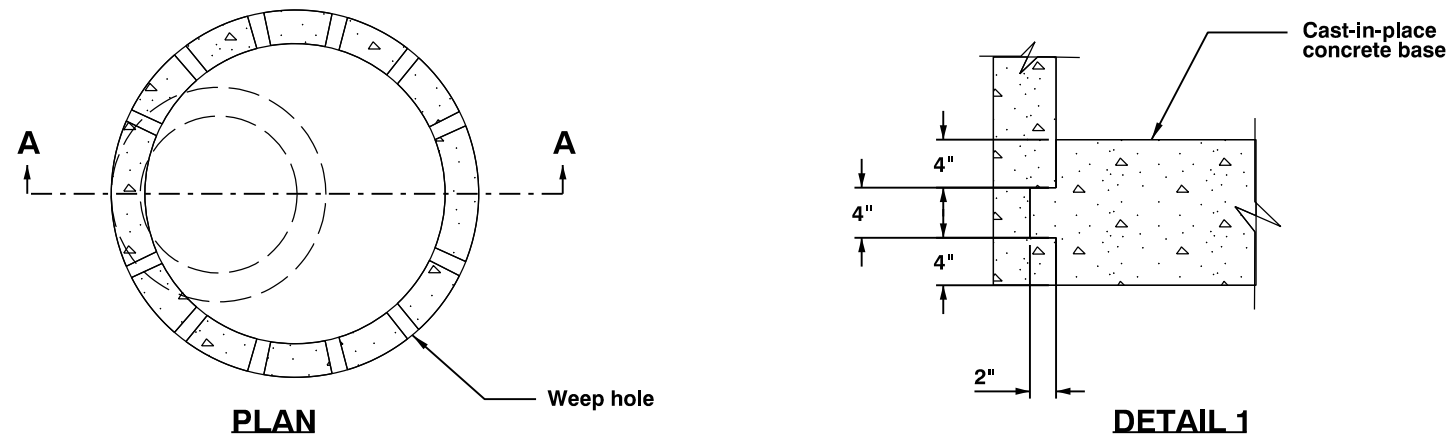

DRYWELL INSTALLATION TABLE						
DRAWING REFERENCE	STATIONING	OFFSET	DFI no.	W (FT)	DEPTH (FT)	MIN. INFILTRATION CAPACITY REQUIRED
C02C	Sta. 1105+22.92	51.89' Lt.	D01165	3.00	30.00	90 GPM
C02C	Sta. "122ND" 8+50.45	34.99' Rt.	N/A	4.00	30.00	110 GPM
C02C	Sta. "123RD" 15+66.59	5.51' Lt.	N/A	3.00	30.00	90 GPM
C03C	Sta. "124TH" 5+90.88	8.11' Lt.	N/A	3.00	30.00	90 GPM
C03C	Sta. 1111+36.53	26.96' Rt.	D01168	3.00	30.00	90 GPM
C03C	Sta. "125TH" 26+06.80	9.40' Lt.	N/A	3.00	30.00	90 GPM
C04C	Sta. "127TH" 7+49.75	6.69' Rt.	N/A	4.50	30.00	120 GPM
C04C	Sta. "127TH" 7+24.75	6.65' Rt.	N/A	4.50	30.00	120 GPM
C04C	Sta. 1118+85.31	13.18' Rt.	D01170	3.00	30.00	90 GPM
C04C	Sta. "128TH" 5+69.93	3.92' Rt.	N/A	3.00	30.00	90 GPM
C04C	Sta. "129TH" 10+70.21	4.91' Lt.	N/A	4.00	30.00	110 GPM
C05C	Sta. "130TH" 30+72.83	6.64' Rt.	N/A	4.00	30.00	110 GPM
C05C	Sta. "131ST" 5+43.36	6.32' Lt.	N/A	4.50	30.00	120 GPM
C06C	Sta. "132ND" 10+71.74	6.31' Lt.	N/A	3.00	30.00	90 GPM
C06C	Sta. "132ND" 10+96.94	6.30' Lt.	N/A	3.00	30.00	90 GPM
C06C	Sta. 1133+69.50	39.33' Lt.	D01174	3.00	30.00	90 GPM
C06C	Sta. 1133+94.50	39.65' Lt.	D01175	3.00	30.00	90 GPM
C06C	Sta. 1135+50.50	12.08' Rt.	D01176	3.00	30.00	90 GPM
C06C	Sta. 1136+86.40	34.93' Rt.	D01177	3.00	30.00	90 GPM
C06C	Sta. 1137+97.55	41.77' Lt.	D01178	4.50	30.00	120 GPM
C07C	Sta. 1140+78.84	42.65' Lt.	D01180	3.00	30.00	90 GPM
C07C	Sta. 1141+03.92	42.67' Lt.	D01181	3.00	30.00	90 GPM
C07C	Sta. 1144+04.38	42.38' Rt.	D01183	3.00	30.00	90 GPM

- NOTES:
- All precast products shall conform to requirements of ASTM C478.
 - See Std. Drg. RD336 for manhole steps details.
 - Provide a flexible joint for all connected pipes:
 - Rigid pipe Δ 36 inches - 18 inches (max.) from outside wall.
 - Flexible pipe - 18 inches (max.) from the outside wall unless a flexible joint fitting is installed and accepted.
 - Provide 12 inches (min.) of separation between a section joint and the outer edge of any opening.

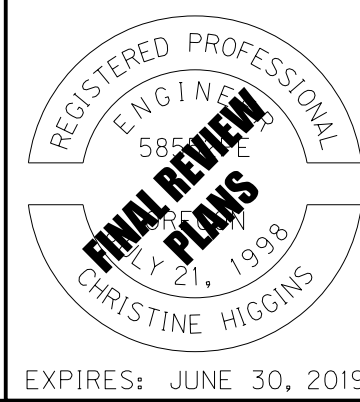

HDR HDR ENGINEERING, INC
 1001 SW 5TH AVENUE, SUITE 1800
 PORTLAND, OR 97204-1134
 503.423.3700

US26 (POWELL BLVD):
SE 122ND AVE - SE 136TH AVE SEC.
 MT. HOOD HIGHWAY
 MULTNOMAH COUNTY

Designer: Cory Gieseke Review: Christine Higgins
 Drafter: Ryan Sheehan Checker: Kyle Donovan

DRAINAGE DETAILS SHEET NO. HA02