

OPERATION & MAINTENANCE MANUAL

Water Quality Filter Strip

Manual prepared: February 2020

DFI No. D01211



Figure 1: DFI No. D01211, looking West [Placeholder for Future Photo]

1. Identification

Drainage Facility ID (DFI): D01211
Facility Type: Water Quality Filter Strip
Construction Drawings: (V-File Numbers) 52V-27
Location: District: 05
Highway No.: 069 AN1
Mile Post: 9.98 to 9.89, Right Side within
Loop Ramp

2. Manual Purpose

The purpose of this manual is to outline inspection needs and summarize maintenance actions.

3. Facility Location

The location map below details the facility location. The highway, mile posts, side streets, access location, and stormwater flow directions are noted on the map. **NOTE: Mile posts are based off of the V-File, and may vary from TransGIS mile posts.**

Facility location type: **Roadway shoulder**

Flow direction: East

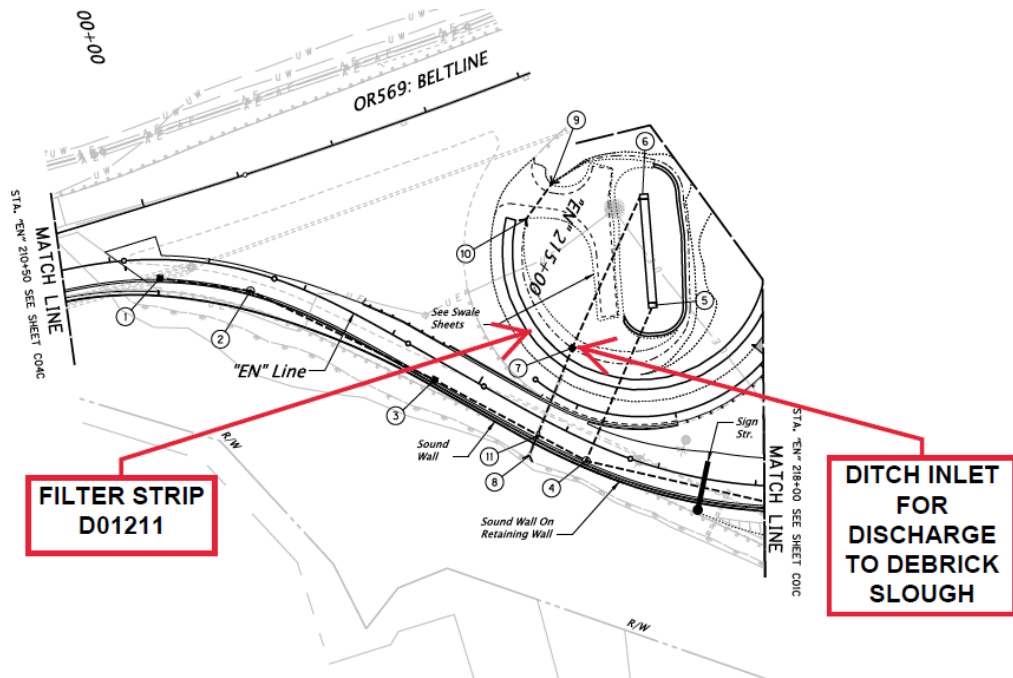


Figure 2: Filter Strip D01211 Location

4. Facility Summary

The width is measured perpendicular to the edge of pavement and is equivalent to the flow length. The length is measured parallel to the edge of pavement and is equivalent to the length of the contributing impervious area.

The length and width of the applicable facility components are:

Component	Length (feet)	Width (feet)
Filter Strip	627	10

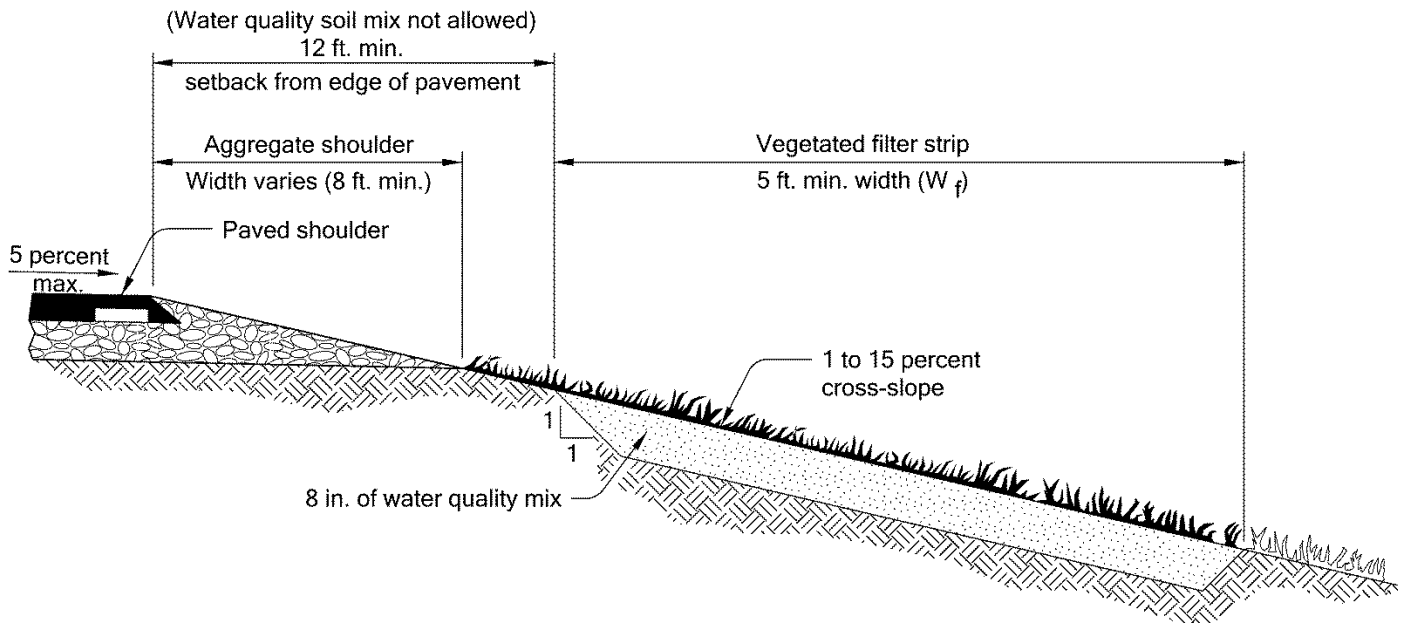


Figure 3: Filter Strip Section

The slope of the facility is presented by a vertical distance (rise) followed by the horizontal distance (run).

Side Slope	Rise (feet)	Run (feet)
Filter Strip	0.50	10

Site Specific Information:

Maintenance vehicles can park next to the filter strip along the Delta Highway shoulder. Heavy equipment should be kept off the filter strip

5. Facility Access

Maintenance access to the facility:

<input type="checkbox"/> Roadside pad	<input checked="" type="checkbox"/> Roadside shoulder
<input type="checkbox"/> Access road with Gate	<input type="checkbox"/> Access road without Gate



Figure 4: [Placeholder pending facility construction]

6. Operational Components / Maintenance Items

Classification and Standard Operational (Op) Plan:

This facility is classified as a:

<p style="text-align: center;"><input checked="" type="checkbox"/> Filter Strip (Op Plan A)</p> <p>A filter strip consists of a vegetated or media slope located parallel to the edge of pavement. It maintains sheet flow of stormwater runoff over the width of the strip.</p>	<p style="text-align: center;"><input type="checkbox"/> Bioslope (Op Plan B)</p> <p>A bioslope consists of a filter strip and treatment zone. It is a flow-through stormwater treatment facility located along roadside embankments.</p>
<p>A standard operational plan illustrates the general facility footprint configuration and explains the purpose of each facility component. Operational plans (A, B) are provided in the Standard Operation Manual.</p>	

See Appendix A for the site specific operational plan.

Operational Components

Filter strips and bioslopes have many components that assist with treatment, conveyance, and infiltration of stormwater runoff. The components in use can vary depending on the facility design. The facility components table (Table 1) has been provided to highlight the applicable components for this facility. The component is in use when the box contains an “x” (e.g.).

The Standard Operation Manual for Water Quality Filter Strips and Bioslopes outlines facility operation, typical footprint configuration, and component definitions and details. A link to the manual is attached to the feature marker in TransGIS.

<https://gis.odot.state.or.us/TransGIS/>

Maintenance Items

Operational components marked in Table 1 should be inspected and maintained according to Section 7. Each facility component is defined and detailed in the Standard Operation Manual using the associated ID number indicated below.

Table 1: Bioslope/Filter Strip Components		ID #
Facility Inlet		
Pavement Sheet Flow	<input checked="" type="checkbox"/>	B1
Flow Spreader	<input type="checkbox"/>	B2
Ground Cover		
Vegetated Slope	<input type="checkbox"/>	B3
Aggregate Media Slope	<input checked="" type="checkbox"/>	B4
Underground Components		
Water Quality Mix	<input checked="" type="checkbox"/>	B5
Ecology Mix	<input type="checkbox"/>	B6
Granular Drain Backfill Material	<input type="checkbox"/>	B7
Geotextile Fabric	<input type="checkbox"/>	B8
Geocell Grid	<input type="checkbox"/>	B9
Structures		
Curb/Berm	<input type="checkbox"/>	B10
Check Dam	<input type="checkbox"/>	B11
Cleanout	<input type="checkbox"/>	B12
Facility Outlet		
Perforated Drain Pipe	<input type="checkbox"/>	B13
Open Slope Outlet	<input type="checkbox"/>	B14
Open Channel Outlet	<input type="checkbox"/>	B15
Storm Drain Outlet Pipe	<input type="checkbox"/>	B16
Outfall Type		
Waterbody (Creek/Lake/Ocean)	<input checked="" type="checkbox"/> C	B17
	<input type="checkbox"/> L	
	<input type="checkbox"/> O	
Outfall Channel	<input type="checkbox"/>	B18
Storm Drain System	<input type="checkbox"/>	B19
Outfall Components		
Pervious Berm	<input type="checkbox"/>	B20
Riprap Pad	<input type="checkbox"/>	B21

7. Maintenance

Maintenance Frequency/Maintain Records

- a. Inspect annually. Preferably prior to the rainy season.
- b. Clean and maintain as necessary. Refer to Activity 125 for conditions when maintenance is needed.
- c. Keep a record of inspections, maintenance, and repairs.

Maintenance Guide/Maintenance Actions

The ODOT Routine Road Maintenance Water Quality and Habitat Guide (the *Blue Book*) outlines the standard maintenance actions for water quality facilities under Activity 125.

There are standard maintenance tables for standard ODOT designs. The maintenance tables describe the maintenance component, the defect or problem, the condition when maintenance is needed, and the recommended maintenance to correct the problem. Use the following tables to maintain ODOT filter strips and bioslopes:

- Table 1 (General Maintenance): Contains general maintenance and inspection guidelines that are applicable to all ODOT water quality facilities
- Table 4 (Water Quality Filter Strips)

The ODOT Maintenance Guide can be viewed at the following website:

<http://www.oregon.gov/ODOT/HWY/OOM/pages/mguide.aspx>

The *Blue Book* can be viewed at the following website:

http://www.oregon.gov/ODOT/Maintenance/Documents/blue_book.pdf

8. Limitations

Filter strips and bioslopes are NOT designed to allow the use of heavy equipment. Vehicles entering the facility can create depressions (tire ruts), damage vegetation, and damage structural components (e.g. flow spreaders). These conditions may result in poor treatment and drainage performance.

9. Waste Material Handling

Material removed from the facility is defined as waste by the Department of Environmental Quality (DEQ). Refer to the road waste section of the ODOT Maintenance Yard Environmental Management System (EMS) Policy and Procedures Manual for disposal options:

<http://www.oregon.gov/ODOT/HWY/OOM/pages/ems.aspx>


Contact any of the following for more detailed information about management of waste materials found on site:

ODOT Clean Water Unit	(503) 986-3008
ODOT Statewide Hazmat Coordinator	(503) 667-7442
ODOT Region 1 Hazmat Coordinator	(503) 731-8290
ODOT Region 2 Hazmat Coordinator	(503) 986-2647
ODOT Region 3 Hazmat Coordinator	(541) 957-3594
ODOT Region 4 Hazmat Coordinator	(541) 388-6186
ODOT Region 5 Hazmat Coordinator	(541) 963-1590
ODEQ Northwest Region Office	(503) 229-5263


A Appendix A – Site Specific Operational Plan

Contents:


Operational Plan: DFI D01211

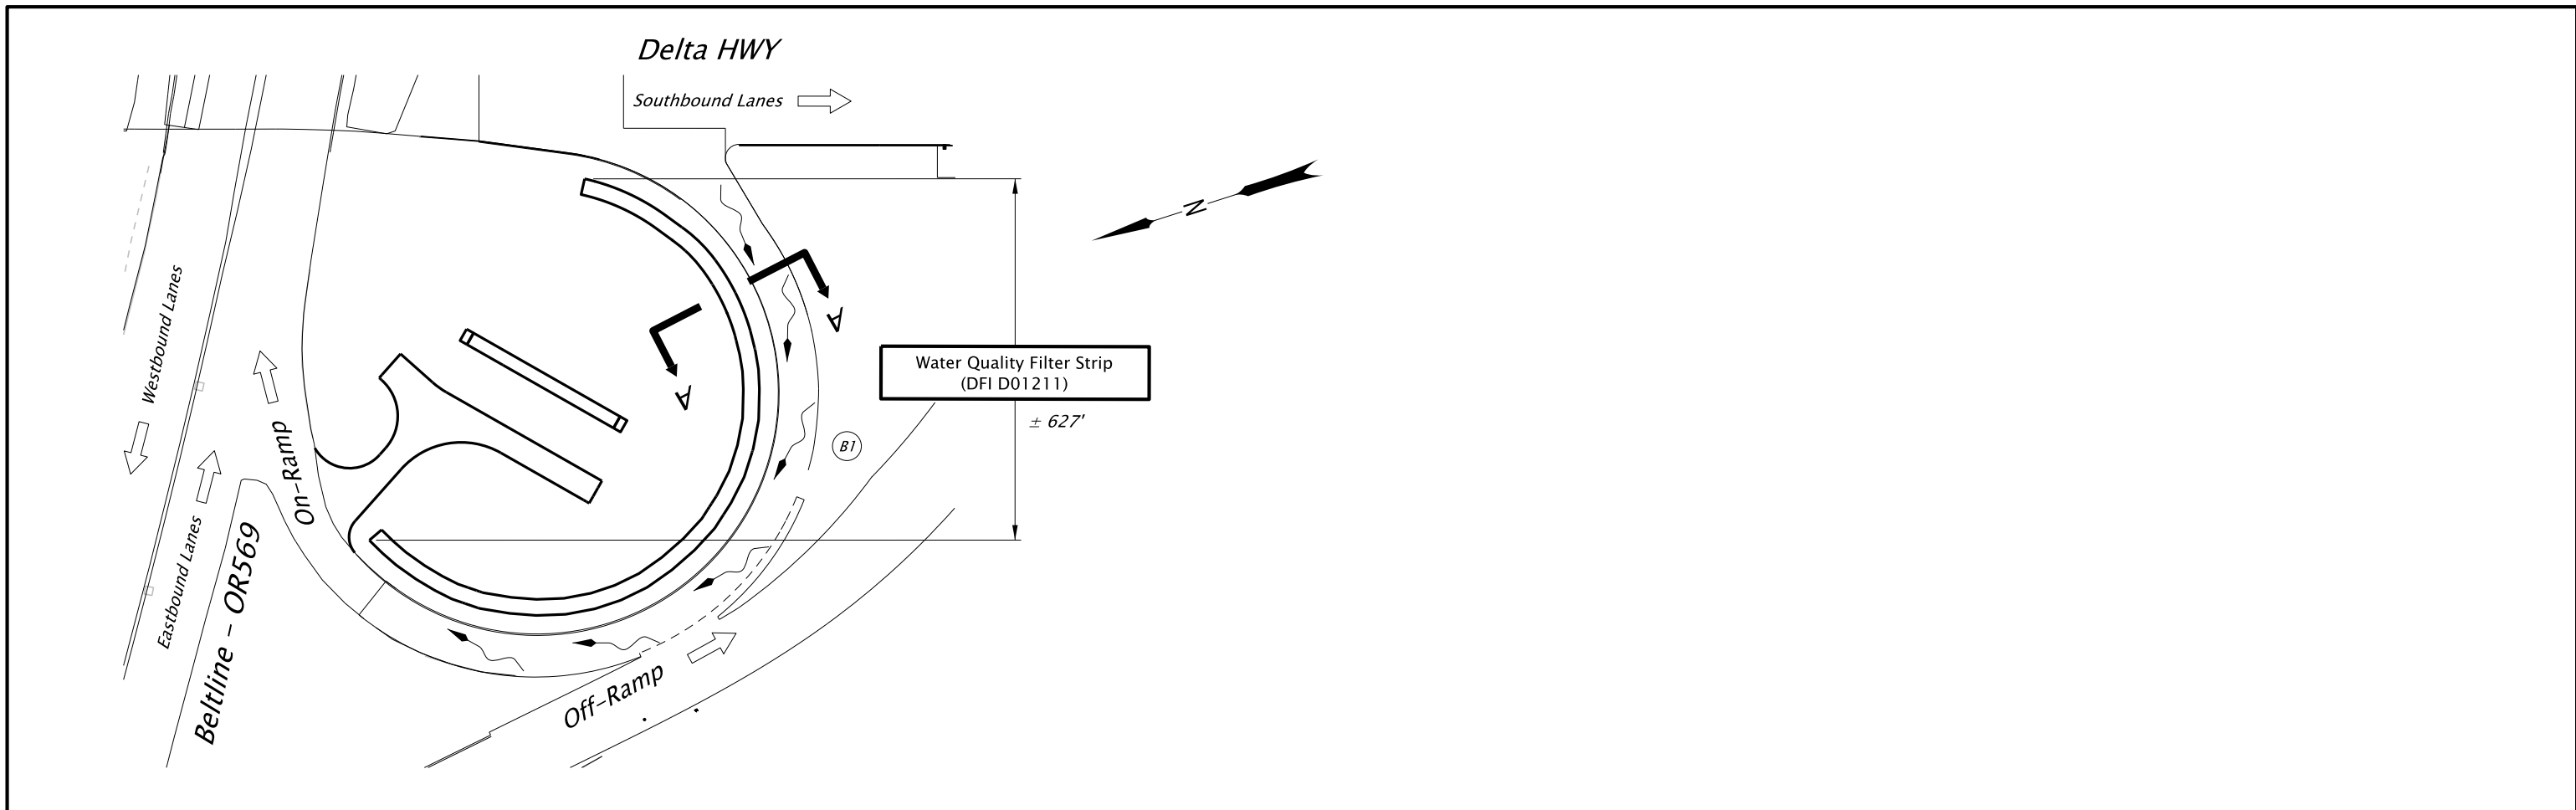

PLAN
N.T.S.

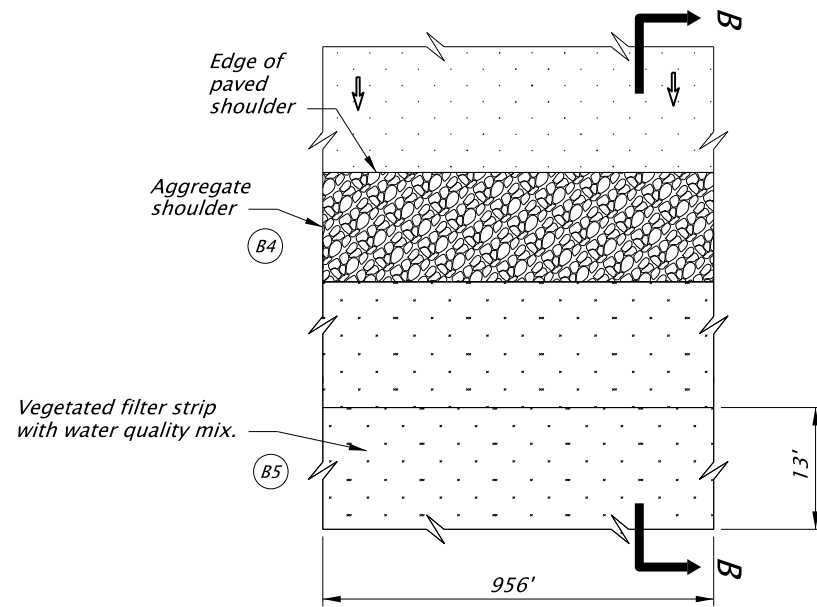

SECTION A-A
N.T.S.

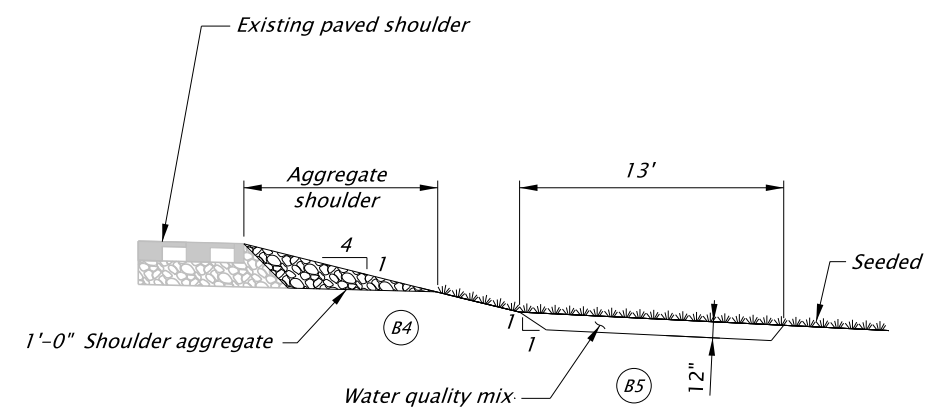

SECTION B-B
N.T.S.

- LEGEND:
- (B#) Swale Component (See Table 1 in O&M Manual)
 - Manhole
 - Inlet
 - - - Storm Pipe (Facility)
 - ▶ Conveyance Direction
 - ↔ Pavement / Facility Flow Path
 - ↔ Highway Lane Direction

WATER QUALITY FILTER STRIP
N.T.S.

Prepared By: R. Attenasio
Drafted By: M. Wainscott

Sht. 1 of 1


OREGON DEPARTMENT OF TRANSPORTATION

DFI D01211
MAINTENANCE DISTRICT 05 HWY OR569
WATER QUALITY BIOFILTRATION SWALE
BELTLINE HIGHWAY
LANE COUNTY

B Appendix B – Project Contract Plans

Contents:

Site Specific Subset of Project Contract Plan 52V-27

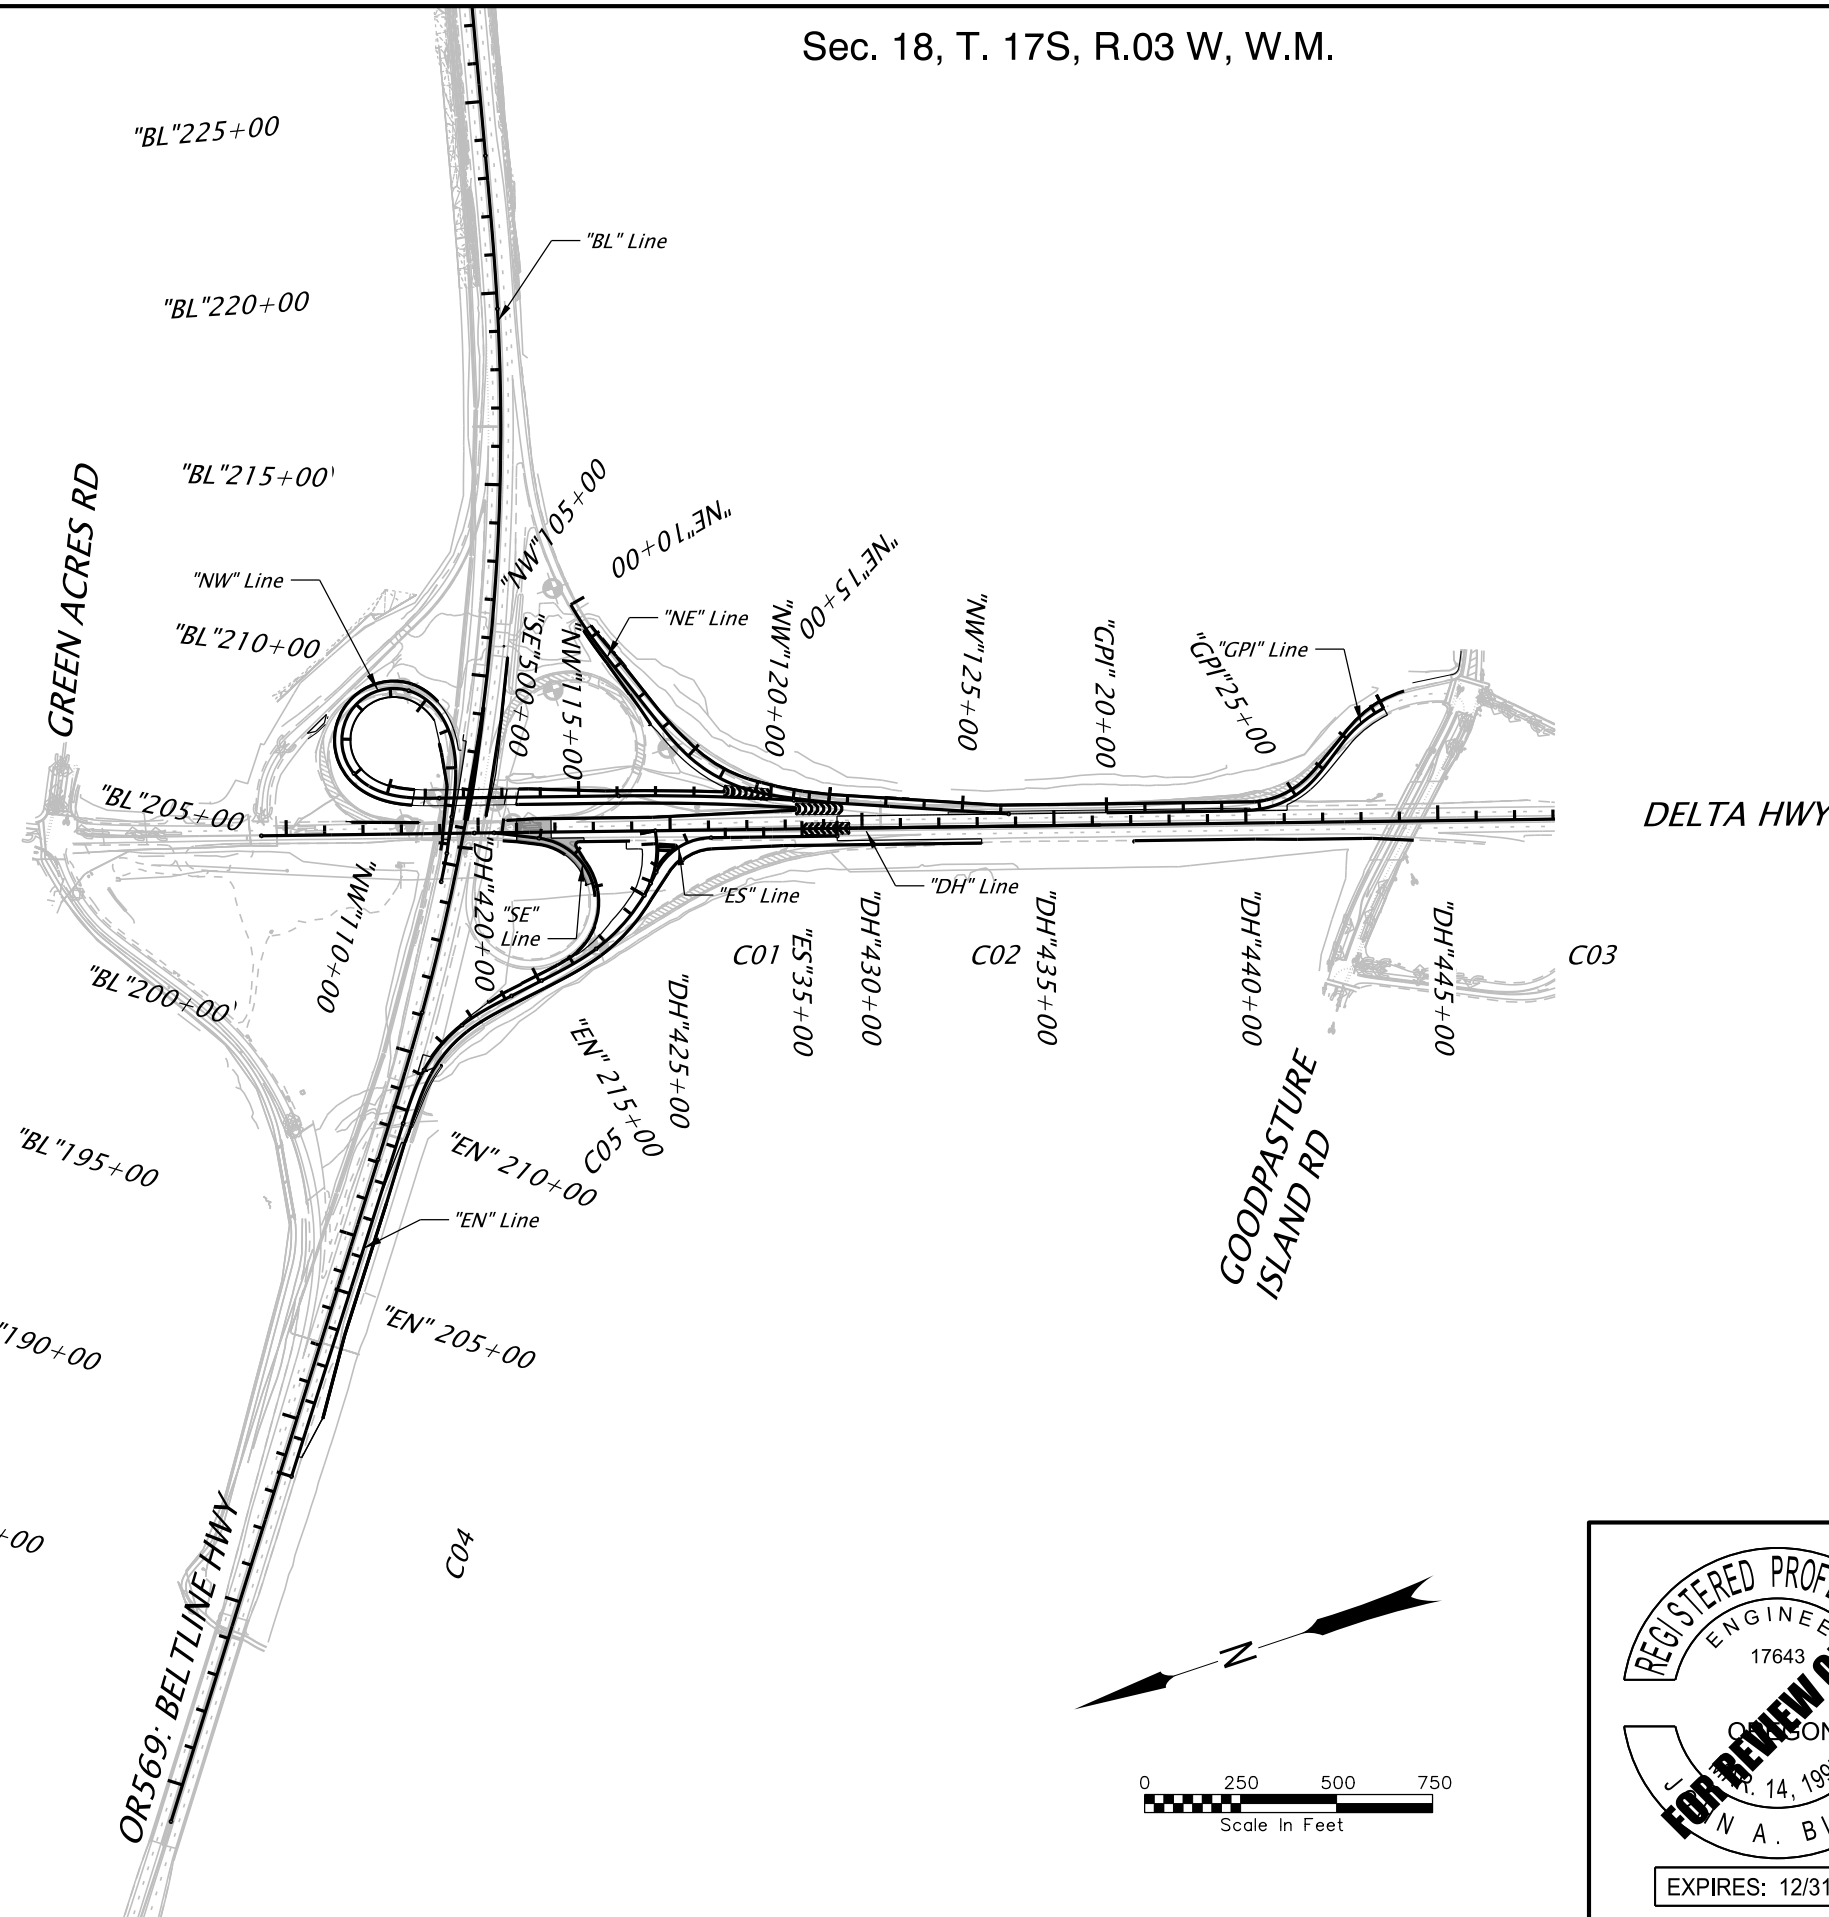


DELTA HWY

GOODPASTURE ISLAND RD

GREEN ACRES RD

OR569 BELTLINE HWY

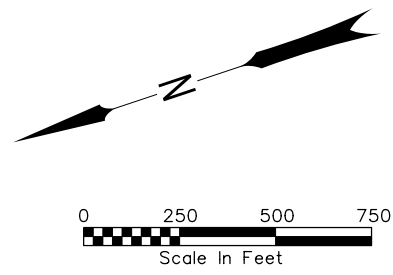

REGISTERED PROFESSIONAL ENGINEER
 17643
 OREGON
 APR 14, 1995
 N. A. BLAND
 EXPIRES: 12/31/2019


ch2m 2020 SW 4TH AVE. - 3RD FLOOR
 PORTLAND, OR 97201-4953
 TEL. 503.235.5000

OR569: BELTLINE @ DELTA HIGHWAY - INTERCHANGE SEC.
 BELTLINE HIGHWAY
 LANE COUNTY

Designer: B. Niameogo Reviewer: S. Litchfield
 Drafter: M. Wainscott Checker: J. Bland

PLAN SHEET LAYOUT SHEET NO. A04

- ① Sta. "EN" 211+50.97, 18.68' Rt.
Const. type "G-2" conc. inlet with sump
Grate Elev. = 396.54
I.E. (OUT) = 392.33 (SE)
- ② Sta. "EN" 212+48.02, 18.68' Rt.
Inst. 12" DI storm sew. pipe - 91' (NW)
5' depth
Const. storm manhole 48" dia. with inlet grate
Rim Elev. = 397.24
I.E. (IN) = 391.89 (NW)
I.E. (OUT) = 391.89 (S)
- ③ Sta. "EN" 214+59.31, 18.73' Rt.
Inst. 18" storm sew. pipe - 206' (N)
5' depth
Const. type "G-2" Conc. inlet with sump
Grate Elev. = 396.39
I.E. (IN) = 391.35 (N)
I.E. (OUT) = 391.15 (S)
- ④ Sta. "EN" 216+20.00, 18.73' Rt.
Inst. 18" storm sew. pipe - 174' (N)
10' depth
Inst. 18" storm sew. pipe - 201' (SE)
10' depth
Const. storm manhole 48" dia. with inlet grate
Grate Elev. = 398.05
I.E. (IN) = 390.70 (N)
I.E. (IN) = 390.70 (SE)
I.E. (OUT) = 390.50 (E)
- ⑤ Sta. "EN" 216+29.25, 149.57' Rt.
Inst. 18" storm sew. pipe with sloped end section - 169' (W)
10' depth
I.E. (OUT) = 389.78 (W)
- ⑥ Sta. "EN" 215+28.92, 170.07' Rt.
See sheet HA07
I.E. (IN) = 389.00
- ⑦ Sta. "EN" 215+55.66, 74.85' Lt.
Inst. 18" storm sew. pipe with sloped end section - 167'
5' depth
Const. ditch inlet Type D
Grate Elev. = 392.69
I.E. (IN) = 388.00 (E)
I.E. (OUT) = 387.80 (W)
- ⑧ Sta. "EN" 215+65.84, 38.08' Rt.
Inst. 18" storm sew. pipe with sloped end section - 113' (E)
10' depth
I.E. (OUT) = 387.42
Riprap Outlet (Cl. 50)(18" depth)
- ⑨ Sta. "EN" 214+70.02, 220.03' Lt.
Const. sloped end
I.E. (IN) = 394.63
- ⑩ Sta. "EN" 214+57.22, 174.88' Lt.
Inst. 18" culv. pipe - 47' (E)
5' depth
I.E. (OUT) = 394.20
Const. sloped end
- ⑪ Sta. "EN" 215+77.00, 25.74' Rt.
Install 6' steel casing under soundwall
Min. dia. 34" smooth steel casing
0.313" thickness per ASTM A 53 grade B
or ASTM A 252 grade 2

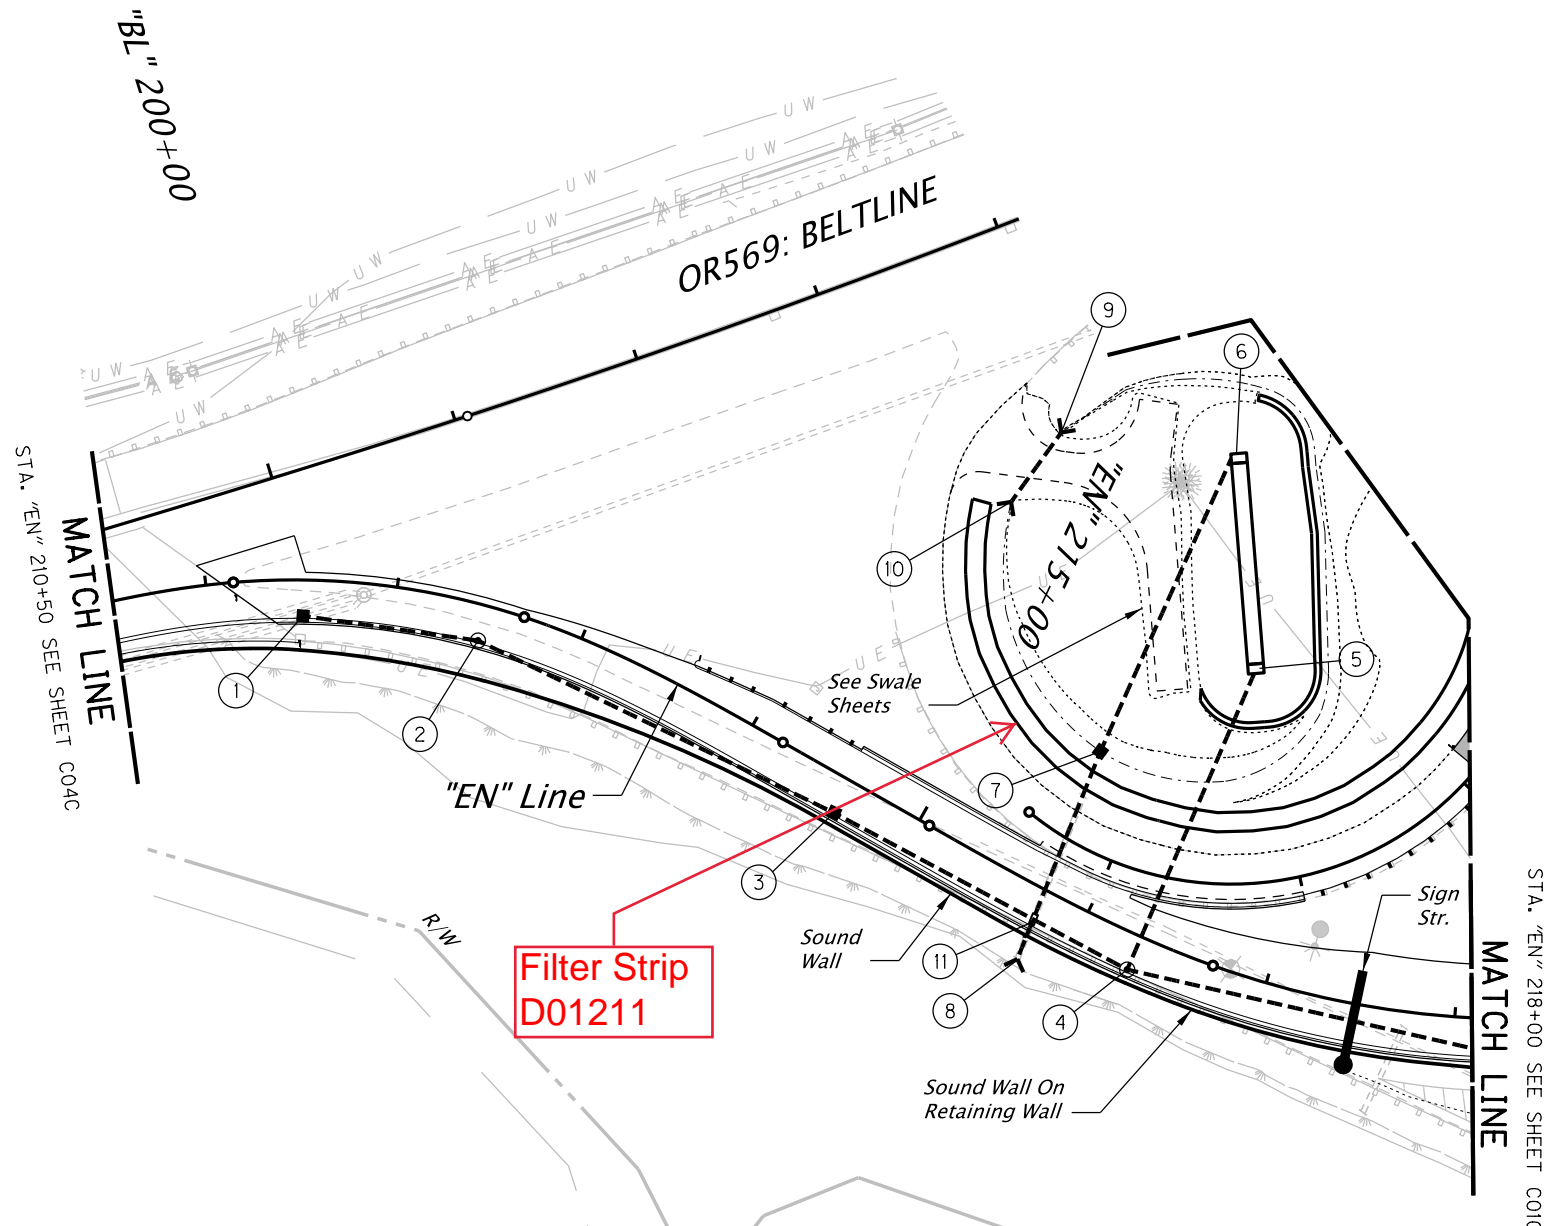


Filter Strip
D01211


REGISTERED PROFESSIONAL
ENGINEER
15058PE
OREGON
RICHARD E. ATTANASIO
EXPIRES: 12/31/2019

FOR REVIEW ONLY


ch2m	2020 SW 4TH AVE. - 3RD FLOOR PORTLAND, OR 97201-4953 TEL. 503.235.5000
OR569: BELTLINE @ DELTA HIGHWAY - INTERCHANGE SEC.	
BELTLINE HIGHWAY LANE COUNTY	
Designer: D. Alves	Reviewer: S. Litchfield
Drafter: M. Wainscott	Checker: R. Attanasio
DRAINAGE AND UTILITIES	
SHEET NO. C05B	

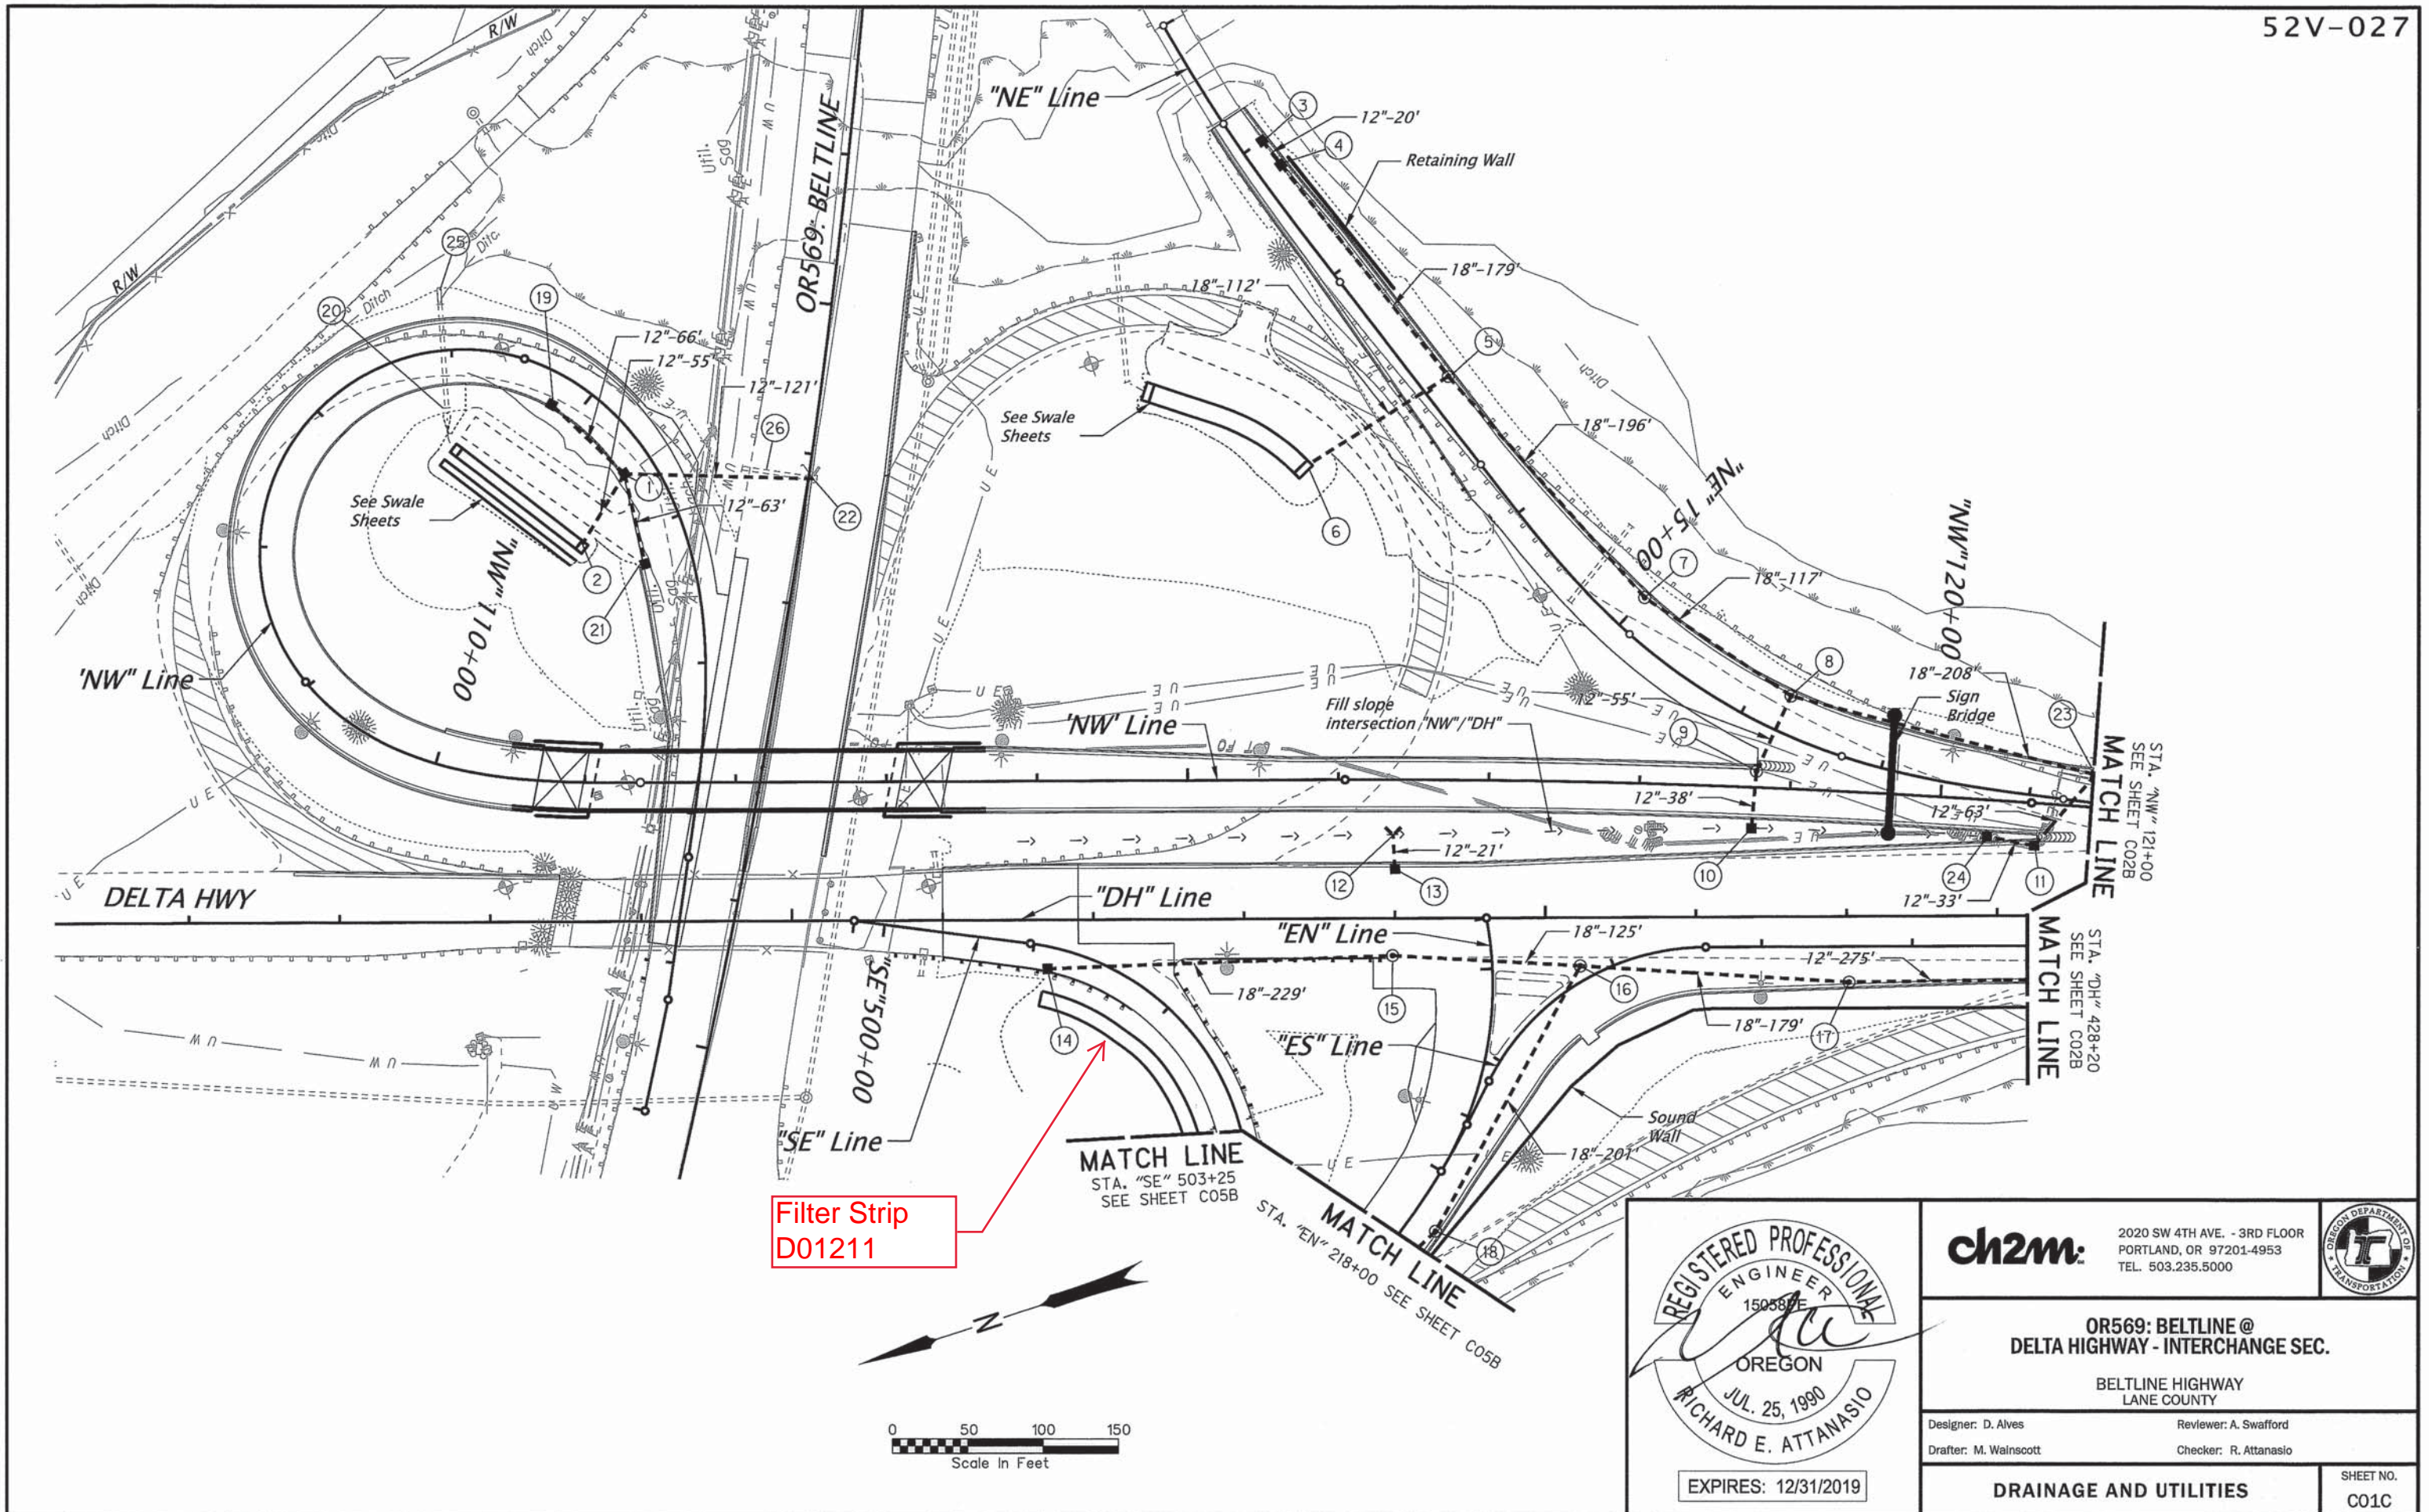

Filter Strip
D01211

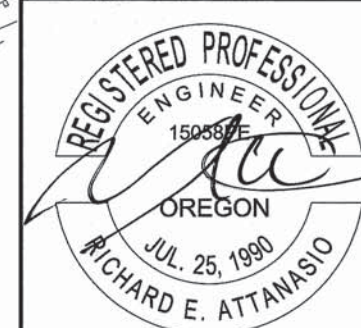


ch2m
 2020 SW 4TH AVE. - 3RD FLOOR
 PORTLAND, OR 97201-4953
 TEL. 503.235.5000



OR569: BELTLINE @ DELTA HIGHWAY - INTERCHANGE SEC.
 BELTLINE HIGHWAY
 LANE COUNTY


Designer: D. Alves Reviewer: A. Swafford
 Drafter: M. Wainscott Checker: R. Attanasio

DRAINAGE AND UTILITIES SHEET NO. C01C

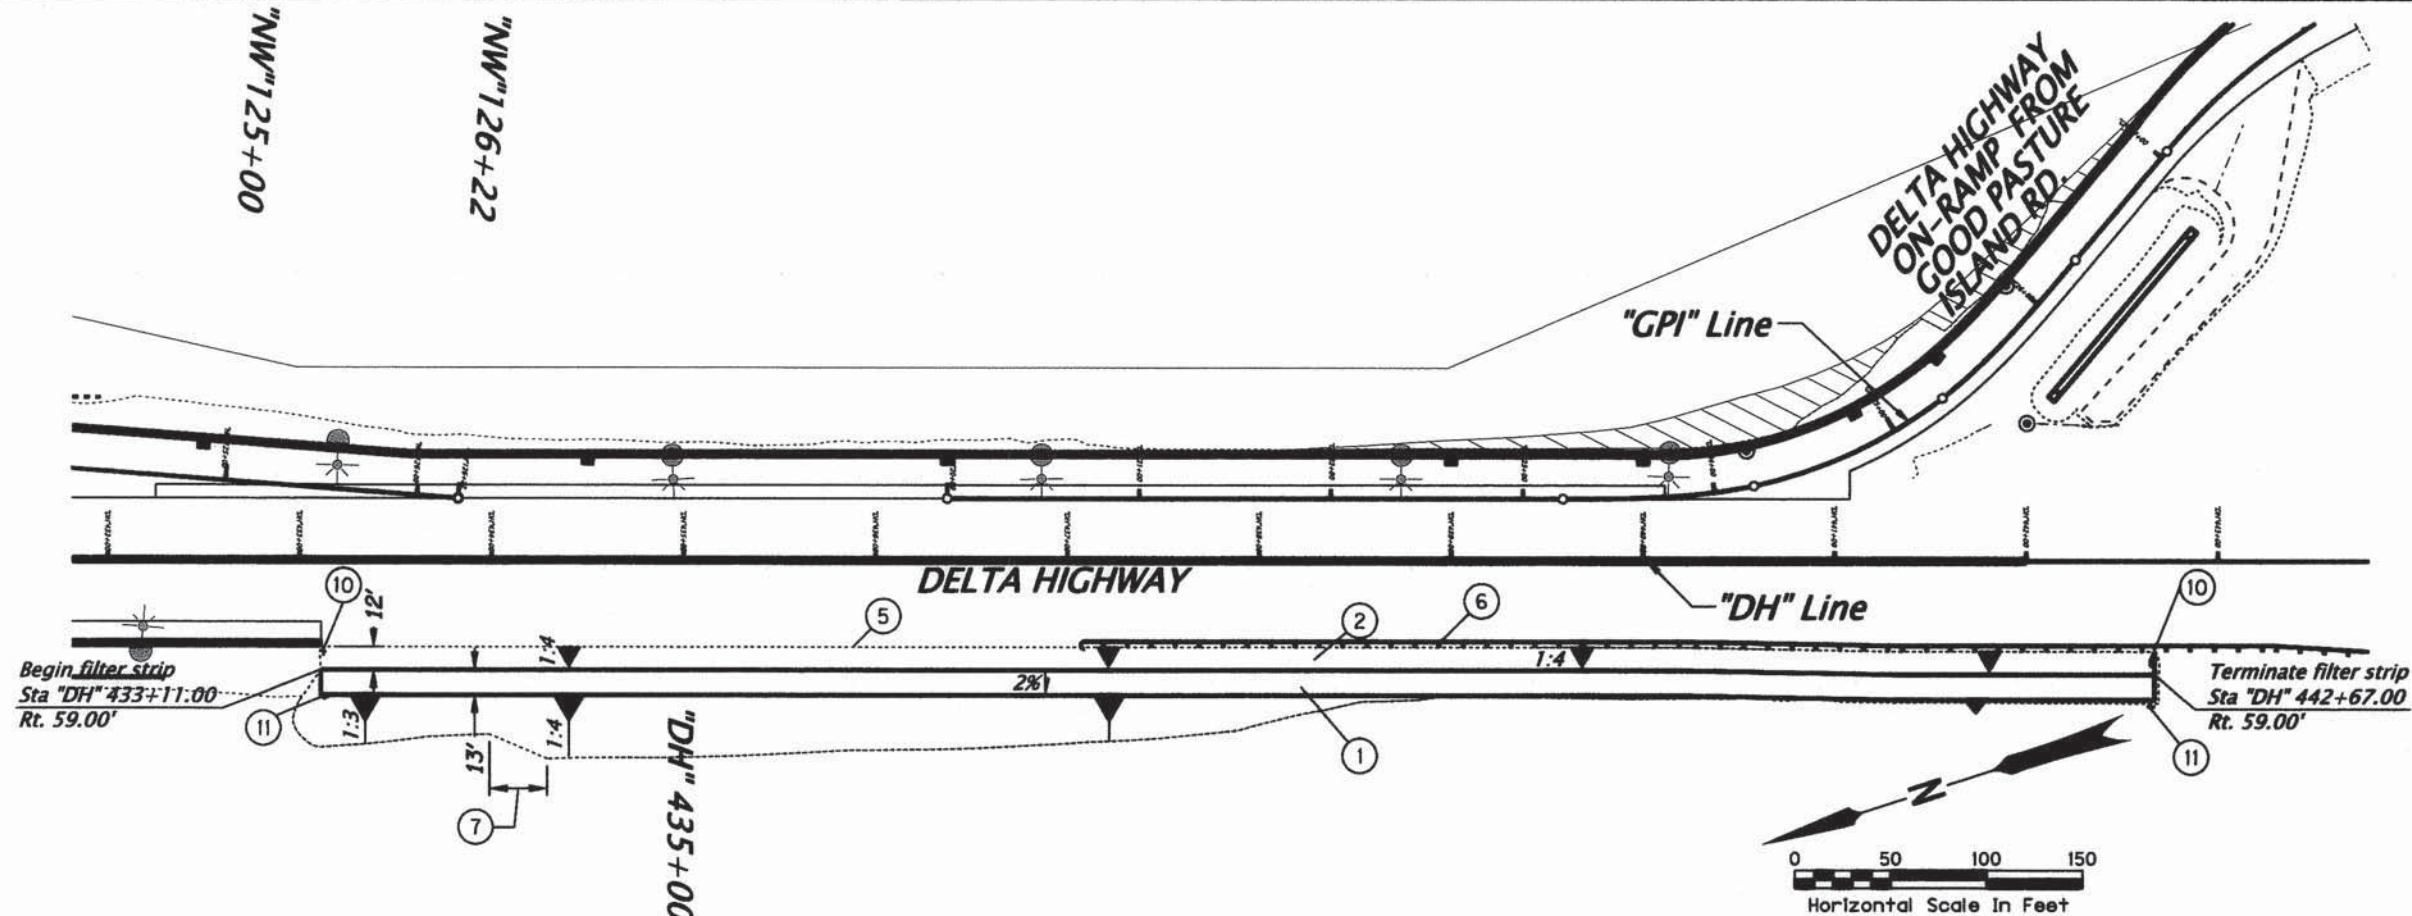


WATER QUALITY FILTER STRIP 5 (FS5) PLAN DFI #: D01210

- ① Const. 13' water quality filter strip (For details, see sht. HA10)
- ② Setback from edge of pavement (For details, see sht. HA10)
- ③ Const. 10' water quality filter strip (For details, see sht. HA10)
- ④ Transition cross-slope for setback from 1:4 to 1:20
- ⑤ Existing edge of pavement
- ⑥ Guardrail (For details, see sht. C03A)
- ⑦ 30' transition from 1:3 to 1:4 for fill slope below filter strip
- ⑧ 1:4 setback cross-slope
- ⑨ 1:20 setback cross-slope
- ⑩ Inst. stormwater Facility Field Marker Type S1-4, (see drg. no. RD399)
- ⑪ Inst. stormwater Facility Field Marker Type S2-4, (see drg. no. RD399)
- ⑫ Transition from 1:2 to 1:4 for fill slope below filter strip
- ⑬ 1:4 fill slope below filter strip
- ⑭ 1:2 fill slope below filter strip

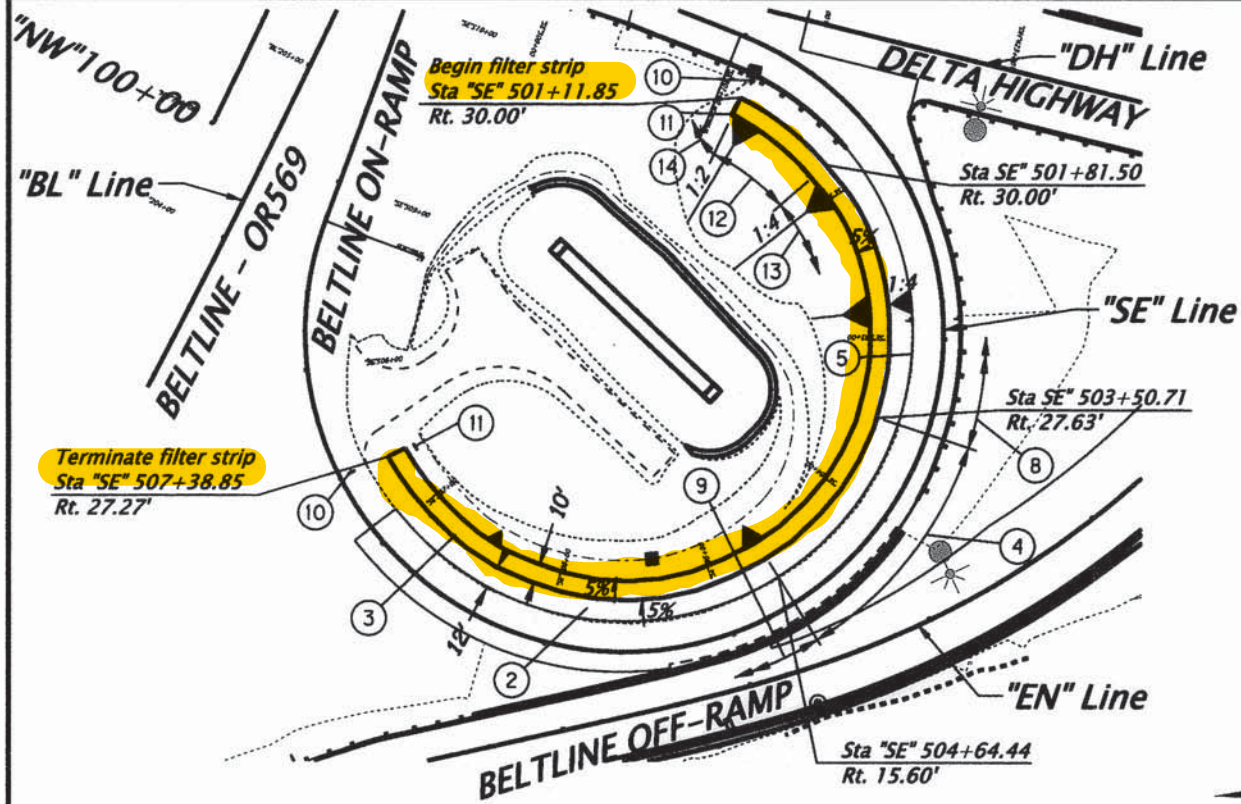

WATER QUALITY FILTER STRIP 6 (FS6) PLAN DFI #: D01211

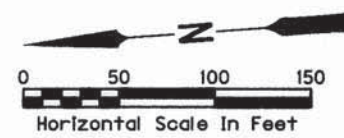


REGISTERED PROFESSIONAL ENGINEER
15058PE
OREGON
JUL. 25, 1980
RICHARD E. ATTANASIO
EXPIRES: 12/31/2019

ch2m 2020 SW 4TH AVE. - 3RD FLOOR
PORTLAND, OR 97201-4953
TEL. 503.235.5000


OR569: BELTLINE @ DELTA HIGHWAY - INTERCHANGE SEC.
BELTLINE HIGHWAY
LANE COUNTY

Designer: M. Little Reviewer: S. Mader
Drafter: J. Pfeifer Checker: R. Attanasio

WATER QUALITY SHEET NO. HA09

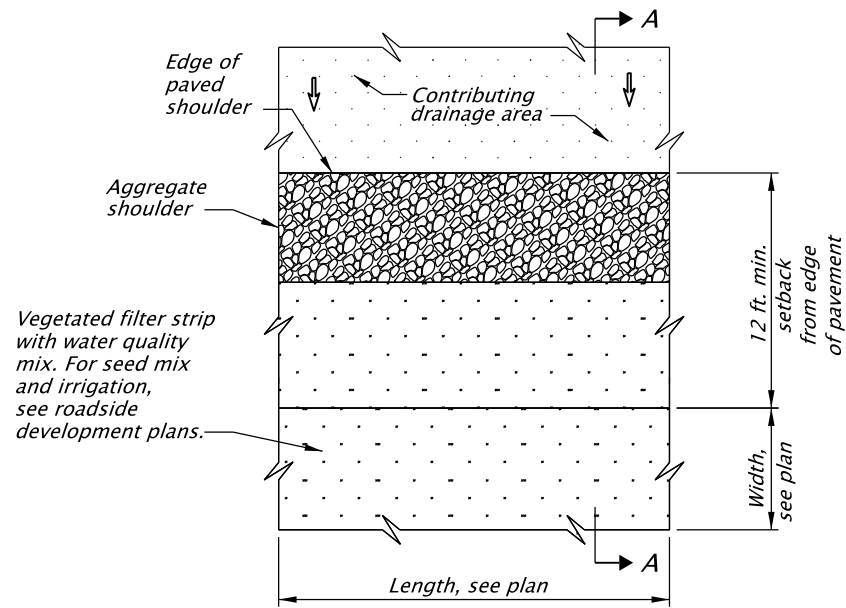


PLAN VIEW

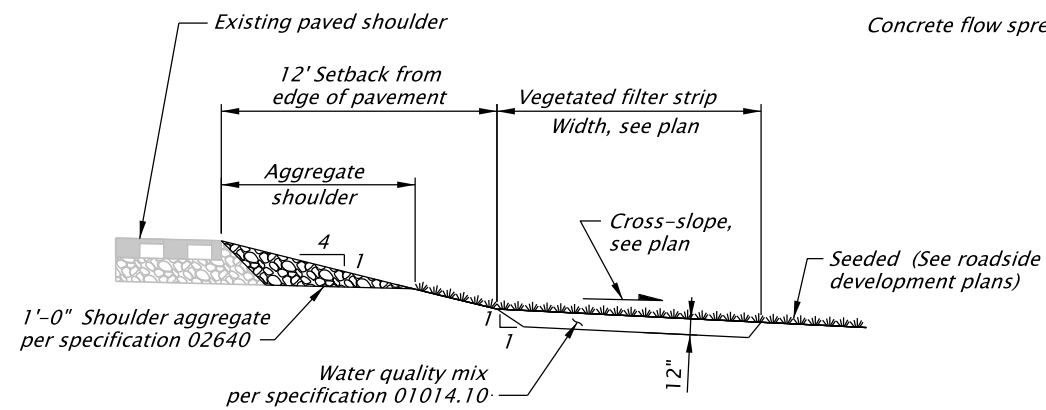


SECTION A-A

FILTER STRIP
NTS

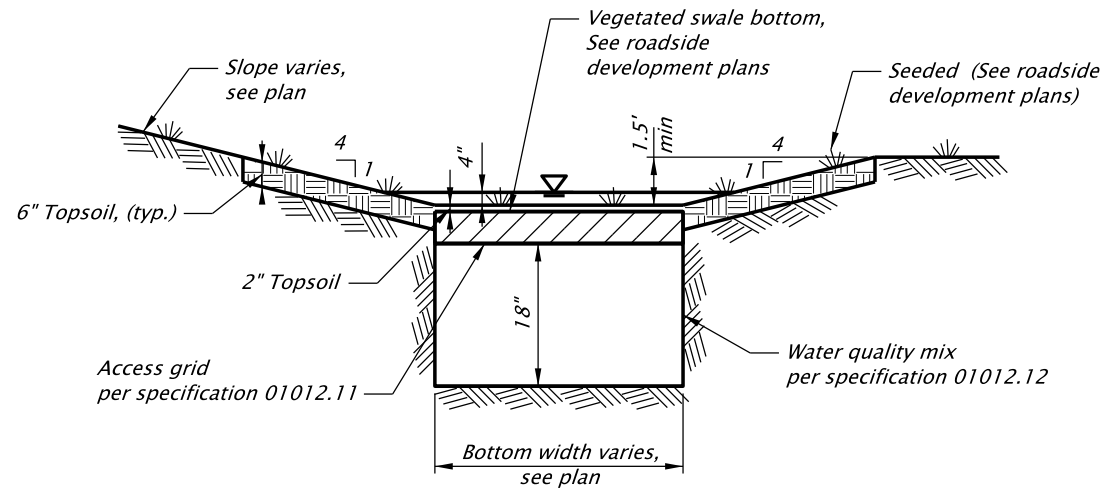


BIOSWALE

NTS

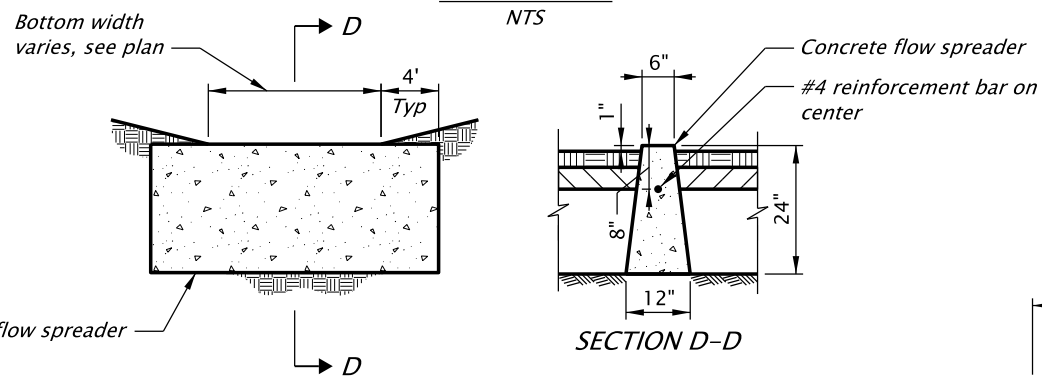


FLOW SPREADER

NTS

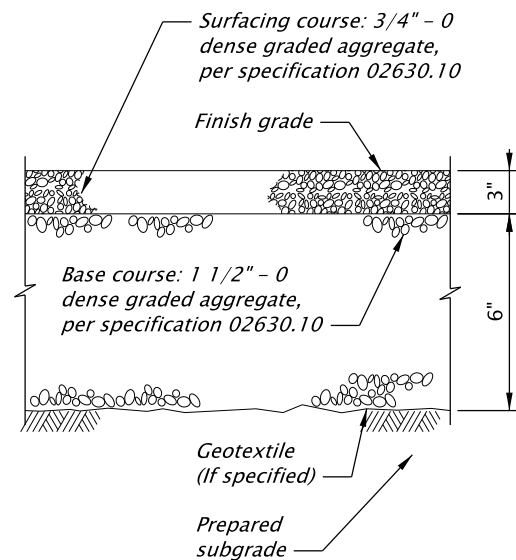


GRAVEL ACCESS ROAD SECTION

NTS

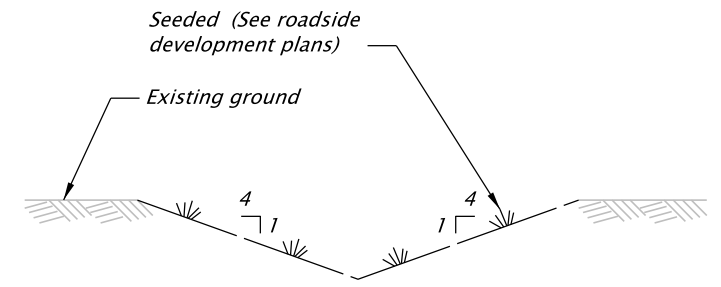


V-DITCH

NTS

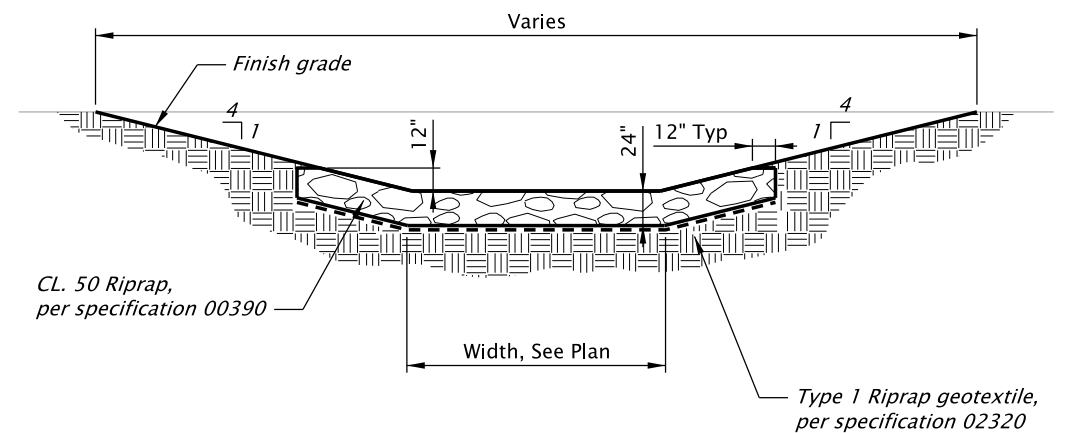

RIPRAP BASIN

NTS

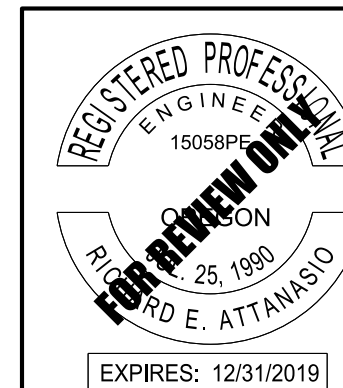

ch2m

2020 SW 4TH AVE. - 3RD FLOOR
PORTLAND, OR 97201-4953
TEL. 503.235.5000



OR569: BELTLINE @
DELTA HIGHWAY - INTERCHANGE SEC.

BELTLINE HIGHWAY
LANE COUNTY

Designer: M. Little
Drafter: J. Pfeiffer

Reviewer: S. Litchfield
Checker: R. Attanasio

WATER QUALITY

SHEET NO.
HA10